

REGISTER SCHEDULE

ALL REGISTER & DIFFUSERS SHALL BE 1/4" THICK.
 SIZES SHOWN & GIVEN AS SHOWN ON DIMS & AS FOLLOWS:
 MAKE GALLAGHER MFG.
 CD 24" x 24" x 1/4"
 CR 24" x 24" x 1/4"
 CR 24" x 24" x 1/4"

FEEDER SCHEDULE

F1 10Y 4 NIGHT CHILDS NO 150 HO-2 200V
 WENTHER 2000 CFM @ 0.4 SR 1/2 HP
 MOTOR 115 V 150000 BTU GAS INPUT ELECTRIC
 IGNITION THERMOSTAT CONTINUOUS FAN OPERATION
 ON HEATING CYCLE 230 LBS WT


PLUMBING-FIXTURE SCHEDULE

MARK	FIXTURE	QTY	SIZE	VOL	CM	HW	MANUFACTURER & CATALOG NO.
CS	CLUSTER	2	1 1/2"	1/4"	1/4"	1/4"	TRU-TEMP & SET BY OTHER TRADES GIVEN BY PLUMBER, FURNISH BY L.K. SPEC 1 1/2" LA CP 1754P
WC	WATER CLOSET	4	-	2	1/2"	1/2"	"LA STD" FLUSH NEW APRIL SIGHT BOWL 1/2" V.G. SWIRL 100 SERIES HOLE AND SHAFT SCHEDULE 40S E WICKER-BROS CONTROL VALVE STAIN BOWL 186-11
UB	URINAL	2	-	1/2"	1/4"	1/4"	"LA STD" FLUSH NEW APRIL SIGHT BOWL 1/2" V.G. SWIRL 100 SERIES HOLE AND SHAFT SCHEDULE 40S E WICKER-BROS CONTROL VALVE STAIN BOWL 186-11
WS	WASH SINK	2	1 1/2"	1/4"	1/4"	1/4"	"LA STD" FLUSH NEW APRIL SIGHT BOWL 1/2" V.G. SWIRL 100 SERIES HOLE AND SHAFT SCHEDULE 40S E WICKER-BROS CONTROL VALVE STAIN BOWL 186-11
WS	WASH SINK	2	1 1/2"	1/4"	1/4"	1/4"	SMILE AS WS/1 DISCET 450 LENS TWO PROTECTORS 1/2" V.G. SWIRL 100 SERIES HOLE AND SHAFT SCHEDULE 40S E WICKER-BROS CONTROL VALVE STAIN BOWL 186-11
SS	SERVICE SINK	2	2	1 1/2"	1/4"	1/4"	"LA STD" FLUSH NEW APRIL SIGHT BOWL 1/2" V.G. SWIRL 100 SERIES HOLE AND SHAFT SCHEDULE 40S E WICKER-BROS CONTROL VALVE STAIN BOWL 186-11
WV	WATER HEATER	1	30"	1/2"	1/4"	1/4"	"LONGRUNNING" 80-G (G GAL) 1000 W 115 V WASHIE P & T VALVE, WALL MOUNTED
HOSE	HOSE BIBB	1	3/4"	1/2"	1/4"	1/4"	K-COBAL "DISC 2"
FC	FILE EXT CYL	1	1/4"	1/2"	1/4"	1/4"	"STANDARD" 102 AT WA-11-212 OIL SEAL AND EXT


EXHAUST FAN SCHEDULE

MARK	CFM	HP	TYPE	SIZE	REMARKS
EP	240	1/4	1/5 V	14"	TYPE 500 SOUND CUBA
EF	670	1/2	1/5 V	14"	TYPE 500 SOUND CUBA

1. PLUS ABOVE TO HAVE BACKUP UNIT DIMENSIONS & 2000 SAELENS
 2. COUPLING ASSISTERS 1/2" THICK & 1/4" x 24" x 20"

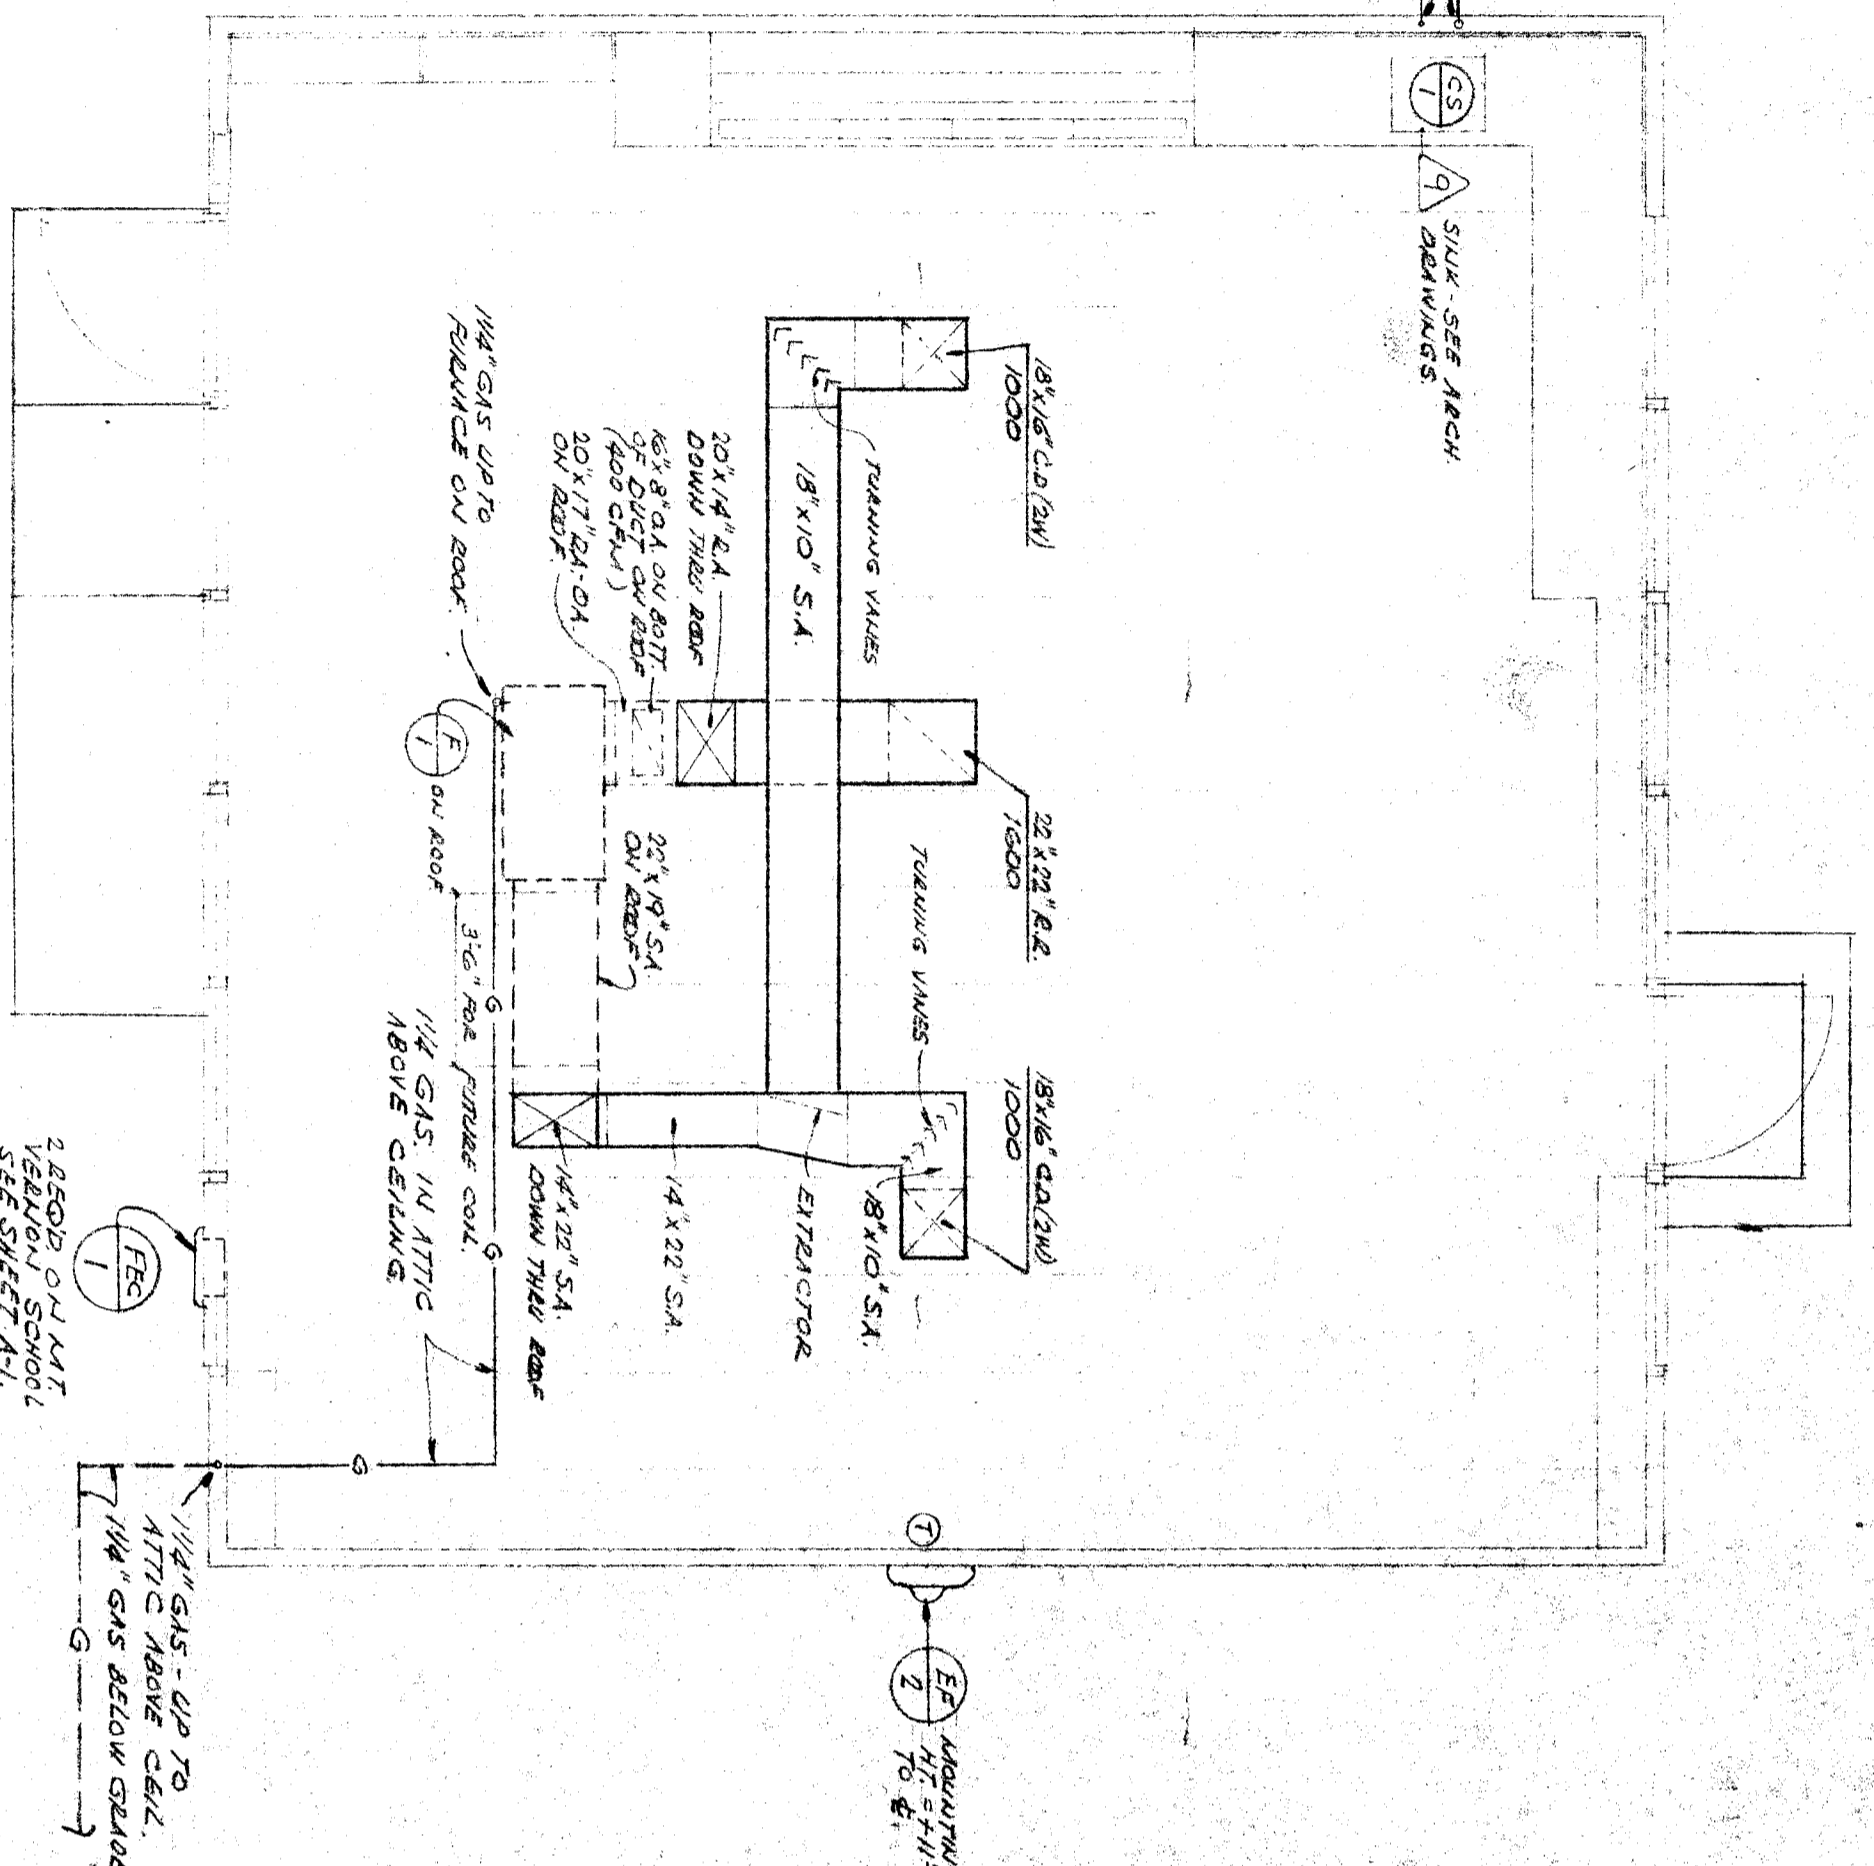

**PLUMBING-VENTILATING PLAN, SCALE 1/4\"/>
 PORTABLE TOILETS-JUNIOR BUILDING**

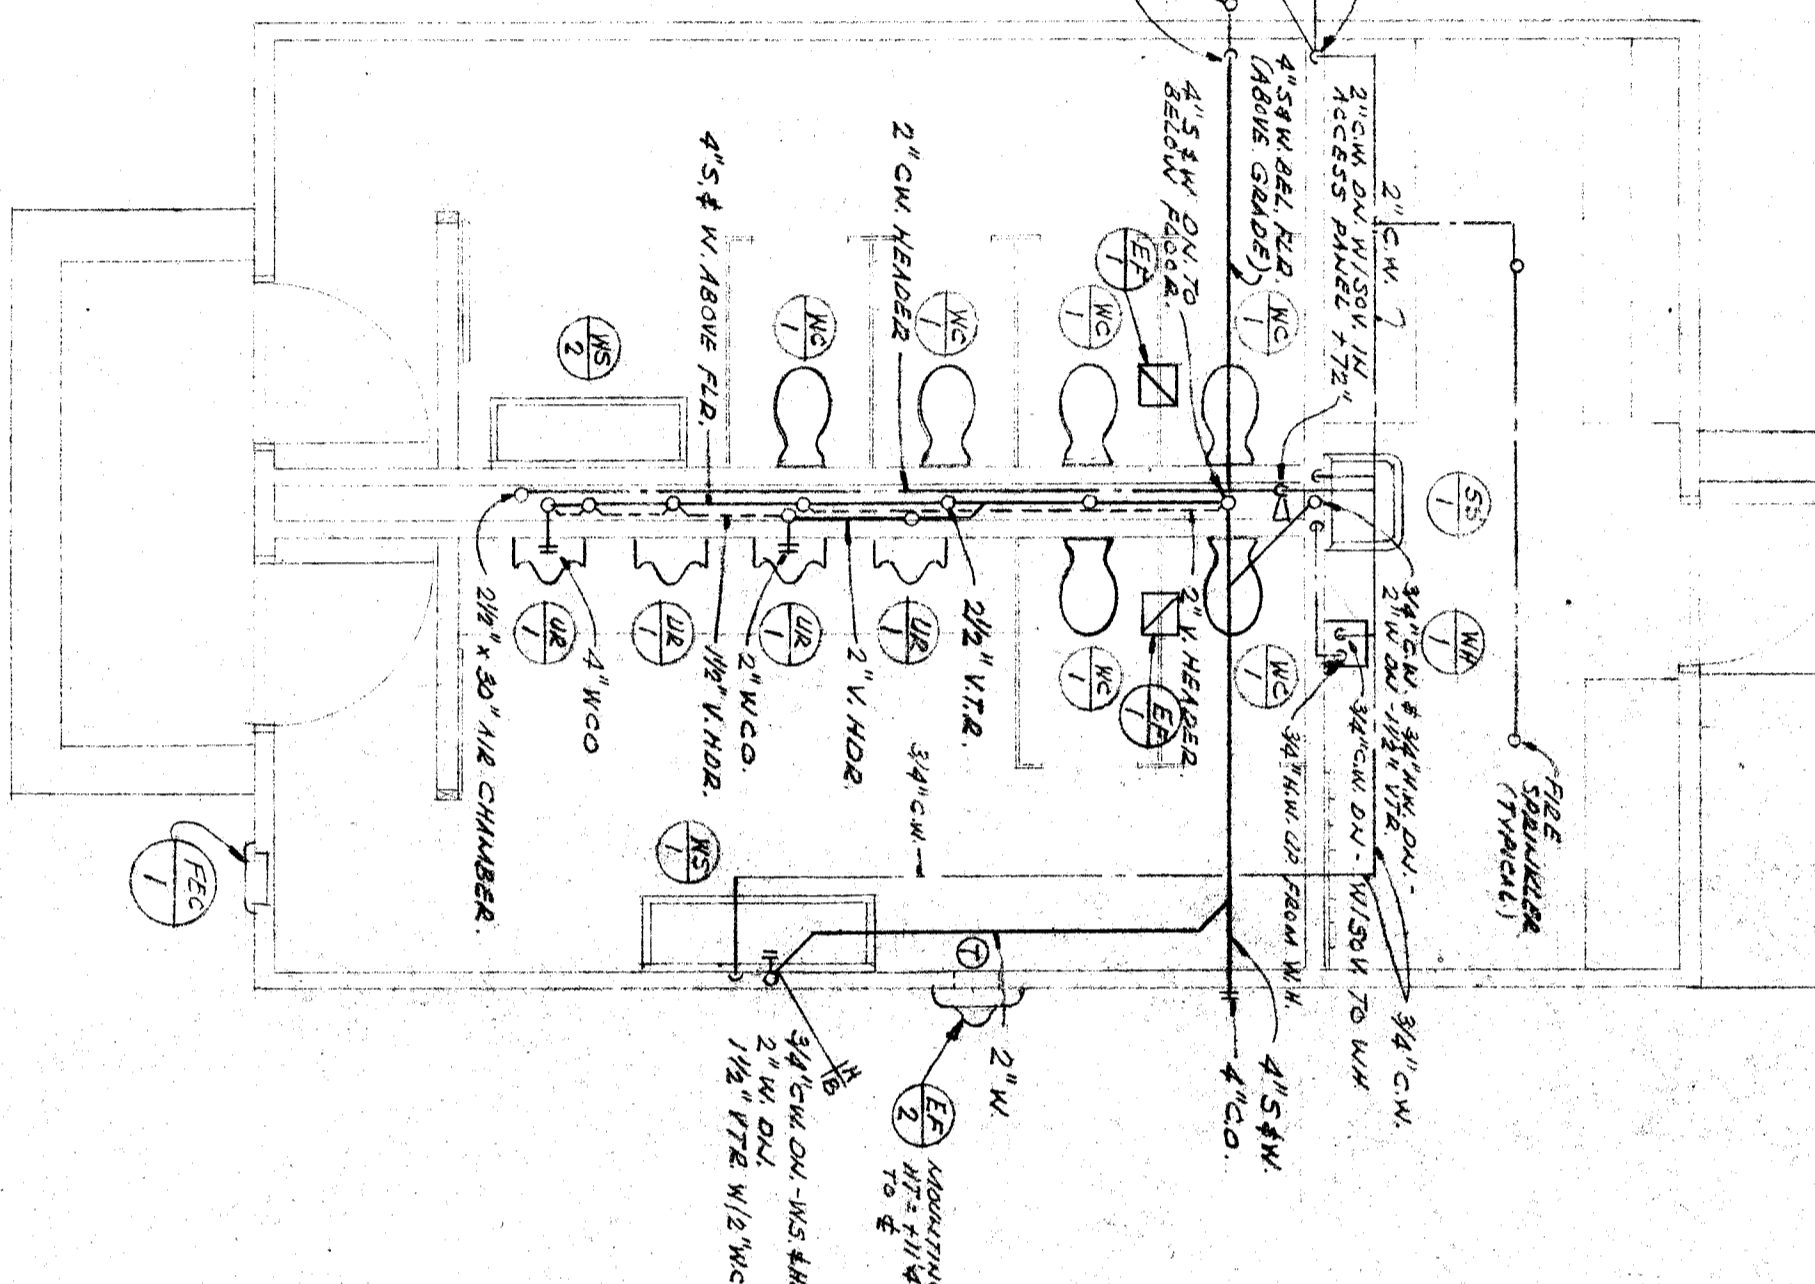

ELECTRICAL SYMBOLS

SYMBOL	DESCRIPTION
1	WATER CLOSET
2	WASH SINK
3	SERVICE SINK
4	WATER HEATER
5	HOSE BIBB
6	VENT STACK
7	EXHAUST FAN
8	DIFFUSER
9	REGISTER
10	DUCTWORK BOX
11	MECHANICAL VENT FAN
12	RECESS
13	FLOOR LIGHT
14	MOTOR WITH DISCONNECT SWITCH AND CHARGER (ALL W/1)
15	SWITCH
16	THREE WAY
17	STANDARD LIGHT FIXTURE
18	FLUORESCENT LIGHT FIXTURE
19	FLUORESCENT LIGHT FIXTURE
CODE RULES AND REGULATIONS:

ALL WORK AND MATERIALS SHALL BE IN FULL ACCORDANCE WITH THE LATEST RULES & REGULATIONS OF THE STATE FIRE MARSHAL. THE SHEET CHARGES OF THE DIVISION OF INDUSTRIAL SAFETY, WHO CHARGE AND CHARGE SINCE THE DIVISION OF INDUSTRIAL SAFETY IS TO BE CONSIDERED TO BE THE AUTHORITY FOR THE INTERPRETATION OF THESE RULES.



GENERAL NOTES:

1. ALL UTILITY SERVICES SHALL BE ACCORDING TO THE SERVING UTILITY COMPANY'S REQUIREMENTS.
2. VERIFY EXIST LOCATION OF ALL ELECTRICAL WIRING ON EQUIPMENT FURNISHED BY OTHERS WITH RESPECTIVE EQUIPMENT CONTRACTOR BEFORE STARTING WORK.
3. SEE MECHANICAL DRAWINGS FOR ALL CONTROL WIRING DIAGRAMS. THE ELECTRICAL CONTRACTOR SHALL BE RESPONSIBLE FOR ALL ELECTRICAL WIRING ON THE MECHANICAL CONTRACTOR SHALL BE RESPONSIBLE FOR EQUIPMENT WIRING ON ALL MECHANICAL EQUIPMENT.
4. SEPARATE SWITCHES AND STARTERS REQUIRED EXCEPT FOR SINGLE CIRCUIT BREAKERS AND FUSES. ALL ELECTRICAL WIRING SHALL BE IN ACCORDANCE WITH THE NATIONAL ELECTRICAL CODE AS AMENDED BY THE NATIONAL ELECTRICAL CODE. THE MECHANICAL CONTRACTOR SHALL BE RESPONSIBLE FOR THE MECHANICAL CONTRACTOR.
5. ALL PLUMBING SHALL BE IN ACCORDANCE WITH THE NATIONAL PLUMBING CODE AS AMENDED BY THE NATIONAL PLUMBING CODE.
6. PLUMBING CONTRACTOR SHALL BE RESPONSIBLE FOR ALL PLUMBING WORK AS SHOWN ON THESE DRAWINGS.
7. STUD UP CONDUIT FROM ALL PLUMBING FIXTURES TO ACCESSIBLE ATTIC SPACE.
8. THE WORD 'ACCORDING' ON THESE DRAWINGS AND SPECIFICATIONS REFERS ONLY TO 100% VISUAL CHECK. NO MIXTURE OF ANY OTHER MATERIALS WILL BE ACCEPTED. THE ELECTRICAL CONTRACTOR SHALL BE RESPONSIBLE FOR ALL ELECTRICAL WIRING ON THE MECHANICAL CONTRACTOR SHALL BE RESPONSIBLE FOR EQUIPMENT WIRING ON ALL MECHANICAL EQUIPMENT.
9. ALL WIRING IN PLUMBING SHALL HAVE PLUMBING CONTRACTOR'S SIGNATURE AND APPROVAL ON ALL PLUMBING CONTRACTOR'S DRAWINGS.
10. INSTANT LOCATIONS ON VENTOR FEELS.
11. THE ELECTRICAL CONTRACTOR SHALL SECURE ALL PERMITS AND PAY ALL FEES AND INCREASES UNDER THE N.E.C. & A.P.C.

FIXTURE SCHEDULE

MARK	FIXTURE	QTY	SIZE	VOL	CM	HW	MANUFACTURER & CATALOG NO.
CS	CLUSTER	2	1 1/2"	1/4"	1/4"	1/4"	TRU-TEMP & SET BY OTHER TRADES GIVEN BY PLUMBER, FURNISH BY L.K. SPEC 1 1/2" LA CP 1754P
WC	WATER CLOSET	4	-	2	1/2"	1/2"	"LA STD" FLUSH NEW APRIL SIGHT BOWL 1/2" V.G. SWIRL 100 SERIES HOLE AND SHAFT SCHEDULE 40S E WICKER-BROS CONTROL VALVE STAIN BOWL 186-11
UB	URINAL	2	-	1/2"	1/4"	1/4"	"LA STD" FLUSH NEW APRIL SIGHT BOWL 1/2" V.G. SWIRL 100 SERIES HOLE AND SHAFT SCHEDULE 40S E WICKER-BROS CONTROL VALVE STAIN BOWL 186-11
WS	WASH SINK	2	1 1/2"	1/4"	1/4"	1/4"	"LA STD" FLUSH NEW APRIL SIGHT BOWL 1/2" V.G. SWIRL 100 SERIES HOLE AND SHAFT SCHEDULE 40S E WICKER-BROS CONTROL VALVE STAIN BOWL 186-11
WS	WASH SINK	2	1 1/2"	1/4"	1/4"	1/4"	SMILE AS WS/1 DISCET 450 LENS TWO PROTECTORS 1/2" V.G. SWIRL 100 SERIES HOLE AND SHAFT SCHEDULE 40S E WICKER-BROS CONTROL VALVE STAIN BOWL 186-11
SS	SERVICE SINK	2	2	1 1/2"	1/4"	1/4"	"LA STD" FLUSH NEW APRIL SIGHT BOWL 1/2" V.G. SWIRL 100 SERIES HOLE AND SHAFT SCHEDULE 40S E WICKER-BROS CONTROL VALVE STAIN BOWL 186-11
WV	WATER HEATER	1	30"	1/2"	1/4"	1/4"	"LONGRUNNING" 80-G (G GAL) 1000 W 115 V WASHIE P & T VALVE, WALL MOUNTED
HOSE	HOSE BIBB	1	3/4"	1/2"	1/4"	1/4"	K-COBAL "DISC 2"
FC	FILE EXT CYL	1	1/4"	1/2"	1/4"	1/4"	"STANDARD" 102 AT WA-11-212 OIL SEAL AND EXT

**LIGHTING-POWER & SIGNAL FLOOR PLAN, SCALE 1/4\"/>
 PORTABLE TOILETS-JUNIOR BUILDING**

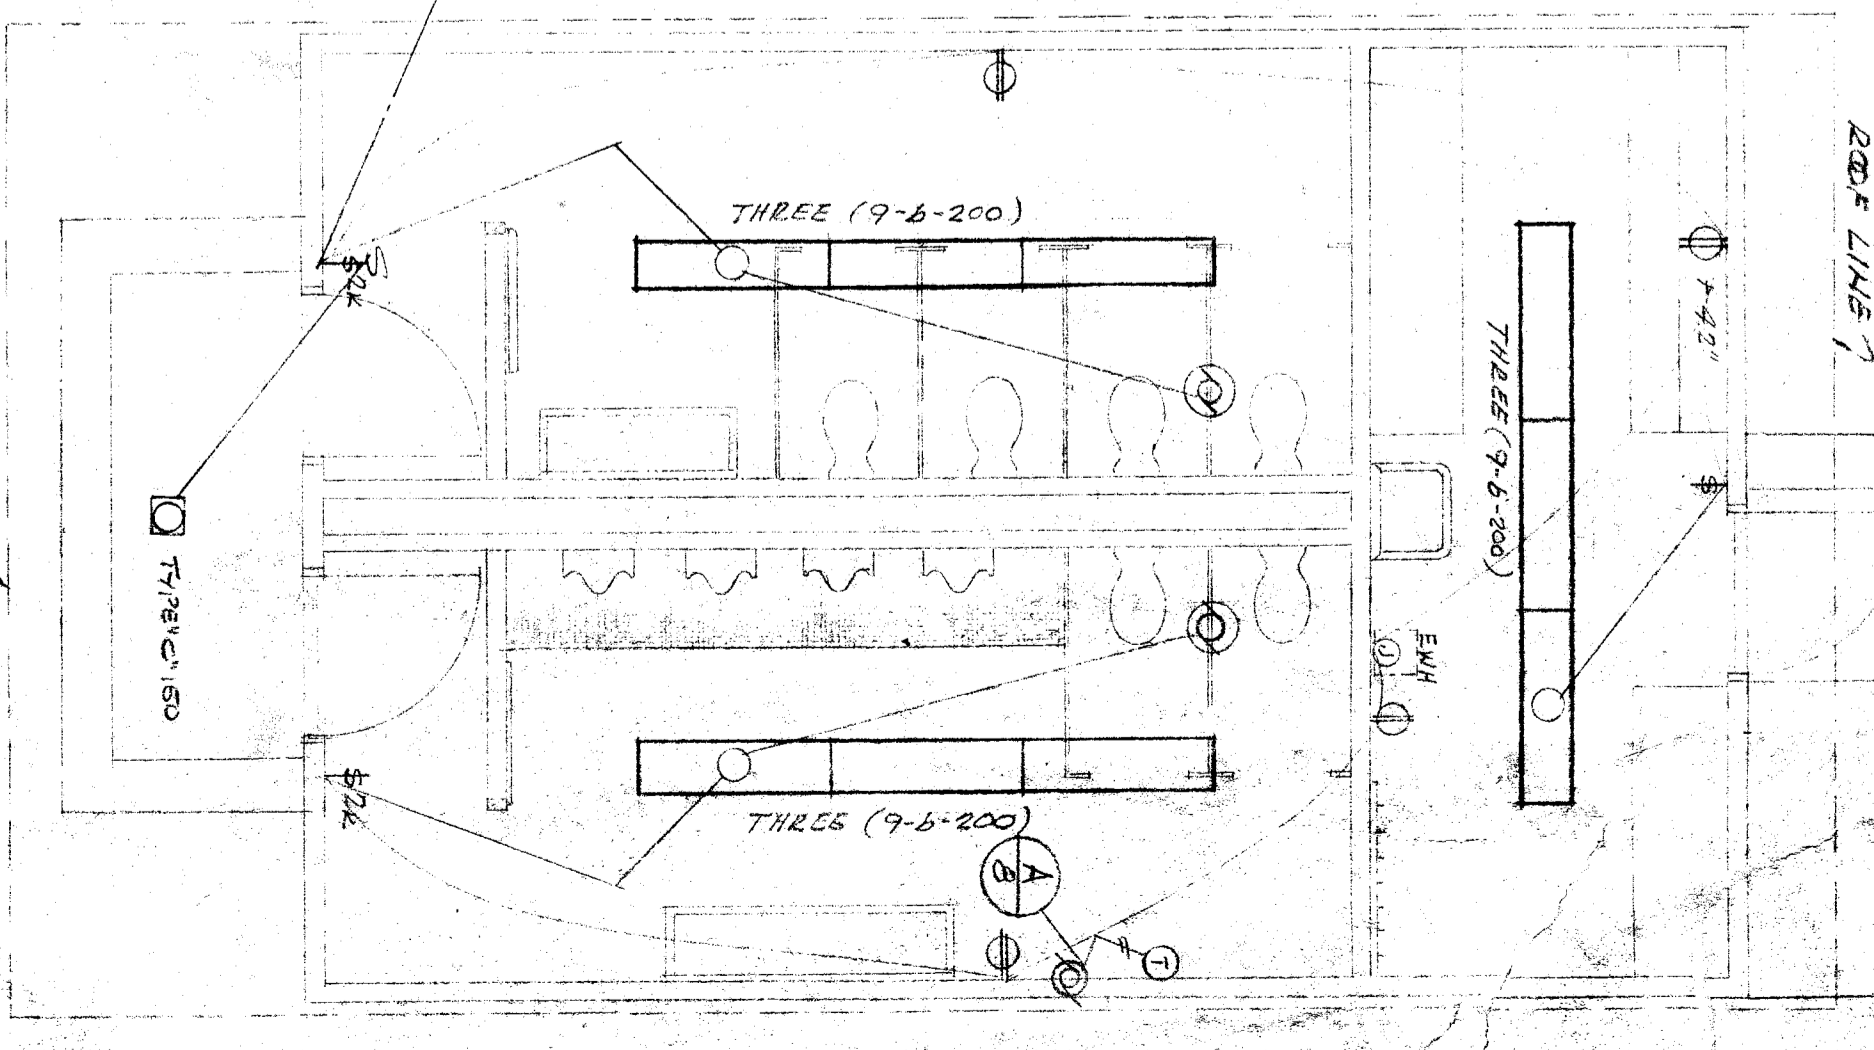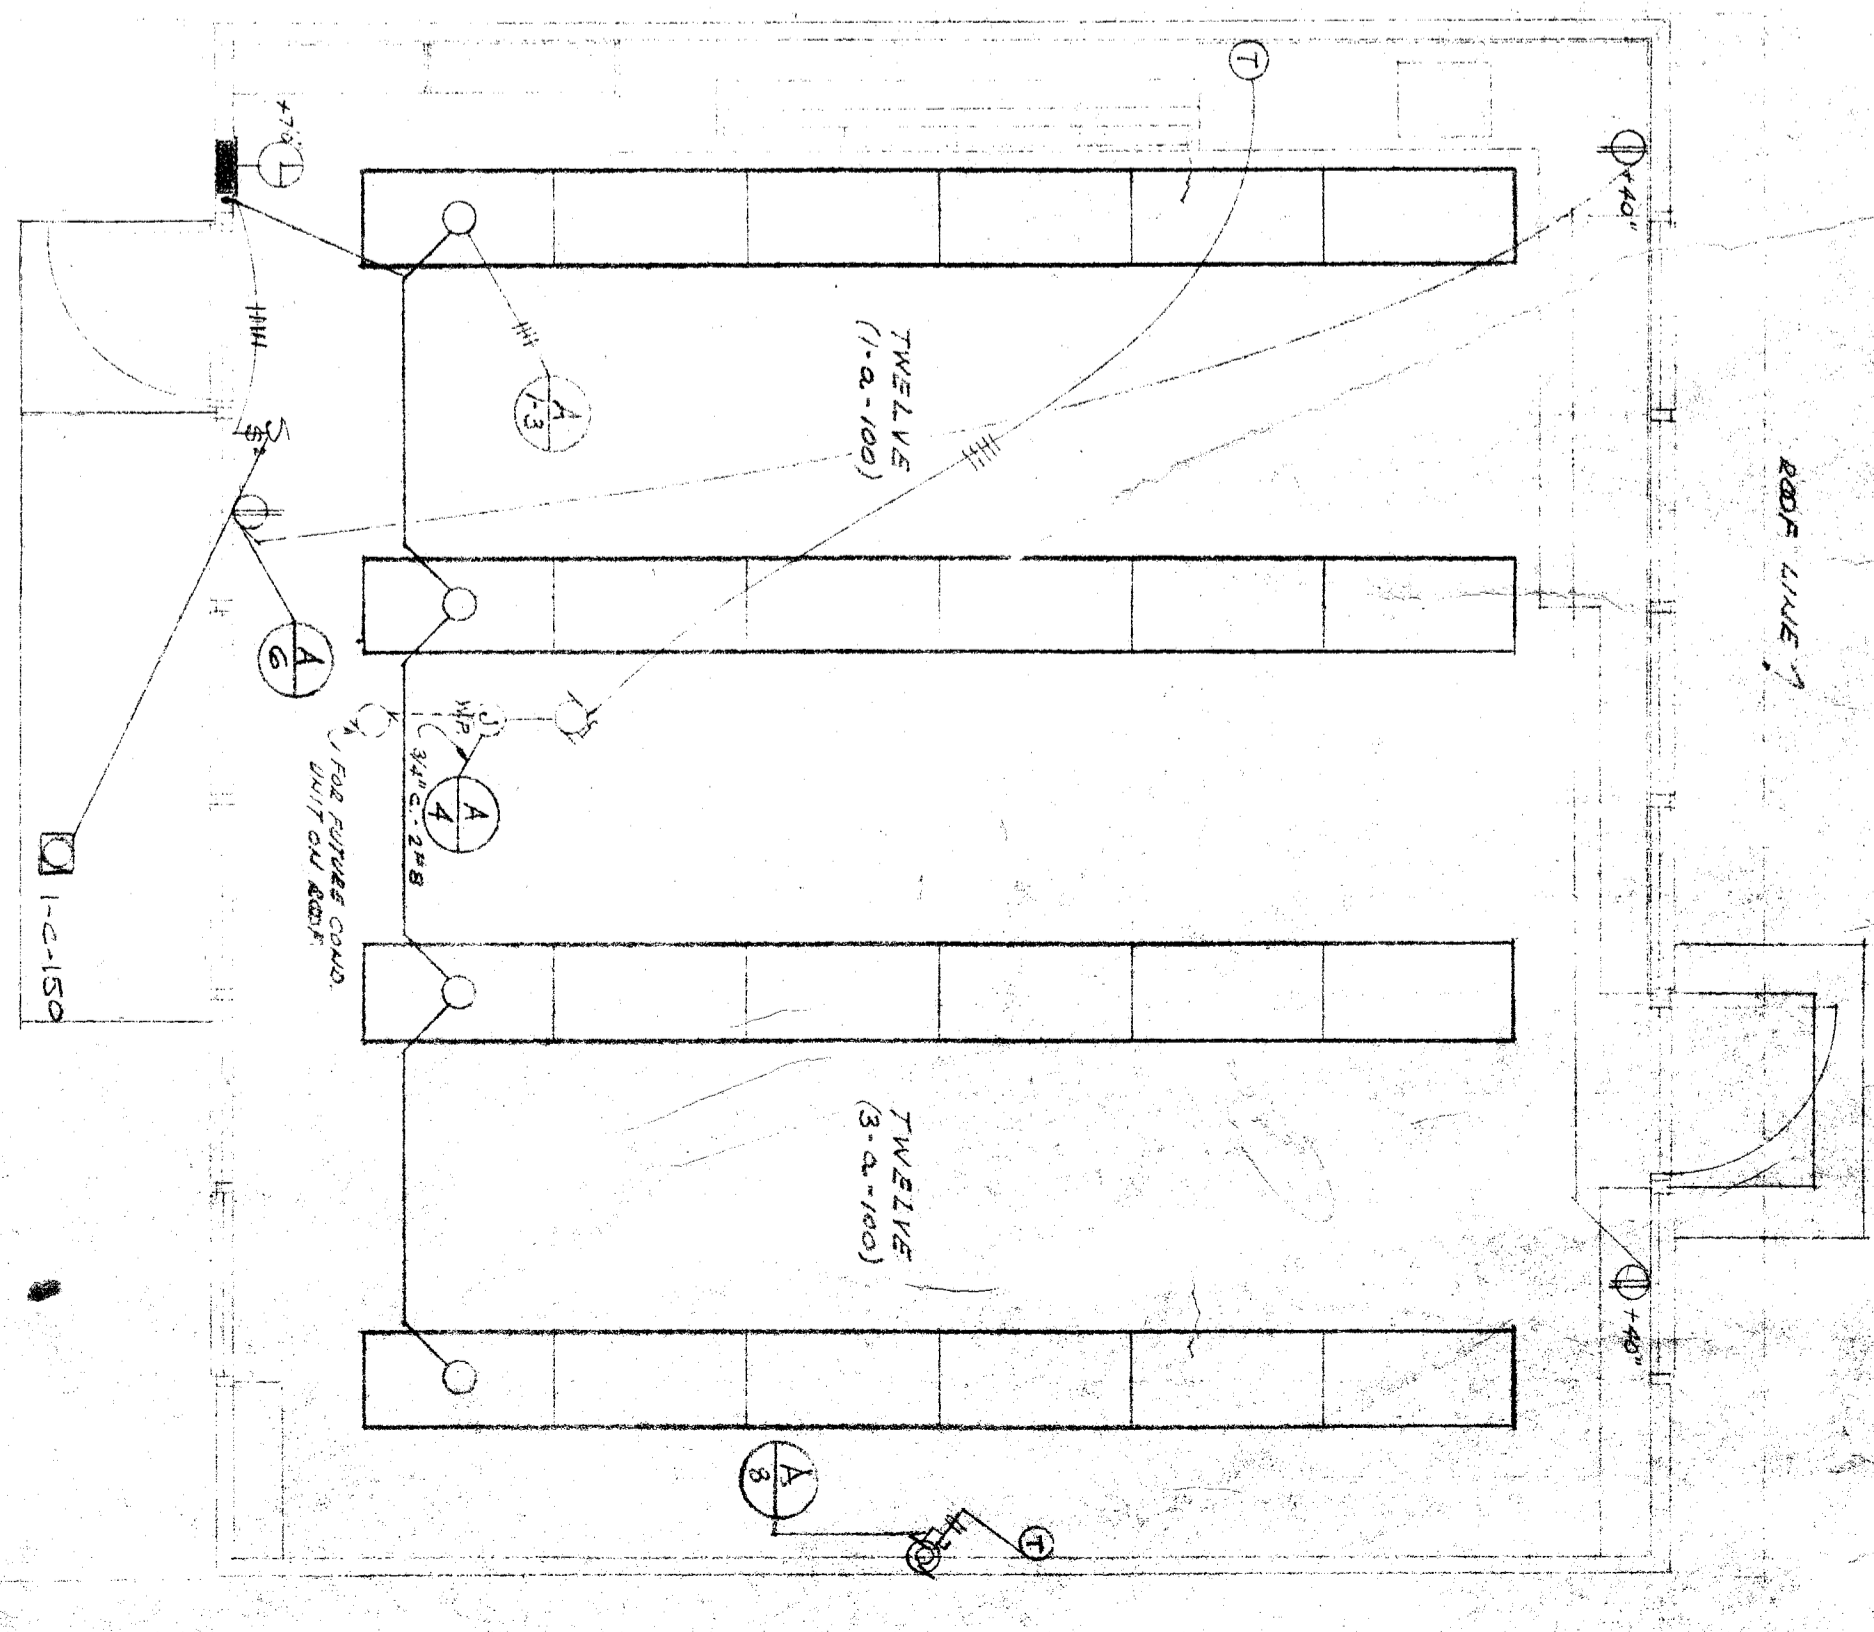

**LIGHTING-POWER & SIGNAL PLAN, SCALE 1/4\"/>
 PORTABLE TOILETS-JUNIOR BUILDING**

BARRETSFIELD CITY SCHOOL DISTRICT
 BOARD OF EDUCATORS
 JOB NO. 0755
 ROBERT F. STUHR
 ARCHITECT

MOHAWK VENTNOX SCHOOL
 LIGHT POWER SIGNAL FLOOR PLANS SCHEDULES
 PLUMBING-FIXTURE PLAN SCHEDULES
 PORTABLE TOILETS-JUNIOR BUILDING
 PORTABLE TOILETS-JUNIOR BUILDING
 PORTABLE TOILETS-JUNIOR BUILDING

ME
 ARCHITECT
 1212 CALIFORNIA AVE
 ST. LOUIS, MISSOURI 63102
 PHONE 527-1833