




NORTH ELEVATION

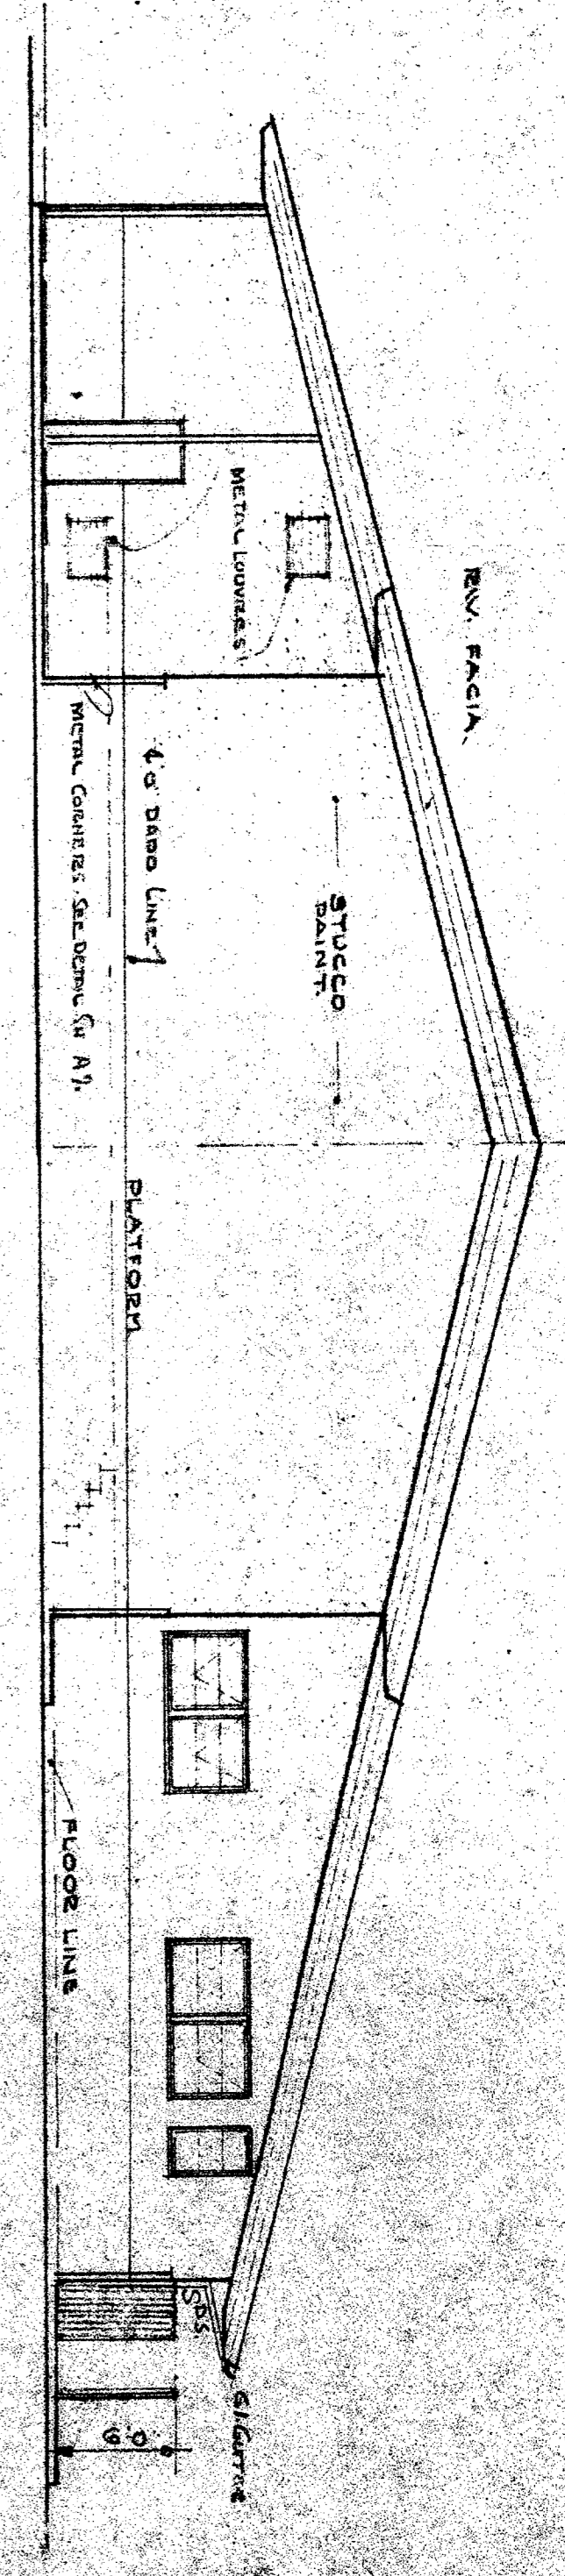

EAST ELEVATION

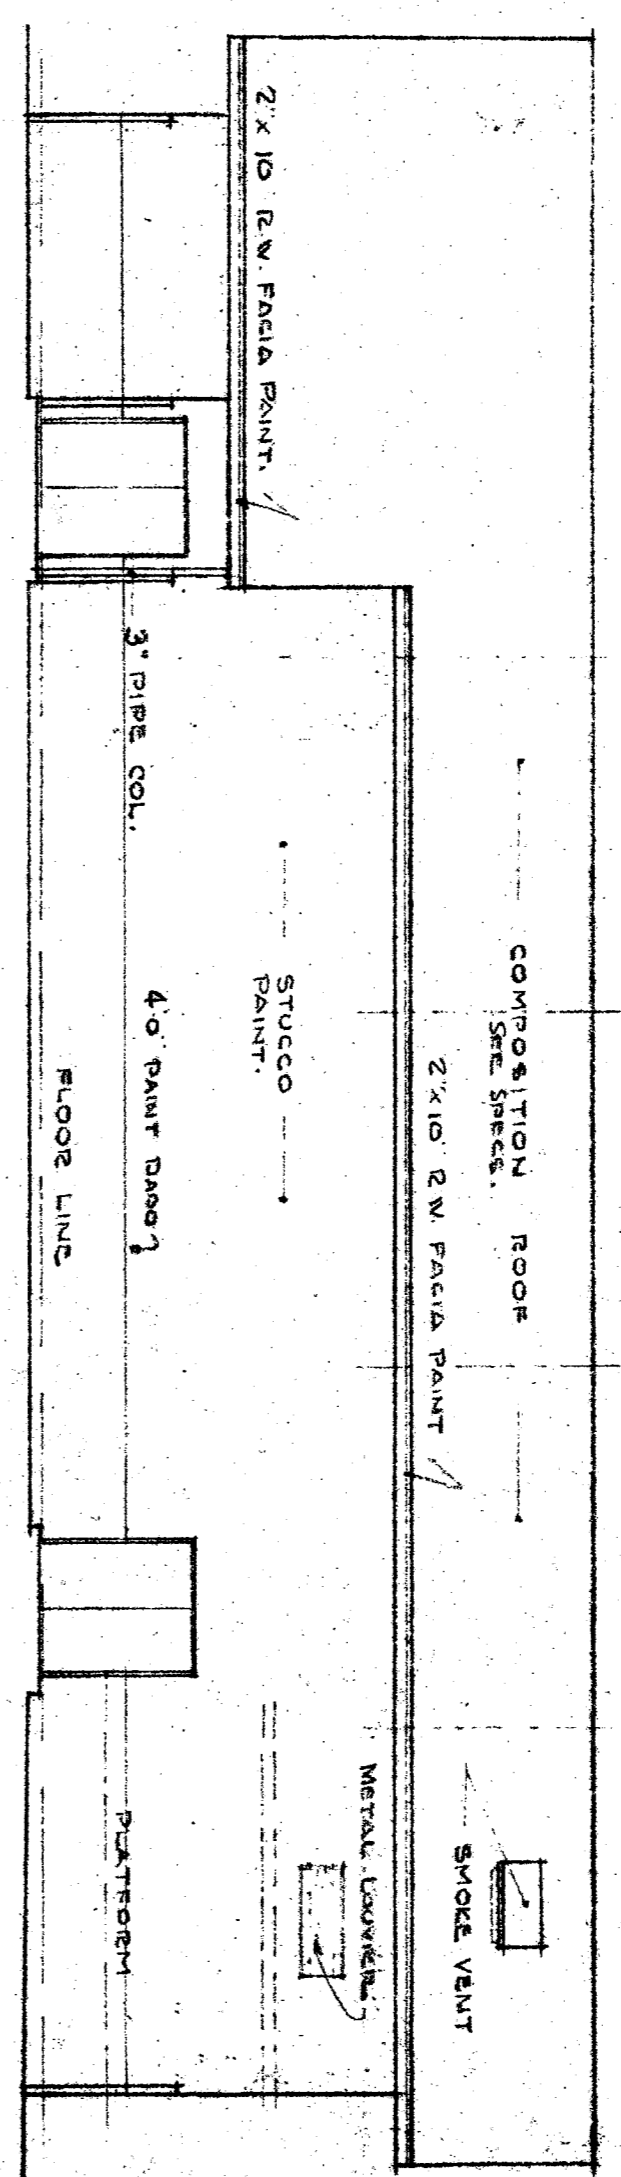


SOUTH ELEVATION

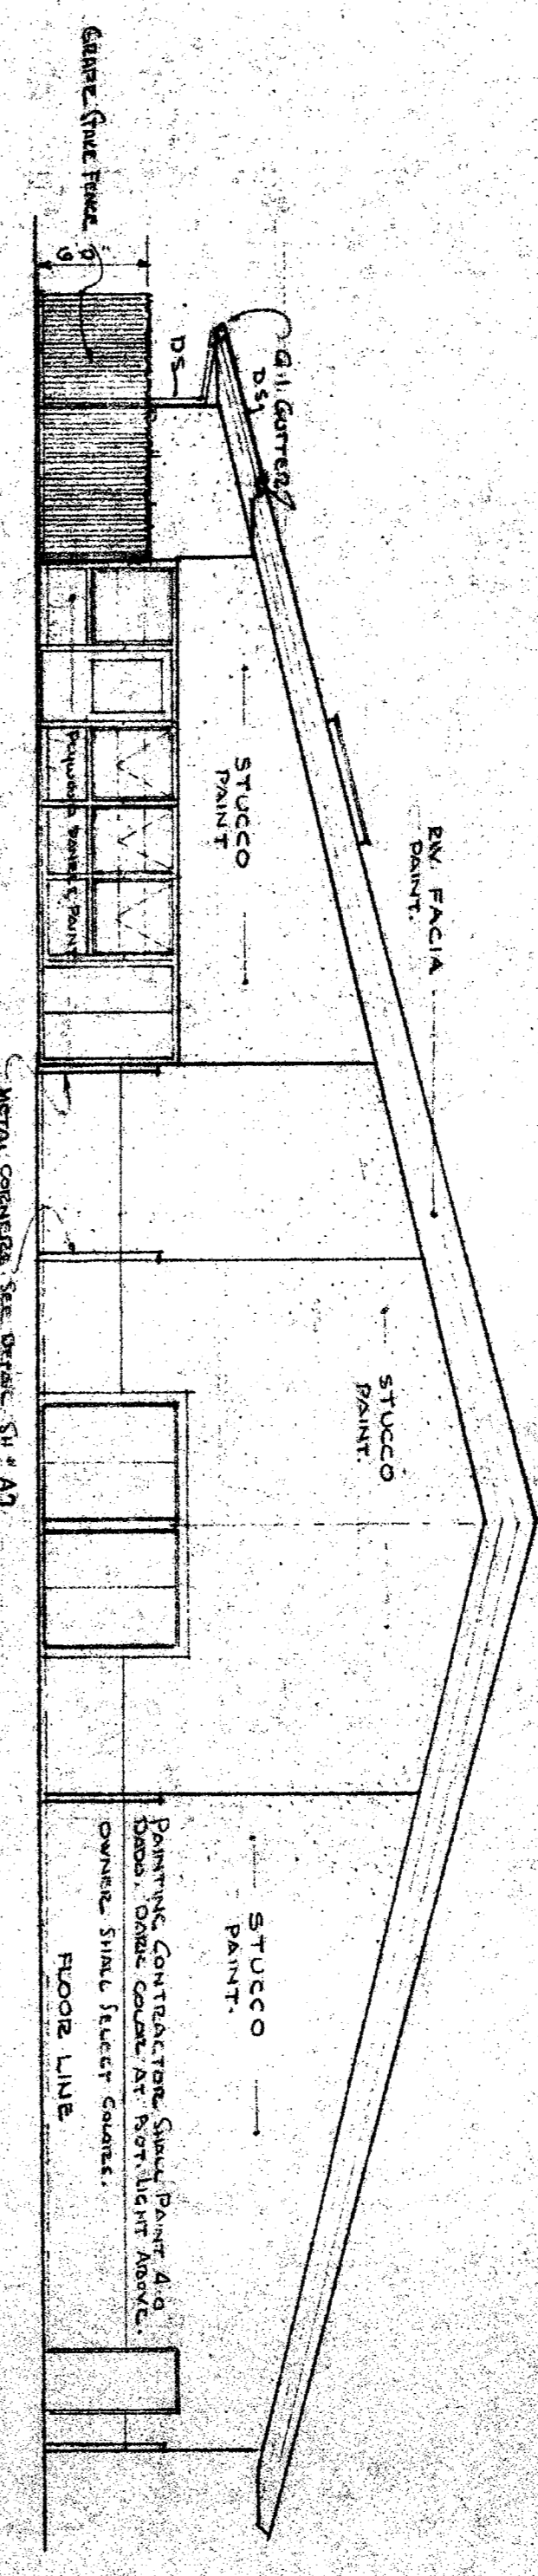


WEST ELEVATION

TYP. EAVE DETAIL

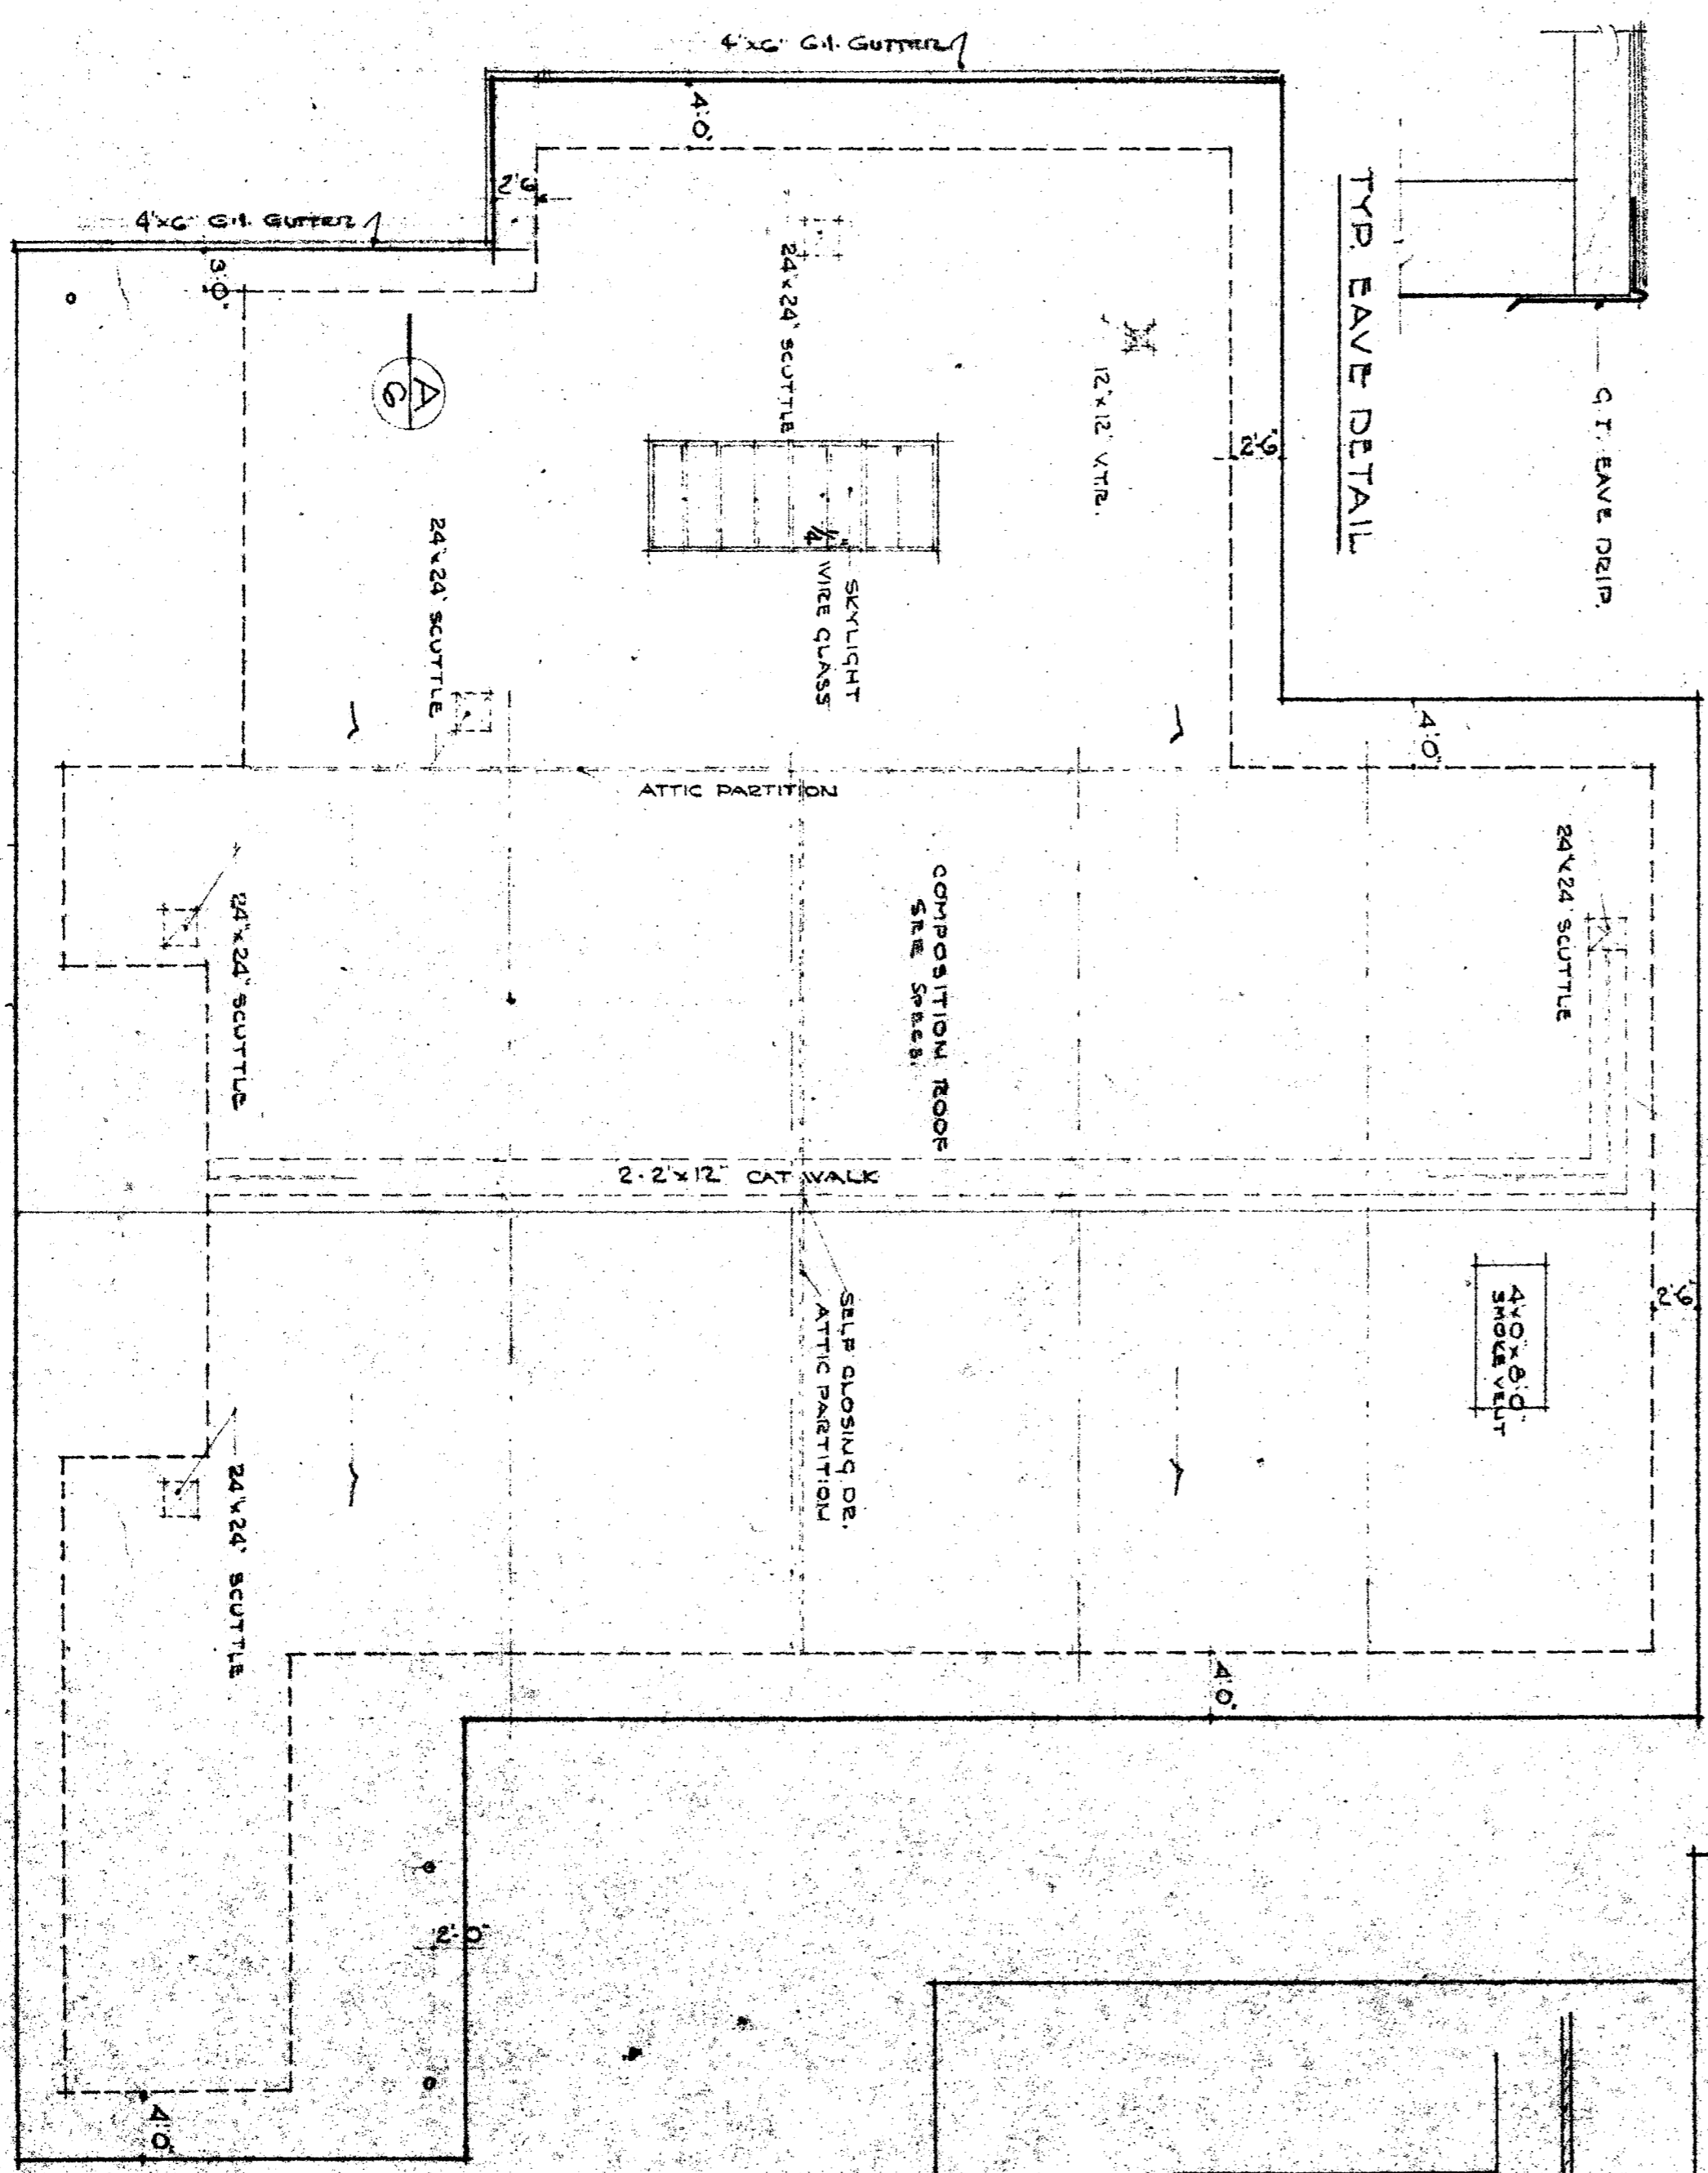


ROOF PLAN
SCALE 1/8"


CABLE CORNICE
SCALE 1/2"

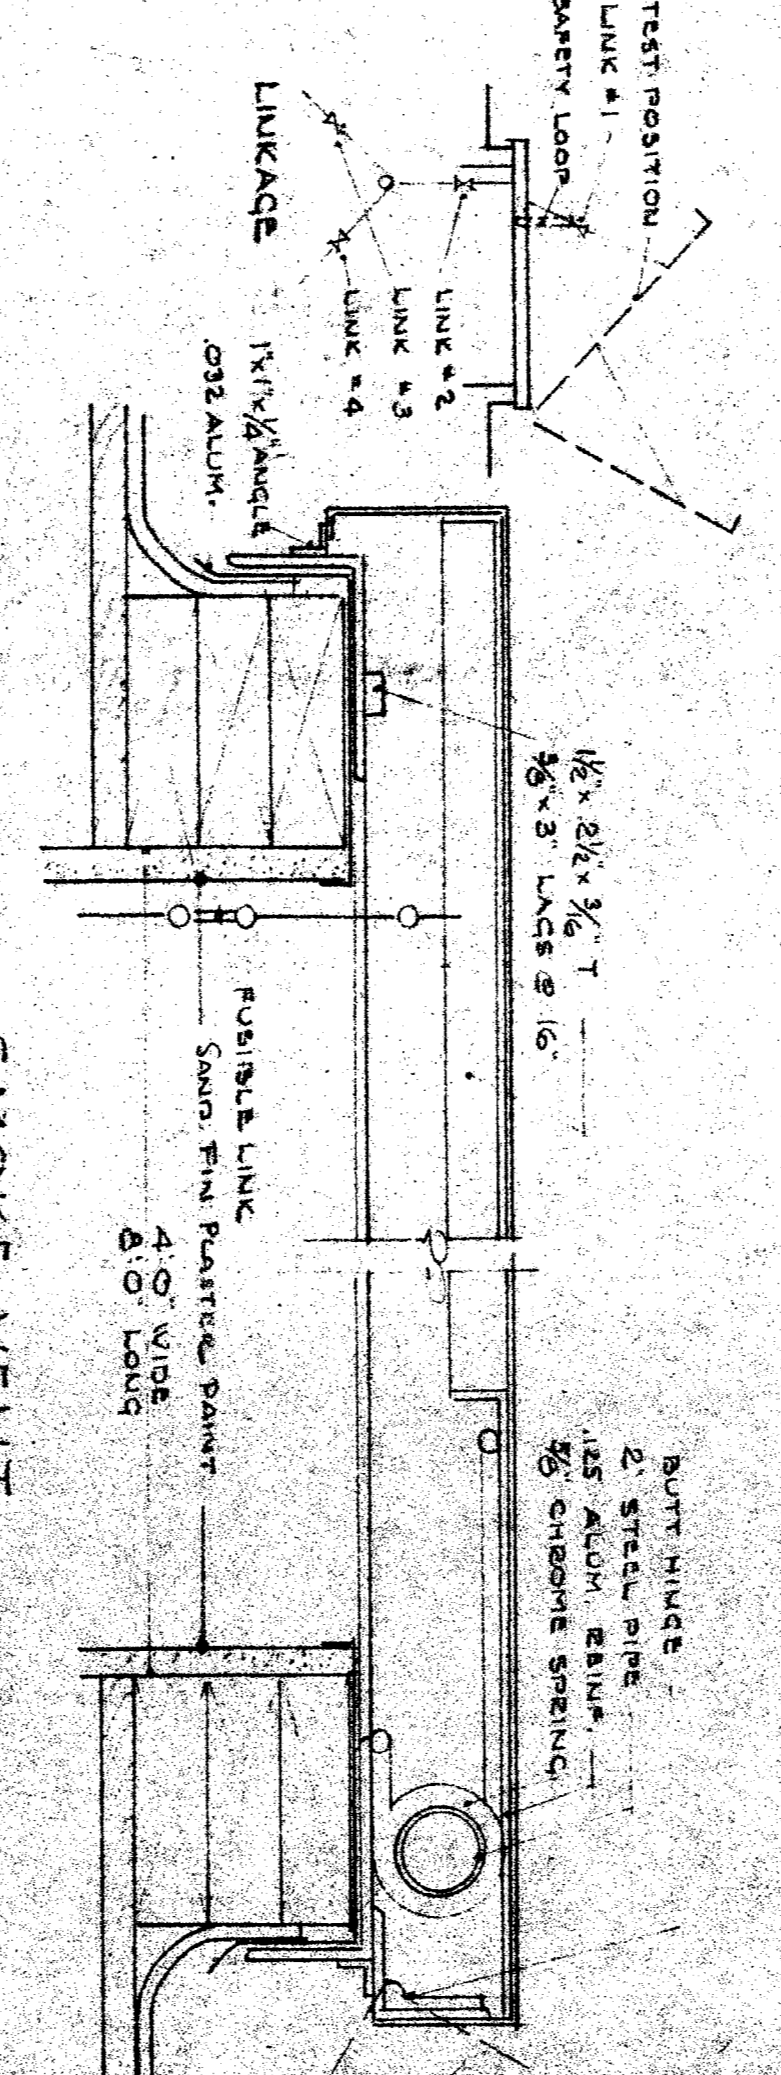


SMOKE VENT
SCALE 3/16"

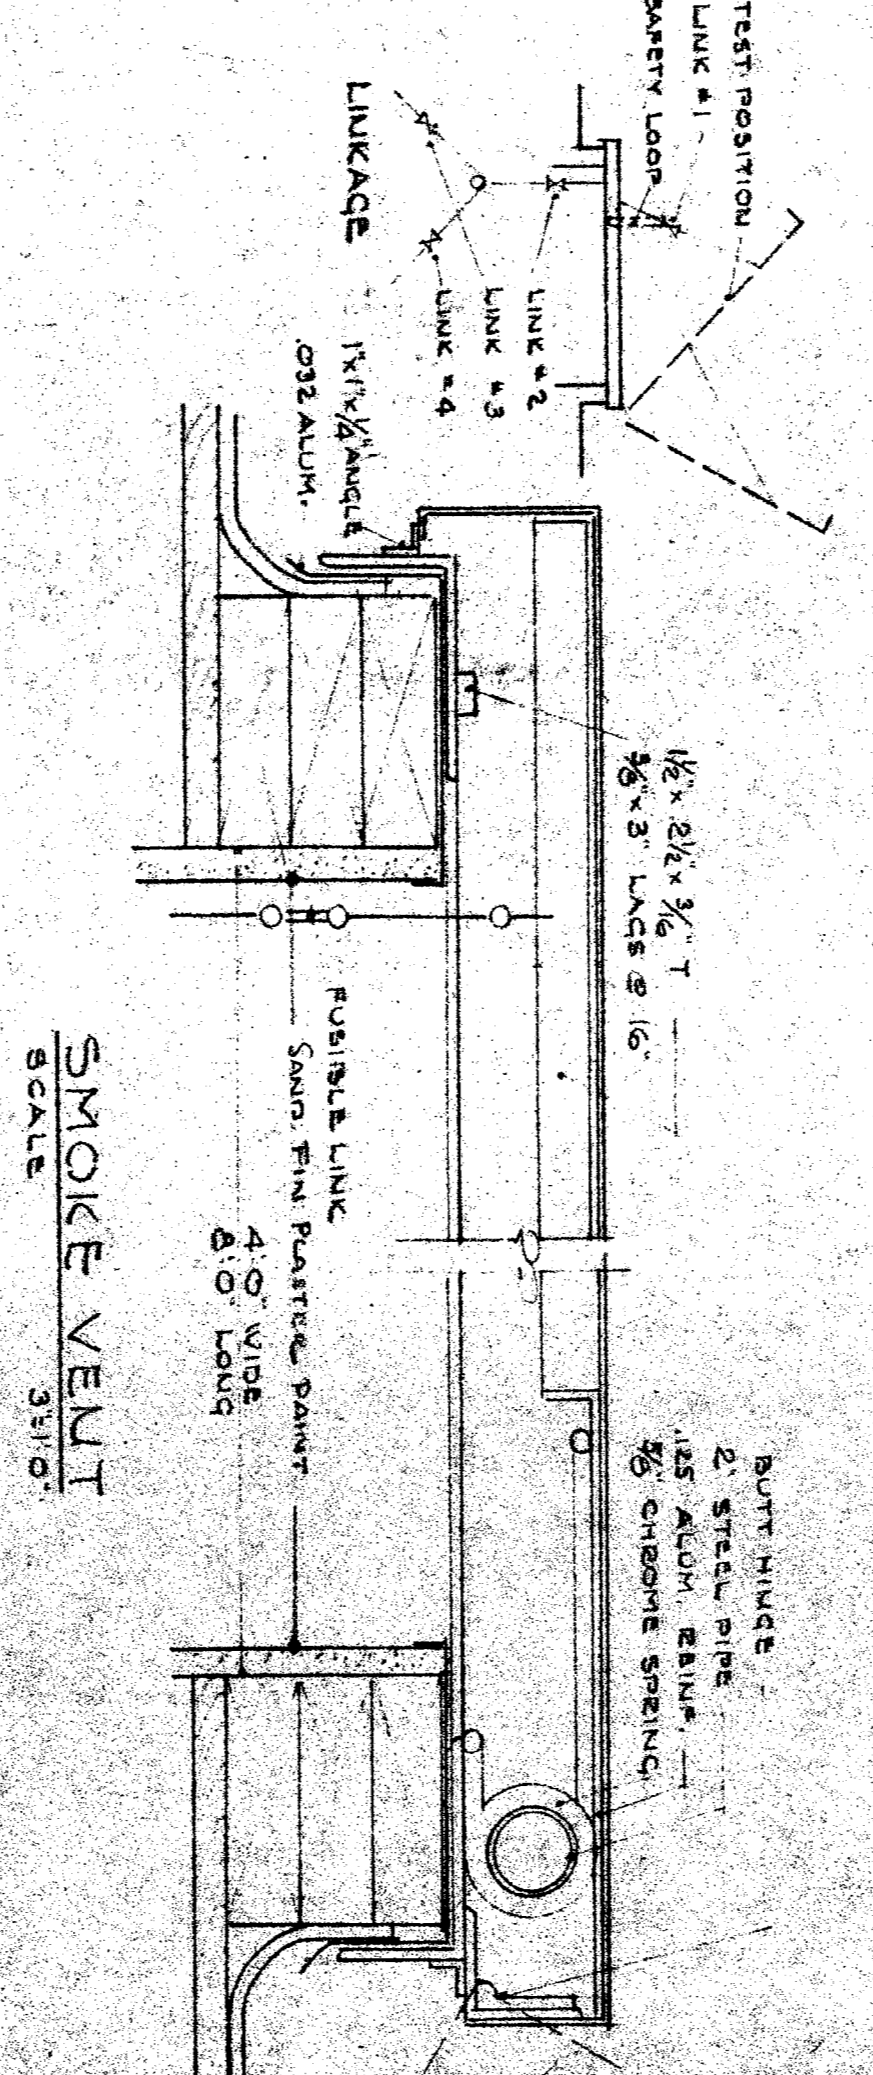


SCUTTLE & LADDER
SCALE 1/2"

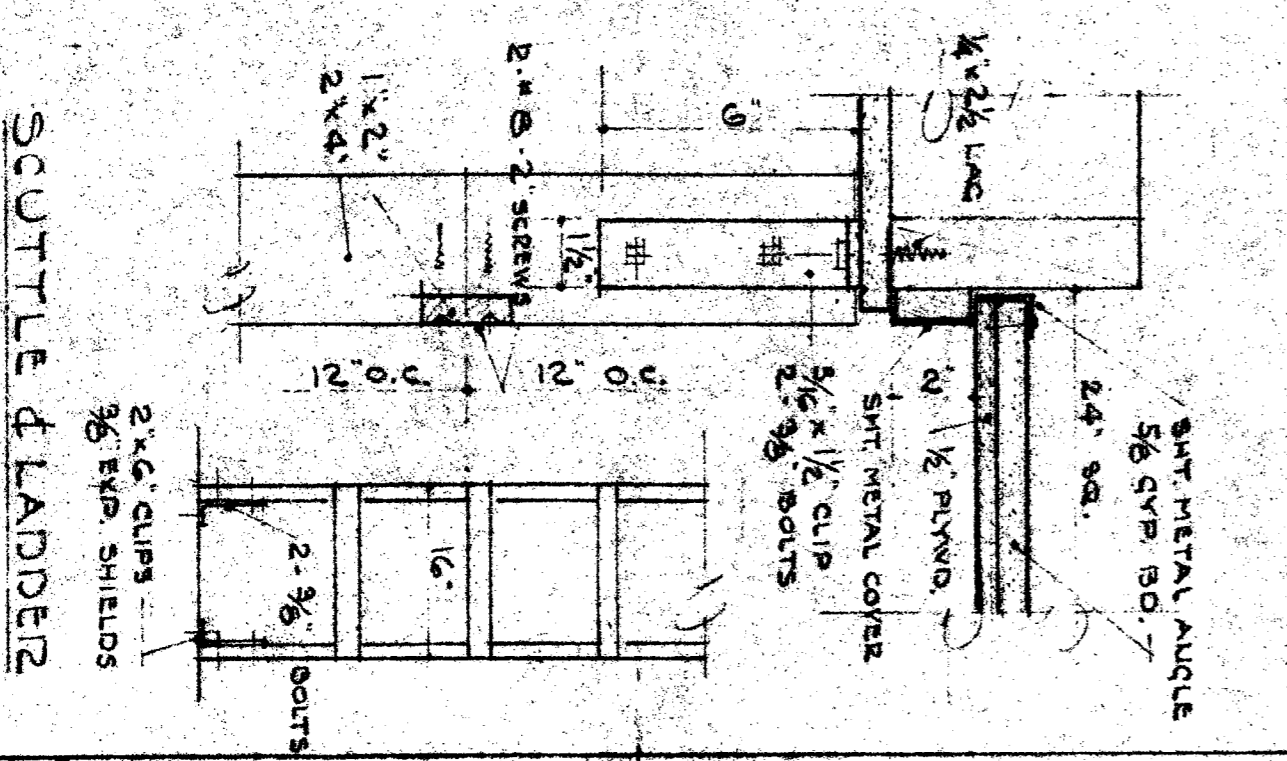

ROOF VENTS
SCALE 1/2"

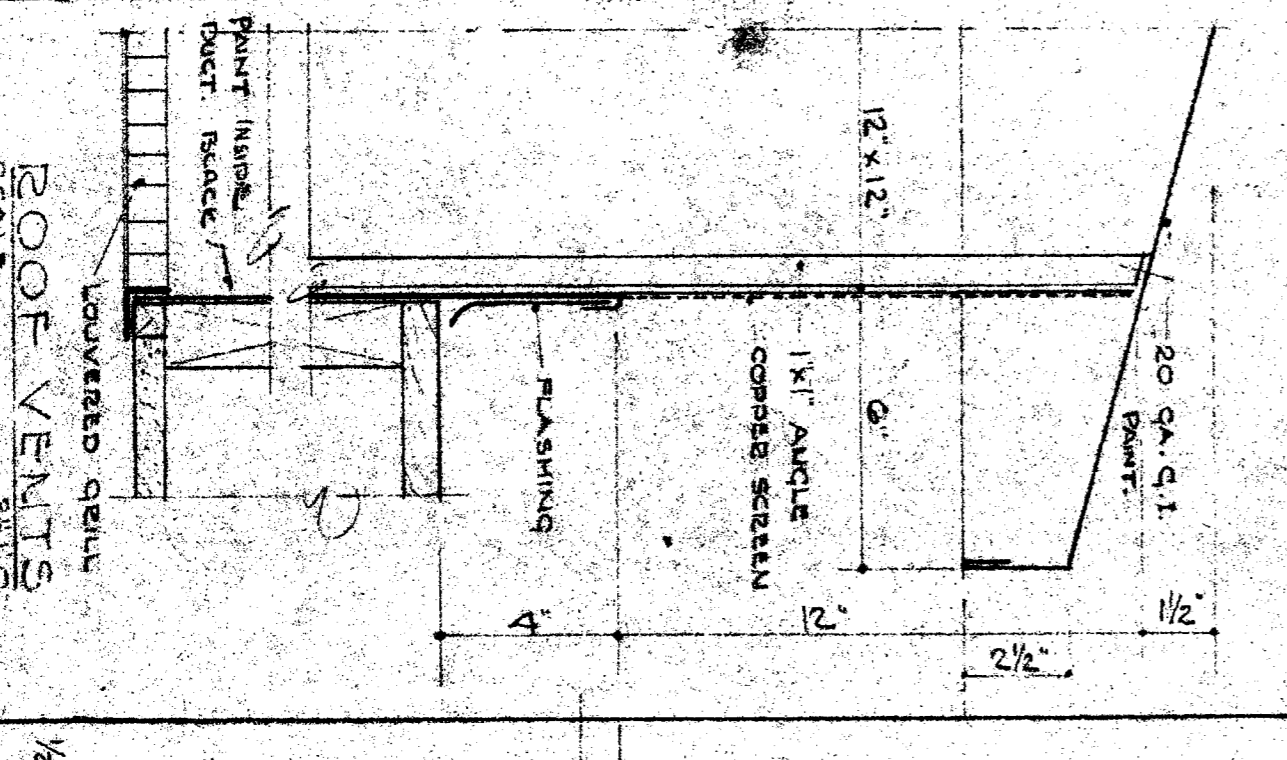

SELF CLOSING DR.
SCALE 3/16"

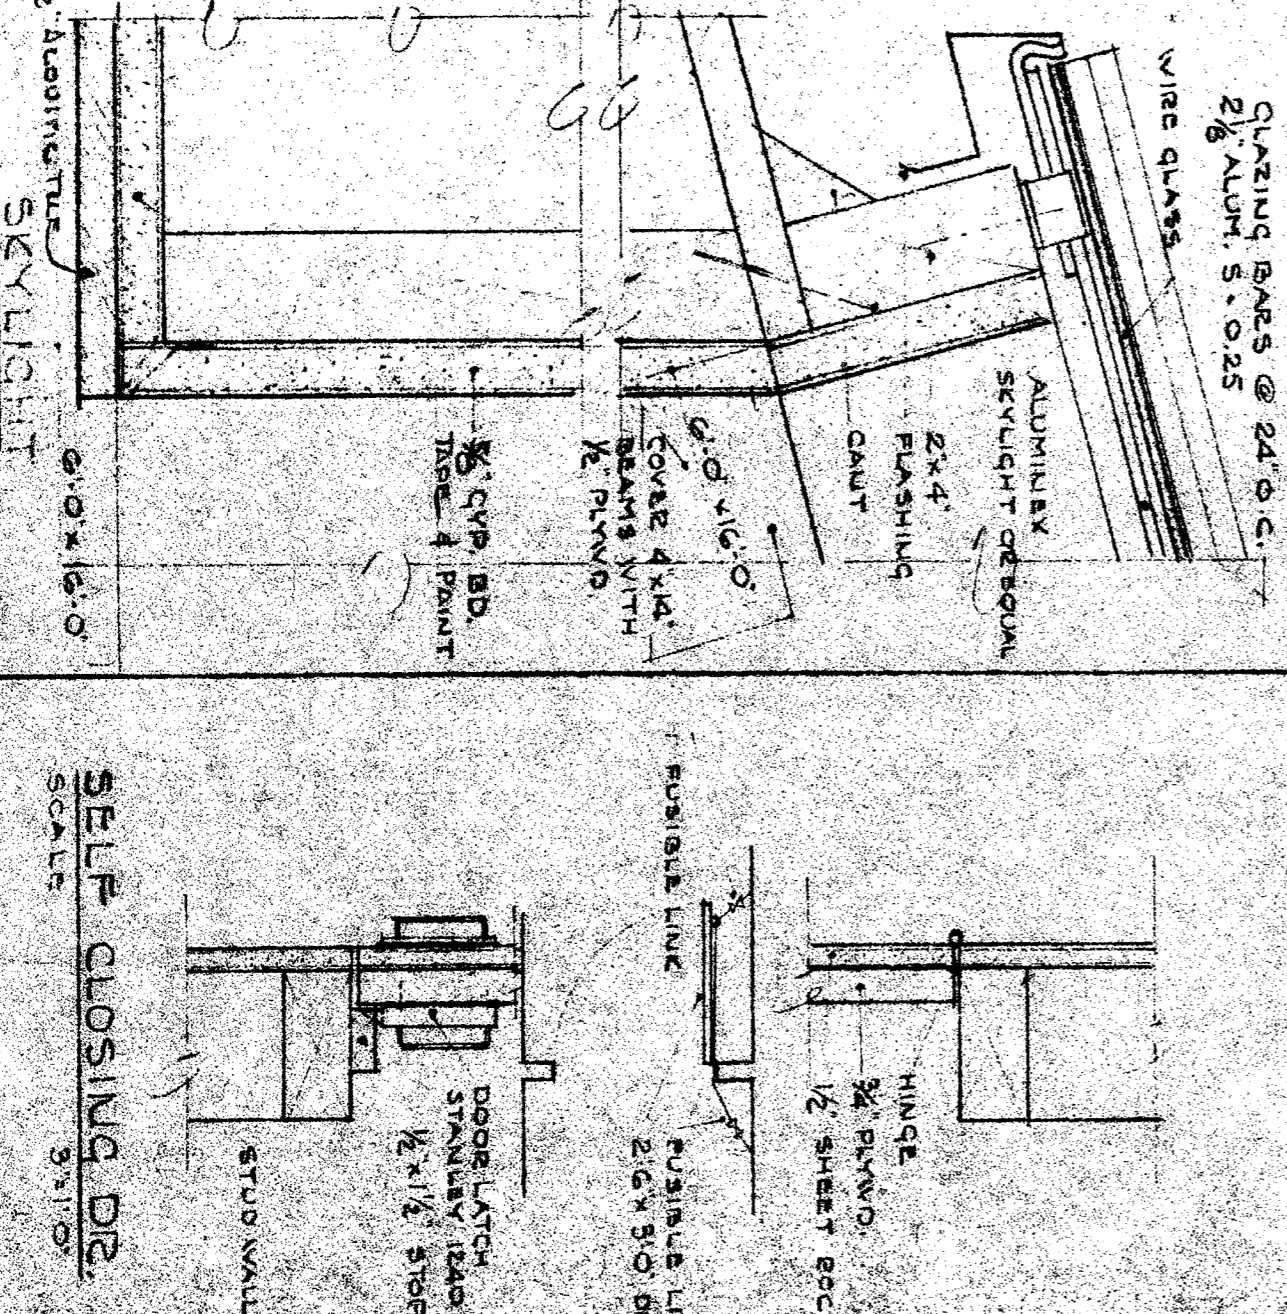

APPROVED BY:
ROBERT C. BARTON
BARTON ALFORD ARCHITECTS
DATE: 10-17-57
BY: R. C. Barton
SUPERVISOR OF SCHOOL DISTRICT

DATE OF ORIGINAL: 10-17-57
DATE OF REVISION: SEP 5 1958
BY: R. C. Barton
SUPERVISOR OF SCHOOL DISTRICT

EXTERIOR ELEVATIONS:
MULTI PURPOSE ROOM,
MT. VERNON SCHOOL,
DAVERSFIELD CITY SCHOOL DISTRICT.

c. barton alford
A R C H I T E C T S
1516 CALIFORNIA AVENUE
DAVERSFIELD, CALIFORNIA

AIA
23