

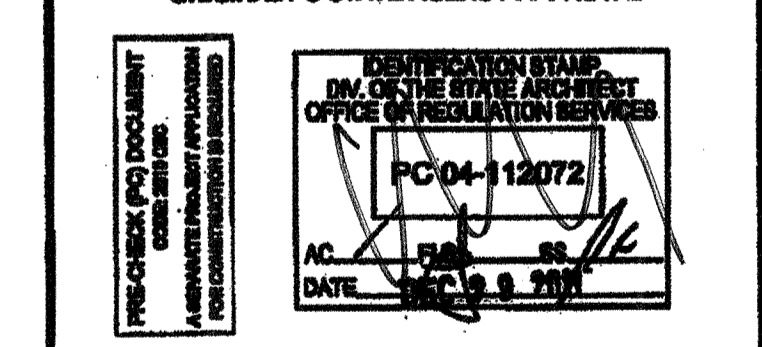


THESE DRAWINGS AND ALL MATERIAL CONTAINED HEREIN ARE THE PROPERTY OF SILVERCREEK INDUSTRIES, INC. (SCI INC) AND SHALL NOT BE REPRODUCED, COPIED OR OTHERWISE DISPOSED OF DIRECTLY OR INDIRECTLY AND SHALL NOT BE USED IN WHOLE OR IN PART TO ASSIST IN THE MAKING OF OR FOR THE PURPOSES OF FURNISHING ANY INFORMATION FOR THE MAKING OF DRAWINGS, PRINTS, APPARATUS OR PARTS THEREOF WITHOUT THE FULL KNOWLEDGE AND WRITTEN CONSENT OF SCI INC. ALL PATENTABLE MATERIAL CONTAINED HEREIN AND ORIGINATING WITH SCI INC SHALL BE THE PROPERTY OF SCI INC.

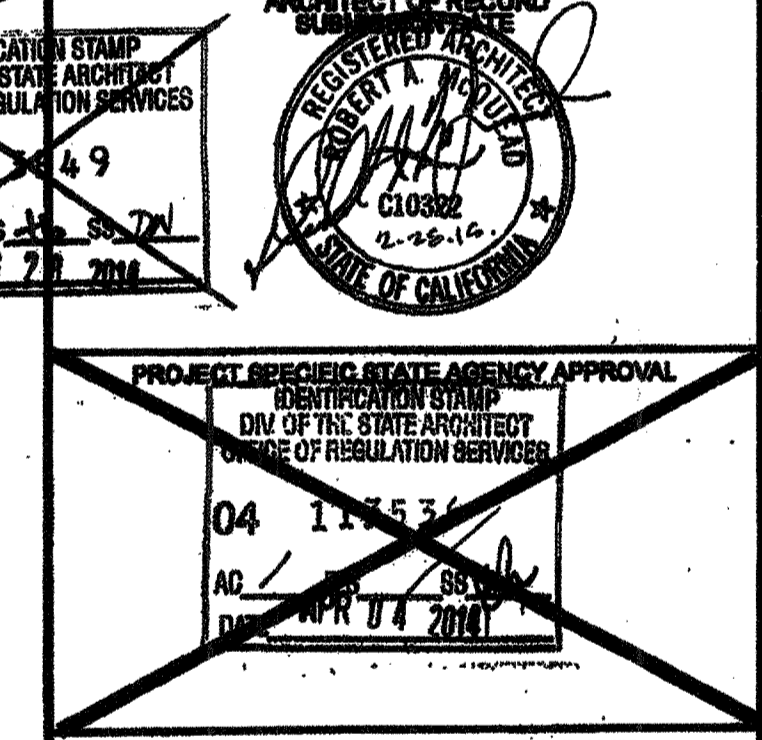

PROJECT NAME:  
**CLASS LEASING CLASSROOM BLDG'S**

SHEET TITLE:  
**CROSS SECTION MONO SLOPE 0.018" OR BUILT-UP ROOF DECK OR PARAPET**

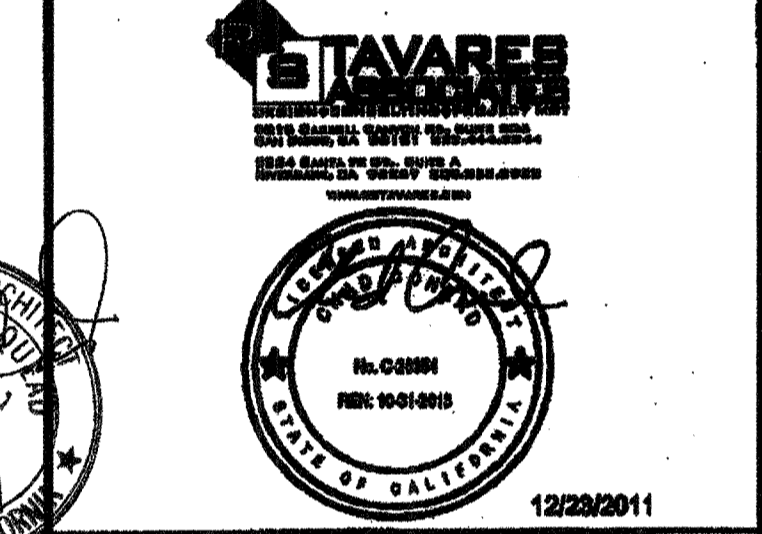


REVISIONS	

SILVER CREEK INDUSTRIES  
24' x 40' PC

PROJECT NO:  
DRAWN BY:  
SCALE: AS NOTED  
DATE: 12-22-11

P.C. SHEET NUMBER  
**A-5.01**

STKP 140

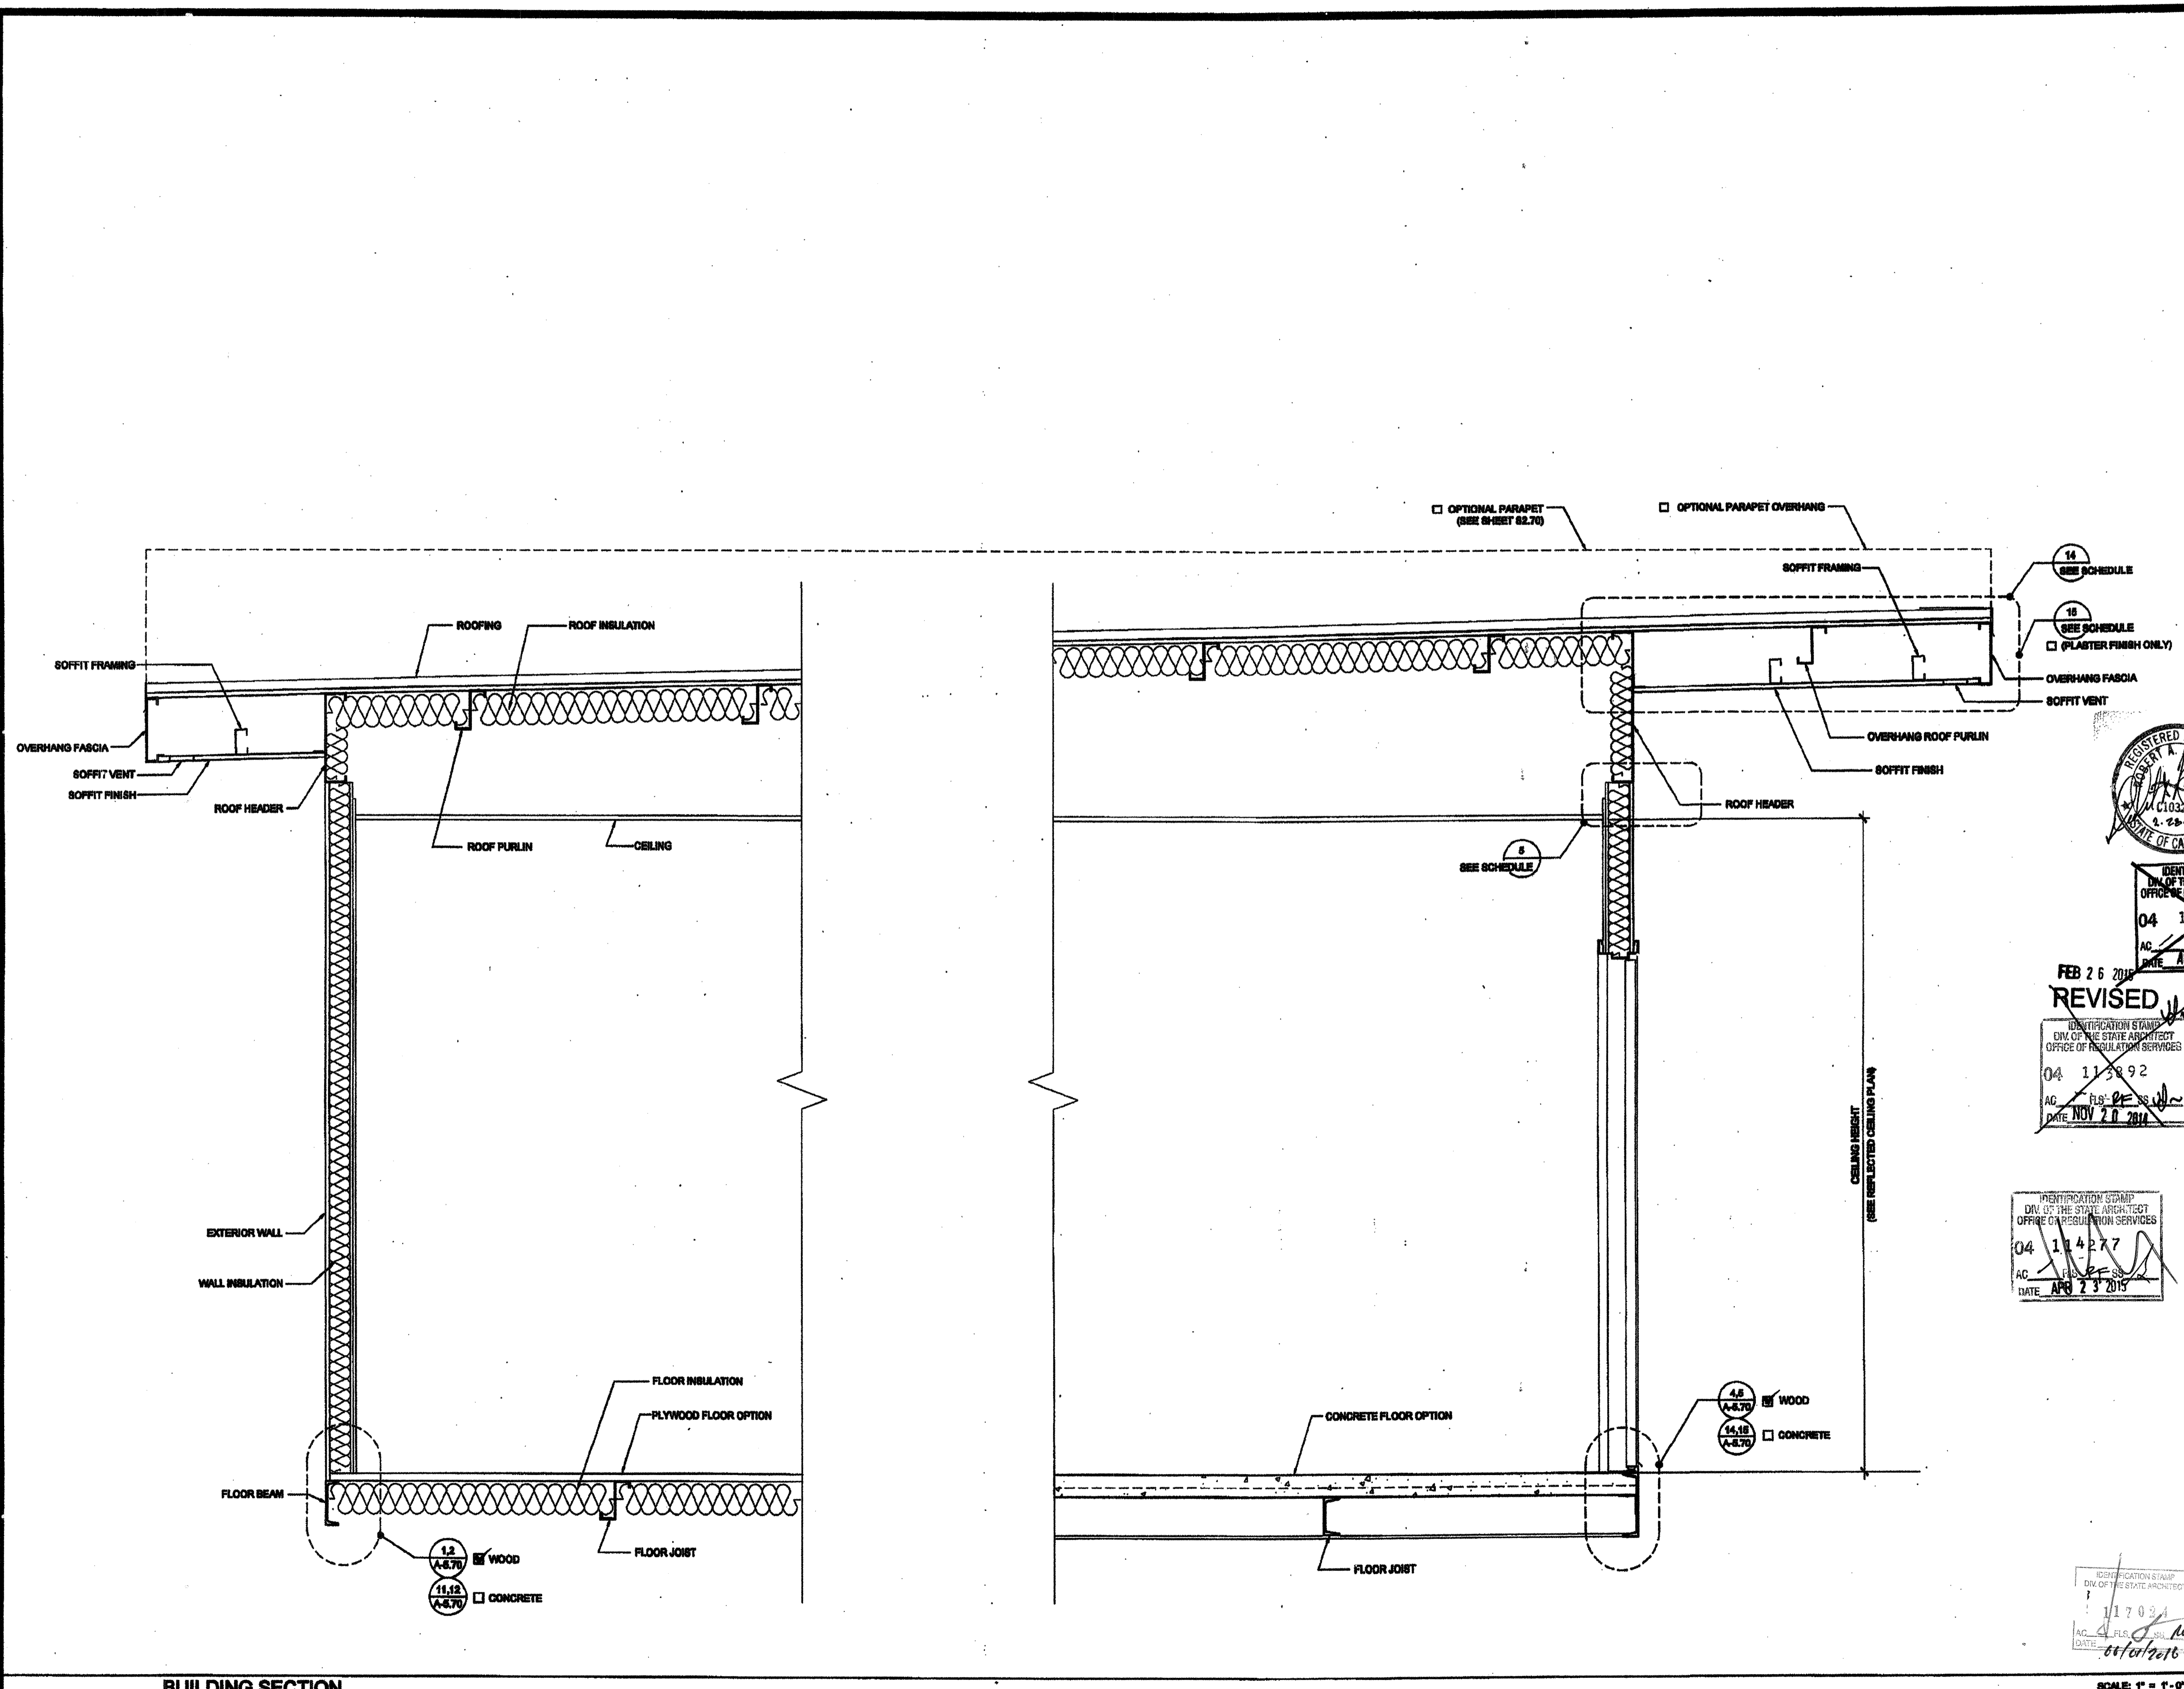

**BUILDING SECTION**

SCALE: 1" = 1'-0" 1