

THESE DRAWINGS AND ALL MATERIAL CONTAINED HEREIN ARE THE PROPERTY OF SILVER CREEK INDUSTRIES, INC. (SCI INC) AND SHALL NOT BE REPRODUCED, COPIED OR OTHERWISE DISPOSED OF DIRECTLY OR INDIRECTLY AND SHALL NOT BE USED IN WHOLE OR IN PART TO ASSIST IN THE MAKING OF OR FOR THE PURPOSE OF FURNISHING ANY INFORMATION FOR THE MAKING OF DRAWINGS, PRINTS, APPARATUS OR PARTS THEREOF WITHOUT THE FULL KNOWLEDGE AND WRITTEN CONSENT OF SCI INC. ALL PATENTABLE MATERIAL CONTAINED HEREIN AND COORDINATING WITH SCI INC SHALL BE THE PROPERTY OF SCI INC



SILVER CREEK INDUSTRIES, INC.



195 EAST MORGAN AVENUE, CALIFORNIA 92571
PHONE: 951-943-5919 FAX: 951-943-2211

PROJECT NAME:
CLASS LEASING CLASSROOM BLDG'S

SHEET TITLE:
**INTERIOR ELEVATION
36' x 40'**

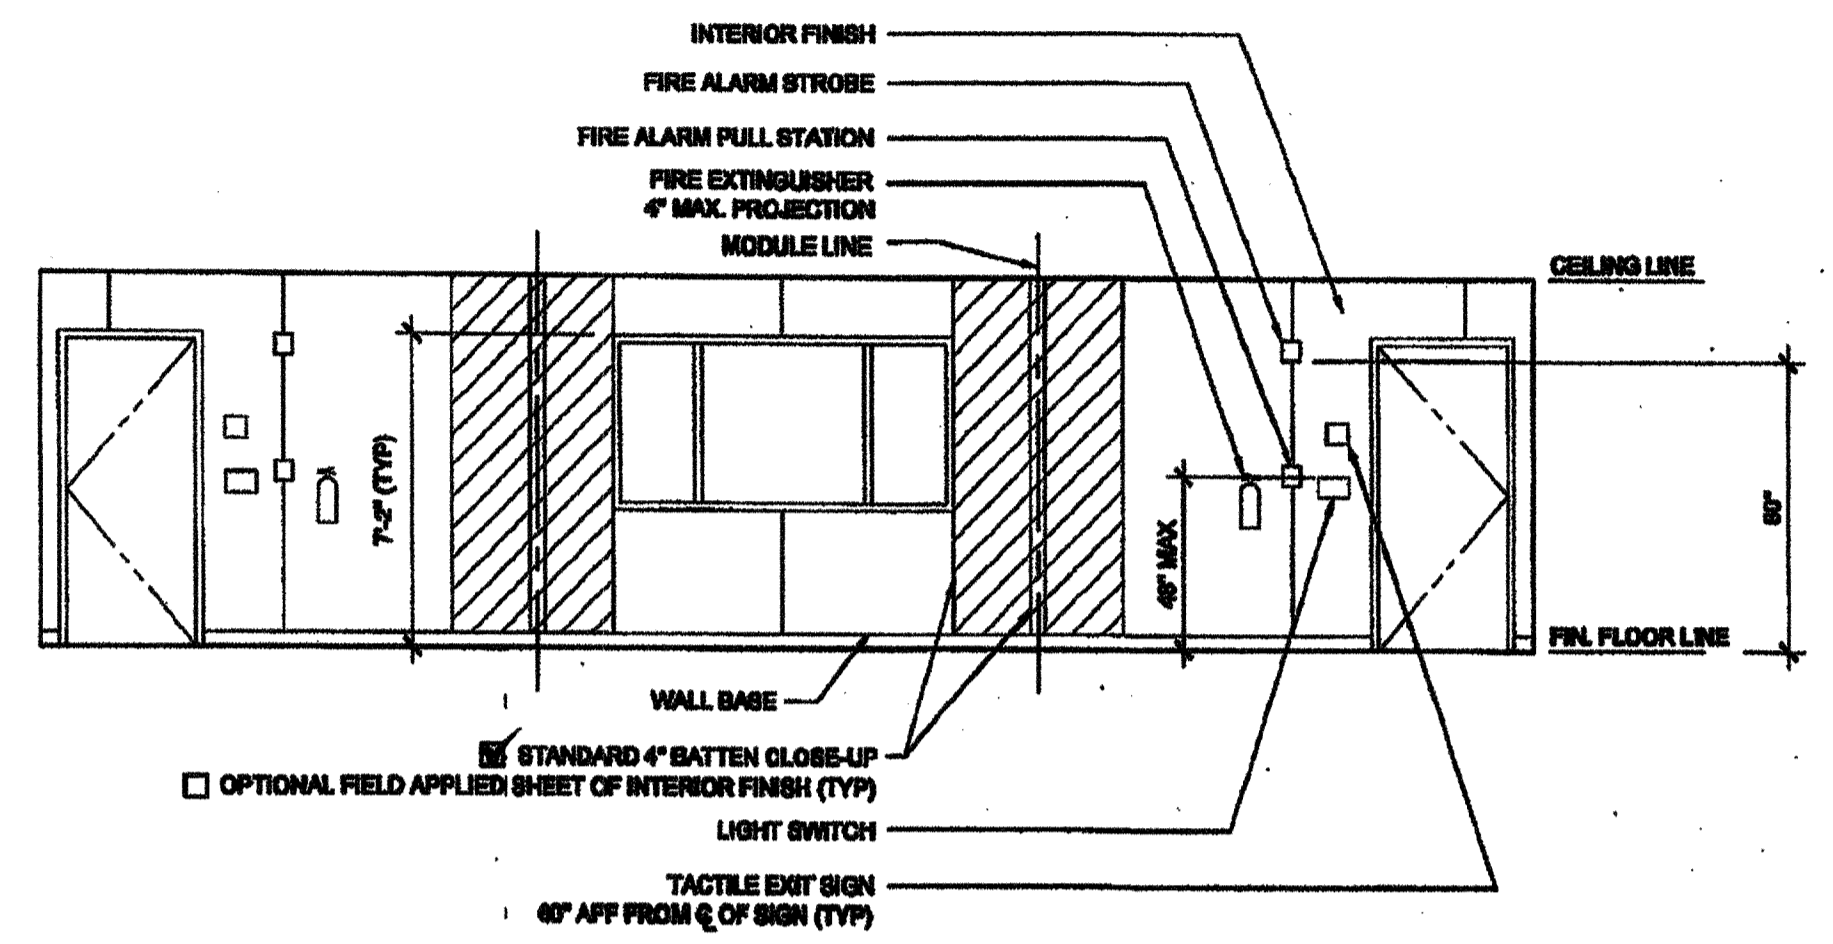
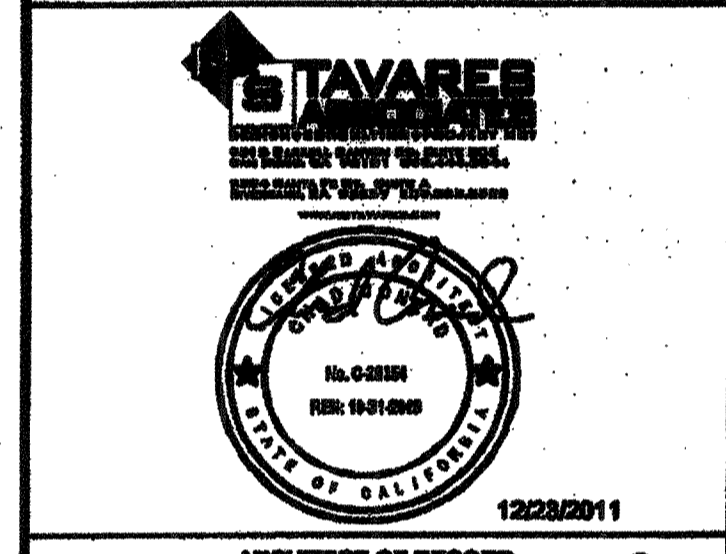


FRONT ELEVATION

SCALE: 1/4" = 1'-0"

REAR ELEVATION

SCALE: 1/4" = 1'-0"

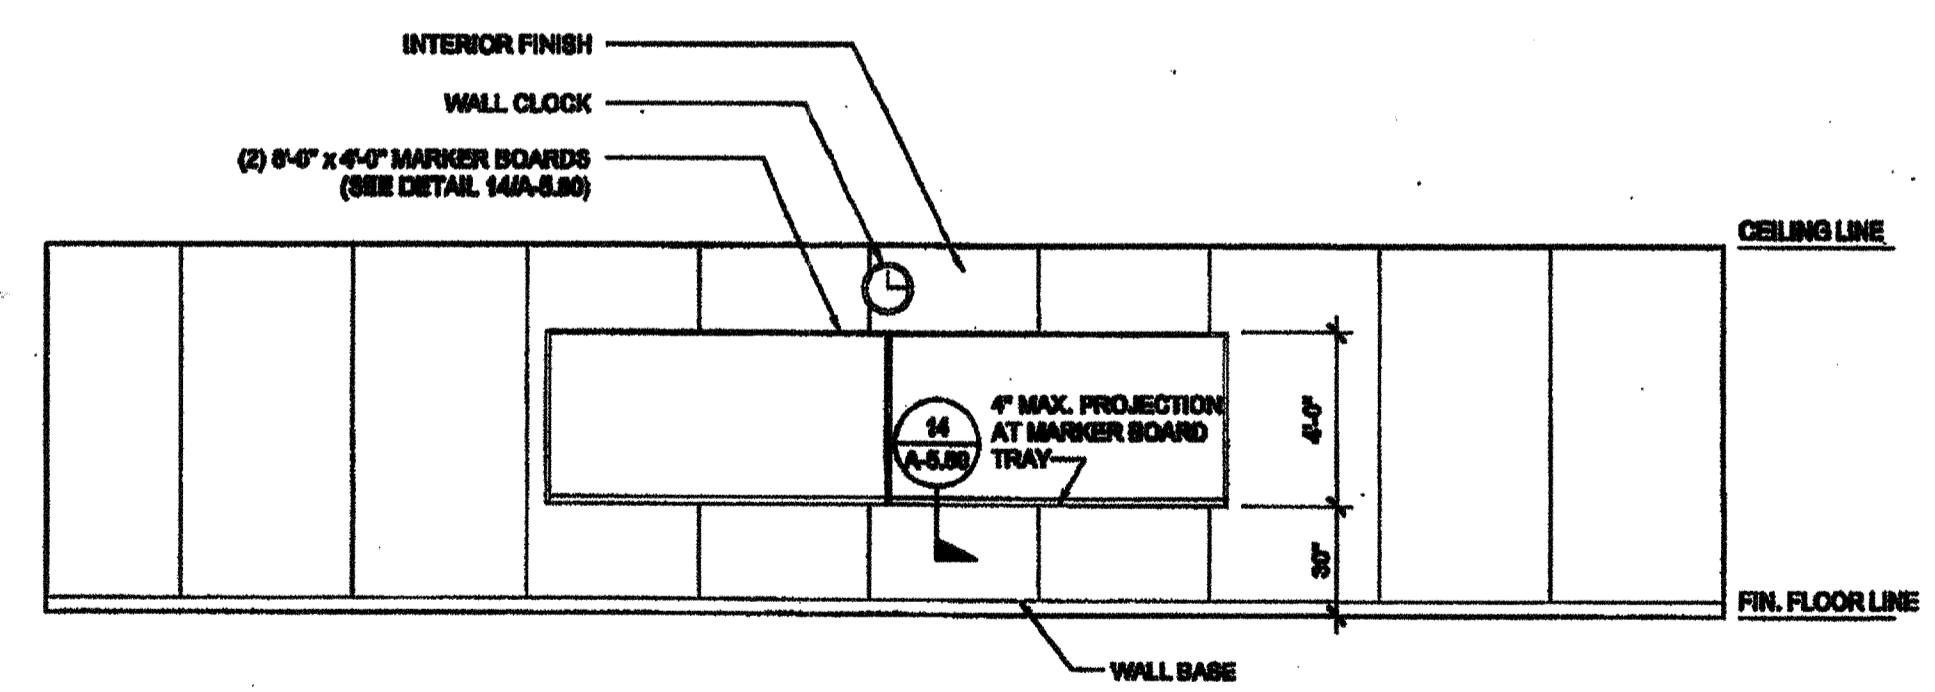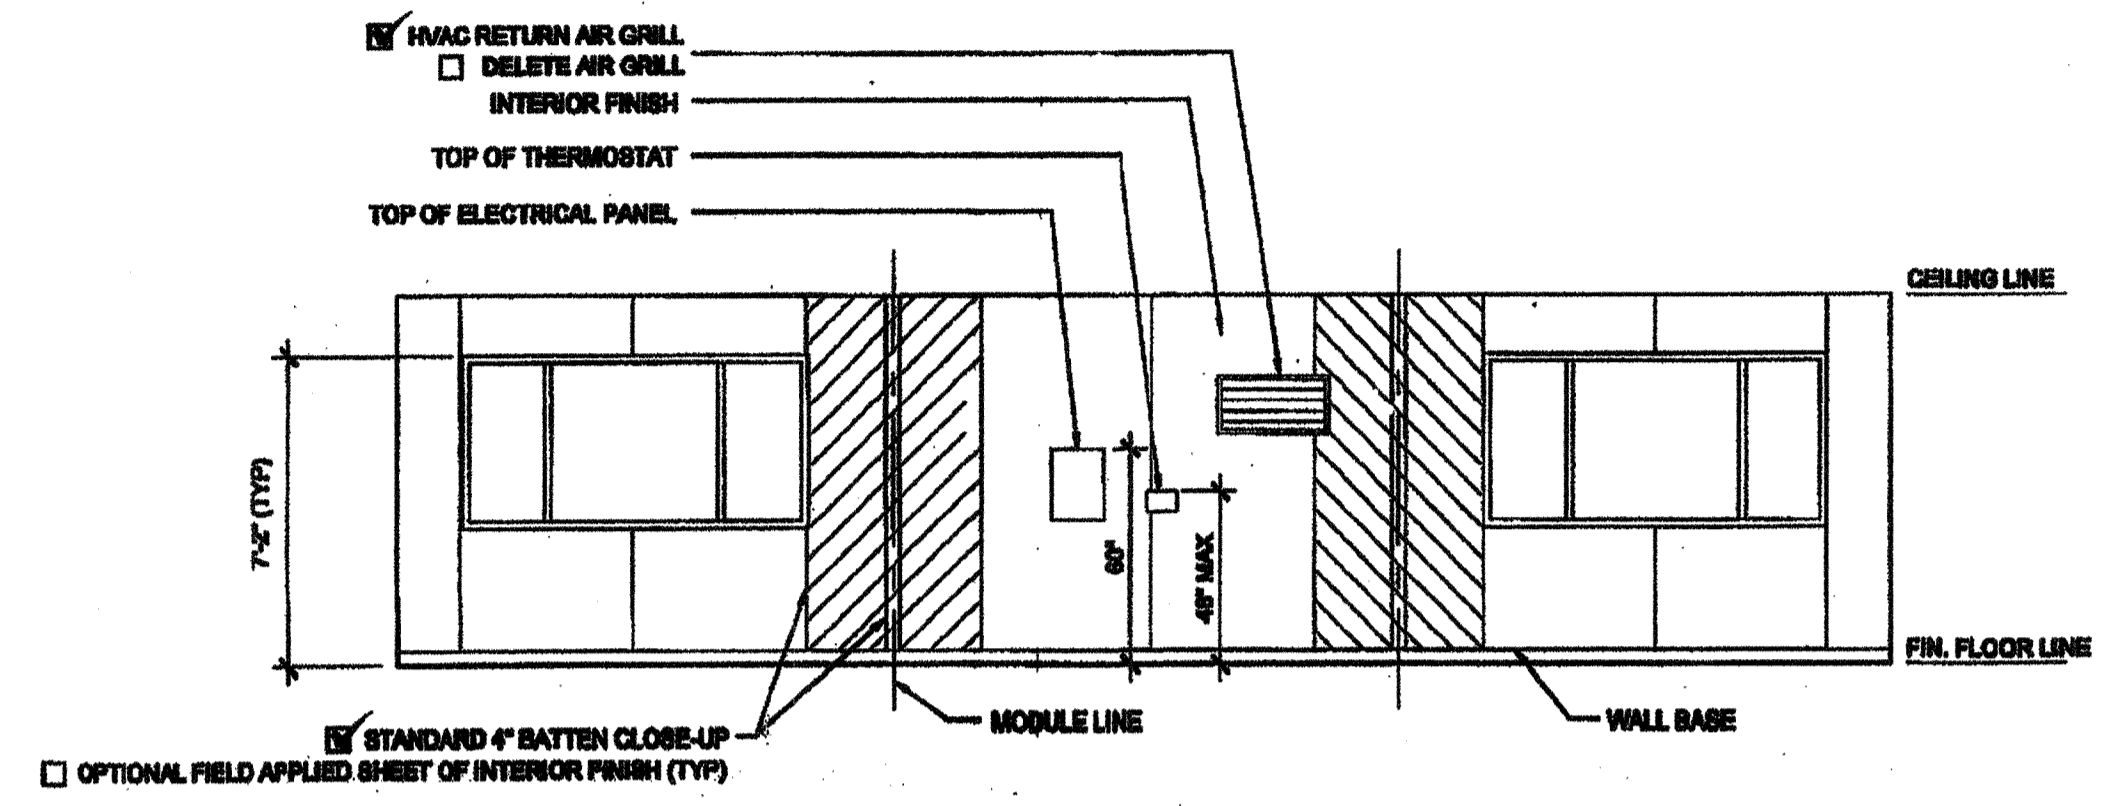

SIDE ELEVATION

SCALE: 1/4" = 1'-0"

SIDE ELEVATION

SCALE: 1/4" = 1'-0"

REVISED
IDENTIFICATION STAMP
DIV. OF THE STATE ARCHITECT
OFFICE OF REGULATION SERVICES
04 113892
AC [Signature] FS [Signature] SS [Signature]
DATE FEB 26 2015

IDENTIFICATION STAMP
DIV. OF THE STATE ARCHITECT
OFFICE OF REGULATION SERVICES
04 113849
AC [Signature] FS [Signature] SS [Signature]
DATE AUG 28 2014

~~PROJECT SPECIFIC STATE AGENCY APPROVAL
IDENTIFICATION STAMP
DIV. OF THE STATE ARCHITECT
OFFICE OF REGULATION SERVICES
04 113529
AC [Signature] FS [Signature] SS [Signature]
DATE APR 04 2014~~

ORIGINAL PC STATE AGENCY APPROVAL
IDENTIFICATION STAMP
DIV. OF THE STATE ARCHITECT
OFFICE OF REGULATION SERVICES
PC 04-112072
AC [Signature] FS [Signature] SS [Signature]
DATE JULY 2 2014

IDENTIFICATION STAMP
DIV. OF THE STATE ARCHITECT
OFFICE OF REGULATION SERVICES
04 114277
AC [Signature] FS [Signature] SS [Signature]
DATE APR 23 2015

IDENTIFICATION STAMP
DIV. OF THE STATE ARCHITECT
OFFICE OF REGULATION SERVICES
03 117021
AC [Signature] FS [Signature] SS [Signature]
DATE 04/01/2014

REVISIONS

SILVER CREEK INDUSTRIES 36' x 40' PC	
PROJECT NO.:	
DRAWN BY:	
SCALE:	AS NOTED
DATE:	12-23-11
P.C. SHEET NUMBER	STW 140
A-6.02	