
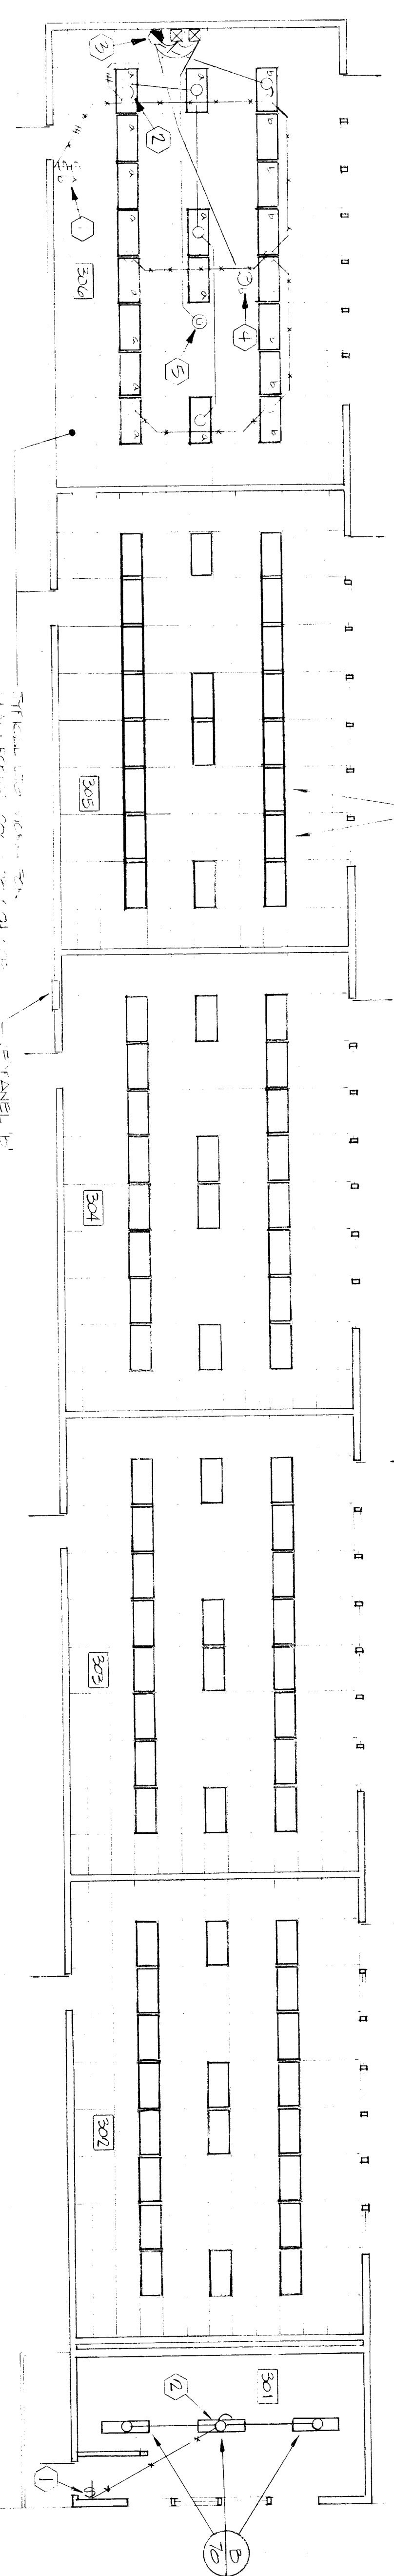


MATCH LINE A SEE SHEET E-5

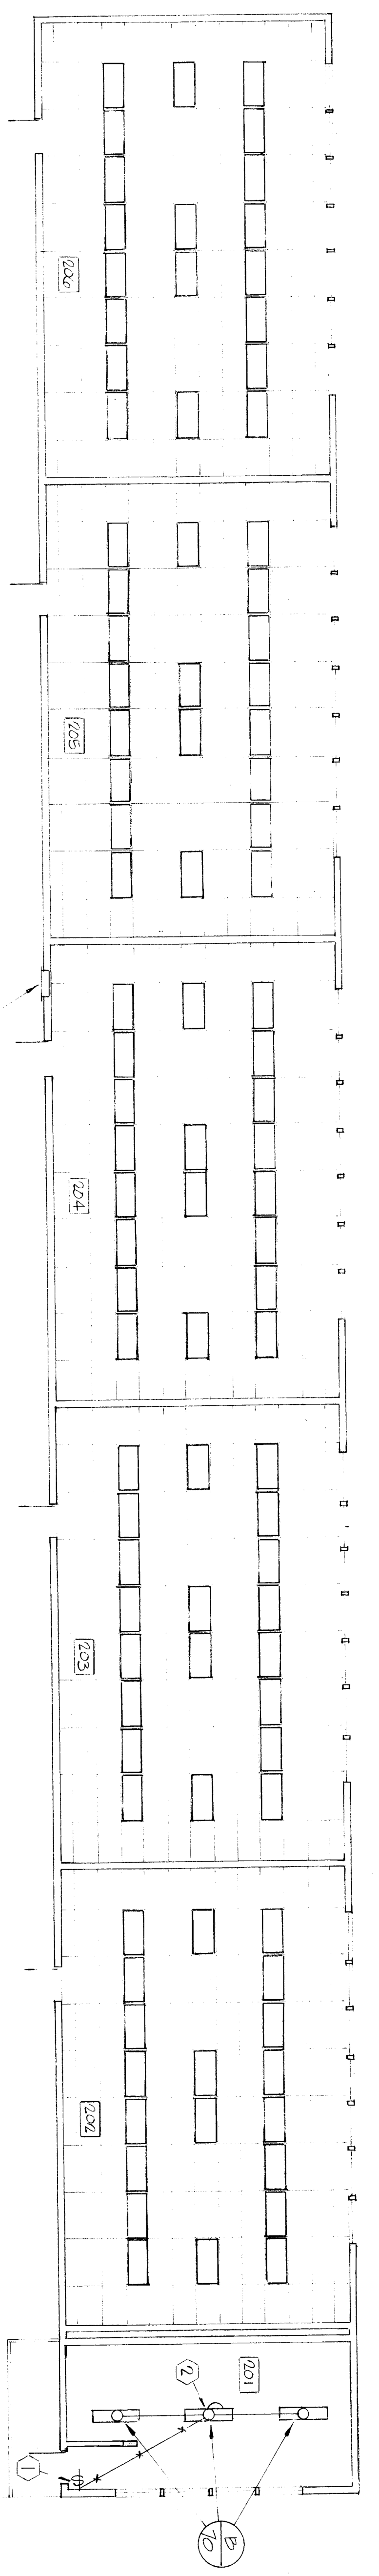

MATCH LINE B SEE SHEET E-3

LIGHTING FLOOR PLANS

1/8"=1'-0"

TYPE	DESCRIPTION	LAMPS	MTG.	VOLT.	REMARKS
A	NOT USED				
B	NOT USED				
C	LITHONIA # 40 120 BS	2F40	FLUORESC	120V	SEE MTG. (2) CENTRAL (E-3)
D	LITHONIA # 40 120 BS	2F40	FLUORESC	120V	SEE MTG. (1) CENTRAL (E-3)
E	LITHONIA # 40 120 BS	2F40	FLUORESC	120V	
F	LITHONIA # 40 120 BS	2F40	FLUORESC	120V	
G	LITHONIA # 40 120 BS	2F40	FLUORESC	120V	
H	LITHONIA # 40 120 BS	2F40	FLUORESC	120V	
J	LITHONIA # 40 120 BS	2F40	FLUORESC	120V	
K	LITHONIA # 40 120 BS	2F40	FLUORESC	120V	
X					

- REFERENCE NOTES (THIS SHEET ONLY):
- 1) REPLACE EXISTING WALL SWITCHES AND PLATE.
 - 2) CONNECT NEW FIXTURES TO EXISTING CIRCUITS.
 - 3) AUTOMATIC TUNING CONTROL MOUNTED ABOVE CEILING IN ACCESSIBLE AREA - SEE WIRING DIAGRAM ON SHEET E-4.
 - 4) PHOTOELECTRIC CELL MOUNTED ON CEILING MINIMUM 10'-0" AWAY FROM NEAREST WINDOW - SEE WIRING DIAGRAM ON SHEET E-4.
 - 5) MOTION SENSOR MOUNTED ON CEILING APPROXIMATELY IN CENTER OF ROOM - SEE WIRING DIAGRAM ON SHEET E-4.
- FIXTURE NOTES:
- 1 ALL 40W FLUORESCENT BALLASTS TO BE ADVANCE MARK 111.
 - 2 ALL 40W FLUORESCENT LAMPS TO BE GE F40L/R/S/M/11.
 - 3 ALL LENSES TO BE MINIMUM 125" PATTERN 12A ACW/LIC.
 - 4 ALL HID BALLASTS TO BE RATED BY FIXTURE MANUFACTURER WITH BALLASTS RECOMMENDATIONS.

APPROVAL

DATE

PROJECT

CLIENT

DESIGNER

INTERSTATE ENGINEERING, INC.

DP ARCHITECTS

architects planners

APPLICATION NO. 77/50802

DATE 1 FEB. 1988

PROJECT



architects - planners