




FRONT END/ENTRY ELEVATION
SCALE: 3/8" = 1'-0"

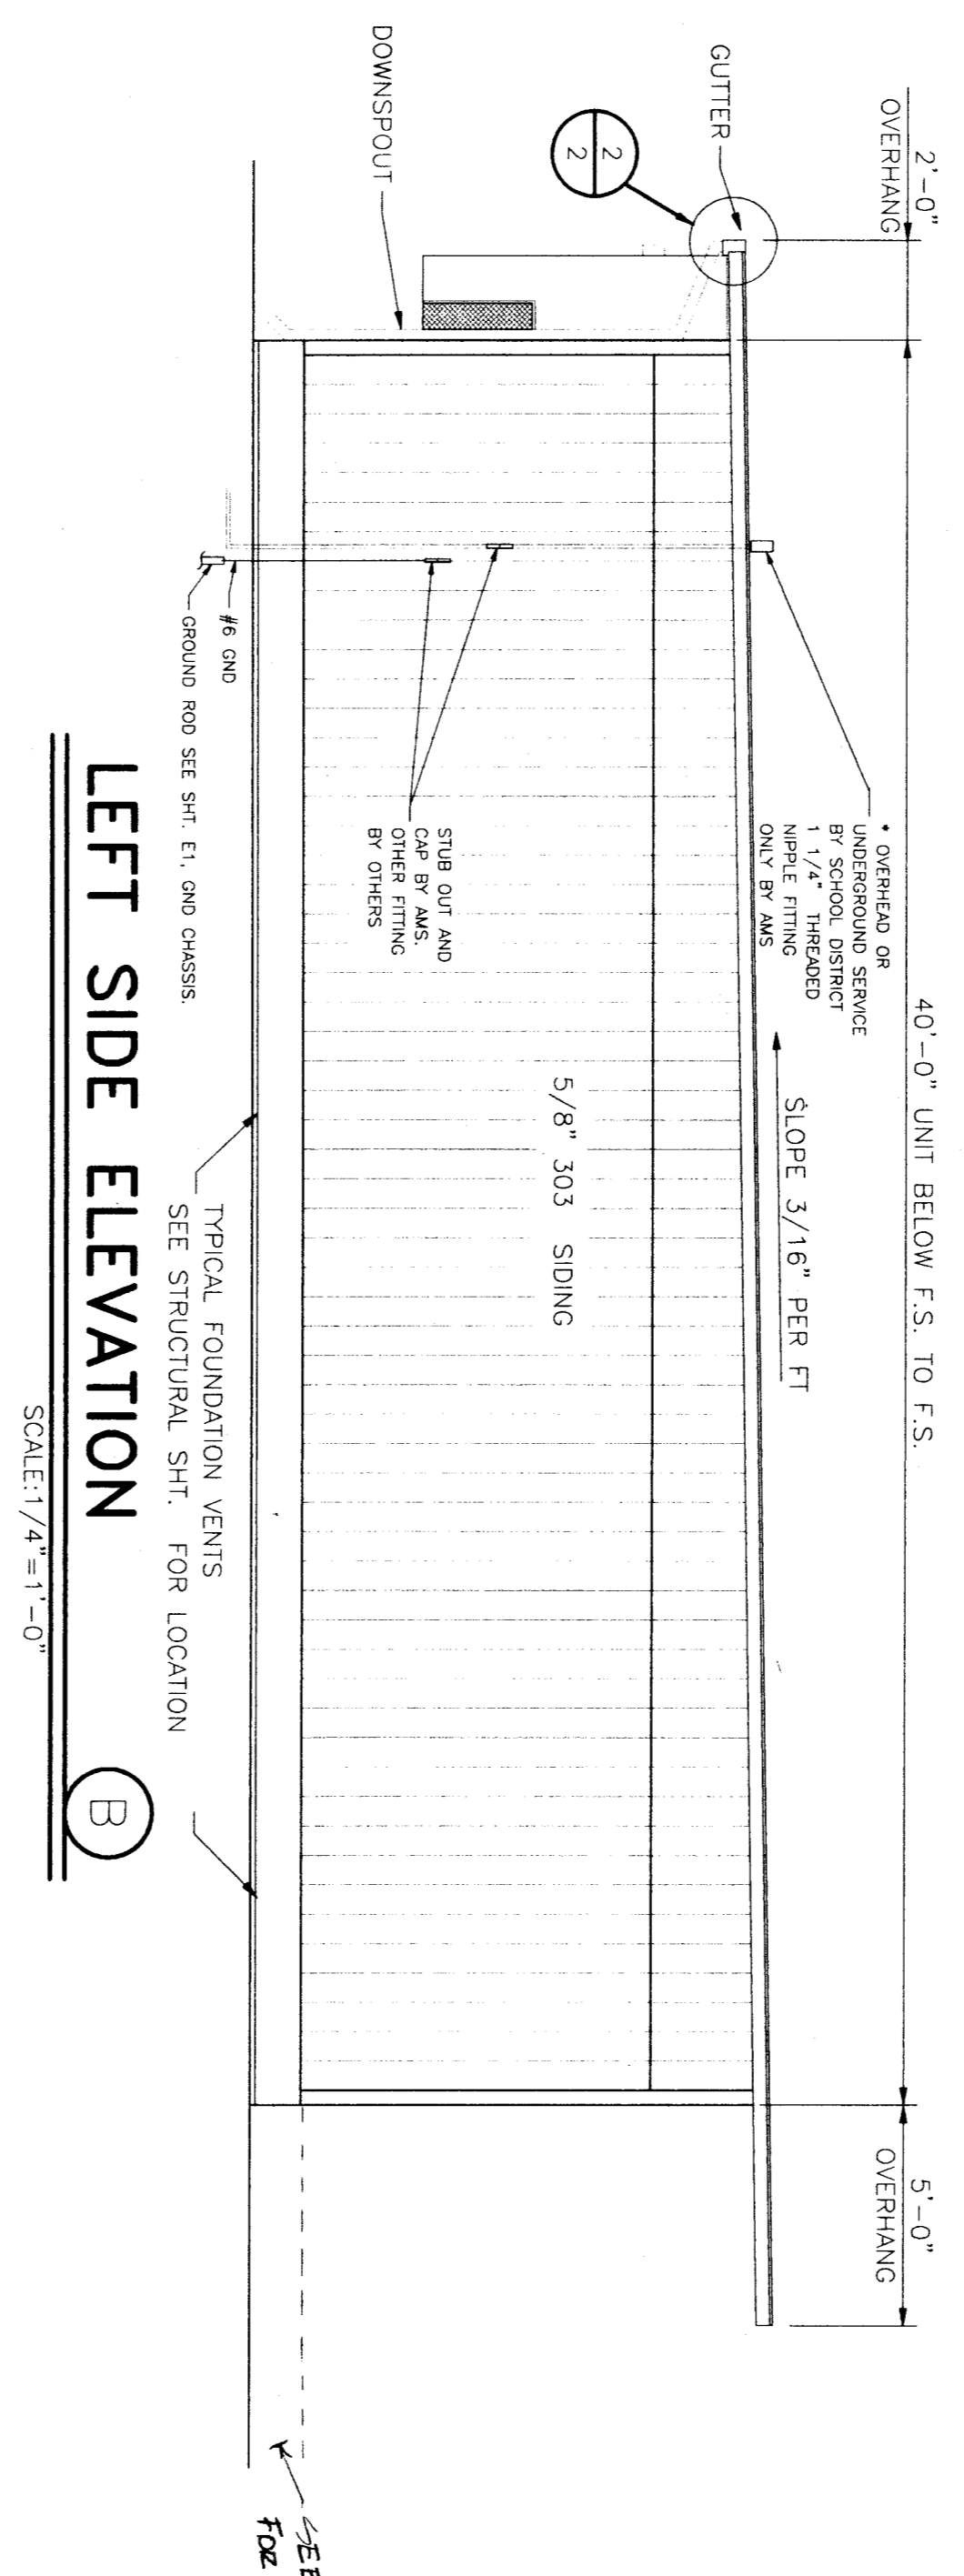


LEFT SIDE ELEVATION
SCALE: 1/4" = 1'-0"

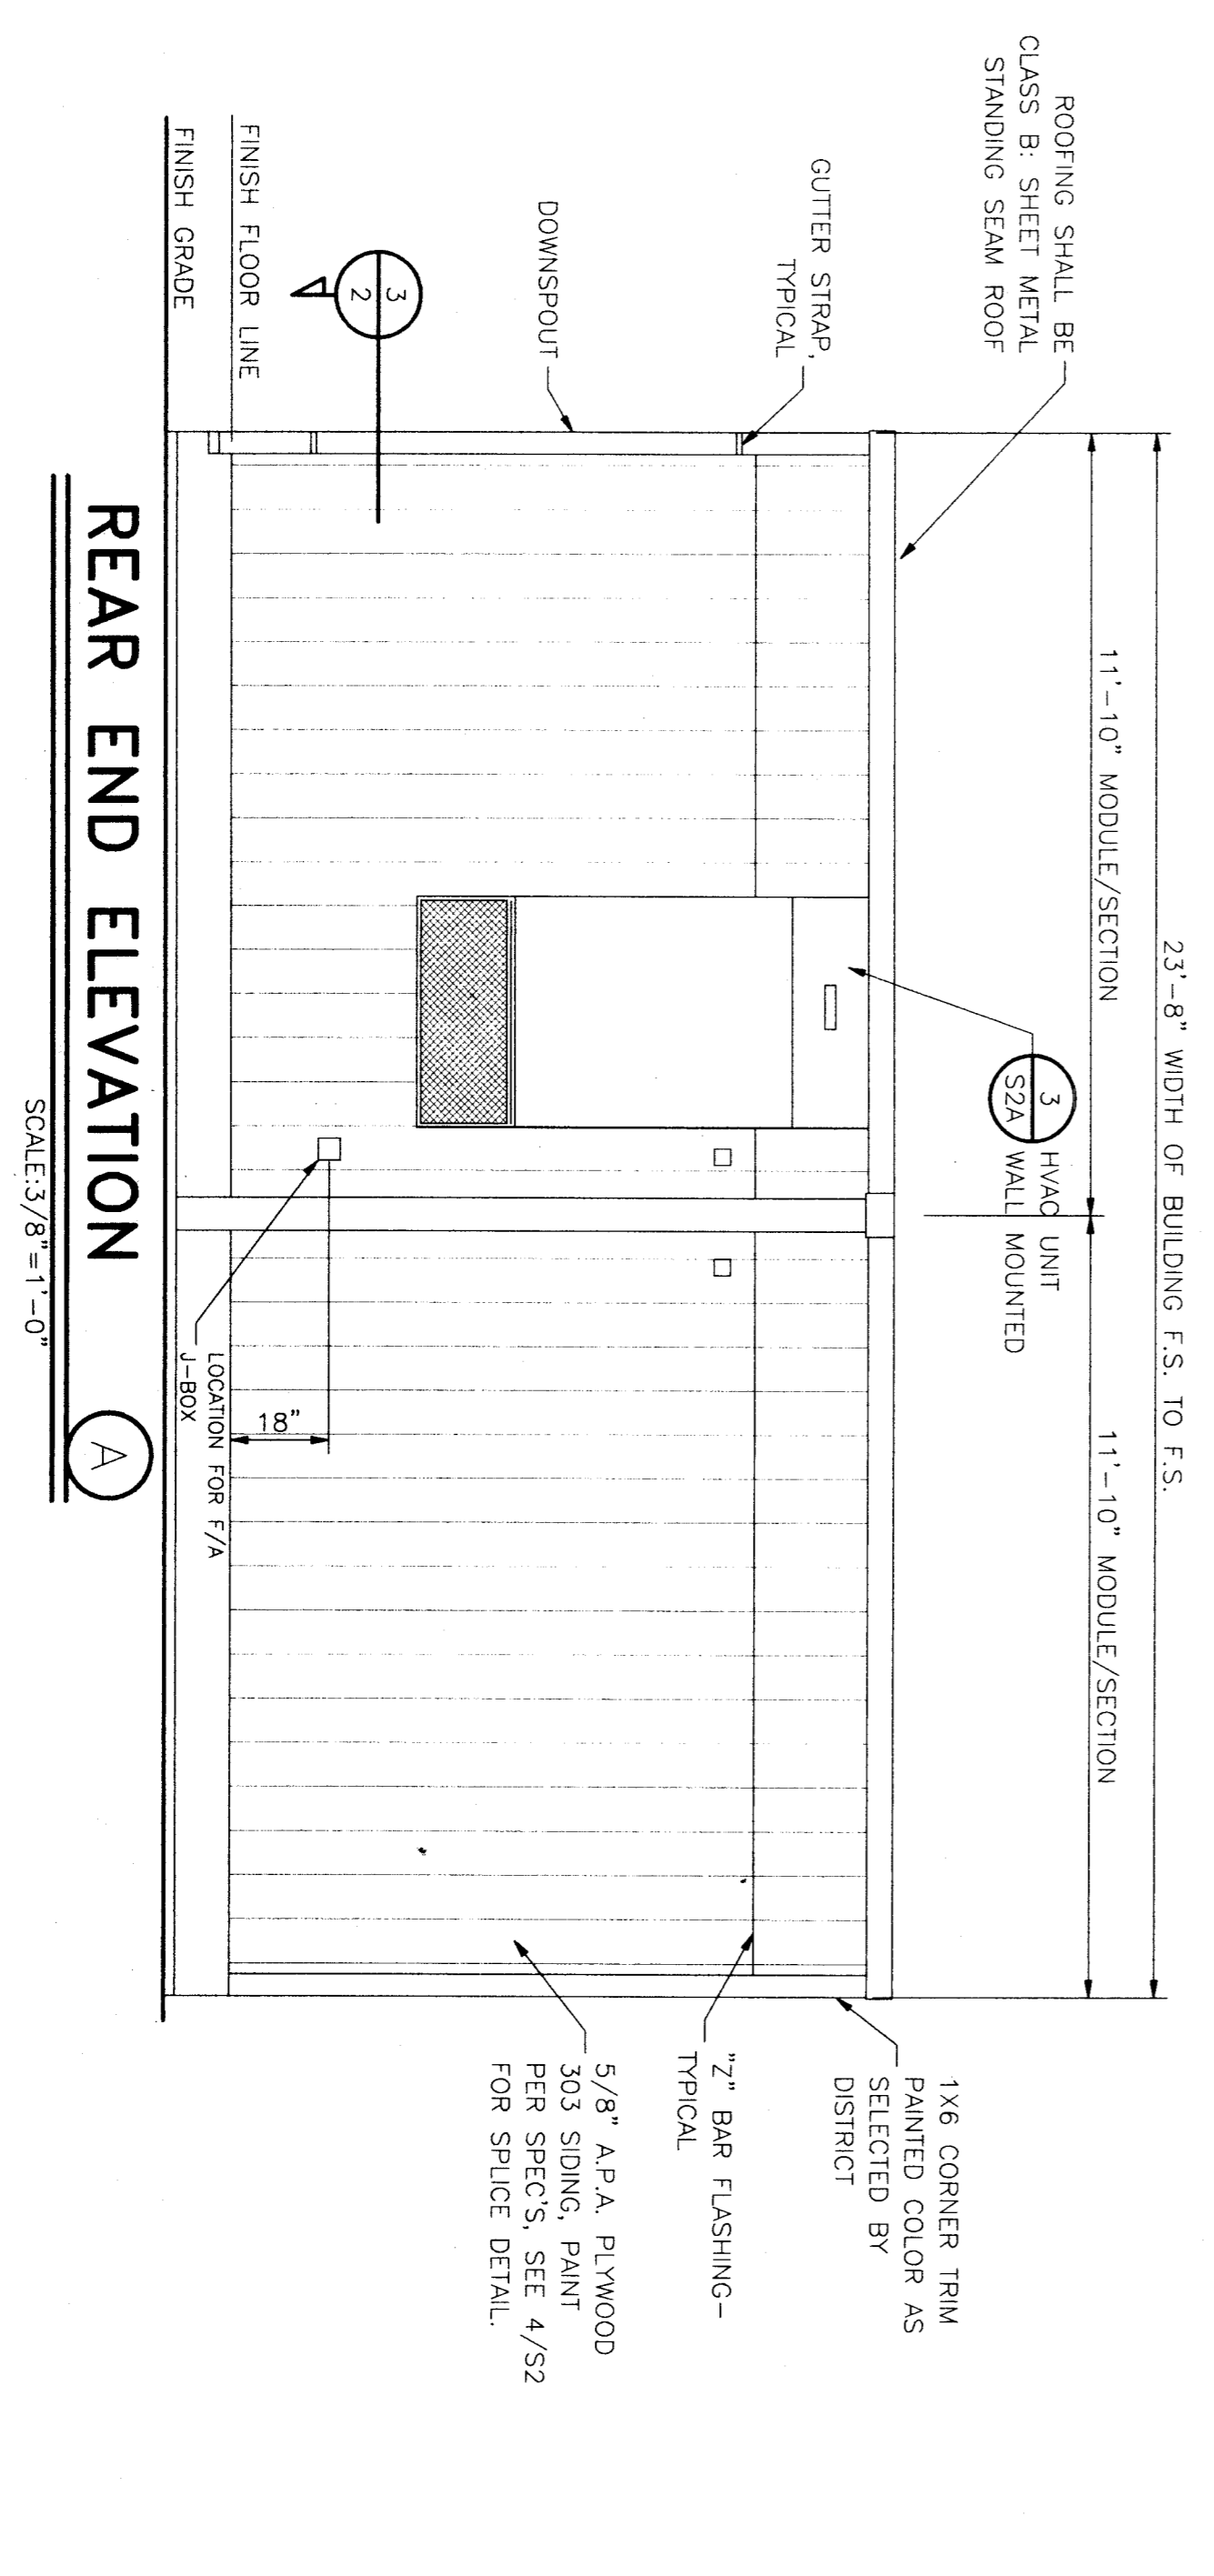

REAR END ELEVATION
SCALE: 3/8" = 1'-0"

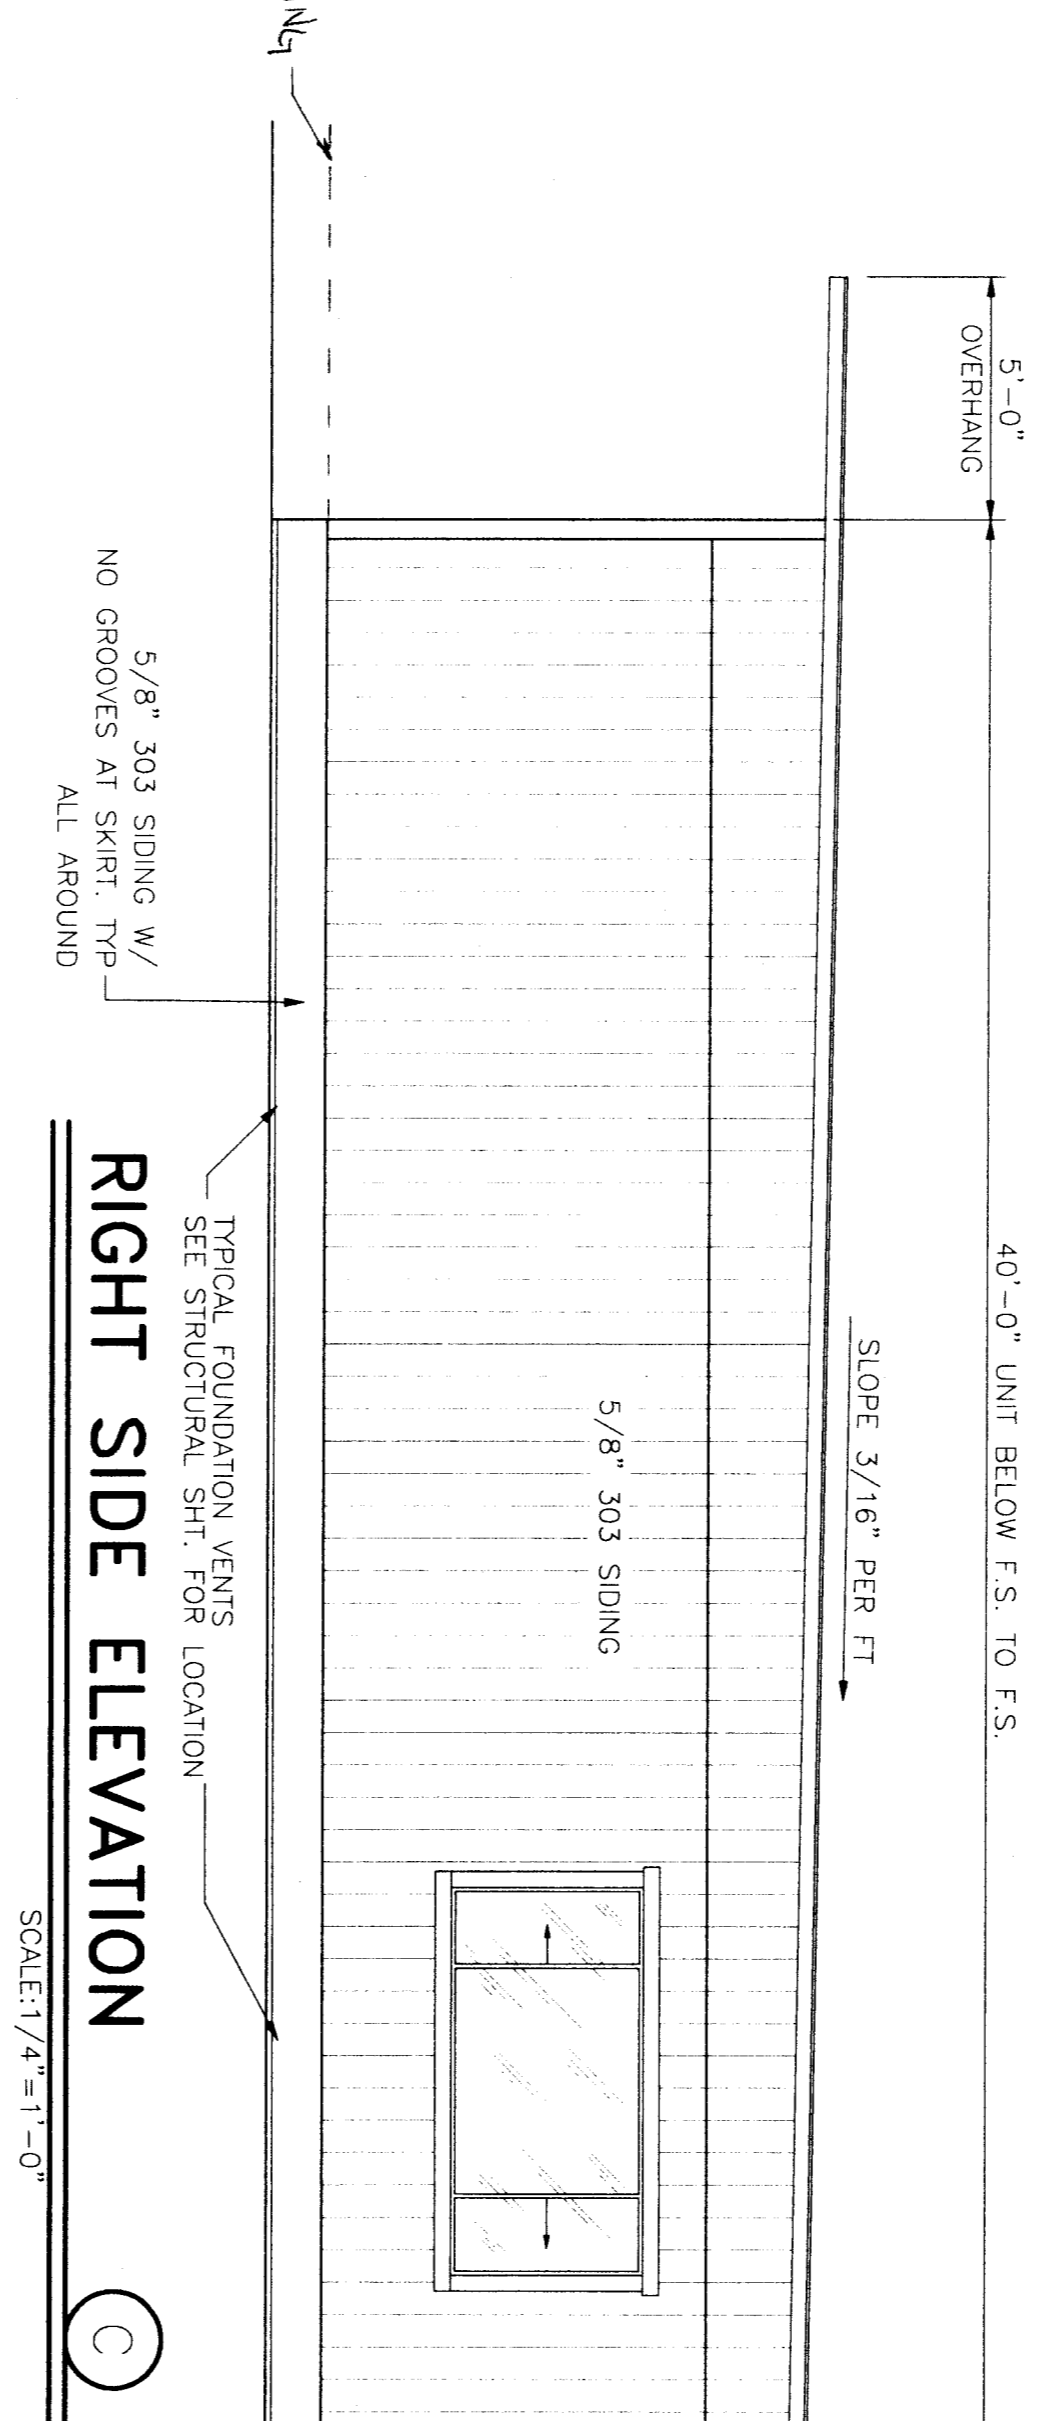

 
RIGHT SIDE ELEVATION
SCALE: 1/4" = 1'-0"



GUTTER AT OVERHANG DETAIL
SCALE: 1/2" = 1'-0"



DOWNSPOUT DETAIL
SCALE: 1/2" = 1'-0"

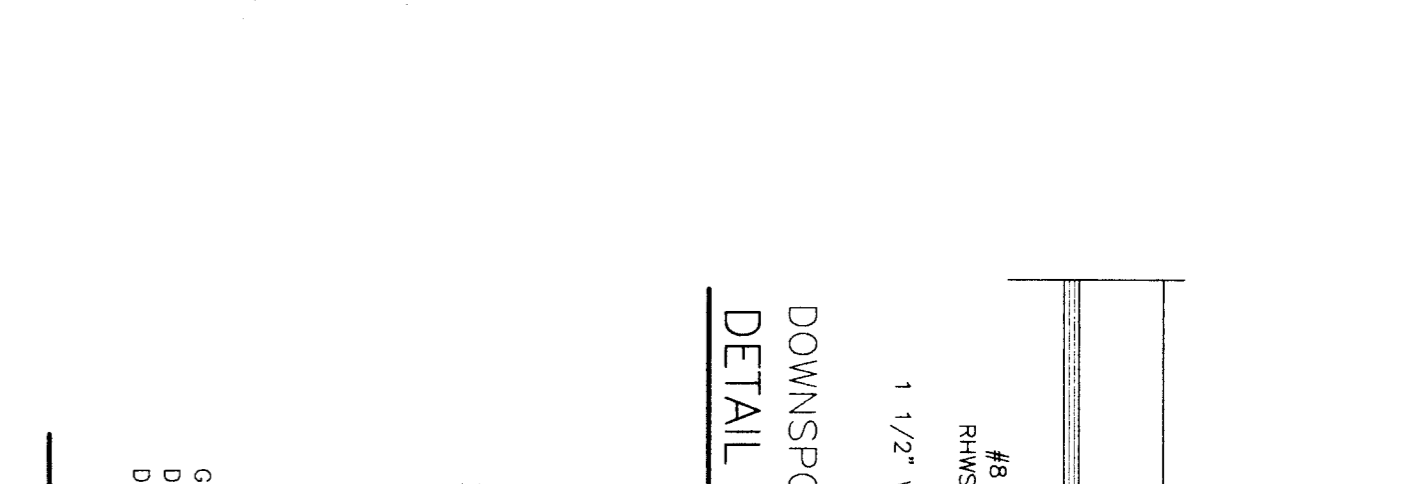


VENT DETAIL
SCALE: 1/2" = 1'-0"

DOOR SIGNAGE
NOT A PART OF THIS CONTRACT (NOT PROVIDED BY A.M.S.)

NOTE:
WHERE PERMANENT IDENTIFICATION IS PROVIDED FOR ROOMS OR SPACES, RAISED LETTERS SHALL BE PROVIDED AND SHALL BE ACCOMPANIED BY BRAILLE IN CONFORMANCE WITH THE FOLLOWING:
1. IDENTIFICATION LETTERS SHALL BE 1/2" HIGH.
2. IDENTIFICATION LETTERS SHALL BE 1/16" SPACED.
3. IDENTIFICATION LETTERS SHALL BE 1/16" SPACED.
24 X 40
RELOCATABLE
CLASSROOMS

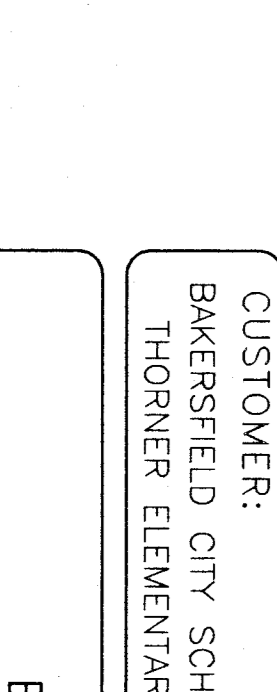

333 EAST CARNEGIE CT. MANTeca, CALIFORNIA 95337
PHONE (209) 825-1921 FAX (209) 825-7018

CUSTOMER:
BAKERSFIELD CITY SCHOOL DISTRICT
THORNER ELEMENTARY SCHOOL

EXTERIOR ELEVATIONS

NO.	DATE	DESCRIPTION	NO.	DATE	DESCRIPTION

PROJECT NO.
SHEET No. 2

FILE NO.
105313
DATE

PROJ. IDENTIFICATION STAMP
DATE OF REVISION

AC BY FLS SS BAK