


CONSTRUCTION DOCUMENTS

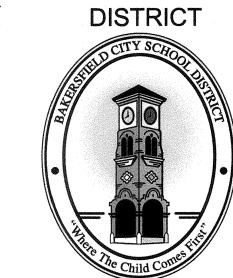

REVISIONS

DESCRIPTION

ROOSEVELT E.S. -MARQUEE SIGN 2324 VERDE ST., BAKERSFIELD, CA 93304

17146.000

OPSC or OSHPD PROJ. NO:

PRIME CONSULTANT

10/25/2017

OVERALL & PARTIAL SITE PLANS

A1100