

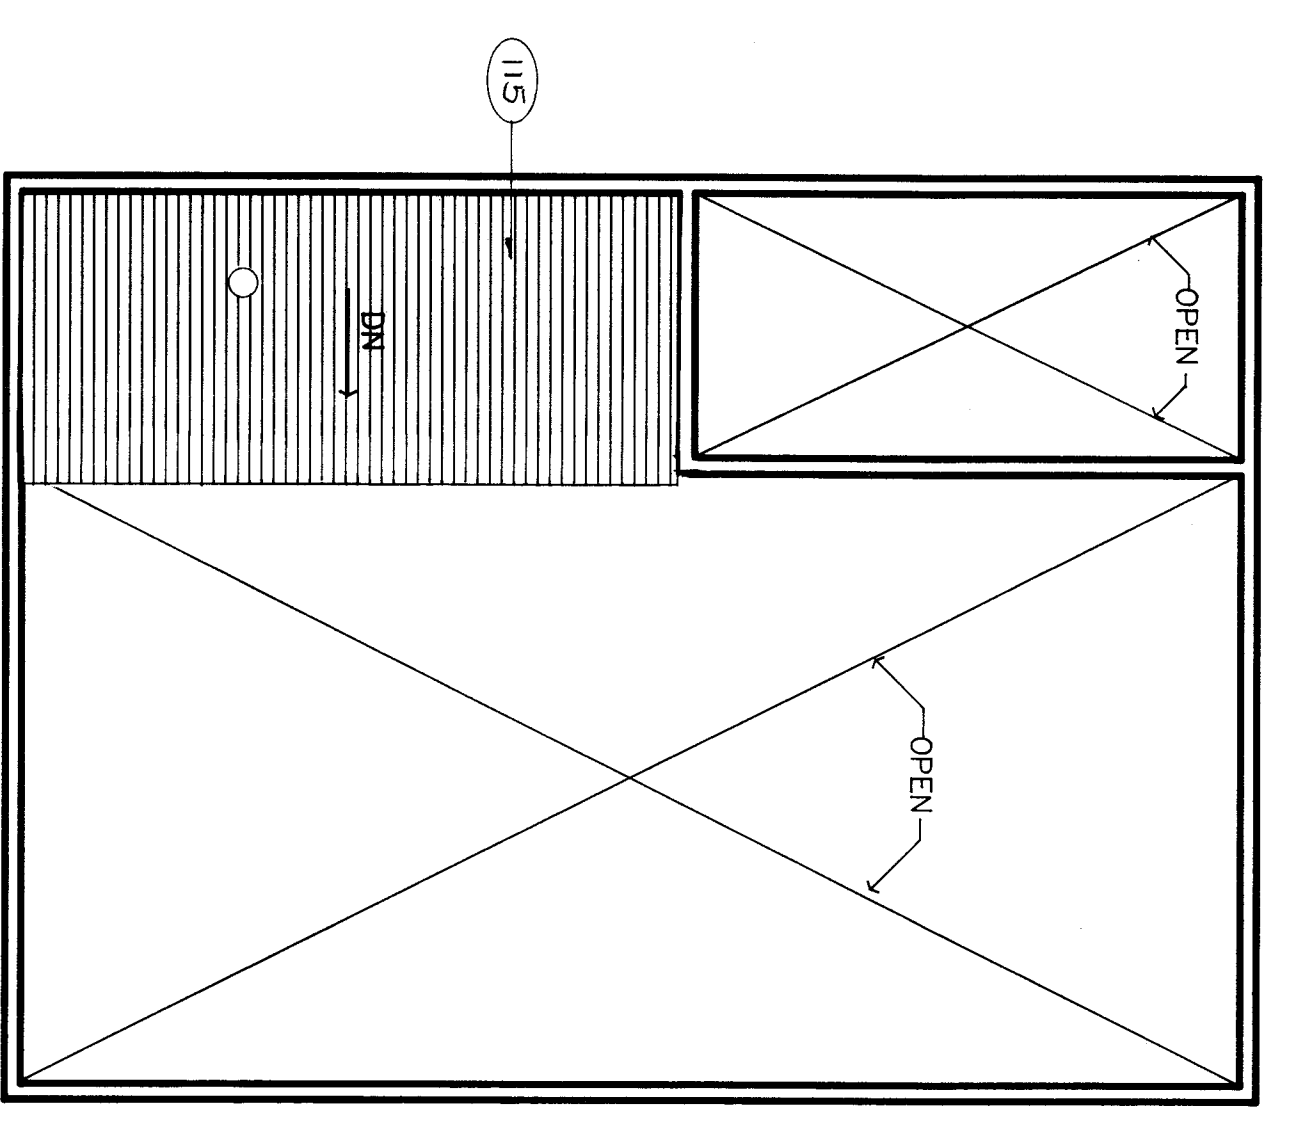



ADDITIVE ALTERNATE NO. 5
 ADD EXTENDED CEMENT PLASTER TO CURTAIN
 NOTE: BASE BID IS PAINT OVER CONCRETE
 BLOCK

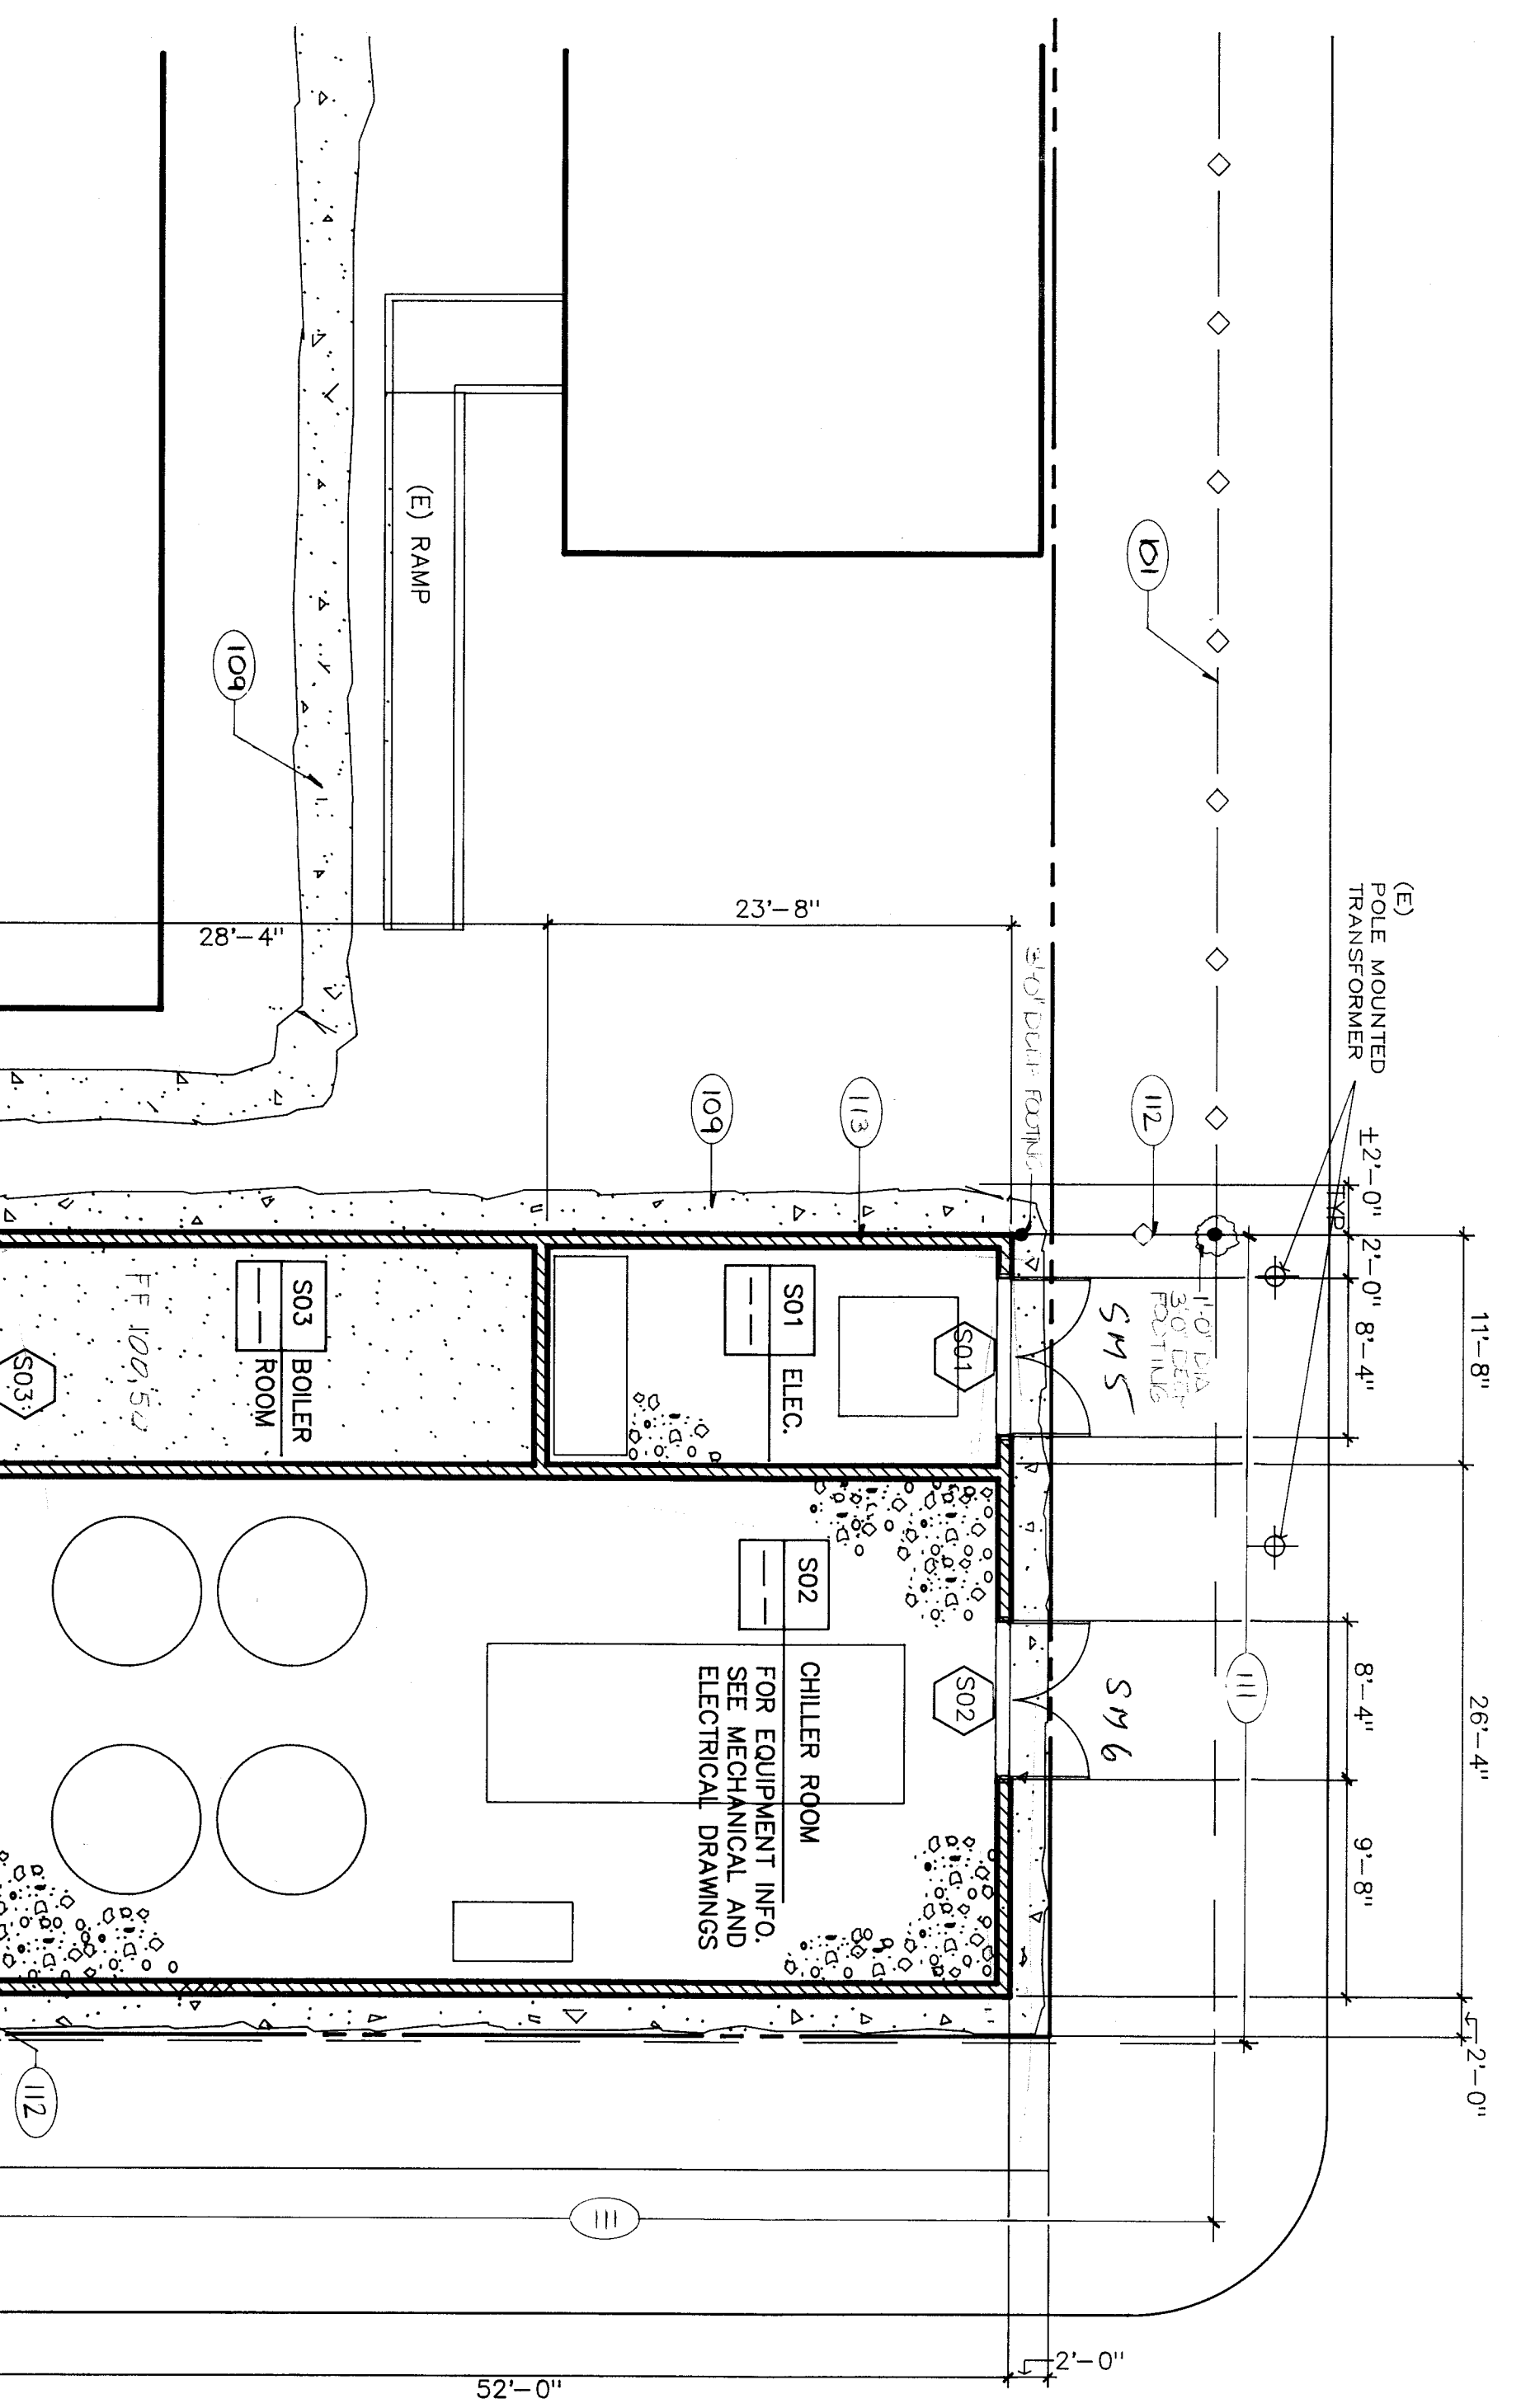

CHILLER YARD REFLECTED CEILING PLAN
 1/8"

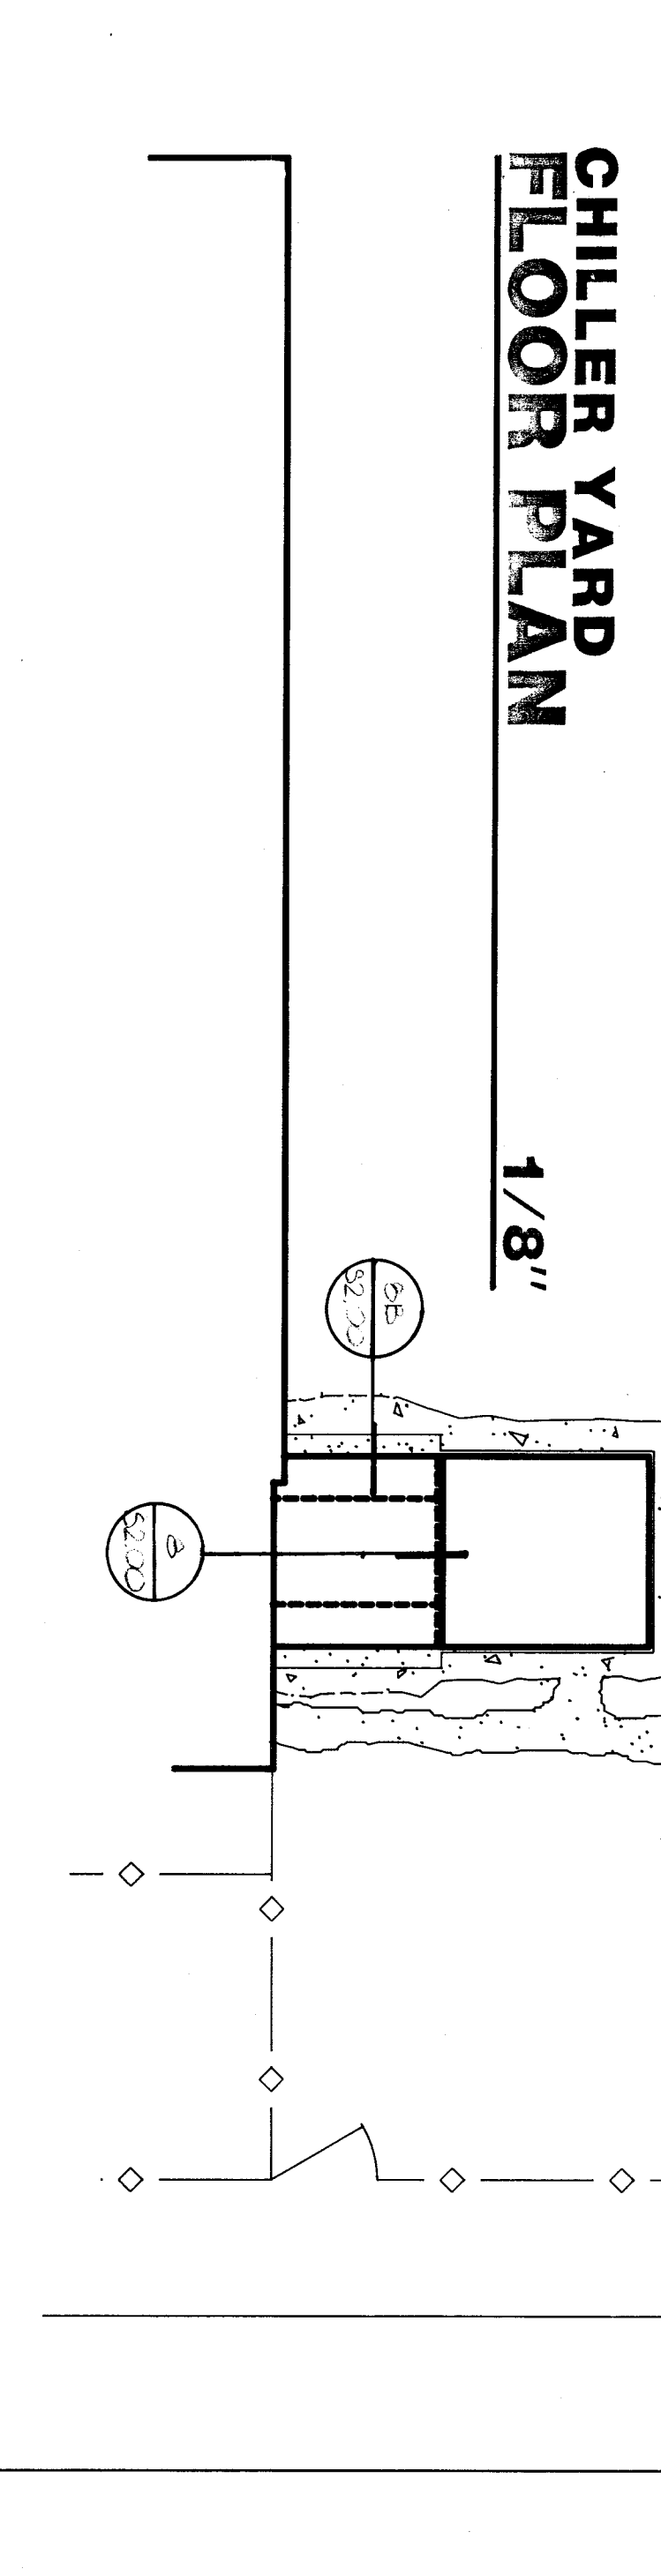

CHILLER YARD FLOOR PLAN
 1/8"

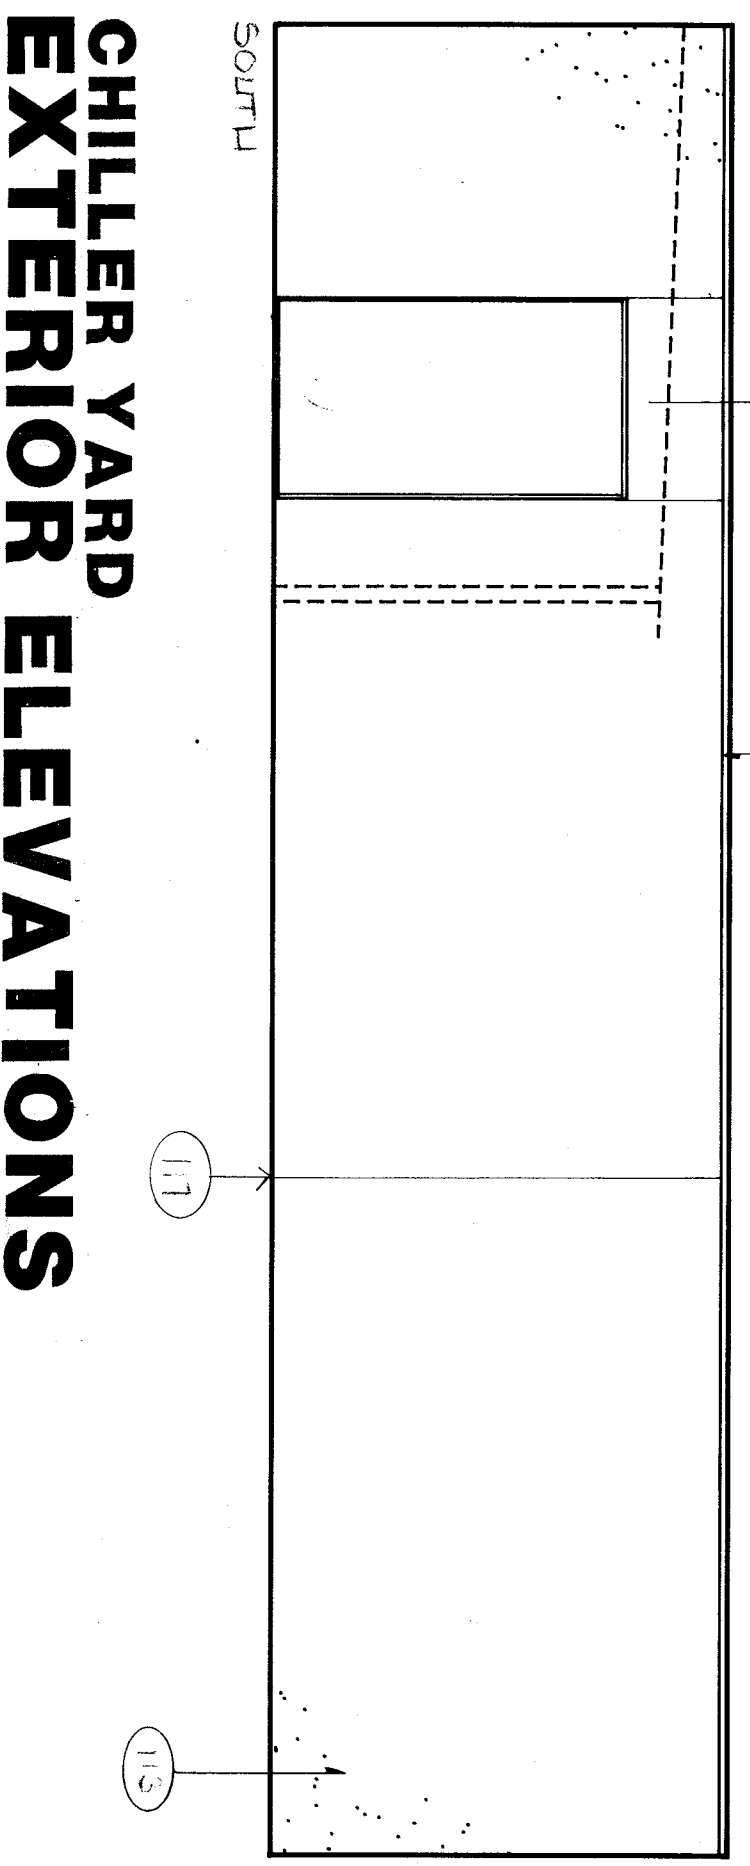


CHILLER YARD EXTERIOR ELEVATIONS
 1/4"


KEY NOTES

- A. NOT ALL DIMENSIONS ARE SHOWN IN THIS SHEET - SEE OTHER SHEETS.
- 101 (E) CURTAIN LINE FINISH.
- 102 THROUGH CONSTRUCTION CURTAIN LINE FINISH - 4'-0" HIGH.
- 103 THROUGH CONSTRUCTION CURTAIN LINE DATE.
- 104 LINE INDICATES START OF WORK.
- 105 CONSTRUCTION STAGING AREA.
- 106 THROUGH PERMANENT CLASSROOM DOORWAY - FINISH TO MATCH EXISTING DOORWAY - NOT PART OF THIS CONTRACT.
- 107 MECHANICAL AND ELECTRICAL WORK - SEE MECHANICAL AND ELECTRICAL DRAWINGS FOR DETAILS.
- 108 REMOVE AND REPAIR (E) CONCRETE SLAB AT INDICATED PER MECHANICAL AND/OR ELECTRICAL CONTRACTOR. AFTER COMPLETION OF WORK, PATCH TO MATCH (E) TEXTURE, COLOR, FINISH OR ADVISORY SURVEYOR.
- 109 INDICATED PER MECHANICAL AND/OR ELECTRICAL CONTRACTOR. REMOVE, PATCH, REPAIR AND RECONSTRUCT CURTAIN LINE FINISH TO MATCH (E) TEXTURE, COLOR, FINISH OR ADVISORY SURVEYOR.
- 110 4'-2 1/2" STEEL HOLLOW CHANNELS 2" SIZE AT 11' SPACING (E) CURTAIN LINE FINISH IN THIS AREA.
- 111 SMOOTH (E) CURTAIN LINE FINISH IN THIS AREA.
- 112 CURTAIN LINE FINISH.
- 113 SECTION CORRECT PLASTER OVER CONCRETE FINISH.
- 114 CUR BLOCK.
- 115 METAL BLOCK.
- 116 TO BE RELOCATED BY OWNER.


SEE CEILING PLAN FOR CURTAIN LINE FINISH TO MATCH EXISTING CURTAIN LINE FINISH.

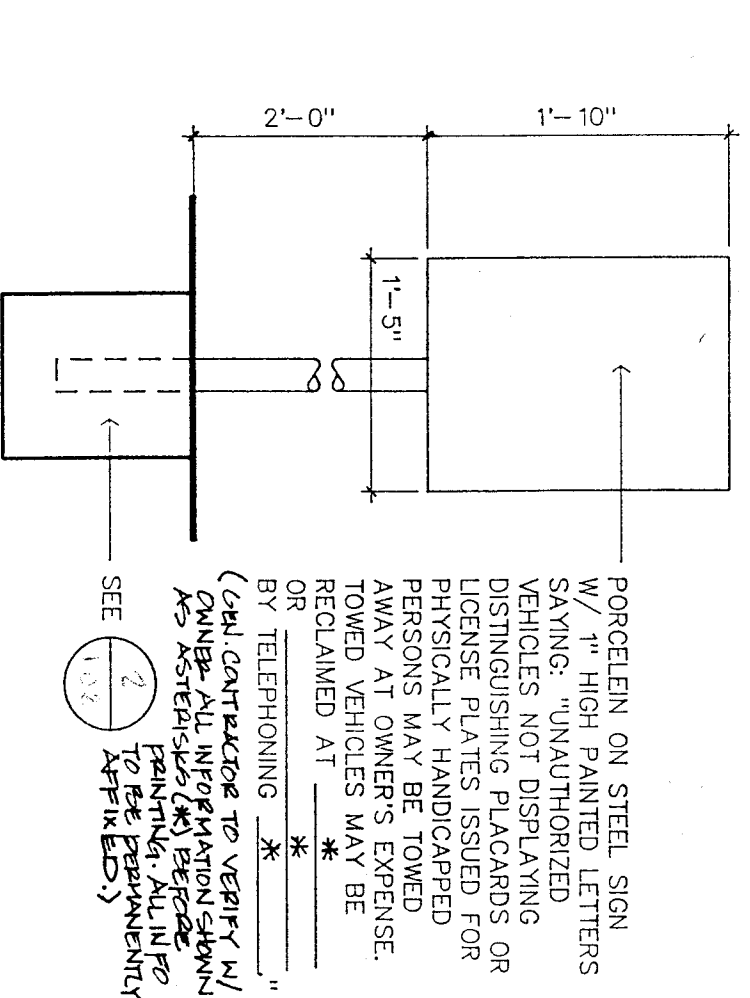


N.T.C.

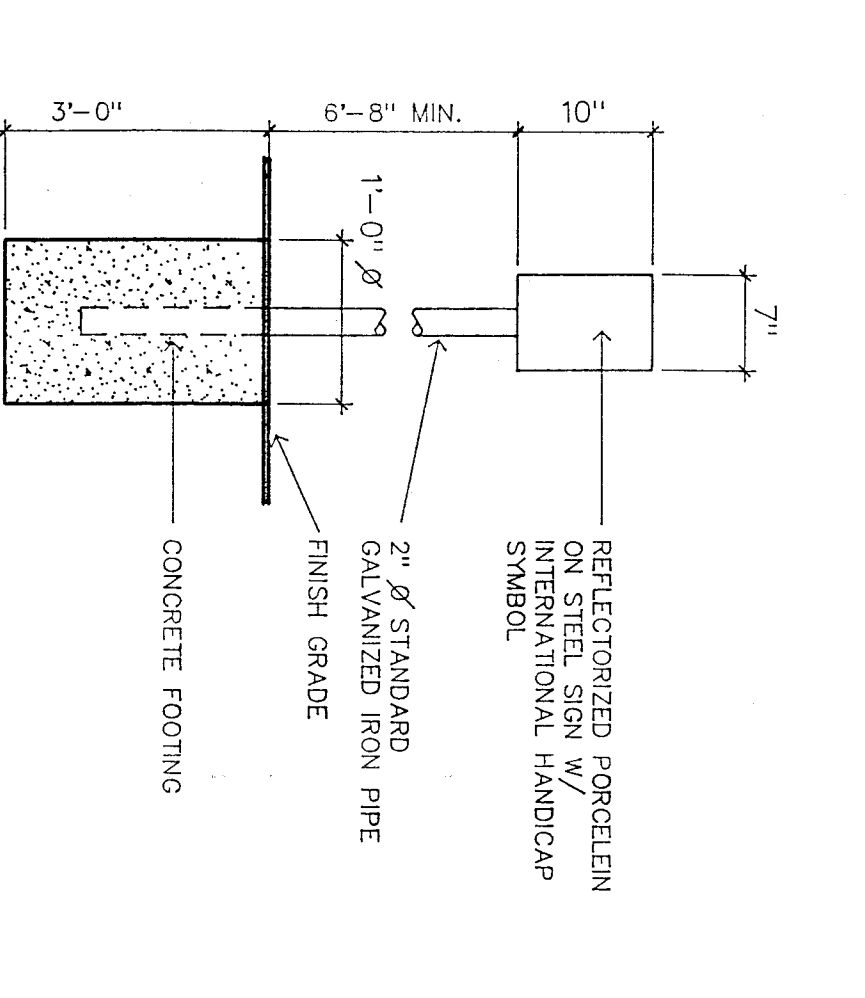

N.T.C.

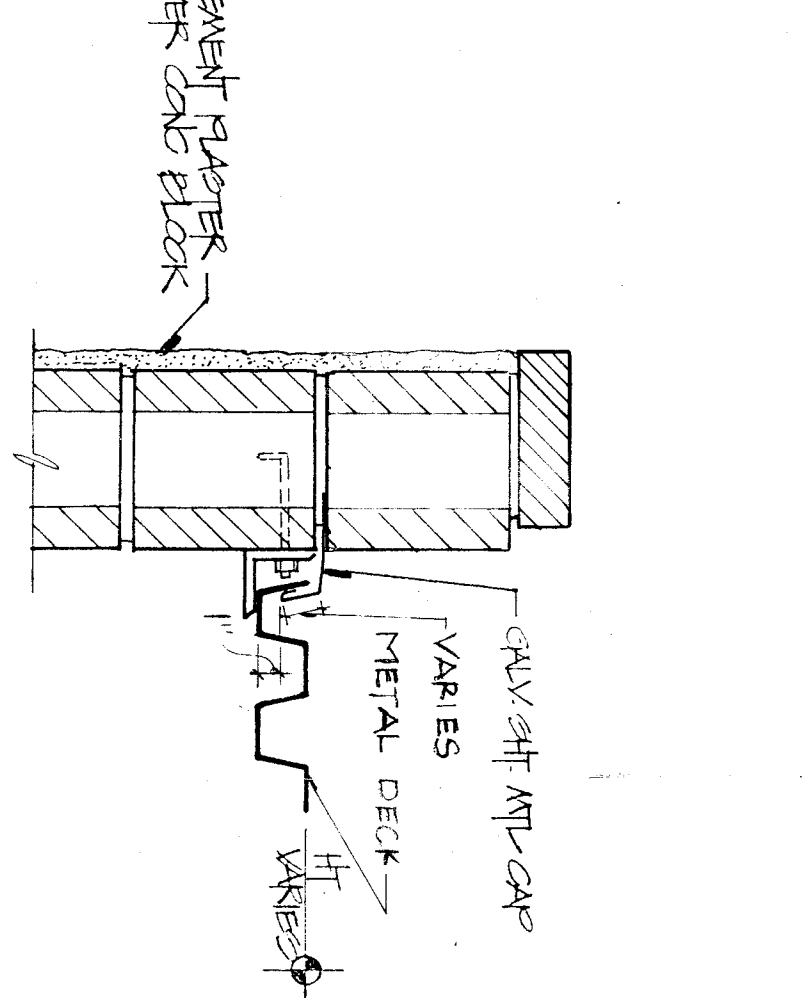

1	NO. 1
2	NO. 2

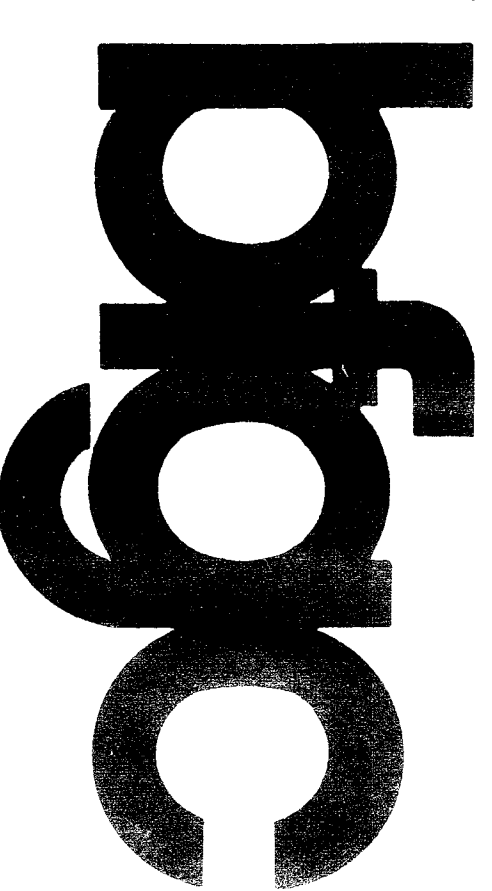

ROOSEVELT SCHOOL MODERNIZATION
 FOR
 BAKERSFIELD CITY SCHOOL DISTRICT

CHILLER YARD FLOOR PLAN, REFLECTED CEILING PLAN, AND EXTERIOR ELEVATIONS

bfgc architects planners inc.
 p.o. box 6698 bakersfield california 93399-8698
 31 south red road 93309 (805) 832 8122

DF ORISKANY

C-3132 X-C-6564 C-8021 C-8702

job no.	33-142
date	20 JAN 1989
drawn by	T. WARREN
chk'd by	SCOTT
copyright	1989

