


DOOR AND FRAME SCHEDULE

DOOR NUMBER	DOOR			FRAME			PERIOD	HARDWARE SET	SIGN	REMARKS	
	TYPE	SIZE (EACH LEAF)	LOUVER	TYPE	DETAILS	DETAILS					
		W H	W H		LEFT JAMB	HEAD	RIGHT JAMB				
S01	A	4'-0"	7'-0"		C	6/1/2 03	6/1/2 02	6/1/2 02		21	
S02	A	4'-0"	7'-0"		C	6/1/2 02	6/1/2 02	6/1/2 02		24	
S03	B	4'-0"	7'-0"		B	6/1/2 02	6/1/2 02	6/1/2 02		25	
S04											
S05											
S06											
S07											
S08											
S09											
S10											
S11											
S12											
S13											
S14											
S15											
S16											
S17											
S18											
S19											
S20											
S21											
S22											
S23											
S24											
S25											
S26											
S27											
S28											
S29											
S30											
S31											
S32	B	3'-6"	7'-0"		(E)						
S33											
S34											
S35											
S36											
S37											
S38											
S39											
S40											
S41											
S42	A	3'-0"	7'-0"		C	6/1/2 03	6/1/2 03	6/1/2 03		11	SEE S/5200
S43											
S44											
S45											
S46											
S47											
S48											
S49	A	3'-0"	7'-0"		C	6/1/2 03	6/1/2 03	6/1/2 03		23	SEE S/5200
S50											
S51											
S52											
S99											
S00											


DOOR AND FRAME SCHEDULE

DOOR NUMBER	DOOR			FRAME			PERIOD	HARDWARE SET	SIGN	REMARKS	
	TYPE	SIZE (EACH LEAF)	LOUVER	TYPE	DETAILS	DETAILS					
		W H	W H		LEFT JAMB	HEAD	RIGHT JAMB				
S08											
S09											
S10											
S11											
S12	B	3'-6"	7'-0"		(E)						
S13											
S14											
S15											
S49											
S50	B	3'-0"	6'-0"		B	2 5/8 W/2 03	1/2 03	2 1/2 03		6	BOY'S HANDBALL SIGN
S51											
S52											
S53	B	3'-0"	7'-0"		B	2 5/8 W/2 03	1/2 03	2 5/8 W/2 03		6	GIRLS HANDBALL SIGN
S54	B1	3'-6"	7'-0"		(E)						
S55	B	3'-6"	7'-0"		(E)						
S56											
S57	B	3'-6"	7'-0"		(E)						
S58											
S59	B	3'-6"	7'-0"		(E)						
S60											
S61											
S62											
S99											
S00											

DOOR TYPES

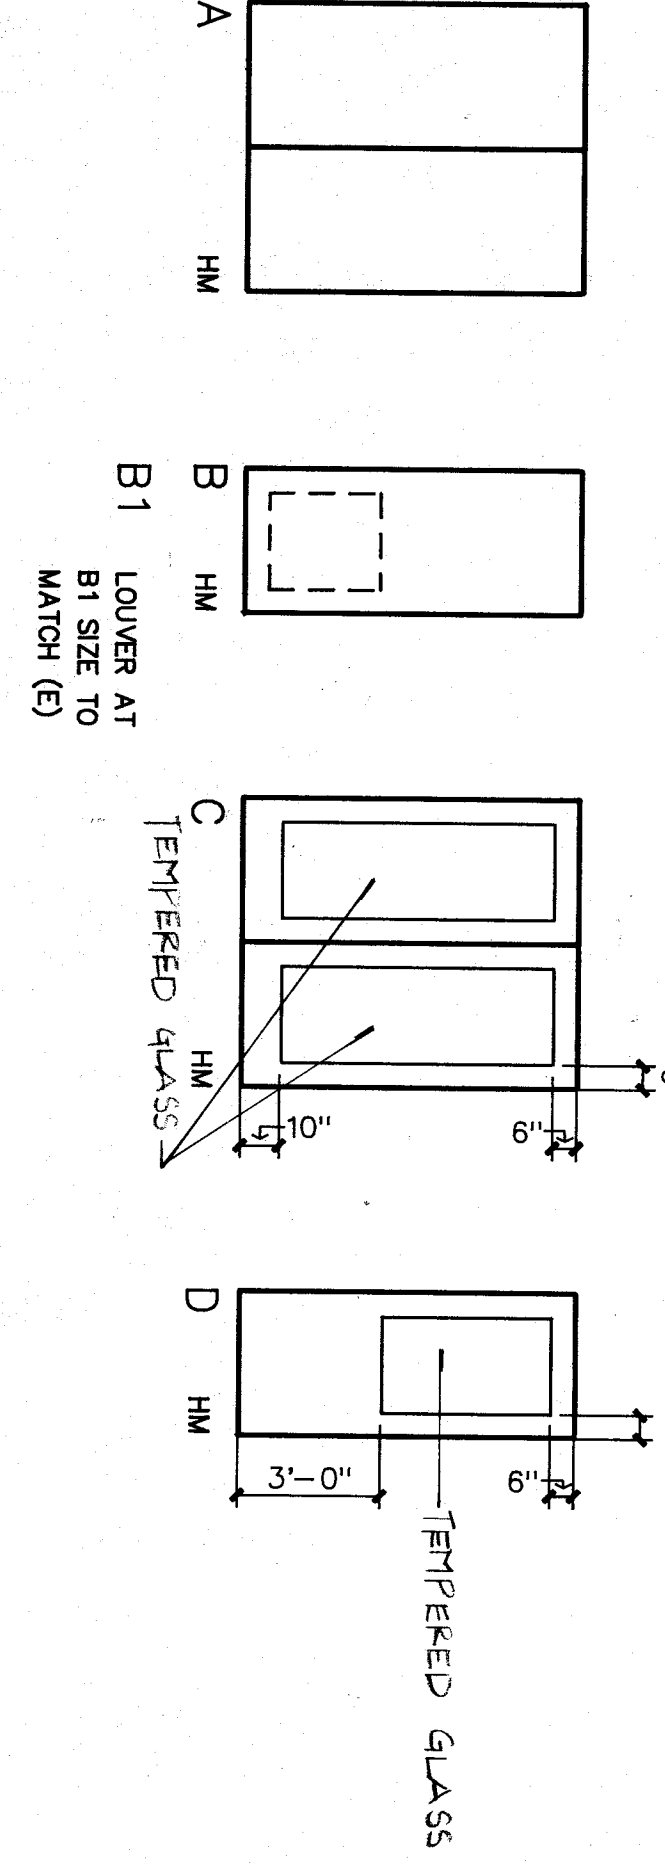

FRAME TYPES

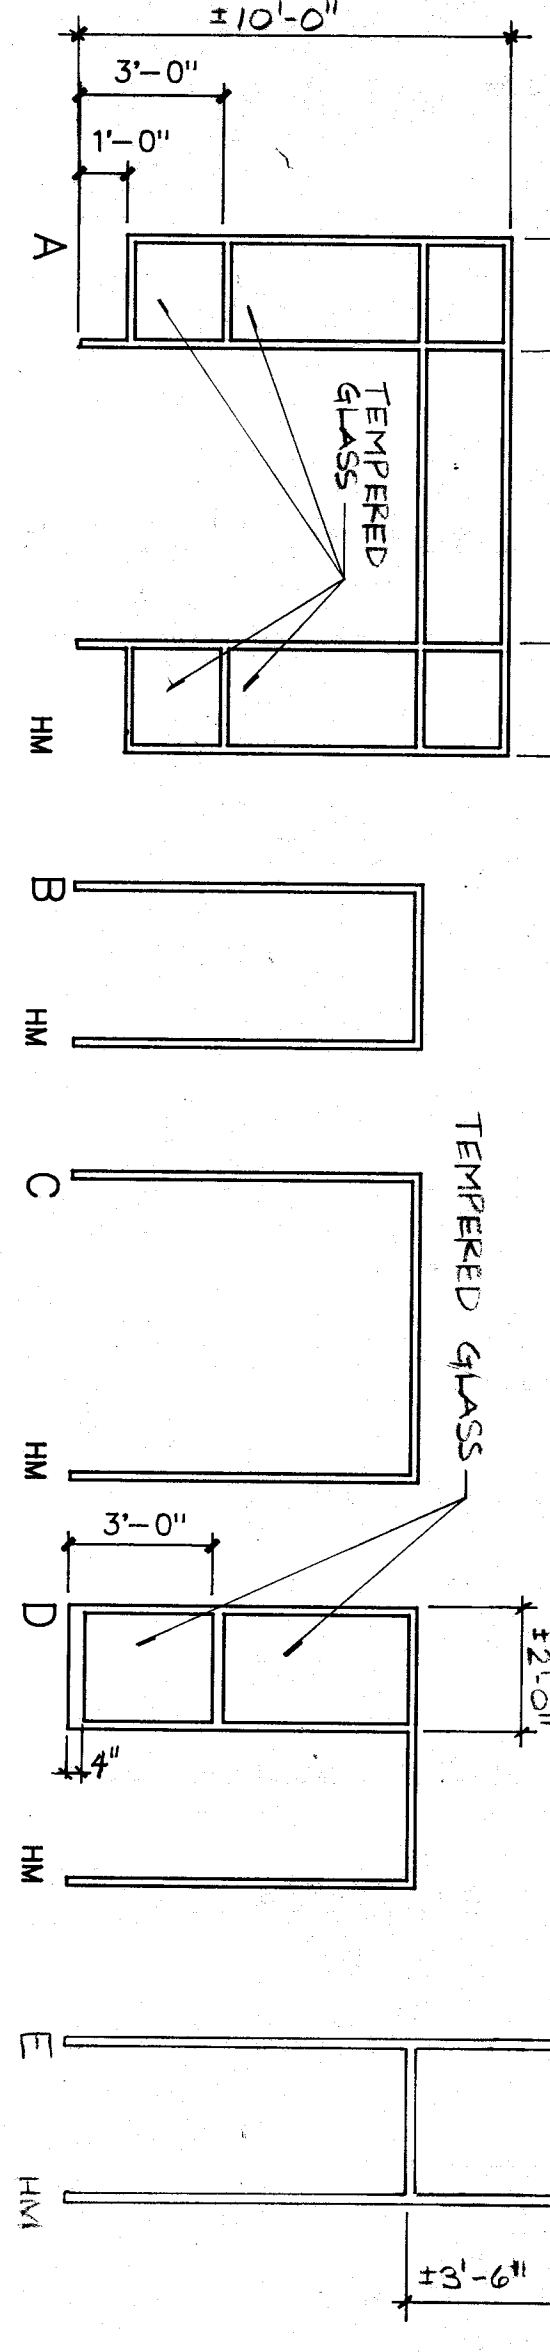

GENERAL NOTES

- A1 U.O.N. ALL HOLLOW METAL DOOR/WINDOW FRAMES SHALL RECEIVE PAINT
- A2 U.O.N. ALL HOLLOW METAL DOOR/WINDOW FRAME ASSEMBLIES SHALL BE 2" O.D. SEE DETAILS ON A-202 AND A-210
- A3 U.O.N. ALL HOLLOW METAL DOORS SHALL RECEIVE ENAMEL PAINT
- A4 U.O.N. ALL GLASS PANELED IN EXTERIOR DOORS ARE TINTED INSULATED GLASS-TEMPERED.
- A5 ALL RATED DOORS TO BE POSITIVE LATCHING AND SELF-CLOSING. "LABEL" SHALL MEAN "ASSEMBLY" AS DEFINED IN SECTION 4309(B), UBC 85.</