




C.L. GATE HINGE
SCALE: 3/8"=1'-0"
BY SITE CONTRACTOR
A10 8

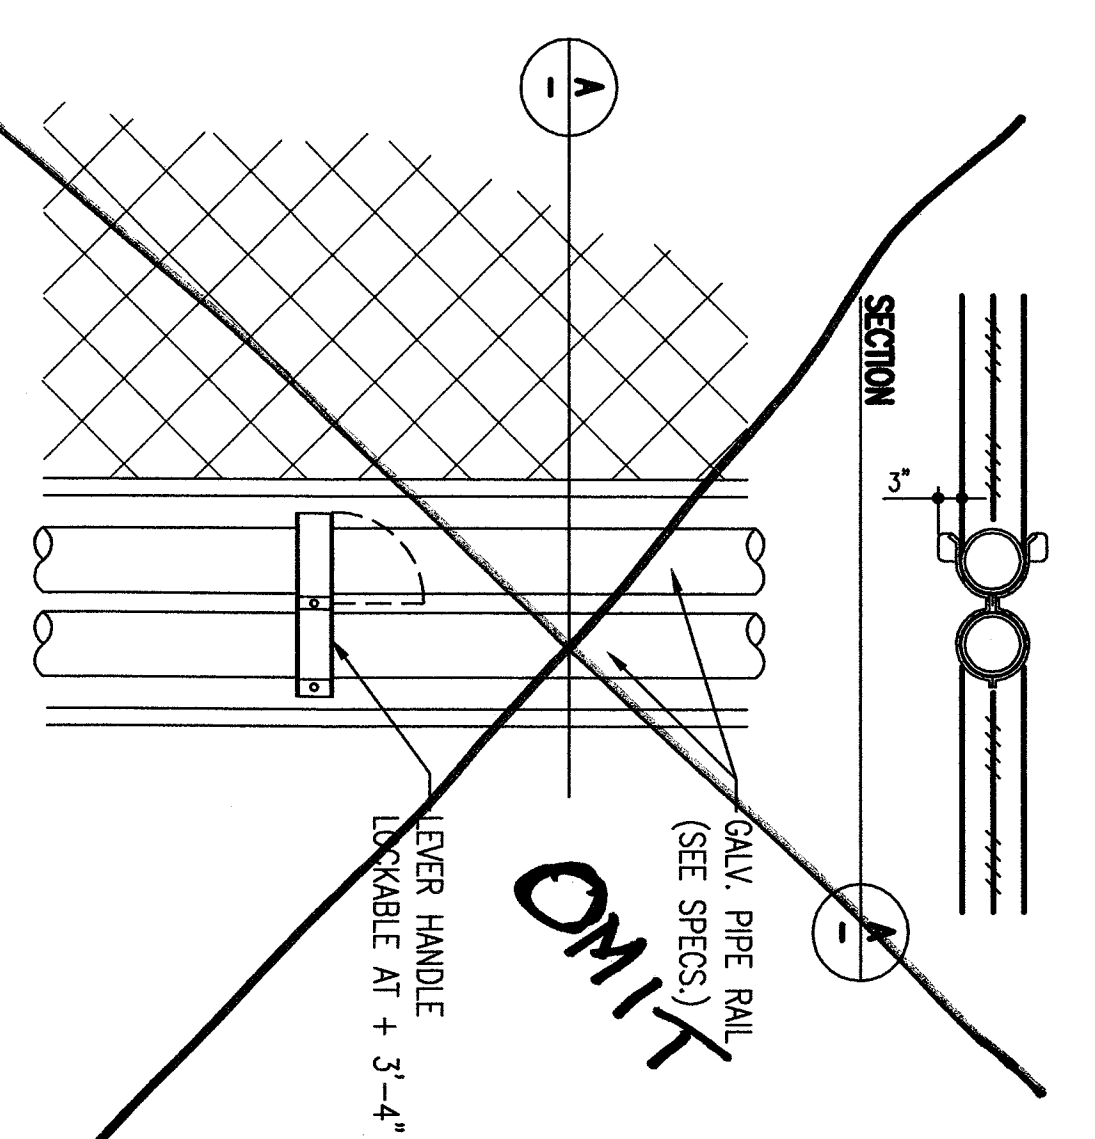


C.L. GATE LEVER
SCALE: 3/8"=1'-0"
BY SITE CONTRACTOR
A10 7

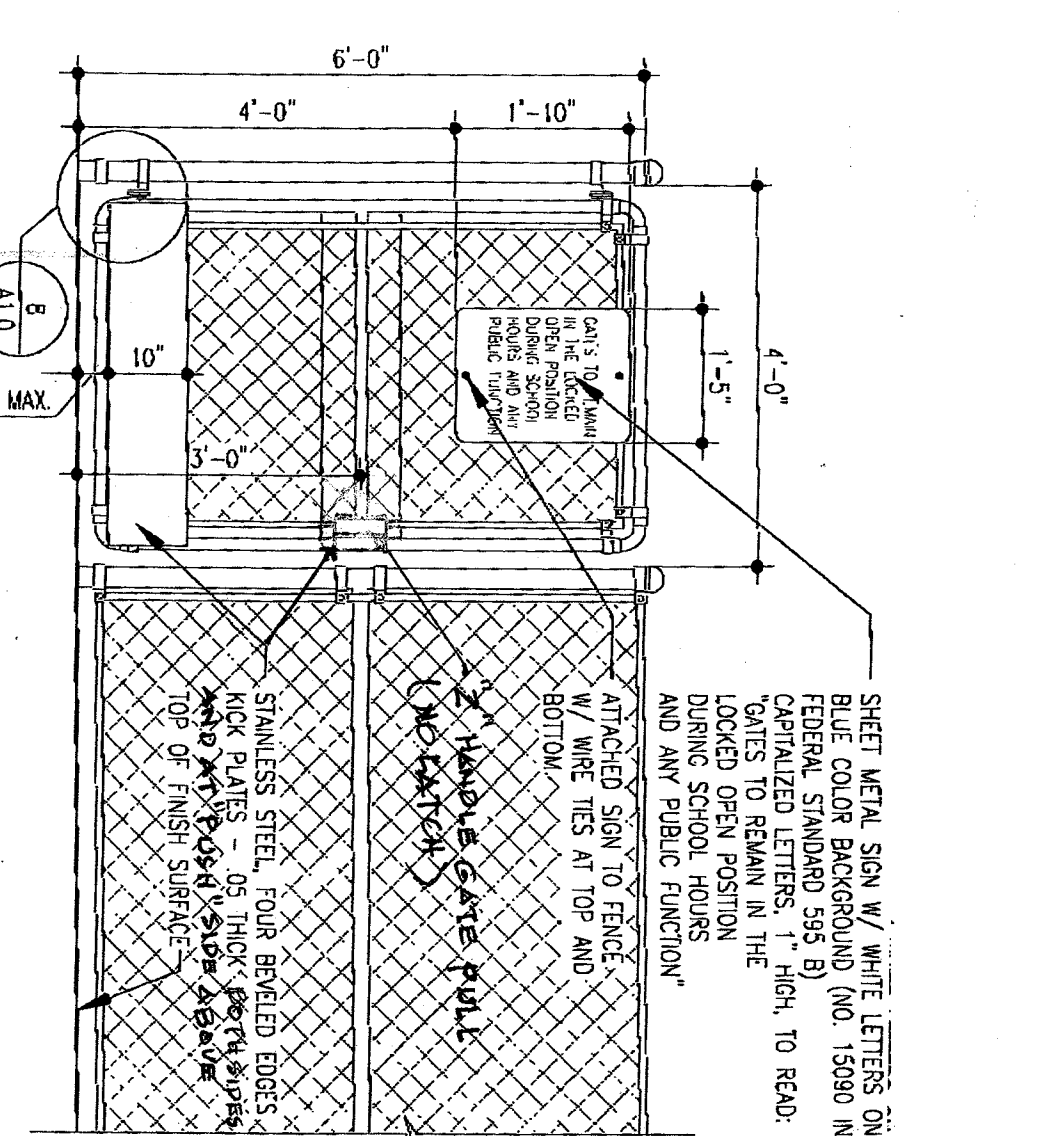


GATE SIGN ON PATH OF TRAVEL
SCALE: 1/2"=1'-0"
BY SITE CONTRACTOR
A10 6

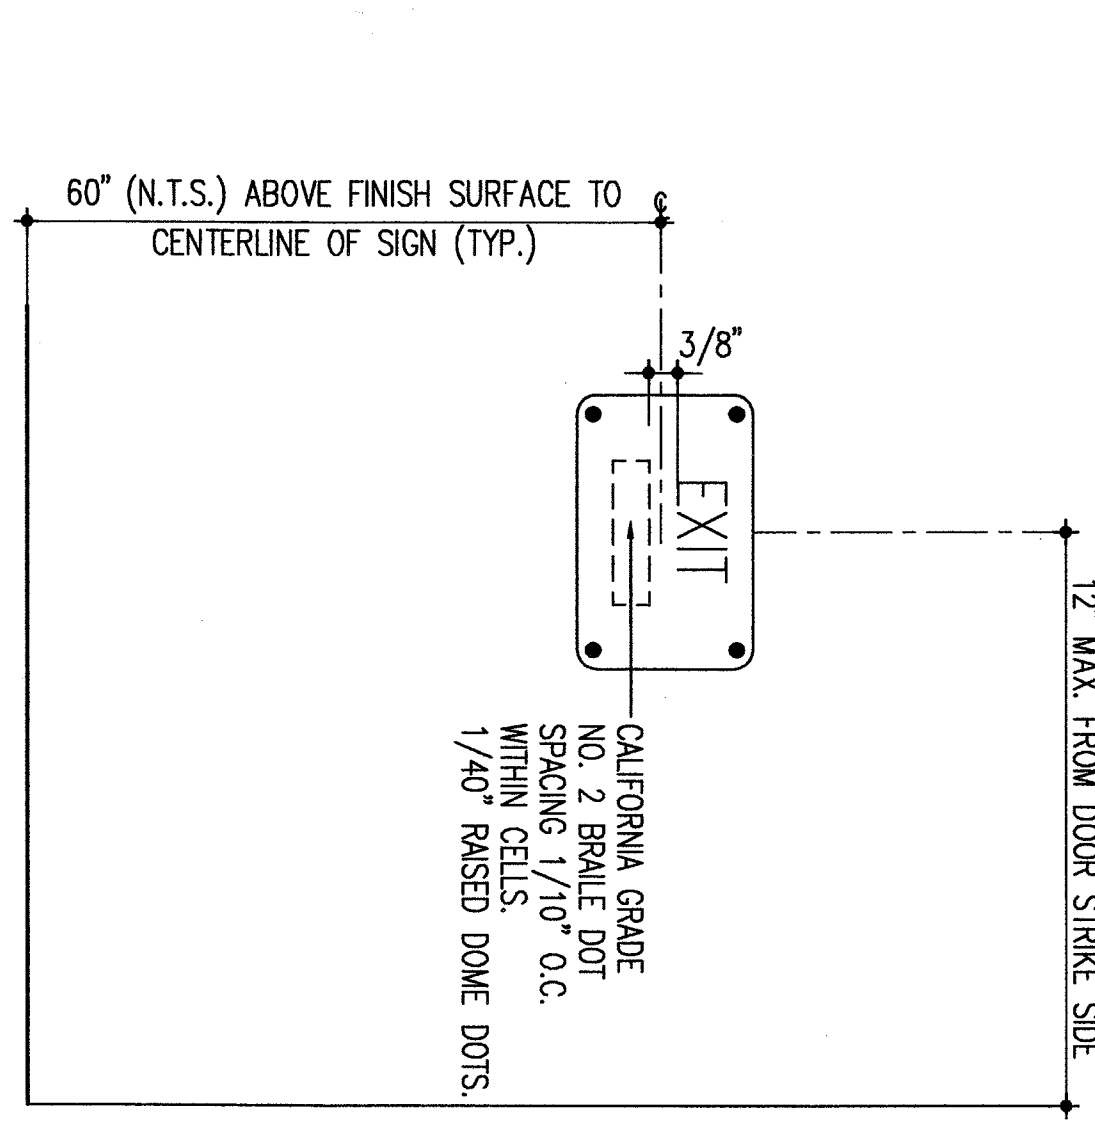


INTERIOR EXIT SIGNAGE
SCALE: 3/4"=1'-0"
BY SITE CONTRACTOR
A10 5

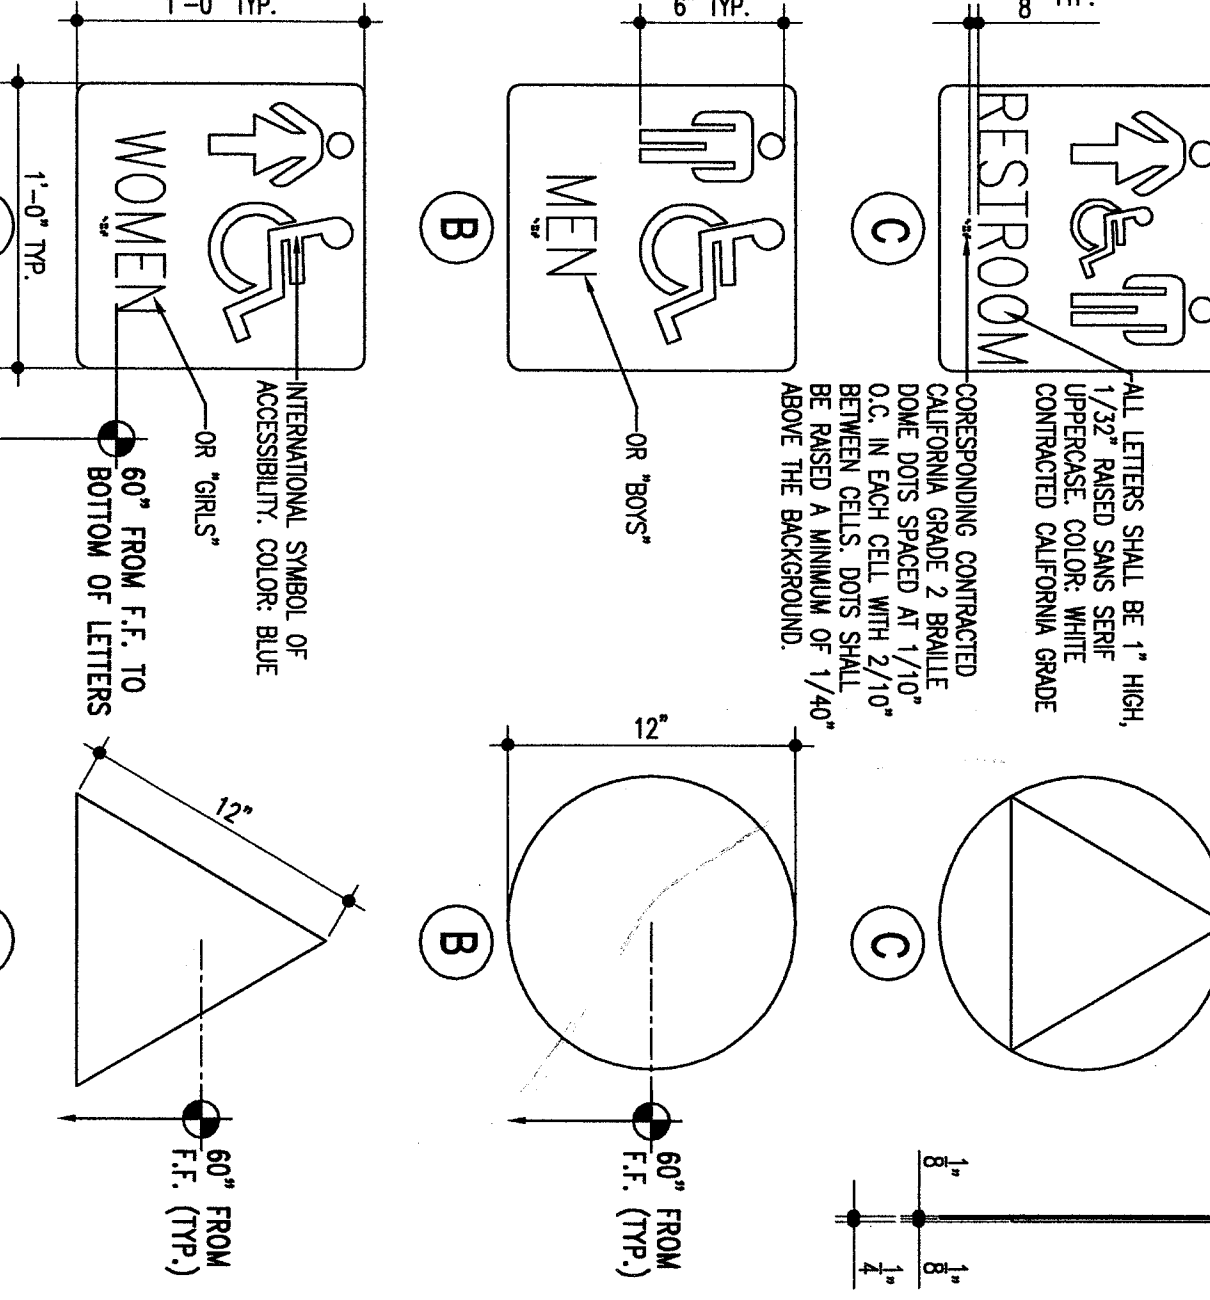


RESTROOM SIGNAGE
SCALE: 3/4"=1'-0"
BY SITE CONTRACTOR
A10 3

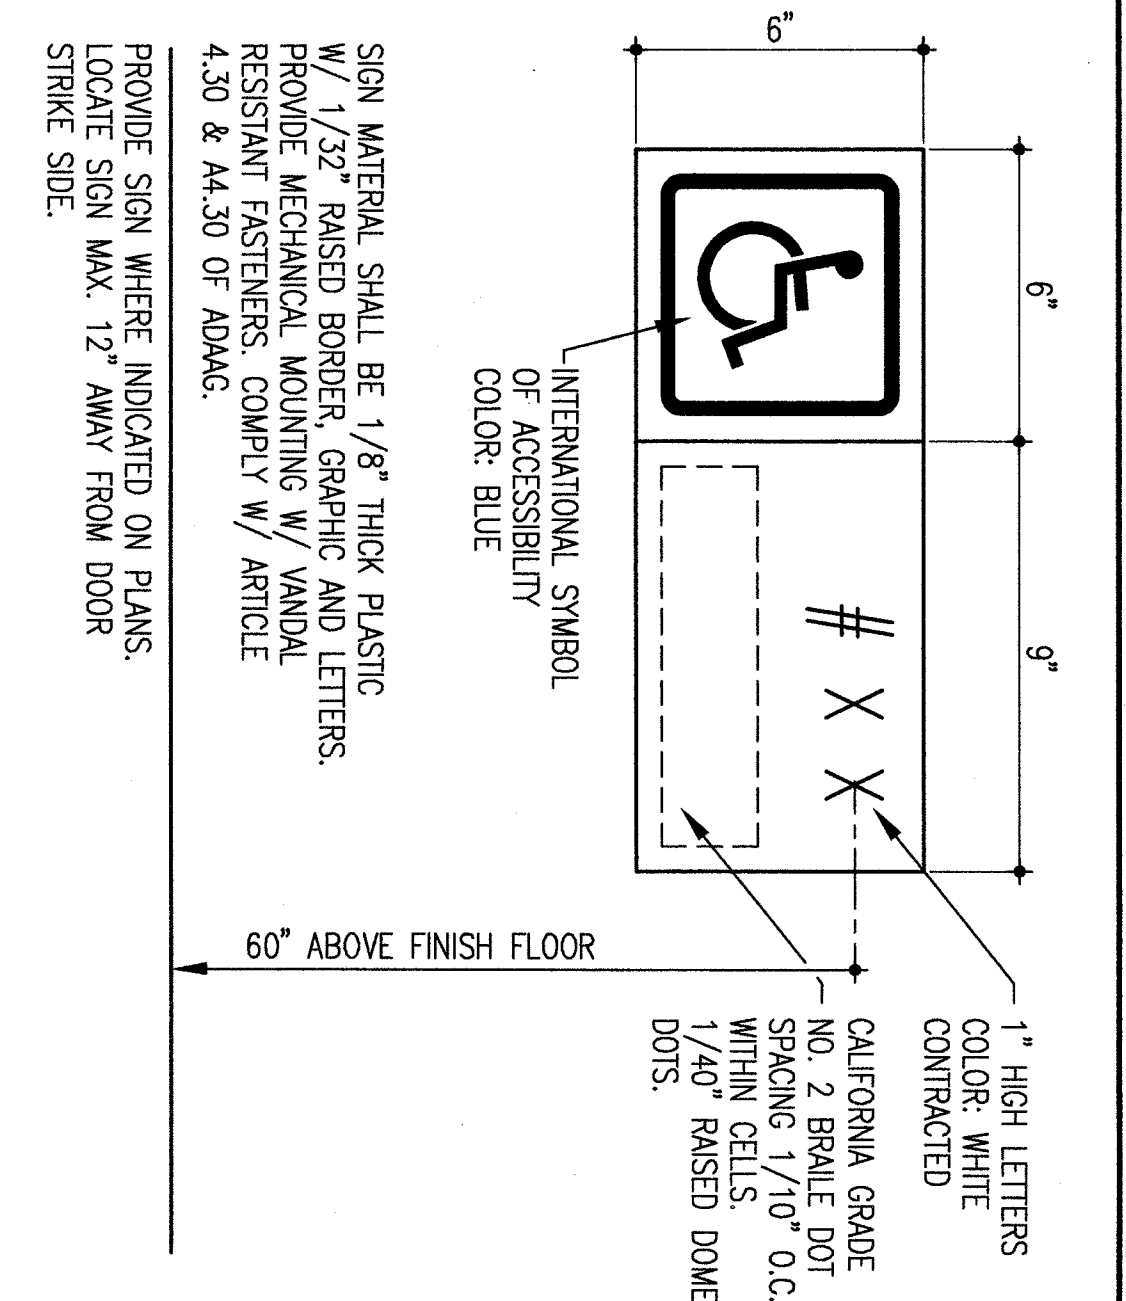

ROOM SIGNAGE
SCALE: 3/4"=1'-0"
BY SITE CONTRACTOR
A10 4

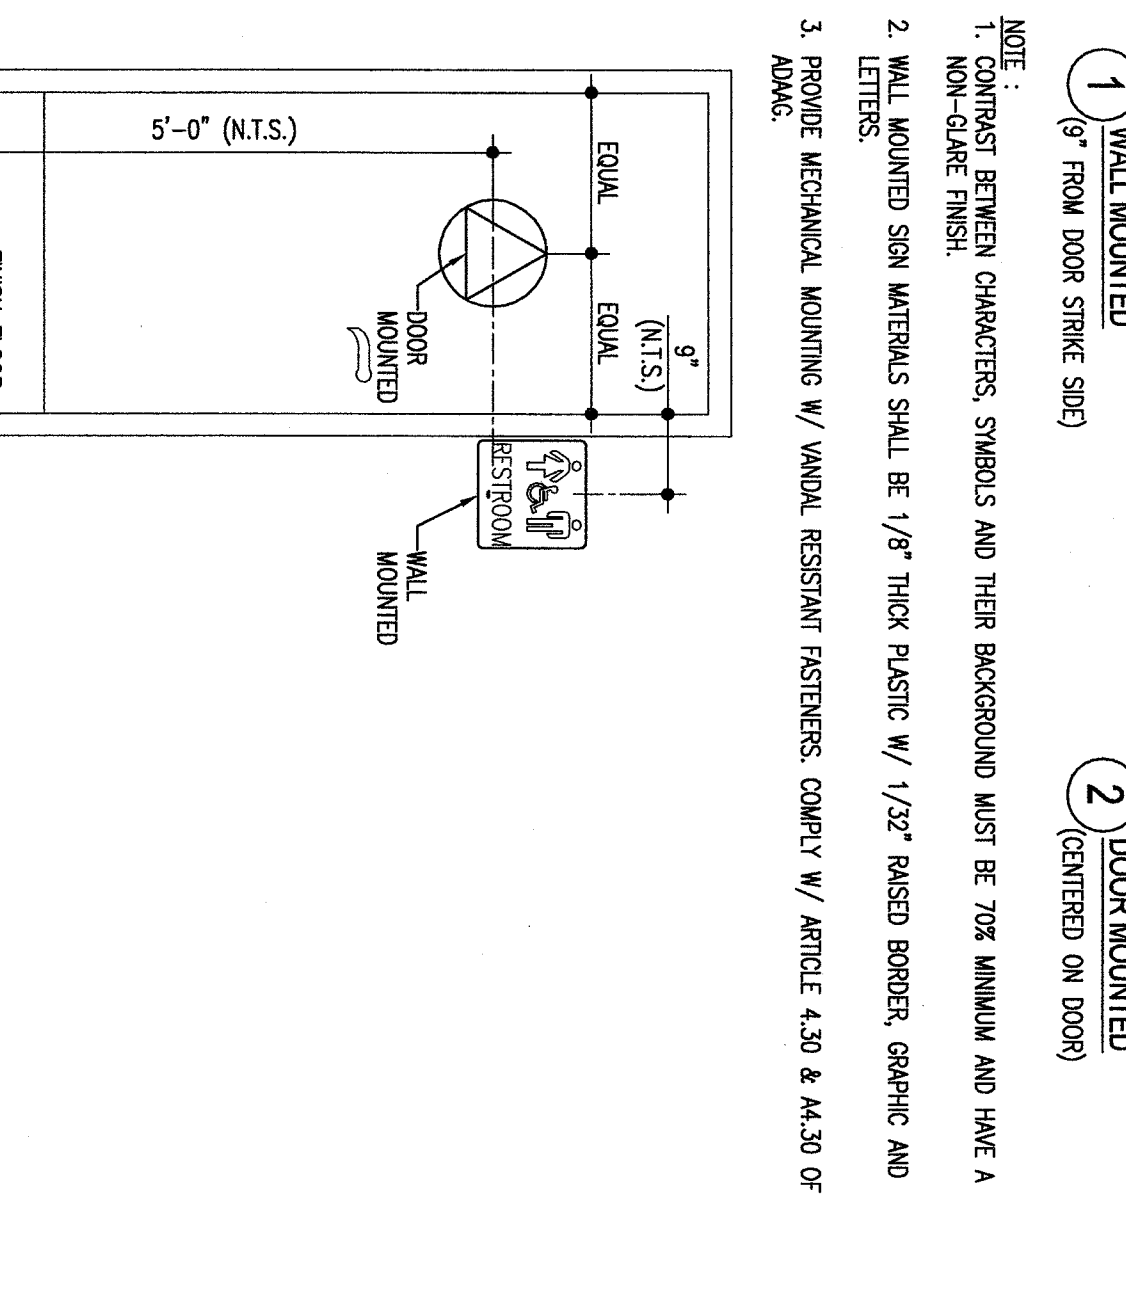


ACCESSIBLE SIGNAGE FOR RESTROOM
SCALE: 1 1/2"=1'-0"
BY SITE CONTRACTOR
A10 3

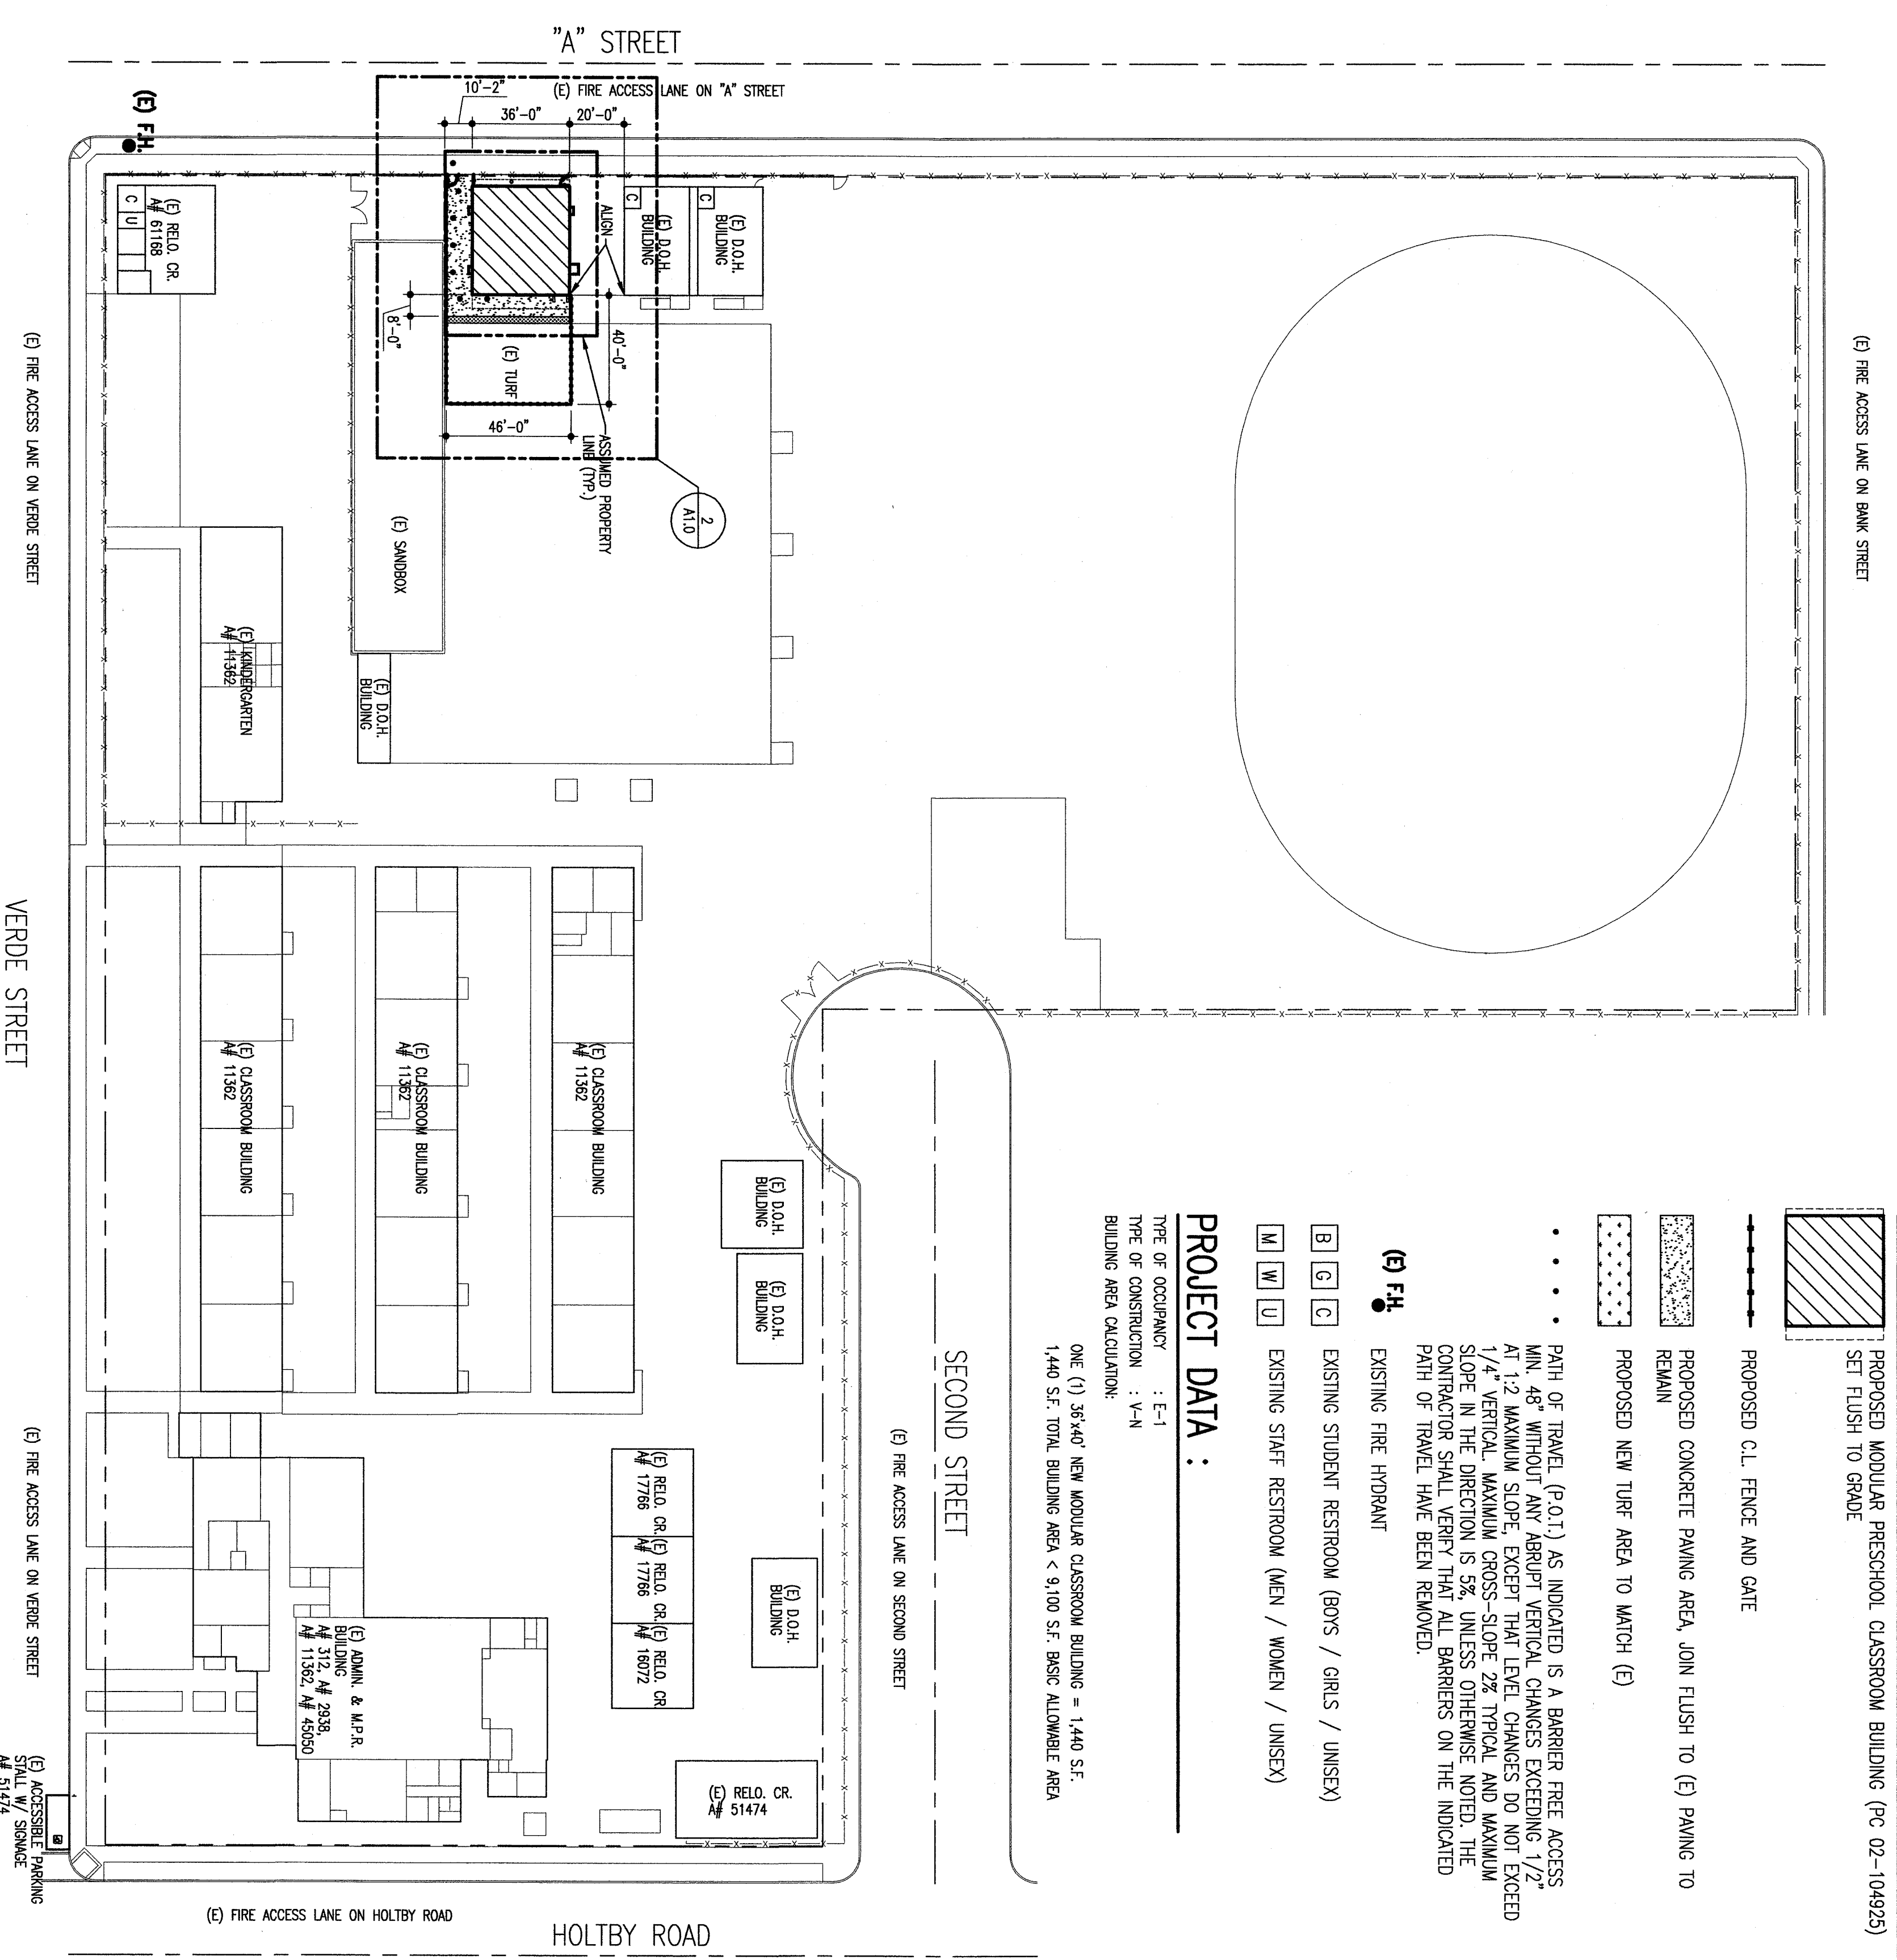


SITE PLAN LEGEND :
 PROPOSED MODULAR PRESCHOOL CLASSROOM BUILDING (PC 02-104925)
 SET FLUSH TO GRADE
 PROPOSED C.L. FENCE AND GATE
 PROPOSED CONCRETE PAVING AREA, JOIN FLUSH TO (E) PAVING TO REMAIN
 PROPOSED NEW TURF AREA TO MATCH (E)
 PATH OF TRAVEL (P.O.T.) AS INDICATED IS A BARRIER FREE ACCESS MIN. 48" WITHOUT ANY ABRUPT VERTICAL CHANGES EXCEEDING 1/2" AT 12" MAXIMUM SLOPE, EXCEPT THAT LEVEL CHANGES DO NOT EXCEED 1/2" PER 12" SLOPE. EXCEPT WHERE SHOWN OTHERWISE, ALL HORIZONTAL SLOPE PERCENTS SHALL BE AS SHOWN. UNLESS OTHERWISE SHOWN, ALL SLOPE CONTRACTOR SHALL VERIFY THAT ALL BARRIERS ON THE INDICATED PATH OF TRAVEL HAVE BEEN REMOVED.
 (E) FH EXISTING FIRE HYDRANT
 (B) (G) (C) EXISTING STUDENT RESTROOM (BOYS / GIRLS / UNISEX)
 (M) (W) (U) EXISTING STAFF RESTROOM (MEN / WOMEN / UNISEX)
PROJECT DATA :
 TYPE OF OCCUPANCY : E-1
 TYPE OF CONSTRUCTION : V-A-N
 BUILDING AREA CALCULATION :
 ONE (1) 36'x40' NEW MODULAR CLASSROOM BUILDING = 1,440 S.F.
 1,440 S.F. TOTAL BUILDING AREA < 9,100 S.F. BASIC ALLOWABLE AREA


SITE PLAN - ROOSEVELT E.S.
SCALE: 1"=40'-0"

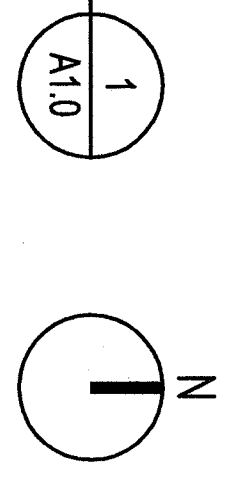


DISA - A.C.S. NOTE
 A WAIVER TO PROVIDE ACCESSIBLE PARKING SPALL FOR THIS APPLICATION HAS BEEN GRANTED BY RON VAUGHN, SENIOR ARCHITECT ACCESS COMPLIANCE SECTION ON 5/19/2007 DUE TO FINANCIAL HARDSHIP. SEE DISTRICT'S LETTER ON DISA FILE.

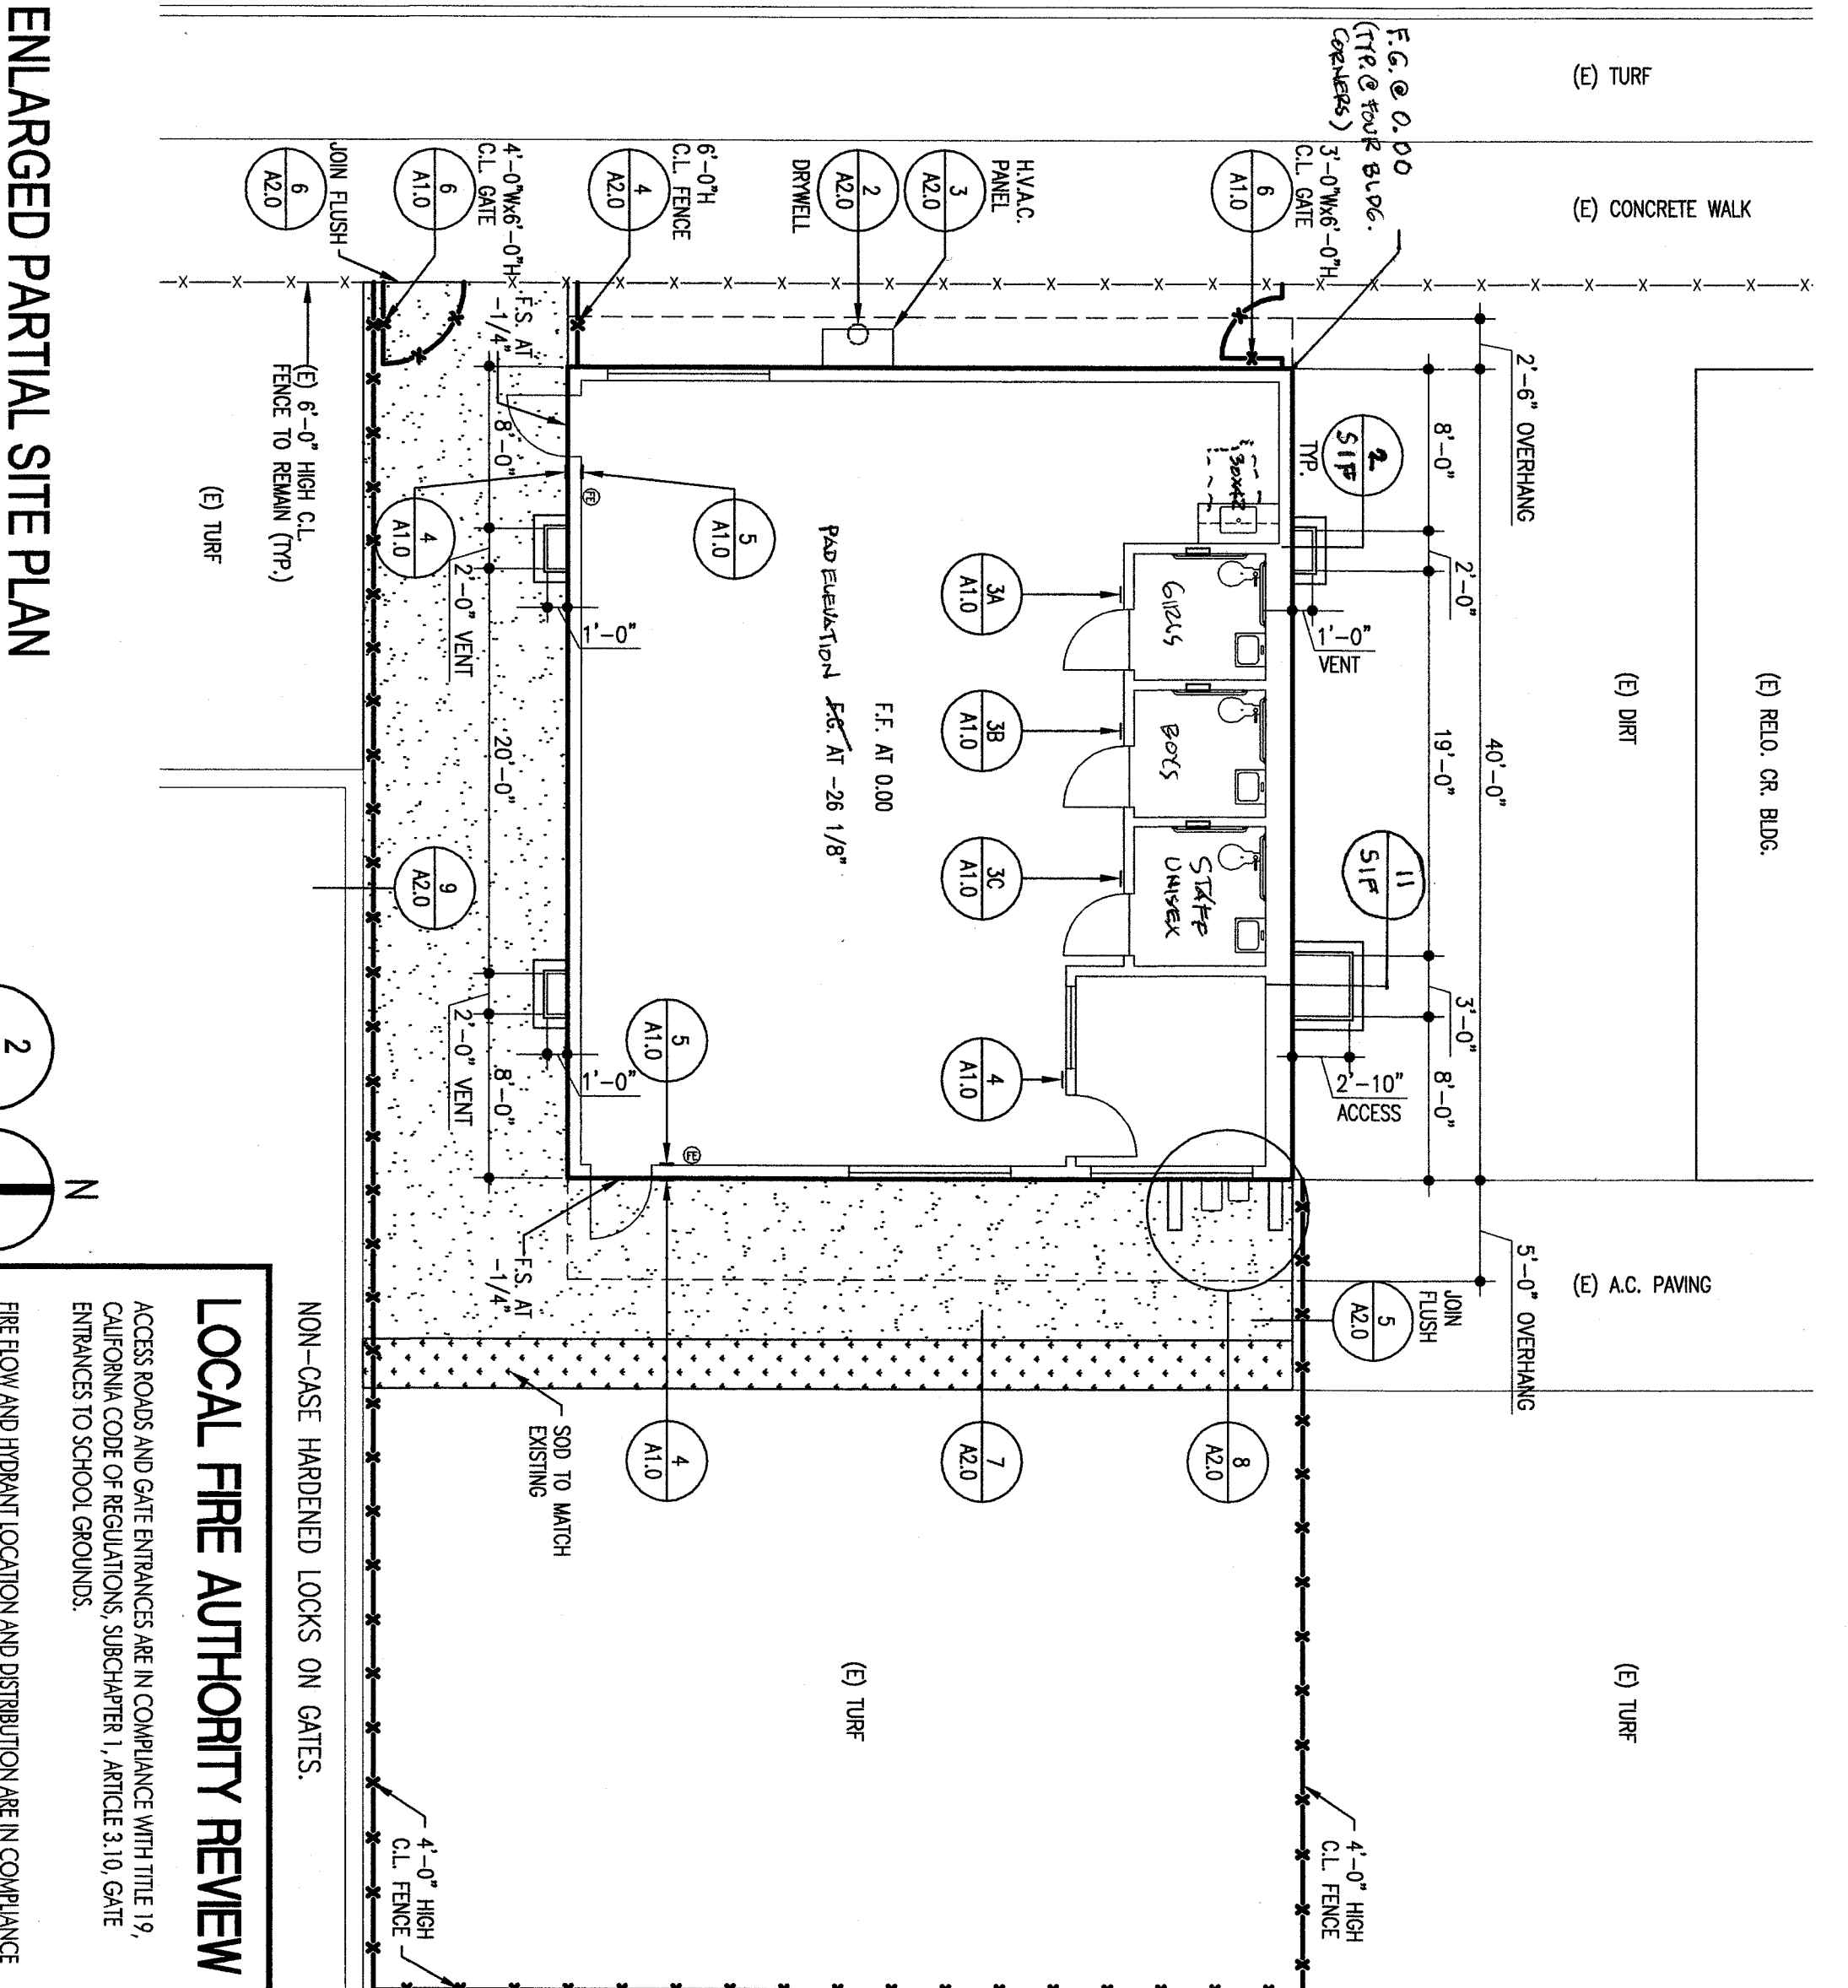

ENLARGED PARTIAL SITE PLAN
SCALE: 1/8"=1'-0"

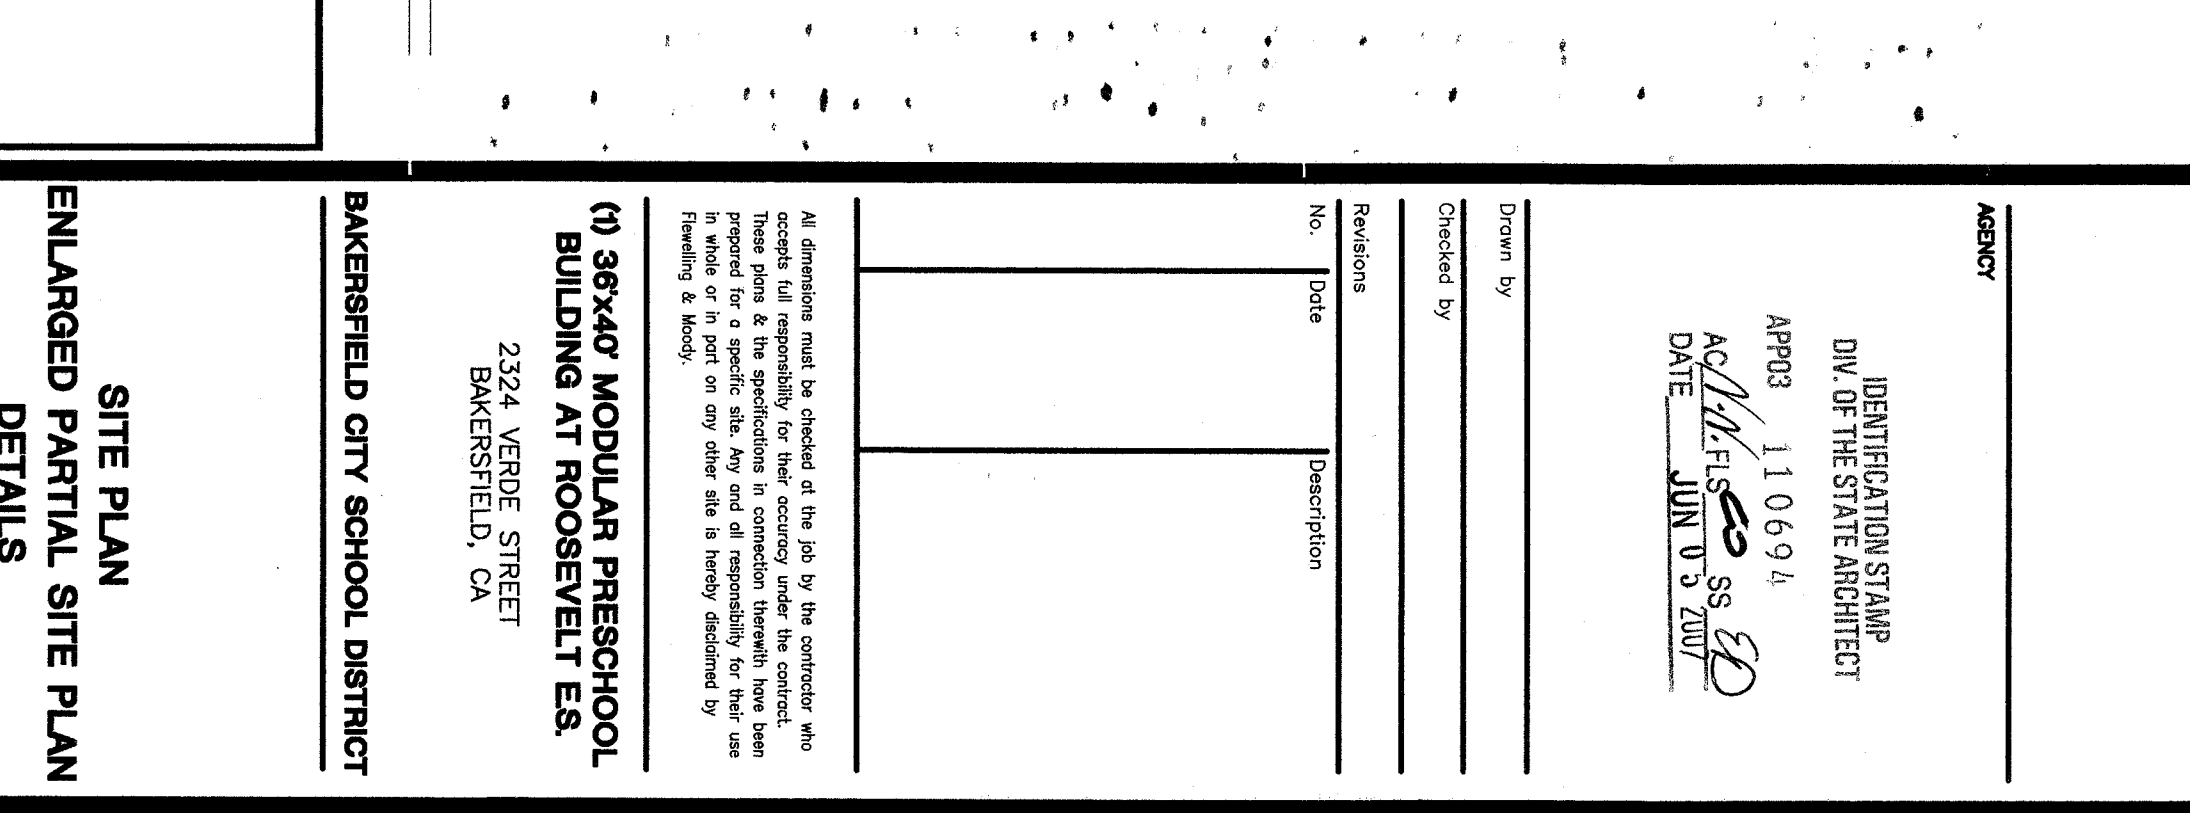


LOCAL FIRE AUTHORITY REVIEW
SCALE: 1/8"=1'-0"

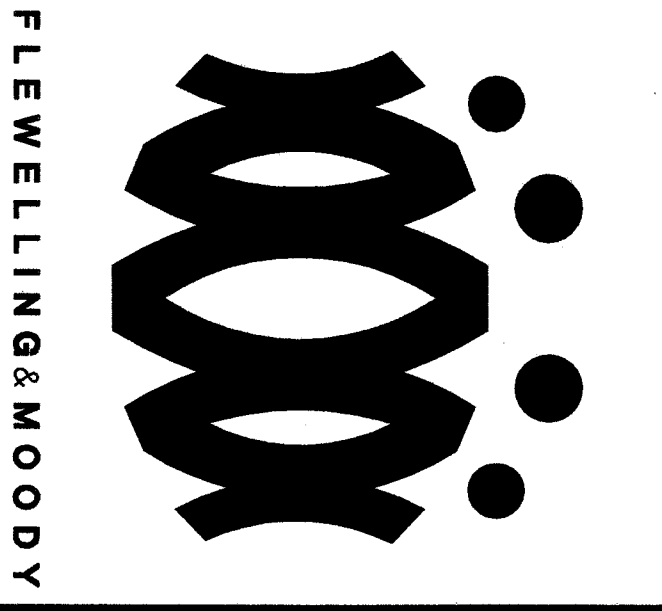

HEADQUARTERS OFFICE:
 91 South Lane Avenue, Suite 100
 Berkeley, CA 94702 FAX: 415.841.8177
 E-MAIL: flewelling@flewellingmoody.com

ANTIOCH VALLEY OFFICE:
 1025 West Leland Boulevard
 94540-0771 FAX: 925.562.2843
 E-MAIL: flewelling@flewellingmoody.com

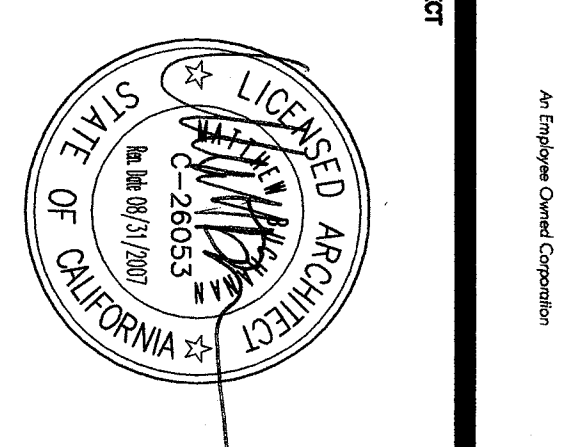

ARCHITECT:
 FLEWELLING & MOODY

CONSULTANT:
 ARCHITECTURE
 DENISE PATRICK SHARP
 DIV. OF THE STATE ARCHITECT
 APPROX. 110694
 ARCHITECT'S SEAL
 DATE: JUN 03 2007

APPROVALS:

APPROVED BY: _____ DATE: _____

APPROVED BY: _____ DATE: _____

ENLARGED PARTIAL SITE PLAN
 SITE PLAN
 ENLARGED PARTIAL SITE PLAN
 DETAILS
 A10

Job No. 2211
 Date 5-10-2007