

American Modular Systems Inc.

(2) 36 X 40 RELOCATABLE CLASSROOM
BAKERSFIELD CITY SCHOOL
ROOSEVELT E.S

TEST AND INSPECTION LIST

TESTING LABORATORY: _____ DATE: _____
NAME: _____
DISTRICT/OWNER: _____ APPLICATION NO. _____
DIVISION-FILE NO. _____
ARCHITECT: _____
INSPECTIONS
OPS 103-1 (R 11/85)

STATE OF CALIFORNIA
DEPT. OF GENERAL SERVICES
DIVISION OF THE
STATE ARCHITECT
STRUCTURAL
TESTS
AND
INSPECTIONS

The following tests and inspections, as checked, will be required as detailed in applicable specifications.


TESTING ITEM	TESTING METHOD	TESTING FREQUENCY	TESTING LOCATION	TESTING METHOD	TESTING FREQUENCY	TESTING LOCATION
COMPACTED FILL	TESTING METHOD	TESTING FREQUENCY	TESTING LOCATION	TESTING METHOD	TESTING FREQUENCY	TESTING LOCATION
REINFORCING STEEL	TESTING METHOD	TESTING FREQUENCY	TESTING LOCATION	TESTING METHOD	TESTING FREQUENCY	TESTING LOCATION
STRUCTURAL STEEL	TESTING METHOD	TESTING FREQUENCY	TESTING LOCATION	TESTING METHOD	TESTING FREQUENCY	TESTING LOCATION
BRICK AND BLOCK	TESTING METHOD	TESTING FREQUENCY	TESTING LOCATION	TESTING METHOD	TESTING FREQUENCY	TESTING LOCATION
GLUED LAMINATED STRUCTURAL LUMBER	TESTING METHOD	TESTING FREQUENCY	TESTING LOCATION	TESTING METHOD	TESTING FREQUENCY	TESTING LOCATION
3 1/2" x 3 1/2" x 1/4" SQ. COL.	TESTING METHOD	TESTING FREQUENCY	TESTING LOCATION	TESTING METHOD	TESTING FREQUENCY	TESTING LOCATION
N-1	GENERAL NOTES AND SPECIFICATIONS
1	FLOOR PLAN & NOTES
2	EXTERIOR ELEVATIONS
3	CEILING GRID, DETAILS AND NOTES
4	INTERIOR ELEVATIONS AND OPTIONS
S1E	CONCRETE FOUNDATION PLANS & NOTES
S1F	50 PSF FLOOR LIVE LOAD +20 PSF PART. LOAD
S2	CONCRETE FOUNDATION DETAILS
S2A	FLOOR FRAMING PLAN AND DETAILS
S2A	BUILDING SECTIONS AND WALL DETAILS
S3	ROOF FRAMING PLAN AND DETAILS
S3A	ROOF SECTIONS & DETAILS
S4	WALL FRAMING ELEVATIONS AND FRAMING DETAILS
M1	MECHANICAL PLAN, DETAILS & NOTES
M2	MANDATORY MEASURES
E1	ELECTRICAL PLAN & NOTES

BUILDING DATA
CLASSROOMS

OCCUPANCY: E-1/B
TYPE OF CONSTRUCTION: V - NON-RATED
WIND LOAD (80 MPH EXPOSURE C): 21 LBS./SQ FT
FLOOR LIVE LOAD: 50 LBS. + 20 LBS./SQ. FT.
ROOF LIVE LOAD: 20 LBS./SQ FT (REDUCIBLE)
BUILDING AREA: 1440 SQ FT
CLIMATE ZONES: 1-16
2001 CALIFORNIA BUILDING STANDARDS ADMINISTRATIVE CODE (PART 1, TITLE 24, CSR)
2001 CALIFORNIA BUILDING CODE, VOLUMES 1, 2 AND 3 (PART 2, TITLE 24, CSR)
(1997 EDITION UNIFORM BUILDING CODE WITH 2001 CALIFORNIA AMENDMENTS)
2004 CALIFORNIA ELECTRICAL CODE (PART 3, TITLE 24, CSR)
2002 EDITION NATIONAL ELECTRICAL CODE WITH 2001 CALIFORNIA AMENDMENTS)
2001 CALIFORNIA MECHANICAL CODE (PART 4, TITLE 24, CSR)
(2000 EDITION IMDO UNIFORM MECHANICAL CODE WITH 2001 CALIFORNIA AMENDMENTS)
(2000 EDITION IMDO UNIFORM PLUMBING CODE WITH 2001 CALIFORNIA AMENDMENTS)
2005 CALIFORNIA ENERGY CODE (PART 6, TITLE 24, CSR)
2001 CALIFORNIA ELEVATOR SAFETY CONSTRUCTION CODE (PART 7, TITLE 24, CSR)
2001 CALIFORNIA FIRE CODE (PART 9, TITLE 24, CSR)
2001 CALIFORNIA REFERENCED STANDARDS CODE (PART 12, TITLE 24, CSR)
NFPA 13, 1999 EDITION, THE INSTALLATION OF AUTOMATIC SPRINKLER SYSTEMS, AS AMENDED
NFPA 14, 2000 EDITION, INSTALLATION OF STANDPIPE, PRIVATE HYDRANT AND HOSE SYSTEMS
NFPA 24, 1995 EDITION, INSTALLATION OF PRIVATE FIRE SERVICE MAINS AND THEIR APPURTENANCES
NFPA 72, 1999 EDITION, NATIONAL FIRE ALARM CODE, AS AMENDED
SYSTEM: (3) 12' X 40' MODULES
FOUNDATION: CONCRETE
SEISMIC: ZONE 4
SEISMIC SOURCE A DISTANCE FROM SEISMIC SOURCE 2 KM
SOIL TYPE S

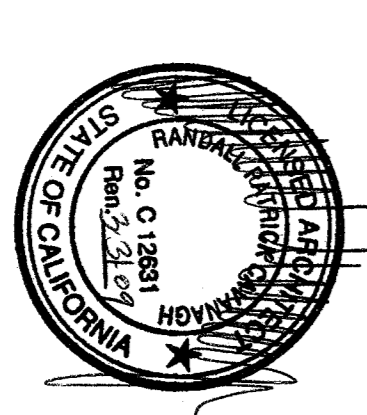

IDENTIFICATION STAMP
DW. OF THE STATE ARCHITECT
APR 03 110694
APR 4/4/03
DATE JUN 05 2007



American Modular Systems Inc.
757 Sparadale Ave, Van Nuys, CA 91411
(209)325-1921 Fax (209)955-7018
americanmodular.com

BASE ON PC 02-104925

JOB NO. _____
DATE: MAY 25, 2007
SHEET NUMBER
TS-1
BUILDING ORDER 1

SCANNED

SCANNED