
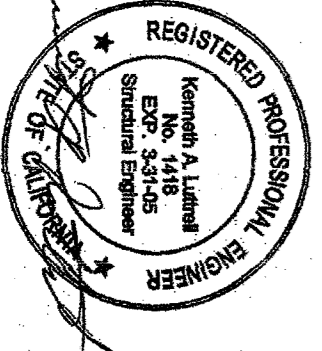


FLOOR JOIST SCHEDULE

LIVE LOAD	14 GA JOIST	12 GA JOIST
50-20 PSF	24" OC	48" OC
40-20 PSF	24" OC	48" OC

NOTES:
1. SEE SHEET S4 FOR TYPICAL WALL FRAMING.
2. SPACING IS TO CENTER LINE OF TYP. FLANGE.
3. PROVIDE 12 GA JOIST WHERE PARTITION BEAMS DIRECTLY OVER JOIST.

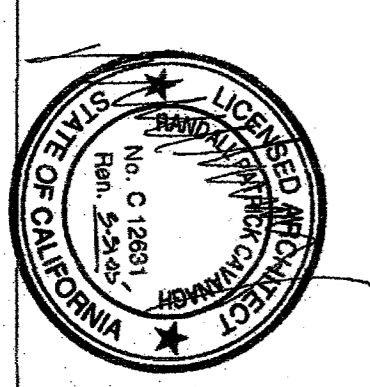


CUSTOMER:
RELOCATABLE CLASSROOM

DATE: 5/20/03
DRAWN BY: BBA
DESIGNED BY: WBP
CHECKED BY: WAL
SERIAL NO.:

REVISIONS

NO.	DATE	DESCRIPTION

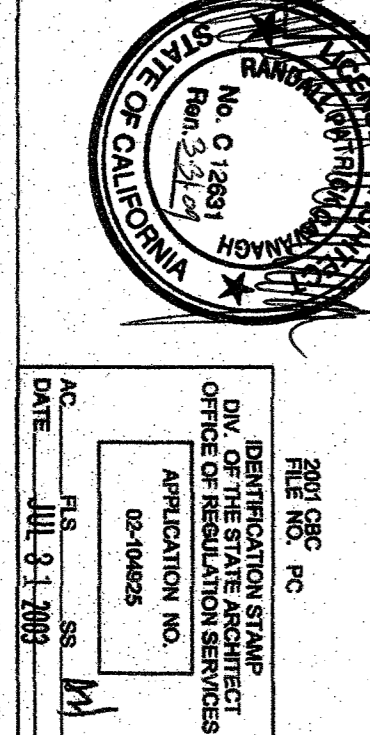

IDENTIFICATION STAMP
DW. OF THE STATE ARCHITECT
APR 03 11 06 94
AC FLS SS
DATE JUN 03 2007

PRODUCT NO.: 02156-02
SHEET NO.: S2