

MARK	DATE	REVISIONS
△		
△		
△		



CHECK AND VERIFY ALL DIMENSIONS BEFORE PROCEEDING WITH THE WORK. REPORT DISCREPANCIES TO THE ARCHITECT. ALL CONSTRUCTION SHALL CONFORM TO THE G.C.

ROOSEVELT ELEMENTARY SCHOOL
SITE IMPROVEMENTS FOR MODULAR CLASSROOM
 2324 VERDE STREET, BAKERSFIELD, CALIFORNIA
 FOR
 BAKERSFIELD CITY SCHOOL DISTRICT
 BAKERSFIELD, KERN COUNTY, CALIFORNIA, 93304

IDENTIFICATION STAMP
 DIV. OF THE STATE ARCHITECT
 OFFICE OF REGULATION SERVICES
 APR. 03-116979
 FILE 15-6
 AC. [initials] R.S. [initials] SS. [initials]
 DATE 4/13/16
 PTN - 63321-204




1601 NEW STINE ROAD, SUITE 280
 BAKERSFIELD, CA 93309
 PH: (661) 397-4377
 FAX: (661) 397-4378
 WWW.SCARCHITECT.COM

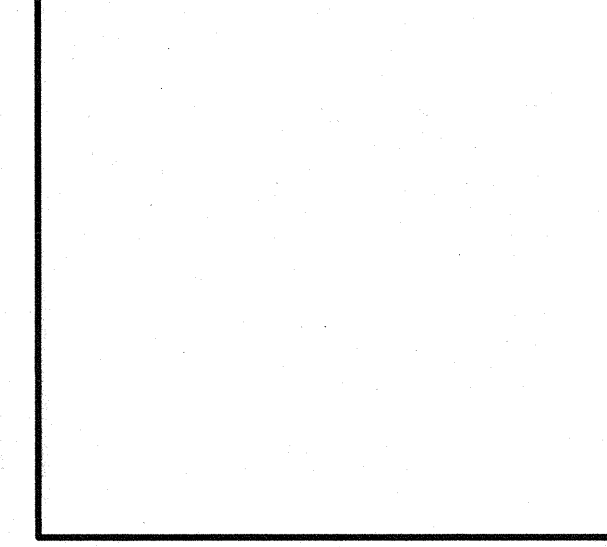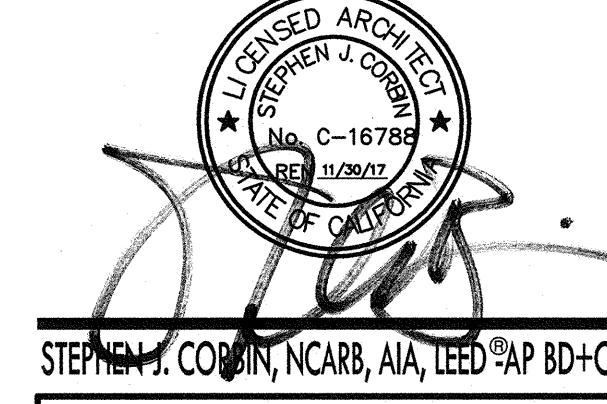


PARTIAL SITE PLAN

JOB NO. 1216
 DRAWN:
 CHECKED:
 DATE 4-13-2016
1.1
 OF 2 SHEETS

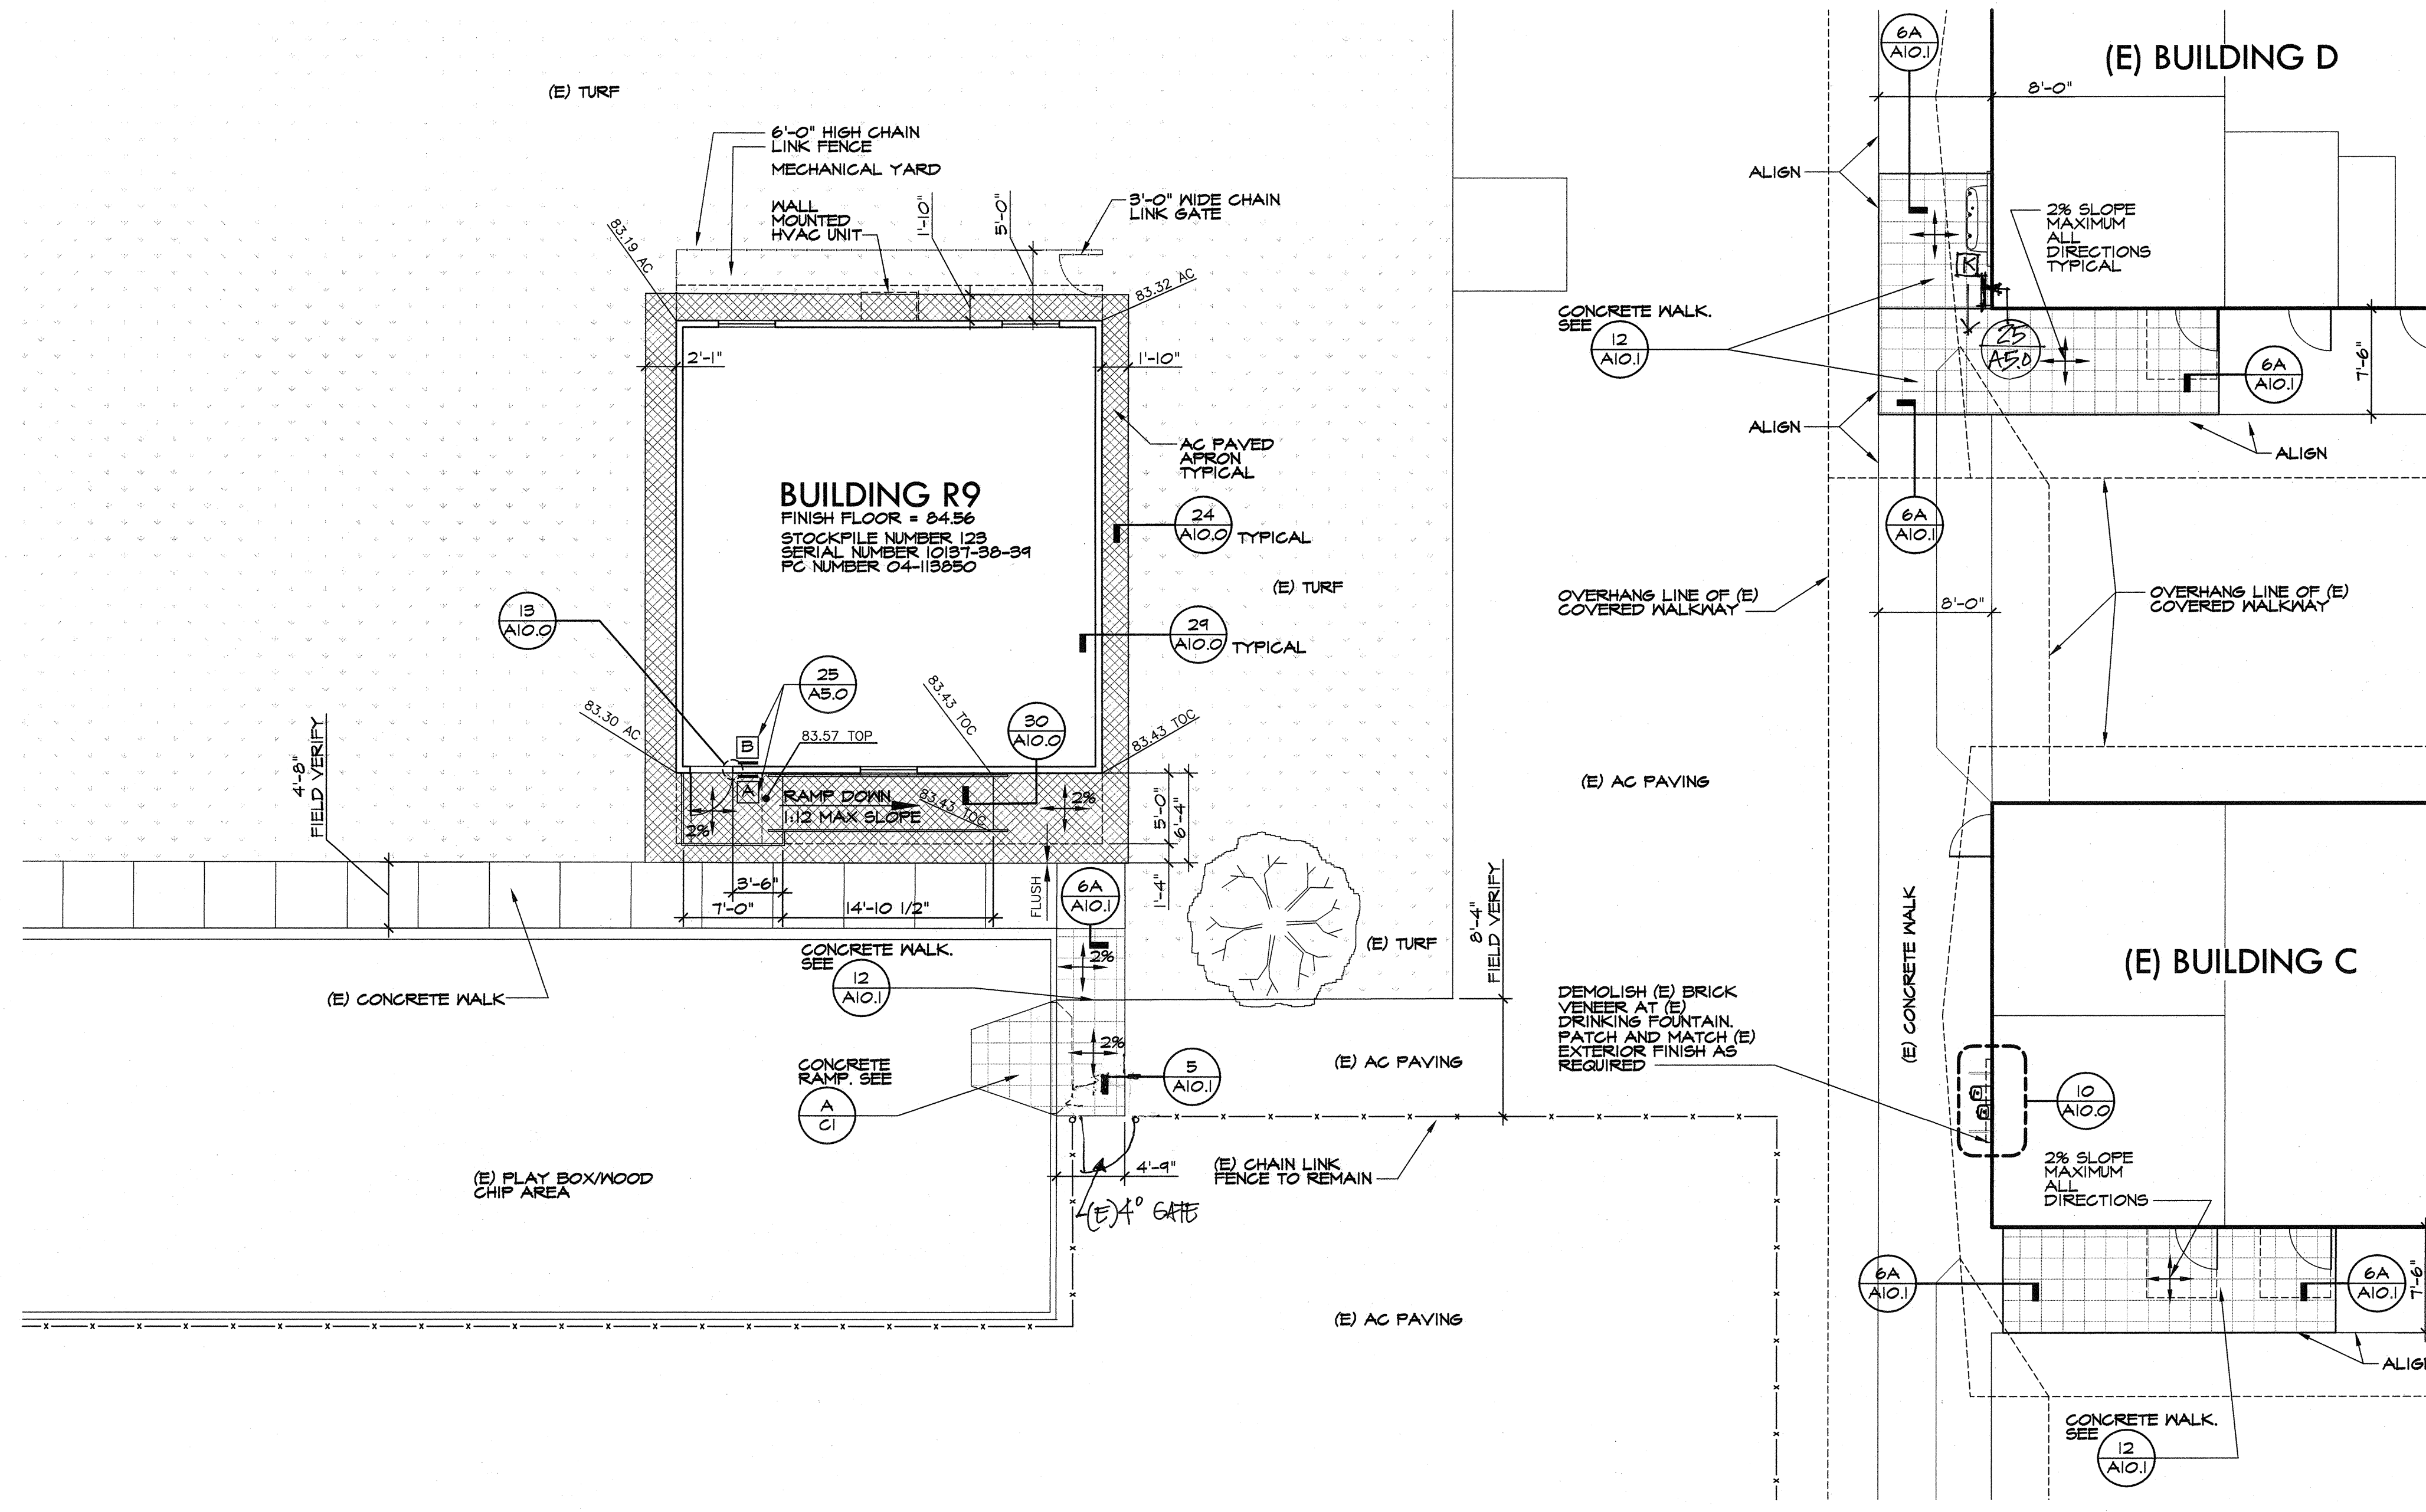

A PARTIAL SITE PLAN SCALE: 1/8"=1'-0"

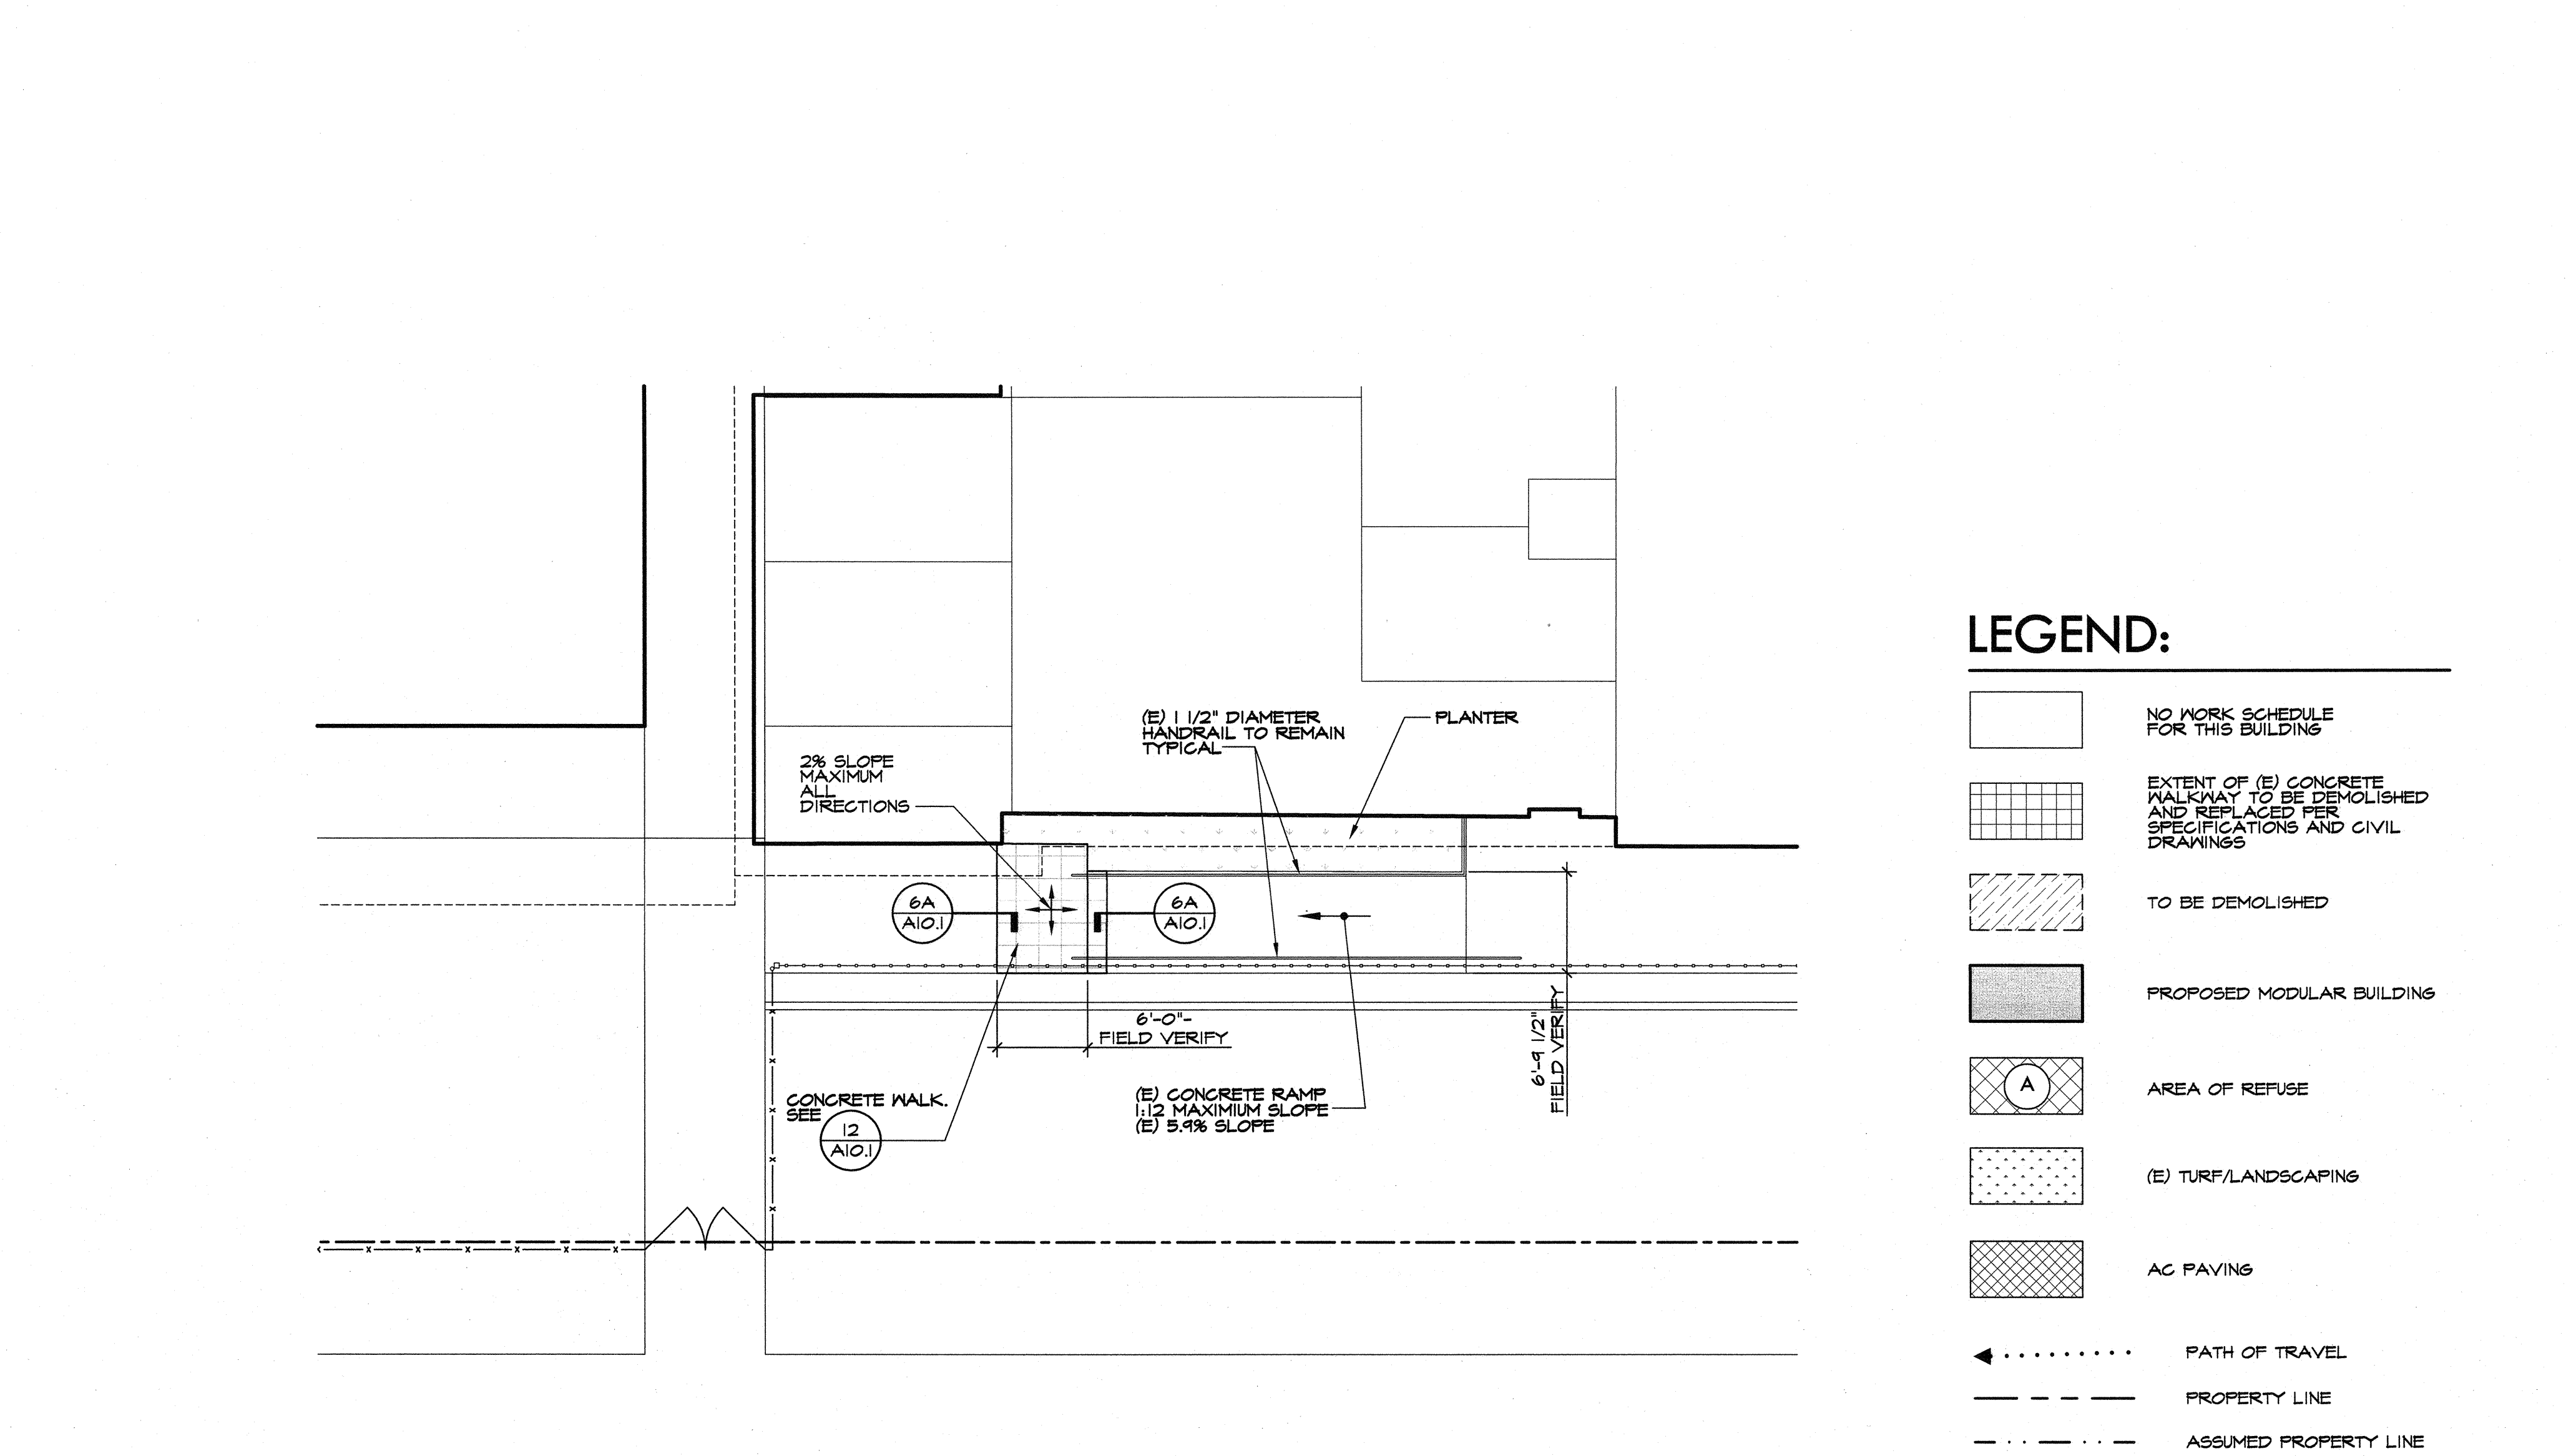

B PARTIAL SITE PLAN SCALE: 1/8"=1'-0"

