


NOT USED

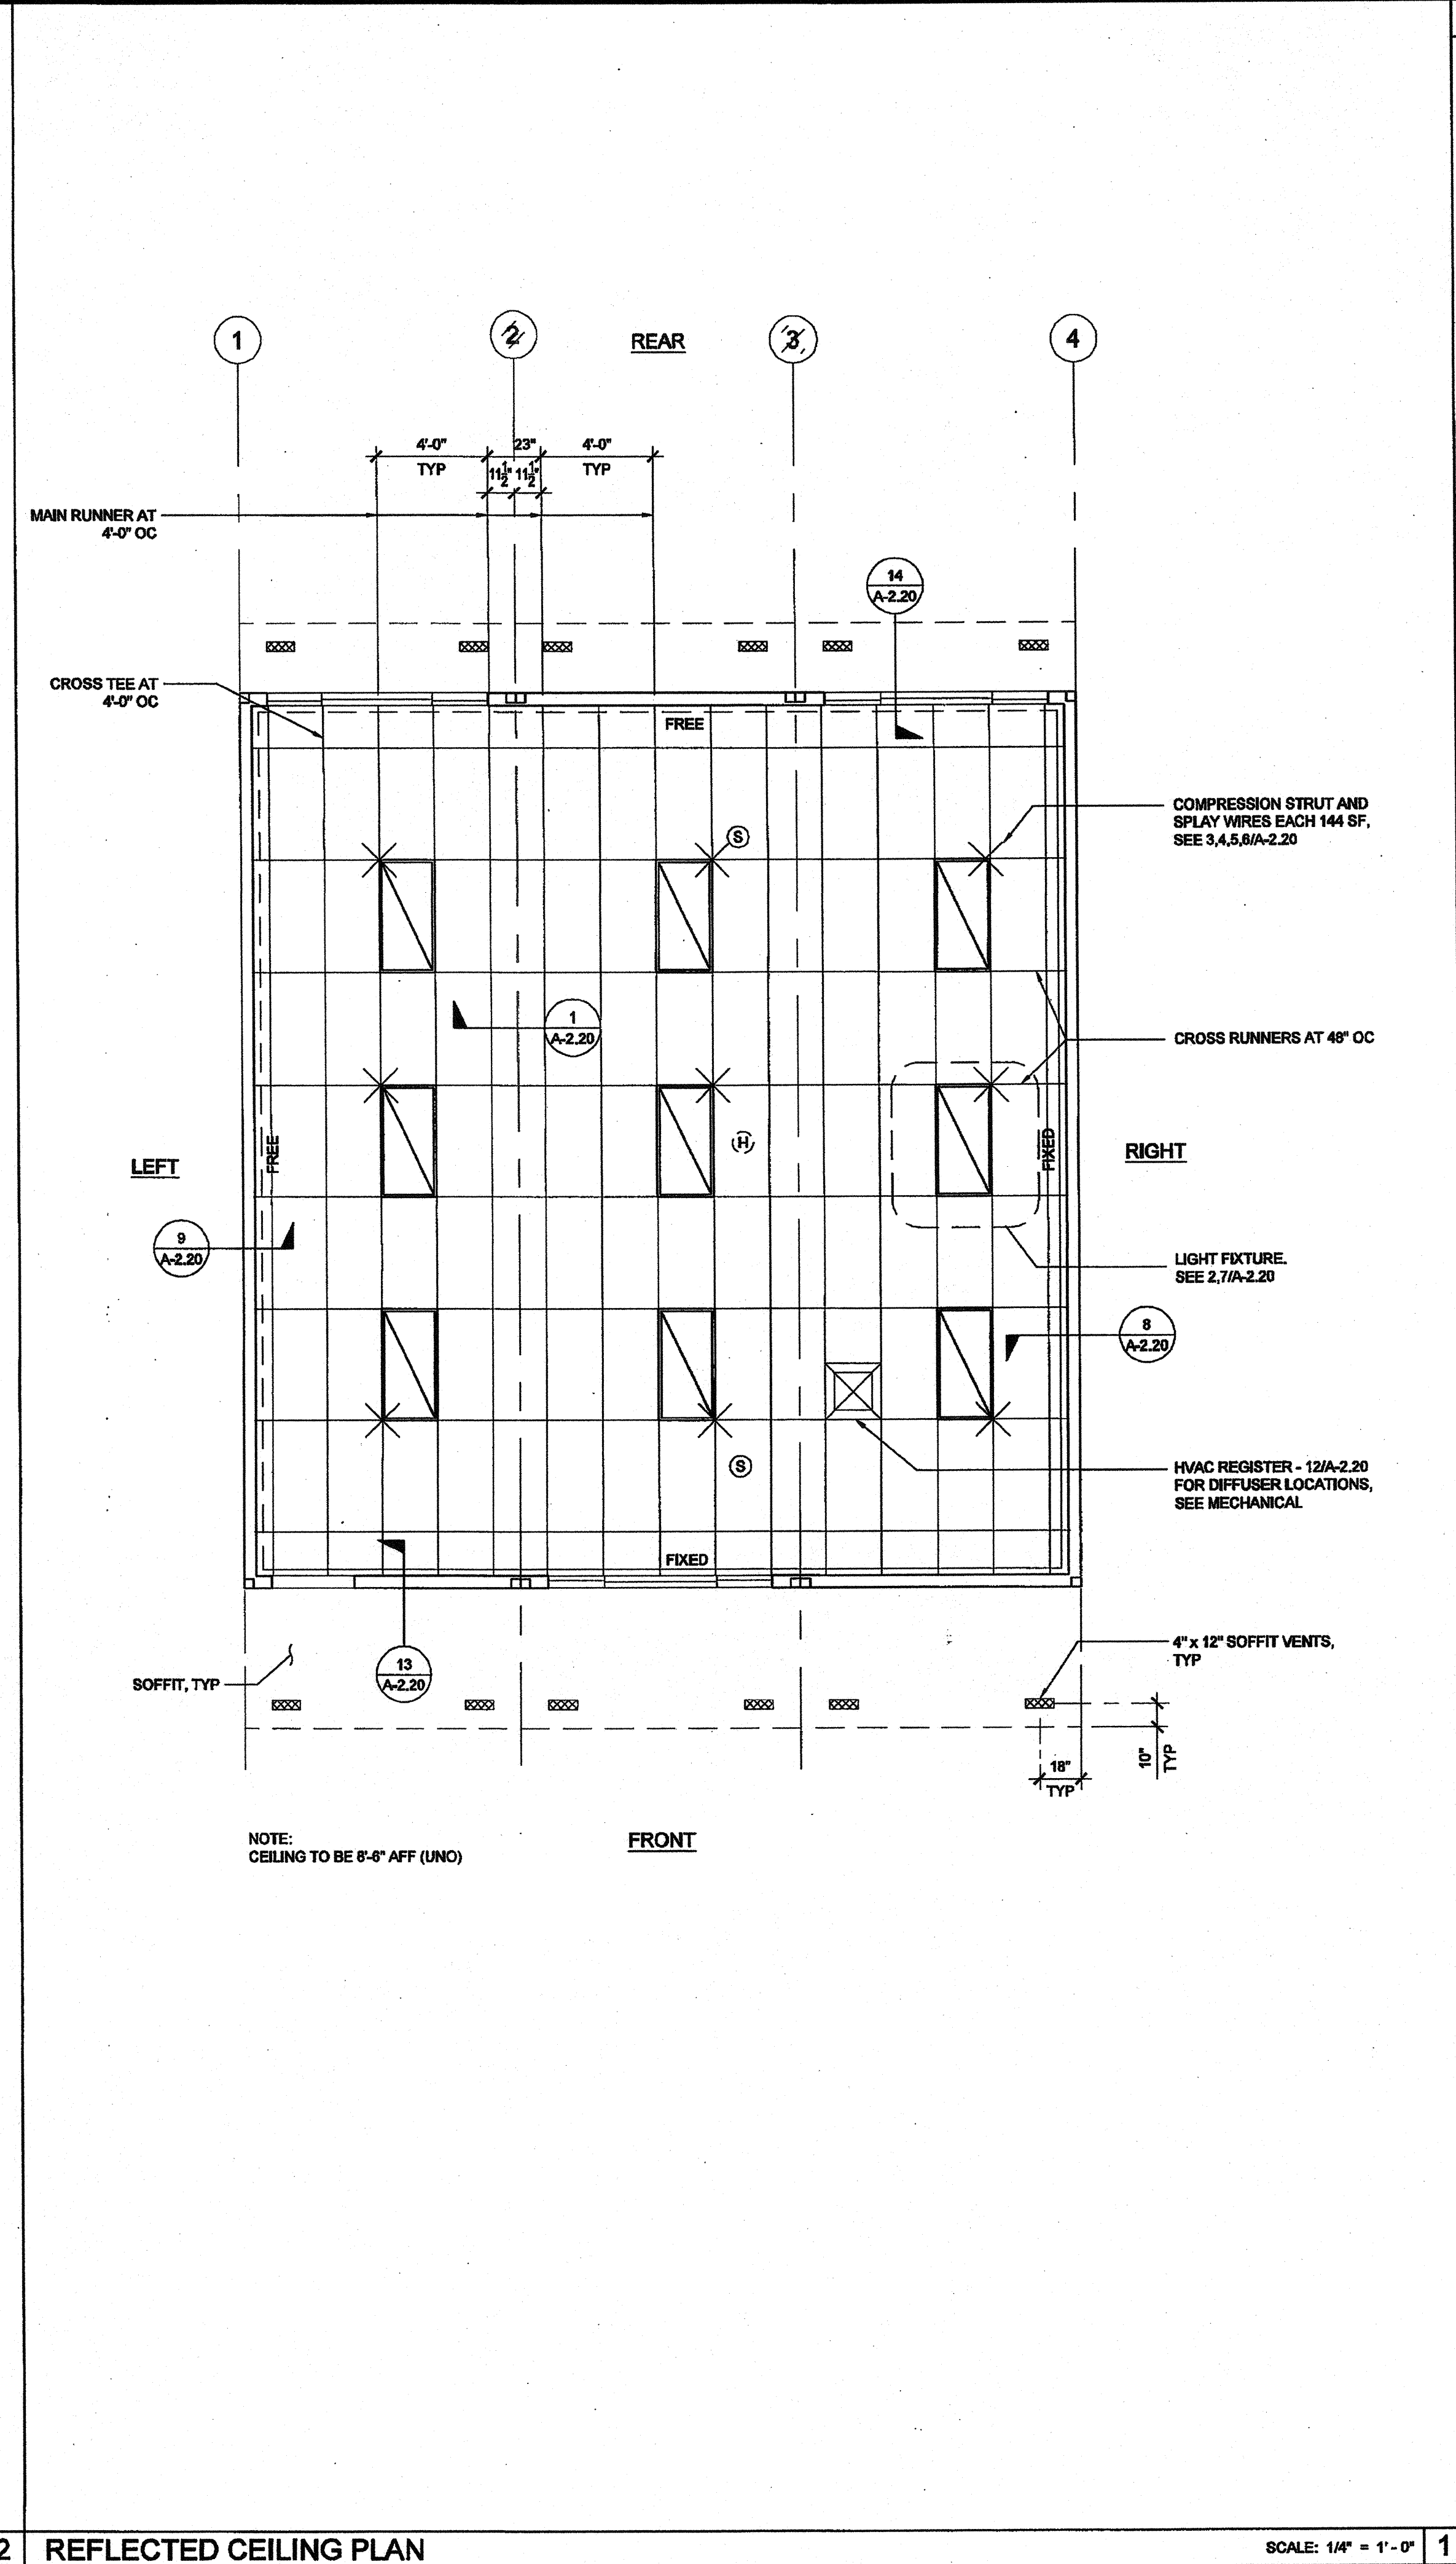

**LEGEND**

	T-BAR CEILING
	FIELD INSTALLED PANEL AT MODULE LINE
	2' x 4' RECESSED LIGHT FIXTURE
	"OPTIONAL" 1' x 4' RECESSED LIGHT FIXTURE
	SPLAY WIRE
	CEILING MOUNTED SMOKE DETECTOR
	ATTIC MOUNTED HEAT DETECTOR
	SUPPLY AIR REGISTER
	CEILING EXHAUST FAN

**NOTE:**  
FOR ALL REFLECTED CEILING NOTES  
SEE SHEET A-0.1

**T-BAR SCHEDULE**

ARMSTRONG PART NUMBERS PA-041  
 MAIN RUNNER: 7301  
 4" CROSS TEE: XL7341  
 2" CROSS TEE: XL7308

STANDARD 7/8" WALL ANGLE WITH BERC-2 CLIP (ICC #ESP-1308) 2" WALL ANGLE: 7810 (OPTIONAL)

THESE DRAWINGS AND ALL MATERIAL CONTAINED HEREIN ARE THE PROPERTY OF SILVERCREEK INDUSTRIES, INC. (SCI Inc) AND SHALL NOT BE REPRODUCED, COPIED OR OTHERWISE DISPOSED OF DIRECTLY OR INDIRECTLY AND SHALL NOT BE USED IN WHOLE OR IN PART TO ASSIST IN THE MAKING OF OR FOR THE PURPOSE OF FURNISHING ANY INFORMATION FOR THE MAKING OF DRAWINGS, PRINTS, APPARATUS OR PARTS THEREOF WITHOUT THE FULL KNOWLEDGE AND WRITTEN CONSENT OF SCI Inc. ALL PATENTABLE MATERIAL CONTAINED HEREIN AND ORIGINATING WITH SCI Inc SHALL BE THE PROPERTY OF SCI Inc.

**SILVER CREEK INDUSTRIES, INC.**

"BUILDING FOR THE NEXT GENERATION"

**SILVER CREEK**

195 EAST MORGAN PERRIS, CALIFORNIA 92571  
 PHONE: 951-943-5393 FAX: 951-943-2211

PROJECT NAME:  
**CLASS LEASING CLASSROOMS BLDG'S**

SHEET TITLE:  
**REFLECTED CEILING PLAN 30' x 32'**

**TAVARES ASSOCIATES**

REGISTERED ARCHITECT  
 No. C-8856  
 Exp. 10-31-2013  
 12/23/2011

ARCHITECT OF RECORD  
 SUBMISSION STAMP

REGISTERED ARCHITECT  
 No. C-8856  
 Exp. 10-31-2013  
 12/23/2011

PROJECT SPECIFIC STATE AGENCY APPROVAL

IDENTIFICATION STAMP  
 DIV. OF THE STATE ARCHITECT  
 OFFICE OF REGULATION SERVICES  
 04 113850  
 AC [Signature] SS [Signature]  
 DATE **AUG 27 2011**

ORIGINAL PC STATE AGENCY APPROVAL

PRE-CHECKED DOCUMENT  
 CONFORMS TO THE REQUIREMENTS OF THE STATE ARCHITECTURE ACT  
 THIS DOCUMENTATION IS VALIDATED

IDENTIFICATION STAMP  
 DIV. OF THE STATE ARCHITECT  
 OFFICE OF REGULATION SERVICES  
 PC 04-112070  
 AC [Signature] SS [Signature]  
 DATE **DEC 10 2011**

REVISIONS


SILVER CREEK INDUSTRIES  
 30' x 32' PC

PROJECT NO:  
 DRAWN BY:  
 SCALE: AS NOTED  
 DATE: 6-17-11  
 P.C. SHEET NUMBER  
**A-2.01**