



FRONT ELEVATION

SCALE: 1/4" = 1'-0" 3

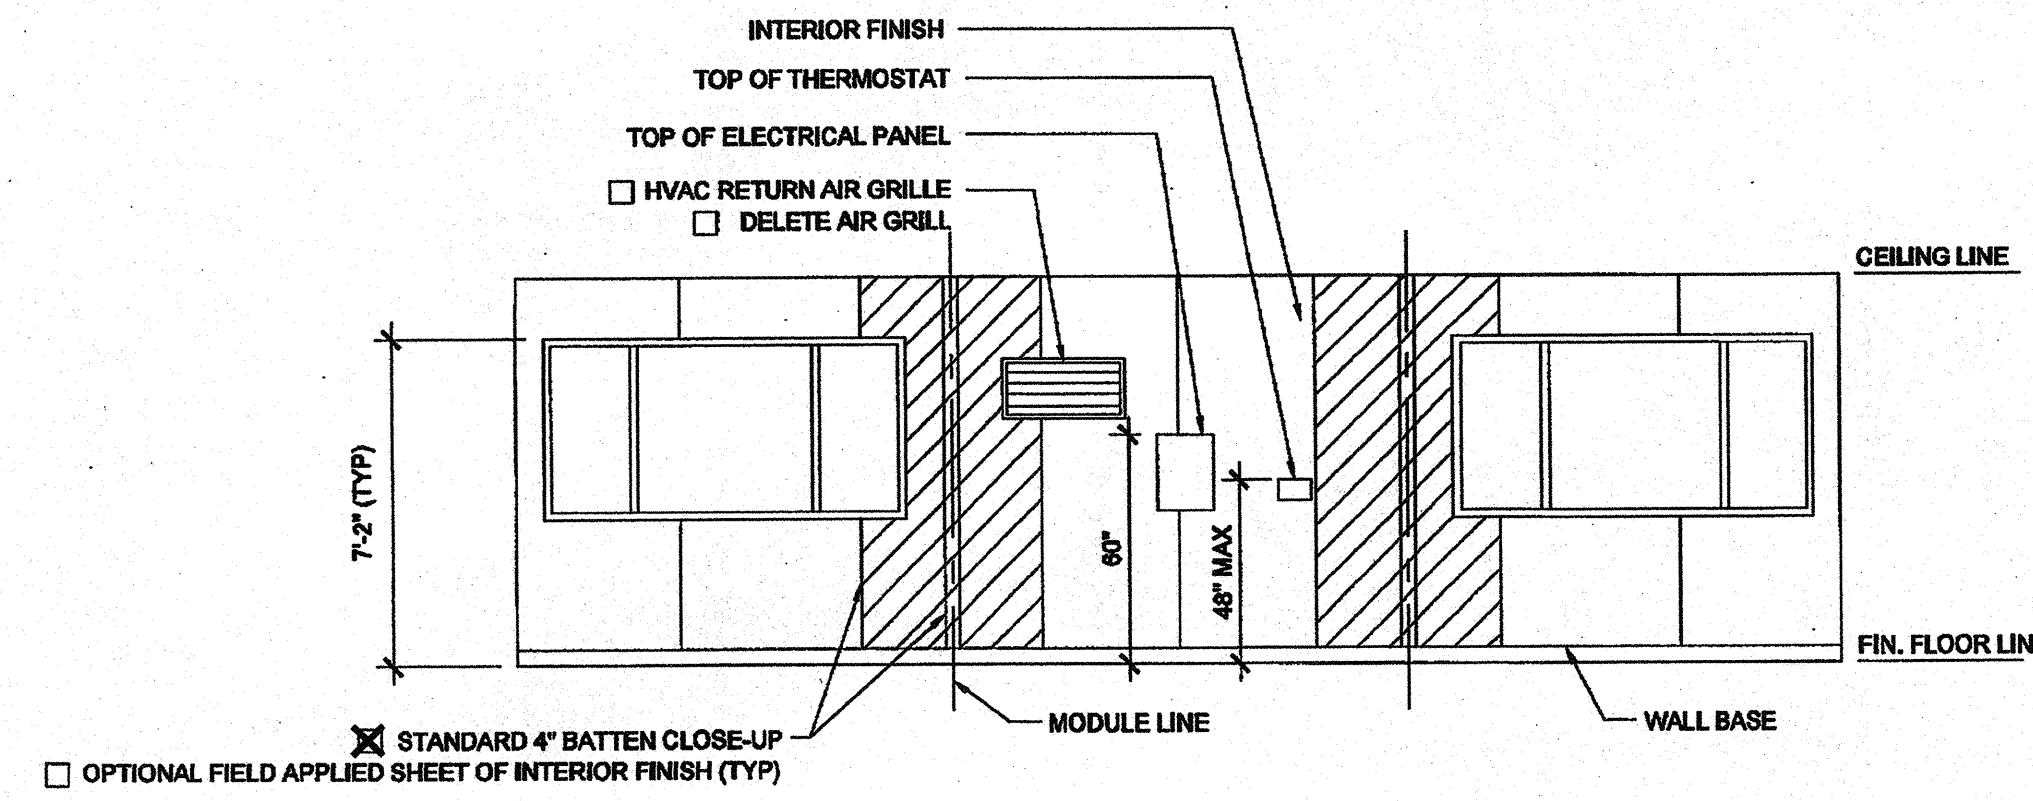


REAR ELEVATION

SCALE: 1/4" = 1'-0" 1

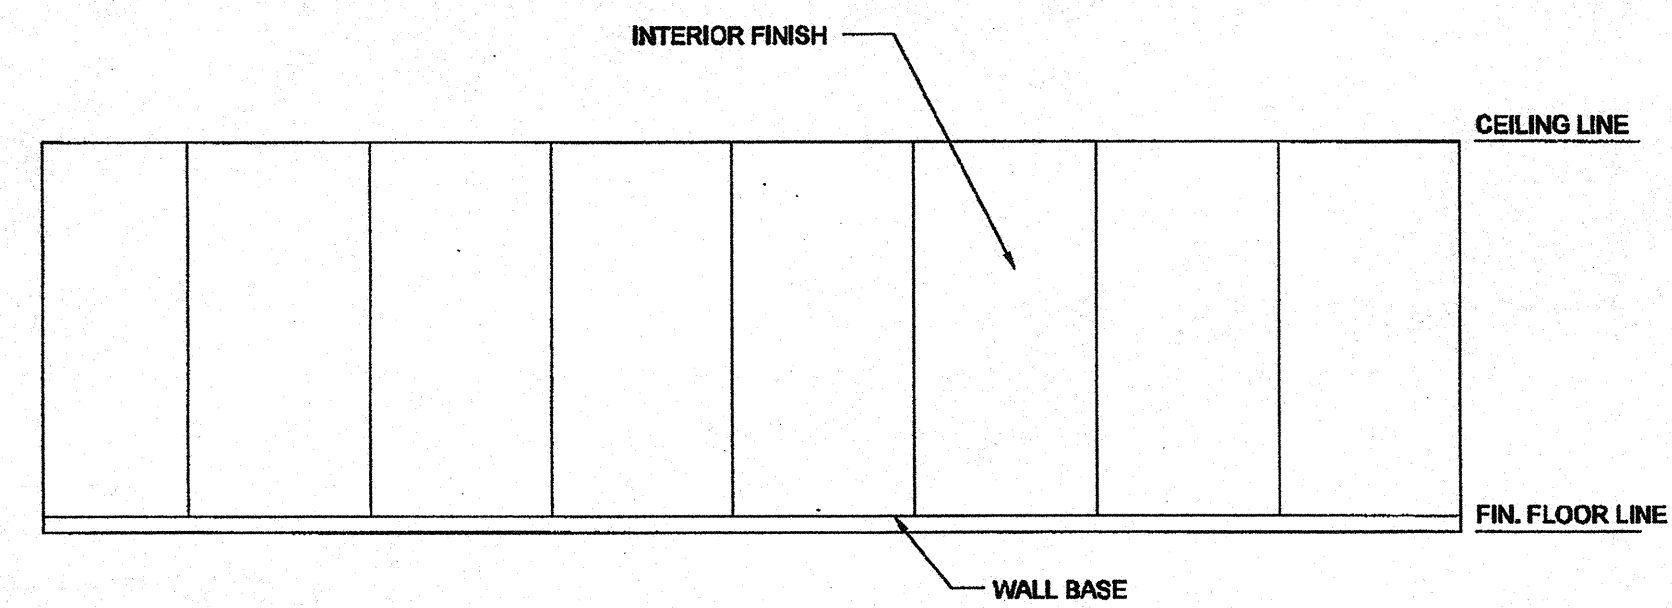

SIDE ELEVATION

SCALE: 1/4" = 1'-0" 4

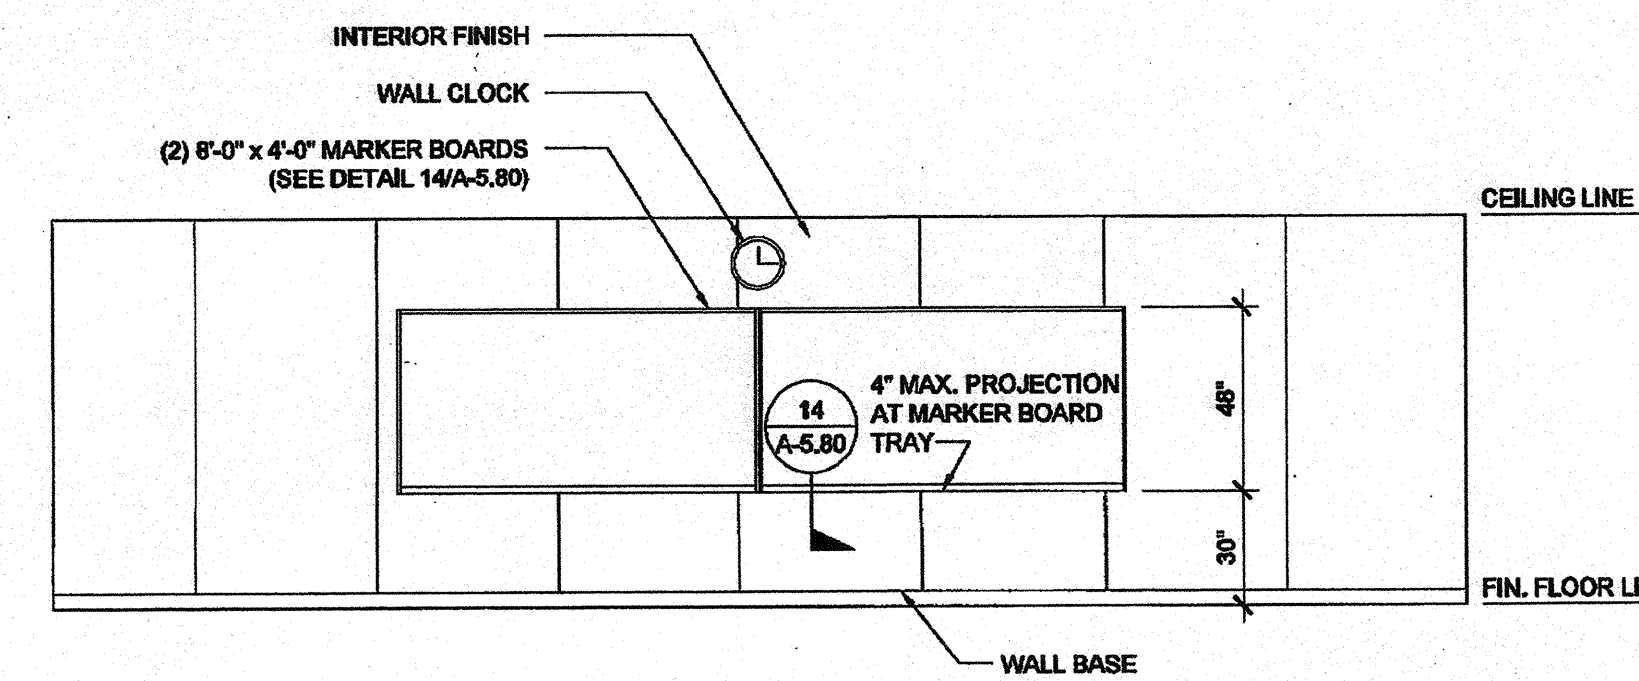

SIDE ELEVATION

SCALE: 1/4" = 1'-0" 2

IDENTIFICATION STAMP
DIV. OF THE STATE ARCHITECT
APP03 116979
ACW FLS MISS BY
Date 4/13/16

THESE DRAWINGS AND ALL MATERIAL CONTAINED HEREIN ARE THE PROPERTY OF SILVERCREEK INDUSTRIES, INC (SCI Inc) AND SHALL NOT BE REPRODUCED, COPIED OR OTHERWISE DISPOSED OF DIRECTLY OR INDIRECTLY AND SHALL NOT BE USED IN WHOLE OR IN PART TO ASSIST IN THE MAKING OF OR FOR THE PURPOSE OF FURNISHING ANY INFORMATION FOR THE MAKING OF DRAWINGS, PRINTS, APPARATUS OR PARTS THEREOF WITHOUT THE FULL KNOWLEDGE AND WRITTEN CONSENT OF SCI Inc.
ALL PATENTABLE MATERIAL CONTAINED HEREIN AND ORIGINATING WITH SCI Inc SHALL BE THE PROPERTY OF SCI Inc.

SILVER CREEK INDUSTRIES, INC.

SILVER CREEK

195 EAST MORGAN FERRIS, CALIFORNIA 92571
PHONE: 951-943-5393 FAX: 951-943-2211

PROJECT NAME:
CLASS LEASING CLASSROOMS BLDG'S

SHEET TITLE:
INTERIOR ELEVATION 30' x 32'

STAVARES ASSOCIATES

REGISTERED ARCHITECT
No. C-20854
Exp. 10-31-2013
12/23/2011

ARCHITECT OF RECORD
SUBMISSION DATE

REGISTERED ARCHITECT
No. C-11322
Exp. 10-16-16
12/23/2011

PROJECT SPECIFIC STATE AGENCY APPROVAL

IDENTIFICATION STAMP
DIV. OF THE STATE ARCHITECT
OFFICE OF REGULATION SERVICES
04 113850
DATE AUG 20 2014

ORIGINAL PC STATE AGENCY APPROVAL

IDENTIFICATION STAMP
DIV. OF THE STATE ARCHITECT
OFFICE OF REGULATION SERVICES
PC 04-112070
DATE DEC 4 9 2014

REVISIONS

SILVER CREEK INDUSTRIES
30' x 32' PC

PROJECT NO:
DRAWN BY:
SCALE: AS NOTED
DATE: 6-17-11
P.C. SHEET NUMBER

A-6.01