

INCLUDES CORNER  
MODLINE PLTS SEE  
1&20/S-1.50

FLOOR FRAMING PLAN

SCALE: 1/4" = 1'-0" 1

NOTES:

- FOR FLOOR BLOCKING SEE DETAILS 4.7B / S-1.50 (STD), 4.7A / S-1.50 (ALT)
- FOR BUILDINGS ON WOOD FOUNDATION SYSTEMS, PROVIDE 1 1/8" DIA. HOLE AT BOTTOM FLANGE OF FLOOR BEAM FOR LAG SCREW ATTACHMENT TO FOUNDATION PLATES BELOW. FOR EXACT HOLE LOCATIONS, SEE FOUNDATION PLAN.

FLOOR JOIST TABLE

| LIVE LOAD PSF | JOIST SPACING |
|---------------|---------------|
| 50            | 48"           |
| 50 + 15       | 48"           |
| 100           | 36"           |
| 150           | 24"           |

THESE DRAWINGS AND ALL MATERIAL CONTAINED HEREIN ARE THE PROPERTY OF SILVERCREEK INDUSTRIES, INC (SCI INC) AND SHALL NOT BE REPRODUCED, COPIED OR OTHERWISE DISPOSED OF DIRECTLY OR INDIRECTLY AND SHALL NOT BE USED IN WHOLE OR IN PART TO ASSIST IN THE MAKING OF OR FOR THE PURPOSE OF FURNISHING ANY INFORMATION FOR THE MAKING OF DRAWINGS, PRINTS, APPARATUS OR PARTS THEREOF WITHOUT THE FULL KNOWLEDGE AND WRITTEN CONSENT OF SCI INC. ALL PATENTABLE MATERIAL CONTAINED HEREIN AND ORIGINATING WITH SCI INC SHALL BE THE PROPERTY OF SCI INC.

SILVER CREEK INDUSTRIES, INC.




195 EAST MORGAN PEERIS, CALIFORNIA 92571  
PHONE: 951-943-5292 FAX: 951-943-2211

PROJECT NAME:


CLASS LEASING  
CLASSROOMS BLDG'S

SHEET TITLE:


FLOOR FRAMING PLAN  
WOOD FLOOR

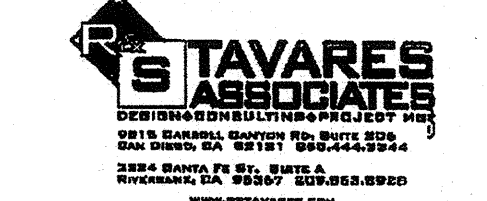


12/23/2011

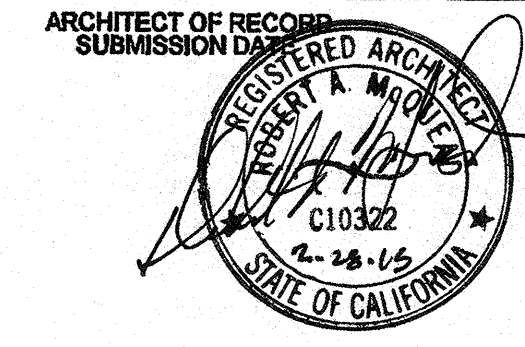

PROJECT SPECIFIC STATE AGENCY APPROVAL

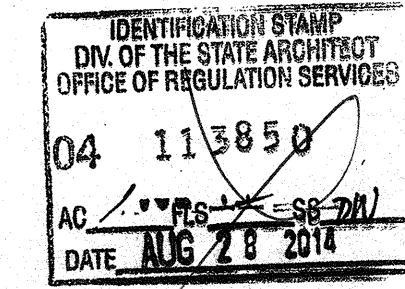

ORIGINAL PC STATE AGENCY APPROVAL

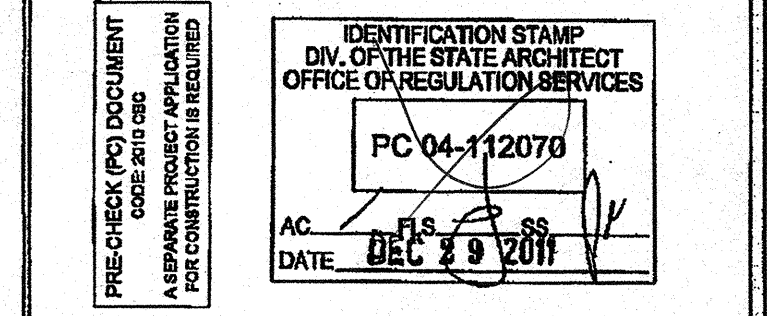

REVISIONS

|  |  |
|--|--|
|  |  |
|  |  |
SILVER CREEK INDUSTRIES  
30' x 32' PC

PROJECT NO:  
DRAWN BY:  
SCALE: AS NOTED  
DATE: 6-17-11

P.C. SHEET NUMBER  
**S-1.01**

IDENTIFICATION STAMP  
DIV. OF THE STATE ARCHITECT

APP03 116979  
AC WFLS - SS 84  
Date 4-13-16