




TYP. VERTICAL & DIAGONAL (U.N.O.) SCALE: 1 1/2" = 1'-0" 6

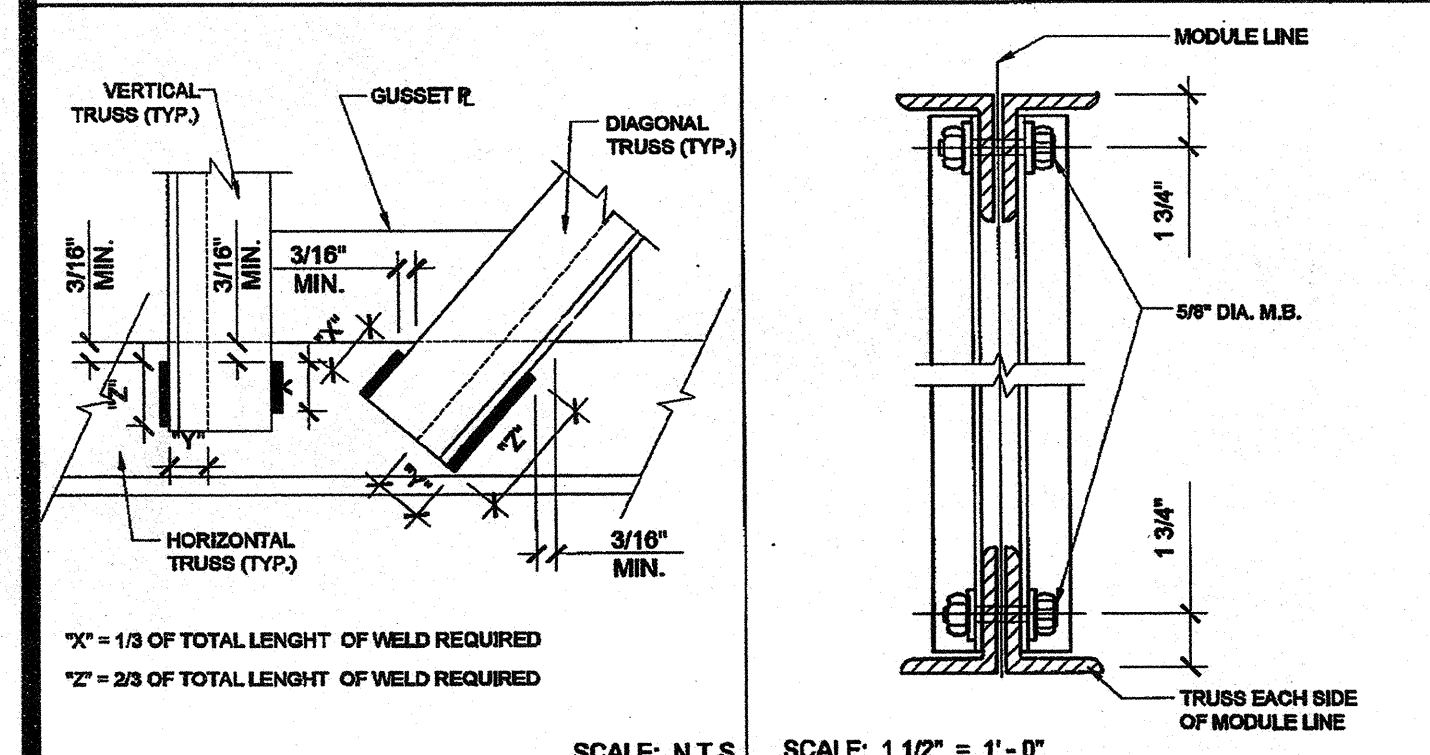


WELD REQUIREMENTS 7A CONNECTION @ MODULE LINE SCALE: N.T.S. 7

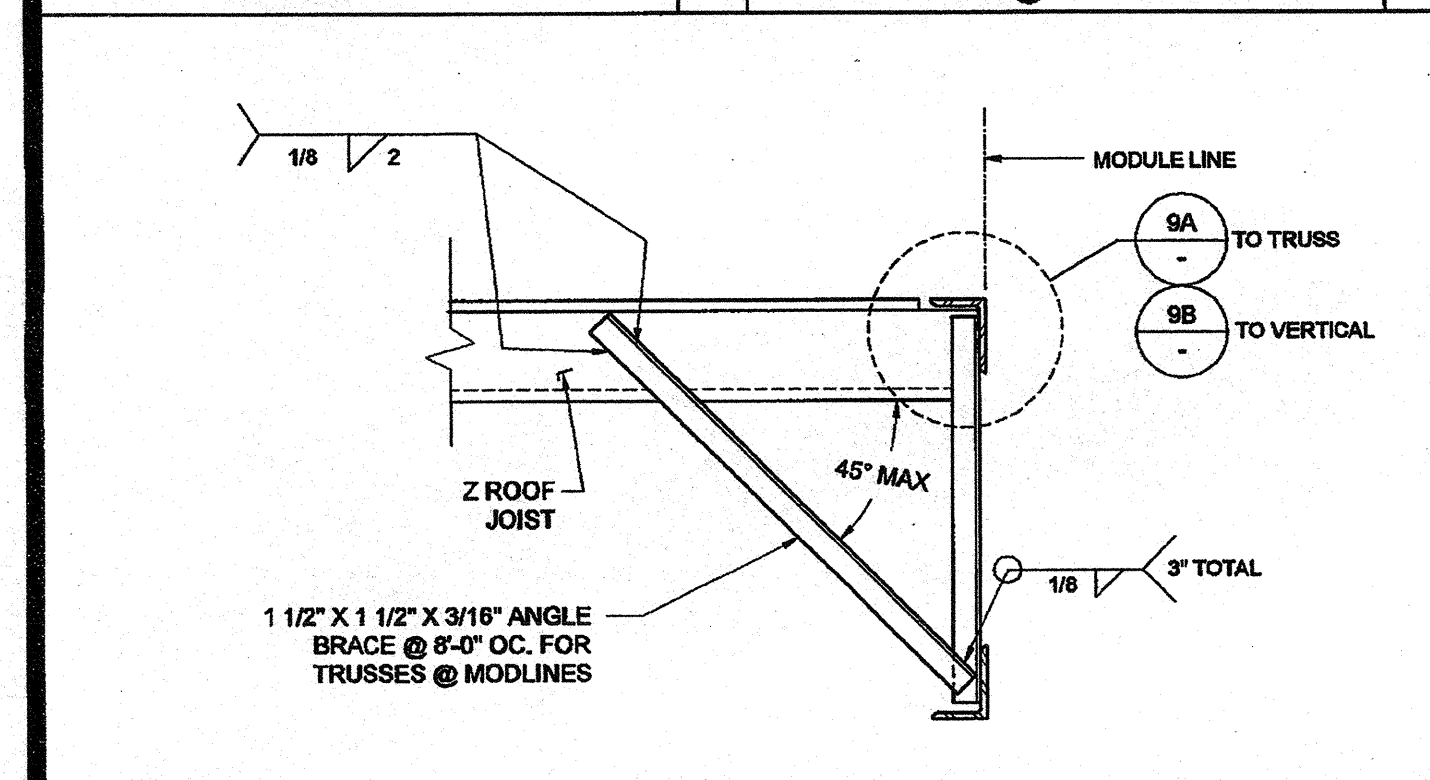


BRACE @ TRUSS & MATING LINE SCALE: 1 1/2" = 1'-0" 8

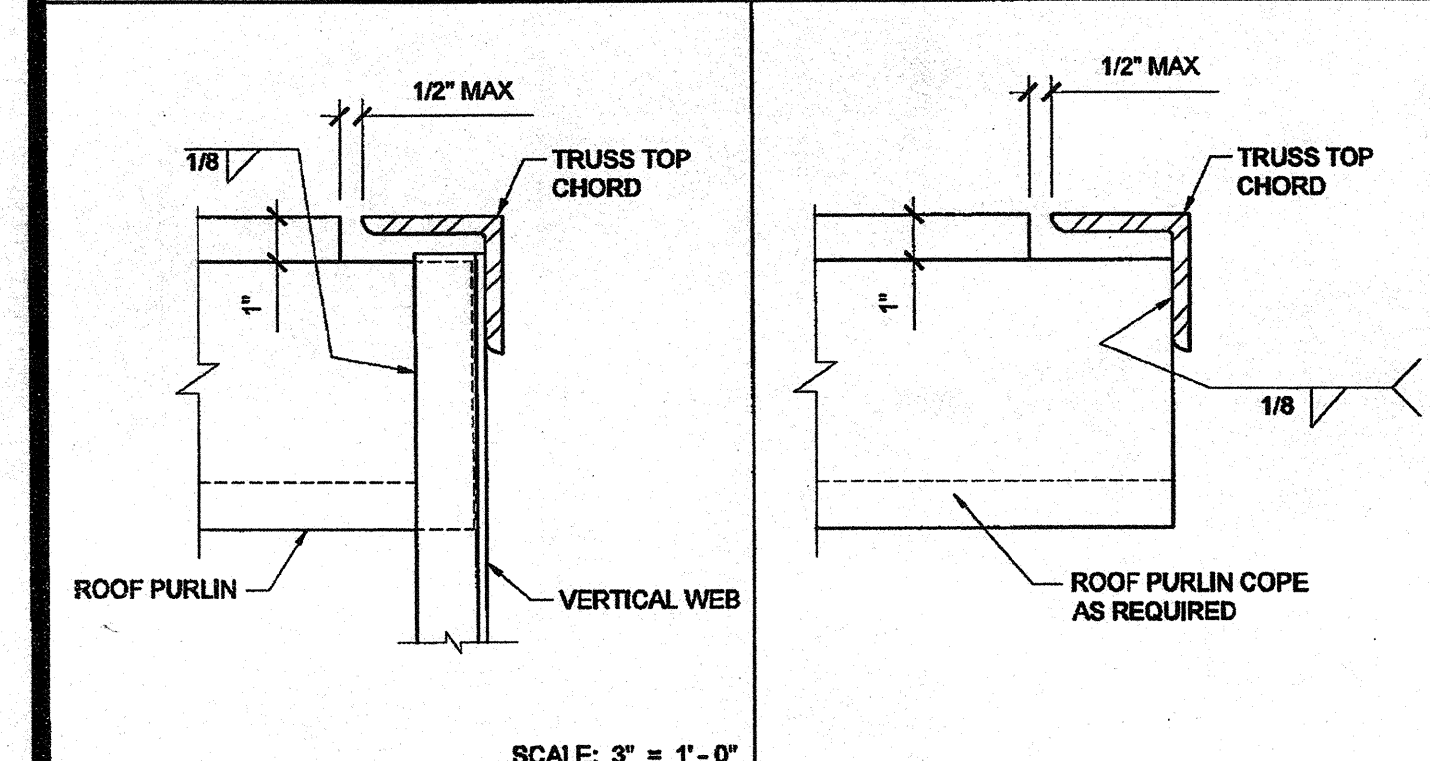

PURLIN TO VERT. ANGLE CONN. SCALE: 3" = 1'-0" 9B

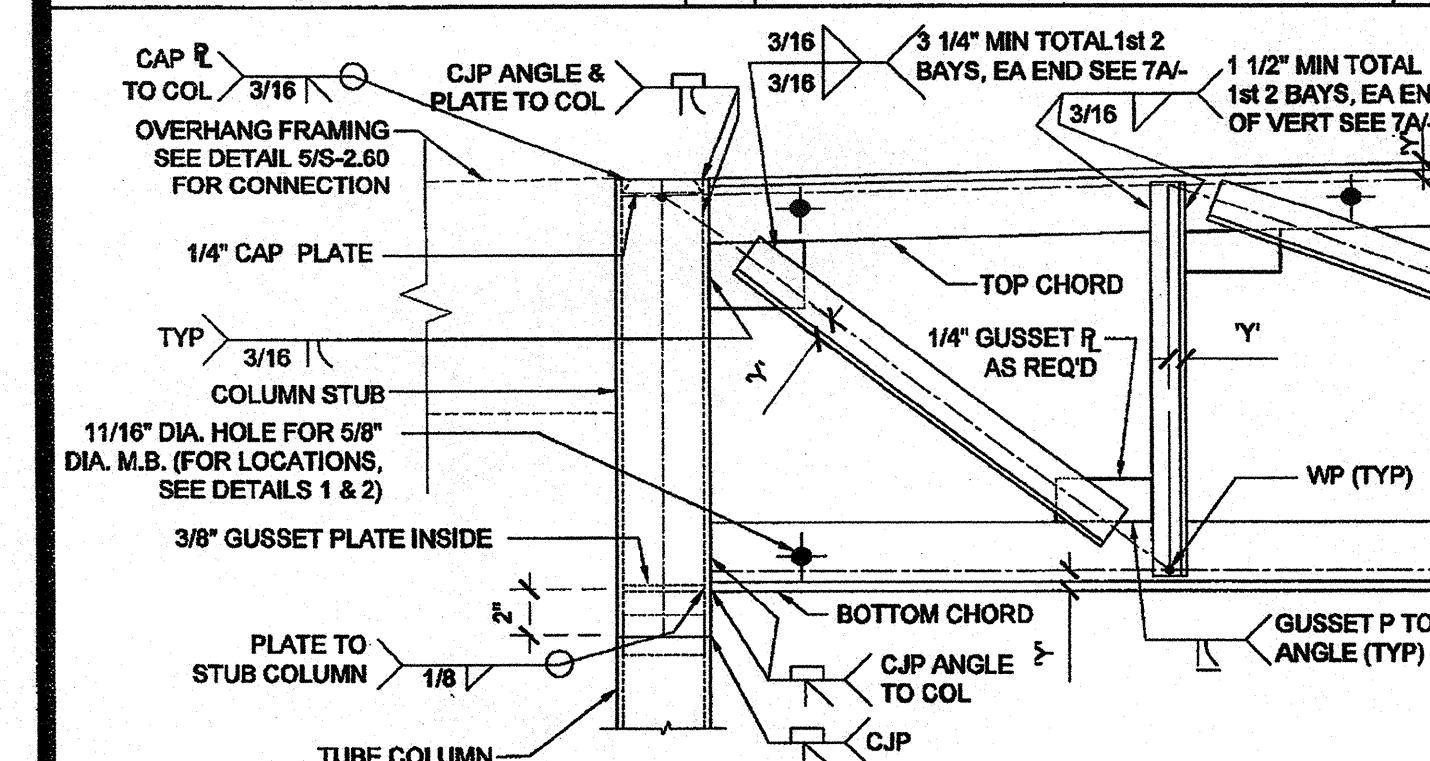

TRUSS TO COLUMN / OH FRAME CONN. SCALE: 1 1/2" = 1'-0" 10

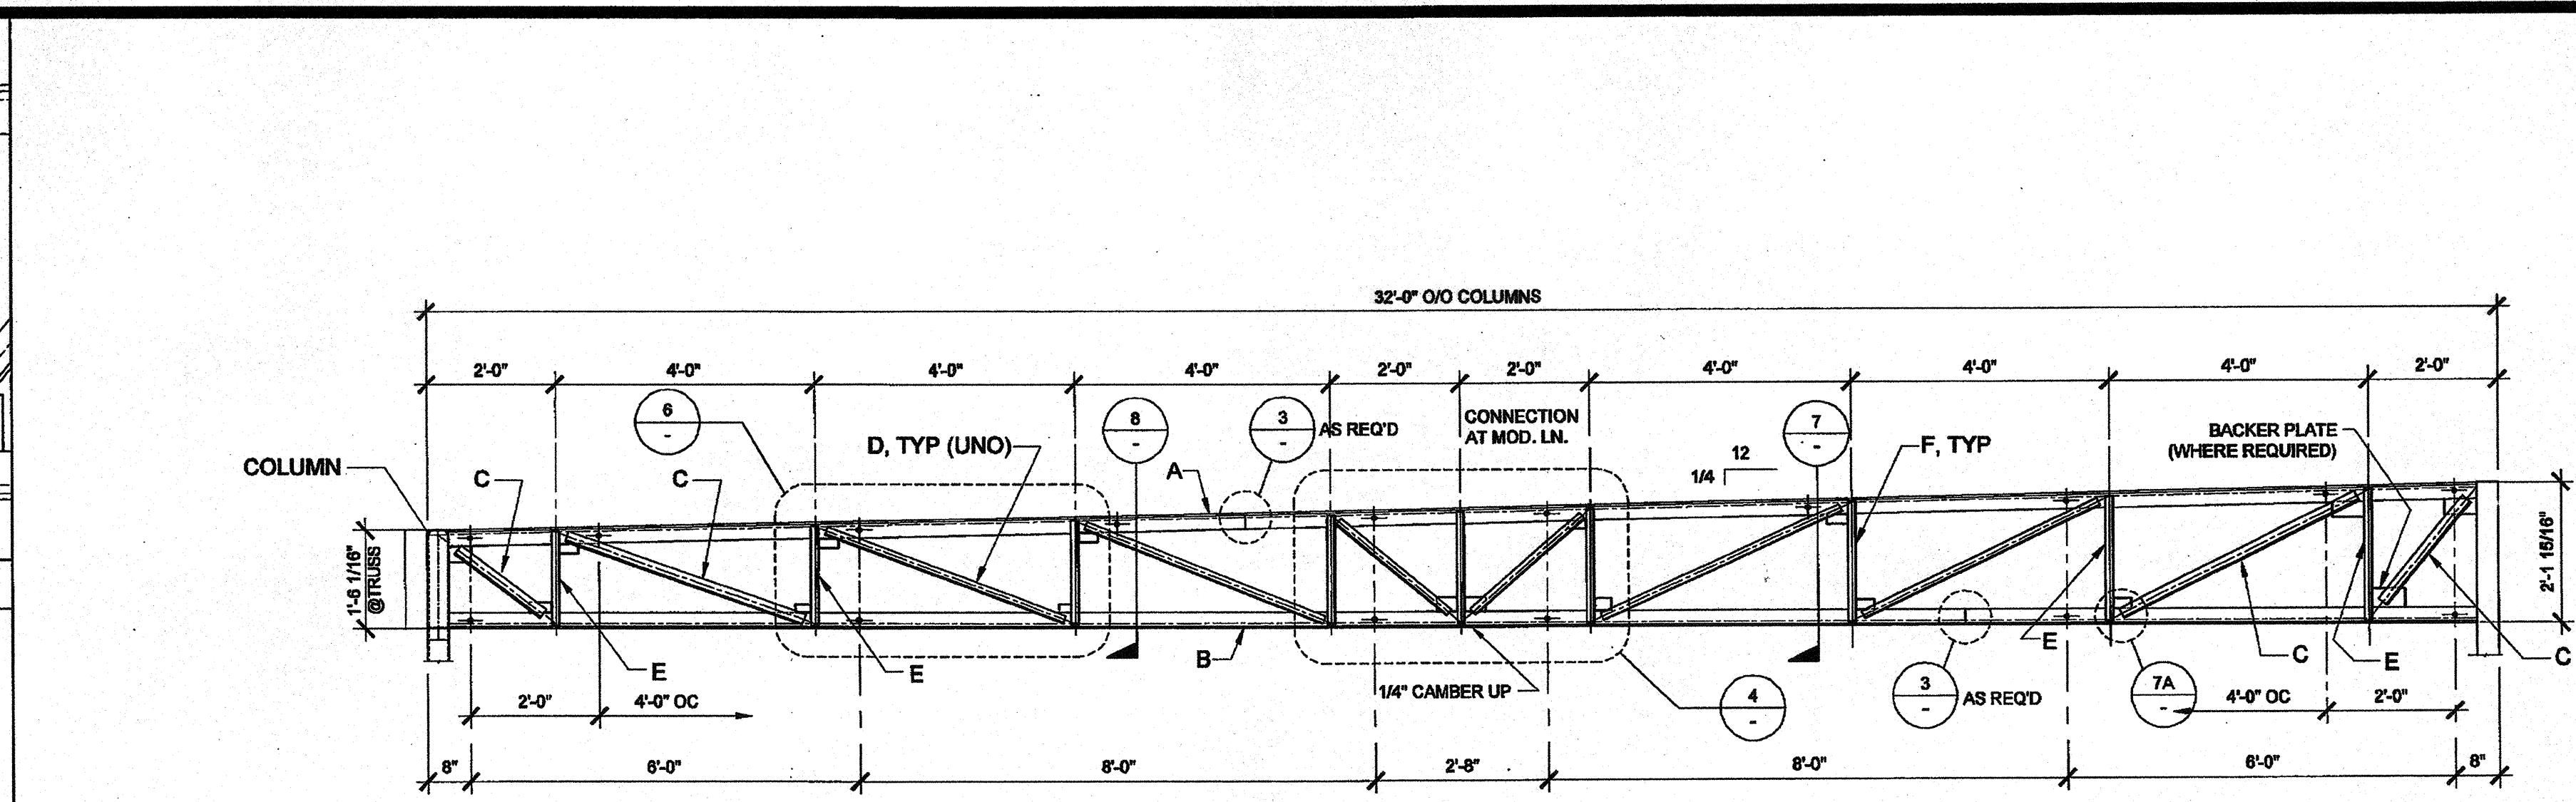


**NOTES:**

1. ALL STEEL GRADES TO BE A-36 WITH 36 K.S.I. MIN. YIELD
2. REQUIRED ELECTRODES FOR ALL WELDS TO BE E-70
3. VOLTAGE & AMPERAGE SHALL BE PER ELECTRODE MANUFACTURERS SPECIFICATIONS
4. BOLTS AND NUTS GRADES TO BE A307

REF: ROOF FRAMING PLAN

TRUSS MARK	Y=
A TOP CHORD	4" x 3" x 1/4" (LLV) 1 1/4
B BOTTOM CHORD	4" x 3" x 1/4" (LLV) 1 1/4
C END DIAGONALS (2 EACH END)	1 1/2" x 1 1/2" x 3/16" 7/16
D TYPICAL DIAGONALS	1 1/2" x 1 1/2" x 3/16" 7/16
E END VERTICAL (2 EACH END)	1 1/2" x 1 1/2" x 3/16" 7/16
F TYPICAL VERTICALS	1 1/2" x 1 1/2" x 3/16" 7/16

MONO SLOPE TRUSS SCALE: 1/2" = 1'-0" 1

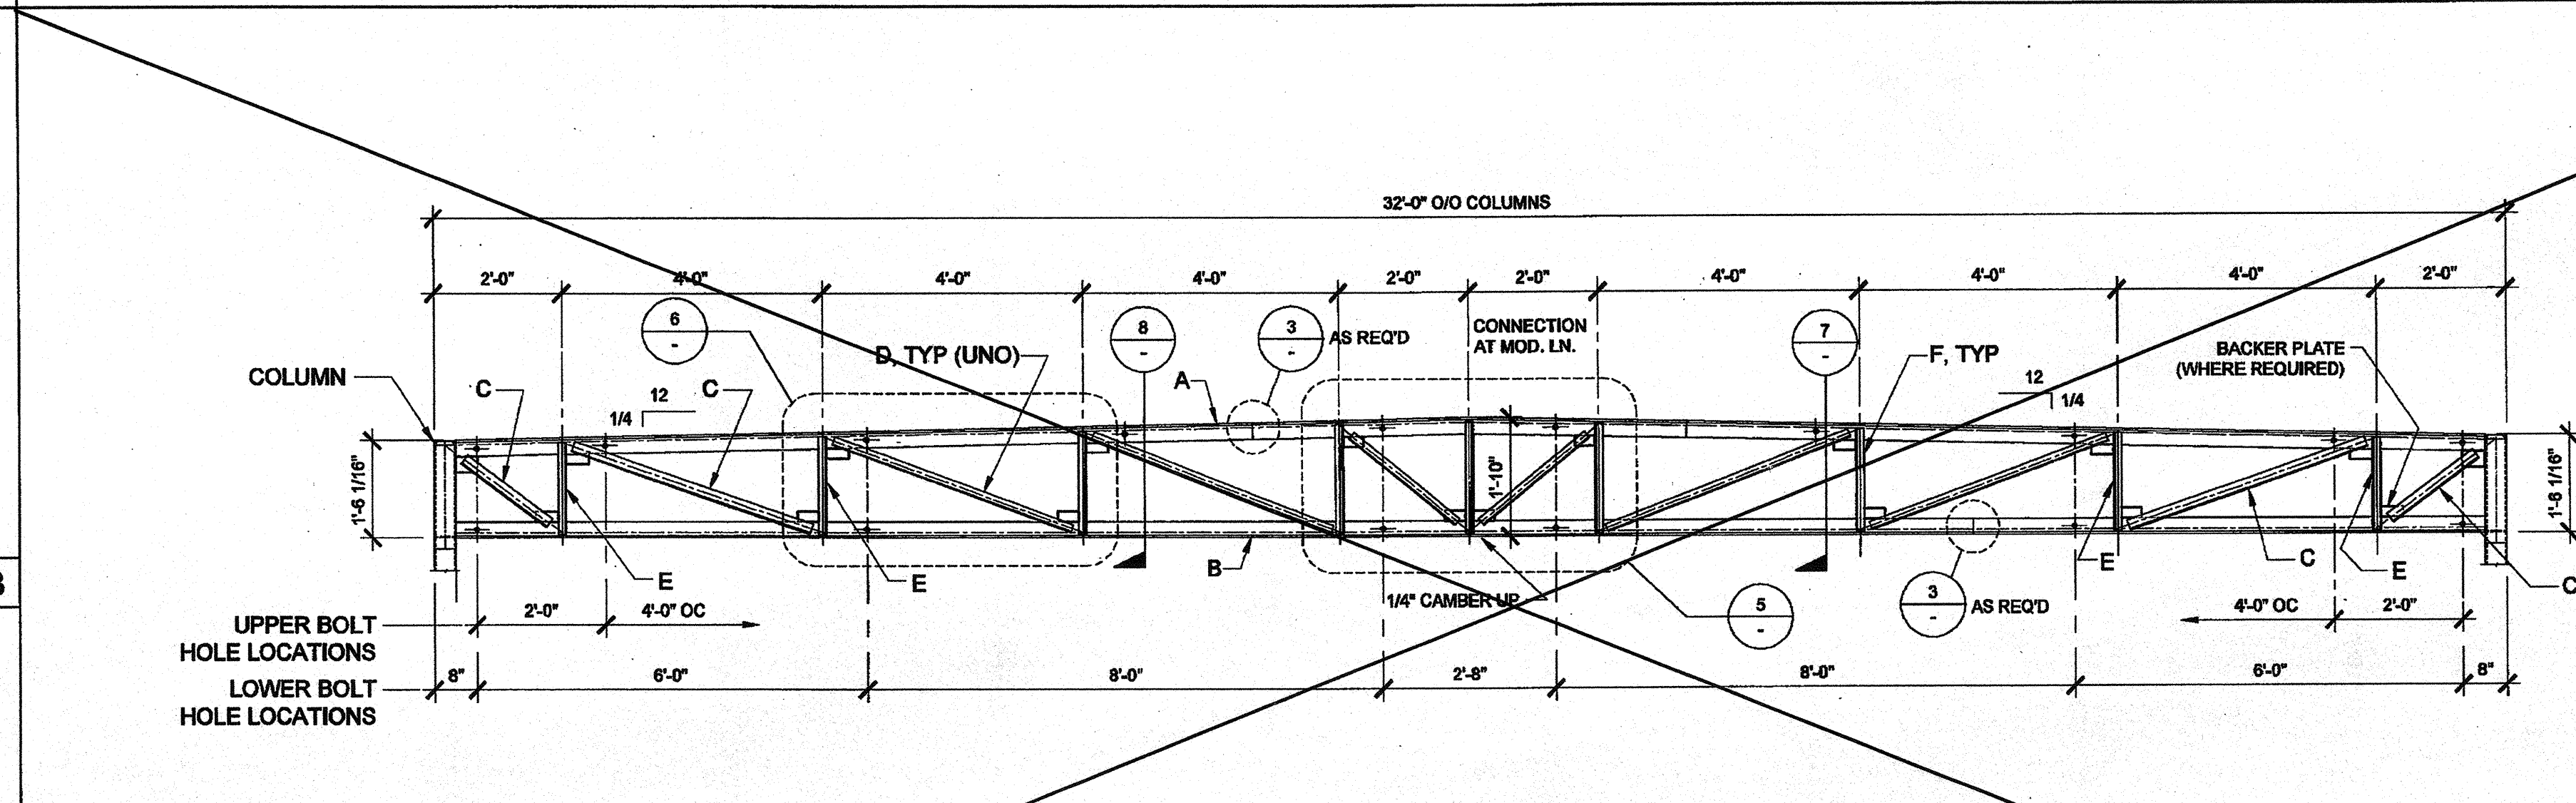


**NOTES:**

1. ALL STEEL GRADES TO BE A-36 WITH 36 K.S.I. MIN. YIELD
2. REQUIRED ELECTRODES FOR ALL WELDS TO BE E-70
3. VOLTAGE & AMPERAGE SHALL BE PER ELECTRODE MANUFACTURERS SPECIFICATIONS
4. BOLTS AND NUTS GRADES TO BE A307


REF: ROOF FRAMING PLAN

TRUSS MARK	Y=
A TOP CHORD	4" x 3" x 1/4" (LLV) 1 1/4
B BOTTOM CHORD	4" x 3" x 1/4" (LLV) 1 1/4
C END DIAGONALS (2 EACH END)	1 1/2" x 1 1/2" x 3/16" 7/16
D TYPICAL DIAGONALS	1 1/2" x 1 1/2" x 3/16" 7/16
E END VERTICAL (2 EACH END)	1 1/2" x 1 1/2" x 3/16" 7/16
F TYPICAL VERTICALS	1 1/2" x 1 1/2" x 3/16" 7/16


DUAL SLOPE TRUSS SCALE: 1/2" = 1'-0" 2

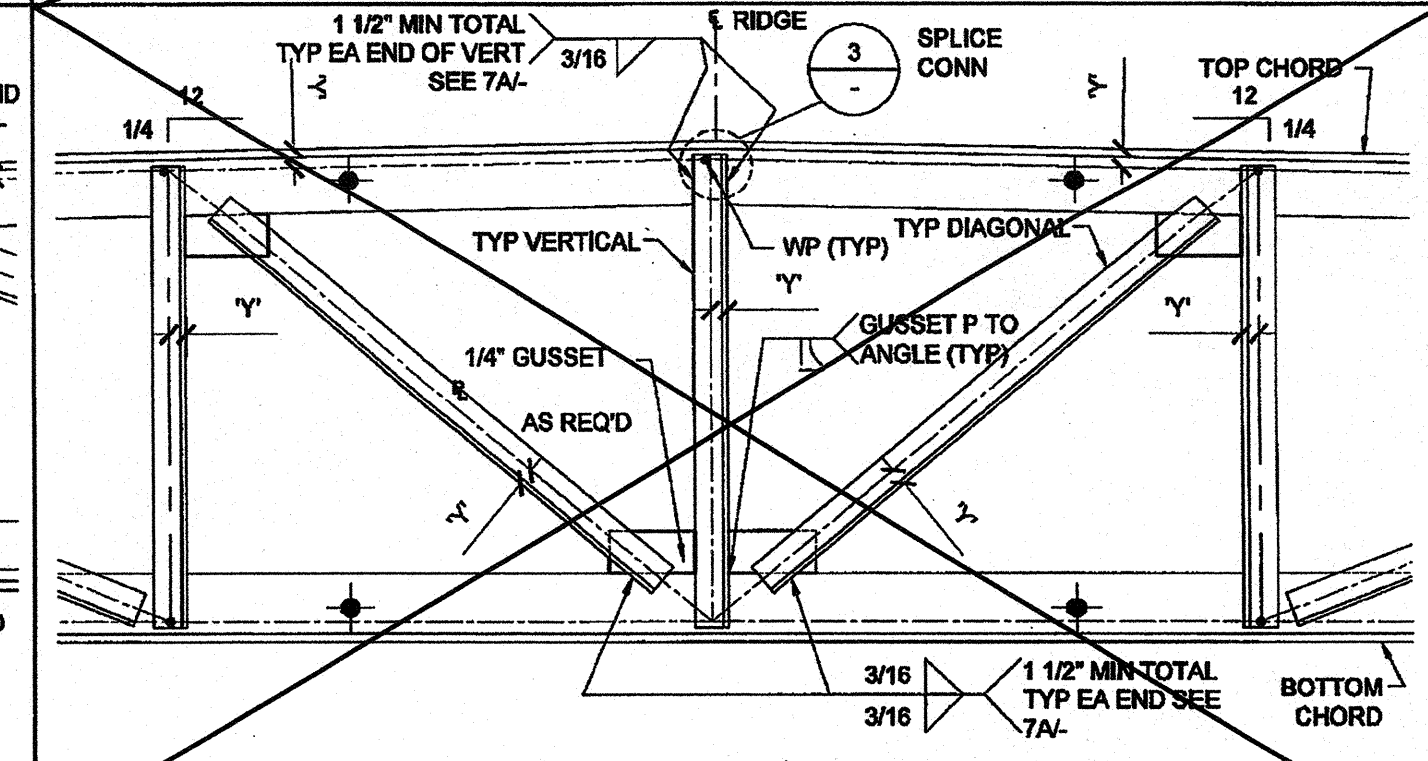

VERT. & DIAG. AT MID-POINT SCALE: 1 1/2" = 1'-0" 5

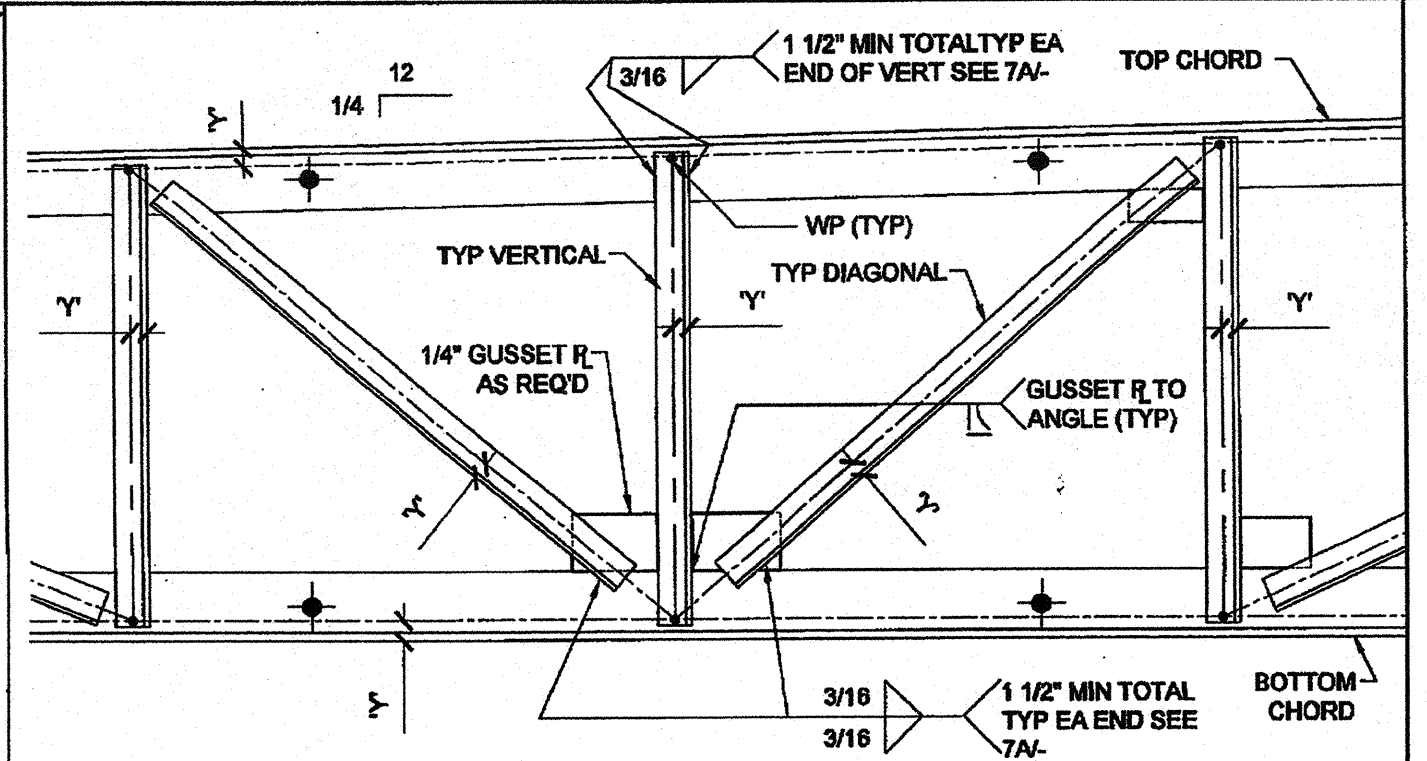

VERT. & DIAG. AT MID-POINT SCALE: 1 1/2" = 1'-0" 4

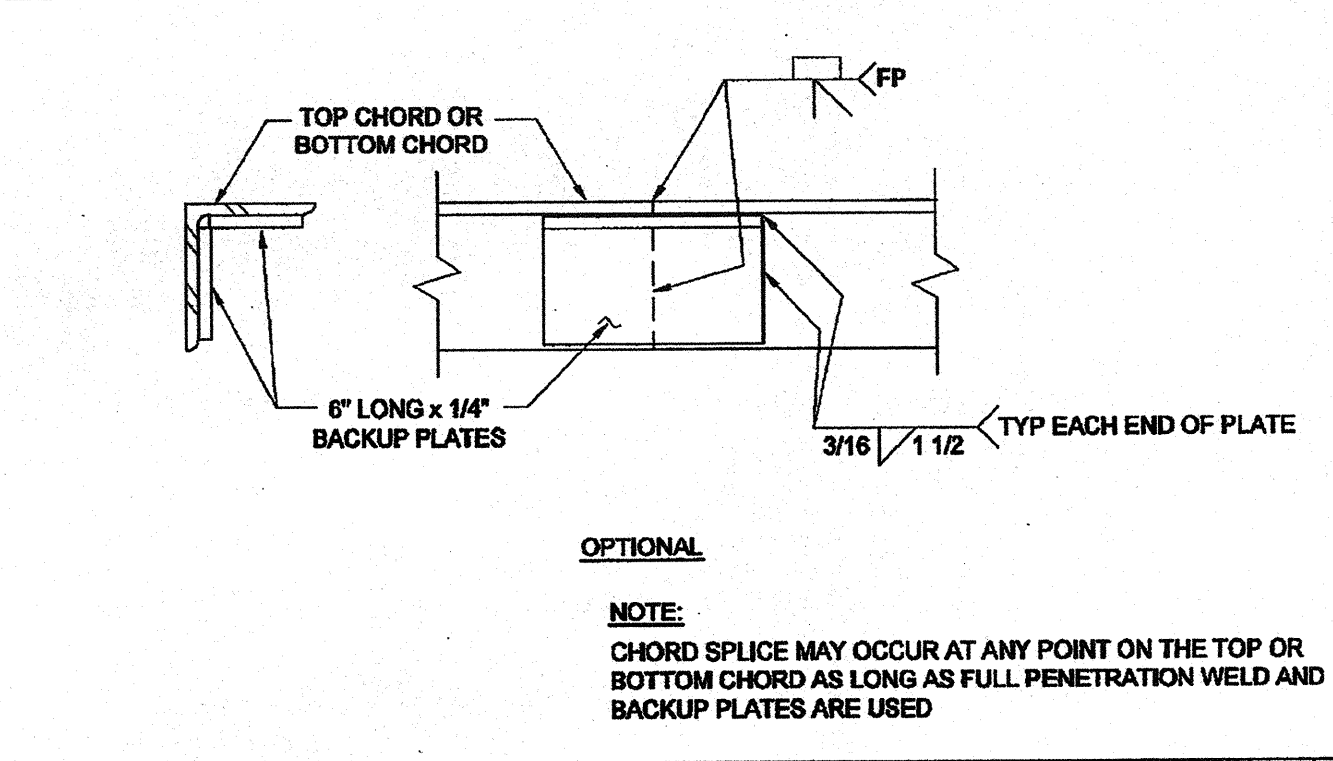

TRUSS CHORD SPLICE SCALE: 3" = 1'-0" 3

THESE DRAWINGS AND ALL MATERIAL CONTAINED HEREIN ARE THE PROPERTY OF SILVERCREEK INDUSTRIES, INC. (SCI) AND SHALL NOT BE REPRODUCED, COPIED OR OTHERWISE DISPOSED OF DIRECTLY OR INDIRECTLY AND SHALL NOT BE USED IN WHOLE OR IN PART TO ASSIST IN THE MAKING OF OR FOR THE PURPOSE OF FURNISHING ANY INFORMATION FOR THE MAKING OF DRAWINGS, PRINTS, APPARATUS OR PARTS THEREOF WITHOUT THE FULL KNOWLEDGE AND WRITTEN CONSENT OF SCI Inc.

SILVER CREEK INDUSTRIES, INC.





195 EAST MORGAN FERRIS, CALIFORNIA 92571  
PHONE: 951-943-5393 FAX: 951-943-2211

PROJECT NAME:


CLASS LEASING CLASSROOMS BLDG'S

SHEET TITLE:


ROOF FRAMING DETAILS TRUSS

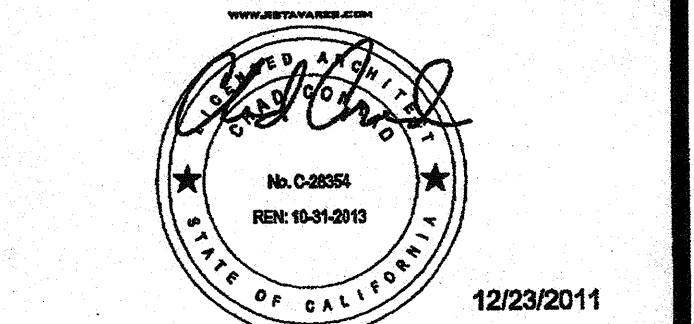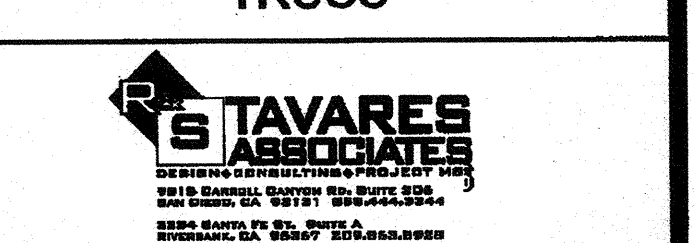


ARCHITECT OF RECORD SUBMISSION DATE

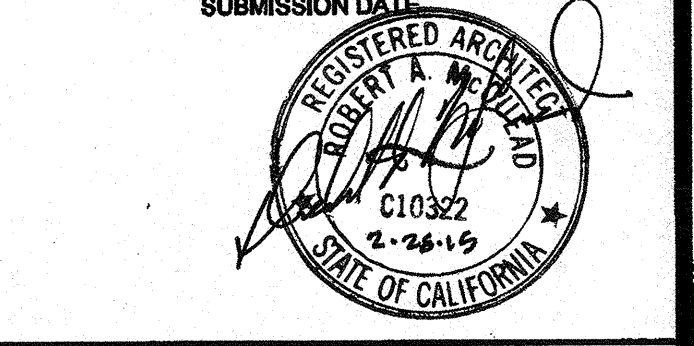

PROJECT SPECIFIC STATE AGENCY APPROVAL

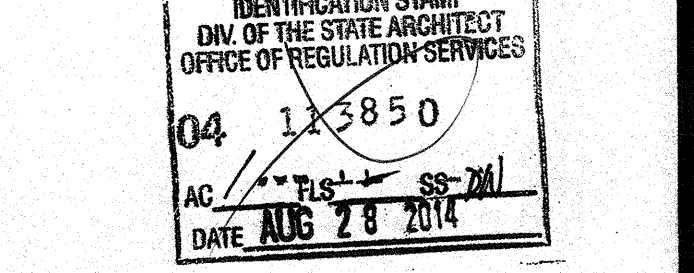

ORIGINAL PC STATE AGENCY APPROVAL

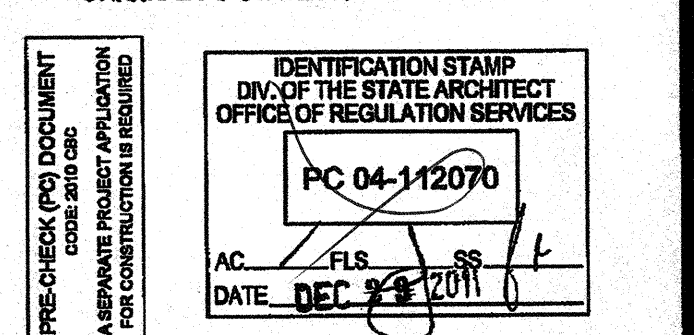

REVISIONS

NO.	DESCRIPTION

SILVER CREEK INDUSTRIES 30' x 32' PC

PROJECT NO:

DRAWN BY: AS NOTED

SCALE: 6-17-11

P.C. SHEET NUMBER

S-2.90