




PARTITION CONNECTION AT CONG FLOOR SCALE: 3/4\"/>

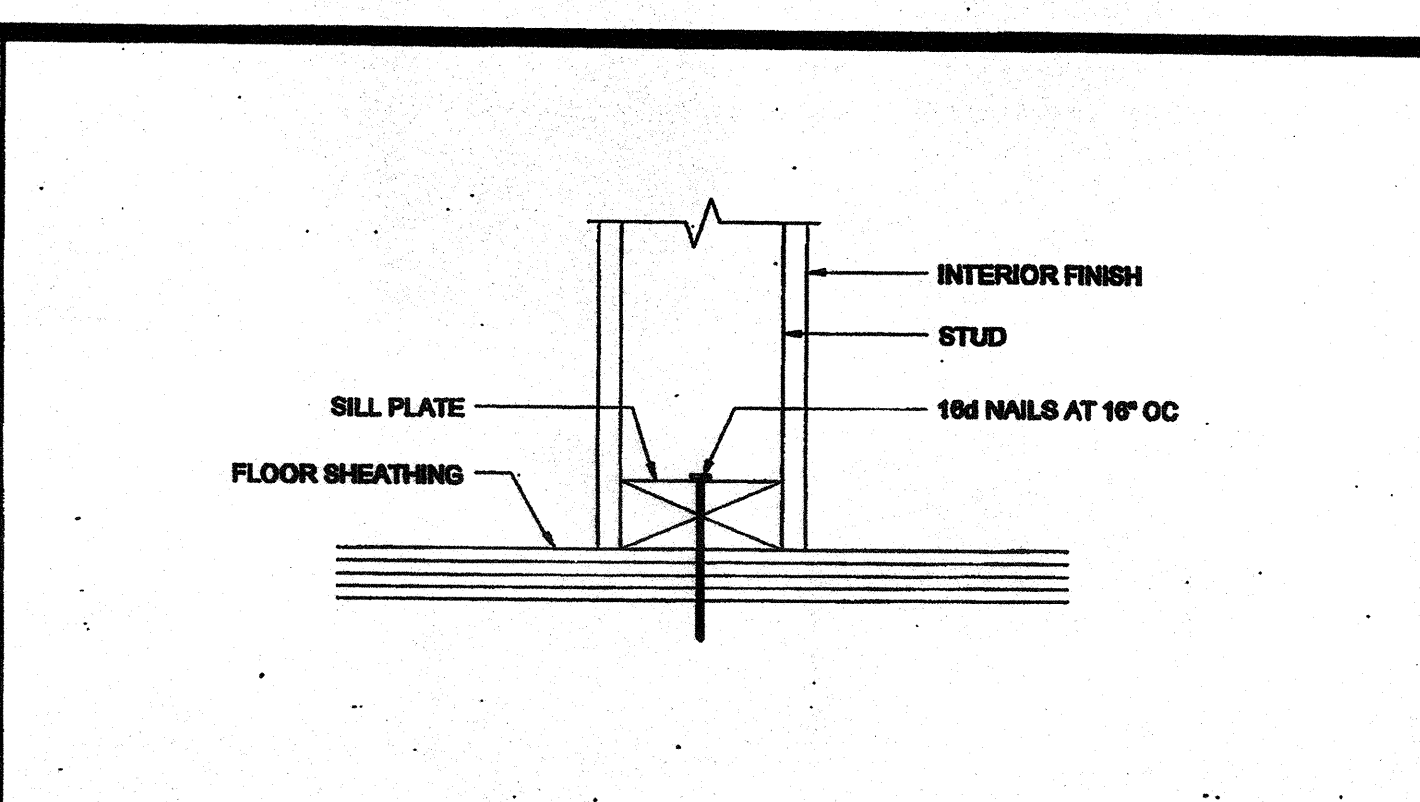


PARTITION CONNECTION AT WOOD FLOOR SCALE: 3/4\"/>

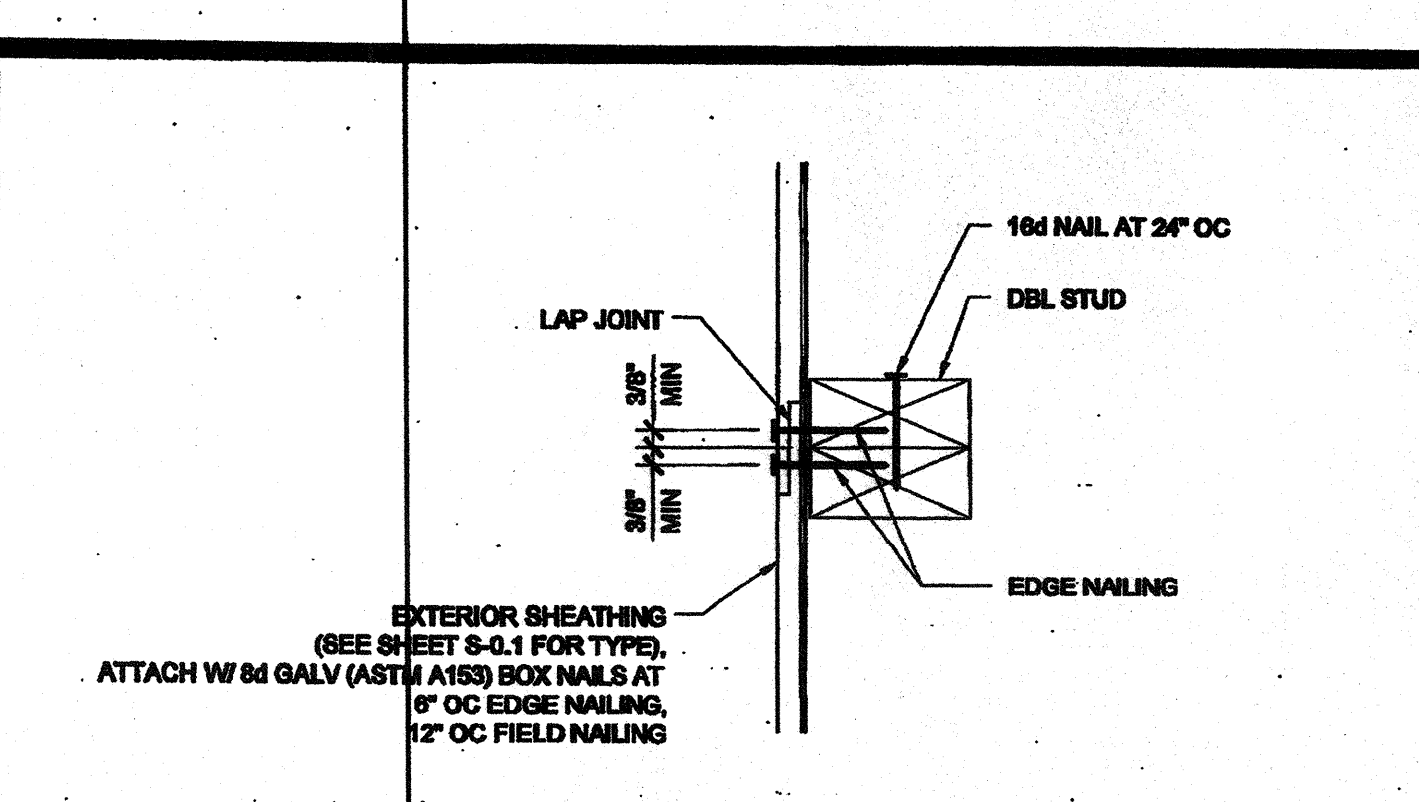


VERTICAL SHEATHING LAP JOINT SCALE: 3/4\"/>

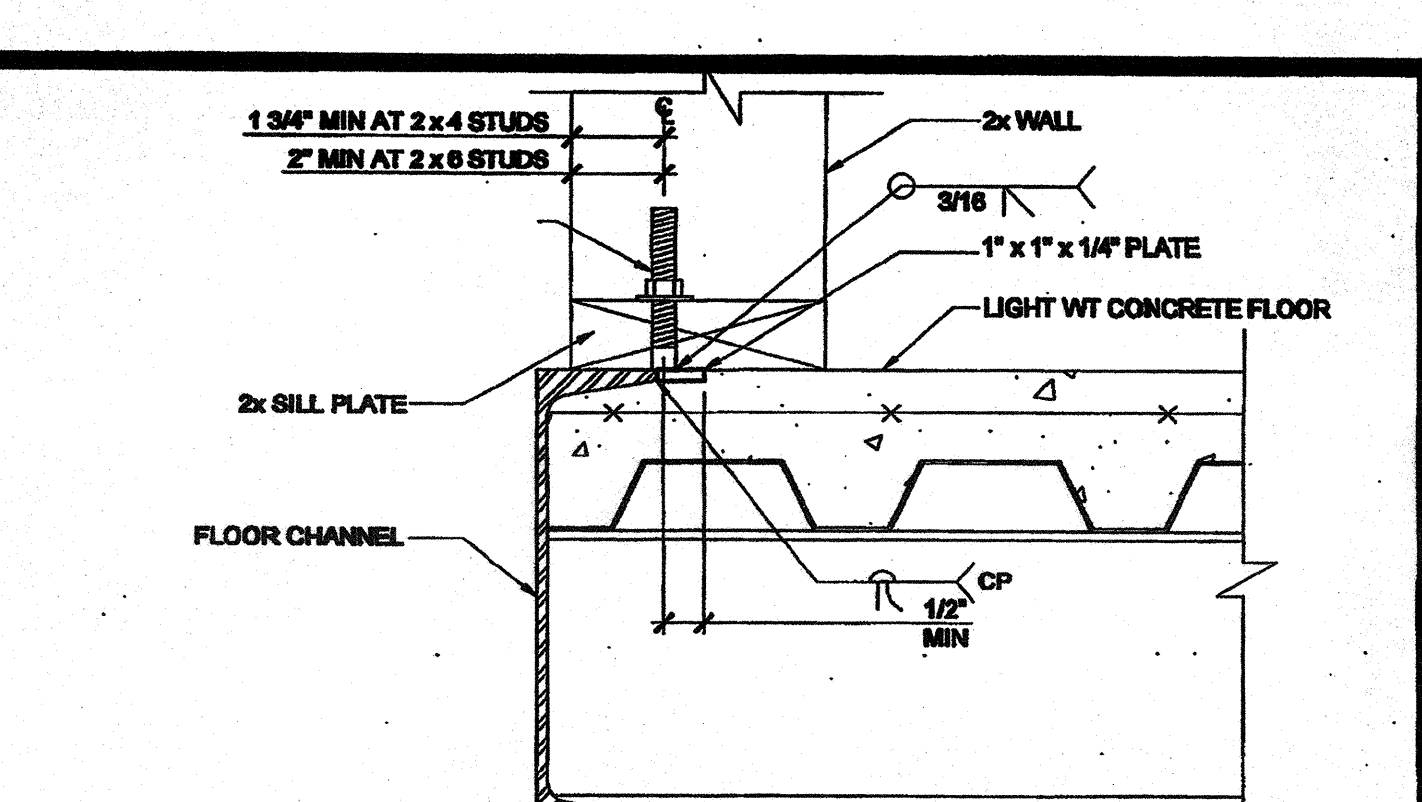


OPTIONAL BOLTED WALL TO FLOOR SCALE: NTS 1

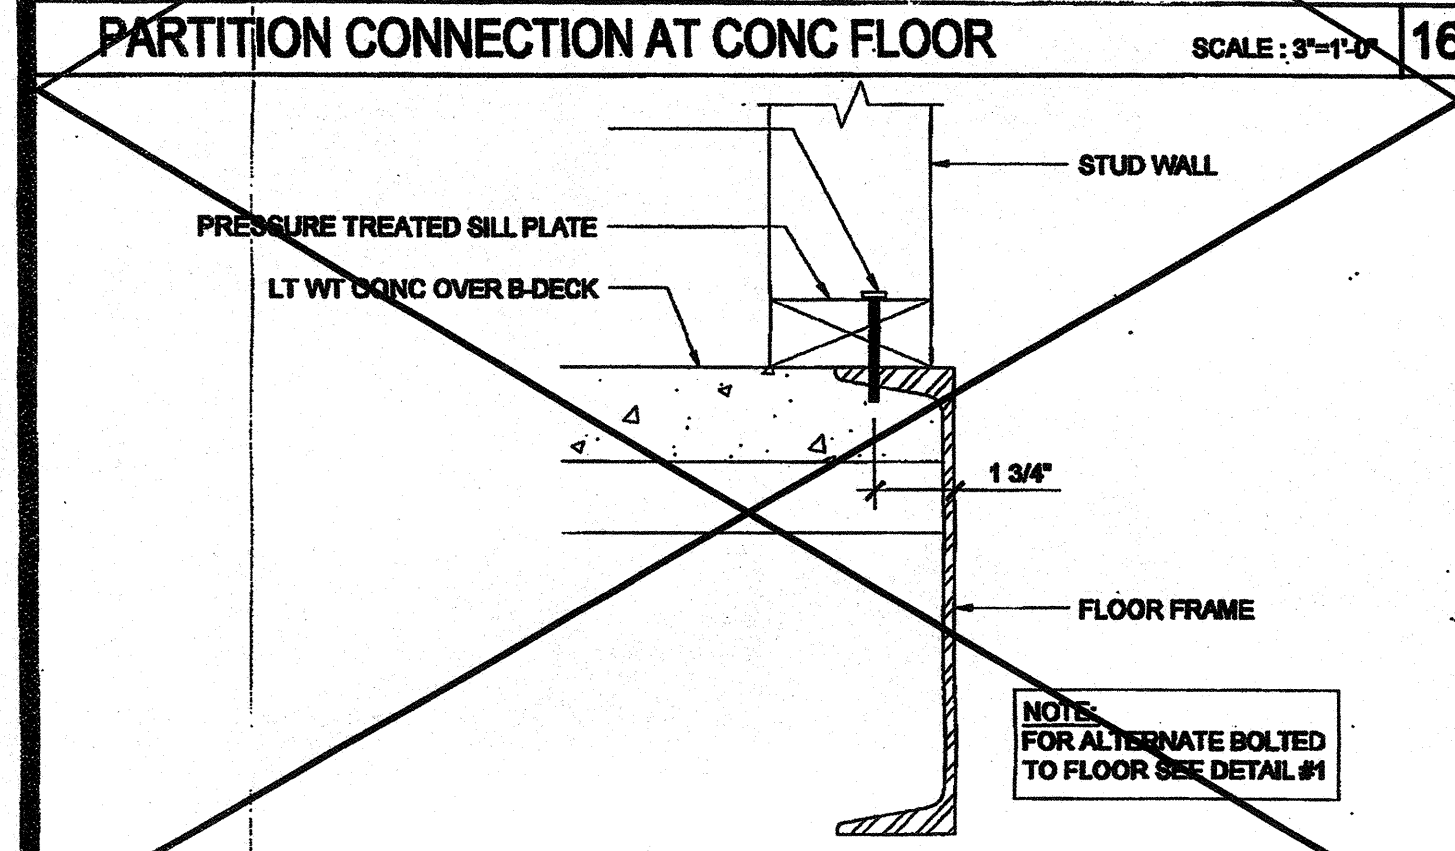


WALL SILL AT CONCRETE FLOOR SCALE: 3/4\"/>

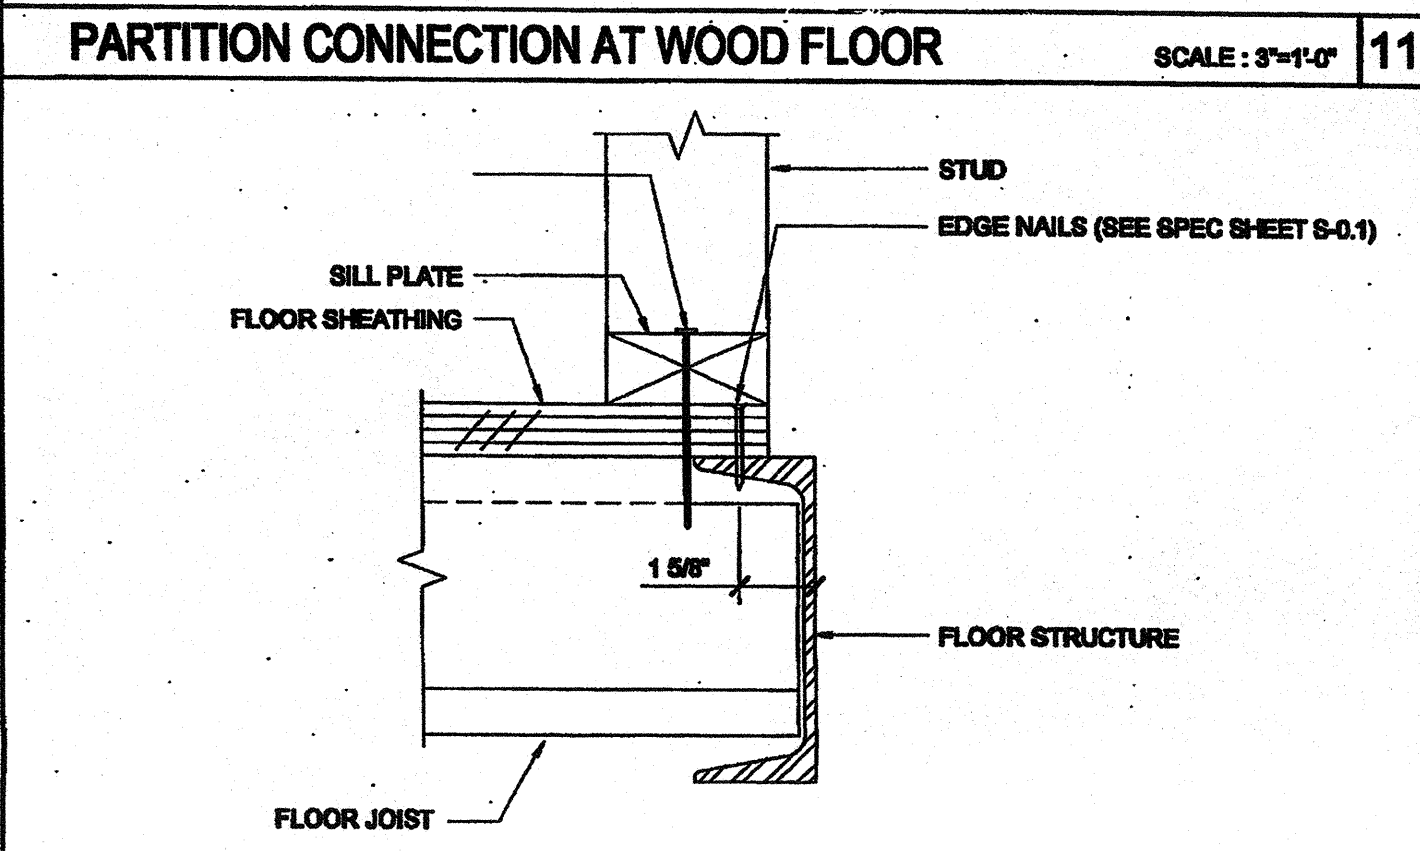


WALL SILL AT WOOD FLOOR SCALE: 3/4\"/>

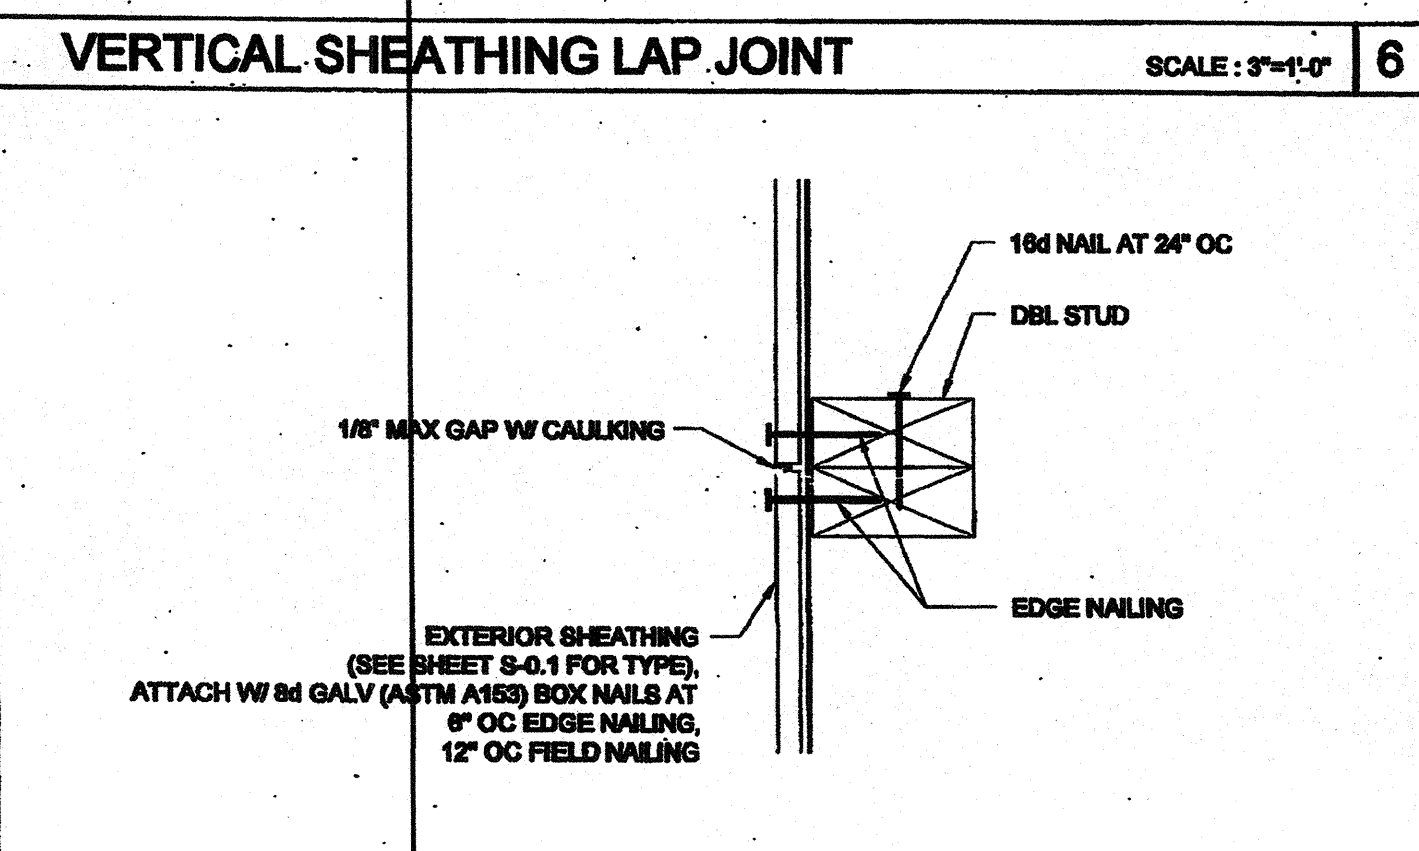


VERTICAL SHEATHING BUTT JOINT SCALE: 3/4\"/>

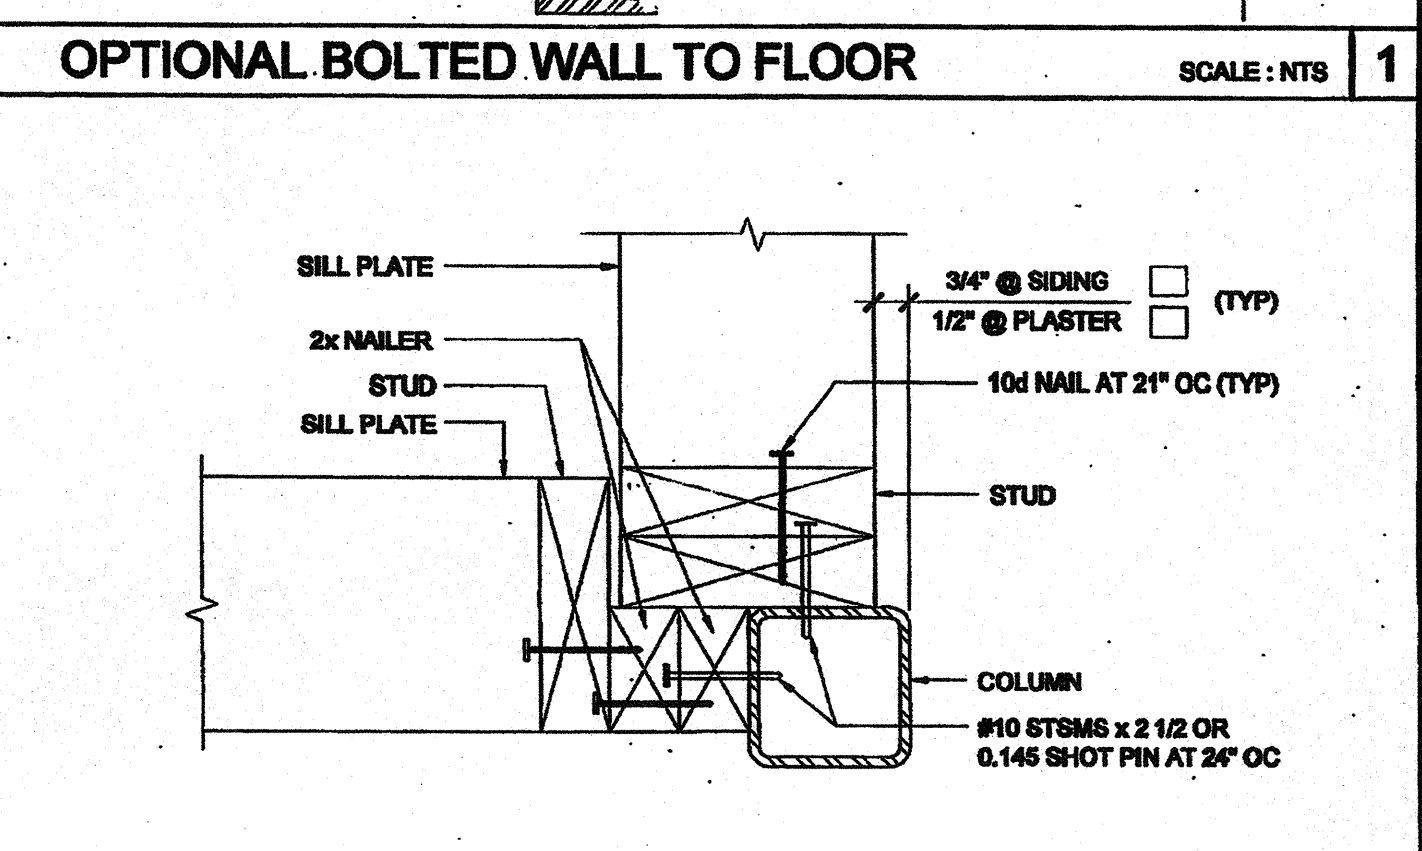


COLUMN AT ENDWALL (2x6) SCALE: 3/4\"/>

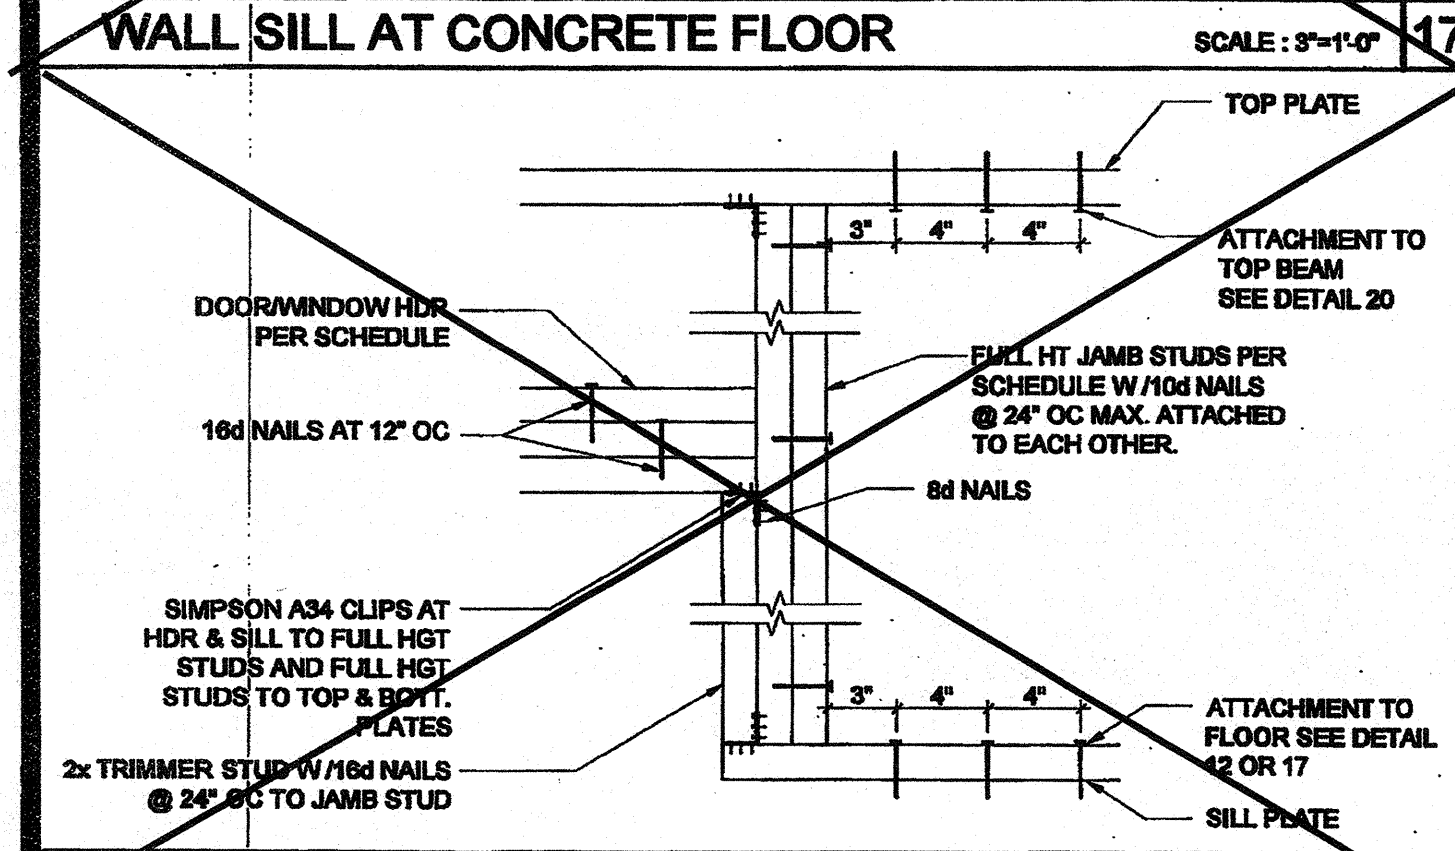

DOOR/WINDOW HEADER AND JAMB SCALE: 1 1/2\"/>

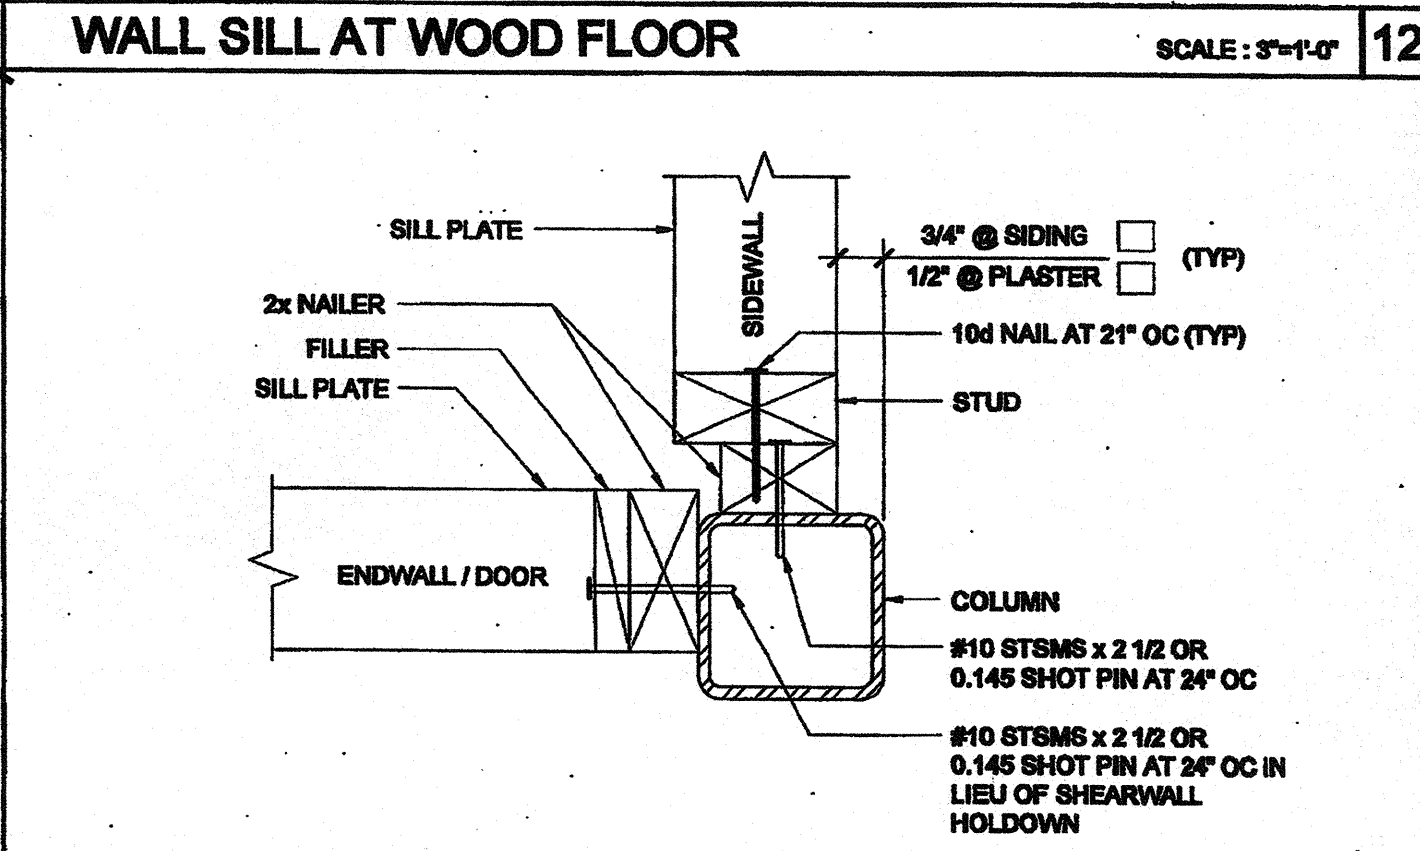


COLUMN AT ENDWALL SCALE: 3/4\"/>

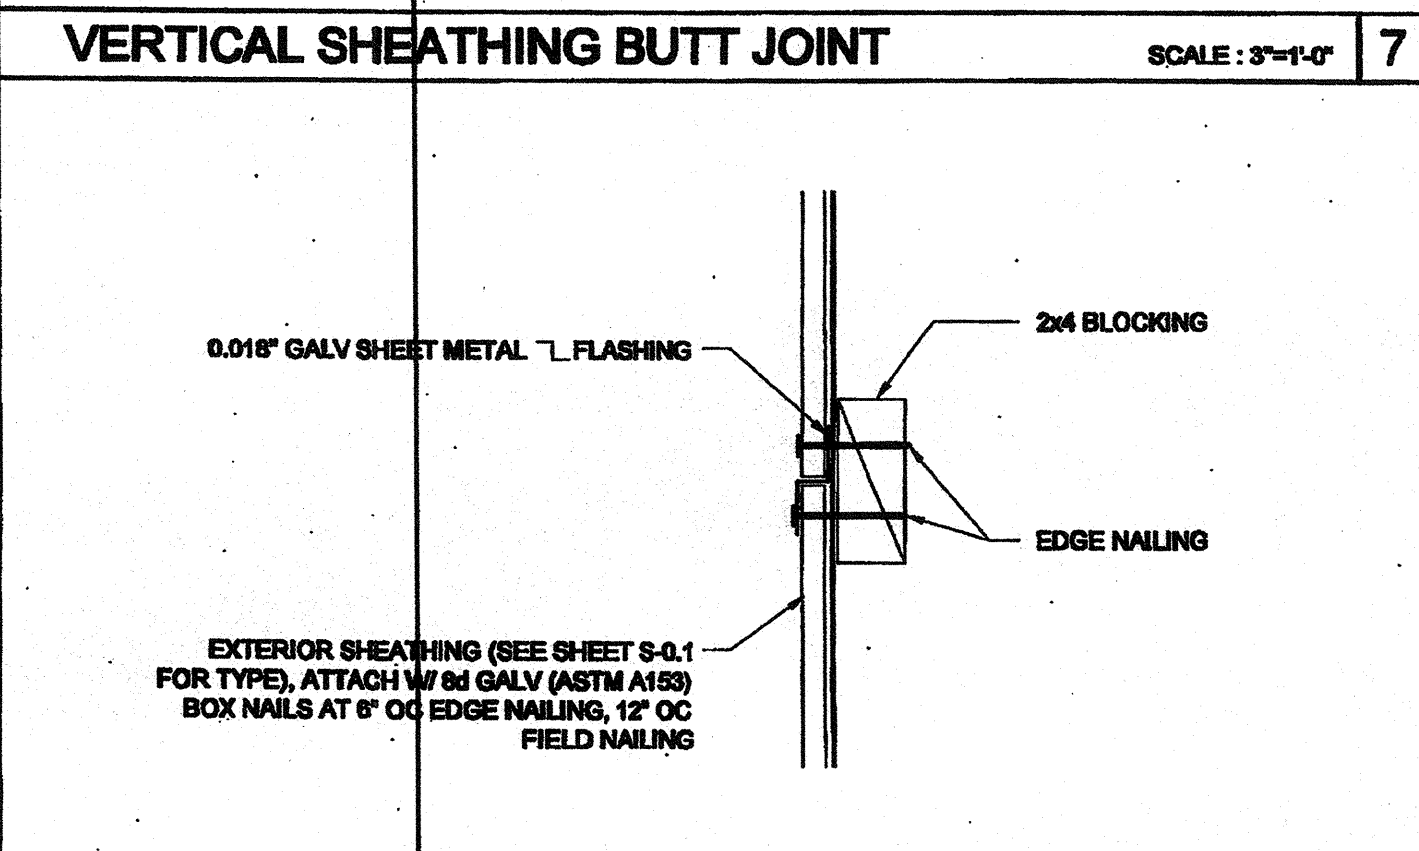


HORIZONTAL SHEATHING JOINT SCALE: 3/4\"/>


COLUMN HEIGHT	OPENING SIZE	EXT. FINISH				HEADER				SILL				FULL HEIGHT KING STUD							
		NUMBER	SIZE	LUMBER TYPE	NUMBER	SIZE	LUMBER TYPE	NUMBER	SIZE	LUMBER TYPE	NUMBER	SIZE	LUMBER TYPE	NUMBER	SIZE	LUMBER TYPE					
3070	NO PLASTER	(1)	2x4	HF	#2	N/A	N/A	(2)	2x4	HF	#2	(2)	2x4	HF	#2	(2)	2x4	DF	#2		
		(1)	2x4	DF	#2	N/A	N/A	(2)	2x4	DF	#2	(2)	2x4	DF	#2	(2)	2x4	DF	#2		
		(1)	2x4	HF	#2	N/A	N/A	(2)	2x4	DF	#2	(2)	2x4	DF	#2	(2)	2x4	DF	#2		
4070	NO PLASTER	(1)	2x4	HF	#2	N/A	N/A	(2)	2x4	HF	#2	(2)	2x4	HF	#2	(2)	2x4	DF	#2		
		(1)	2x4	DF	#2	N/A	N/A	(2)	2x4	DF	#2	(2)	2x4	DF	#2	(2)	2x4	DF	#2		
		(1)	2x4	HF	#2	N/A	N/A	(2)	2x4	DF	#2	(2)	2x4	DF	#2	(2)	2x4	DF	#2		
6040	NO PLASTER	(1)	2x4	HF	#2	(1)	2x4	HF	#2	(2)	2x4	HF	#2	(2)	2x4	HF	#2	(2)	2x4	DF	#2
		(1)	2x4	DF	#2	(1)	2x4	DF	#2	(2)	2x4	DF	#2	(2)	2x4	DF	#2	(2)	2x4	DF	#2
		(2)	2x4	HF	#2	(2)	2x4	HF	#2	(4)	2x4	HF	#2	(4)	2x4	HF	#2	(4)	2x4	DF	#2
8040	NO PLASTER	(2)	2x4	DF	#2	(2)	2x4	DF	#2	(2)	2x4	DF	#2	(2)	2x4	DF	#2	(2)	2x4	DF	#2
		(2)	2x4	HF	#2	(2)	2x4	HF	#2	(2)	2x4	HF	#2	(2)	2x4	HF	#2	(2)	2x4	DF	#2
		(2)	2x4	DF	#2	(2)	2x4	DF	#2	(2)	2x4	DF	#2	(2)	2x4	DF	#2	(2)	2x4	DF	#2

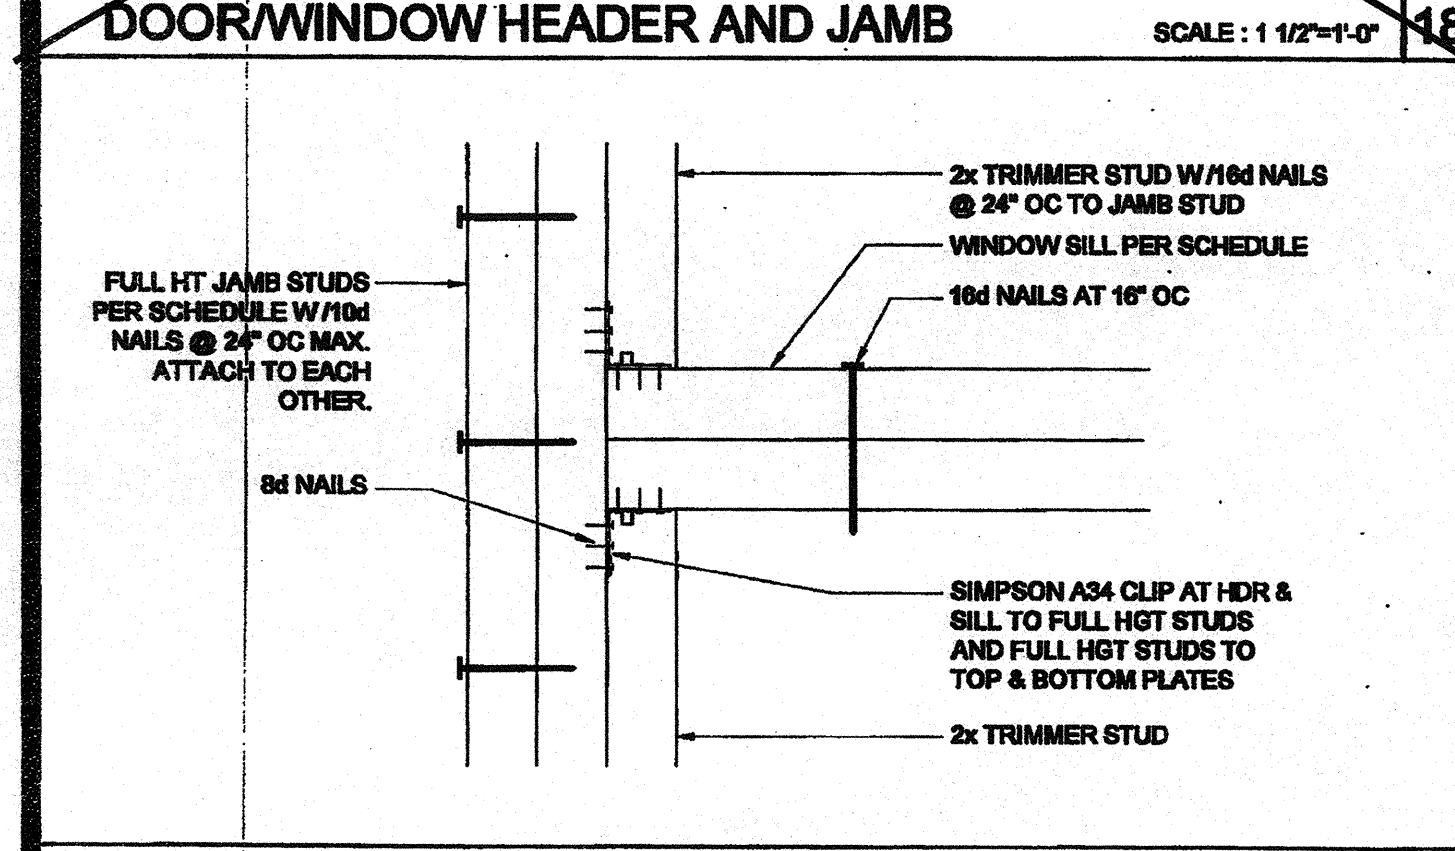

WINDOW SILL AND JAMB SCALE: 3/4\"/>

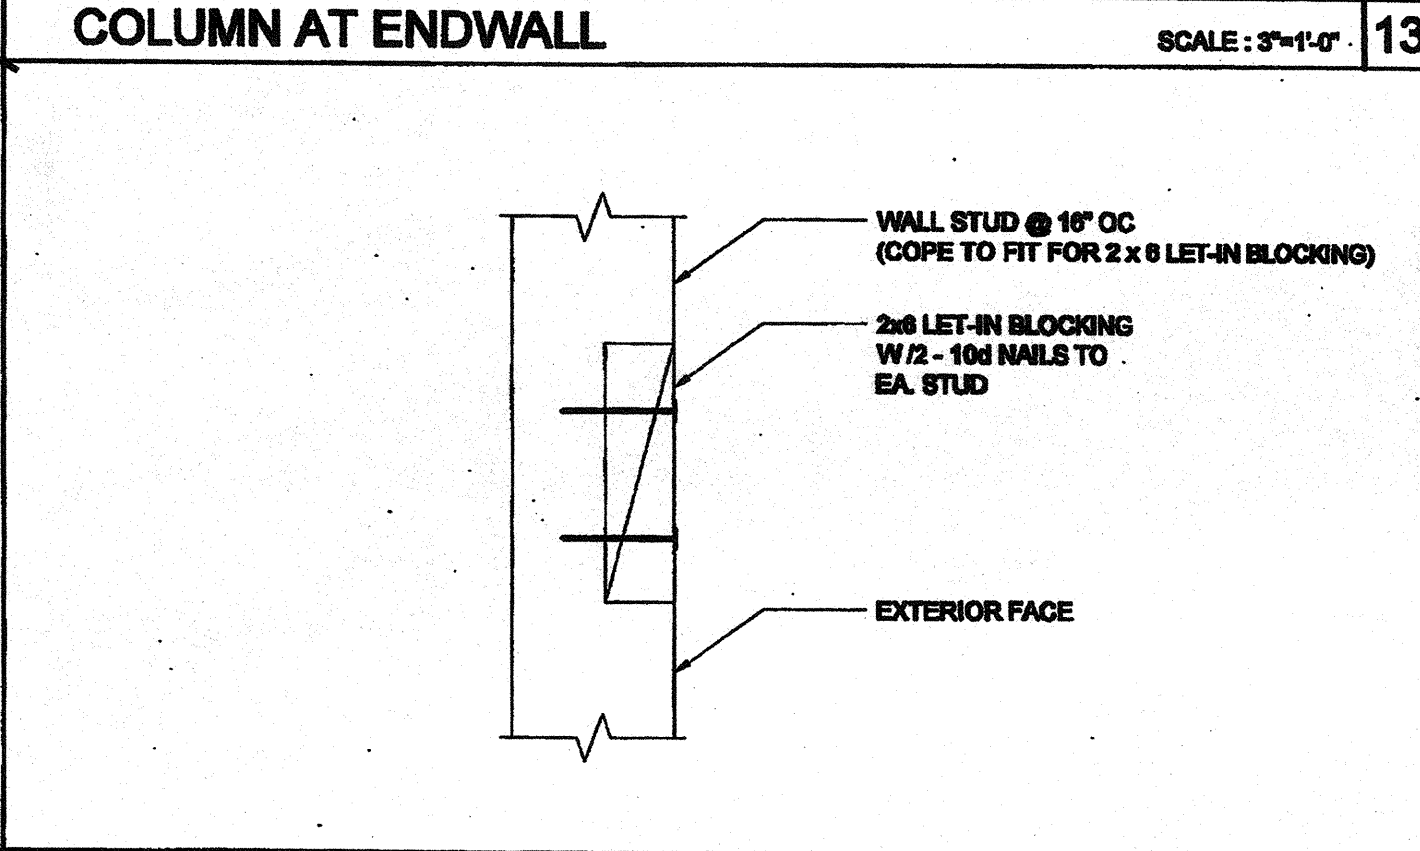


LET-IN BLOCK ATTACHMENT SCALE: 3/4\"/>

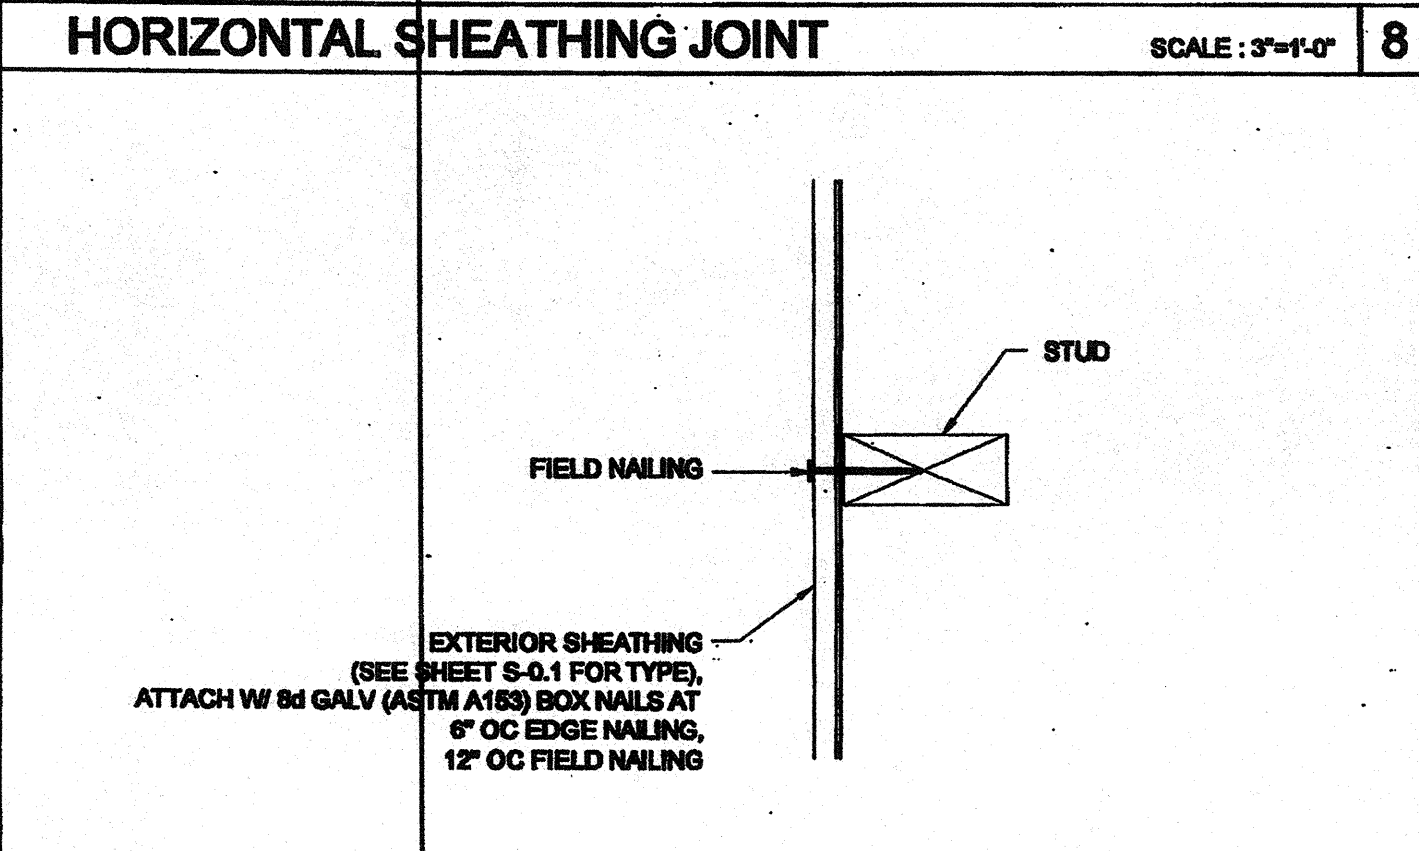

SECTION AT SHEATHING TO STUD ATTACHMENT SCALE: 3/4\"/>


COLUMN HEIGHT	OPENING SIZE	EXT. FINISH				HEADER				SILL				FULL HEIGHT KING STUD							
		NUMBER	SIZE	LUMBER TYPE	NUMBER	SIZE	LUMBER TYPE	NUMBER	SIZE	LUMBER TYPE	NUMBER	SIZE	LUMBER TYPE	NUMBER	SIZE	LUMBER TYPE					
3070	NO PLASTER	(1)	2x4	HF	#2	N/A	N/A	(2)	2x4	HF	#2	(2)	2x4	HF	#2	(2)	2x4	DF	#2		
		(1)	2x4	DF	#2	N/A	N/A	(2)	2x4	DF	#2	(2)	2x4	DF	#2	(2)	2x4	DF	#2		
		(1)	2x4	HF	#2	N/A	N/A	(2)	2x4	DF	#2	(2)	2x4	DF	#2	(2)	2x4	DF	#2		
4070	NO PLASTER	(1)	2x4	HF	#2	N/A	N/A	(2)	2x4	HF	#2	(2)	2x4	HF	#2	(2)	2x4	DF	#2		
		(1)	2x4	DF	#2	N/A	N/A	(2)	2x4	DF	#2	(2)	2x4	DF	#2	(2)	2x4	DF	#2		
		(1)	2x4	HF	#2	N/A	N/A	(2)	2x4	DF	#2	(2)	2x4	DF	#2	(2)	2x4	DF	#2		
6040	NO PLASTER	(1)	2x4	DF	#2	(1)	2x4	DF	#2	(2)	2x4	DF	#2	(2)	2x4	DF	#2	(2)	2x4	DF	#2
		(1)	2x4	HF	#2	(1)	2x4	HF	#2	(2)	2x4	HF	#2	(2)	2x4	HF	#2	(2)	2x4	DF	#2
		(2)	2x4	DF	#2	(2)	2x4	DF	#2	(2)	2x4	DF	#2	(2)	2x4	DF	#2	(2)	2x4	DF	#2
8040	NO PLASTER	(2)	2x4	HF	#2	(2)	2x4	HF	#2	(2)	2x4	HF	#2	(2)	2x4	HF	#2	(2)	2x4	DF	#2
		(2)	2x4	DF	#2	(2)	2x4	DF	#2	(2)	2x4	DF	#2	(2)	2x4	DF	#2	(2)	2x4	DF	#2
		(2)	2x4	HF	#2	(2)	2x4	HF	#2	(2)	2x4	HF	#2	(2)	2x4	HF	#2	(2)	2x4	DF	#2

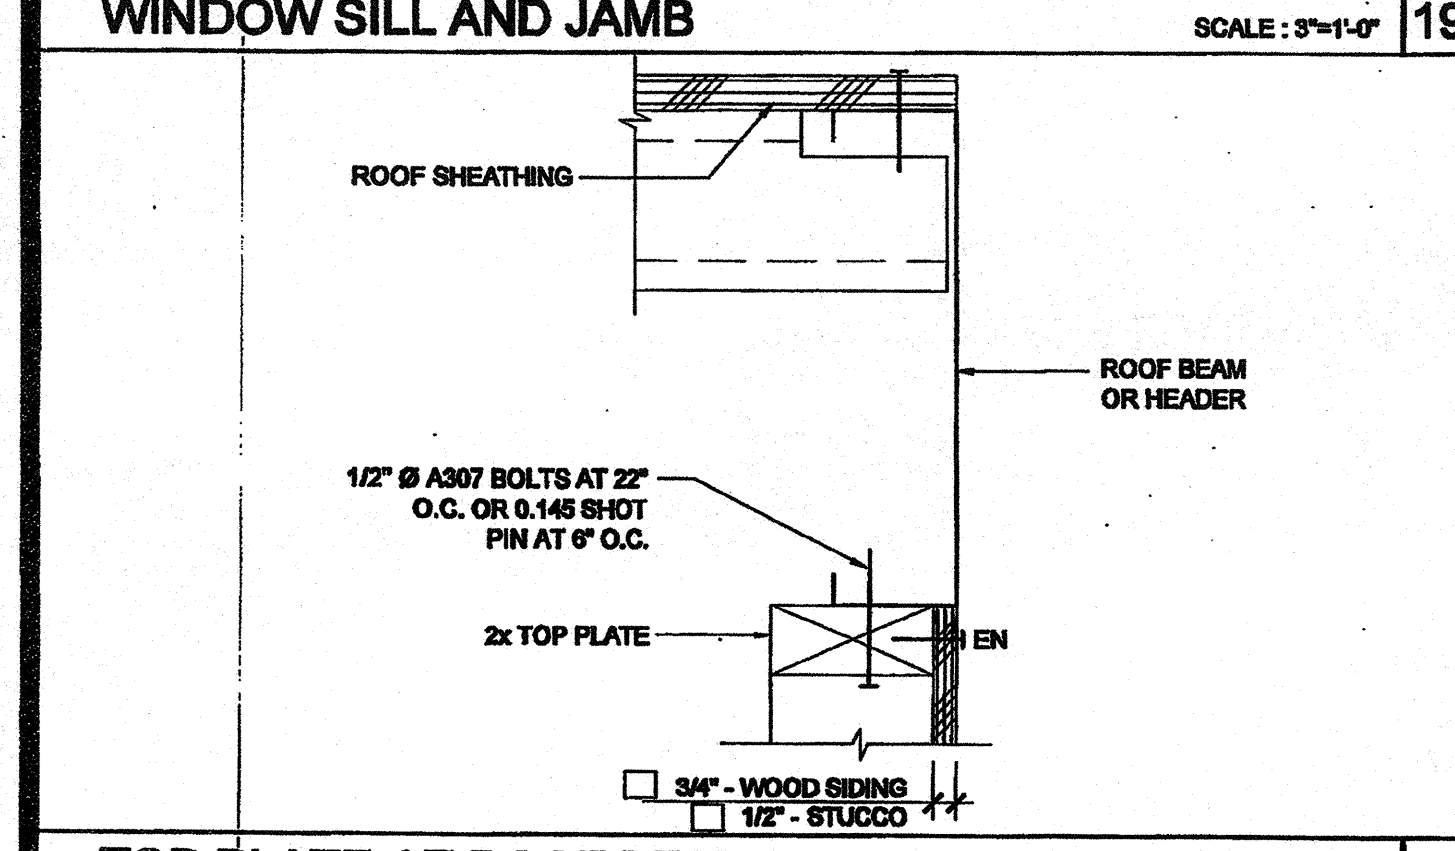

TOP PLATE AT ROOF BEAM SCALE: 3/4\"/>

DOOR	WINDOW	STANDARD	WELDED FRAME
3070	26"	85"	28 1/4" 88 1/4"
3070	36"	85"	40 1/4" 88 1/4"
4070	50"	85"	52 1/4" 88 1/4"
6070	74"	85"	76 1/4" 88 1/4"
4040	47 3/4"	47 5/8"	52 1/4" 52 1/4"
6040	71 3/4"	47 5/8"	76 1/4" 52 1/4"
8040	95 3/4"	47 5/8"	100 1/4" 52 1/4"
6020	71 3/4"	23 5/8"	76 1/4" 28 1/4"
8020	95 3/4"	23 5/8"	100 1/4" 28 1/4"

ROUGH OPENING SCHEDULE SCALE: 3/4\"/>

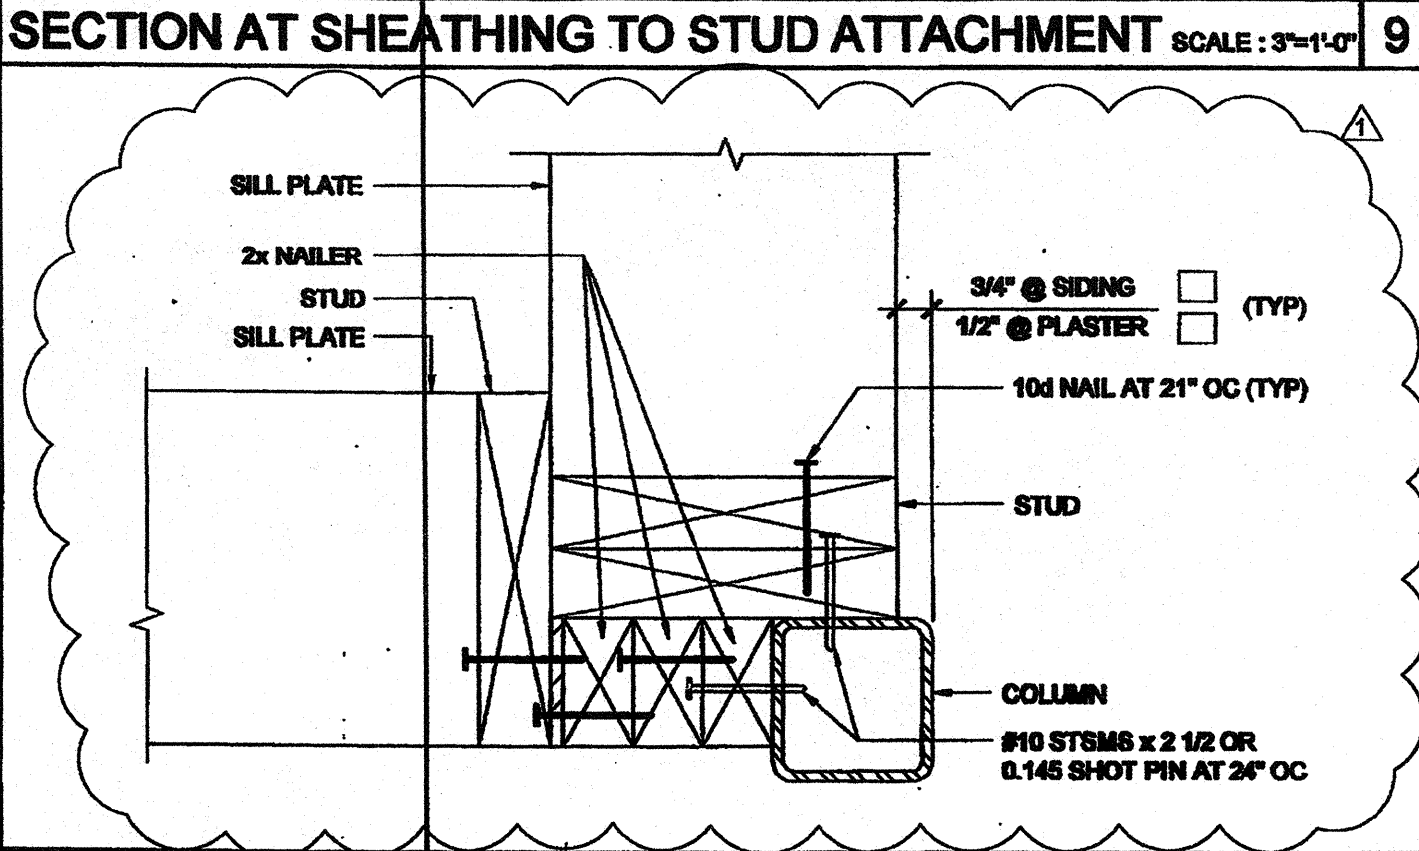

COLUMN AT ENDWALL (2x8) SCALE: 3/4\"/>

COLUMN HEIGHT	OPENING SIZE	WOOD WALL FRAMING				# CORNER OF WOOD WALL FRAMING (ZONE B)					
		NUMBER	SIZE	LUMBER TYPE	OC	NUMBER	SIZE	LUMBER TYPE	OC		
LESS THAN 9'-0"	NO PLASTER	(1)	2x4	HF	#2	16" OC	(1)	2x4	HF	#2	16" OC
		(1)	2x4	DF	#2	16" OC	(1)	2x4	DF	#2	16" OC
		(1)	2x4	HF	#2	16" OC	(1)	2x4	DF	#2	16" OC
9'-0" TO 10'-0"	NO PLASTER	(1)	2x4	HF	#2	16" OC	(1)	2x4	DF	#2	16" OC
		(1)	2x4	DF	#2	16" OC	(1)	2x4	DF	#2	16" OC
		(1)	2x4	HF	#2	16" OC	(1)	2x4	DF	#2	16" OC

WALL FRAMING SCHEDULE - 100 MPH SCALE: 3/4\"/>

THESE DRAWINGS AND ALL MATERIAL CONTAINED HEREIN ARE THE PROPERTY OF SILVER CREEK INDUSTRIES, INC. (SCI) AND SHALL NOT BE REPRODUCED, COPIED OR OTHERWISE DISPOSED OF DIRECTLY OR INDIRECTLY AND SHALL NOT BE USED IN WHOLE OR IN PART TO ASSIST IN THE MAKING OF OR FOR THE PURPOSE OF FURNISHING ANY INFORMATION FOR THE MAKING OF DRAWINGS, PRINTS, APPARATUS OR PARTS THEREOF WITHOUT THE FULL KNOWLEDGE AND WRITTEN CONSENT OF SCI Inc. ALL PATENTABLE MATERIAL CONTAINED HEREIN AND ORIGINATING WITH SCI Inc SHALL BE THE PROPERTY OF SCI Inc.

SILVER CREEK INDUSTRIES, INC.





195 EAST MORGAN FERRIS, CALIFORNIA 92571
PHONE: 951-943-5393 FAX: 951-943-2211

PROJECT NAME:


CLASS LEASING CLASSROOMS BLDG'S

SHEET TITLE:


WALL FRAMING DETAILS WOOD STUDS

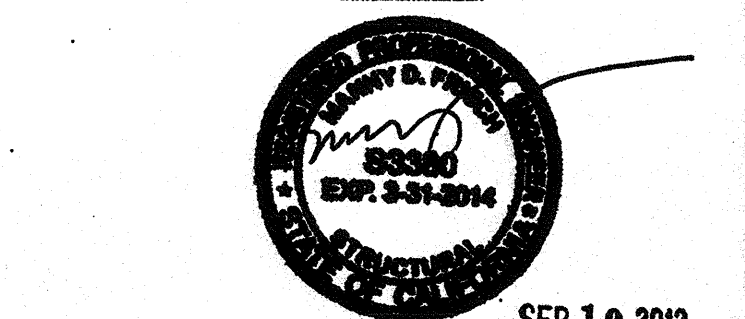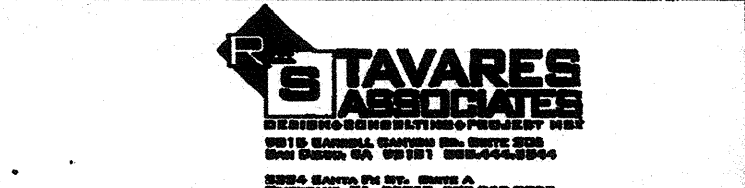


ARCHITECT OF RECORD SUBMISSION DATE SEP 19 2012

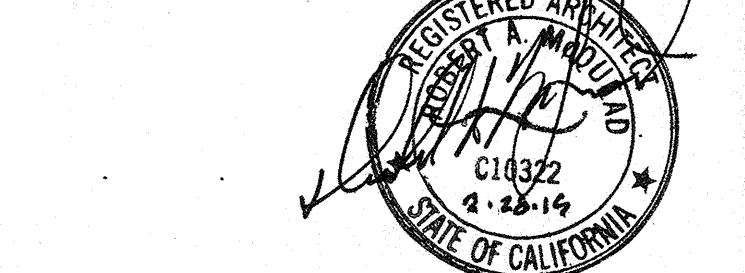

PROJECT SPECIFIC STATE AGENCY APPROVAL

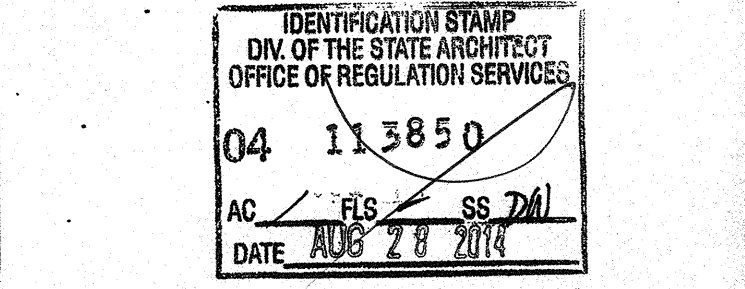

ORIGINAL PC STATE AGENCY APPROVAL

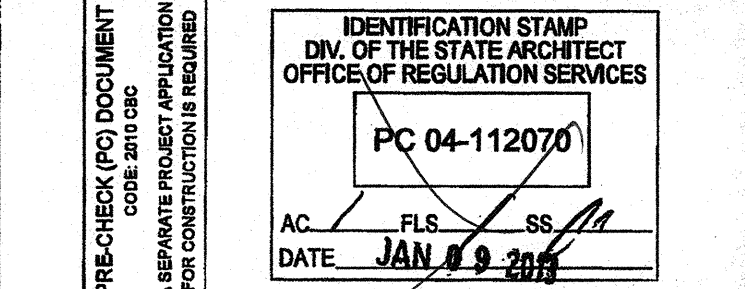

REVISIONS

PC REVISION 07/24/2012

SILVER CREEK INDUSTRIES 30 x 32 PC

PROJECT NO:

DRAWN BY:

SCALE: AS NOTED

DATE: 6-17-11

P.C. SHEET NUMBER

S-5.10