



SYM,	LOCATION	SERVICE	MANUF.	MODEL	CFM	SONES	SP	ELECTRICAL				
								VOLTS	Ø	POWER	WGT.	REMARKS
EF 1	CEILING	TOILET EXHAUST	BROAN	676	100	4.0	0.25	120	1	156 WATTS	7 LBS.	WITH BROAN ROOF CAP #836, PROVIDE 4" DIA EXHAUST DUCT UP TO ROOF, INTERLOCK WITH LIGHT SWITCH.
2 P	CEILING	TOILET EXHAUST	BROAN	L100	109	1.0	0.25	120	1	87 WATTS	22.80 LBS.	WITH BROAN ROOF CAP #634. PROVIDE 6" DIA EXHAUST DUCT UP TO ROOF, INTERLOCK WITH LIGHT SWITCH.
EF 3	CEILING	TOILET EXHAUST	BROAN	L200	210	2.0	0.25	120	1	127 WATTS	23.0 LBS.	WITH BROAN ROOF CAP #634. PROVIDE 8" DIA EXHAUST DUCT UP TO ROOF. INTERLOCK WITH LIGHT SWITCH.
EF 4	CEILING	TOILET EXHAUST	BROAN	L300	308	2.8	0.25	120	1	212 WATTS	23.10 LBS.	WITH BROAN ROOF CAP #634. PROVIDE 8" DI/ EXHAUST DUCT UP TO ROOF. INTERLOCK WITH LIGHT SWITCH.

ITEM	NECK SIZE	RANGE CFM	MFG & MODEL #			
SUPPR	6°Ø 0 - 150		Fixed Curve Blade, 4-way throw			
SUPPLY	8°Ø 150 - 230	150 - 230	For lay-in T-bar ceilings use Harth & Cooley SD-94			
	10 " Ø	230 - 350	(Sizes as shown on Mech Plan)			
16X16-4W	127Ø	350 - 460				
	147Ø	460 - 640				

ITEM	NECK SIZE	RANGE CFM	MFG & MODEL#		
T-BAR RETURN	670	0 - 230	Perforated face		
	10"Ø	230 - 460	For lay-in T-bar ceilings use Shoemaker 105P with 24 ga., 45 deg. angle. (Sizes as shown on Mech Plan.)		
	1479	460 - 710			

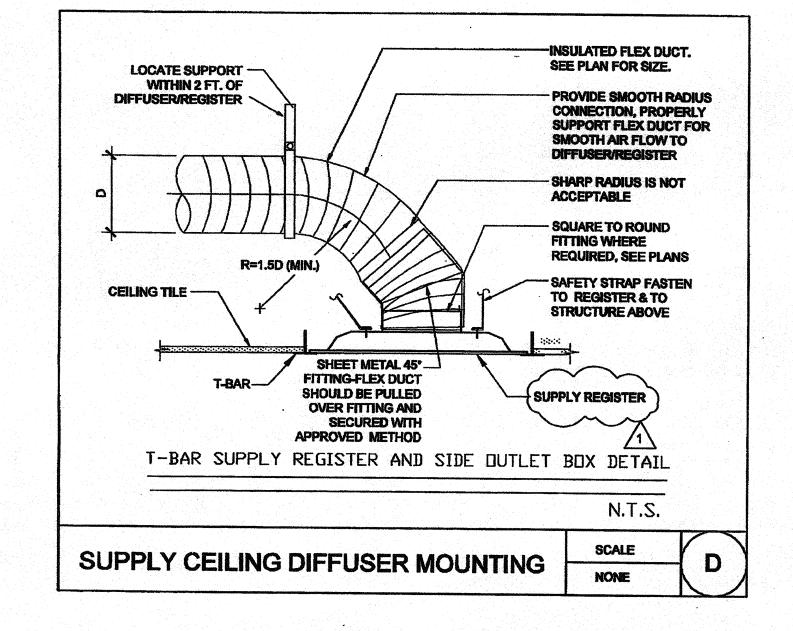

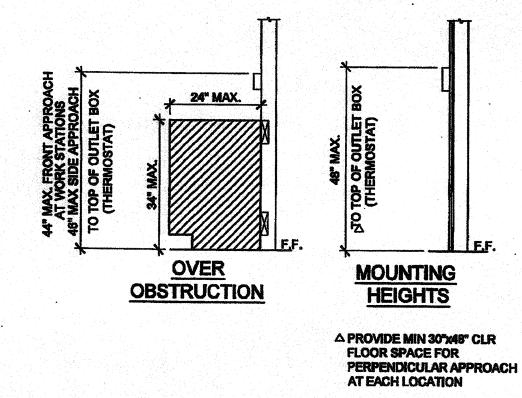

GENERAL NOTES

ALL MECHANICAL, PLUMBING AND ELECTRICAL COMPONENTS SHALL BE ANCHORED AND INSTALLED PER THE DETAILS ON THE DSA APPROVED CONSTRUCTION DOCUMENTS. WHERE NO DETAIL IS INDICATED, THE FOLLOWING COMPONENTS SHALL BE ANCHORED OR BRACED TO MEET THE FORCE AND DISPLACEMENT REQUIREMENTS PRESCRIBED IN THE 2010 CBC, SECTIONS 1615A.1.12 THROUGH 1615A.1.22 AND ASCE 7-05 CHAPTER 8 AND 13.

- AL PERMANENT EQUIPMENT AND COMPONENTS.
 TEMPORARY OR MOVABLE EQUIPMENT THAT IS
 PERMANENTLY ATTACHED (E.G. HARD WIRED) TO THE
 BUILDING UTILITY SERVICES SUCH AS ELECTRICITY, GAS
- OR WATER.

 3. MOVABLE EQUIPMENT WHICH IS STATIONED IN ONE PLACE FOR MORE THAN 8 HOURS AND HEAVIER THAN 400 POUNDS ARE REQUIRED TO BE ANCHORED WITH TEMPORARY ATTACHMENTS.
- THE ATTACHMENT OF THE FOLLOWING MECHANICAL AND ELECTRICAL COMPONENTS SHALL BE POSITIVELY ATTACHED TO THE STRUCTURE, BUT NEED NOT BE DETAILED ON THE PLANS. THESE COMPONENTS SHALL HAVE FLEXIBLE CONNECTIONS PROVIDED BETWEEN THE COMPONENT AND ASSOCIATED DUCTWORK, PIPING, AND CONDUIT.
- COMPONENTS WEIGHING LESS THAN 400 POUNDS AND HAVE A CENTER OF MASS LOCATED 4 FEET OR LESS ABOVE THE ADJACENT FLOOR OR ROOF LEVEL THAT DIFFECTLY SUPPORT THE COMPONENT. COMPONENTS WEIGHING LESS THAN 20 POUNDS, OR IN THE CASE OF DISTRIBUTED SYSTEMS, LESS THAN 5 POUNDS PER FOOT, WHICH ARE SUSPENDED FROM A ROOF OR FLOOR OR HUNG FROM A WALL.

FOR THOSE ELEMENTS THAT DO NOT REQUIRE DETAILS ON THE APPROVED DRAWINGS, THE INSTALLATION SHALL BE SUBJECT TO THE APPROVAL OF THE STRUCTURAL ENGINEER OF RECORD AND THE DSA DISTRICT STRUCTURAL ENGINEER. THE PROJECT INSPECTOR WILL VERIFY THAT ALL COMPONENTS AND EQUIPMENT HAVE BEEN ANCHORED IN ACCORDANCE WITH ABOVE REQUIREMENTS.


PIPING, DUCTWORK AND ELECTRICAL DISTRIBUTION SYSTEM BRACING NOTE

PIPING, BUCTWORK AND ELECTRICAL DISTRIBUTION SYSTEMS SHALL BE BRACED TO COMPLY WITH THE FORCES AND DISPLACEMENTS PRESCRIBED IN ASCE 7-05 SECTION 13.3 AS EFINED IN ASCE 7-05 SECTION 13.6.8, 13.6.7, 13.6.5.6 AND 2010 CBC SECTIONS 1615A.1.20, 1615A.1.21 AND 1615A.1.22.

THE BRACING AND ATTACHMENTS TO THE STRUCTURE SHALL BE DETAILED ON THE APPROVED DRAWINGS OR THEY SHALL COMPLY MITH ONE OF THE OSHPD PRE-APPROVALS (OPA #) AS MODIFIED TO SATISFY ANCHORAGE REQUIREMENTS OF ACI 318, APPENDIX D.

COPIES OF THE MANUAL SHALL BE AVAILABLE ON THE JOBSITE PRIOR TO THE START OF HANGING AN BRACING OF THE PIPE, DUCTWORK AND ELECTRICAL DISTRIBUTION SYSTEMS.

THE STRUCTURAL ENGINEER OF RECORD SHALL VERIFY THE ADEQUACY OF THE STRUCTURE TO SUPPORT THE HANGER AND BRACE LOADS.

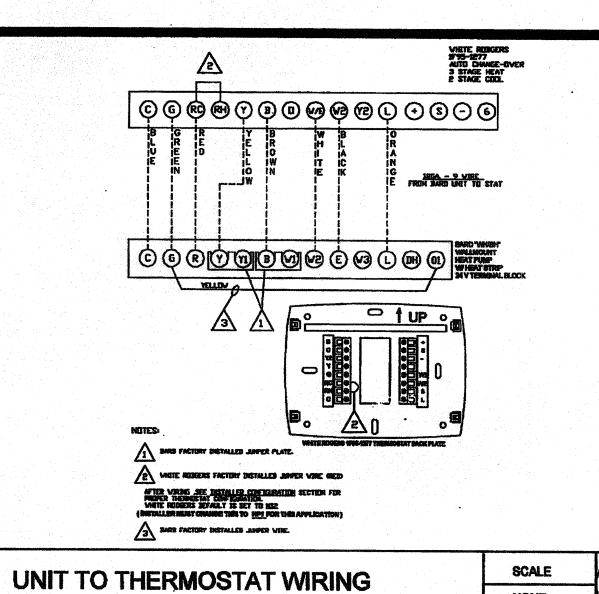

INSULATED FLEX DUCT.-

SHARP RADIUS IS NOT -

SQUARE TO ROUND

REQUIRED, SEE PLANS

SAFETY STRAP FASTEN -


TO REGISTER & TO STRUCTURE ABOVE (SEE DETAIL 12 /A-2.20)

FITTING WHERE

PROVIDE SMOOTH RADIUS -CONNECTION, PROPERLY

SUPPORT FLEX DUCT FOR SMOOTH AIR FLOW TO

SEE PLAN FOR SIZE.

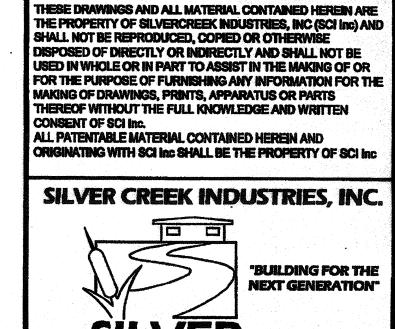

CREEK 195 EAST MORGAN PERRIS, CALIFORNIA 9257 1 PHONE: 951-943-5393 FAX: 951-943-221 1 PROJECT NAME:

CLASS LEASING CLASSROOMS BLDG'S

MECHANICAL NOTES, SCHEDULES, & DETAILS

> STAVARES 9815 Cammul Campus No. Suite 508 San Dusco, Ca. 45187 SEC.444-5844 2224 Canda Pi St. Suite a Novemball, ca ereat Eco.Sec.Stes SEP 19 2012

> > IDENTIFICATION STAMP
> > DIV. OF THE STATE ARCHITECT
> > OFFICE OF REGULATION SERVICES


ORIGINAL PC STATE AGENCY APPROVAL

SILVER CREEK INDUSTRIES

AS NOTED

IDENTIFICATION STAMP DIV. OF THE STATE ARCHITECT OFFICE OF REGULATION SERVICES

PG 04-1/12070

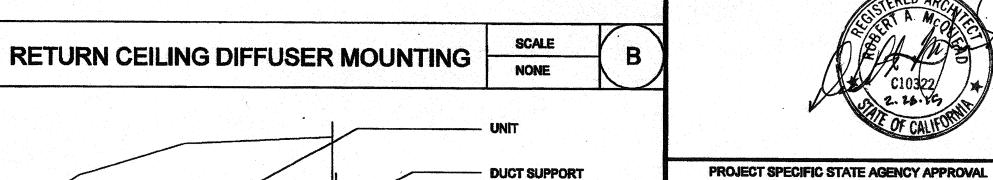

R=1.5D (MIN.)

FITTING-FLEX DUCT

SHOULD BE PULLED

OVER FITTING AND


SECURED WITH APPROVED METHOD NONE

- LOCATE SUPPORT WITHIN 2 FT. OF

- CEILING TILE

SEE SCHEDULE FOR

TYPE AND SIZE.

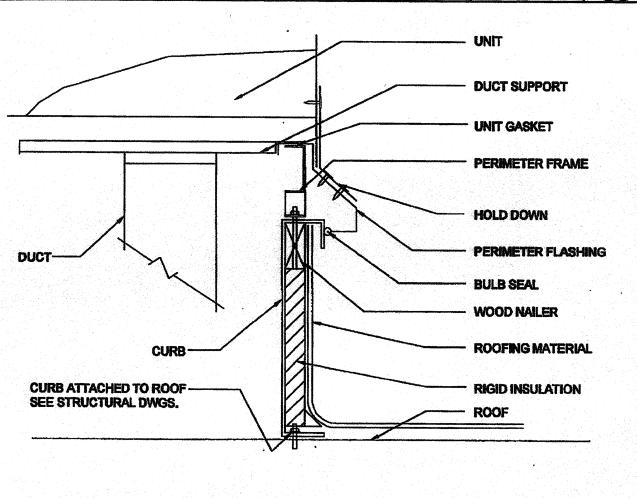

A/C UNIT MOUNTING NONE

FOR APPROPRIATE HVAC TONNAGE PER BUILDING SIZE.

BUILDING SIZES VARY. SEE KEY PLANS ON SHEET A-0.3

IDENTIFICATION STAMP DIV. OF THE STATE ARCHITECT APP03 116979

ACN FLS MSS M

Date 4:/3:/6

PROJECT NO: P.C. SHEET NUMBER

M-0.1

PC REVISION 09/14/2012