

ROBERT F. STUHR ARCHITECT INC.

3121 CALIFORNIA AVE. BAKERSFIELD, CA. 93304 (805) 327-1632

ROBERT F. STUHR AIA C-1610
 WILLIAM J. MELBY AIA C-16835
 DANNY E. ORDZ AIA C-14728

Donald K. Lawrence & Associates
 DONALD K. LAWRENCE & ASSOCIATES
 CONSULTING MECHANICAL ENGINEERS, INCORPORATED
 2000 N. ZEEB RD., SUITE 1000
 BAKERSFIELD, CALIF. 93311
 (805) 327-1632

IDENTIFICATION STAMP
 Department of General Services
 Office of the State Architect
 A1511889
 Structural Safety Section
 Inspected by: J. L. HILL
 Issued by: P. HILL

AS BUILT
 STATE OF CALIFORNIA
 DEPARTMENT OF GENERAL SERVICES
 OFFICE OF THE STATE ARCHITECT

PROJECT NO. 51927-00-10 80
 DATE: 11/12/80

BOILER ROOM / CHILLER YARD & ICE STORAGE YARD PLAN

PIONEER DRIVE SCHOOL MODERNIZATION

BAKERSFIELD CITY SCHOOL DISTRICT

BAKERSFIELD, KERN COUNTY, CALIFORNIA

'As Built'
 Unchanged

CHECK AND VERIFY ALL DIMENSIONS BEFORE PROCEEDING WITH THE WORK. REPORT ANY DISCREPANCIES AND CONSTRUCTION SHALL CONFORM TO UBC.

MARK	DATE	REVISIONS
△		
△		
JOB NO. _____


DESIGNED BY: D.E.M.S.

CHECKED BY: G.W.T.E.

DATE: _____

M

6 OF 11 SHEETS

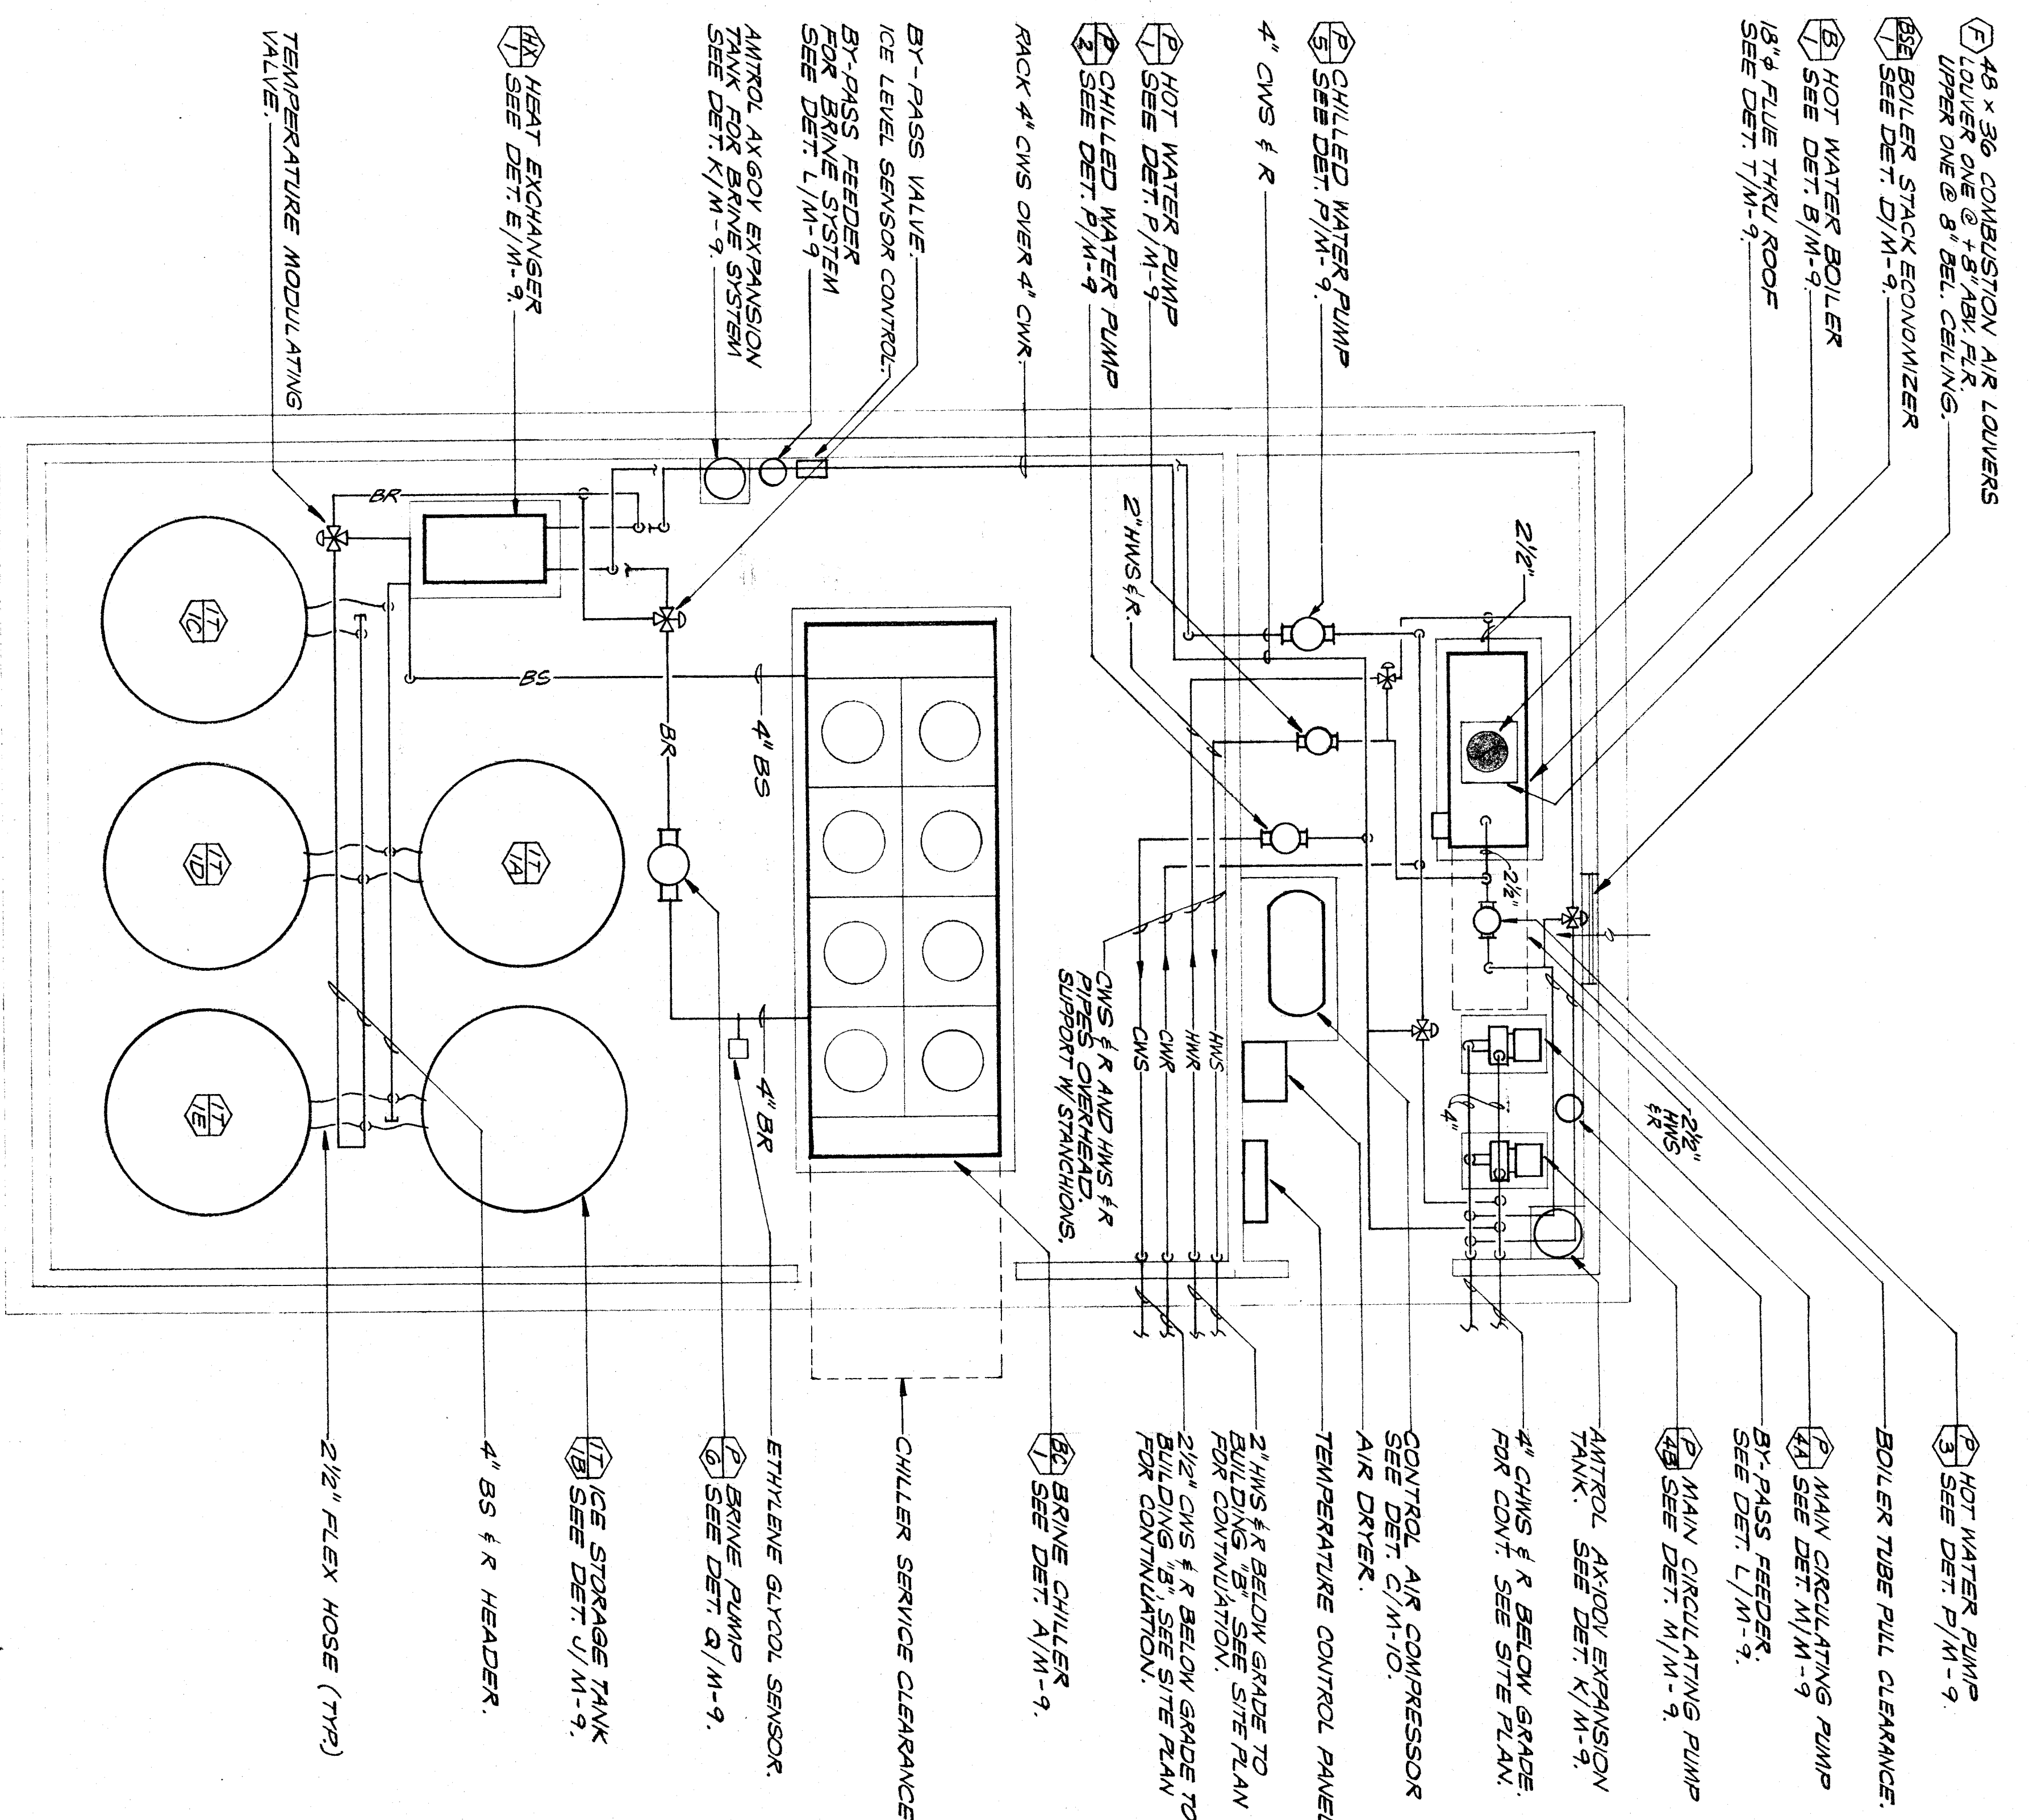

BOILER ROOM / CHILLER YARD & ICE STORAGE YARD PLAN



A-1/6

SCALE: 1/4"=1'-0"