

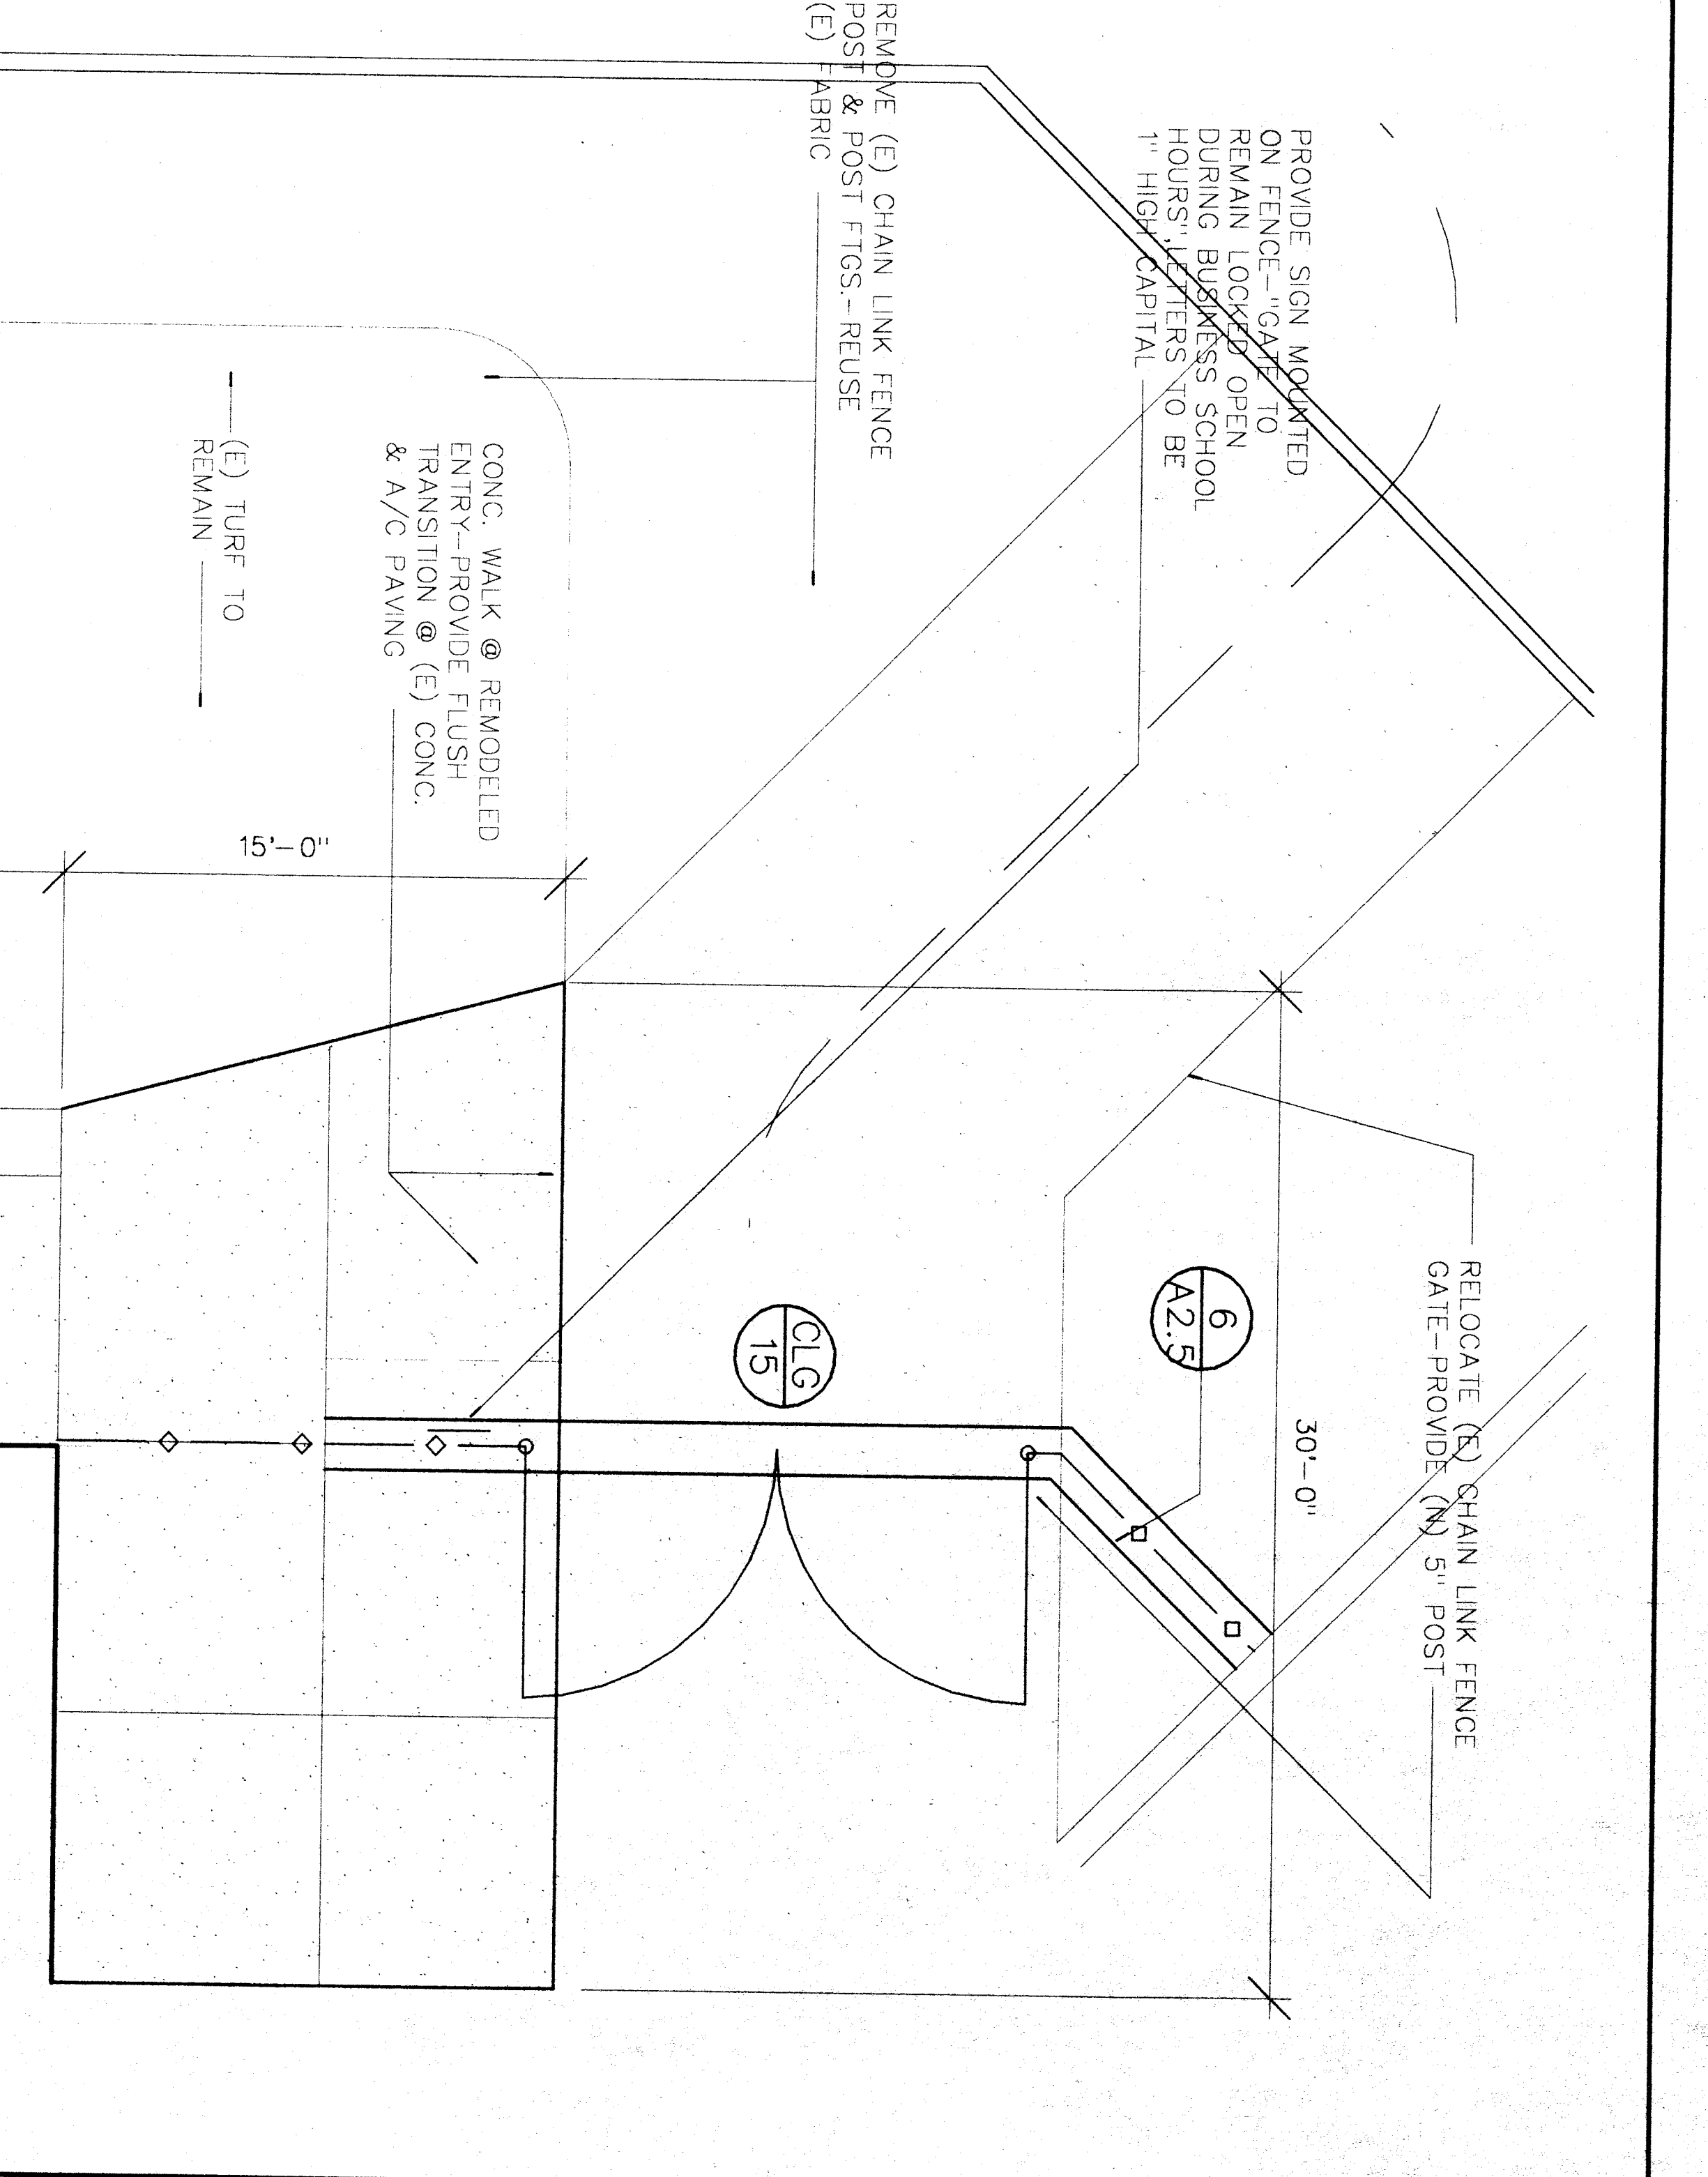


FLOOR PLAN - UNIT 700-TOILETS

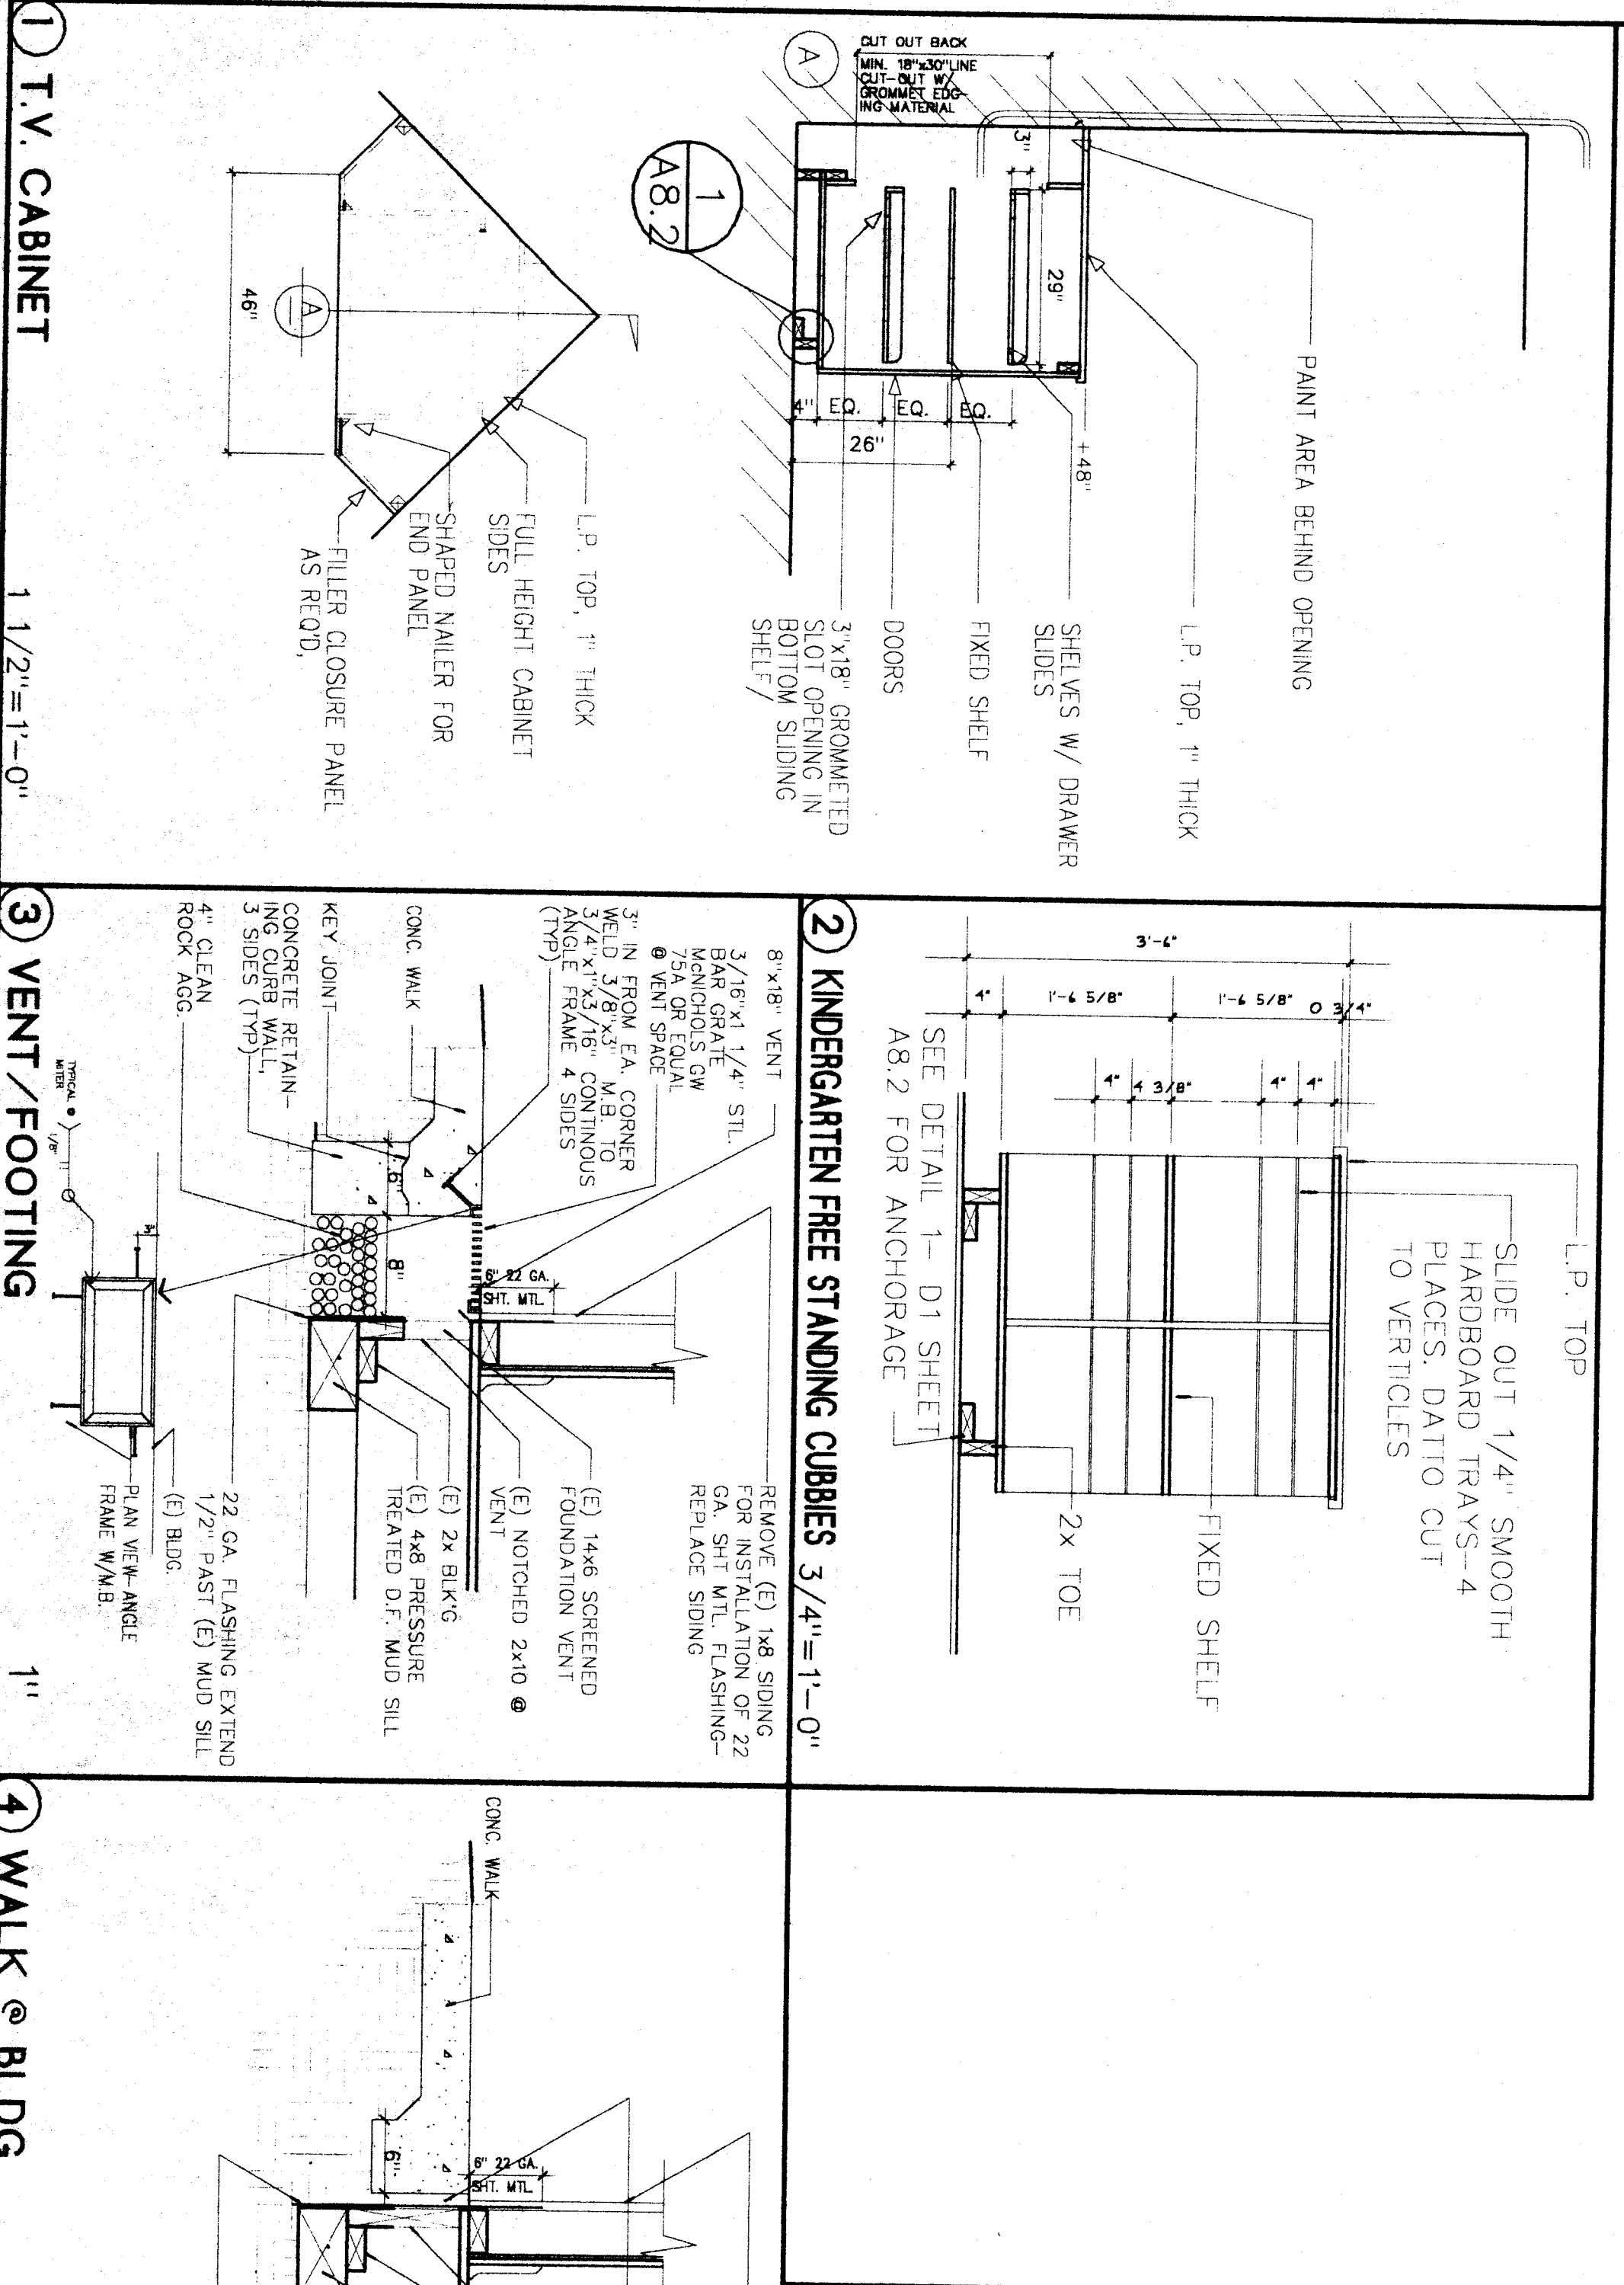

1 ENLARGED PARTIAL SITE PLAN 3

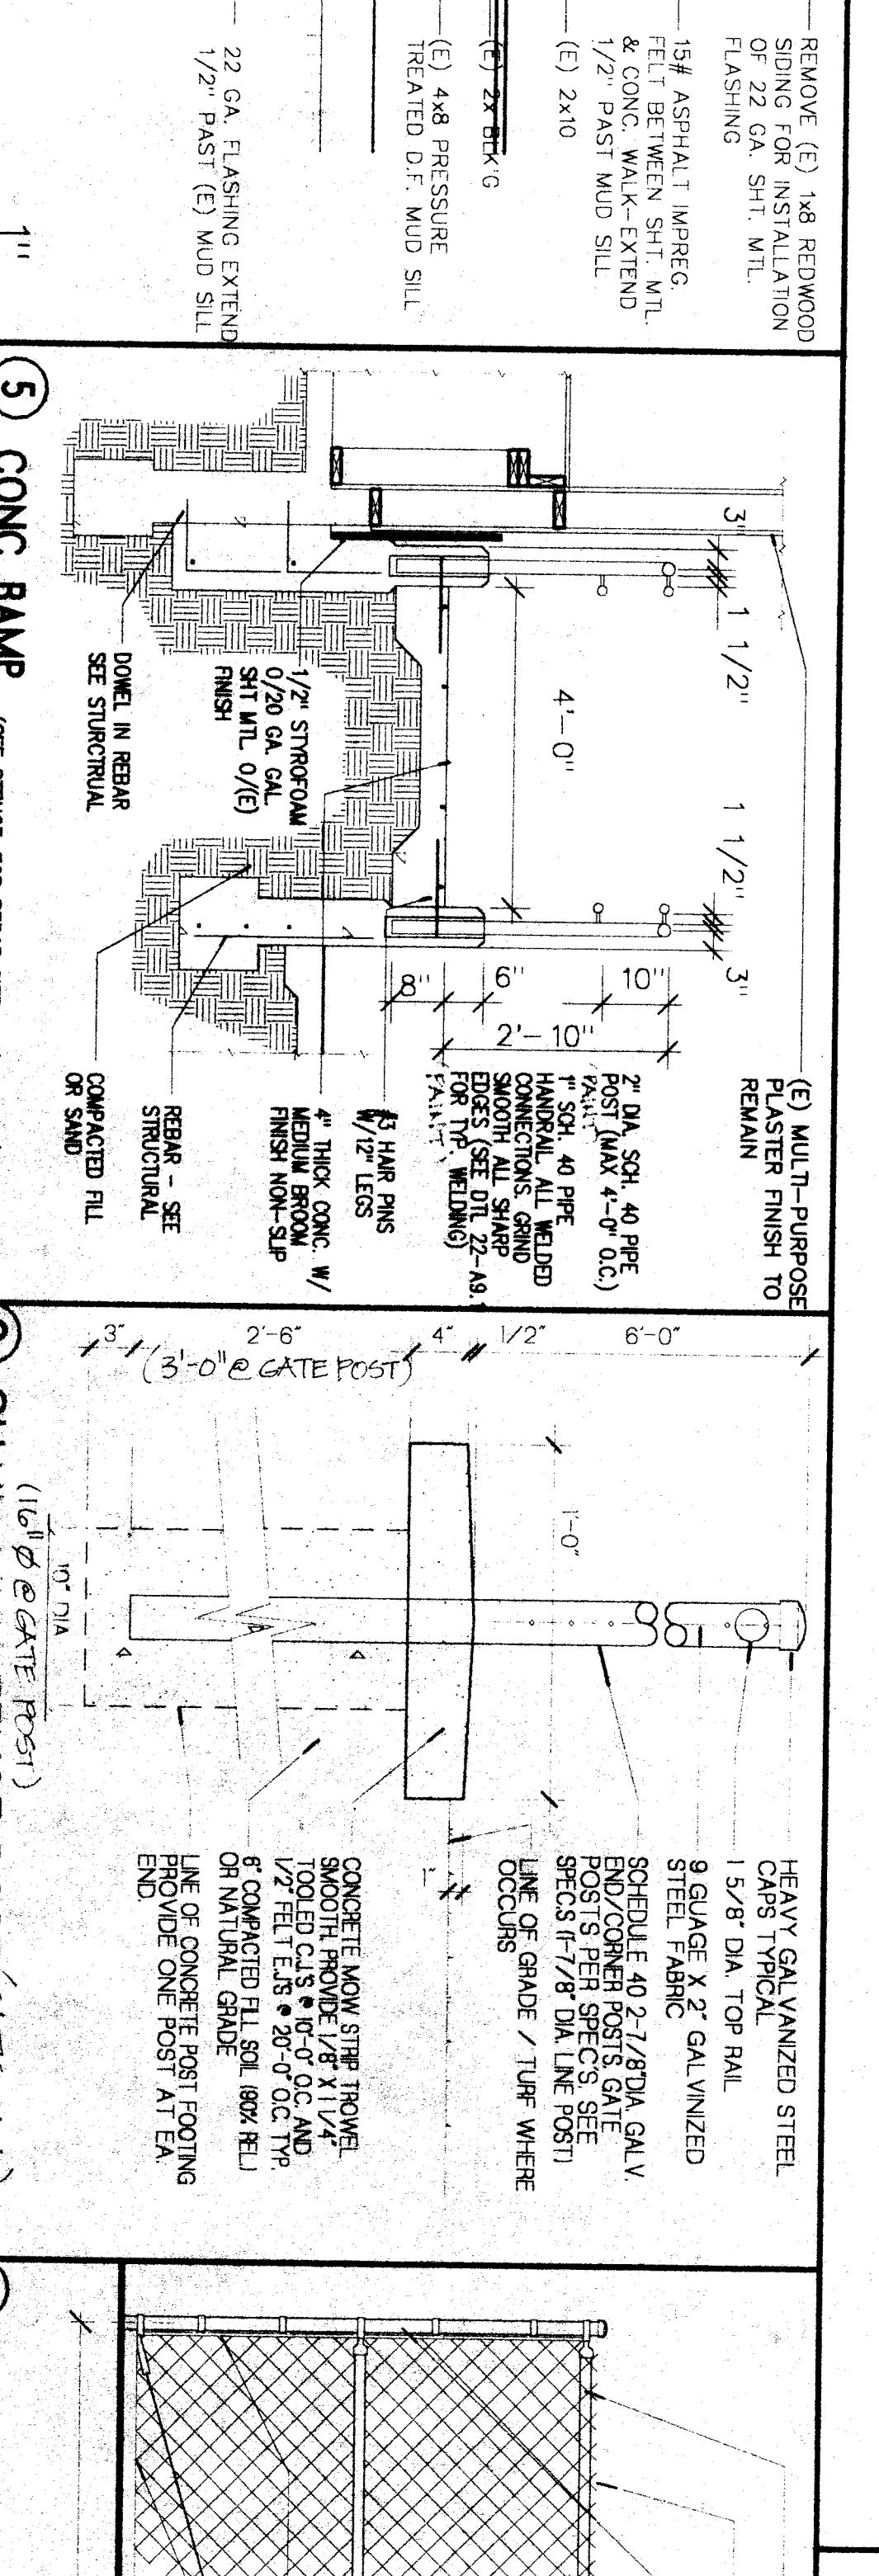

KEY NOTES

- (E)CON EXISTING CONCRETE FLOOR TO REMAIN--ADD WASH & REGRIND
- (E)C.T. EXISTING CERAMIC TILE TO REMAIN--PATCH PREP & PAINT & FRAME TO REMAIN--
- (N)LV1 NEW LAVATORY--SEE PLUMBING PLANS
- (N)LV2 PLUMBING ACCESSIBLE LAVATORY--SEE PLUMBING PLANS
- (N)WC1 WATER CLOSET--CONNECT TO EXISTING WATER CLOSET--CONNECT TO EXISTING MOUNT FLUSH VALVE--ELEV ON OPEN SIDE OF TOILET--SEE PLUMBING
- (N)WC2 PROVIDE/INSTALL H.C. ACCESSIBLE WATER CLOSET--CONNECT TO EXISTING WATER CLOSET--CONNECT TO EXISTING MOUNT FLUSH VALVE--ELEV ON OPEN SIDE OF TOILET--SEE PLUMBING
- (E)JUN EXISTING JUNCTION--REMOVE
- (N)JUN1 NEW JUNCTION--REMOVE
- (N)JUN2 NEW JUNCTION--REMOVE
- (N)PT1 PROVIDE/INSTALL NEW SOLID PLASTIC TOILET PARTITIONS.

LEGEND

- (N) 2x4 STUD WALL FRAMING
- (N) 2x6 STUD WALL FRAMING
- (N) 2x6 STUD WALL FRAMING
- (E) 2x4 STUD WALL FRAMING
- 2x WALLS - TO BE REMOVED
- (E) CABINET TO REMAIN
- (E) CABINET TO BE REMOVED
- (E) CABINET TO BE RELOCATED
- (E) CABINET/COUNTERTOP RELOCATED
- (N) 2x6 STUD WALL FRAMING
- (N) LOCKER--SEE DEMO PLAN
- (E) CABINET W/(N) COUNTERTOP
- (N) CABINET & (N) COUNTERTOPS
- SEE CABINET SCHEDULE
- SEE DEMO & PLUMBING PLANS

ORDIZ MELBY ARCHITECTS INC.
 5620 DISTRICT BLVD. #105
 BAKERSFIELD, CA 93313
 TEL (805)-832-6568
 FAX (805)-832-4291

IDENTIFICATION STAMP
 DIV. OF STATE ARCHITECT
 OFFICE OF REGULATION SERVICES
 APR 10 101484
 AC FLS 101484 SS HC
 DATE 1-13-1777

DANNY E. KRITZ A.I.A.
 ARCHITECT
 WILLIAM J. MELBY A.I.A.
 ARCHITECT
 C-161855

AS BUILT DRAWINGS
 MODERNIZATION OF
 COLLEGE HEIGHTS
 ELEM. SCHOOL
 FOR:

BAKERSFIELD CITY SCHOOL DISTRICT

2551 SUNNY LN.
 BAKERSFIELD, CALIFORNIA 93305

CHECK AND VERIFY ALL DIMENSIONS BEFORE PROCEEDING WITH THE WORK. DISCREPANCIES TO THE ARCHITECT.

MARK DATE REVISION

FLOOR PLAN UNIT 700 TOILETS PARTIAL SITE PLAN DETAILS

JOB NUMBER 07140
 DATE 1/6/99
 DRAWN BY M.K.B.

2.5 SHEET OF 20