


LEGEND

- SURFACE MOUNTED LIGHT FIXTURE SEE ELECTRICAL
- LIGHT FIXTURE TO BE REMOVED SEE ELECTRICAL
- 2 X 2 ACOUSTIC CEILING TILE
- 1/2" ACOUSTIC CEILING TILE
- CEMENT PLASTER
- 1/2" PLYWOOD SOFFIT-PAINT
- SUPPLY AIR GRILL-SEE MECHANICAL
- RETURN AIR GRILL-SEE MECHANICAL
- EXHAUST FAN-SEE MECHANICAL
- ROOM NUMBER
- ROOM NAME
- FINISHED CEILING HEIGHT

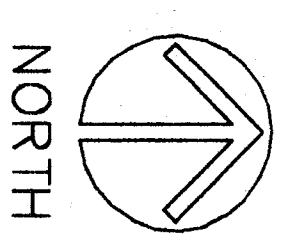

UNIT 700-TOILETS

REFLECTED CEILING PLAN - UNIT 700-TOILETS

<p>② FIRE EXT. CAB.</p> <p>25" CABINET VERIFY LAMINATE 5/8" TYPE 'X' GYP. BOARD TO FACE SURFACE W/ACRYLIC BUBBLE DOOR SOLID BLOCKING ALL AROUND</p>	<p>① GYP. BOARD CEILING</p> <p>2x6 @ 16" O.C. 2x6 CONTINUOUS LEGER W/2 16d EA STUD 1/2" GYP. BOARD W/1/8" VENEER W/LU HANGER WALL FINISH-SEE SCHEDULE</p>
<p>④ VCTW @ SHEAR WALL</p> <p>1/4" WOOD TRIM-DADO CUT TO FIT VCTW-PAINT ACCENT COLOR 1/2" VINYL COVERED TACKABLE WALLBOARD SEE DETAIL 3 FOR SIMILAR NOTES</p>	<p>③ SHEAR WALL</p> <p>(N) 1/2" SHEAR PANEL-SEE STRUCT. (N) 5/8" TYPE 'X' GYP. BOARD WITH DRYWALL J-MOLD & VENEER PLASTER-PAINT (E) 6x (E) 2x6 @ 16" O.C. (E) PLASTER FINISH TO REMAIN CAULK</p>
<p>⑤ WOOD TRIM @ STAGE</p> <p>1/4" WOOD TRIM-DADO CUT TO FIT VCTW-PAINT ACCENT COLOR 1/2" VINYL COVERED TACKABLE WALLBOARD (E) 6x FRAMING</p>	<p>⑤ VCTW</p> <p>(N) 1/2" SHEAR PANEL-SEE STRUCT. (E) PLASTER FINISH TO REMAIN 1/4" WOOD TRIM-DADO CUT TO FIT VCTW-PAINT ACCENT COLOR 1/2" VINYL COVERED TACKABLE WALLBOARD (N) 5/8" TYPE 'X' GYP. BOARD WITH DRYWALL J-MOLD</p>
<p>⑧ DOOR JAMB</p> <p>(E) HOLLOW METAL DOOR (E) 2 X 4 FRAMING (E) 1x8 REDWOOD SIDING CAULK TYPICAL BULLNOSE (N) CER. TILE OVER MOD. SET BASE INTO (E) HOLLOW METAL FRAME</p>	<p>⑦ SILL/HEAD @ 3"</p> <p>(E) HEADER PATCH PLASTER AS REQD. WITH 1/2" METAL-PLAST STUD LATH W/ J-METAL-PLAST 0.32 ALUM. BREAK METAL 2 DRIP FLASHING 1/2" W. 0/1" PLASTER-PATCH BRD-MATCH (E) WALL FINISH THICKNESS FRONT LONGER ALUM. WINDOW SILL T-SEALED GLAZING SYSTEM CAULK 0.5 ALUM. BREAK METAL SILL ATTACHED TO-DOORS/VELU (E) 2X FRAMING 1/2" VINYL COVERED WOOD SUBSTRATE (E) 2X FRAMING</p>
<p>⑩ WINDOW SILL (JAMB/HEAD SIM.)</p> <p>FIBERBOARD W/1/8" VENEER PLASTER-PAINT CAULK T-TRIM-PAINT 1" FINISHED WALL (E) 2X FRAMED WALL</p>	<p>⑨ CERAMIC TILE WAINSCOT</p> <p>FIBERBOARD W/1/8" VENEER PLASTER-PAINT 3/4" STOP WAINSCOT MISST CERAMIC TILE (E) 2X STUD WALL REMOVE CERAMIC TILE INSTALLATION CHIP OUT FOR COVE BASE PLATE CONCRETE AS REQUIRED (E) LIGHTWEIGHT CONCRETE WOOD SUBSTRATE</p>
<p>⑫ HANDRAIL @ RAMP/STEPS</p> <p>CONCRETE WALK STEEL STRUCTURE SEE DETAIL 22-AB 1 FOR WELDS SLOPE TO MATCH RAMP T. DIA. SCHEDULE 40 GALVANIZED HANDBARLS 2" DIA. SCHEDULE 40 GALVANIZED HANDRAILS (E) 2 X 4 FRAMING AND TOP RAIL</p>	<p>⑪ GYP. BOARD CEILING</p> <p>(E) 2x4 HANGER @ 16" O.C. 2x4 CONTINUOUS LEGER W/2 16d @ 16" O.C.-REMOVE (E) FINISH FOR WOOD TO WOOD CONNECTION 2x4 C.U.J. @ 16" O.C. W/LU HANGER 1/2" GYP. BOARD W/1/8" VENEER PLASTER</p>

KEY NOTES
THIS SHEET ONLY

(E)PLWD (E) 3/8" PLYWOOD SOFFIT OVERHANG TO PREP SURFACE-PAINT DAMAGED PANELS.
(N)UTE PROVIDE/INSTALL NEW LIGHT FIXTURES-SEE ELECTRICAL PLANS.
(E)OCLA EXISTING PLYWOOD CEILING TO REMAIN REPLACE ANY DAMAGED PANELS. PREP SURFACE-PAINT.

ORDIZ MELBY ARCHITECTS INC.
5620 DISTRICT BLVD. #106
BAKERSFIELD, CA 93313
TEL (805)-832-6268
FAX (805)-832-4291


IDENTIFICATION STAMP
DIV. OF STATE ARCHITECT
OFFICE OF REGULATIONS SERVICES
APR 10 10 14 84
A.C. F.C. PL. S.S. H.C.
DATE 1-15-1999

DANNY E. ORDIZ - A1/A ARCHITECT
WILLIAM J. NELBY - A1/A ARCHITECT

AS BUILT DRAWINGS
MODERNIZATION OF COLLEGE HEIGHTS ELEM. SCHOOL FOR:

BAKERSFIELD CITY SCHOOL DISTRICT

2551 SUNNY LN.
BAKERSFIELD, CALIFORNIA 93305

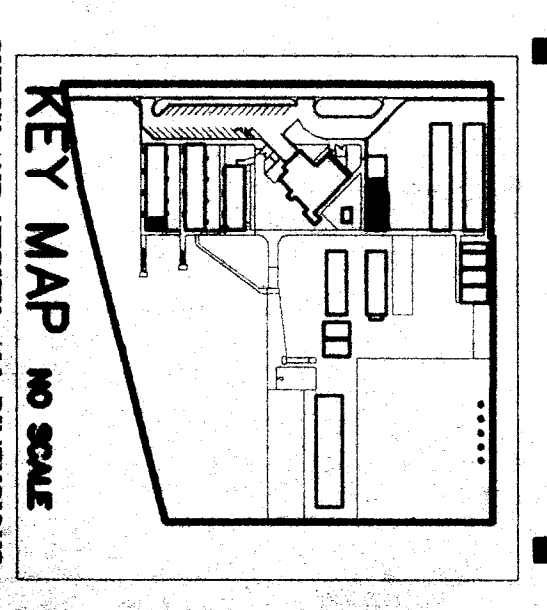

CHECK AND VERIFY ALL DIMENSIONS FOR WORK. REPORT DISCREPANCIES TO THE ARCHITECT

MARK	DATE	REVISION

REFLECTED CEILING PLAN-UNIT 700 TOILETS DETAILS
DATE 1/8/99
DRAWN BY MCK
CHECKED BY MCK
3.3 SHEET OF 20