



**KEY NOTES**  
THIS SHEET ONLY

- (N)W1 NEW 2" WALL SEE FLOOR PLAN & FINISH SCHEDULE
- (N)R22 RUBBER TOP SET BASE SHEET WHNL
- (N)R23 FLOORING
- (N)R24 NEW LAMINATE PLASTIC CABINET-SEE CABINET SCHEDULE TAKEABLE
- (N)W11 CAMERON SCHEDULE TAKEABLE
- (N)W12 MOLD TRIM OVER EXISTING WALL FINISH, WALLBOARD WITH COLOR MATCHING J-MOLD TRIM OVER NEW 1/2" GYP BOARD
- (E)P1ST1 EXISTING PLASTER TO REMAIN-REPAIR & PATCH
- (E)P1ST2 PATCH PLASTER @ DEMO FLOOR-EXTEND TO LOWER LEVEL-PAATCH AS REQUIRED
- (E)P1ST3 1/2" GYP BOARD WITH 1/8" VENEER PLASTER-PATCH PLASTER OVER METAL LATH-REPAIR/REPLACE DAMAGED OR BROKEN PLASTER
- (E)C1 PATCH/REPLACE BROKEN OR DAMAGED TILE AS REQUIRED
- (E)W1 REPAIR/REPLACE BROKEN OR DAMAGED WINDOW
- (E)W2 EXISTING WINDOWS TO REMAIN-REPAIR & PATCH
- (N)W11 EXISTING WINDOWS TO REMAIN-REPAIR & PATCH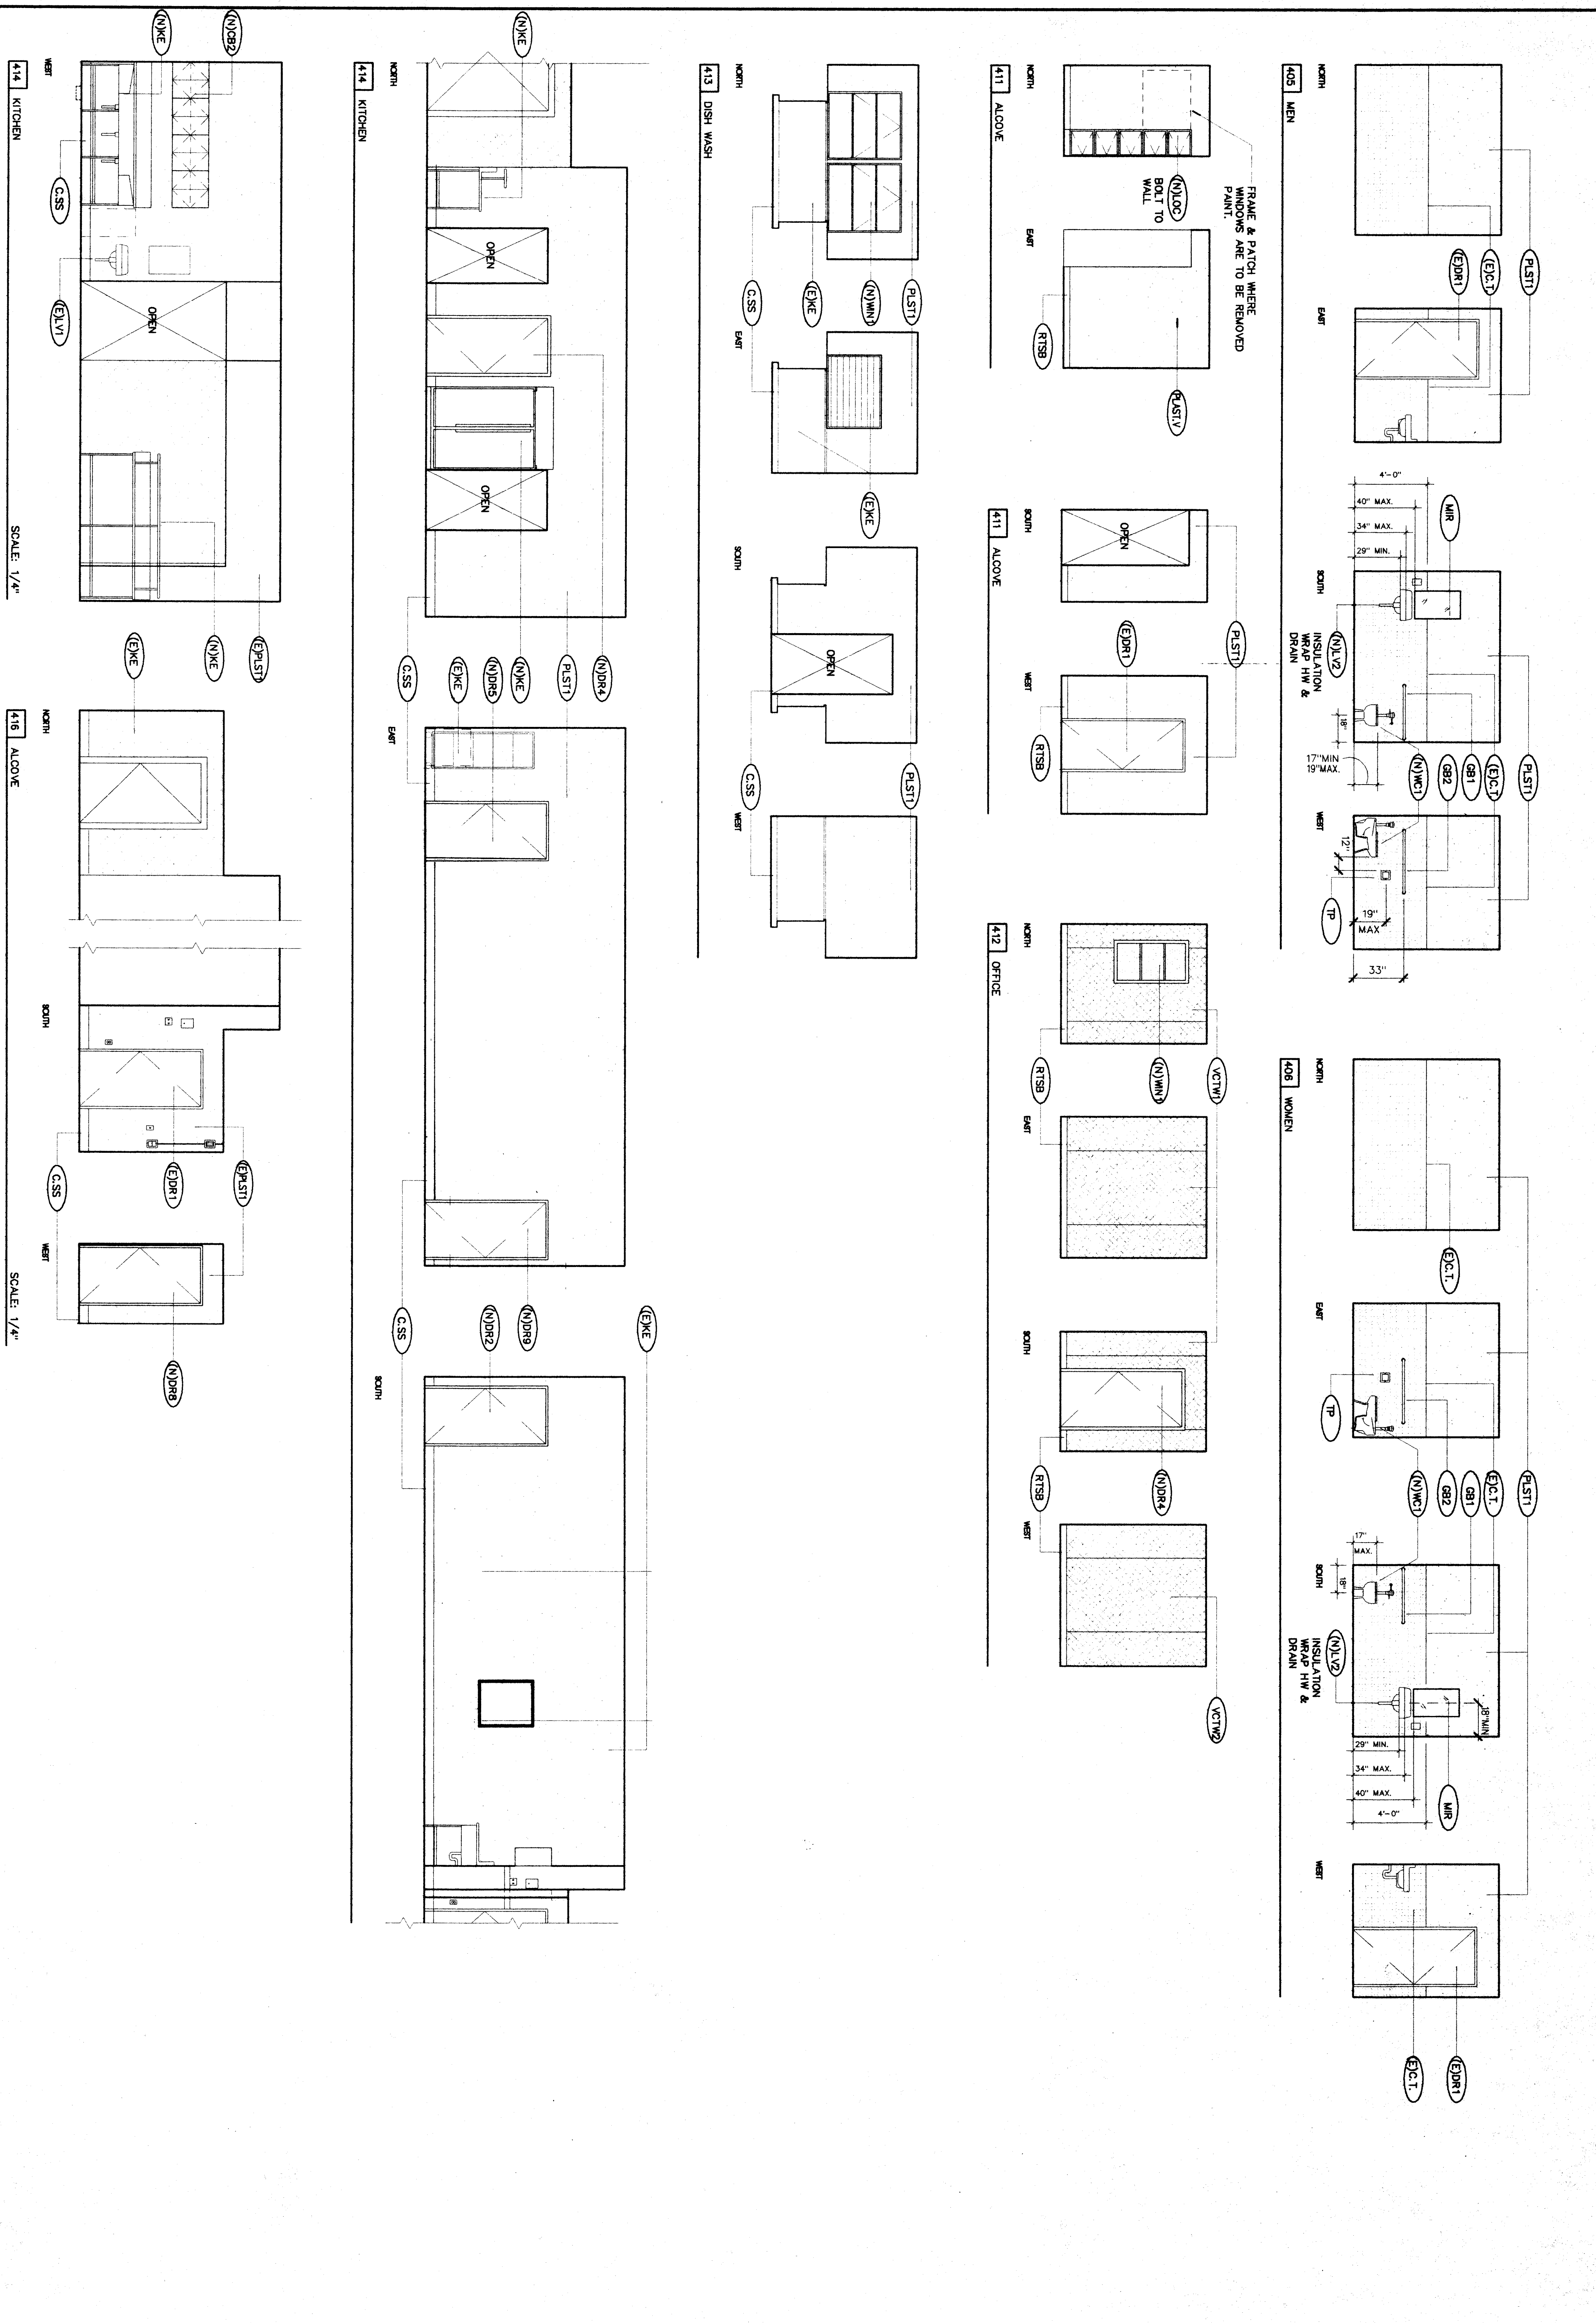
**INTERIOR ELEVATIONS - UNIT 400**

1/4"

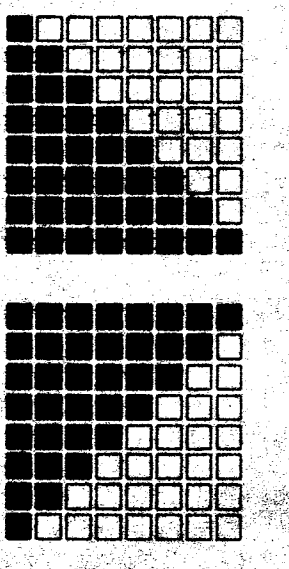

**ORDIZ MELBY ARCHITECTS INC.**  
5820 DISTRICT BLVD. #105  
BAKERSFIELD, CA 93313  
TEL (805) 832-5258  
FAX (805) 832-4281

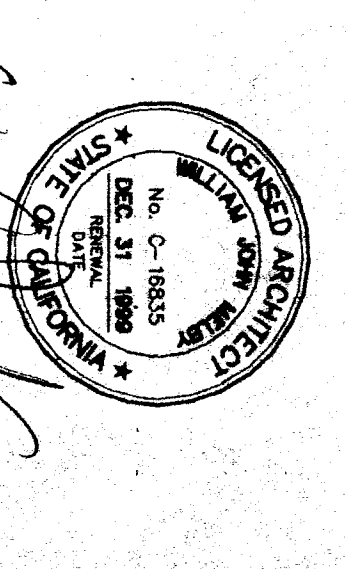

**WILLIAM J. MELBY AIA ARCHITECT**  
C-161835

IDENTIFICATION STAMP  
OFFICE OF REGULATORY SERVICES  
APPL. 101484  
AC 7/1 FL 5/18 SS MC  
DATE 1-15-1999

AS BUILT DRAWINGS  
MODERNIZATION OF COLLEGE HEIGHTS ELEM. SCHOOL FOR

**BAKERSFIELD CITY SCHOOL DISTRICT**

2551 SUNNY LN.  
BAKERSFIELD, CALIFORNIA  
93305

MARK DATE REVISION


INTERIOR ELEV.  
UNIT. 400

JOB NUMBER 97140  
DATE 1/6/99  
SHEET 5.3  
OF 20

CHECK AND VERIFY ALL DIMENSIONS  
BEFORE PROCEEDING WITH THE  
WORK. REPORT DISCREPANCIES TO  
THE ARCHITECT