

**LIGHTING COMPLIANCE SUMMARY**  
PROJECT NAME: BLDG 4100  
BUILDING #100 (KINDERGARTEN)  
DATE: 01-06-99

ACTUAL LIGHTING POWER	ALLOWED LIGHTING POWER (GROSS ONE METHOD)
2310	2310
PLUG SUB-TOTAL FROM CONTINUATION PAGE	2310
LESS CORRECTION (SEE TABLE 10-2.1)	
ADJUSTED ACTUAL WATTS	2310

IF NOT USING THE GROSS ONE METHOD, PLEASE PROVIDE SUPPORTING DOCUMENTATION.

CLASSIFICATION	DESCRIPTION	AREA (SQ FT)	WATTS PER SQUARE FOOT	WATTS PER LAMP	NO. OF LAMPS	TOTAL WATTS
4	4 LAMP SURFACE MOUNT	10	110	110	3	330
5	5 LAMP SURFACE MOUNT					
SUB-TOTAL FROM THIS PAGE						
TOTAL						

APPROVED LIGHTING POWER (GROSS ONE METHOD)

CLASSIFICATION	DESCRIPTION	AREA (SQ FT)	WATTS PER SQUARE FOOT	WATTS PER LAMP	NO. OF LAMPS	TOTAL WATTS
4	4 LAMP SURFACE MOUNT	10	110	110	3	330
5	5 LAMP SURFACE MOUNT					
SUB-TOTAL FROM THIS PAGE						
TOTAL						

DATE: 01-06-99

**LIGHTING COMPLIANCE SUMMARY**  
PROJECT NAME: BLDG 4100  
BUILDING #100 (KINDERGARTEN)  
DATE: 01-06-99

ACTUAL LIGHTING POWER	ALLOWED LIGHTING POWER (GROSS ONE METHOD)
2072	2072
PLUG SUB-TOTAL FROM CONTINUATION PAGE	2072
LESS CORRECTION (SEE TABLE 10-2.1)	
ADJUSTED ACTUAL WATTS	2072

IF NOT USING THE GROSS ONE METHOD, PLEASE PROVIDE SUPPORTING DOCUMENTATION.

CLASSIFICATION	DESCRIPTION	AREA (SQ FT)	WATTS PER SQUARE FOOT	WATTS PER LAMP	NO. OF LAMPS	TOTAL WATTS
4	4 LAMP SURFACE MOUNT	6	64	64	3	192
5	5 LAMP SURFACE MOUNT	12	110	110	3	330
6	6 LAMP SURFACE MOUNT	1	32	32	1	32
SUB-TOTAL FROM THIS PAGE						
TOTAL						

APPROVED LIGHTING POWER (GROSS ONE METHOD)

CLASSIFICATION	DESCRIPTION	AREA (SQ FT)	WATTS PER SQUARE FOOT	WATTS PER LAMP	NO. OF LAMPS	TOTAL WATTS
4	4 LAMP SURFACE MOUNT	6	64	64	3	192
5	5 LAMP SURFACE MOUNT	12	110	110	3	330
6	6 LAMP SURFACE MOUNT	1	32	32	1	32
SUB-TOTAL FROM THIS PAGE						
TOTAL						

DATE: 01-06-99

**LIGHTING COMPLIANCE SUMMARY**  
PROJECT NAME: BLDG 4100  
BUILDING #100 (KINDERGARTEN)  
DATE: 01-06-99

ACTUAL LIGHTING POWER	ALLOWED LIGHTING POWER (GROSS ONE METHOD)
3960	3960
PLUG SUB-TOTAL FROM CONTINUATION PAGE	3960
LESS CORRECTION (SEE TABLE 10-2.1)	
ADJUSTED ACTUAL WATTS	3960

IF NOT USING THE GROSS ONE METHOD, PLEASE PROVIDE SUPPORTING DOCUMENTATION.

CLASSIFICATION	DESCRIPTION	AREA (SQ FT)	WATTS PER SQUARE FOOT	WATTS PER LAMP	NO. OF LAMPS	TOTAL WATTS
4	4 LAMP SURFACE MOUNT	36	110	110	3	330
5	5 LAMP SURFACE MOUNT					
SUB-TOTAL FROM THIS PAGE						
TOTAL						

APPROVED LIGHTING POWER (GROSS ONE METHOD)

CLASSIFICATION	DESCRIPTION	AREA (SQ FT)	WATTS PER SQUARE FOOT	WATTS PER LAMP	NO. OF LAMPS	TOTAL WATTS
4	4 LAMP SURFACE MOUNT	36	110	110	3	330
5	5 LAMP SURFACE MOUNT					
SUB-TOTAL FROM THIS PAGE						
TOTAL						

DATE: 01-06-99

**LIGHTING COMPLIANCE SUMMARY**  
PROJECT NAME: BLDG 4100  
BUILDING #100 (KINDERGARTEN)  
DATE: 01-06-99

ACTUAL LIGHTING POWER	ALLOWED LIGHTING POWER (GROSS ONE METHOD)
2910	2910
PLUG SUB-TOTAL FROM CONTINUATION PAGE	2910
LESS CORRECTION (SEE TABLE 10-2.1)	
ADJUSTED ACTUAL WATTS	2910







IF NOT USING THE GROSS ONE METHOD, PLEASE PROVIDE SUPPORTING DOCUMENTATION.

CLASSIFICATION	DESCRIPTION	AREA (SQ FT)	WATTS PER SQUARE FOOT	WATTS PER LAMP	NO. OF LAMPS	TOTAL WATTS
4	4 LAMP SURFACE MOUNT	21	110	110	3	330
5	5 LAMP SURFACE MOUNT					
SUB-TOTAL FROM THIS PAGE						
TOTAL						

APPROVED LIGHTING POWER (GROSS ONE METHOD)

CLASSIFICATION	DESCRIPTION	AREA (SQ FT)	WATTS PER SQUARE FOOT	WATTS PER LAMP	NO. OF LAMPS	TOTAL WATTS
4	4 LAMP SURFACE MOUNT	21	110	110	3	330
5	5 LAMP SURFACE MOUNT					
SUB-TOTAL FROM THIS PAGE						
TOTAL						

DATE: 01-06-99

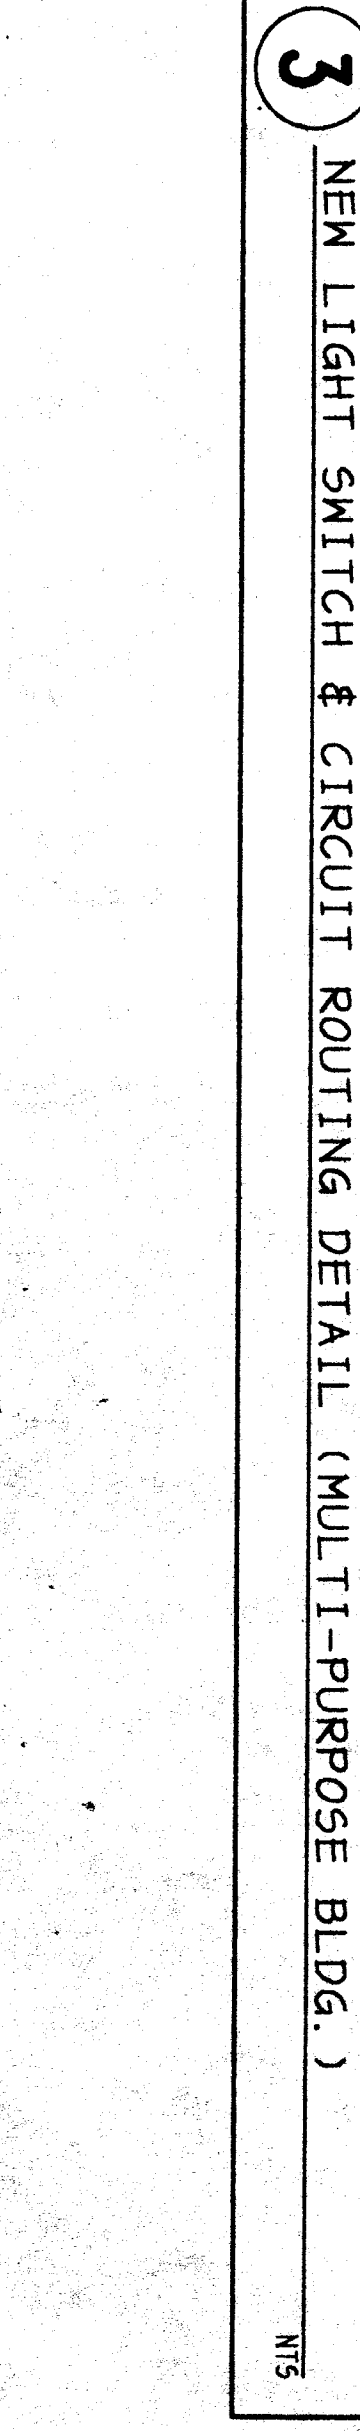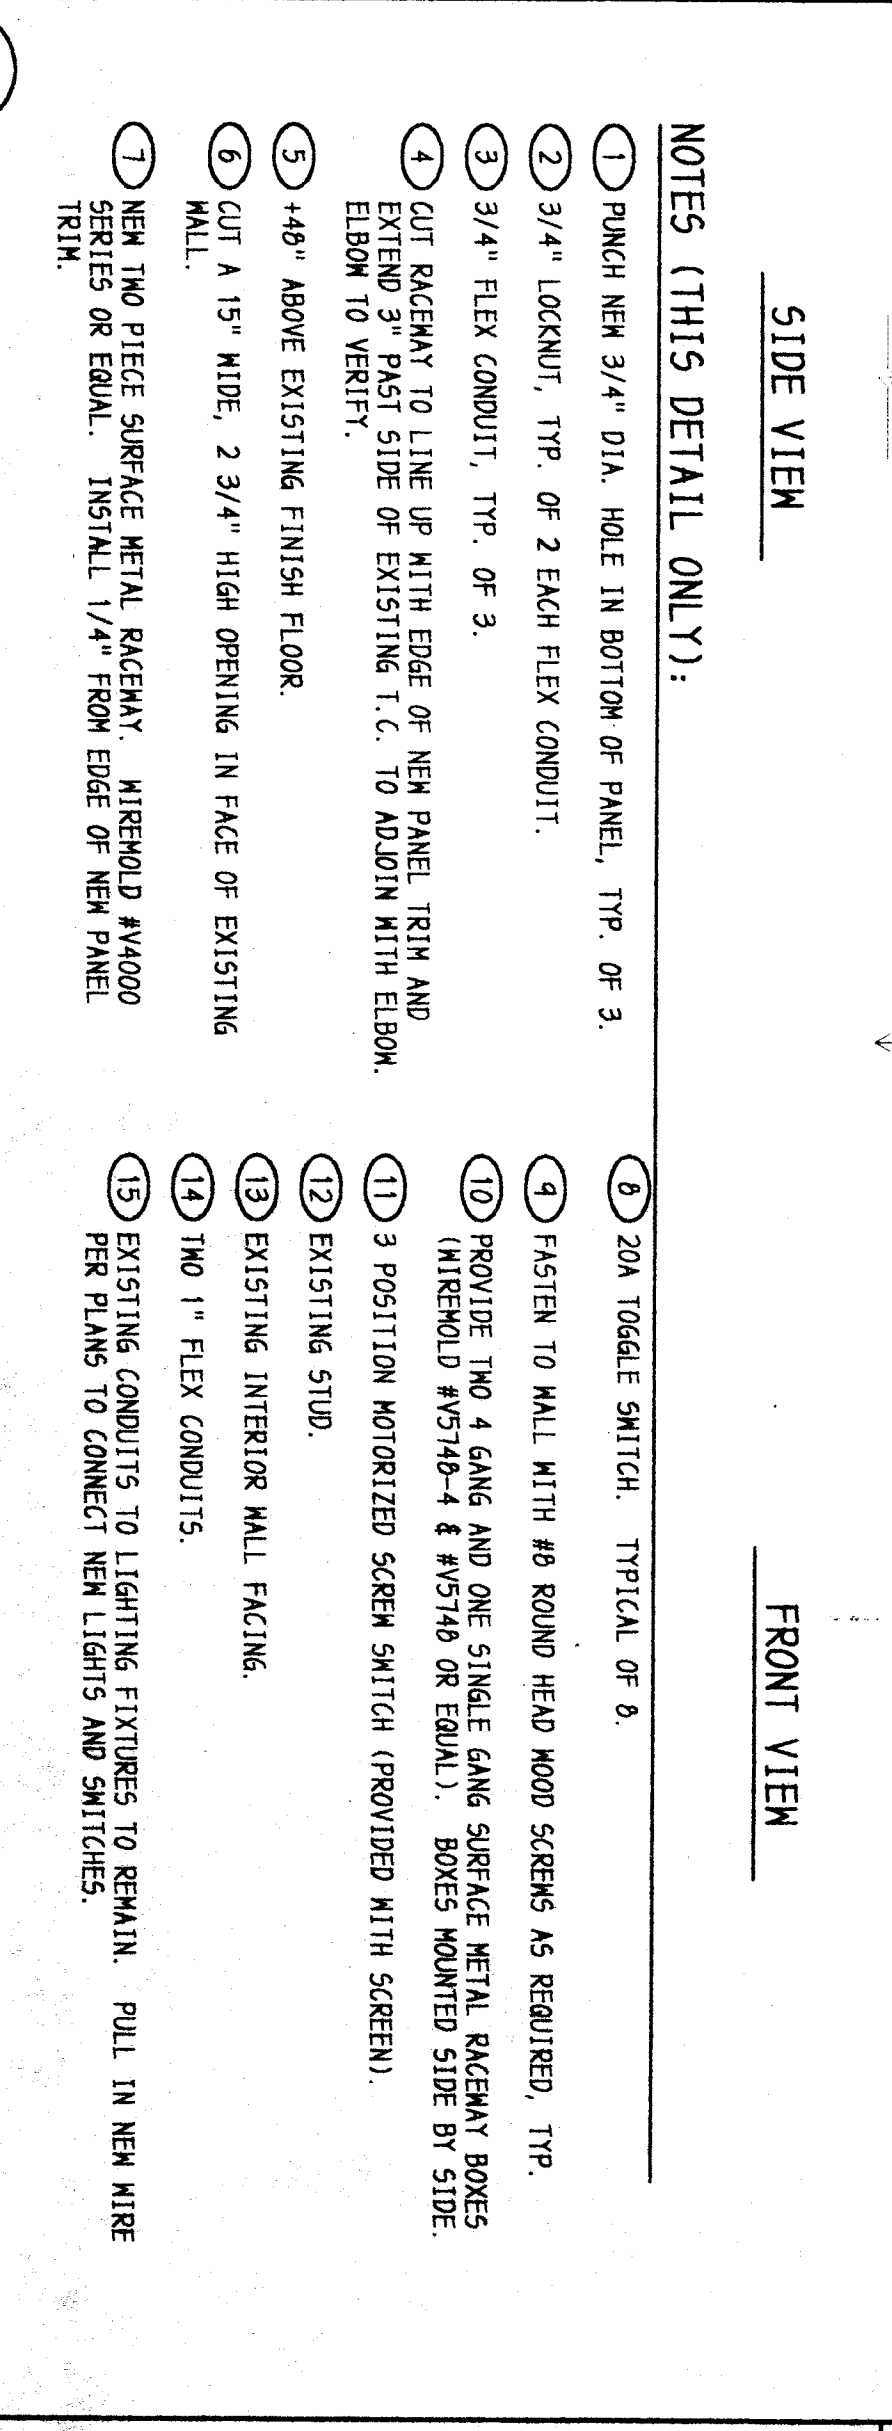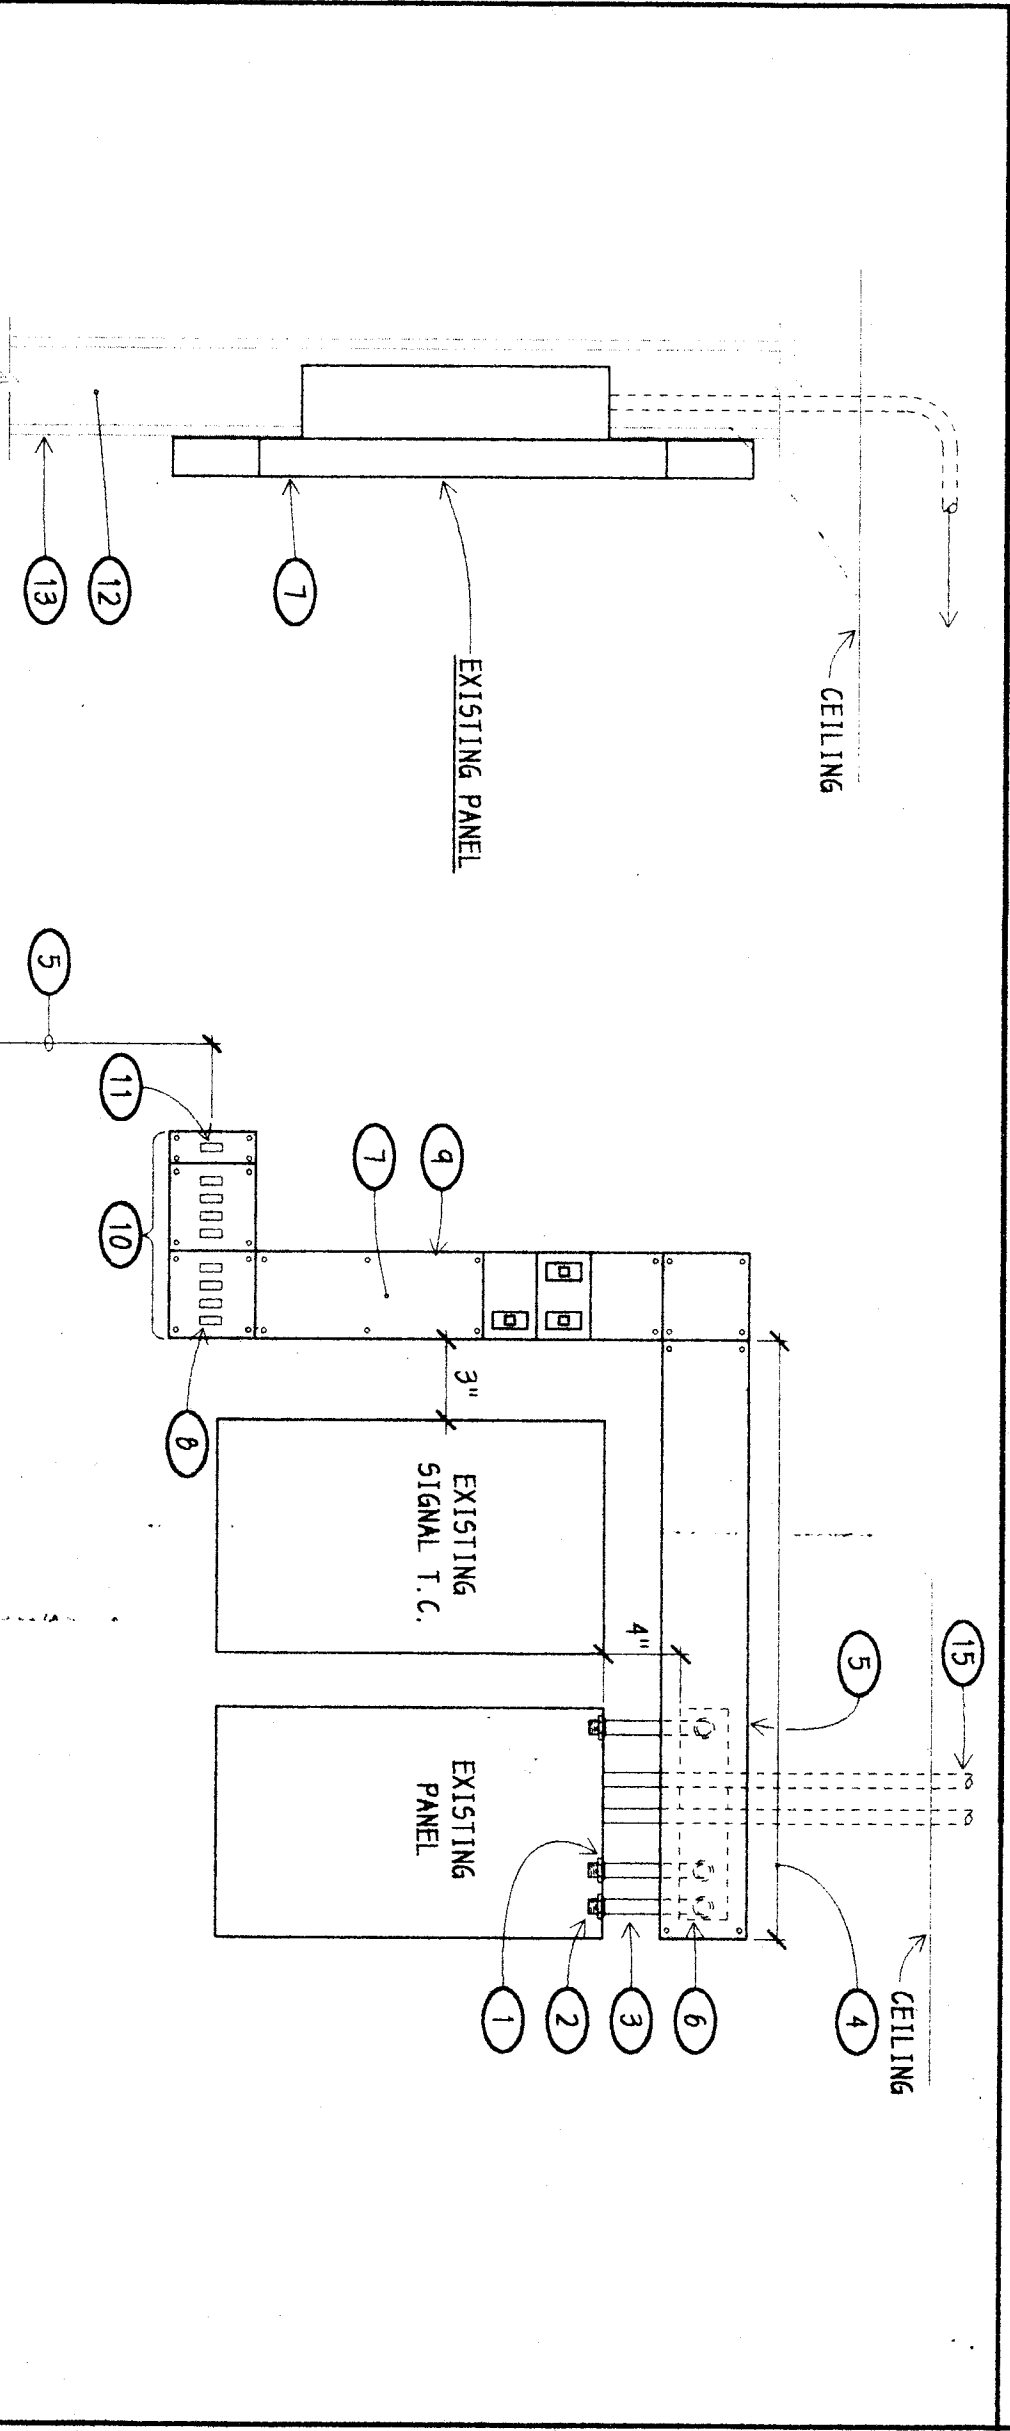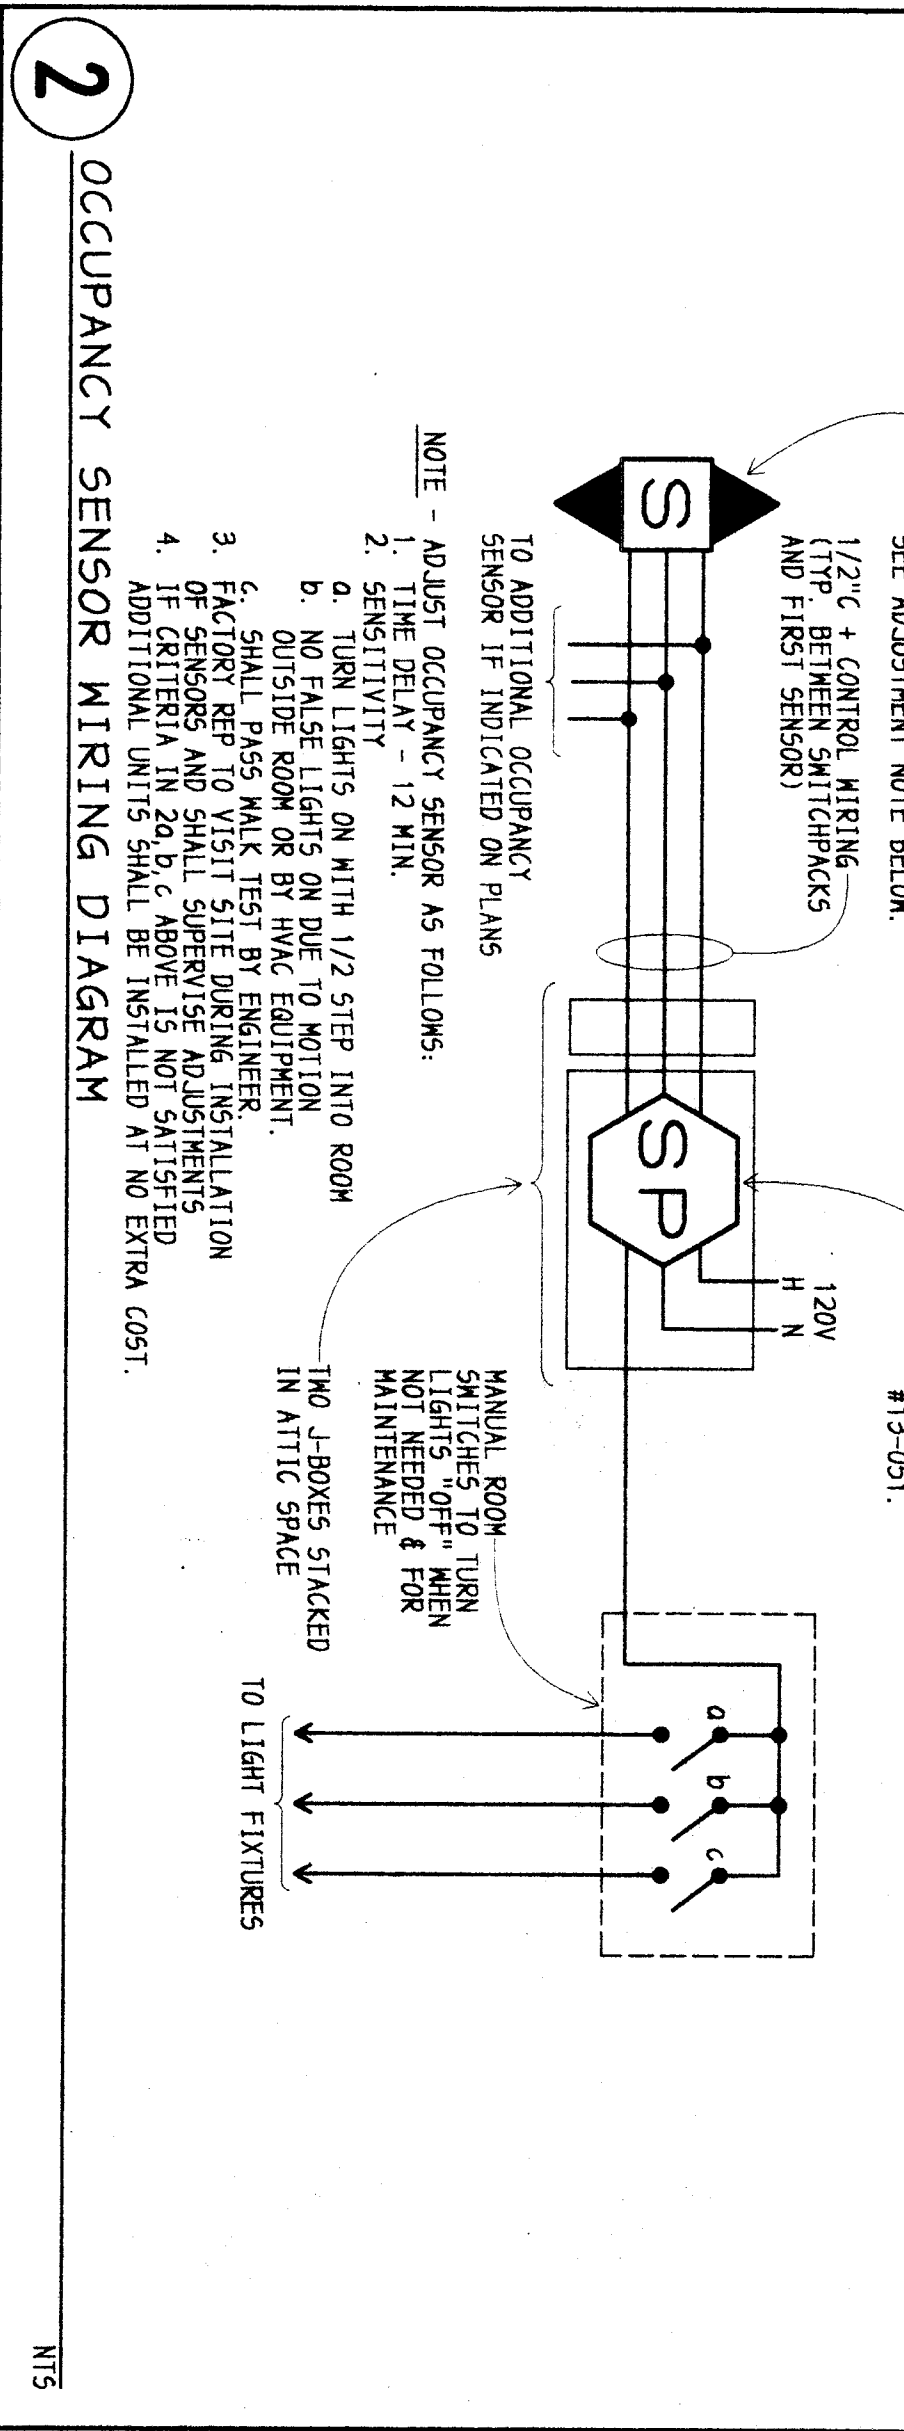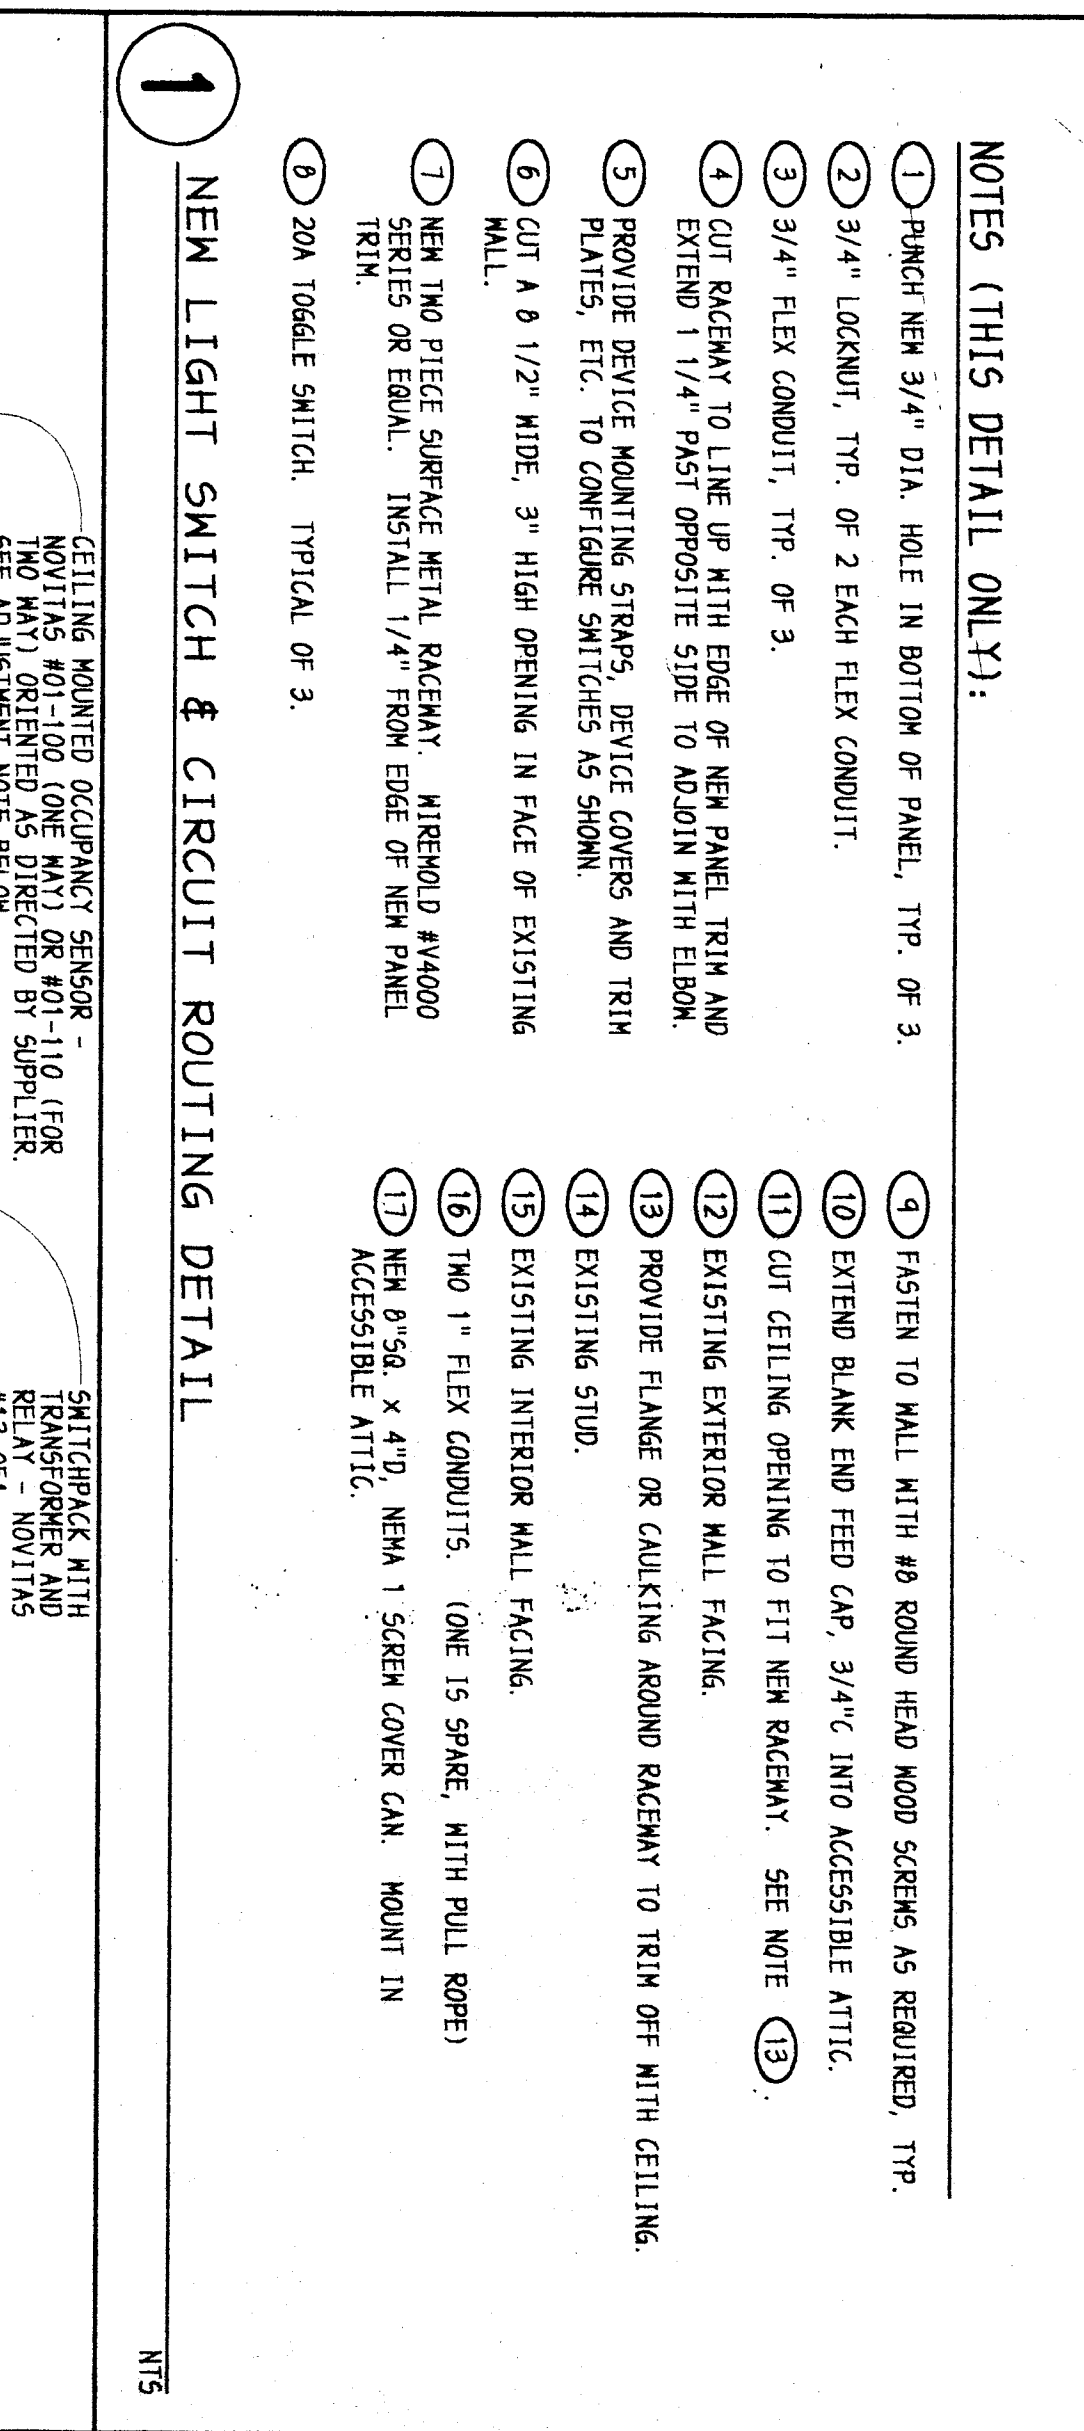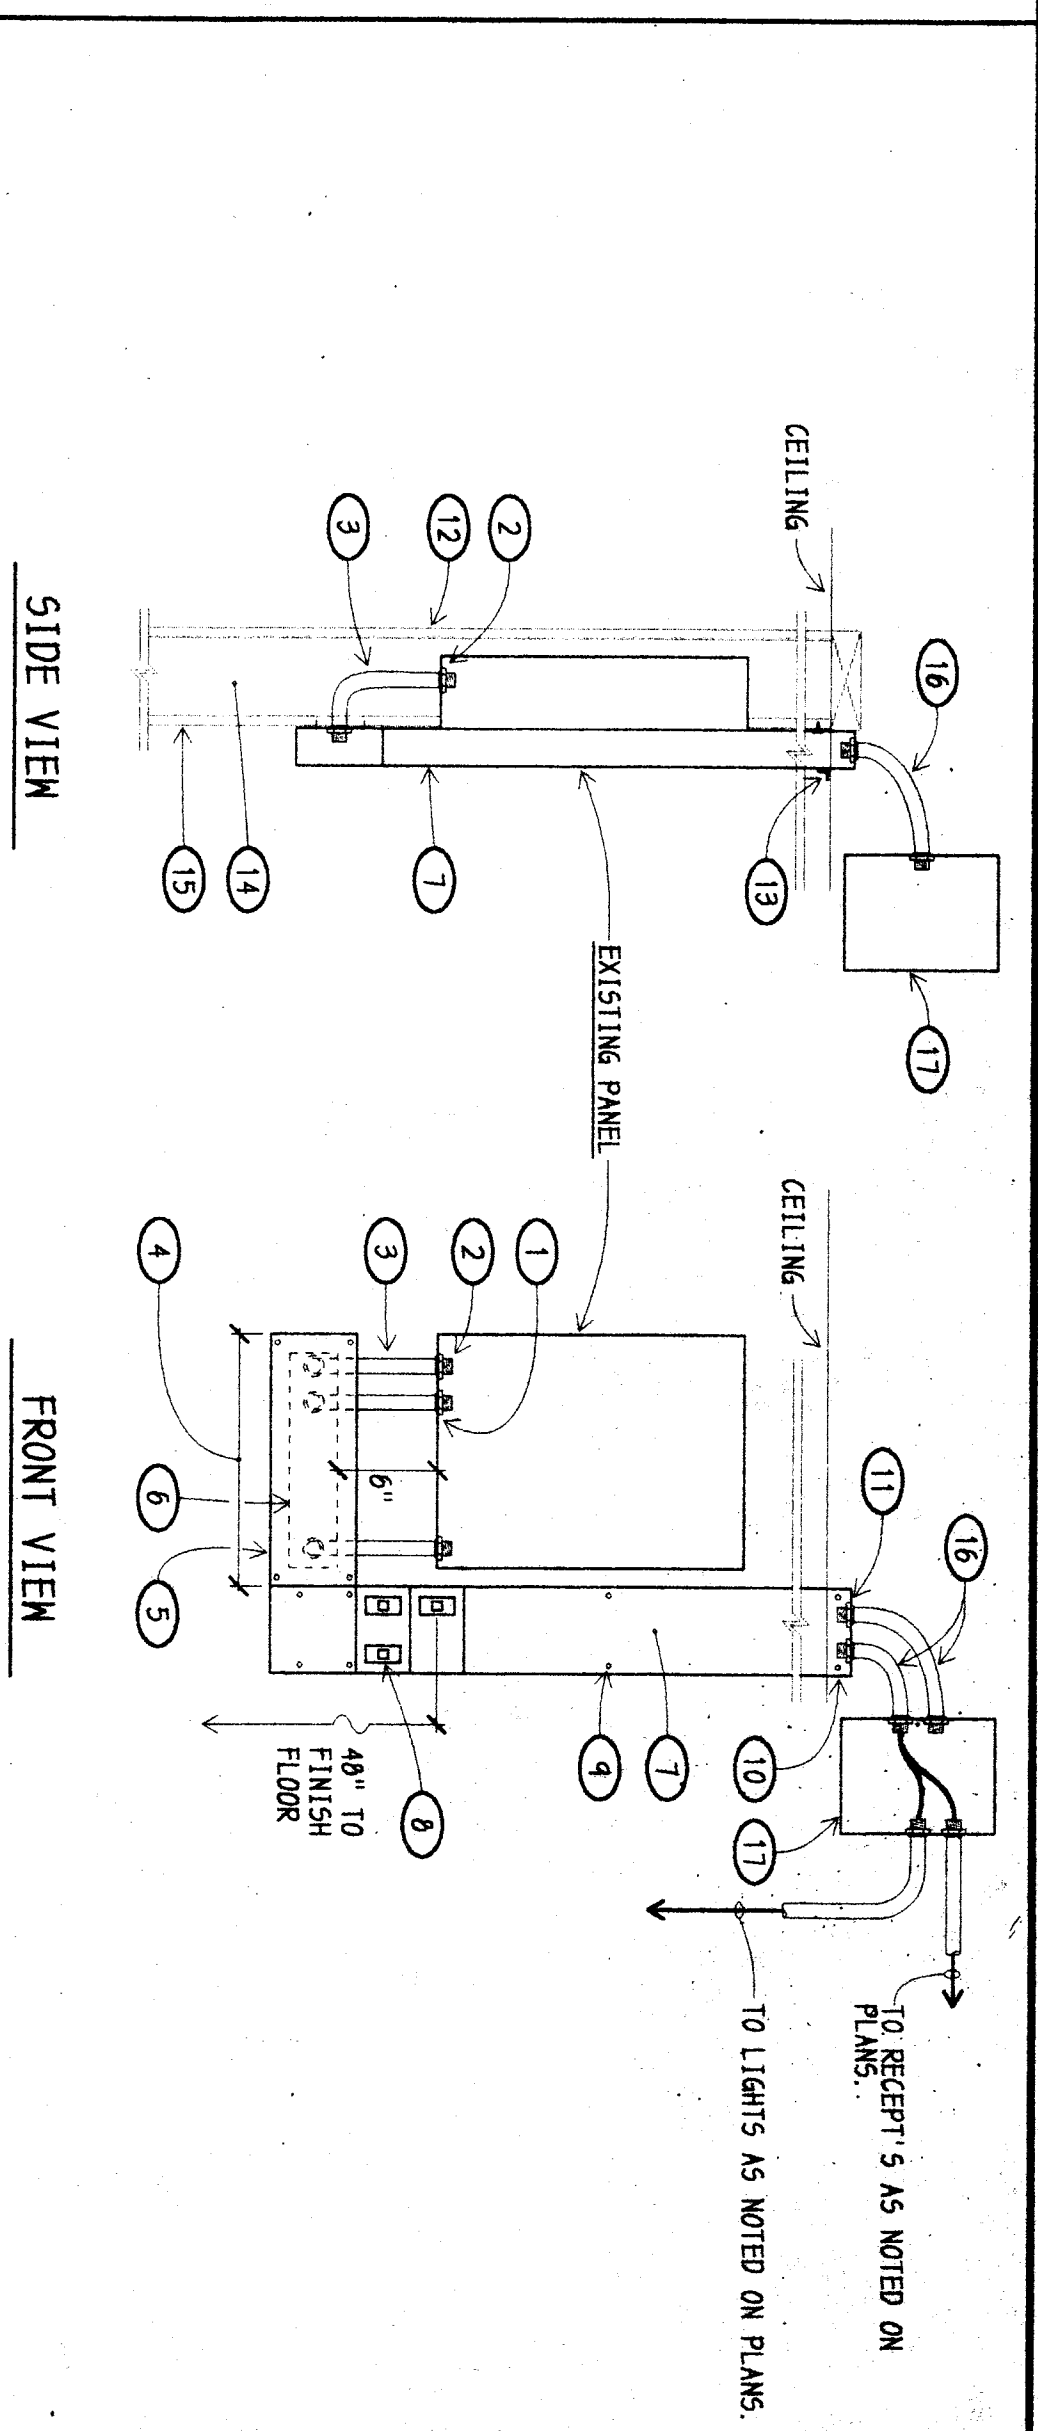

**ORDIZ MELBY ARCHITECTS**  
5620 DISTRICT BLVD. #105  
BAKERSFIELD, CA 93313  
TEL. (805)-832-0280  
FAX. (805)-832-4281

**REGISTERED ARCHITECT**  
DANNY E. ORDOZ  
C-14,1728  
WILLIAM J. MELBY A.I.A.  
C-10,853

**REGISTRATION STAMP**  
OFFICE OF REGISTRATION SERVICES  
FILE NO. 101484  
AC. L.S. L.S. H.C.  
DATE: 1-13-1999

**BAKERSFIELD CITY SCHOOL DISTRICT**  
2651 SUNNY LN.  
BAKERSFIELD, CALIFORNIA 93305

**MODERNIZATION OF COLLEGE HEIGHTS OF ELEM. SCHOOL FOR:**

**AS BUILT DRAWINGS**

CHECK AND VERIFY ALL DIMENSIONS BEFORE PROCEEDING WITH THE ARCHITECT

DATE: 01-06-99  
JOB NUMBER: 97140  
CONSENTING ELECTRICAL ENGINEERS: CONSULTING ELECTRICAL ENGINEERS, INC. (REG. NO. 13281)

**LIGHTING COMPLIANCE AND DETAILS**