


**FIRE ALARM SYSTEM VOLTAGE DROP CALCULATIONS**


VOLTAGE DROP =	CURRENT x WIRE LENGTH x 21.6
	CIR. MIL
VOLTAGE DROP % =	VOLTAGE DROP x 100
	APPLIED VOLTAGE
V. D. =	$0.42 \times 570 \times 21.6 = 5.04 \text{ VOLTS}$
	$6500$
	$1.54 \times 100 = 154.0$
	$24 \times 100 = 2400$
	$516 \text{ CFT } \#511$
V. D. =	$.211 \times 842 \times 21.6 = .39 \text{ VOLTS}$
	$6500$
	$.54 \times 100 = 54.0$
	$516 \text{ CFT } \#54$

**FIRE ALARM LEGEND**



- 1130 VISUAL DEVICE 300d. MOUNT PER DETAIL #2/RS.0 WHEEL LOCK #MS-2430W-FR 659H #1725-07051.41
- 1131 VISUAL DEVICE 150d. MOUNT PER DETAIL #2/RS.0 WHEEL LOCK #MS-2430W-FR 659H #1725-07051.41
- 1132 VISUAL DEVICE 150d. MOUNT PER DETAIL #2/RS.0 WHEEL LOCK #MS-2430W-FR 659H #1725-07051.41
- 1133 VISUAL DEVICE 150d. MOUNT PER DETAIL #2/RS.0 WHEEL LOCK #MS-2430W-FR 659H #1725-07051.41
- 1134 VISUAL DEVICE 150d. MOUNT PER DETAIL #2/RS.0 WHEEL LOCK #MS-2430W-FR 659H #1725-07051.41

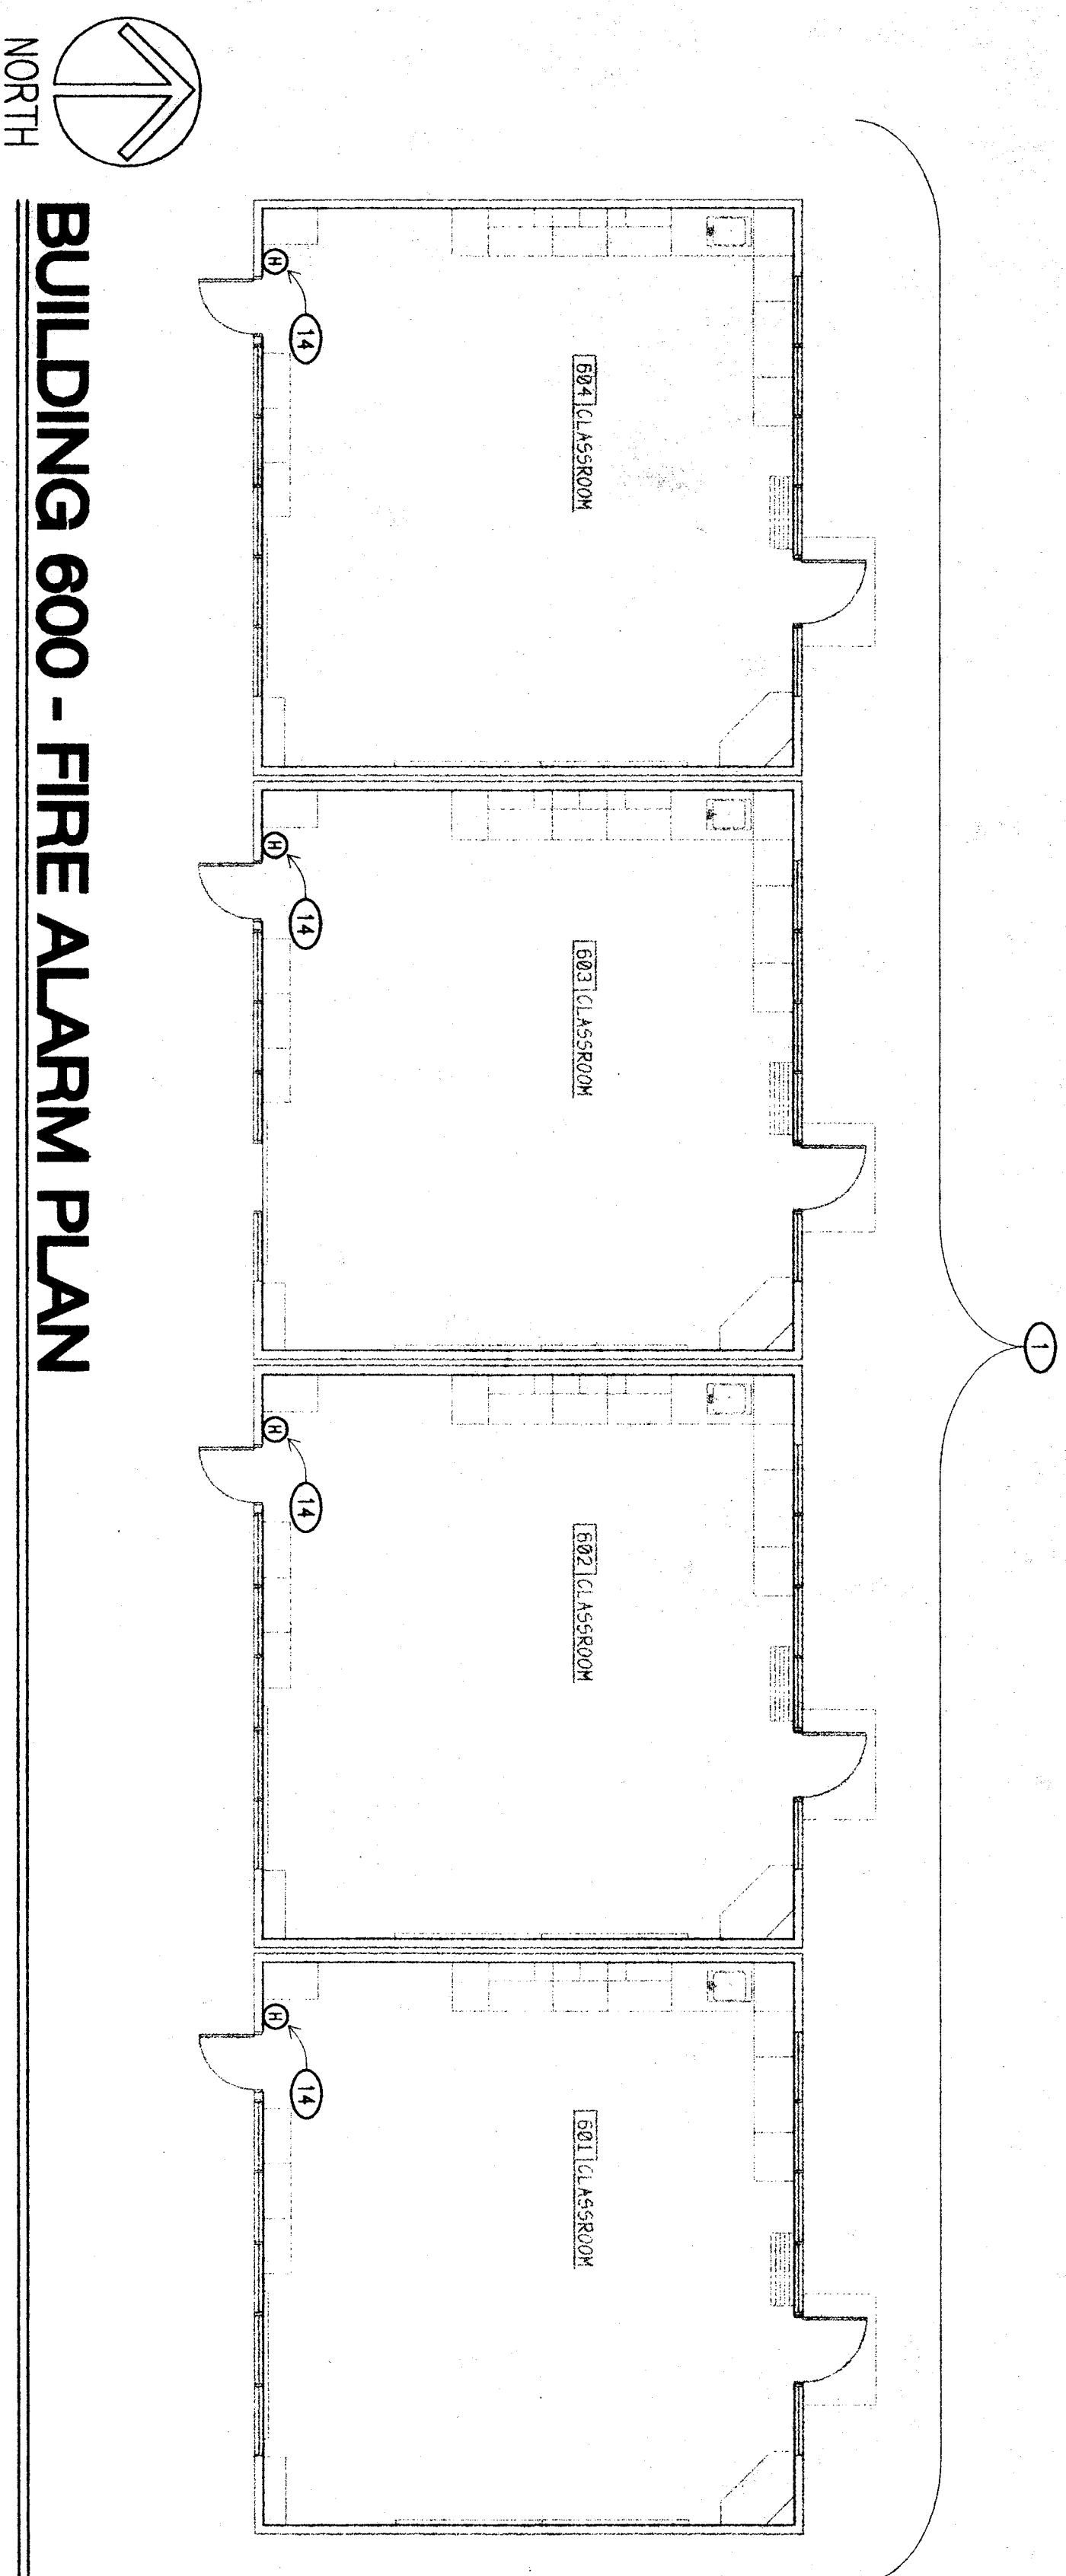

1/8"

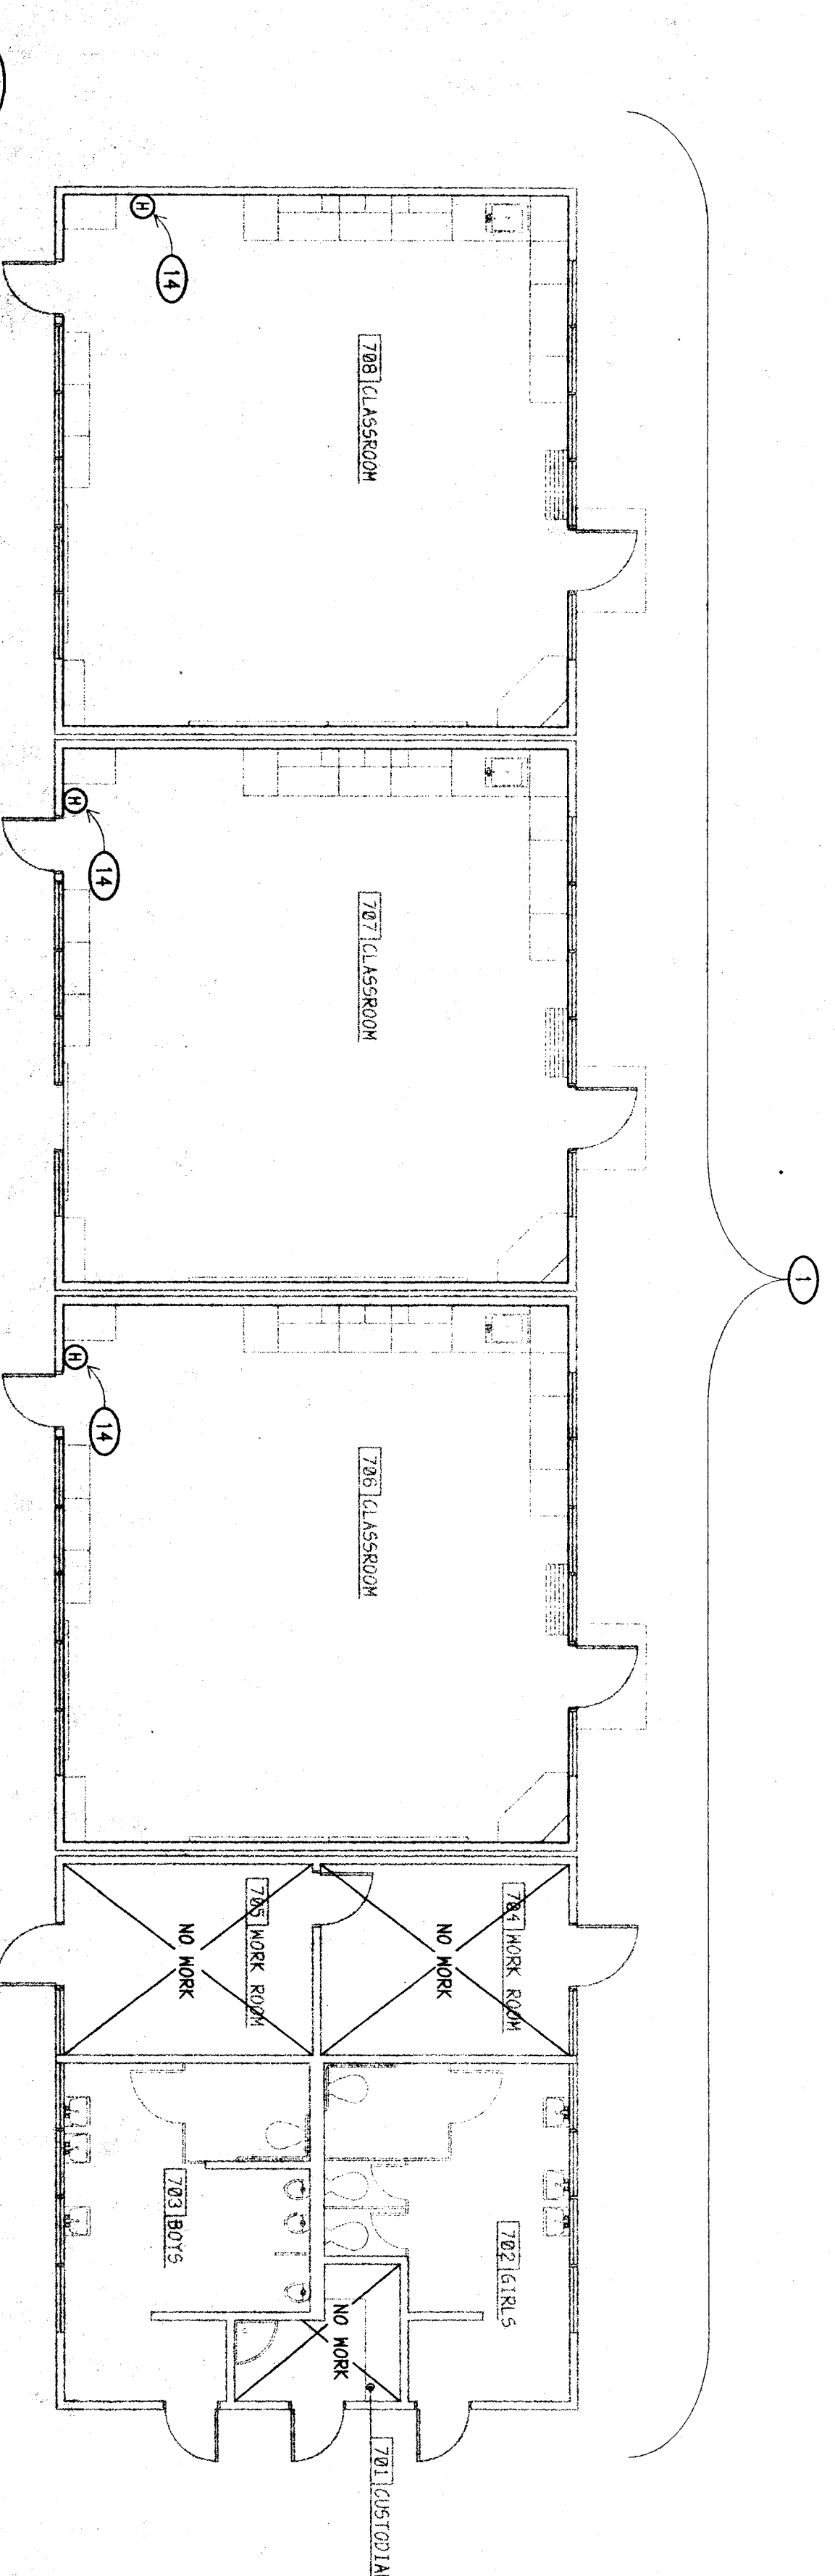

1/8"

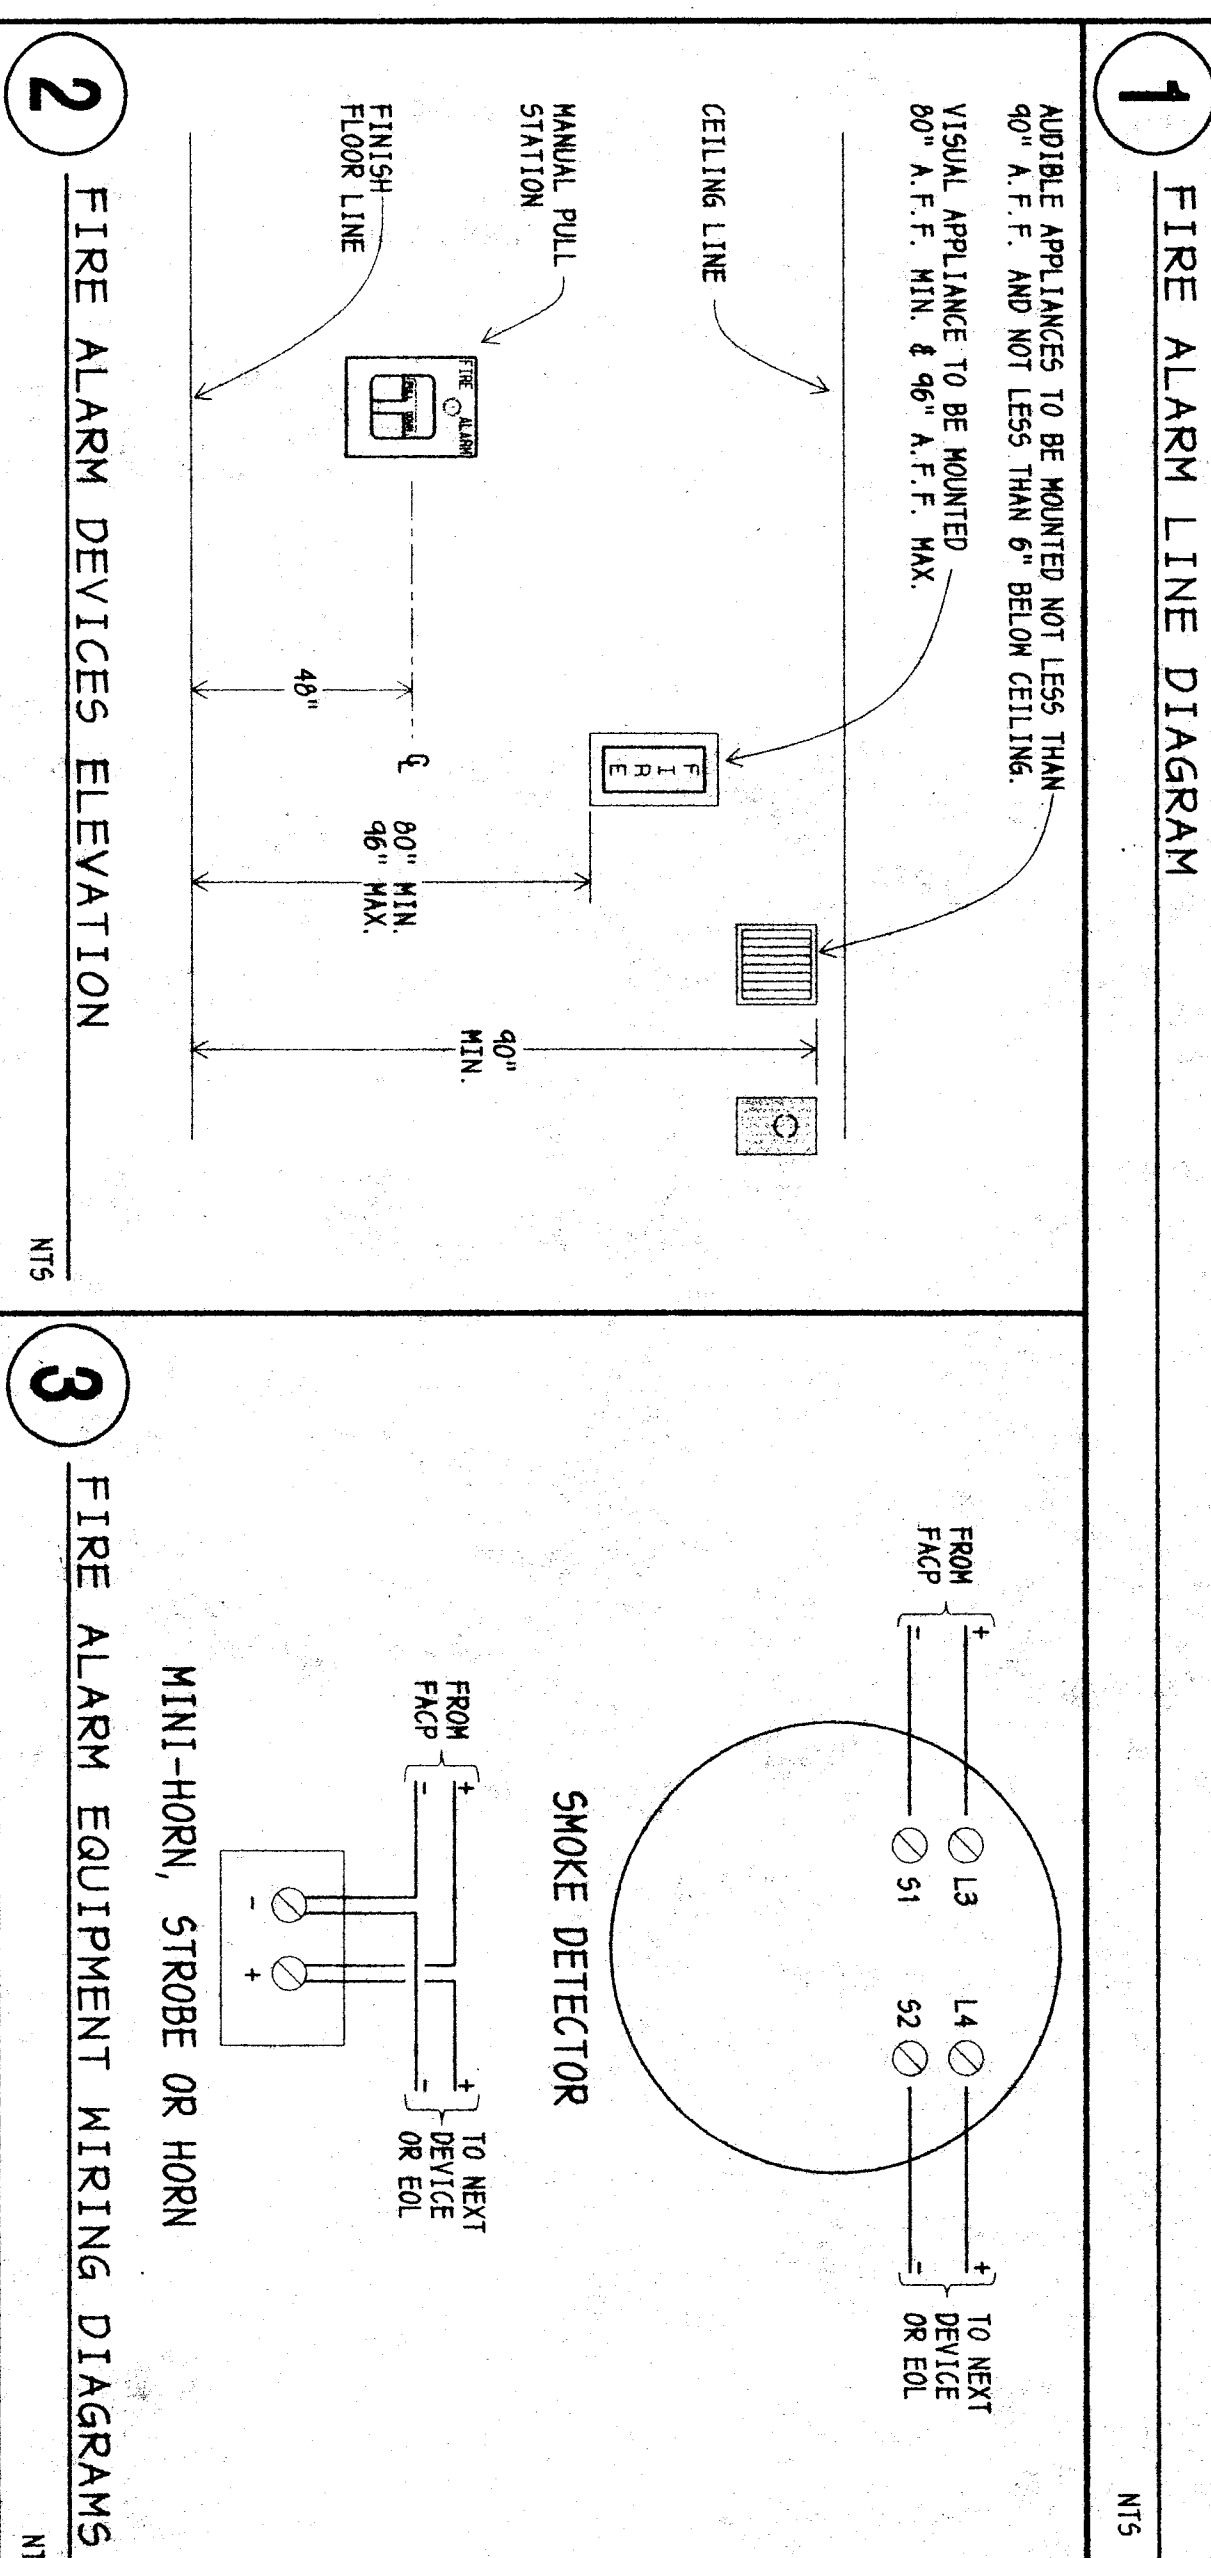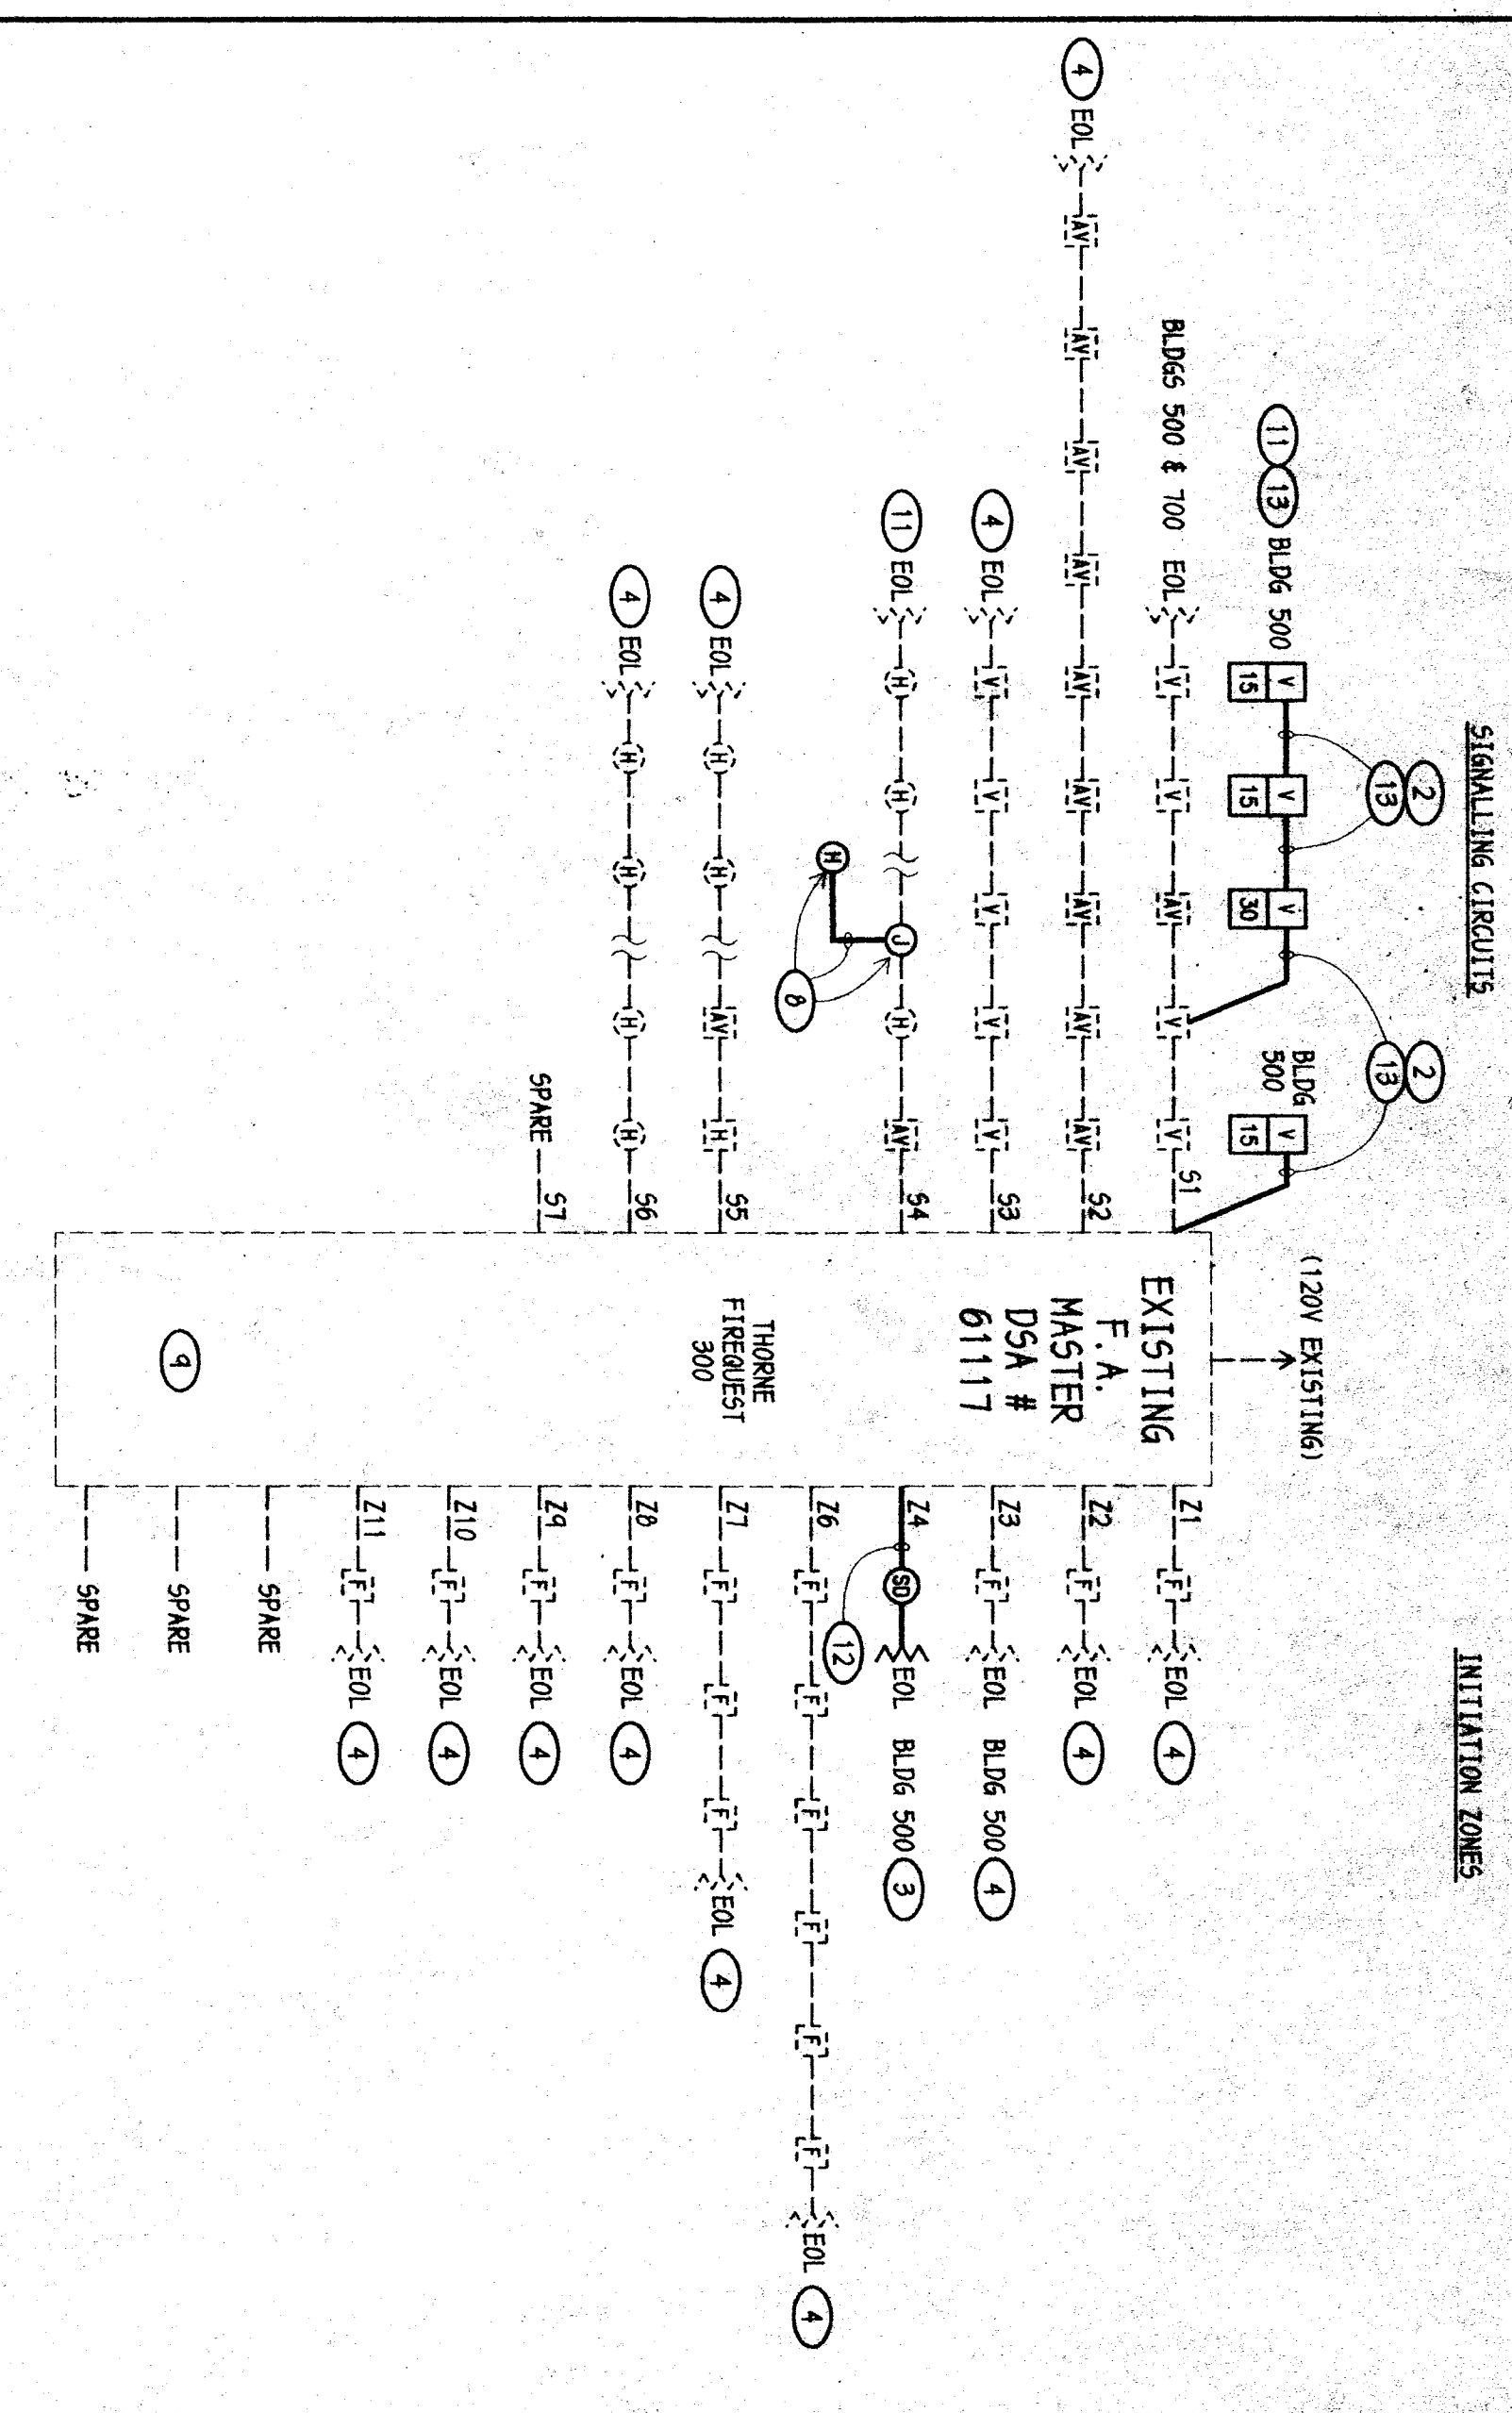

**NOTES (THIS SHEET ONLY):**

- NO WORK REQUIRED AT THIS BUILDING, U.O.N.
- 3/4" - 4 #12
- RELOCATE AND RECONNECT EXISTING SMOKE DETECTOR AS SHOWN.
- TO REMAIN, NO WORK REQUIRED.
- 3/4" - 2 #14, 4 #12
- EXISTING TO REMAIN - NO WORK REQUIRED.
- INTERCEPT EXISTING VISUAL CIRCUIT AT THIS DEVICE AND EXTEND CONCEALED OVERHEAD WITH 3/4" - 4 #12.
- INTERCEPT EXISTING HORN CIRCUIT AT THIS DEVICE WITH SURFACE 1-80X & ROUTE CIRCUIT CONCEALED OVERHEAD AS REQUIRED WITH 3/4" - 4 #12.
- SYSTEM HAS 9.0 AMP HOUR BATTERIES.
- RELOCATE EXISTING DEVICE AS SHOWN & NOTED.
- DO NEW WORK AS NOTED.
- DO THIS WORK ONLY AS PART OF ALTERNATE BID #3
- EXISTING MINI-HORN TO REMAIN, CUT AND PATCH WALL AS REQUIRED TO INSTALL DEVICE IN A NEW FLUSH 1-80X IN SAME LOCATION.


**FIRE ALARM CONTROL PANEL BATTERY CALCULATION**

QUANTITY	ALARM CURRENT EACH	ALARM CURRENT 500-TOTAL	ALARM CURRENT 500-TOTAL
4	0.074	0	.296
1	0.124	0	.124
10	0.074	0	.74
17	0.046	0	.816
41	0.012	0	.492
1	0.122	0	.122
1	0.246	0	2.46
1	1.82	0	1.82
1	.31	0	.31
TOTALS			4.94

TOTAL ALARM CURRENT OF 4.94 x .069 (5 MINUTES) = 0.34 A.H.  
 TOTAL SUPERVISORY CURRENT OF .31 x 24 HOURS = 7.44 A.H.  
 TOTAL AMP HOURS RESULTED = 7.78 A.H.  
 PROVIDE 14.0 AMP HOUR BATTERIES

**COMPLETE FIRE ALARM PLAN SUBMITTAL**

THE FIRE ALARM SYSTEM SHOWN ON THESE PLANS HAS BEEN SUBMITTED AND APPROVED BY THE DIVISION OF THE STATE ARCHITECT. ANY SUBSTITUTION OF THE FIRE ALARM SYSTEM SHALL BE RECOMMENDED TO THE DIVISION OF THE STATE ARCHITECT. ADDITIONAL FEES THAT ARE INCURRED DUE TO THIS SUBSTITUTION.

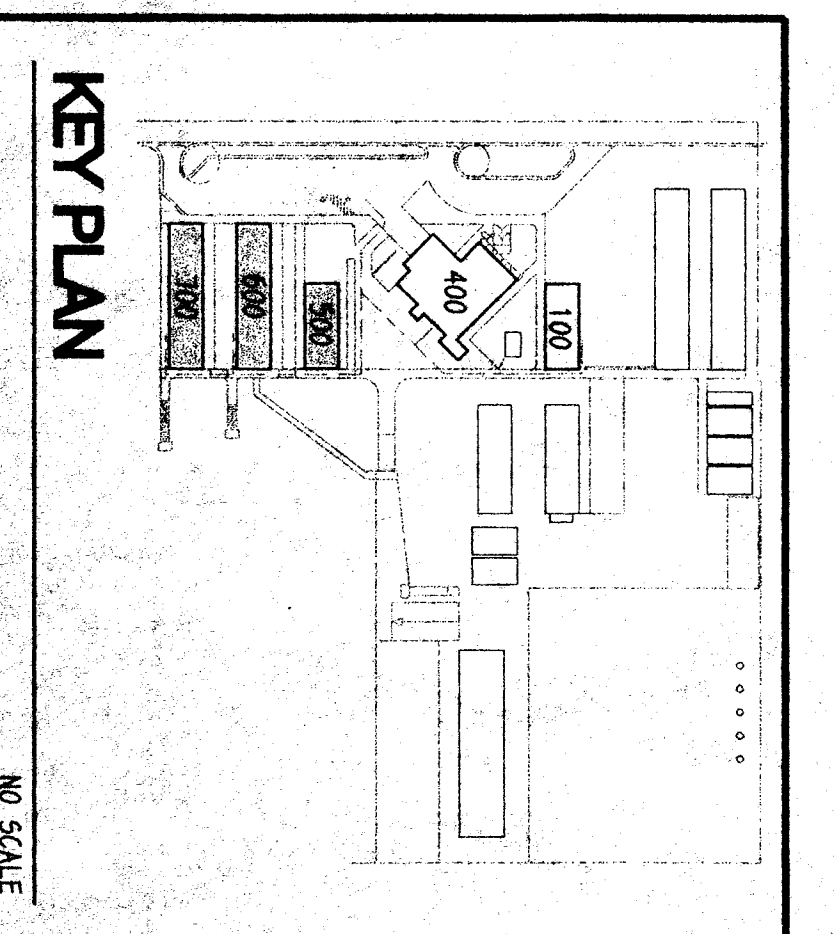

**ORDIZ MELBY ARCHITECTS**  
 5620 DISTRICT BLVD., #105  
 BAKERSFIELD, CA 93313  
 TEL. (805) 832-6266  
 FAX. (805) 832-4291

**REGISTERED ARCHITECT**  
 No. C-14728  
 State of California  
 WILLIAM J. MELBY, AIA  
 ARCHITECT  
 C-14,728

**AS BUILT DRAWINGS**  
 MODERNIZATION OF  
 COLLEGE HEIGHTS  
 ELEM. SCHOOL  
 FOR:

**BAKERSFIELD CITY SCHOOL DISTRICT**

2551 SUNNY LN.  
 BAKERSFIELD,  
 CALIFORNIA  
 93305

**APPENDUM #1 TO DRAWING #E9.0**

**CONNELLS CONSULTING GROUP, INC.**  
 Consulting Electrical Engineers  
 918 W. Main St., P.O. Box 233, 2871  
 BAKERSFIELD, CALIFORNIA 93304

**REGISTERED ELECTRICAL ENGINEER**  
 No. E-18802  
 State of California  
 JOHN W. MELBY, P.E.  
 CONSULTING ELECTRICAL ENGINEER

DATE: 01/11/01  
 REVISION: 01/11/01  
 DRAWN BY: JWM  
 CHECKED BY: JWM  
 DESIGNED BY: JWM

**BUILDINGS 500, 600, AND 700 - FIRE ALARM PLANS**

NO SCALE

9.0