



24x40

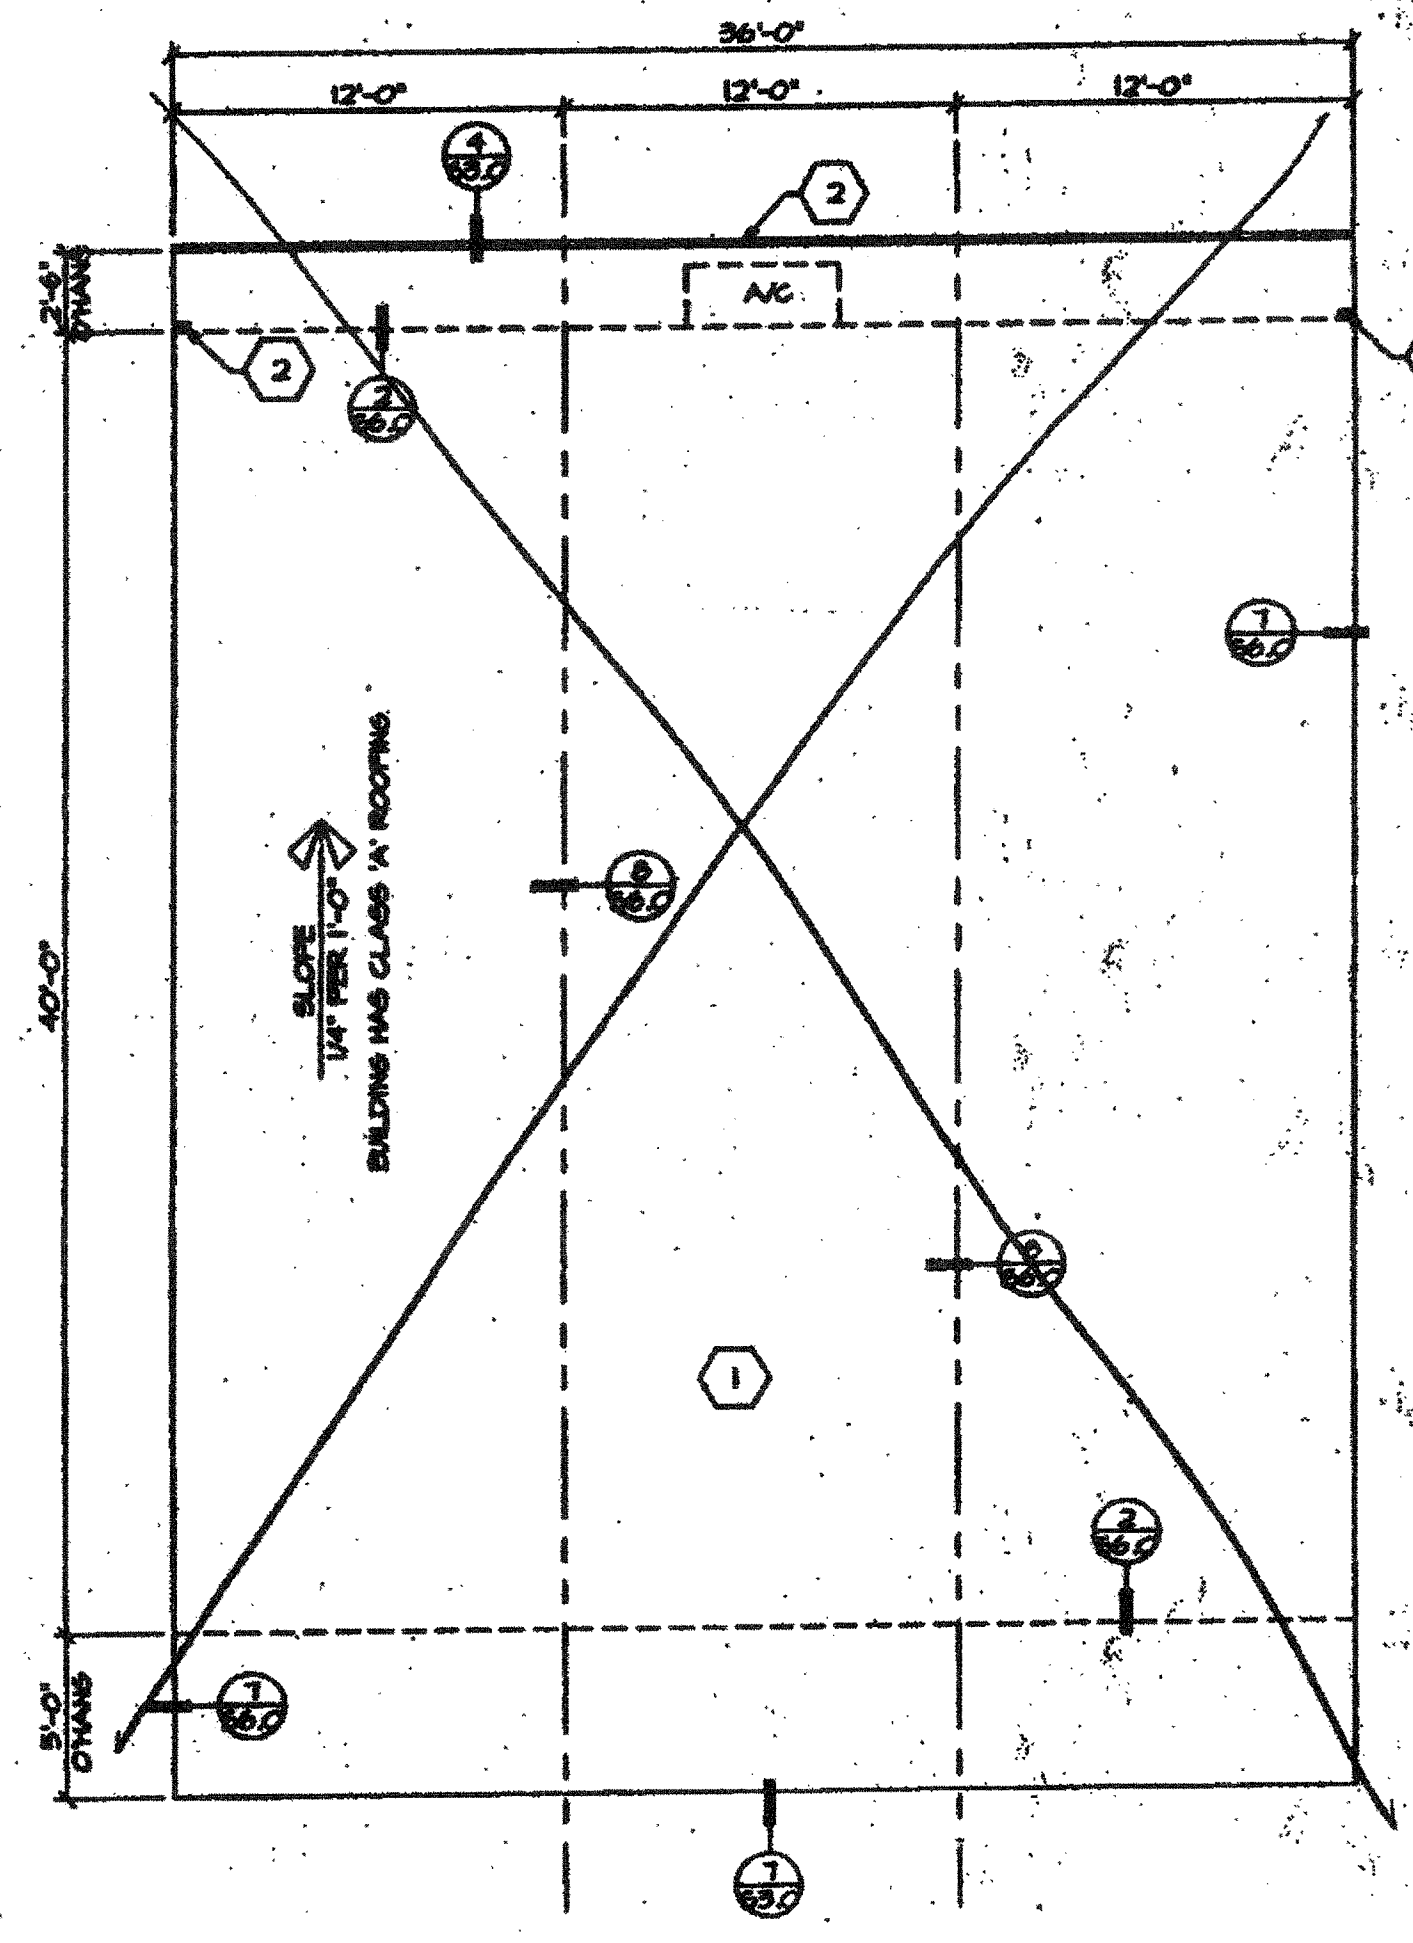

~~36x40~~

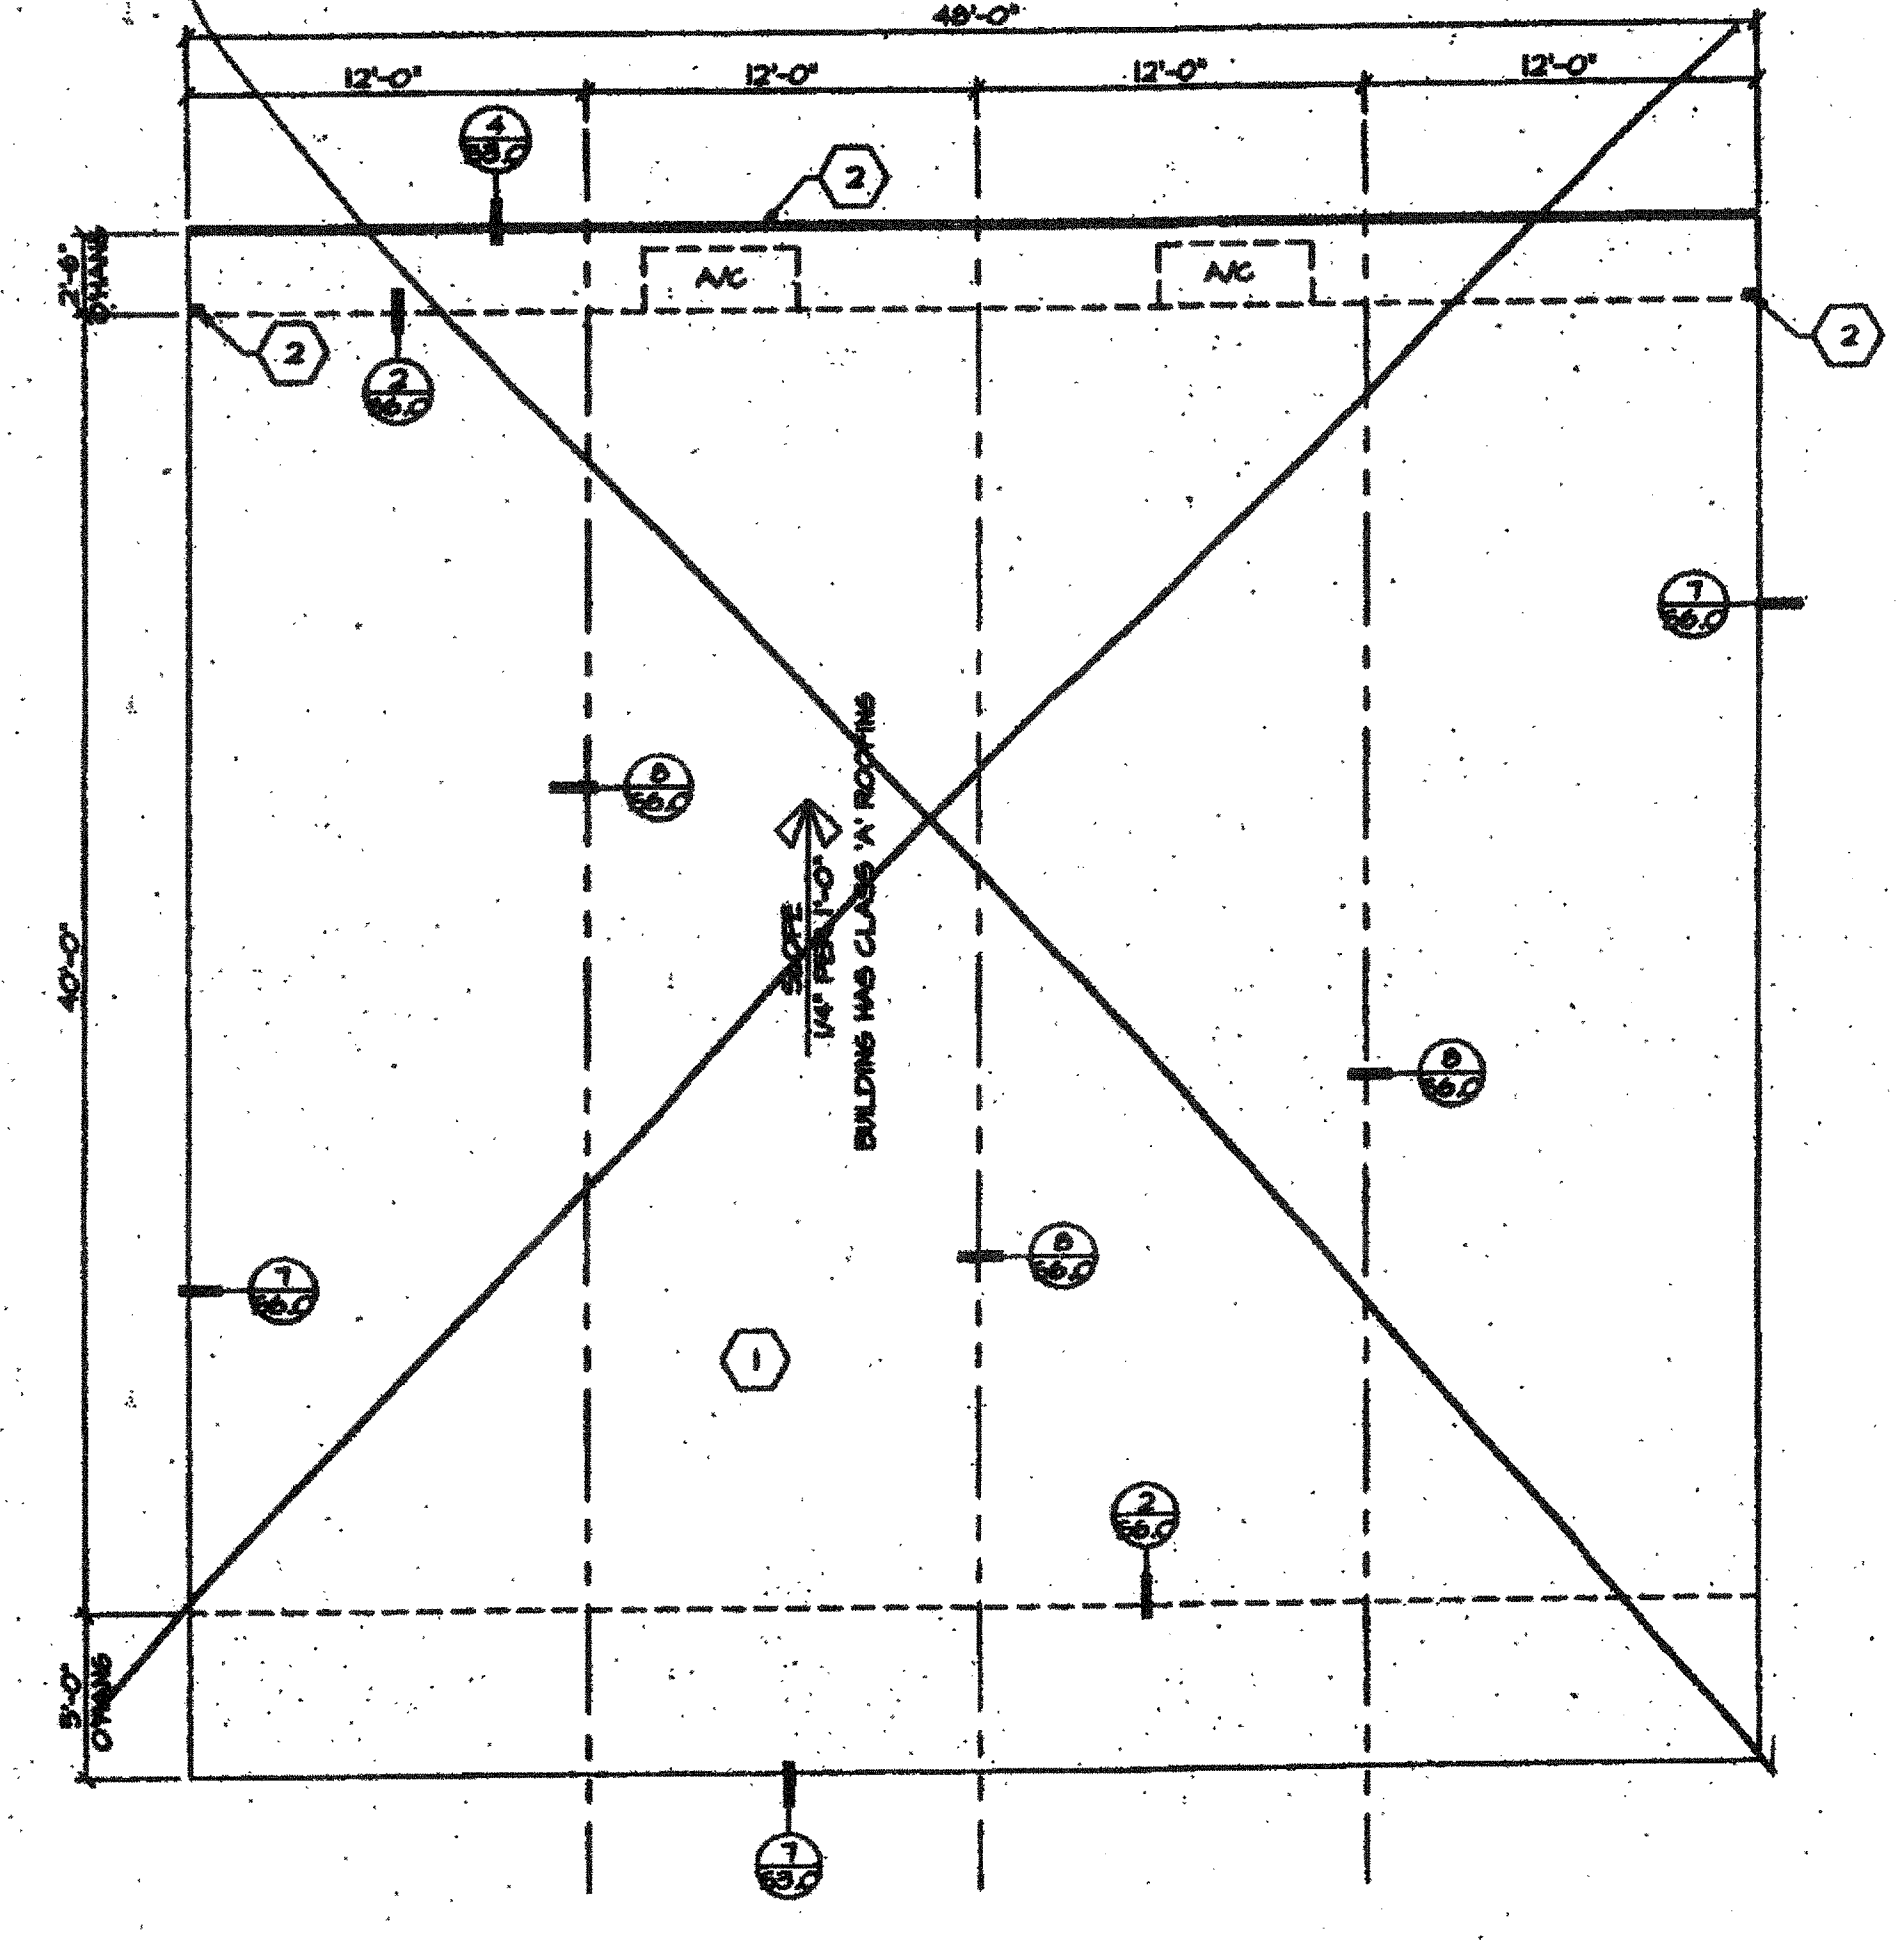

~~48x40~~

ROOF PLAN (MONO SLOPE)  
SCALE: 3/16" = 1'-0"

KEYNOTES  
1 ROOFING- SEE SHEET 41  
2 26 GA. GUTTER AND DOWNSPOUT.

CBC 1998  
PC

D.S.A.  
IDENTIFICATION STAMP  
DIV. OF THE STATE ARCHITECT  
OFFICE OF REGULATION SERVICES  
04-101055  
DATE MAY 03 2016

D.S.A. PORTION 1  
IDENTIFICATION STAMP  
DIV. OF THE STATE ARCHITECT  
066978  
DATE MAY 03 2016

STRUCT. ENGINEER  
ARCHITECT

CHANGE ORDER

CHECKED BY

1833 Kenneth Ave., Riverside, CA 92504  
Tel: (951) 514-2244  
Fax: (951) 514-2245  
**JURORA MODULAR INDUSTRIES**

ROOF PLAN (MONO SLOPE)  
SHEET  
**A4**

IDENTIFICATION STAMP  
DIV. OF THE STATE ARCHITECT  
APP03 116978  
AC - FLSV SS KCL  
Date MAY 03 2016