


4 RELOCATABLE CLASSROOMS

MOUNT VERNON ELEMENTARY SCHOOL

BAKERSFIELD CITY SCHOOL DISTRICT

2161 POTOMAC AVE.

BAKERSFIELD, CA 93307

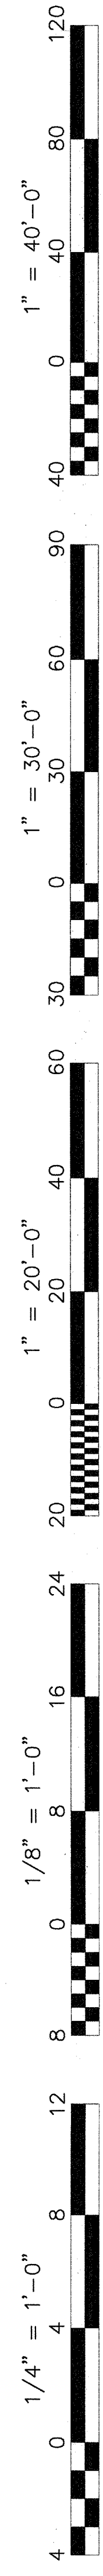

Ownership of Documents
 This document, the ideas and designs incorporated herein, as an instrument of Professional Service is the property of Integrated Designs by SOMAM, Inc. and is not to be used, in whole or in part for any other project without written authorization.
 © COPYRIGHT 2015

integrated designs by SOMAM, Inc.
 ARCHITECTURE - ENGINEERING - INTERIOR DESIGN - CONSTRUCTION MANAGEMENT
 801 N. Fresno, Suite 130 - Fresno, California 93710
 Phone (559) 438-0887 Fax (559) 438-0887 E-Mail: design@somam.com
 www.integrateddesigns.com

TITLE SHEET
 4 RELOCATABLE CLASSROOMS
 MOUNT VERNON ELEMENTARY SCHOOL
 BAKERSFIELD CITY SCHOOL DISTRICT
 2161 POTOMAC AVE, BAKERSFIELD, CA 93307


SHEET INDEX	
SHT. NO.	DESCRIPTION
GENERAL	
T1.01	TITLE SHEET
ARCHITECTURAL	
A1.01	SITE PLAN
A1.02	ENLARGED SITE PLAN
A1.03	SITE DETAILS
ELECTRICAL	
E-1	SITE PLAN - ELECTRICAL
E-2	POWER AND SIGNAL PLAN
E-3	FIRE ALARM PLAN
E-4	DETAILS AND SYSTEM DIAGRAMS

STOCKPILE # 66341 - 24'x40' RELOCATABLE BUILDING BY "MODTECH INC." (STKP-275)	
A.0	COVER SHEET
A1.0A	FLOOR PLAN (24x40)
A3.0A	EXTERIOR ELEVATION (24x40) DUAL PITCH
F0.1	FOUNDATION PLAN (24x40)
F3.0	FOUNDATION DETAILS WOOD
S1.0	FLOOR FRAMING PLAN (TYP 50 PSF)
E1.0A	ELECTRICAL PLAN
R1.0	RAMP / LANDING
R2.0	RAMP / STAIR DETAILS

STOCKPILE # 04-101984 - 24'x40' RELOCATABLE BUILDING BY "MODTECH INC." (STKP-3405)	
A.0	COVER SHEET
A1.0	FLOOR PLAN (24x40)
A3.0	EXTERIOR ELEVATION (24x40) DUAL PITCH
F1.0	FOUNDATION PLAN (24x40) 50 PSF (WOOD)
F2.0	FOUNDATION DETAILS
S1.2	FLOOR FRAMING DETAILS (TYPICAL)
E1.0	ELECTRICAL PLAN (24x40)
R1.00	RAMP / LANDING PLAN w/ 11' RAMP
R1.02	RAMP / STAIR DETAILS

STOCKPILE # 04-100929 - 24'x40' RELOCATABLE BUILDING BY "MODTECH" (STKP-42)	
A0	COVER SHEET
A1.0	FLOOR PLAN (24x40)
AA2.0	EXTERIOR ELEVATIONS
AA3.0	INTERIOR ELEVATIONS
AA4.0	CEILING GRID DETAILS AND NOTES
AA5.0	DOOR, WINDOW, FINISH HARDWARE SCHEDULES
A6.0	ARCHITECTURAL DETAILS
A6.1	ARCHITECTURAL DETAILS
A7.0	REFLECTED CEILING PLAN
A7.1	REFLECTED CEILING DETAILS
F1.0	RELOCATION FOUNDATION PLAN AND DETAILS - PC 04-113776
F2.1	RELOCATION FOUNDATION PLAN AND DETAILS - PC 04-113776
SA1.0	FLOOR FRAMING PLAN
SA2.0	ROOF FRAMING PLAN
S3.0	STRUCTURAL ELEVATIONS AND DETAILS
SA3.1	STRUCTURAL DETAILS
S4.0	STRUCTURAL DETAILS
S5.0	WALL FRAMING
S5.1	WALL FRAMING DETAILS
S5.2	WALL FRAMING DETAILS
M1.0	HVAC PLAN
E1.0	ELECTRICAL PLAN
R1.0	RAMP/LANDING PLAN
R2.0	RAMP/STAIRS DETAILS

ABBREVIATIONS			
ABOVE FINISHED FLOOR	ABV	EACH	EA
ACCESSIBLE	A.C.C.	ELECTRIC	ELEC.
ACOUSTICAL	ACOUST.	ELECTRIC DRINKING FOUNTAIN	E.D.F.
ADJACENT	ADJ.	ELEVATION	ELEV.
ADJUSTABLE	ADJUST.	ELEVATION	ELEV.
AIR CONDITIONING	A/C	EQUIPMENT	EQUIP.
ALUMINUM	ALUM.	ESTIMATE	EST.
ANCHOR BOLT	AB	EXHAUST	EXH.
BENT ANCHOR BOLT	BAB	EXHAUST FAN	E.F.
ANODIZED	ANOD.	EXPANSION	EXP.
ARCHITECTURAL	ARCH.	EXPANSION JOINT	E.J.
ASPHALT CONCRETE	A.C.	EXTERIOR	EXT.
BACKBOARD	BACKBRD.	FABRIC WALL COVERING	F.W.C.
BEAM	BM	FACE OF BLOCK	F.O.B.
BENCH MARK	B.M.	FACE OF CONCRETE	F.O.C.
BETWEEN	BTWN.	FACE OF STUD	F.O.S.
BLOCK	BLK.	FACE OF WALL	F.O.W.
BOTTOM	BTM.	FACTORY FINISH	FF
BUILDING	BLDG.	FEET/FOOT	FT.
CABINET	CAB.	FEMININE NAPKIN DISPOSAL	F.N.D.
CADMIUM	CAD.	FIBER GLASS	F.G.
CARPET	CPT.	FINISH	FIN.
CARRIAGE BOLT	C.B.	FIRE EXTINGUISHER CABINET	F.E.C.
CAST IRON	C.I.	FIRE RATED GYP. BD.	F.R.G.B.
CEILING	C.E.	FIXED GLASS	F.G.
CEILING DIFFUSER	C.D.	FLAT HEAD	F.H.
CEILING GRILLE	C.G.	FLOOR	FLR.
CEILING REGISTER	C.R.	FLOOR DRAIN	F.D.
CEMENT	CEM.	FLUORESCENT	FL.
CENTERLINE	C.L.	FOOTING	FTG.
CERAMIC TILE	C.T.	FOUNDATION	FDN.
CIRCUIT	CRT.	FRAMING	FRM'G.
CLEANOUT	C.O.	GAGE/GAUGE	GA.
CLEAR	CLR.	GALVANIZE	GALV.
COLD WATER	C.W.	GALVANIZED IRON	G.I.
COLUMN	COL.	GLASS	GL.
COMBINATION/COMBUSTION	COMB.	GRAB BAR	G.B.
COMPOSITION, COMPOSITE	COMP.	GRADE	GRD.
CONCRETE	CONC.	GROUND	GND.
CONCRETE MASONRY UNIT	C.M.U.	GYP	GYP
CONDITION	CND.	GYP/UM BOARD	G.B./CYP.BD.
CONNECTION	CONN.	HARDWARE	HDW.
CONSTRUCTION JOINT	CONSTR. J.	HEAD	HDR.
CONTINUOUS	CNT.	HEIGHT	HT.
CONTRACTOR	CONTR.	HOLLOW METAL	H.M.
COORDINATE	COORD.	HORIZONTAL	HORIZ.
COUNTERSINK	CSK.	HOT WATER	H.W.
DEPARTMENT	DEPT.	HOSE BIBB	H.B.
DEPTH, DEEP	DEPT.	INCH	IN.
DETAIL	DET.	INSIDE DIAMETER/DIMENSION	I.D.
DIAGONAL	DIAG.	INSULATION	INSUL.
DIAMETER	DIA.	INTERIOR	INT.
DIMENSION	DIM.	JAMB	JB.
DISPENSER/DISPOSAL	DISP.	JOINT	JT.
DIVISION	DIV.		
DOOR	DR.		
DOUBLE	DBL.		
DOWN	DN.		
DOWNSPOUT	D.S.		
DRAWING	DRWG.		
DRINKING FOUNTAIN	D.F.		
LAMINATE	LAM.	SANITARY NAPKIN DISPENSER	S.N.D.
LAVATORY	LAV.	SANITARY NAPKIN RECEPTACLE	S.N.R.
LEFT HAND	L.H.	SCHEDULE	SCH.
LINEUM	LINO.	SEAT COVER DISPENSER	S.C.D.
LONG	LG.	SECTION	SECT.
MACHINE BOLT	M.B.	SHEATHING	SHTG.
MACHINE SCREW	M.S.	SHEET	SHT.
MANUFACTURER	MFR.	SHEET METAL & AIR	S.M.
MATERIAL	MAT.	CONDITIONING CONTRACTOR	S.M.C.
MAXIMUM	MAX.	NATIONAL ASSOCIATION	S.M.A.
MECH.	MECH.	SHEET METAL SCREWS	S.M.S.
MEDIUM	MD.	SHIELDS	SH.
MEMBRANE	MBNE.	SIMILAR	SM.
METAL	MTL.	SNK	S.
METAL PLANAR CEILING	M.P.C.	SOAP DISPENSER	S.D.
METAL TOILET PARTITION	M.T.P.	SPECIFICATION	SPEC.
MILLIMETER	M.M.	SPLASH	SPL.
MINIMUM	MIN.	SPLASH BLOCK	S.B.
MISCELLANEOUS	MISC.	SQUARE	SQ.
MULLION	MULL.	STAINLESS STEEL	S.S.
NOT IN CONTRACT	N.I.C.	STANDARD	STD.
NOT TO SCALE	N.T.S.	STEEL	STL.
NUMBER	NO.#	STORAGE	STR.
OPPOSITE HAND	O.H.	STIFFENER	STIFF.
ON CENTER	O.C.	STRUCTURAL	STRUC.T.
OPENING	OPG.	SUSPENDED	SUSP.
OUTSIDE DIAMETER/DIMENSION	O.D.	SUSPENDED ACOUSTIC CEILING TILE	S.A.T.C.
OVAL HEAD	O.H.	SWITCH	SW.
OVER (ON)	O/V.	TELEPHONE	TEL.
OVERFLOW	O/VFL.	THICK	THK.
OVERHAND	O/H.	THRESHOLD	THR.
PAIN	PT.	TOILET PAPER HOLDER	T.P.H.
PAIR	PR.	TOLERANCE	TOL.
PAPER TOWEL DISPENSER	P.T.D.	TRANSFORMER	TRANS.
PLASTIC	PLAS.	TYPICAL	TYP.
PLATE	PL.	UNDERWRITERS LABORATORY	U.L.
PLATED	PLTD.	UNLESS OTHERWISE NOTED	U.O.N.
PLUMBING	PLBG.	URINAL	UR.
PLYWOOD	PLYWD.	VENTILATE/VENTILATION	VEN.F.
POINT OF CONNECTION	P.O.C.	VENT THROUGH ROOF	V.T.R.
POUND PER SQ. FOOT	P.S.F.	VERTICAL FIELD	V.F.
POUND PER SQ. INCH	P.S.I.	VERTICAL	VERT.
QUARTER	QTR.	VINYL COMPOSITION TILE	V.C.T.
RADIUS	R.RAD.	VINYL WALL COVERING	V.W.C.
RAINWATER LEADER	R.W.L.	VOLUME	VOL.
RECEPTACLE	RECEPT.	WATER CLOSET	W.C.
REFLECTED	REFLD.	WATER PROOF	W.P.
REFRIGERATOR	REF.	WATER RESISTANT	W.R.
REINFORCING	REINFC.	WIDTH	W.
REMOVABLE	REMOV.	WIRE GLASS	W.G.L.
REQUIRED	REQ'D.	WITHOUT	W/O
RESILIENT	RES.	WOOD	WD.
REVISION	REV.	WOOD SCREWS	W.S.
RIGHT HAND	R.H.		
ROOF DRAIN	R.D.		
RUBBER TOPSET BASE	R.T.B.		

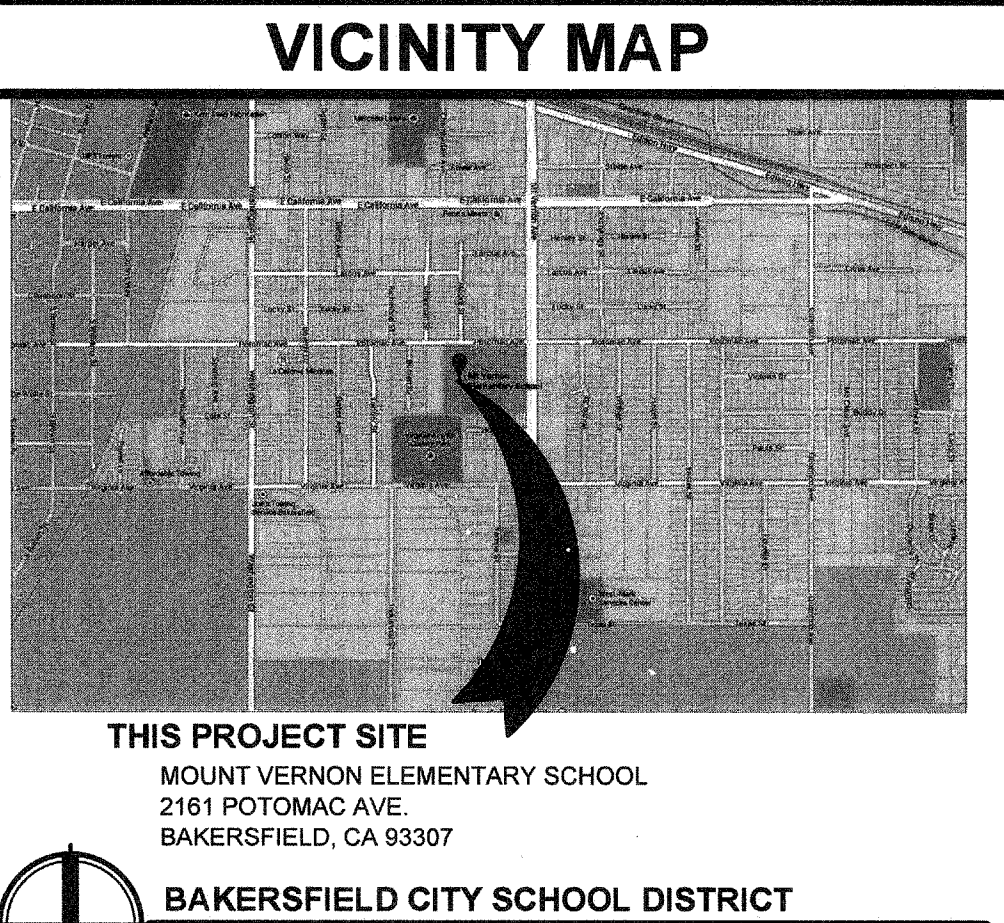

GENERAL NOTES	
1.	ALL WORK SHALL CONFORM TO TITLE 24, CALIFORNIA CODE OF REGULATIONS
2.	CHANGES MADE TO THE APPROVED DRAWINGS AND SPECS SHALL BE MADE BY ADDENDUM OR C.C.D., APPROVED BY DSA AS REQUIRED BY SECTION 4-338, PART 1, TITLE 24, C.C.R.
3.	REFER TO RELOCATABLE BUILDING MANUFACTURER'S DRAWINGS FOR ALL INFORMATION REGARDING THE RELOCATABLE BUILDINGS

SCOPE OF WORK	
•	RELOCATION OF (4) PORTABLE CLASSROOM BUILDINGS AND METAL RAMPS AND CONSTRUCTION OF UTILITY SERVICES ON AN EXISTING ELEMENTARY SCHOOL CAMPUS.

BUILDING DATA	
OCCUPANCY = E	TYPE OF CONSTRUCTION = VB (NON-SPRINKLERED)
TEMP CLASSROOMS	4 (N) CLASSROOMS @ 960 S.F. (24'x40') EA. = 3,840 S.F.
TOTAL = 3,840 S.F.	
PER 2013 C.B.C. TABLE 503:	ALLOWABLE AREA = 9,500 S.F.
3,840 PROPOSED < 9,500 ALLOWABLE =	OK

INSPECTOR OF RECORD

THIS PROJECT REQUIRES A CLASS 4 INSPECTOR. THE INSPECTOR OF RECORD SHALL BE DSA APPROVED AND CONFORM TO THE CLASSIFICATION CRITERIA AS PROVIDED IN INTERPRETATION OF REGULATIONS (IR) A-7, DATED FEBRUARY 22, 2013

THE INSPECTOR SHALL BE EMPLOYED BY THE DISTRICT AND APPROVED BY THE RESPONSIBLE ARCHITECT.

ARCHITECT'S STATEMENT

ARCHITECT'S STATEMENT FOR PLANS PREPARED BY OTHER LICENSED DESIGN PROFESSIONALS AND/OR CONSULTANTS

THESE DRAWINGS AND/OR SPECIFICATIONS AND/OR CALCULATIONS FOR THE ITEMS LISTED IN THE SHEET INDEX AND CHECKED BELOW HAVE BEEN PREPARED BY OTHER DESIGN PROFESSIONALS OR CONSULTANTS WHO ARE LICENSED AND/OR AUTHORIZED TO PREPARE SUCH DOCUMENTS IN THIS STATE. THESE DOCUMENTS HAVE BEEN EXAMINED BY ME FOR DESIGN INTENT AND HAVE BEEN FOUND TO MEET THE APPROPRIATE REQUIREMENTS OF TITLE 24, CALIFORNIA CODE OF REGULATIONS AND THE PROJECT SPECIFICATIONS PREPARED BY ME.

THE ITEMS CHECKED BELOW ARE ACCEPTABLE FOR INCORPORATION INTO THE CONSTRUCTION OF THIS PROJECT FOR WHICH I AM THE INDIVIDUAL DESIGNATED TO BE IN GENERAL RESPONSIBLE CHARGE (OR FOR WHICH I HAVE DELEGATED RESPONSIBILITY FOR THIS PORTION OF THE WORK).

SEE THE SHEET INDEX ON THIS SHEET FOR DRAWINGS OTHER THAN ARCHITECTURAL.

APPLICABLE:

ARCHITECTURAL PLUMBING MECHANICAL ELECTRICAL

PORTABLE MANUFACTURER CIVIL

C-28966 LICENSED NUMBER **05-31-17** EXPIRATION DATE

7/25/16 DATE

SIGNATURE OF ARCHITECT/ENGINEER: CURTIS E. FLYNN, ARCHITECT, INTEGRATED DESIGNS BY SOMAM, INC.

SYMBOLS

	SECTION KEY
	SECTION IDENTIFICATION
	SHEET NUMBER
	DETAIL KEY
	DETAIL NUMBER
	SHEET NUMBER
	INTERIOR ELEVATION KEY
	ELEVATION DIRECTION
	ELEVATION IDENTIFICATION
	SHEET NUMBER
	ELEVATION DATUM
	INDICATES HEIGHT IN RELATION TO 0'-0"
	ROOM NUMBER / FINISH TAG
	ROOM NAME
	ROOM NUMBER
	WINDOW SCHEDULE KEY
	KEYNOTE SCHEDULE KEY
	DOOR SCHEDULE KEY

Issue Date: 10/31/14
 Date: 07/25/16
 Designer: [Signature]
 Date: 7/25/16

Agency Approval Stamp:



FILE # 15-6
 IDENTIFICATION STAMP
 DIV. OF THE STATE ARCHITECT
 OFFICE OF REGULATION SERVICES
 03-117168
 AC ME FL S PH SS TN
 DATE: JUL 04 2018
 TRACKING #:

Stamp(s):

Job No.: **5125**

Sheet No.: **T1.01**

Release: -

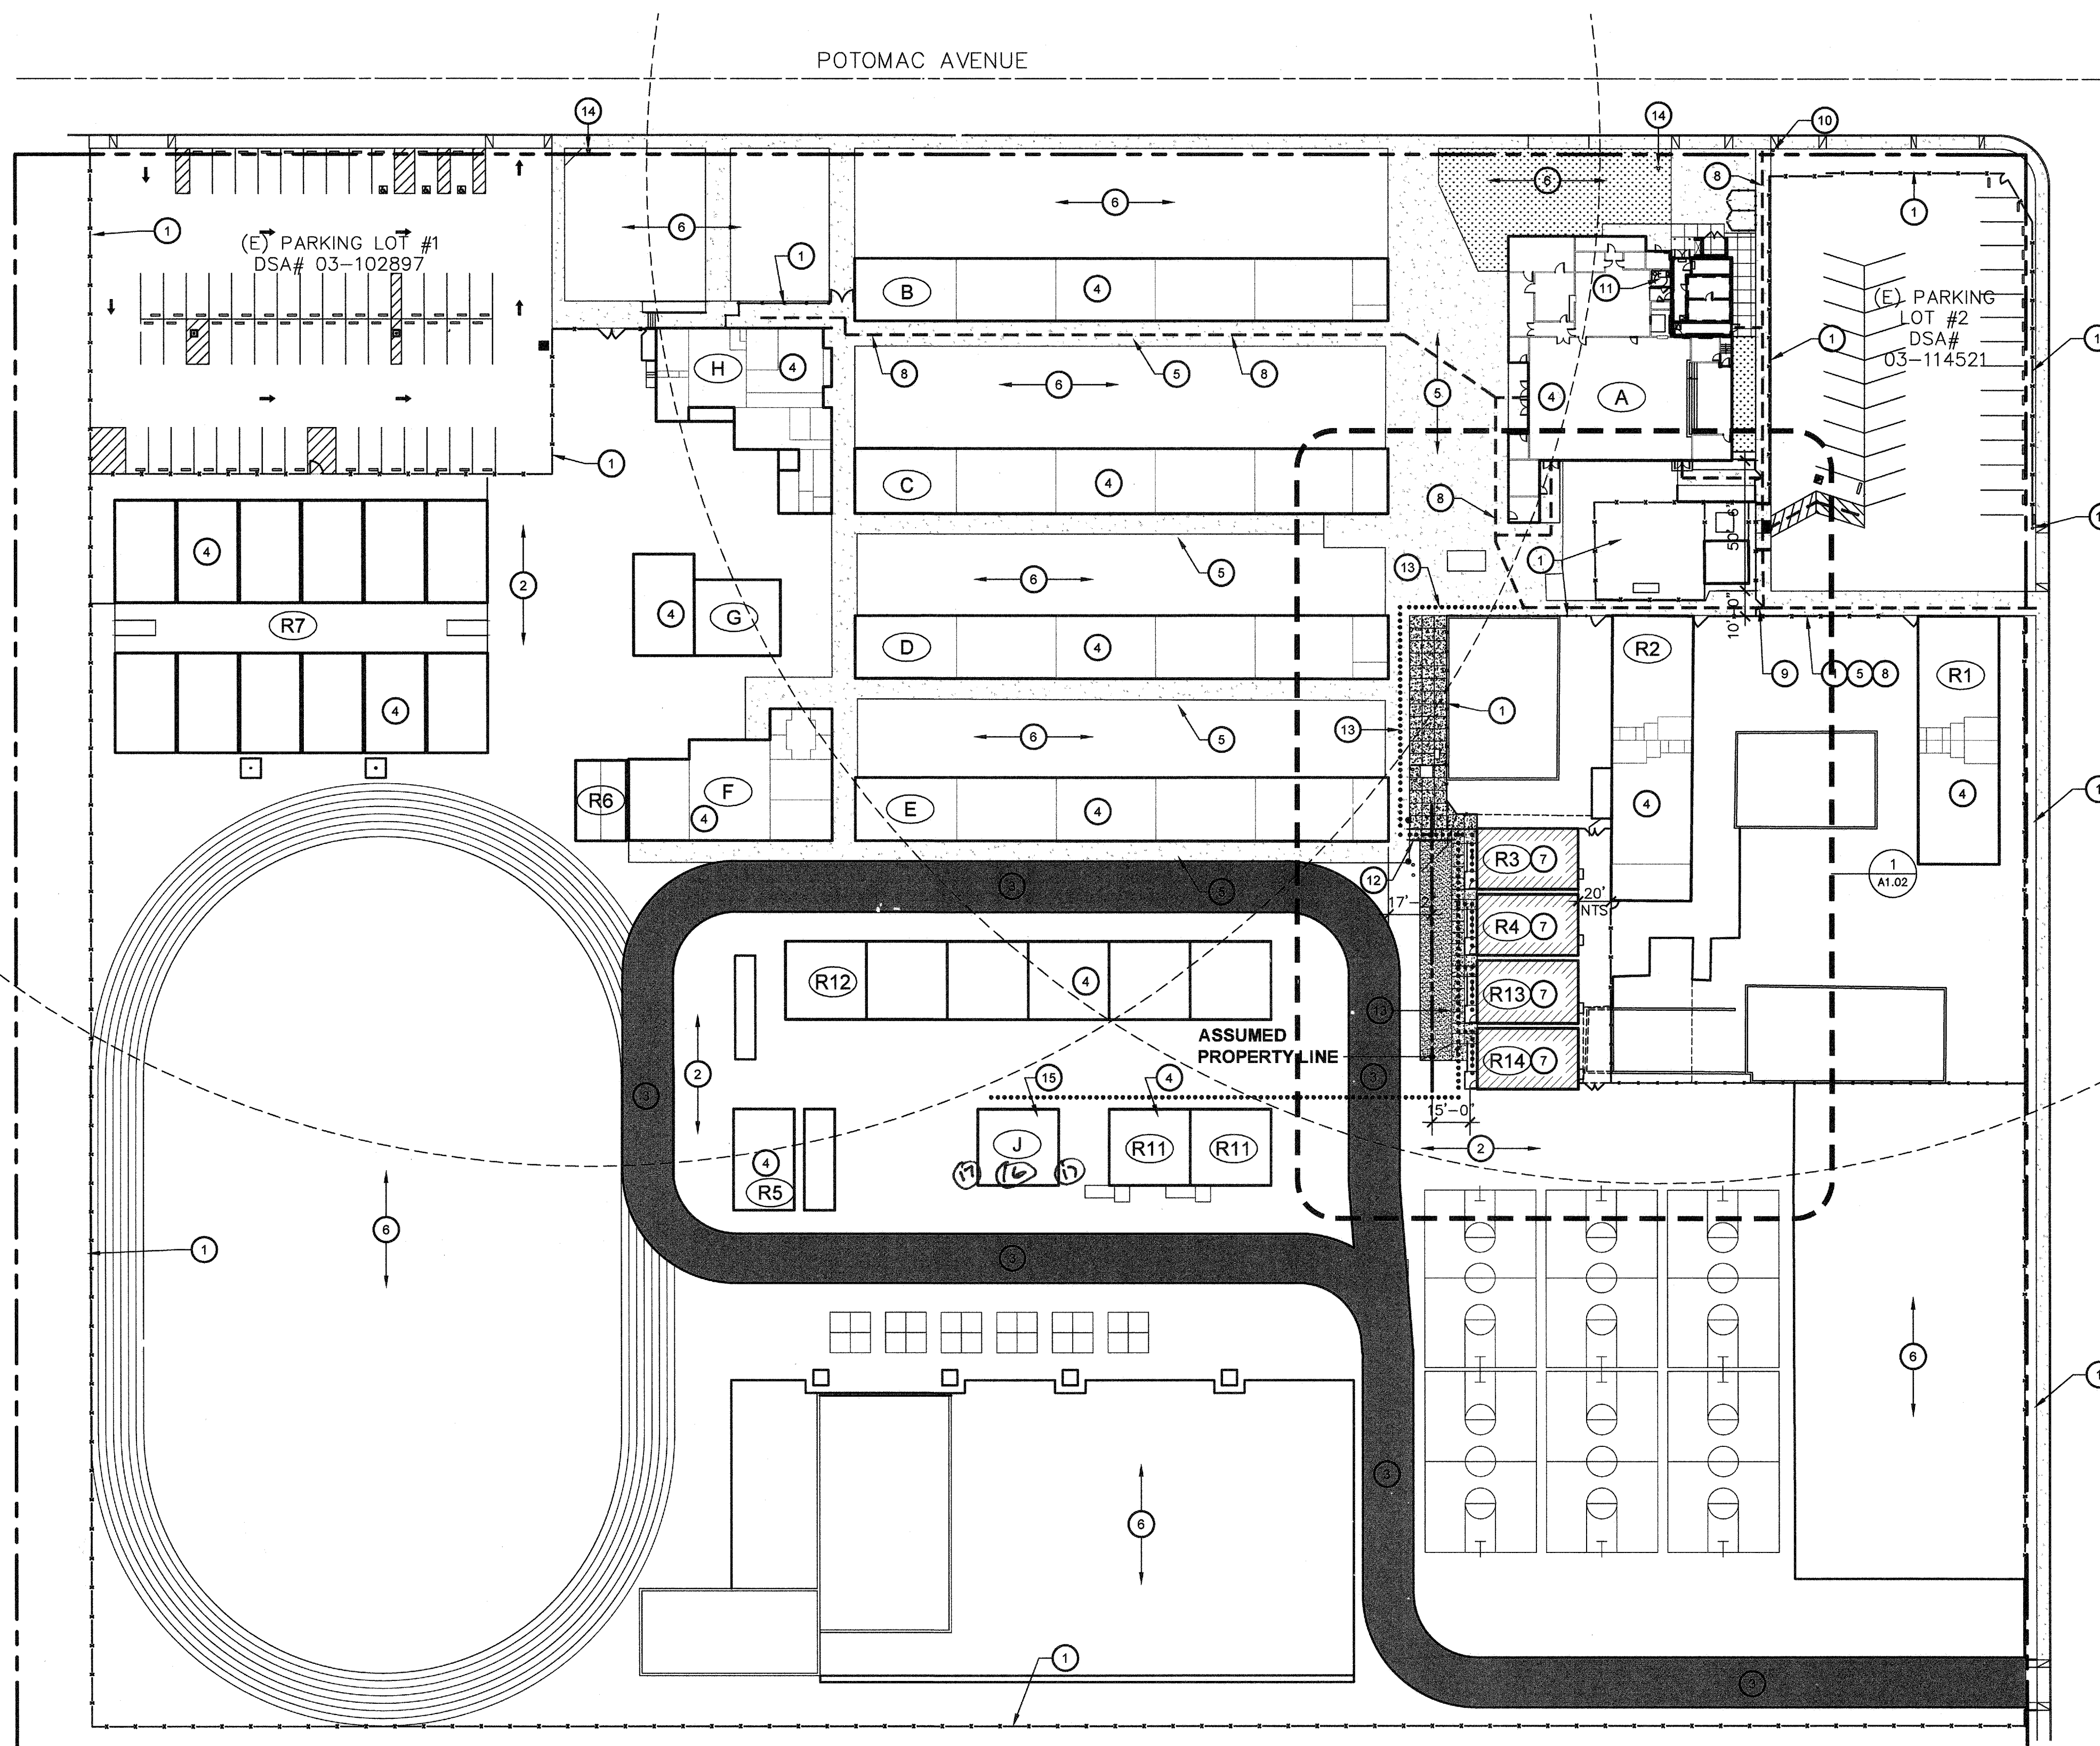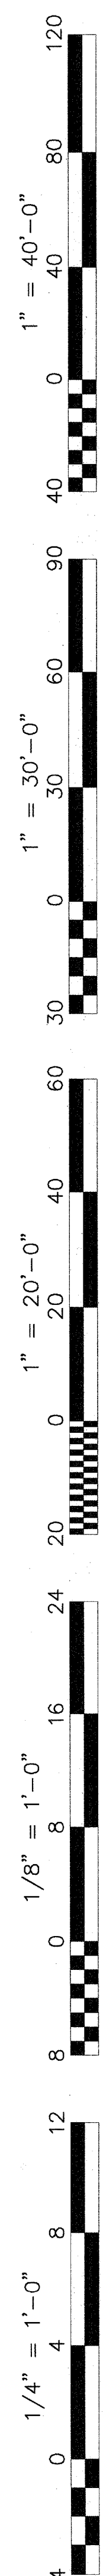

BUILDING KEY

#	DSA APPLICATION	BUILDING USE
A	19177	MULTI-USE, CAFETERIA, KITCHEN
B	3252	5 CLASSROOMS TOILET
C	3252	5 CLASSROOMS TOILET
D	5616	5 CLASSROOMS TOILET
E	5616 / 39113	5 CLASSROOMS TOILET
F	5616	4 MUSIC CLASSROOMS
G	28584	COUN / ACAD / COACH
H	3252 / 32802	ADMINISTRATION
R1	32682	2 KINDERGARTEN CLASSROOMS
R2	27729 / 30116	2 KINDERGARTEN CLASSROOMS
R3	PER THIS APPLICATION	RELOCATABLE CLASSROOM
R4	PER THIS APPLICATION	RELOCATABLE CLASSROOM
R5	NON-COMFORM.	KINDERGARTEN MAGNET
R6	30420	RELO TOILETS
R7	03-102897	12 RELO CLASSROOMS
R11	54429	2 RELO. CLASSROOMS
R12	30402	6 RELO. CLASSROOMS
J	03-102897	TOILETS
R13	PER THIS APPLICATION	RELOCATABLE CLASSROOM
R14	PER THIS APPLICATION	RELOCATABLE CLASSROOM

KEY NOTES

- (E) CHAIN LINK FENCE AND GATE TO REMAIN
- (E) A.C. PAVING TO REMAIN
- (E) 20'-0" WIDE FIRE TRUCK ACCESS LANE
- (E) BUILDING TO REMAIN (NO WORK)
- (E) CONCRETE WALK TO REMAIN (NO WORK)
- (E) TURF AND IRRIGATION TO REMAIN
- NEW MODULAR CLASSROOM ON WOOD FOUNDATION INSTALLED PER MANUFACTURERS DRAWINGS
- EXISTING ACCESSIBLE PATH OF TRAVEL TO REMAIN, VERIFY IN FIELD
- EXISTING 48" WIDE CHAIN LINK GATE W/ PANIC HARDWARE PER DSA APPL. NO. 03-114521
- EXISTING SITE ENTRANCE SIGN PER DSA APPL. NO. 03-114521
- (E) ACCESSIBLE STAFF RESTROOM PER DSA APPL. NO. 03-114521
- NEW ACCESSIBLE CONCRETE RAMP W/ HANDRAILS PER DETAIL 16/A1.03
- PROPOSED ACCESSIBLE PATH OF TRAVEL (P.O.T.) REFER TO ACCESSIBILITY NOTE, THIS SHEET
- EXISTING FIRE HYDRANT TO REMAIN
- UPDATE RESTROOM SIGNAGE PER DETAIL 2/A1.02

Per DSA # 03-102897
16 (C) Student & Staff Rm
17 Existing of Conf. Compliance w/ 2013 CBC Chapters 11B-602 and 11B-211.2

FLOOD ZONE INFO

FLOOD ZONE DESIGNATION: ZONE X (0.2%)
 F.I.R.M. PANEL DESIGNATION: 06029C2325E
 EFFECTIVE DATE OF F.I.R.M.: 09 / 26 / 2008
 BASE FLOOD ELEVATION (BFE): ~400 FT.
 COMMUNITY ORDINANCE SECTION: BMC 15.74.040

PARKING CALCULATION

EXISTING PARKING LOT #1 (03-102897)

TOTAL STALLS PROVIDED: 57

ACCESSIBLE STALLS REQUIRED PER CBC TABLE 11B-208.2: 3

VAN SPACES REQUIRED (1 PER 6 ADA): 1

ACCESSIBLE STALLS PROVIDED: 2 REGULAR
1 VAN
3 TOTAL

EXISTING PARKING LOT #2 (03-114521)

TOTAL STALLS PROVIDED: 34

ACCESSIBLE STALLS REQUIRED PER CBC TABLE 11B-208.2: 2

VAN SPACES REQUIRED (1 PER 6 ADA): 1

ACCESSIBLE STALLS PROVIDED: 1 REGULAR
1 VAN
2 TOTAL

LOCAL FIRE AUTHORITY REVIEW

810

To facilitate the Division of the State Architect's (DSA) approval of the FireLife Safety portion of a project, DSA requires Local Fire Authority (LFA) review of certain elements as identified in this form. Use of this form is mandatory for projects that require fire review as a condition of approval. This form is to be submitted to the DSA along with the project plans and DSA Form 03-1.

Project Information:
 School District/Owner: Bakersfield City School District
 Project Name/School: Mt. Vernon Elementary
 Project Address: 2181 Potomac Ave

LOCAL FIRE AUTHORITY (LFA) Information:
 LFA Agency Name: Kern County Fire Department
 LFA Reviewer Name: [Signature] Title: FF
 Telephone Number: 805-700-7000

Review Key: "R" = Compliant with LFA requirements; "NR" = Not approved (complete Section 9); "NA" = Not applicable to the project.

Description	Y	N	NA	NR
1. Where an elevator does not meet medical emergency service code data, per the California Building Code (CBC), use of alternate fire escape and patient transport is required.				
2. Access route, fire lane markings, pavers and gate entrances are in accordance with Title 19, California Code of Regulations and the California Fire Code, Chapter 6.				
3. Fire hydrant location and distribution complies with the California Fire Code (see # 4).				
4. Fire hydrant location and distribution complies with NFPA 1142, "Alternate Means." If "NR" is checked, DSA can only approve on-site water storage as an alternative. The signature of the school district official is required to acknowledge the use of alternate means.				
5. Signature of School District Official: _____ Date: _____				
6. The location(s) of the proposed post indicator valve and the department connection meet the requirements of this jurisdiction.				
7. The location(s) of the detector check valve assembly meet the requirements of this jurisdiction.				
8. Is the project located in a hazard severity zone area? (CBC, Chapter 7A, Section 7014.1) <input type="checkbox"/> Yes <input checked="" type="checkbox"/> No				
9. Check type of fire: <input type="checkbox"/> Moderate <input type="checkbox"/> High (if one of these boxes is checked, the project design must meet the requirements of Chapter 7A.)				

COMMENTS (note deficiencies):

ACCESSIBILITY NOTES

- THE POT IDENTIFIED IN THESE CONSTRUCTION DOCUMENTS IS COMPLIANT WITH THE CURRENT APPLICABLE CALIFORNIA BUILDING CODE ACCESSIBILITY PROVISIONS FOR PATH OF TRAVEL REQUIREMENTS FOR ALTERATIONS, ADDITIONS AND STRUCTURAL REPAIRS AS PART OF THE DESIGN OF THIS PORTIONS OF THE POT THAT WERE DETERMINED TO BE NONCOMPLIANT 1) HAVE BEEN IDENTIFIED AND 2) THE CORRECTIVE WORK NECESSARY TO BRING THEM INTO COMPLIANCE HAS BEEN INCLUDED WITHIN THE SCOPE OF THIS PROJECT'S WORK THROUGH DETAILS, DRAWINGS AND SPECIFICATIONS INCORPORATED INTO THESE CONSTRUCTION DOCUMENTS. ANY NONCOMPLIANT ELEMENTS, COMPONENTS OR PORTIONS OF THE POT THAT WILL NOT BE CORRECTED BY THIS PROJECT BASED ON VALUATION THRESHOLD LIMITATIONS OR A FINDING OF UNREASONABLE HARDSHIP ARE SO INDICATED IN THESE CONSTRUCTION DOCUMENTS.
- DURING CONSTRUCTION, IF POT ITEMS WITHIN THE SCOPE OF THE PROJECT REPRESENTED AS CODE COMPLIANT ARE FOUND TO BE NONCOMFORMING BEYOND REASONABLE CONSTRUCTION TOLERANCES, THEY SHALL BE BROUGHT INTO COMPLIANCE WITH THE CBC AS PART OF THIS PROJECT BY MEANS OF A CONSTRUCTION CHANGE DOCUMENT.

LEGEND

- [Solid Line] INDICATES EXISTING BUILDING TO REMAIN (NO WORK)
- [Hatched Area] INDICATES NEW PORTABLE BUILDING UNDER THIS APPLICATION
- [Dashed Line] INDICATES PROPOSED FIRE TRUCK ACCESS OVER A.C. PAVING
- [Dotted Line] HALF-TONE DASHED LINE INDICATES EXISTING ACCESSIBLE PATH OF TRAVEL
- [Dotted Line] INDICATES PROPOSED ACCESSIBLE PATH OF TRAVEL, THIS APPLICATION

Ownership of Documents
 This document, the ideas and designs incorporated herein, as an instrument of Professional Service is the property of Integrated Designs by SOMAM, Inc. and is not to be used, in whole or in part for any other project without written authorization.
 © COPYRIGHT 2015

integrated designs by SOMAM, Inc.
 ARCHITECTURE · INTERIOR DESIGN · CONSTRUCTION MANAGEMENT
 8011 N. Fresno, Suite 130 - Fresno, California 93710
 Phone (559) 439-0881 For (559) 439-0887 E-Mail: design@somam.com
 www.integrateddesigns.com

SITE PLAN

4 RELOCATABLE CLASSROOMS
MOUNT VERNON ELEMENTARY SCHOOL
 BAKERSFIELD CITY SCHOOL DISTRICT
 2181 POTOMAC AVE, BAKERSFIELD, CA 93307

Issue Date: 10/31/14
 Date: 07/25/16
 Designer: [Signature]
 Checker: [Signature]
 PLOT: C.H.

Agency Approval Stamp:
 FILE # 15-6
 IDENTIFICATION STAMP
 DIV. OF THE STATE ARCHITECT
 OFFICE OF REGULATION SERVICES
 03-117168
 DATE: 10/15/16
 TRACKING #:



Stamp(s):

Job No.: **5125**

Sheet No.: **A1.01**

Release: -

G:\2014\14-5125\Sheets\5125-A101.dwg RICHARD DELLANINI

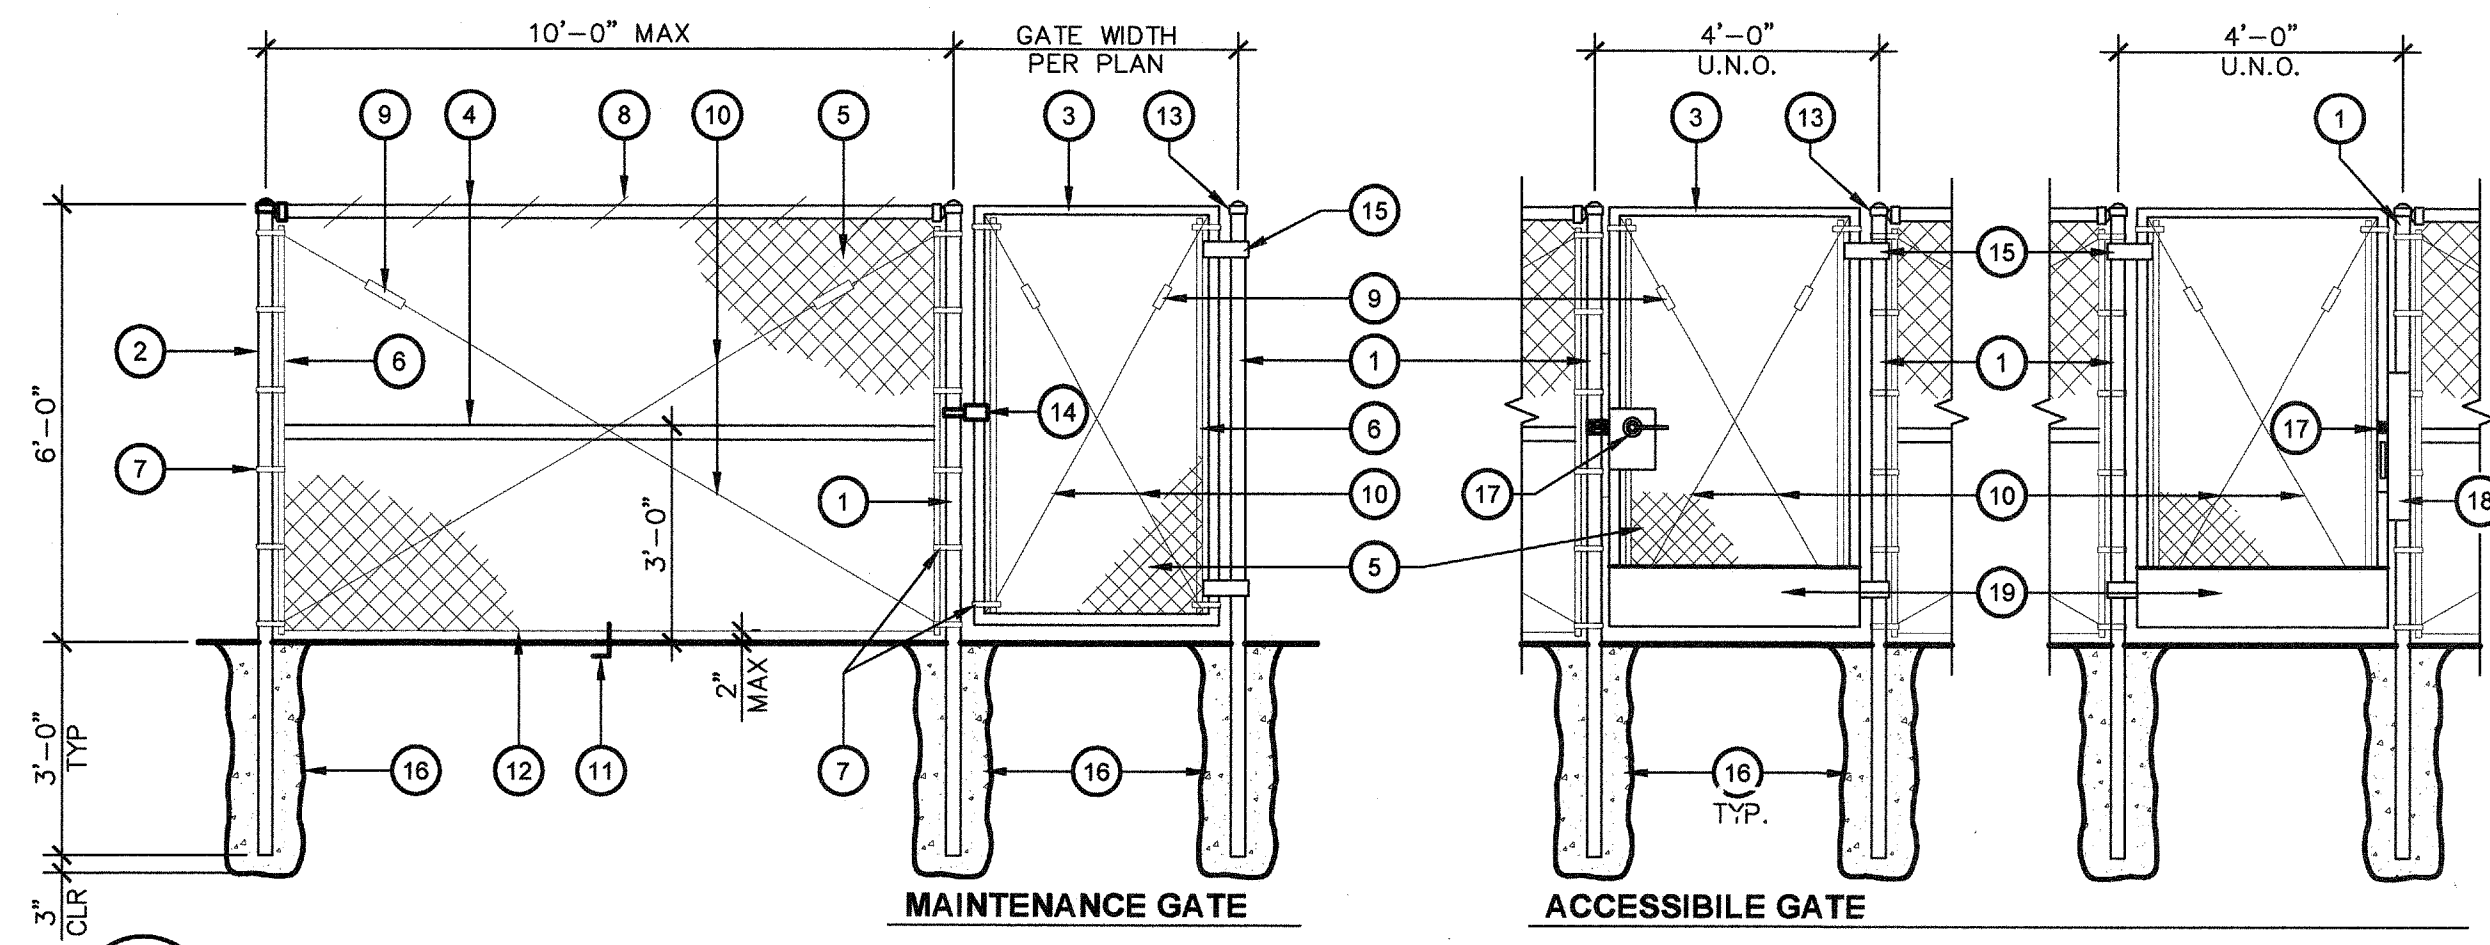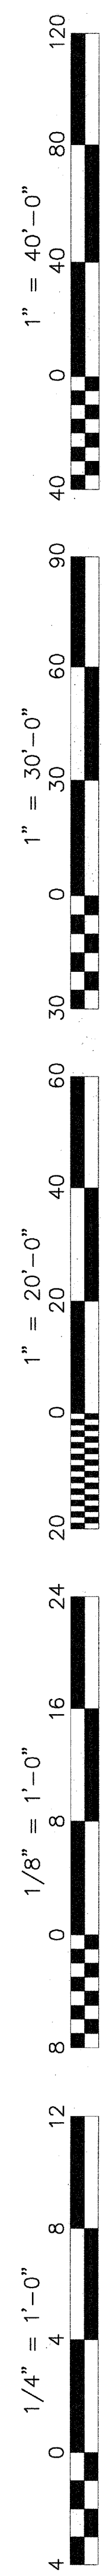

TYPICAL FENCE & GATE KEYNOTES

- 1 4" O.D. GALVANIZED STEEL GATE POST (9.1 lb/ft)
- 2 2 7/8" O.D. GALVANIZED STEEL END OR CORNER POST (5.79 lb/ft)
- 3 2" O.D. GALVANIZED STEEL GATE FRAME (2.72 lb/ft)
- 4 1 5/8" O.D. GALVANIZED STEEL HORIZONTAL RAIL (2.27 lb/ft)
- 5 2"x2" MESH x 9 GAUGE GALVANIZED FENCE FABRIC WITH KNUCKLED TOP AND BOTTOM SELVAGE. FENCE FABRIC TO BE GALVANIZED BEFORE WEAVING (GBW)
- 6 1/4"x3/4" GALVANIZED STEEL STRETCHER BAR
- 7 GALVANIZED STEEL STRETCHER BAR TENSION BAND, MIN. OF 6 TENSION BANDS
- 8 9 GAUGE (0.148" DIA.) GALVANIZED STEEL TIE WIRES OR HOG RINGS AT 15" MAX. SPACING. MIN. 8 TIE WIRES PER EACH 10" HORIZONTAL RAIL
- 9 GALVANIZED ADJUSTABLE TURNBUCKLE FOR 3/8" DIA. TRUSS ROD
- 10 3/8" DIA. GALVANIZED STEEL ADJUSTABLE TRUSS ROD. TRUSS RODS REQUIRED FOR ALL GATE POST PANELS AND END OR CORNER POST PANELS
- 11 3/8"x8" GALVANIZED HOOK BOLT WITH NUT IMBEDDED IN MIDWAY BETWEEN POSTS
- 12 7 GAUGE (0.177" DIA.) GALVANIZED STEEL TENSION WIRE
- 13 RAINPROOF CAP
- 14 LOCKING HASP
- 15 180° GATE HINGE, TYP
- 16 12" CONCRETE POST FOOTING (TYP.)
- 17 TRIM, LEVER HANDLE & RIM CYLINDER LOCK PER DETAIL STANDARD 34" - 44"
- 18 16ga GATE GUARD
- 19 10" HIGH x GATE WIDTH, 16 ga POWDER-COATED METAL KICK PLATE, TYP BOTH SIDES OF GATE.


GENERAL NOTES

- A. DETERIORATION OR EXISTING NON-COMPLIANT CONSTRUCTION:**
- IF ANY CONDITION IS DISCOVERED WHICH, IF LEFT UNCORRECTED, WOULD MAKE THE BUILDING NON-COMPLIANT WITH THE REQUIREMENTS OF THE EDITION OF THE CBC IN FORCE AT THE TIME OF ORIGINAL CONSTRUCTION, THE CONDITION MUST BE CORRECTED IN ACCORDANCE WITH CURRENT CODE REQUIREMENTS. A.C.D. OR A SEPARATE SET OF PLANS AND SPECIFICATIONS DETAILING AND SPECIFYING THE REQUIRED REPAIR WORK SHALL BE SUBMITTED TO AND APPROVED BY DSA BEFORE PROCEEDING WITH THE REPAIR WORK.
- *PER DSA IR 16-1, SEC. 5.4
- B. CONTRACTOR SHALL ADJUST ALL DOOR CLOSERS TO A MAXIMUM OPENING FORCE OF 5 LBF**


KEY NOTES

1. EXISTING CHAIN LINK FENCE AND GATE TO REMAIN
2. EXISTING ACCESSIBLE PATH OF TRAVEL, VERIFY IN FIELD FOR COMPLIANCE
3. NEW TACTILE EXIT SIGN PER DETAIL 2/A1.03
4. NEW ROOM IDENTIFICATION AND ISA SIGNAGE, REFER TO DETAILS 3, 4/A1.03
5. EXISTING 20' WIDE FIRE TRUCK ACCESS LANE OVER EXISTING AC PAVING, APPROVED BY THE LOCAL JURISDICTION.
6. NEW TEMPORARY PORTABLE BUILDINGS ON RAISED WOOD FOUNDATIONS WITH METAL RAMP SUPPLIED BY MANUFACTURER. OWNER TO REMOVE ALL INTERFERING PLAY EQUIPMENT
7. EXISTING LANDSCAPE AREA TO REMAIN. NO WORK
8. EXISTING PLAYBOX TO REMAIN. NO WORK
9. METAL RAMP PER 2/R1.01
10. EXISTING UTILITY BOX TO REMAIN. NO WORK
11. EXISTING BUILDING TO REMAIN. NO WORK
12. EXISTING CONCRETE WALKWAY TO REMAIN. NO WORK
13. EXISTING PLAYCOURT TO REMAIN. NO WORK
14. EXISTING A.C. PAVING TO REMAIN. NO WORK
15. PROPOSED ACCESSIBLE PATH OF TRAVEL PER THIS APPLICATION. SEE ACCESSIBILITY NOTES, SHEET A1.01
16. INSTALL NEW SECTION OF CHAIN LINK FENCE. MATCH AND TIE-IN TO EXISTING
17. NEW PAIR OF 4'-0" CHAIN LINK GATES
18. NEW 6"th. CONCRETE CURB AT EDGE OF NEW PLAYBOX BOUNDARY
19. NEW CAST-IN-PLACE CONCRETE HARDSURF. FLUSH EDGE WITH EXISTING ADJACENT WALKWAY. 2% MAX. CROSS SLOPE
20. NEW CAST-IN-PLACE ACCESSIBLE CONCRETE WALKWAY. 2% MAX. CROSS SLOPE.
21. NEW CAST-IN-PLACE CONCRETE RAMP. 5% MAX SLOPE. 2% MAX. CROSS SLOPE. SEE 16/A1.03.
22. NEW A.C. PAVED TRANSITION. SLOPE AWAY FROM BUILDING AT 2% MAX. TO MEET EXISTING GRADE
23. EXISTING UTILITY BOX TO REMAIN. ADJUST HEIGHT TO BE FLUSH WITH NEW CONCRETE HARDSURF
24. PORTION OF EXISTING CHAIN LINK FENCE AND POSTS TO BE REMOVED
25. PORTION OF EXISTING A.C. PAVING TO BE REMOVED. REGRADE AND PREPARE FOR INSTALLATION OF NEW CONCRETE SURFACE
26. PORTION OF EXISTING CONCRETE CURB AT EDGE OF PLAYBOX AND PLAY FILL TO BE REMOVED. REGRADE AREA AND PATCH BACK WITH NEW A.C. PAVING. FLUSH EDGE OF NEW PAVING WITH EXISTING


1 TYPICAL CHAIN LINK FENCE AND GATES
A1.02 ADY100-01

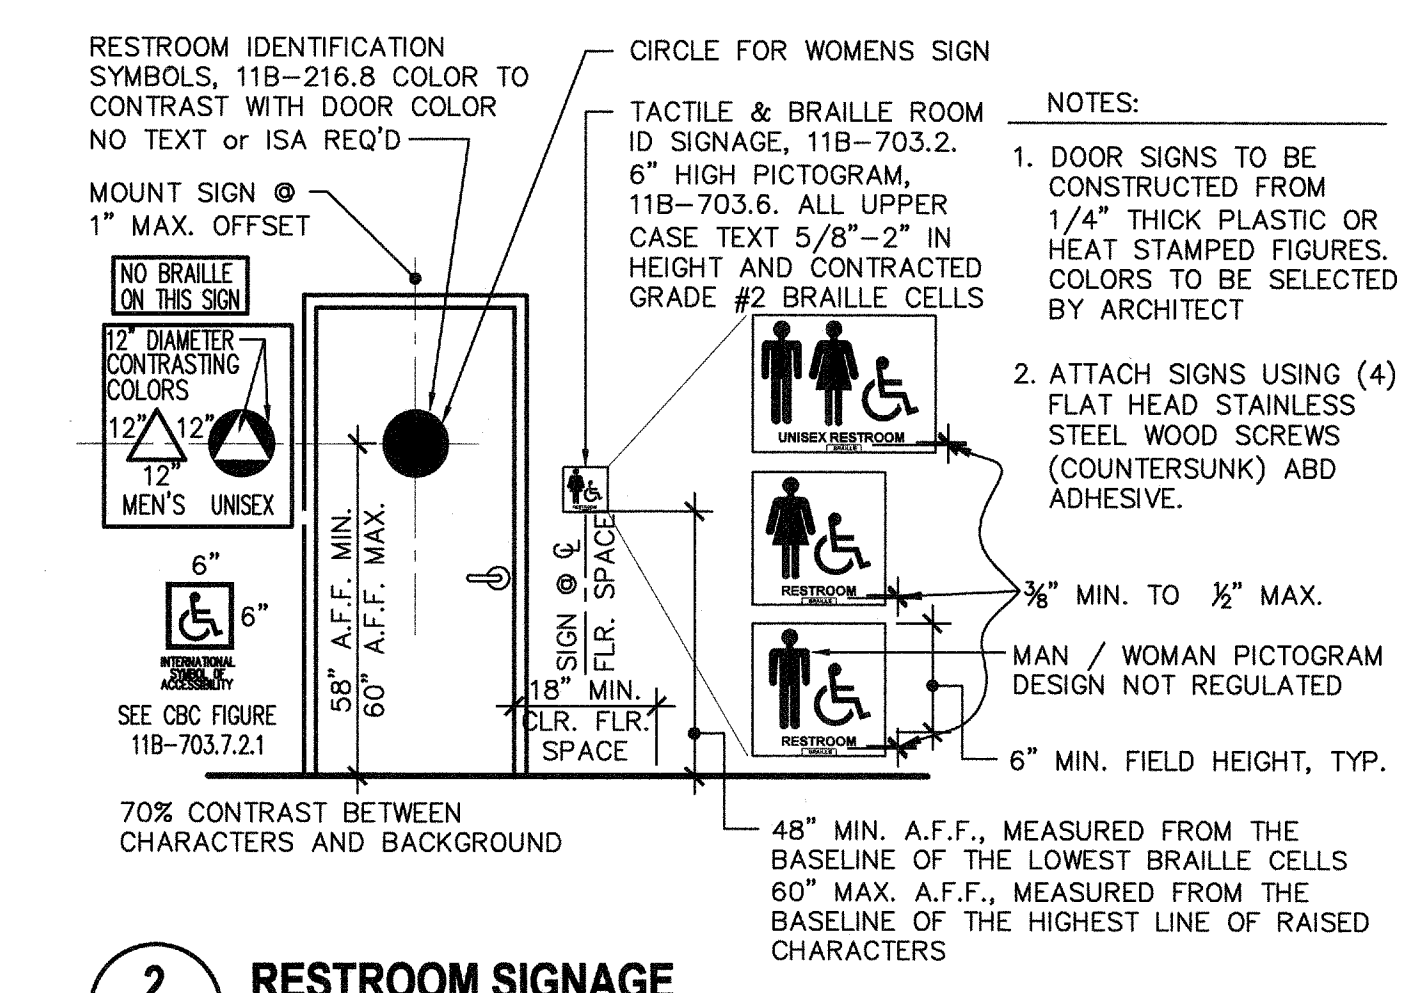

2 RESTROOM SIGNAGE
A1.02 ADA000-01

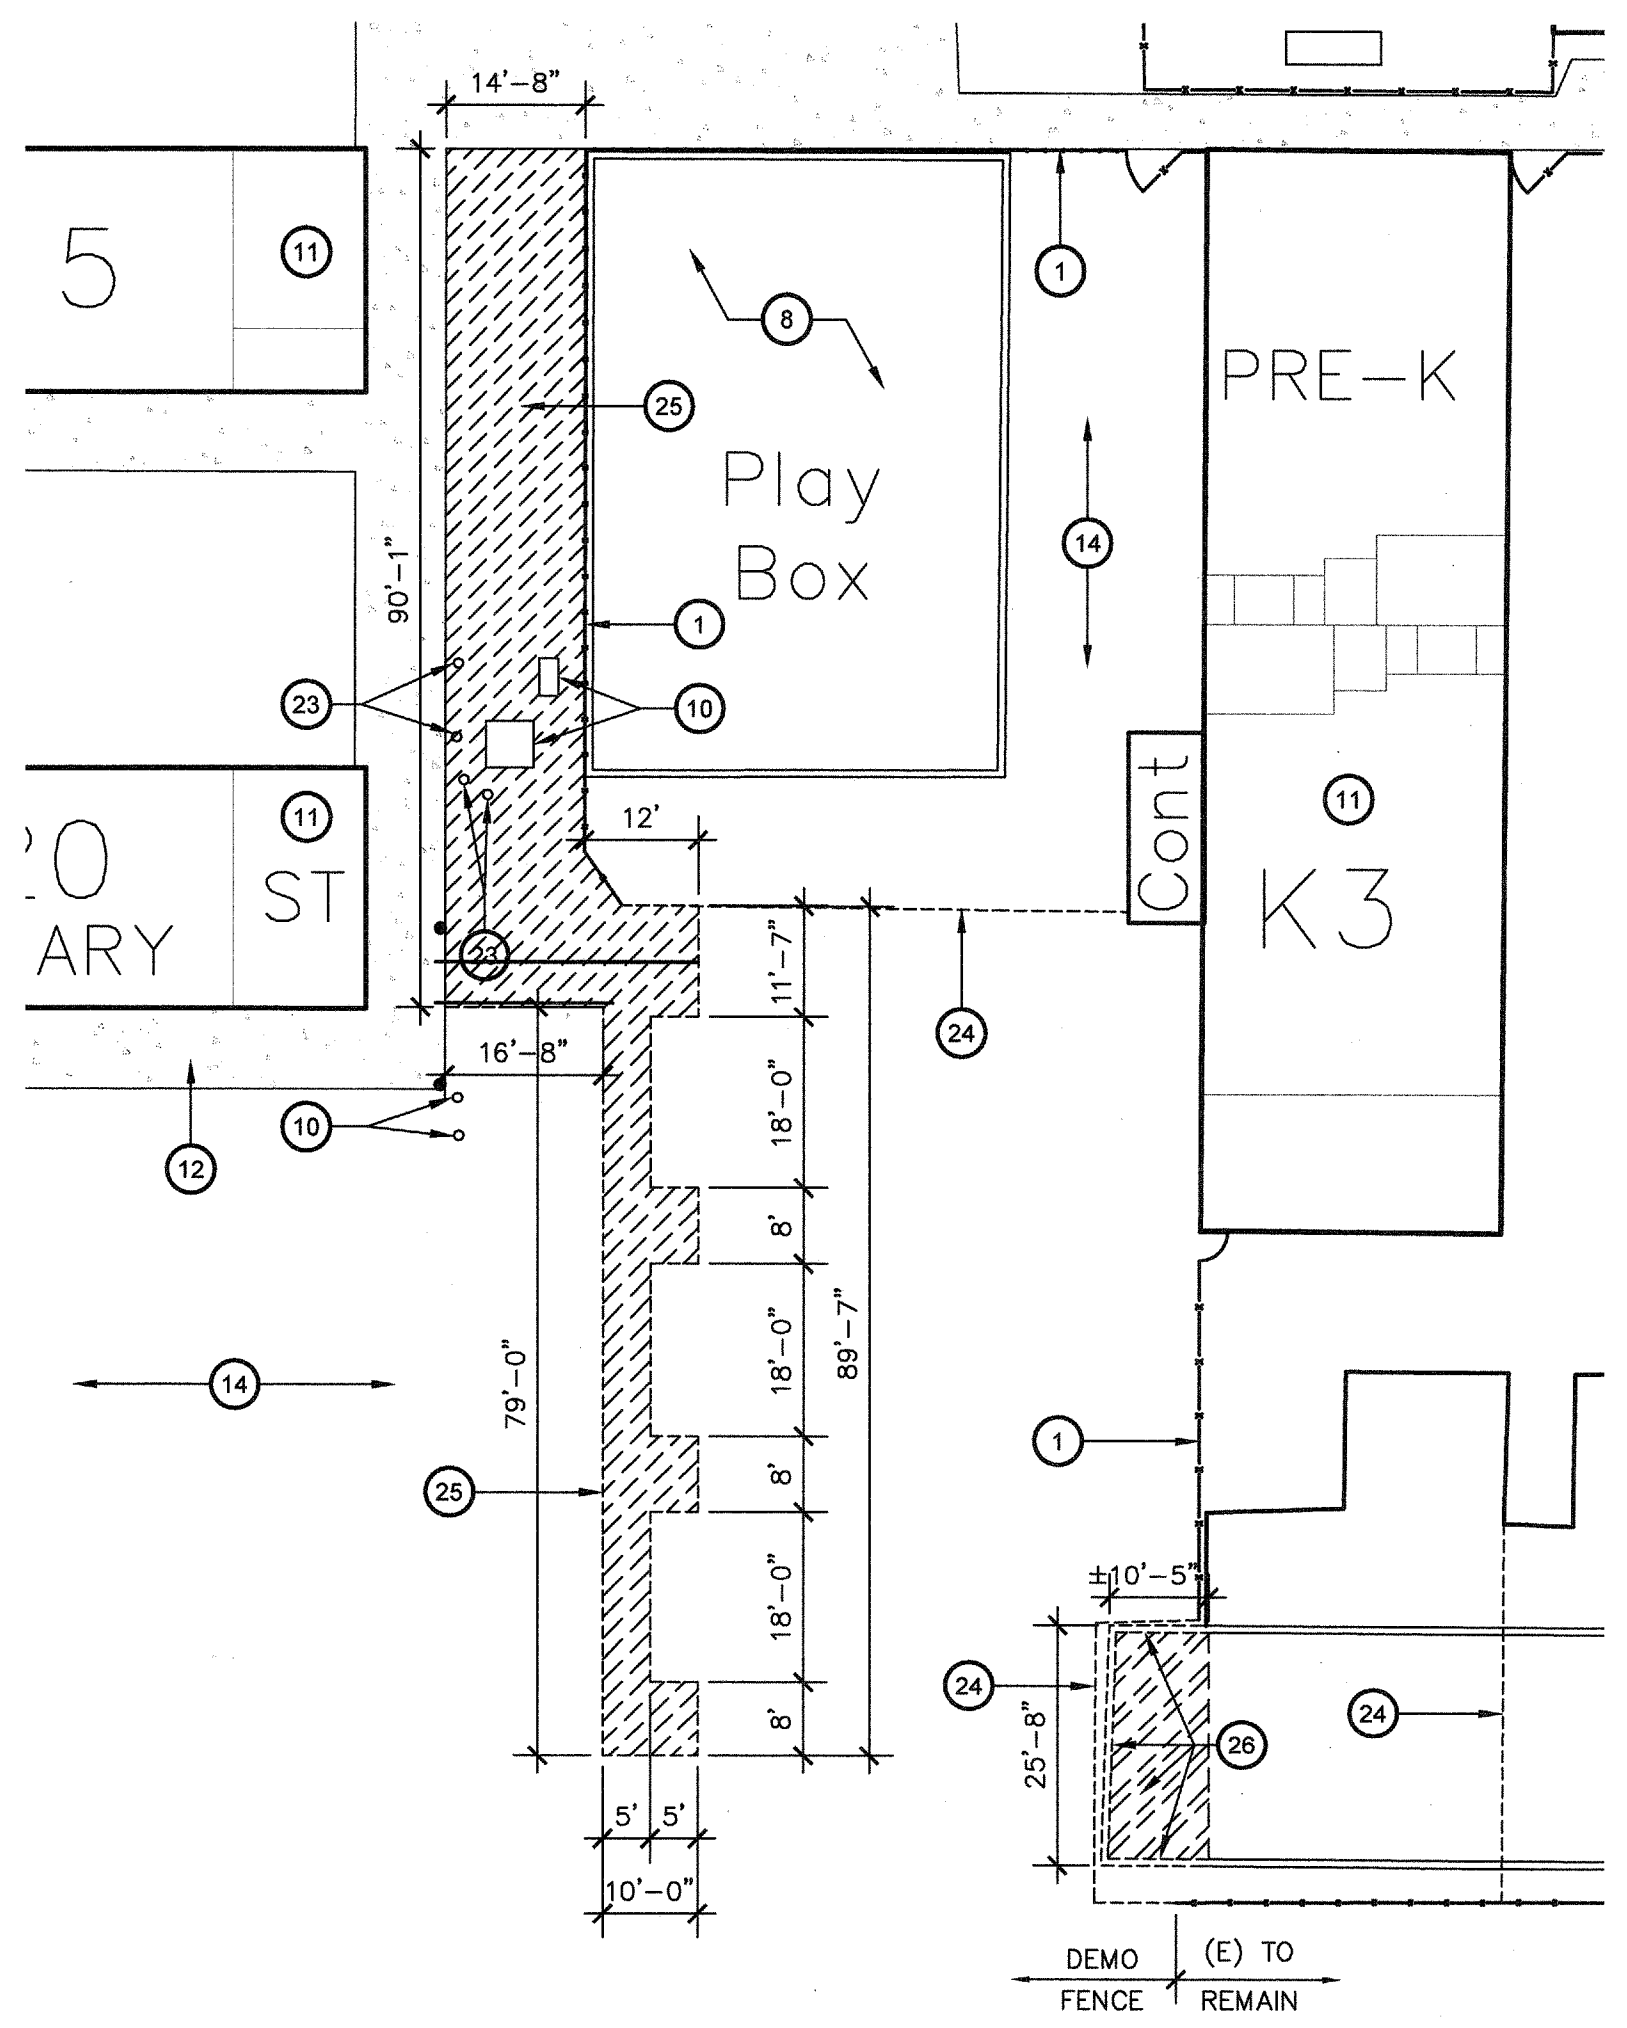

3 SITE DEMOLITION PLAN
1" = 20'

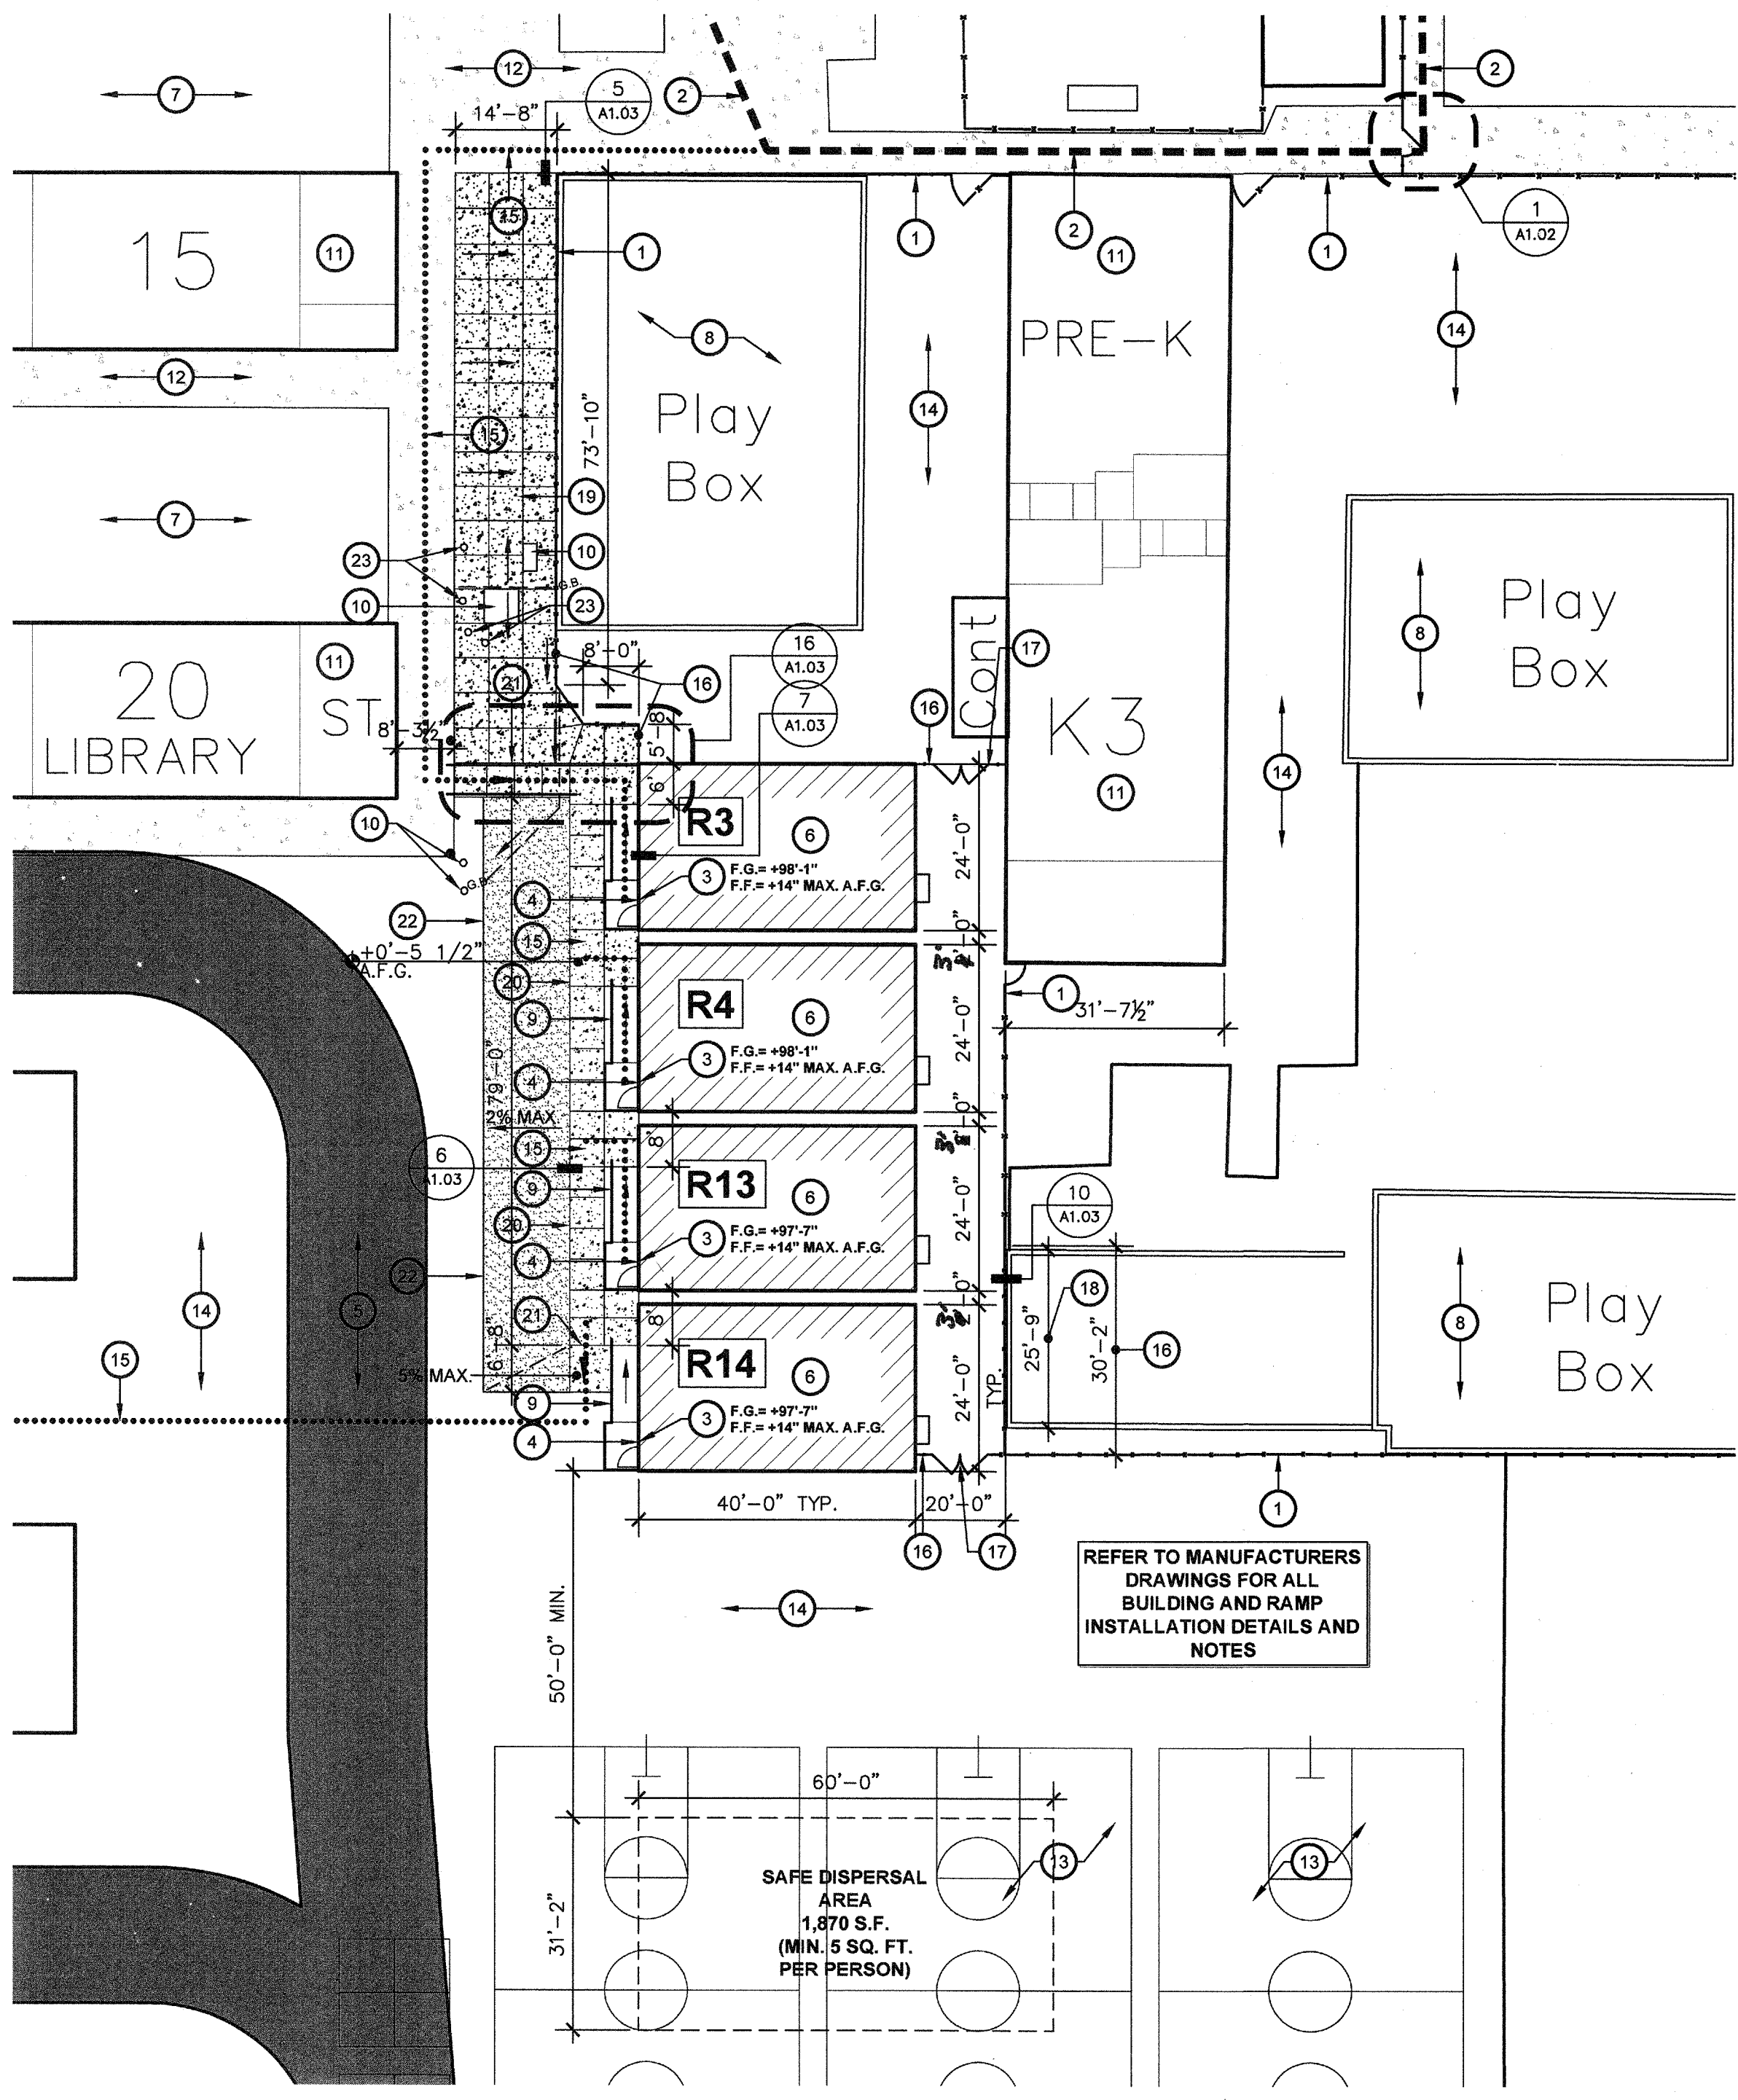

ENLARGED SITE PLAN
MOUNT VERNON ELEMENTARY SCHOOL

SCALE: 1" = 20'

SERIAL NUMBER SCHEDULE

CLSRM	STKP #	SERIAL #
R3	04-100929	38072/73
R4	66341	30256/57
R13	04-101984	44999/45000
R14	04-101984	45023/24

SAFE DISPERSAL

TEMP CLASSROOMS
4 (N) CLASSROOMS @ 960 S.F. (24'x40') EA. = 3,840 S.F.
TOTAL = 3,840 S.F.

3,840 S.F. / 20 S.F. PER OCCUPANT = 192 OCCUPANTS
192 OCCUPANTS x 5 S.F. / OCCUPANT = 960 S.F. REQ'D
1,870 S.F. PROVIDED = OK

LEGEND

- [Symbol] INDICATES EXISTING BUILDING TO REMAIN (NO WORK)
- [Symbol] INDICATES NEW PORTABLE BUILDING UNDER THIS APPLICATION
- [Symbol] INDICATES PROPOSED FIRE TRUCK ACCESS OVER A.C. PAVING
- [Symbol] INDICATES NEW CAST-IN-PLACE CONCRETE SURFACE. SEE CIVIL
- [Symbol] INDICATES BOUNDARY OF NEW A.C. PAVED SURFACE. SEE CIVIL
- [Symbol] INDICATES BOUNDARY OF EXISTING A.C. PAVED SURFACE TO BE DEMOLISHED
- [Symbol] HALF-TONE DASHED LINE INDICATES EXISTING ACCESSIBLE PATH OF TRAVEL
- [Symbol] DOTTED LINE INDICATES PROPOSED ACCESSIBLE PATH OF TRAVEL, THIS APPLICATION

Ownership of Documents
This document, the ideas and designs incorporated herein, as an instrument of Professional Service is the property of Integrated Design by SOMAM Inc. and is not to be used, in whole or in part for any other project without written authorization.
© COPYRIGHT 2015


integrated designs by SOMAM, Inc.
ARCHITECTURE · ENGINEERING · INTERIOR DESIGN · CONSTRUCTION MANAGEMENT
8011 N. Fresno, Suite 130 - Fresno, California 93710
Phone (509) 438-0881 Fax (509) 438-0887 E-Mail: design@somam.com
www.integrateddesigns.com

ENLARGED SITE PLAN


4 RELOCATABLE CLASSROOMS
MOUNT VERNON ELEMENTARY SCHOOL
BAKERSFIELD CITY SCHOOL DISTRICT
2161 POTOMAC AVE, BAKERSFIELD, CA 93307

Issue Date: 10/31/14
Date: 07/25/16
Designer: [Signature]
Agency Approval Stamp: [Signature]
FILE # 15-6
IDENTIFICATION STAMP
DIV. OF THE STATE ARCHITECT
OFFICE OF REGULATION SERVICES
03-117168
AC ME FLS SPASS TN
DATE AUG 04 2016
TRACKING #:
Stamp(s):
Job No.: **5125**
Sheet No.: **A1.02**
Release: -



G:\2014\14-5125\Sheets\5125-A102.dwg RICHARD DELLANINI

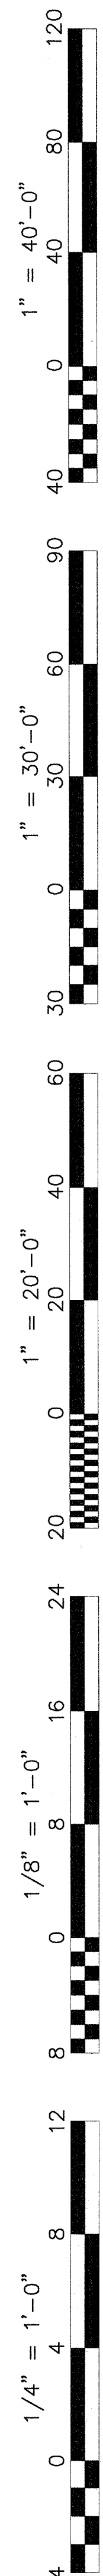


13 HANDRAIL
A1.03 AD50-A SCALE: 1" = 1'-0"

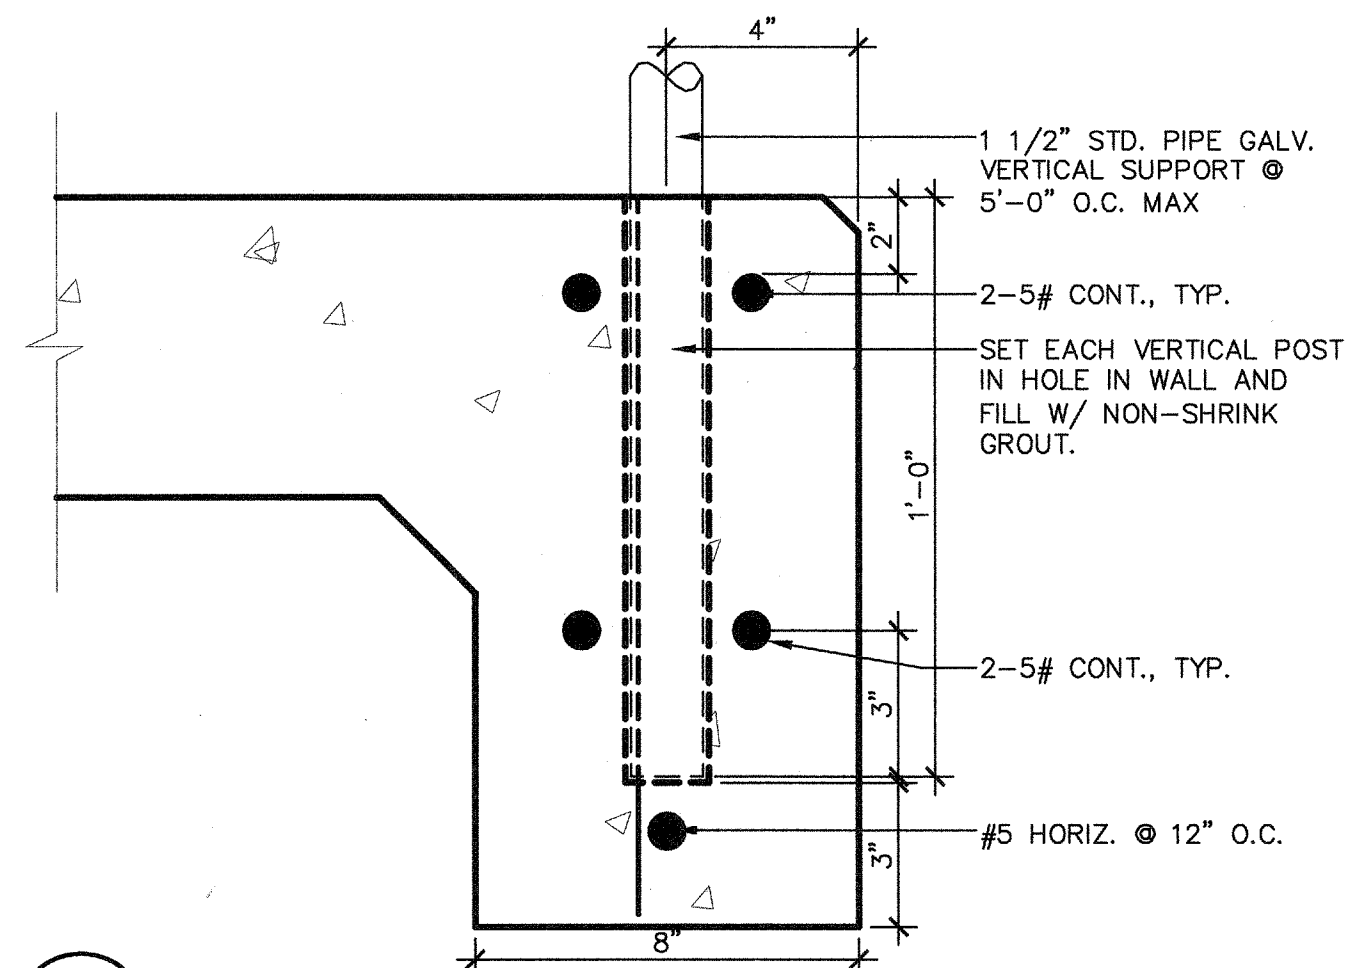


14 HANDRAIL SUPPORT
A1.03 AD48-A SCALE: 3" = 1'-0"

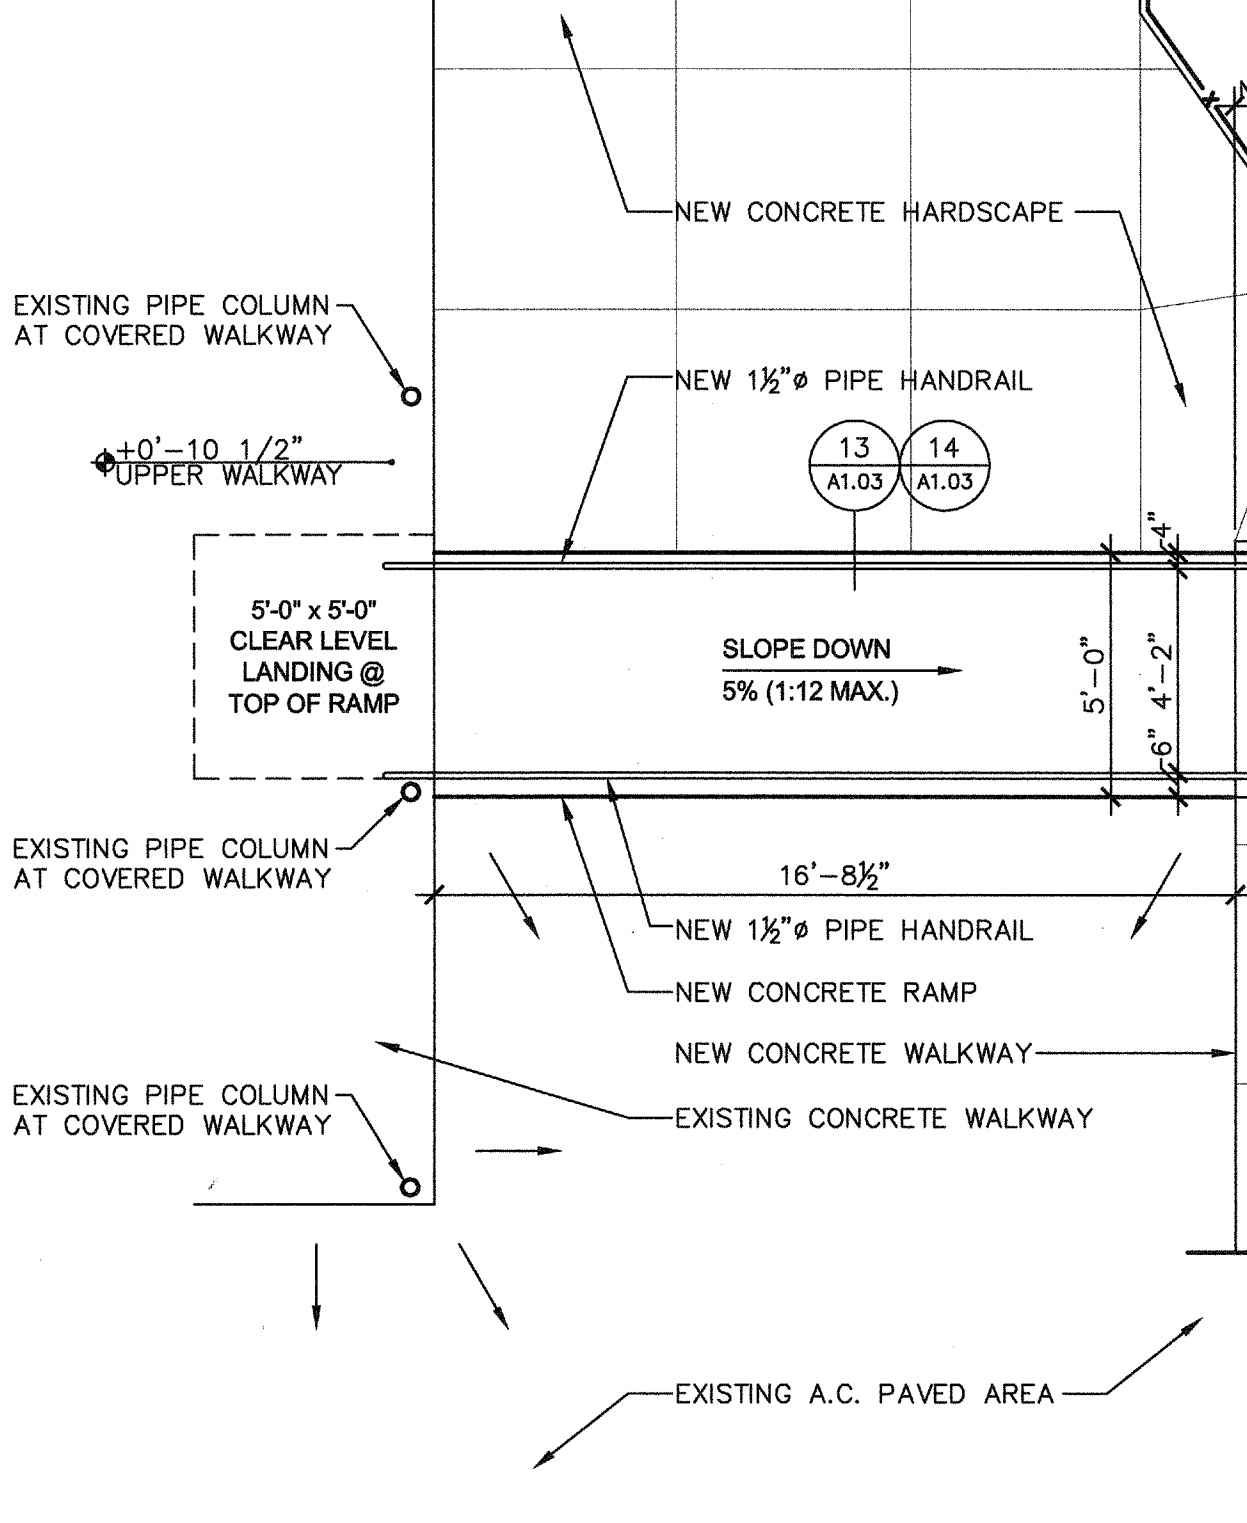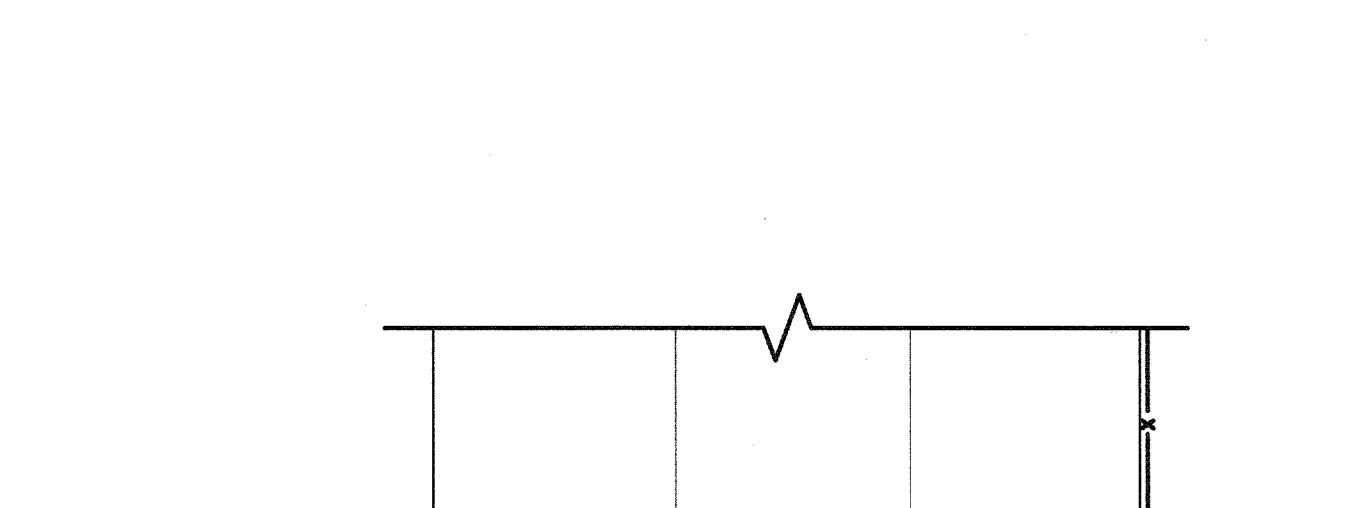


16 RAMP DOWN TO CONC. WALKWAY AT PORTABLES
A1.03 ADS110-03 SCALE: 1/4" = 1'-0"

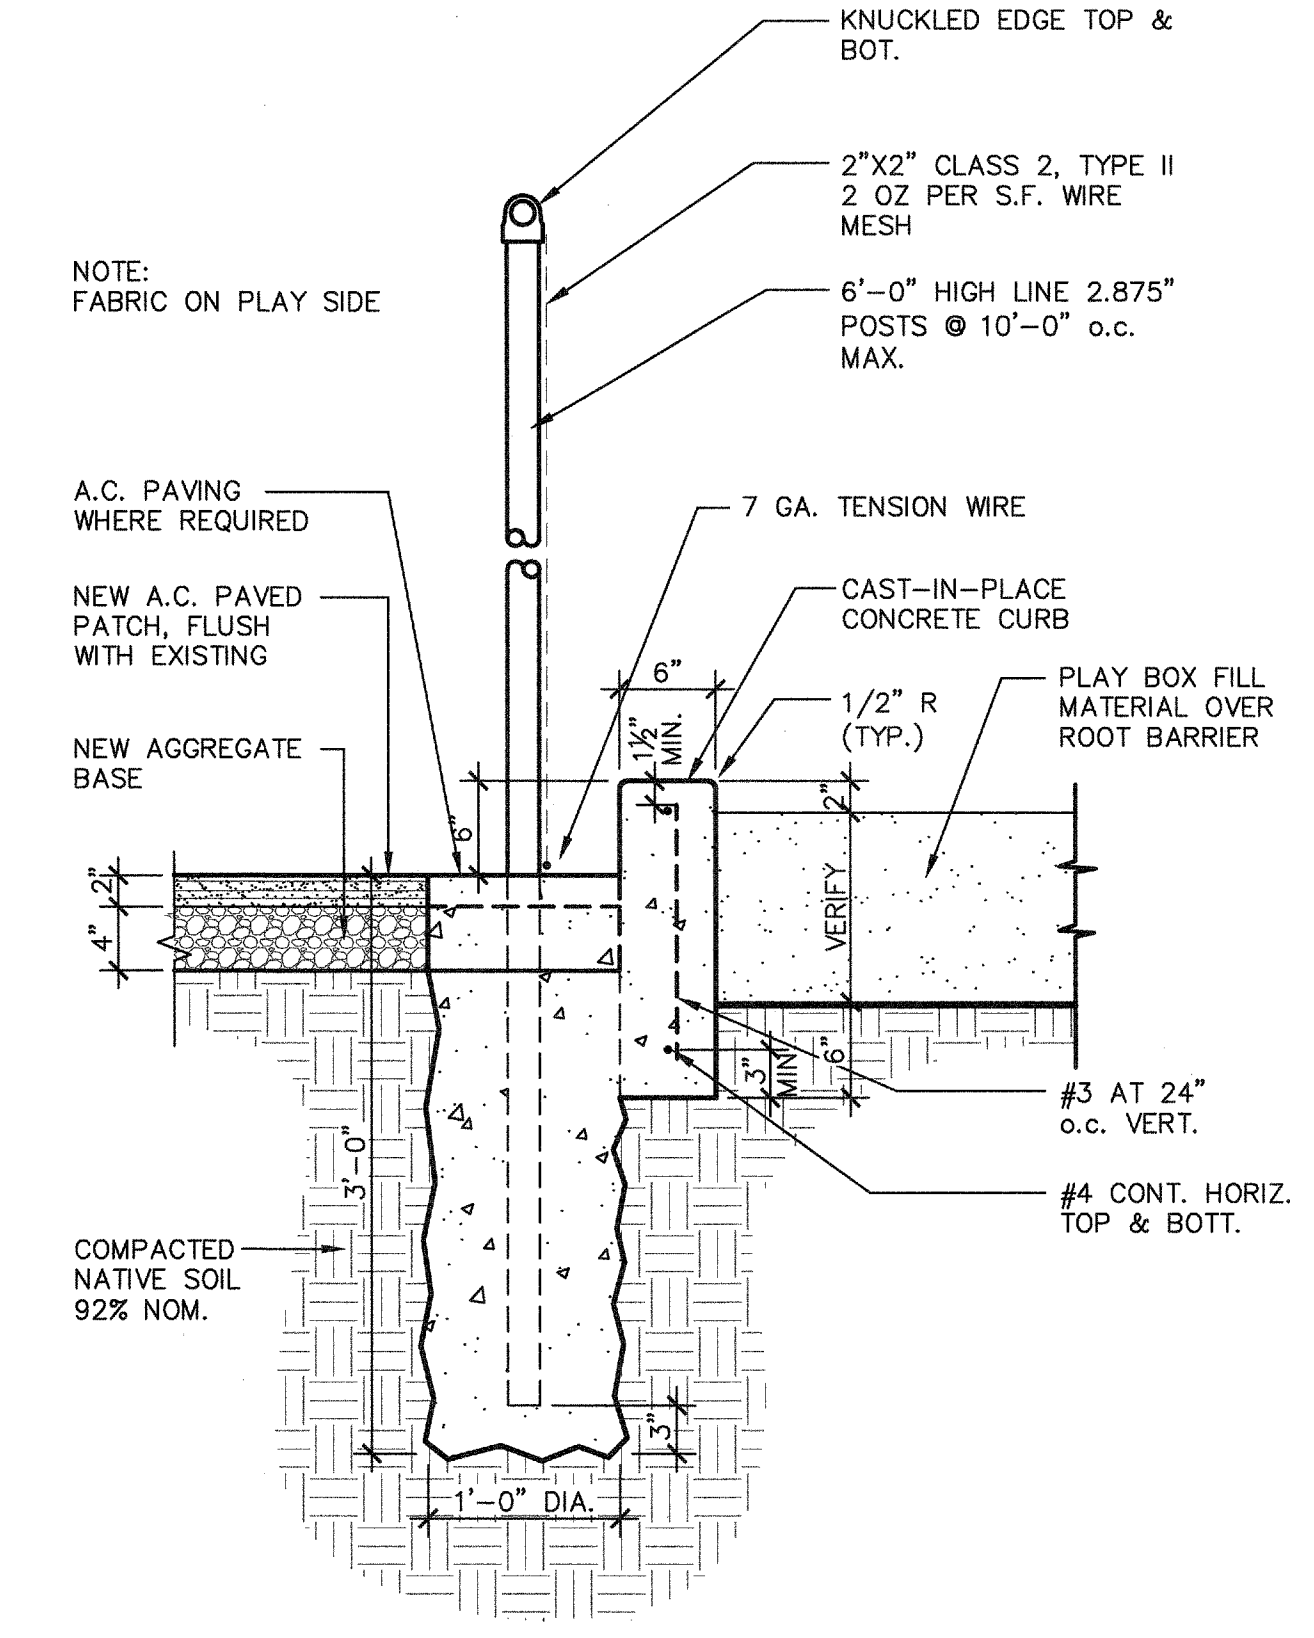


10 CONCRETE CURB AND FENCE AT PLAY BOX
A1.03 ADS110-02 SCALE: 1" = 1'-0"

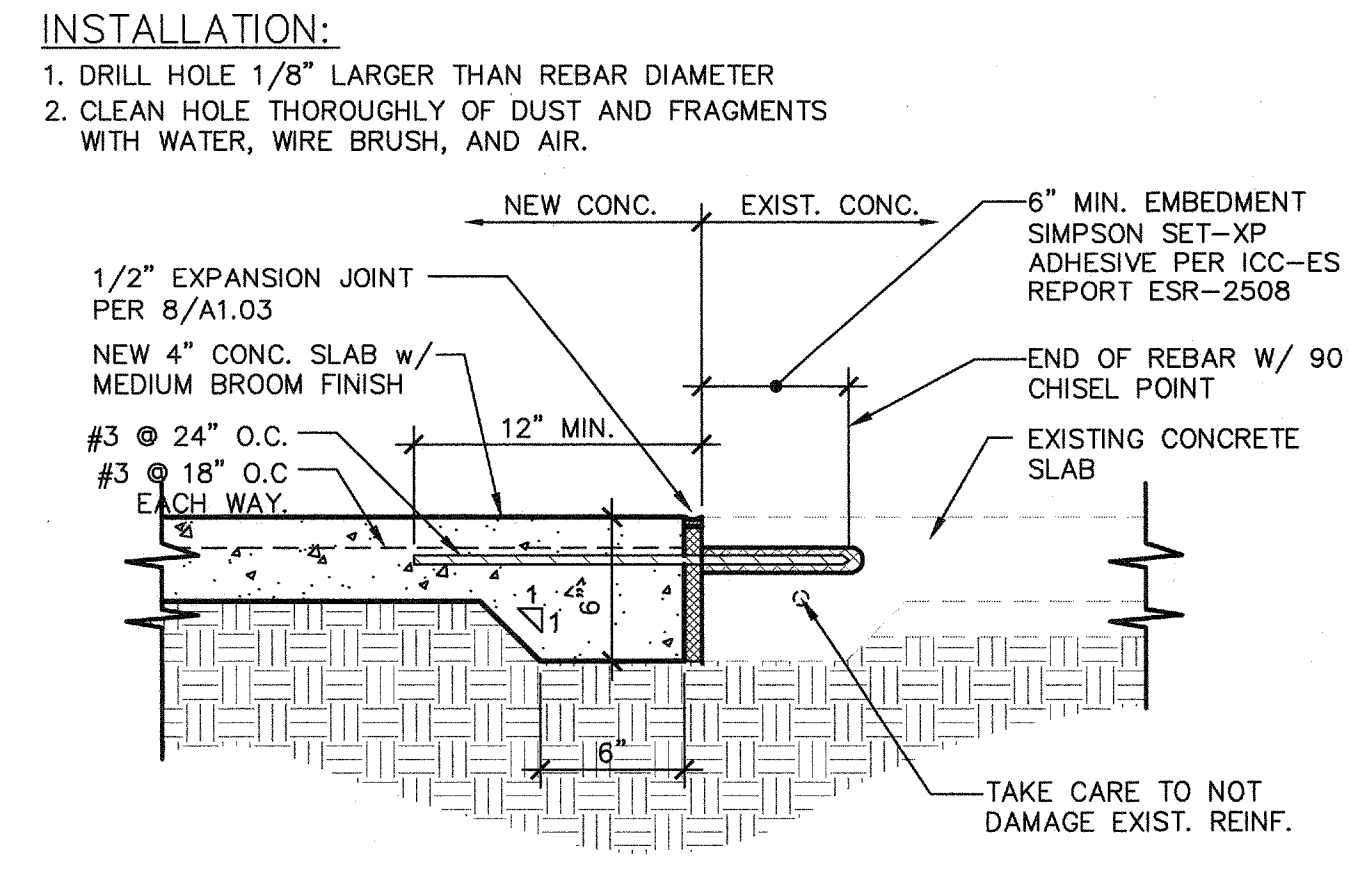


5 (N) CONC. WALK @ (E) CONC. WALK
A1.03 ADS100-05 SCALE: 1 1/2" = 1'-0"

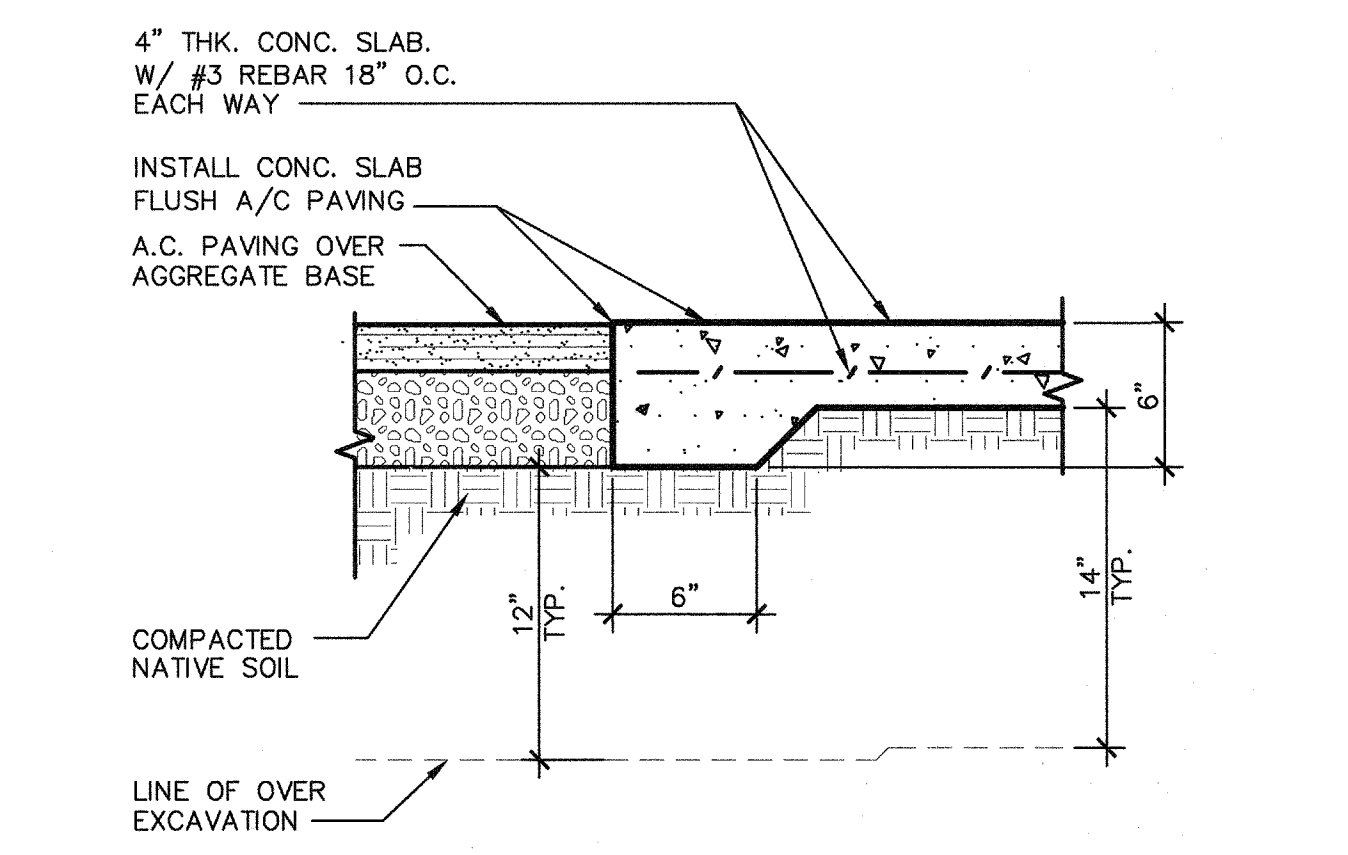

6 CONCRETE SLAB AT PAVING
A1.03 ADS100-03 SCALE: 1 1/2" = 1'-0"

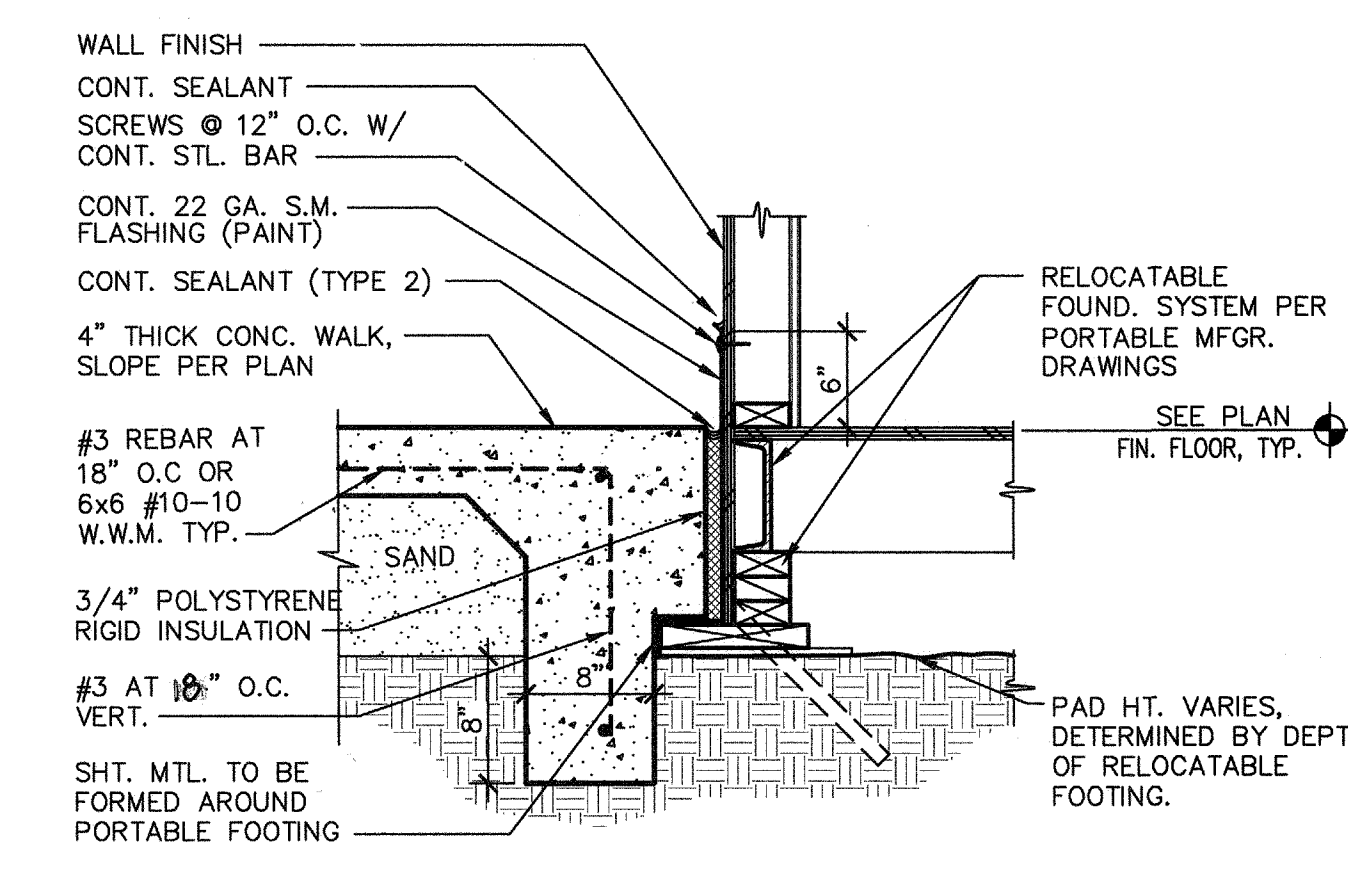


7 TYPICAL FOOTING @ WALK
A1.03 ADP100-02 SCALE: 1" = 1'-0"

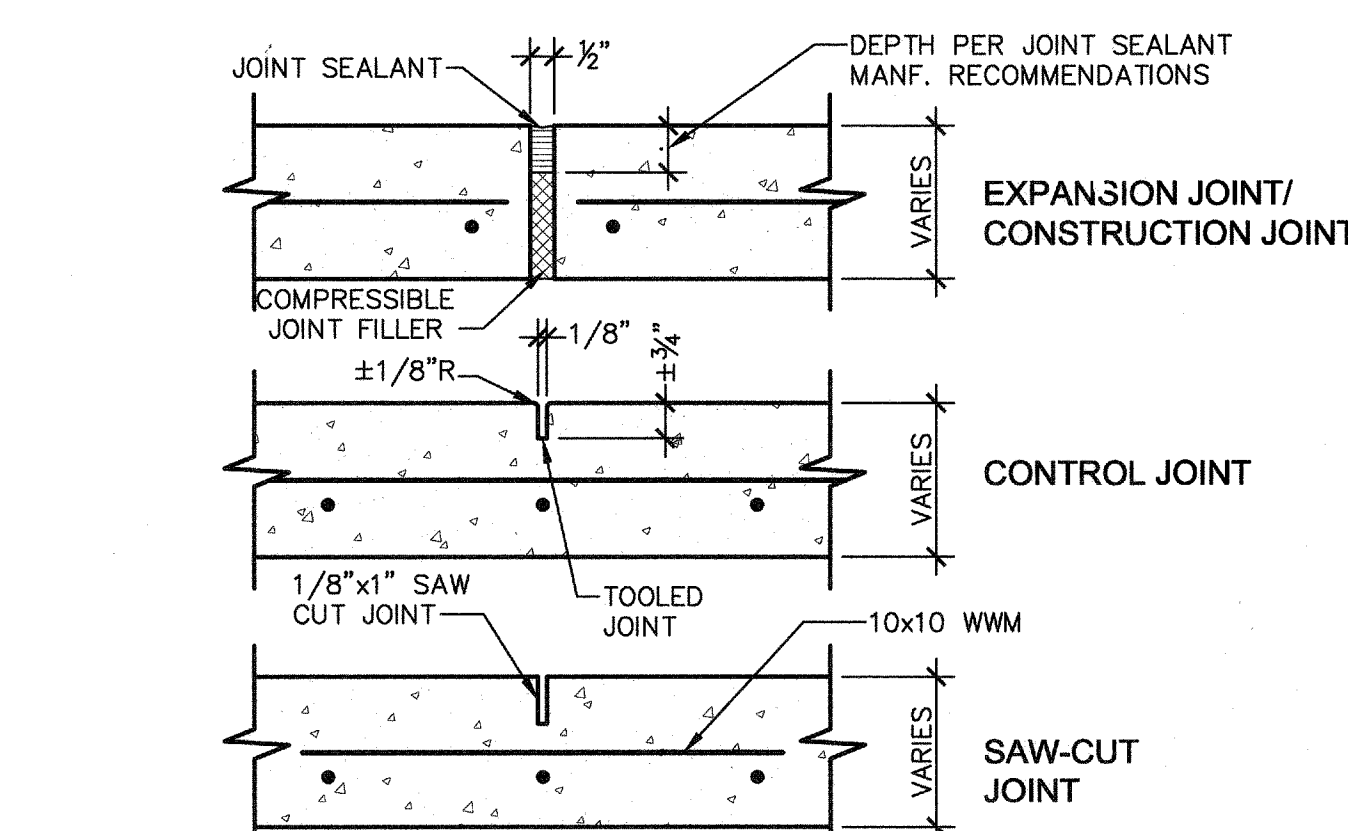


8 CONCRETE JOINTS
A1.03 ADS110-01 SCALE: 3" = 1'-0"


INSTALLATION:
1. DRILL HOLE 1/8" LARGER THAN REBAR DIAMETER
2. CLEAN HOLE THOROUGHLY OF DUST AND FRAGMENTS WITH WATER, WIRE BRUSH, AND AIR.

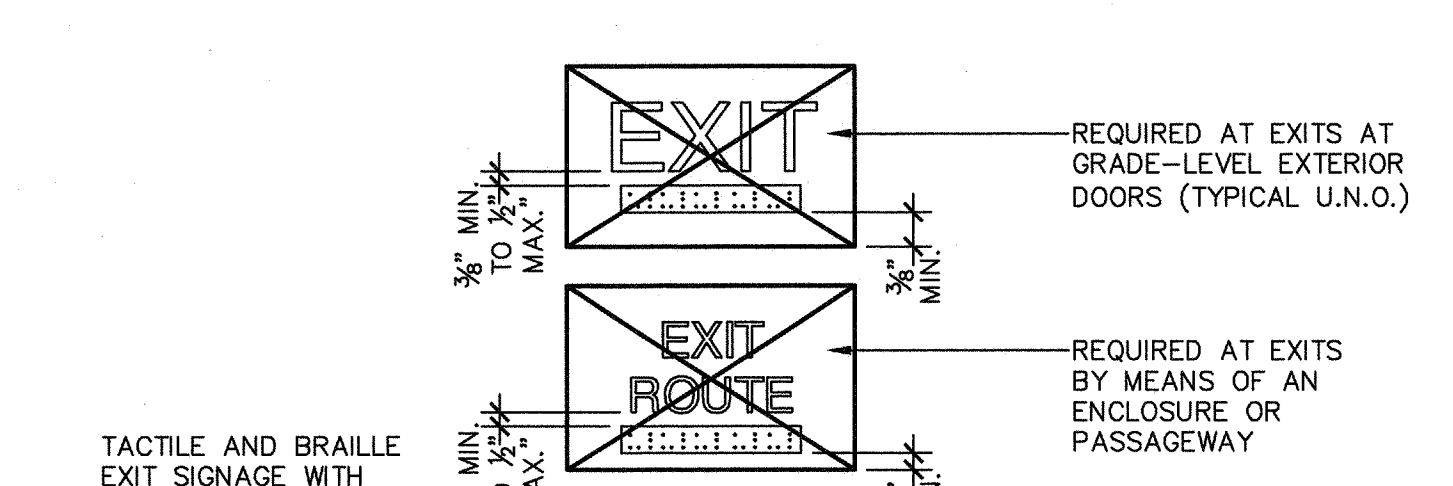


2 TYPICAL EXTERIOR DOOR SIGNAGE
A1.03 ADX200-01 SCALE: 3/8" = 1'-0"

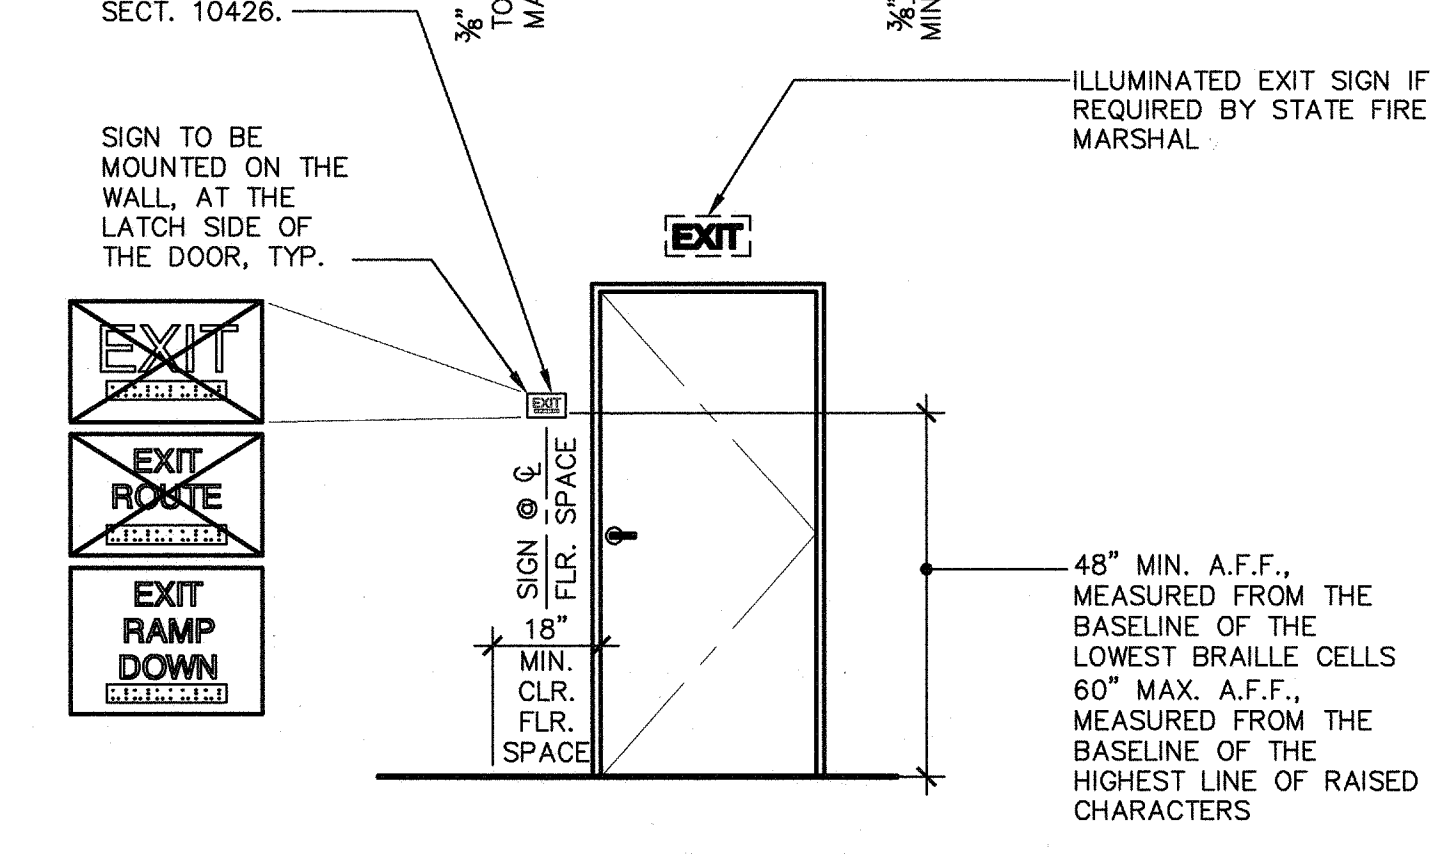

3 ROOM ID SIGNAGE
A1.03 ADX100-01 SCALE: NO SCALE

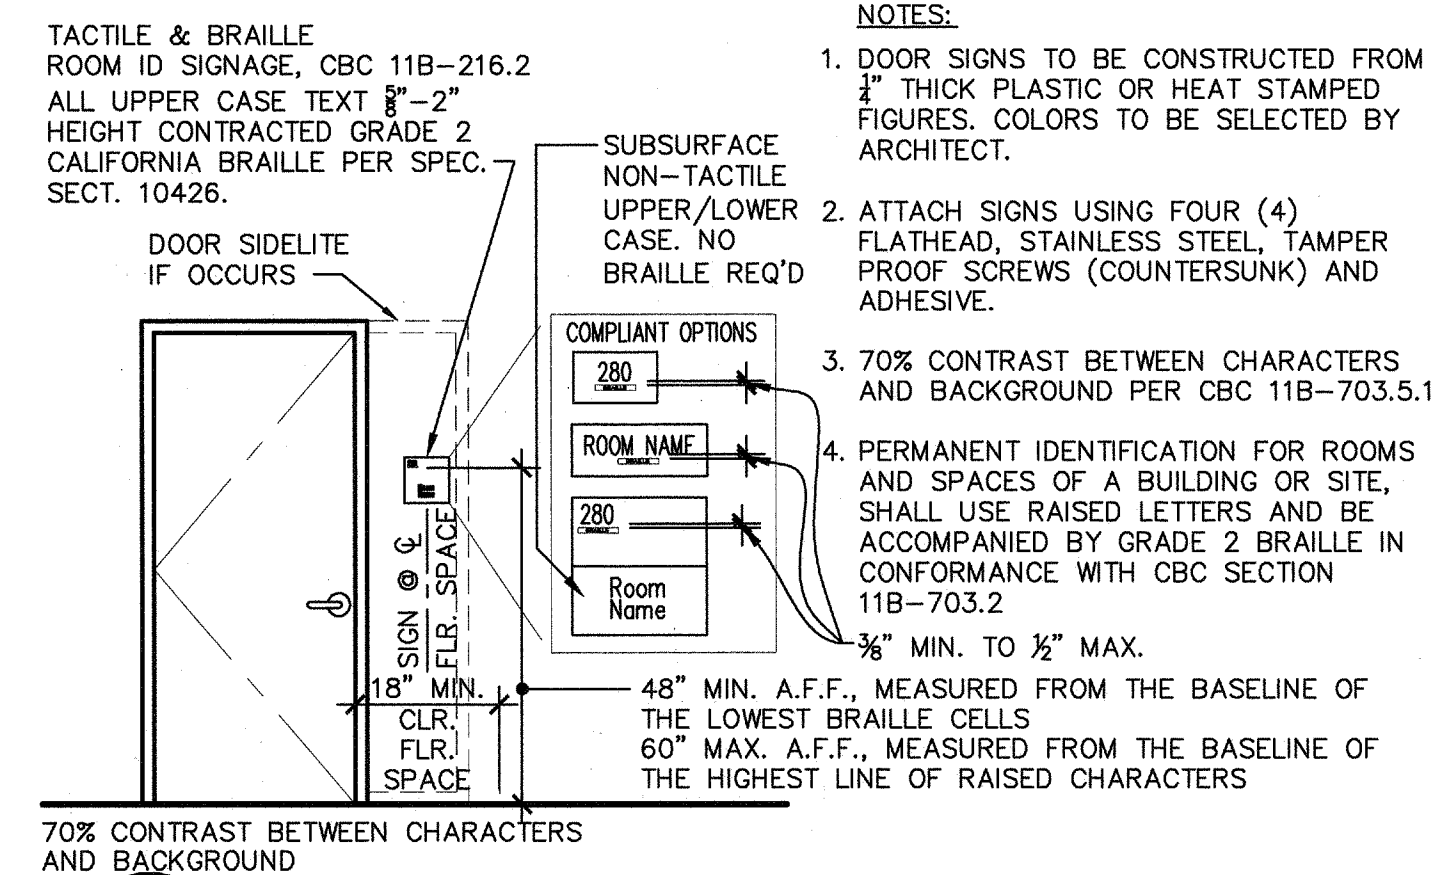

4 BUILDING ENTRANCE/INT'L.S.A. SIGNAGE
A1.03 ADA100-01 SCALE: 1/4" = 1'-0"

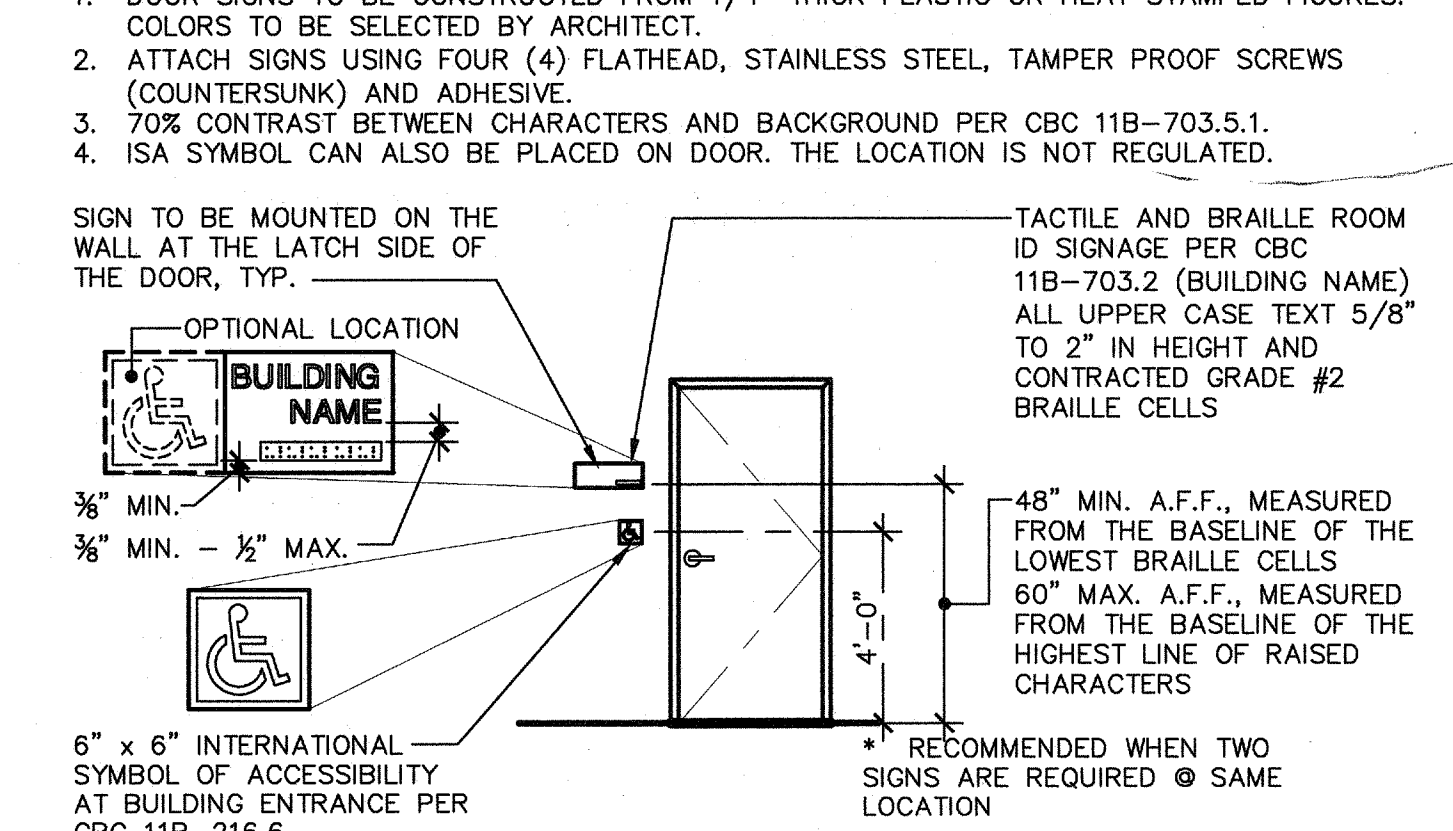

6 CONCRETE SLAB AT PAVING
A1.03 ADS100-03 SCALE: 1 1/2" = 1'-0"

Ownership of Documents
This document, the ideas and designs incorporated herein, as an instrument of Professional Service is the property of Integrated Designs by SOMAM Inc. and is not to be used, in whole or in part for any other project without written authorization.
© COPYRIGHT 2015

integrated designs by SOMAM, Inc.
ARCHITECTURE - INTERIOR DESIGN - CONSTRUCTION MANAGEMENT
6011 N. Fremo, Suite 130 - Fresno, California 93710
Phone (559) 439-0887 Fax (559) 439-0887 E-Mail: design@somam.com
www.integrateddesigns.com

SITE DETAILS

4 RELOCATABLE CLASSROOMS
MOUNT VERNON ELEMENTARY SCHOOL
BAKERSFIELD CITY SCHOOL DISTRICT
2161 POTOMAC AVE., BAKERSFIELD, CA 93307

Project Name & Address: 4 RELOCATABLE CLASSROOMS, MOUNT VERNON ELEMENTARY SCHOOL, BAKERSFIELD CITY SCHOOL DISTRICT, 2161 POTOMAC AVE., BAKERSFIELD, CA 93307

Sheet Title: SITE DETAILS

Issue Date: 10/31/14
Date: 07/26/16
Designer: [Signature]
DR: [Signature]
PC: [Signature]



Agency Approval Stamp:
FILE #15-6
IDENTIFICATION STAMP
DIV. OF THE STATE ARCHITECT
OFFICE OF REGULATION SERVICES
03-117168
AC: [Signature] FL: [Signature] SS: [Signature] TN: [Signature]
DATE: AUG 04 2016
TRACKING #:

Stamp(s):
No. C 28956
STATE OF CALIFORNIA

Job No.: **5125**

Sheet No.: **A1.03**

Release: RICHARD DELLANINI

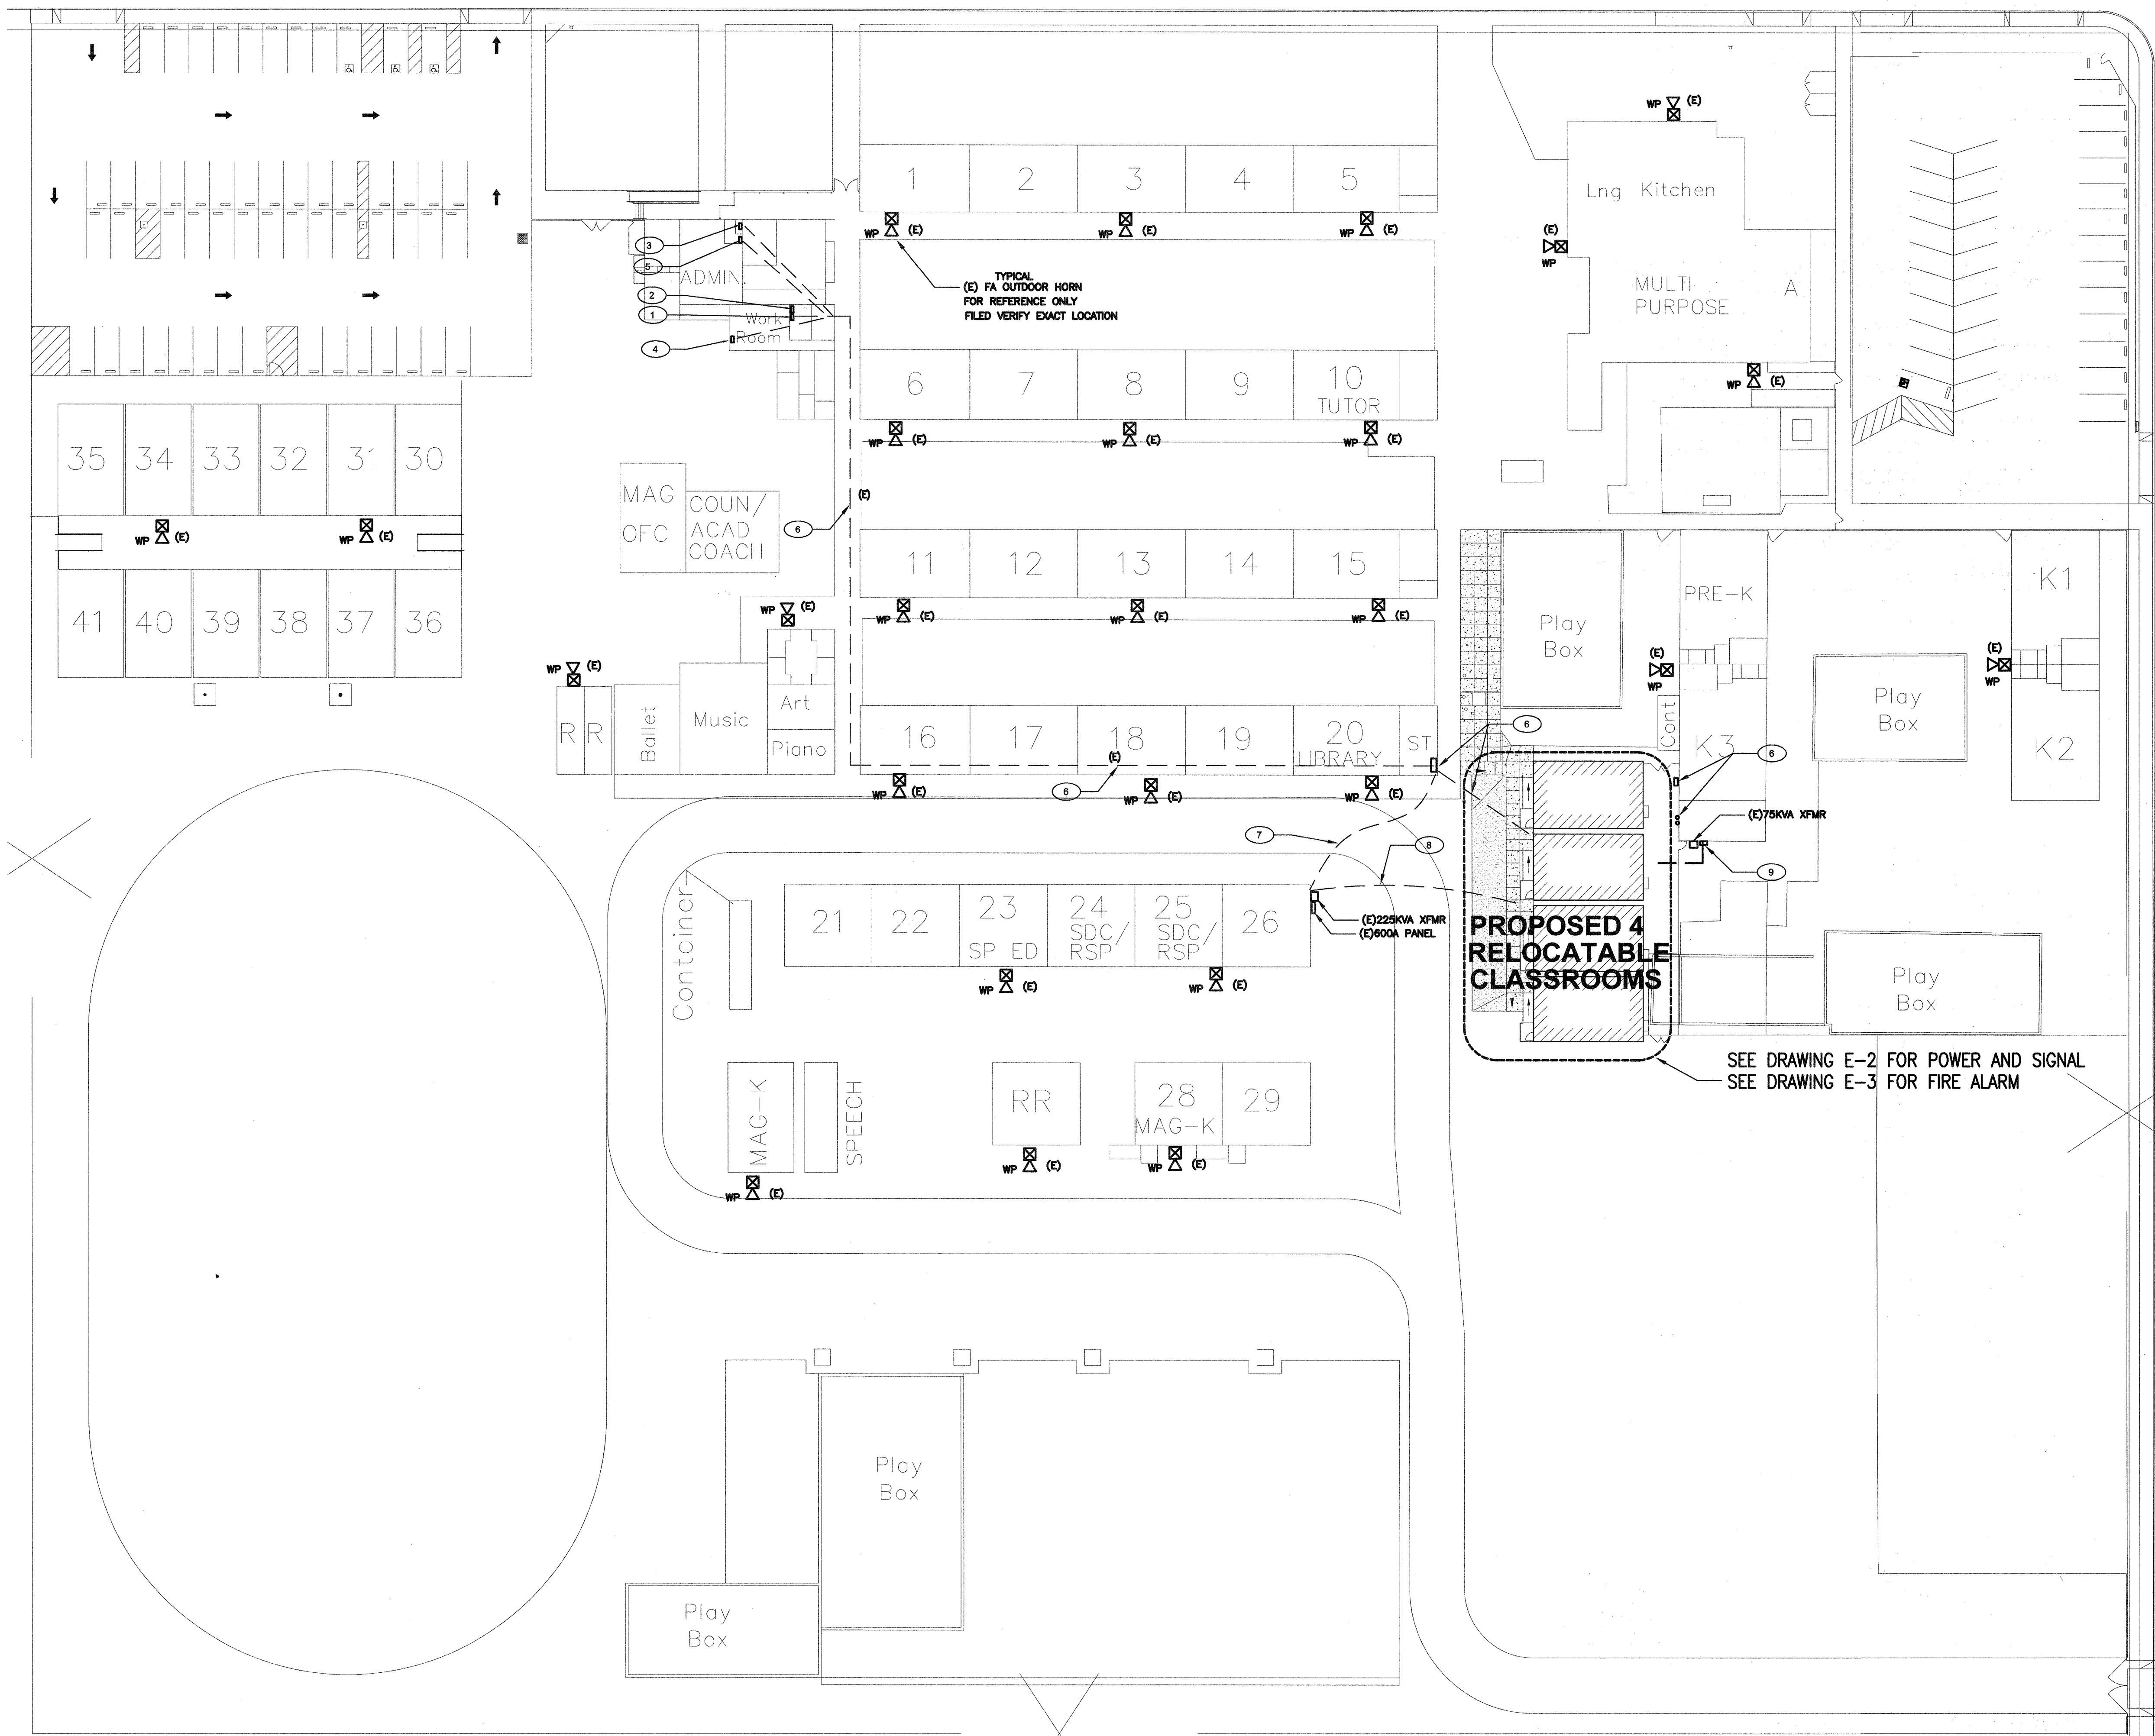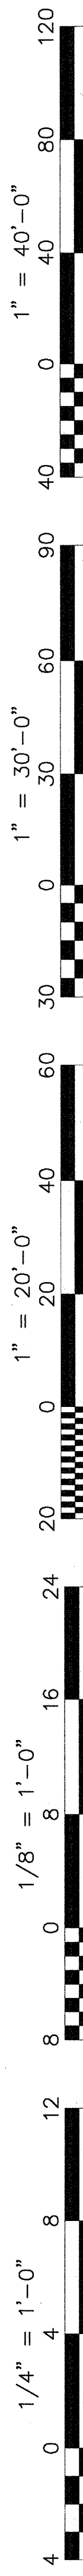

SITE PLAN - ELECTRICAL
3 RELOCATABLE CLASSROOM

SCALE : 1" = 30' - 0"

SHEET NOTES

- 1 APPROXIMATE LOCATION FOR ^{new} ADDRESSABLE FIRE ALARM CONTROL PANEL TO REMAIN IN SERVICE. PROVIDE CONNECTION TO NEW FIRE ALARM DEVICES PER PLANS. UPDATE NEW FIRE ZONE MAP AND PROGRAM NEW DEVICES INFORMATION. MEASURE ACTUAL LOAD CURRENT AND VOLTAGE DROP FOR EACH IAC SIGNAL CIRCUITS, AND FACP STANDBY CURRENT AND ALARM CURRENT. SEND THE REPORT TO OWNER AND ENGINEER FOR REVIEW, AND PLASTIC LAMINATED ONE COPY INSIDE FACP CABINET DOOR.
 - 2 FURNISH AND INSTALL A NEW FIRE ALARM DIGITAL VOICE COMMAND CENTER AND WIRE CONNECT TO EXISTING FIRE ALARM CONTROL PANEL. SURFACE MOUNT NEXT TO OFFICE. FILED VERIFY EXACT LOCATION. SEE FA DRAWING E-3 RISER DIAGRAM.
 - 3 APPROXIMATE LOCATION FOR ^{new} PABX/TELEPHONE EQUIPMENT IN ADMIN OFFICE. PROVIDE NEW CABLE AND CONNECTION FOR NEW SIGNAL DEVICES PER PLANS.
 - 4 APPROXIMATE LOCATION FOR ^{new} SERVER COMPUTER MOF SERVER EQUIPMENT IN ADMIN OFFICE. PROVIDE NEW CABLE AND CONNECTION FOR NEW SIGNAL DEVICES PER PLANS.
 - 5 APPROXIMATE LOCATION FOR ^{new} MASTER INTRUSION ALARM EQUIPMENT IN ADMIN OFFICE. PROVIDE NEW CABLE AND CONNECTION FOR NEW SIGNAL DEVICES PER PLANS.
 - 6 APPROXIMATE LOCATION FOR ^{new} SIGNAL TC AND OR CONDUITS TO REMAIN. PULL IN NEW SIGNAL CONDUCTORS AS REQUIRED. SEE RISER DIAGRAMS.
 - 7 (E) AERIAL CABLE TO REMAIN AND REUSE PER PLANS. SEE SINGLE LINE DIAGRAM.
 - 8 DISCONNECT AND REMOVE (E) AERIAL CABLE. REMOVE ASSOCIATE CONDUIT AND SUPPORT AND RETURN TO OWNER. FILED VERIFY LOCATION.
 - 9 APPROXIMATE LOCATION FOR EXISTING POWER PANEL. PROVIDE NEW UNDERGROUND CONDUIT, FEEDERS AND POWER CONNECTION FOR NEW RELOCATABLE CLASSROOM BUILDINGS PER PLANS. SEE SINGLE LINE DIAGRAM.
- ⓂⓃⓈ INDICATE EXISTING CONDUIT AND WIRING. FOR REFERENCE ONLY. FIELD VERIFY AS REQUIRED.

PROJECT NOTES

1. SOURCE OF POWER HAS BEEN INVESTIGATED AND IS ADEQUATE FOR THE ADDITIONAL LOAD.
2. SITE INSPECTOR IS TO WITNESS AND VERIFY GROUNDING TEST.
3. CONTRACTOR TO MONITOR EXISTING FIRE ALARM SYSTEM IF IT IS INTERRUPTED OR DISCONNECTED.

Ownership of Documents
 This document, the ideas and designs incorporated herein, as an instrument of Professional Service is the property of Integrated Designs by SOMAM Inc. and is not to be used, in whole or in part for any other project without written authorization.
 © COPYRIGHT 2013

integrated designs by SOMAM, Inc.
 ARCHITECTURE - ENGINEERING - INTERIOR DESIGN - CONSTRUCTION MANAGEMENT
 1011 N. Fremont Blvd. - Fresno, Calif. 93710
 Phone (559) 438-0881 Fax (559) 438-0887 E-Mail: design@somam.com
 www.integrateddesigns.com

Rev. Date:	Rev. Description:

SITE PLAN - ELECTRICAL

MT. VERNON ELEMENTARY SCHOOL
4 RELOCATABLE CLASSROOMS
 BAKERSFIELD CITY SCHOOL DISTRICT
 2161 POTOMAC AVE., BAKERSFIELD, CA

Issue Date: 00/00/14
 Date: 05/28/14
 Designer: J CHONG
 DRE: J CHONG
 POC: CJM

Agency Approval Stamp:
 FILE #15-6
 IDENTIFICATION STAMP
 DIV. OF THE STATE ARCHITECT
 OFFICE OF REGULATION SERVICES
 03-117168
 AC: FL/SS/TN
 DATE: AUG 04 2016
 TRACKING #: DSA TRACKING NO




CONSULTING ENGINEERS
John Chong ENGINEERING
 JOHN S. CHONG
 E 14410
 Exp. 8/30/2016
 ELECTRICAL
 2071 E. DEGATUR AVE. FRESNO CA 93710
 (559) 525-9266 • FAX 551-3411
 jcheng1neer@aol.com

REGISTERED PROFESSIONAL ENGINEER
 STATE OF CALIFORNIA

Job No: **5125**

Sheet No: **E-1**

Release:

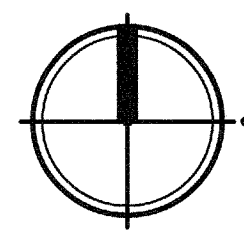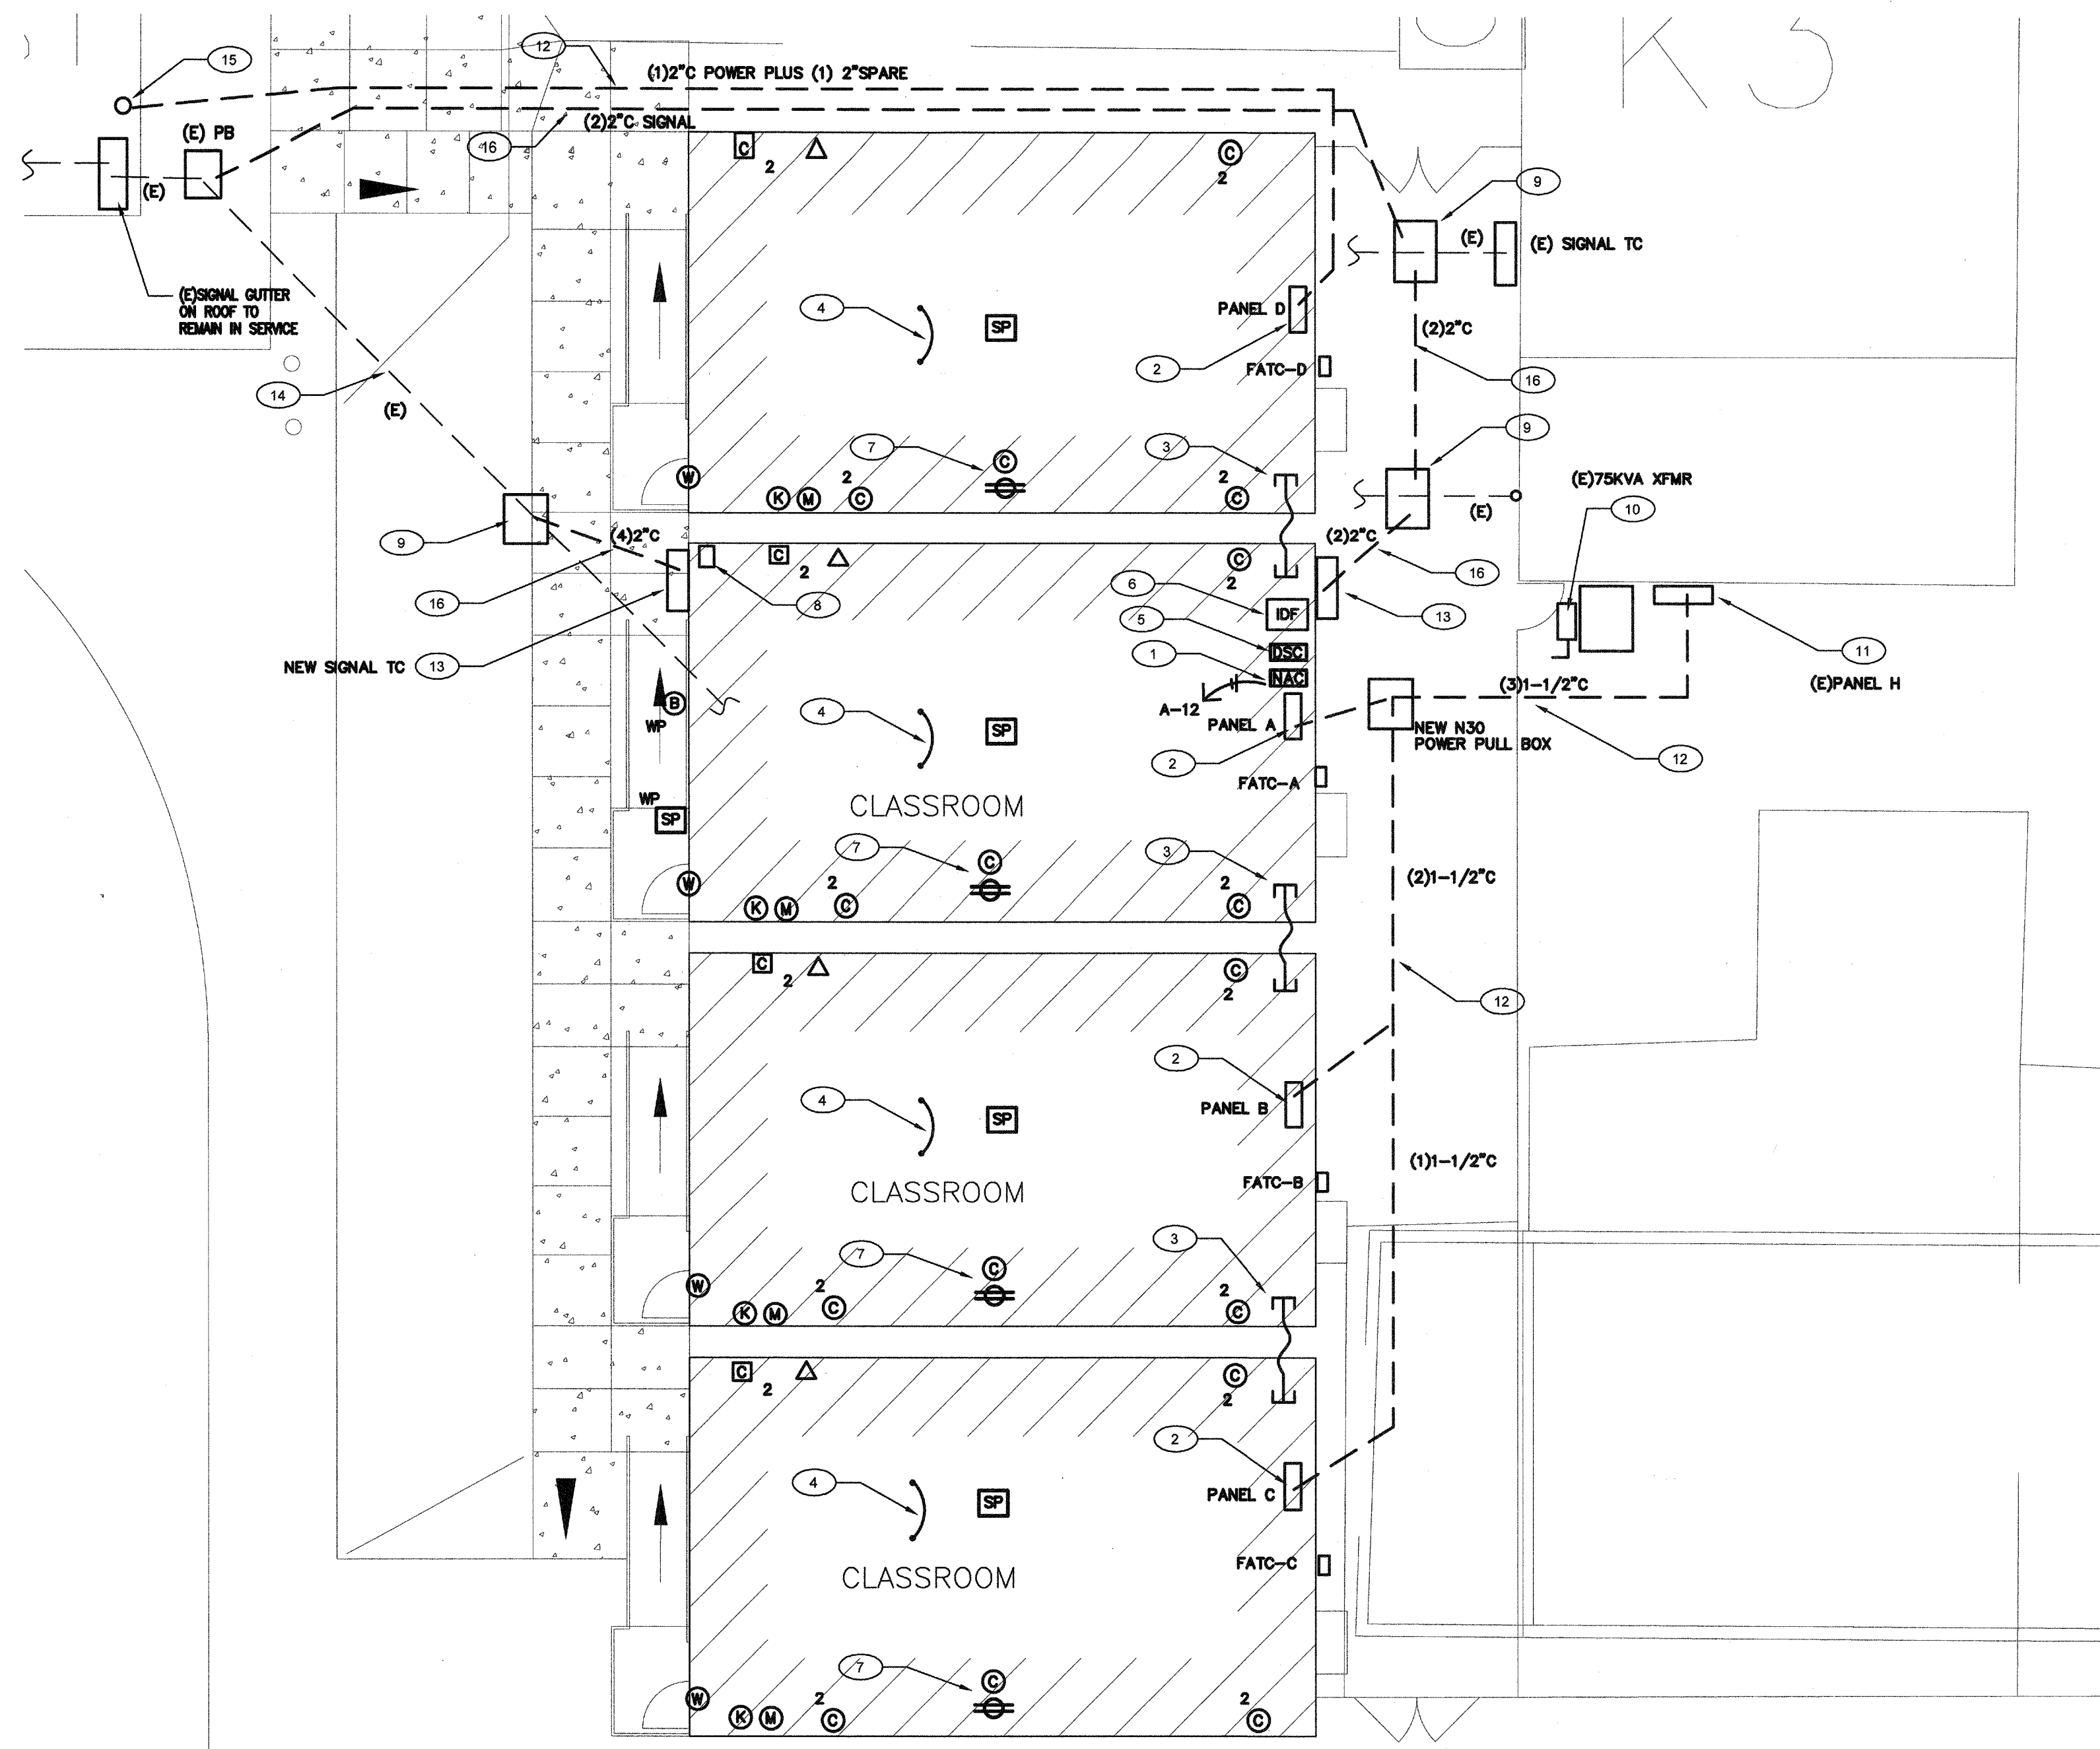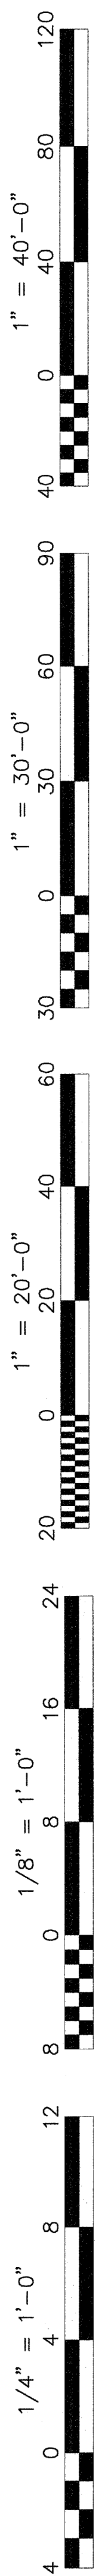


POWER AND SIGNAL PLAN

SCALE : 1/8" = 1' - 0"

SERVING		120/240V 1Ø 3W		REAR		FLUSH	
		100 AMP MAIN BREAKER		10,000 AIC		NEMA 1	
NO	NOTE	AMP	AVG	AMP	AVG	AMP	AVG
1	RECEPTACLE	12/12	20/1	10/17.3		60/2	8/10
2	RECEPTACLE	12/12	20/1	0.7/7.1		HVAC	3.5 TON
3	SPACE	12/12	20/1			20/1	12/12
4	SPACE	12/12	20/1			20/1	12/12
5	SPACE	12/12	20/1			20/1	12/12
6	SPACE	12/12	20/1			20/1	12/12
7	SPACE	12/12	20/1			20/1	12/12
8	INT/EXT LIGHTS	12/12	20/1	0.9		20/1	12/12
9	INT LIGHTS	12/12	20/1	0.8/0.1		20/1	12/12
10	INT LIGHTS	12/12	20/1	0.8/0.1		20/1	12/12
11	INT LIGHTS	12/12	20/1	0.8/0.1		20/1	12/12
12	INT LIGHTS	12/12	20/1	0.8/0.1		20/1	12/12

NOTES:
 1. PROVIDE CIRCUIT DIRECTORY INSIDE PANEL.
 2. PROVIDE NEW MATCHING BREAKER AND MECHANICAL LOCK ON BREAKER PER NFPA 72, 10.6.5.2 DEDICATED CIRCUIT, MECHANICALLY PROTECTED (LOCKOUT), RED MARKING, ACCESSIBLE ONLY TO AUTHORIZED PERSONNEL, IDENTIFIED AS FIRE ALARM, EMERGENCY COMMUNICATIONS OR FIRE ALARM/ESS. LOCATION OF CIRCUIT DISCONNECT (BREAKER) PERMANENTLY IDENTIFIED AT THE FIRE ALARM CONTROL UNIT.

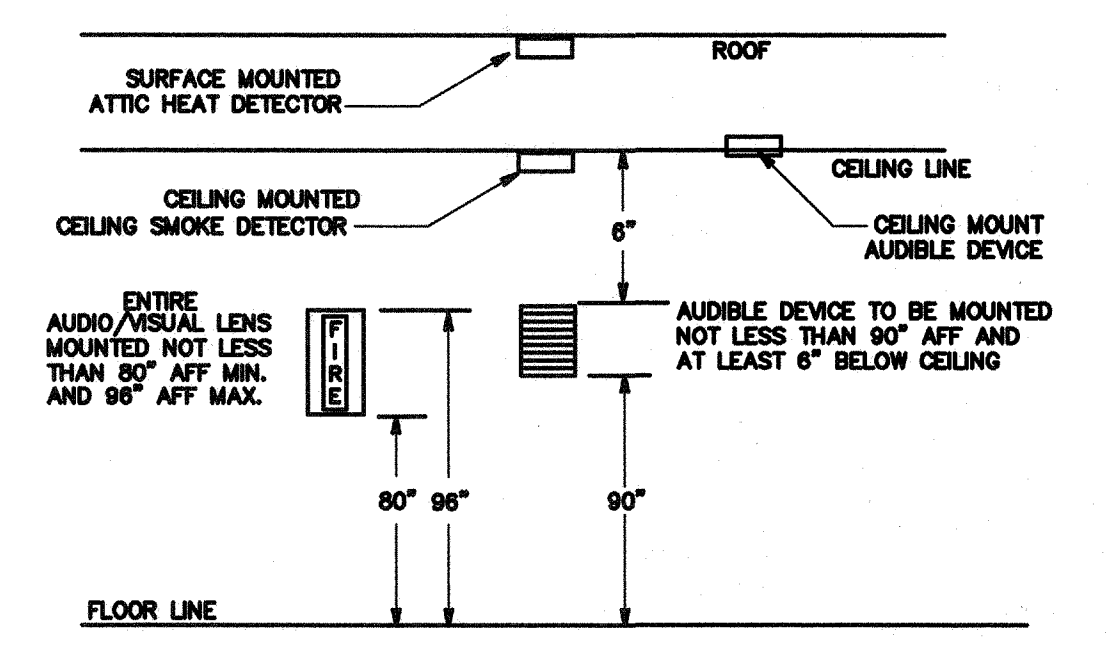

1 TYPICAL FIRE ALARM DEVICES MTD DETAIL
N.T.S.

MEP COMPONENT ANCHORAGE NOTES

ALL MECHANICAL, PLUMBING, AND ELECTRICAL COMPONENTS SHALL BE ANCHORED AND INSTALLED PER THE DETAILS ON THE DATA APPROVED CONSTRUCTION DOCUMENTS. WHERE NO DETAILS IS PROVIDED, THE FOLLOWING COMPONENTS SHALL BE ANCHORED OR BRACED TO MEET THE FORCE AND DISPLACEMENT REQUIREMENTS PRESCRIBED IN THE 2013 CBC, SECTIONS 1910A.1.10 THROUGH 1910A.1.20 AND ACE 7-10 CHAPTER 13, 20 AND 30.

- ALL PERMANENT EQUIPMENT AND COMPONENTS.
- TEMPORARY OR MOVABLE EQUIPMENT THAT IS PERMANENTLY ATTACHED (E.G. HUNG WIRES) TO THE BUILDING UTILITY SERVICES SUCH AS ELECTROLYSIS OR BUSES.
- MOVABLE EQUIPMENT WHICH IS SUSCEIVED IN ONE PLACE FOR MORE THAN 8 HOURS AND HEAVIER THAN 400 POUNDS ARE REQUIRED TO BE ANCHORED WITH TEMPORARY ATTACHMENTS.

THE ATTACHMENT OF THE FOLLOWING MECHANICAL AND ELECTRICAL COMPONENTS SHALL BE POSITIVELY ATTACHED TO THE STRUCTURE, BUT NEED NOT BE DETAIL ON THE PLANS. THESE COMPONENTS SHALL HAVE FLEXIBLE CONNECTIONS PROVIDED BETWEEN THE COMPONENT AND ASSOCIATED DUCTWORK, PIPING, AND CONDUIT.

- COMPONENTS WEIGHING LESS THAN 400 POUNDS AND HAVE A CENTER OF MASS LOCATED 4 FEET OR LESS ABOVE THE ADJACENT FLOOR OR ROOF LEVEL THAT DIRECTLY SUPPORT THE COMPONENT.
- COMPONENTS WEIGHING LESS THAN 20 POUNDS, OR IN THE CASE OF DISTRIBUTED SYSTEMS, LESS THAN 5 POUNDS PER FOOT, WHICH ARE SUSPENDED FROM A ROOF OR FLOOR OR HANG FROM A WALL.

FOR THOSE ELEMENTS THAT DO NOT REQUIRE DETAILS ON THE APPROVED DRAWINGS, THE INSTALLATION SHALL BE SUBJECT TO THE APPROVAL OF THE STRUCTURAL ENGINEER OF RECORD AND THE DATA DISTRICT STRUCTURAL ENGINEER. THE PROJECT INSPECTOR SHALL VERIFY THAT ALL COMPONENTS AND EQUIPMENT HAVE BEEN ANCHORED IN ACCORDANCE WITH ABOVE REQUIREMENTS.

PIPING, DUCTWORK, AND ELECTRICAL DISTRIBUTION SYSTEM BRACING NOTE

PIPING, DUCTWORK, AND ELECTRICAL DISTRIBUTION SYSTEMS SHALL BE BRACED TO COMPLY WITH THE FORCE AND DISPLACEMENTS PRESCRIBED IN ACE 7-10 SECTION 13.3 AS DEFINED IN ACE 7-10 SECTION 12.A, 13.A, 13.B, AND 2013 CBC, SECTION 1910A.1.21, 1910A.1.22, 1910A.1.23 AND 1910A.1.24.

THE BRACING AND ATTACHMENTS TO THE STRUCTURE SHALL BE DETAIL ON THE APPROVED DRAWINGS OR THEY SHALL COMPLY WITH ONE OF THE CORRO PRE-APPROVALS (CPM #) AS MODIFIED TO MEET ANCHORAGE REQUIREMENTS OF ACI 308, APPENDIX D.

COPIES OF THE MANUAL SHALL BE AVAILABLE ON THE JOBSITE PRIOR TO THE START OF PIPING AND BRACING OF THE PIPING, DUCTWORK, AND ELECTRICAL DISTRIBUTION SYSTEMS.

THE STRUCTURAL ENGINEER OF RECORD SHALL VERIFY THE ADEQUACY OF THE STRUCTURE TO SUPPORT THE HANGER AND BRACE LOADS.

SHEET NOTES

- APPROXIMATE LOCATION FOR NEW FIRE ALARM SIGNAL AND AUDIO BOOSTER PANEL. PROVIDE 110V POWER CONNECTION AND DEDICATED CIRCUIT FROM PANEL A-12. SEE DRAWING E-3 FOR MORE INFORMATION.
- PROVIDE POWER CONNECTION FOR RELOCATABLE BUILDING PRE-WIRED PANEL. SEE SINGLE LINE DIAGRAM ON DRAWING E-4.
- PROVIDE 2" EMT BETWEEN BUILDINGS AND STUB INTO BUILDING CEILING CAVITY FOR SIGNAL WIRING RACEWAY. CORE DRILL AND SEAL EXTERIOR WALL AS REQUIRED. PULL BACK PA/TC TELE CABLE TO ADMIN OFFICE MASTER EQUIPMENT FOR NEW DEVICES CONNECTION. SEE RISER DIAGRAMS.
- PROVIDE #6 COPPER GROUNDING CONDUCTOR AND BOND TO EACH SECTION STRUCTURAL STEEL BEAM. FIELD VERIFY EXACT LOCATION WITH GENERAL CONTRACTOR PRIOR TO INSTALLATION.
- NEW SECURITY ALARM PANEL AND SYSTEM. PROVIDE 110V POWER CONNECTION AND INTERCONNECTION TO #8 MASTER EQUIPMENT IN ADMIN OFFICE. FIELD VERIFY EXACT LOCATION AND REQUIREMENT WITH OWNER PRIOR TO INSTALLATION. SEE RISER DIAGRAM.
- NEW IDF AND CABINET SURFACE MOUNTED BELOW CEILING. PROVIDE 110V POWER CONNECTION, DATA SWITCH, FO CABLE AND DATA CABLE PATCH PANEL FOR NEW DATA OUTLET CONNECTION. PROVIDE FO CABLE TO #8 IDF IN ADMIN OFFICE FOR INTERCONNECTION. FIELD VERIFY EXACT LOCATION AND REQUIREMENT WITH OWNER PRIOR TO INSTALLATION. SEE RISER DIAGRAM.
- DATA AND POWER OUTLET AT CEILING FOR SMART BOARD. FIELD VERIFY EXACT LOCATION AND REQUIREMENT WITH OWNER PRIOR TO INSTALLATION. SEE RISER DIAGRAM.
- PROVIDE 50 PAIR PUNCH DOWN BLOCK AND SURFACE MOUNTED BELOW CEILING FOR INTERCOM / TELEPHONE WIRING TERMINATION.
- INTERCEPT EXISTING U/G SIGNAL CONDUITS AND INSTALL CHRISTY N30 PULL BOX, REROUTE AND RECONNECT EXISTING U/G CONDUITS AND WIRING PER ORIGINAL. DO NOT SPICE SIGNAL CONDUCTOR INSIDE PULL BOX. RE PULL NEW CONDUCTORS AS REQUIRED. FIELD VERIFY EXACT LOCATION AND CONDITION PRIOR TO DEMOLITION.
- APPROXIMATE LOCATION FOR 70KVA XFMR. PROVIDE SAFETY DISCONNECT SWITCH ON (3) PHASE PRIMARY SIDE. SEE SINGLE LINE DIAGRAM. FIELD VERIFY LOCATION.
- APPROXIMATE LOCATION FOR EXISTING PANEL H. PROVIDE NEW CONDUITS AND FEEDERS FOR NEW PRE-WIRED PANEL POWER CONNECTION. SEE SINGLE LINE DIAGRAM.
- SAW CUT AND PATCH EXISTING GROUND TO INSTALL NEW U/G POWER CONDUITS AND CONDUCTORS PER PLANS. SEE SINGLE LINE DIAGRAM.
- NEW 24"x24"x4" NEMA3R SIGNAL TO SURFACE MOUNTED ON EXTERIOR WALL AT CEILING LEVEL. PROVIDE (2) 2" STUB INTO BUILDING ATTIC CAVITY. SEE SIGNAL RISER DIAGRAM.
- INTERCEPT EXISTING U/G SIGNAL CONDUITS TO REMAIN AND REUSE PER PLANS. REROUTE AND RE-PULL NEW CONDUCTORS AS REQUIRED. SEE RISER DIAGRAMS.
- INTERCEPT EXISTING AERIAL CABLE AND INSTALL 24"x24"x4" NEMA3R PULL BOX. EXTEND NEW CONDUIT AND CONDUCTORS TO NEW PRE-WIRED PANEL PER PLANS. SEE SINGLE LINE DIAGRAM. FIELD VERIFY LOCATION WITH OWNER AND GENERAL CONTRACTOR PRIOR TO INSTALLATION.
- SAW CUT AND PATCH EXISTING GROUND TO INSTALL NEW U/G SIGNAL CONDUITS AND CONDUCTORS. RE PULL NEW CONDUCTORS TO RECONNECT EXISTING SIGNAL CIRCUITS DUE TO RELOCATED BUILDING REMOVED. FIELD VERIFY EXISTING CONDITION PRIOR TO DEMOLITION.

SIGNAL AND COMM. LEGEND

- SECURITY ALARM SYSTEM**
- DISC: DIGITAL SECURITY ALARM CONTROL PANEL, MODEL SONTROL (64ZONE). INTERFACE WITH EXISTING BUILDING MASTER SECURITY ALARM PANEL AS REQUIRED.
 - LD: LED KEYPAD - MATCH EXISTING EQUIPMENT AS REQUIRED.
 - UD: DUAL TECHNOLOGY CEILING MOUNT DETECTOR. MATCH EXISTING EQUIPMENT AS REQUIRED.
 - EX: EXTERIOR BELL (SIREN) - DISCONNECT WITH WEATHERPROOF BACKBOX AND TAMPER SWITCH.
 - DC: DOOR CONTACT SWITCH. RECESS ABOVE DOOR JAMB AT OPEN SIDE.
 - B: INDOOR SECURITY ALARM CABLE. WEST PENN #241
 - B1: OUTDOOR SECURITY ALARM CABLE. WEST PENN #AQC224
- COMMUNICATION (TELEPHONE/INTERCOM) SYSTEM**
- HP: HANDSET/P PHONE - FIELD VERIFY MODEL NO. AND MATCH EXISTING MASTER EQUIPMENT AS REQUIRED.
 - SP: CEILING SPEAKER - RAULAND #JSD221 W/ACC1000 BAFFLE. PROVIDE BACKBOX AND CEILING SUPPORT AS REQUIRED.
 - SP1: OUTDOOR SPEAKER - ATLAS #AFT15 HORN W/AFMR AND LONELL (#284 FOR SURFACE, #9757X FOR RECESS) BACK BOX W/SILK GRILL.
 - T: OUTDOOR TELE/C CABLE. 22AWG SOLID COPPER 12 PAIR SHIELDED AND 12 PAIR UNSHIELDED CABLE.
 - T1: INDOOR TELEPHONE CABLE. CAT.3 22AWG SOLID COPPER 4UTP SHIELDED CABLE.
 - P1: OUTDOOR PA/C CABLE - WEST PENN #AQC-369
- DATA COMMUNICATION SYSTEM**
- 2: DATA OUTLET - LEVITON CAT 5E (DUAL RECEPTACLE RED IN COLOR FOR ADMINISTRATIVE)
 - 2: DATA OUTLET - LEVITON CAT 5E (DUAL RECEPTACLE BLUE IN COLOR FOR INSTRUCTIONAL)
 - FO: RISER OPTIC CABLE IN INNER DUCT WITH J-HOOK IN ATTIC AND 2" CABLE FOR OUTDOOR. SEE RISER DIAGRAM FOR MODEL NO.
 - C1: (ONE) CAT 5E 22AWG 4UTP. SEE RISER DIAGRAM FOR MODEL NO.
 - C2: (TWO) CAT 5E 22AWG 4UTP. SEE RISER DIAGRAM FOR MODEL NO.
- NOTES:**
- ALL SIGNAL CONDUCTORS CANNOT SPLICE INSIDE PULL BOX. CONDUCTOR MUST BE CONTINUE RUN BETWEEN SIGNAL DEVICES BACK BOX OR ABOVE GROUND TERMINAL CABINET.

Ownership of Documents
 This document, the ideas and designs incorporated herein, as an instrument of Professional Service is the property of Integrated Designs by SOMAM, Inc. and is not to be used, in whole or in part for any other project without written authorization. © COPYRIGHT 2013

Integrated designs by SOMAM, Inc.
 ARCHITECTURE - ENGINEERING - INTERIOR DESIGN - CONSTRUCTION MANAGEMENT
 4011 N. Fremont, Suite 130 - Fresno, California 93710
 Phone: (559) 439-0881 Fax: (559) 439-0887 E-Mail: design@somam.com
 www.integrateddesigns.com

Rev. No.	Date	Revision Description

POWER AND SIGNAL PLAN

Project Name & Address:
MT. VERNON ELEMENTARY SCHOOL
4 RELOCATABLE CLASSROOMS
 BAKERSFIELD CITY SCHOOL DISTRICT
 2161 POTOMAC AVE., BAKERSFIELD, CA

Issue Date: 09/09/14
 Date: 05/29/14
 Designer: J. CHONG
 D.R.: J. CHONG
 P.C.: C.M.

Agency Approval Stamp:
 FILE # 15-6
 IDENTIFICATION STAMP
 DIV. OF THE STATE ARCHITECT
 OFFICE OF REGULATION SERVICES
 03-117168
 AC. FLORIANESS, IN
 DATE: AUG. 04 2015
 TRACKING #: DSA TRACKING NO

Stamp(s):

Job No.: **5125**


Sheet No.: **E-2**

Release:

CONSULTING ENGINEERS
JOHN CHONG ENGINEERING
 JOHN S. CHONG
 E 14419
 Exp. 8/30/2016
 ELECTRICAL
 2017 E. DECATUR AVE. FRESNO CA 93710
 (559) 215-2266 • FAX 559-2401
 jchongengineer@aol.com

REGISTERED PROFESSIONAL ENGINEER
 STATE OF CALIFORNIA

1" = 40'-0"
1" = 30'-0"
1" = 20'-0"
1" = 10'-0"
1/8" = 1'-0"
1/4" = 1'-0"

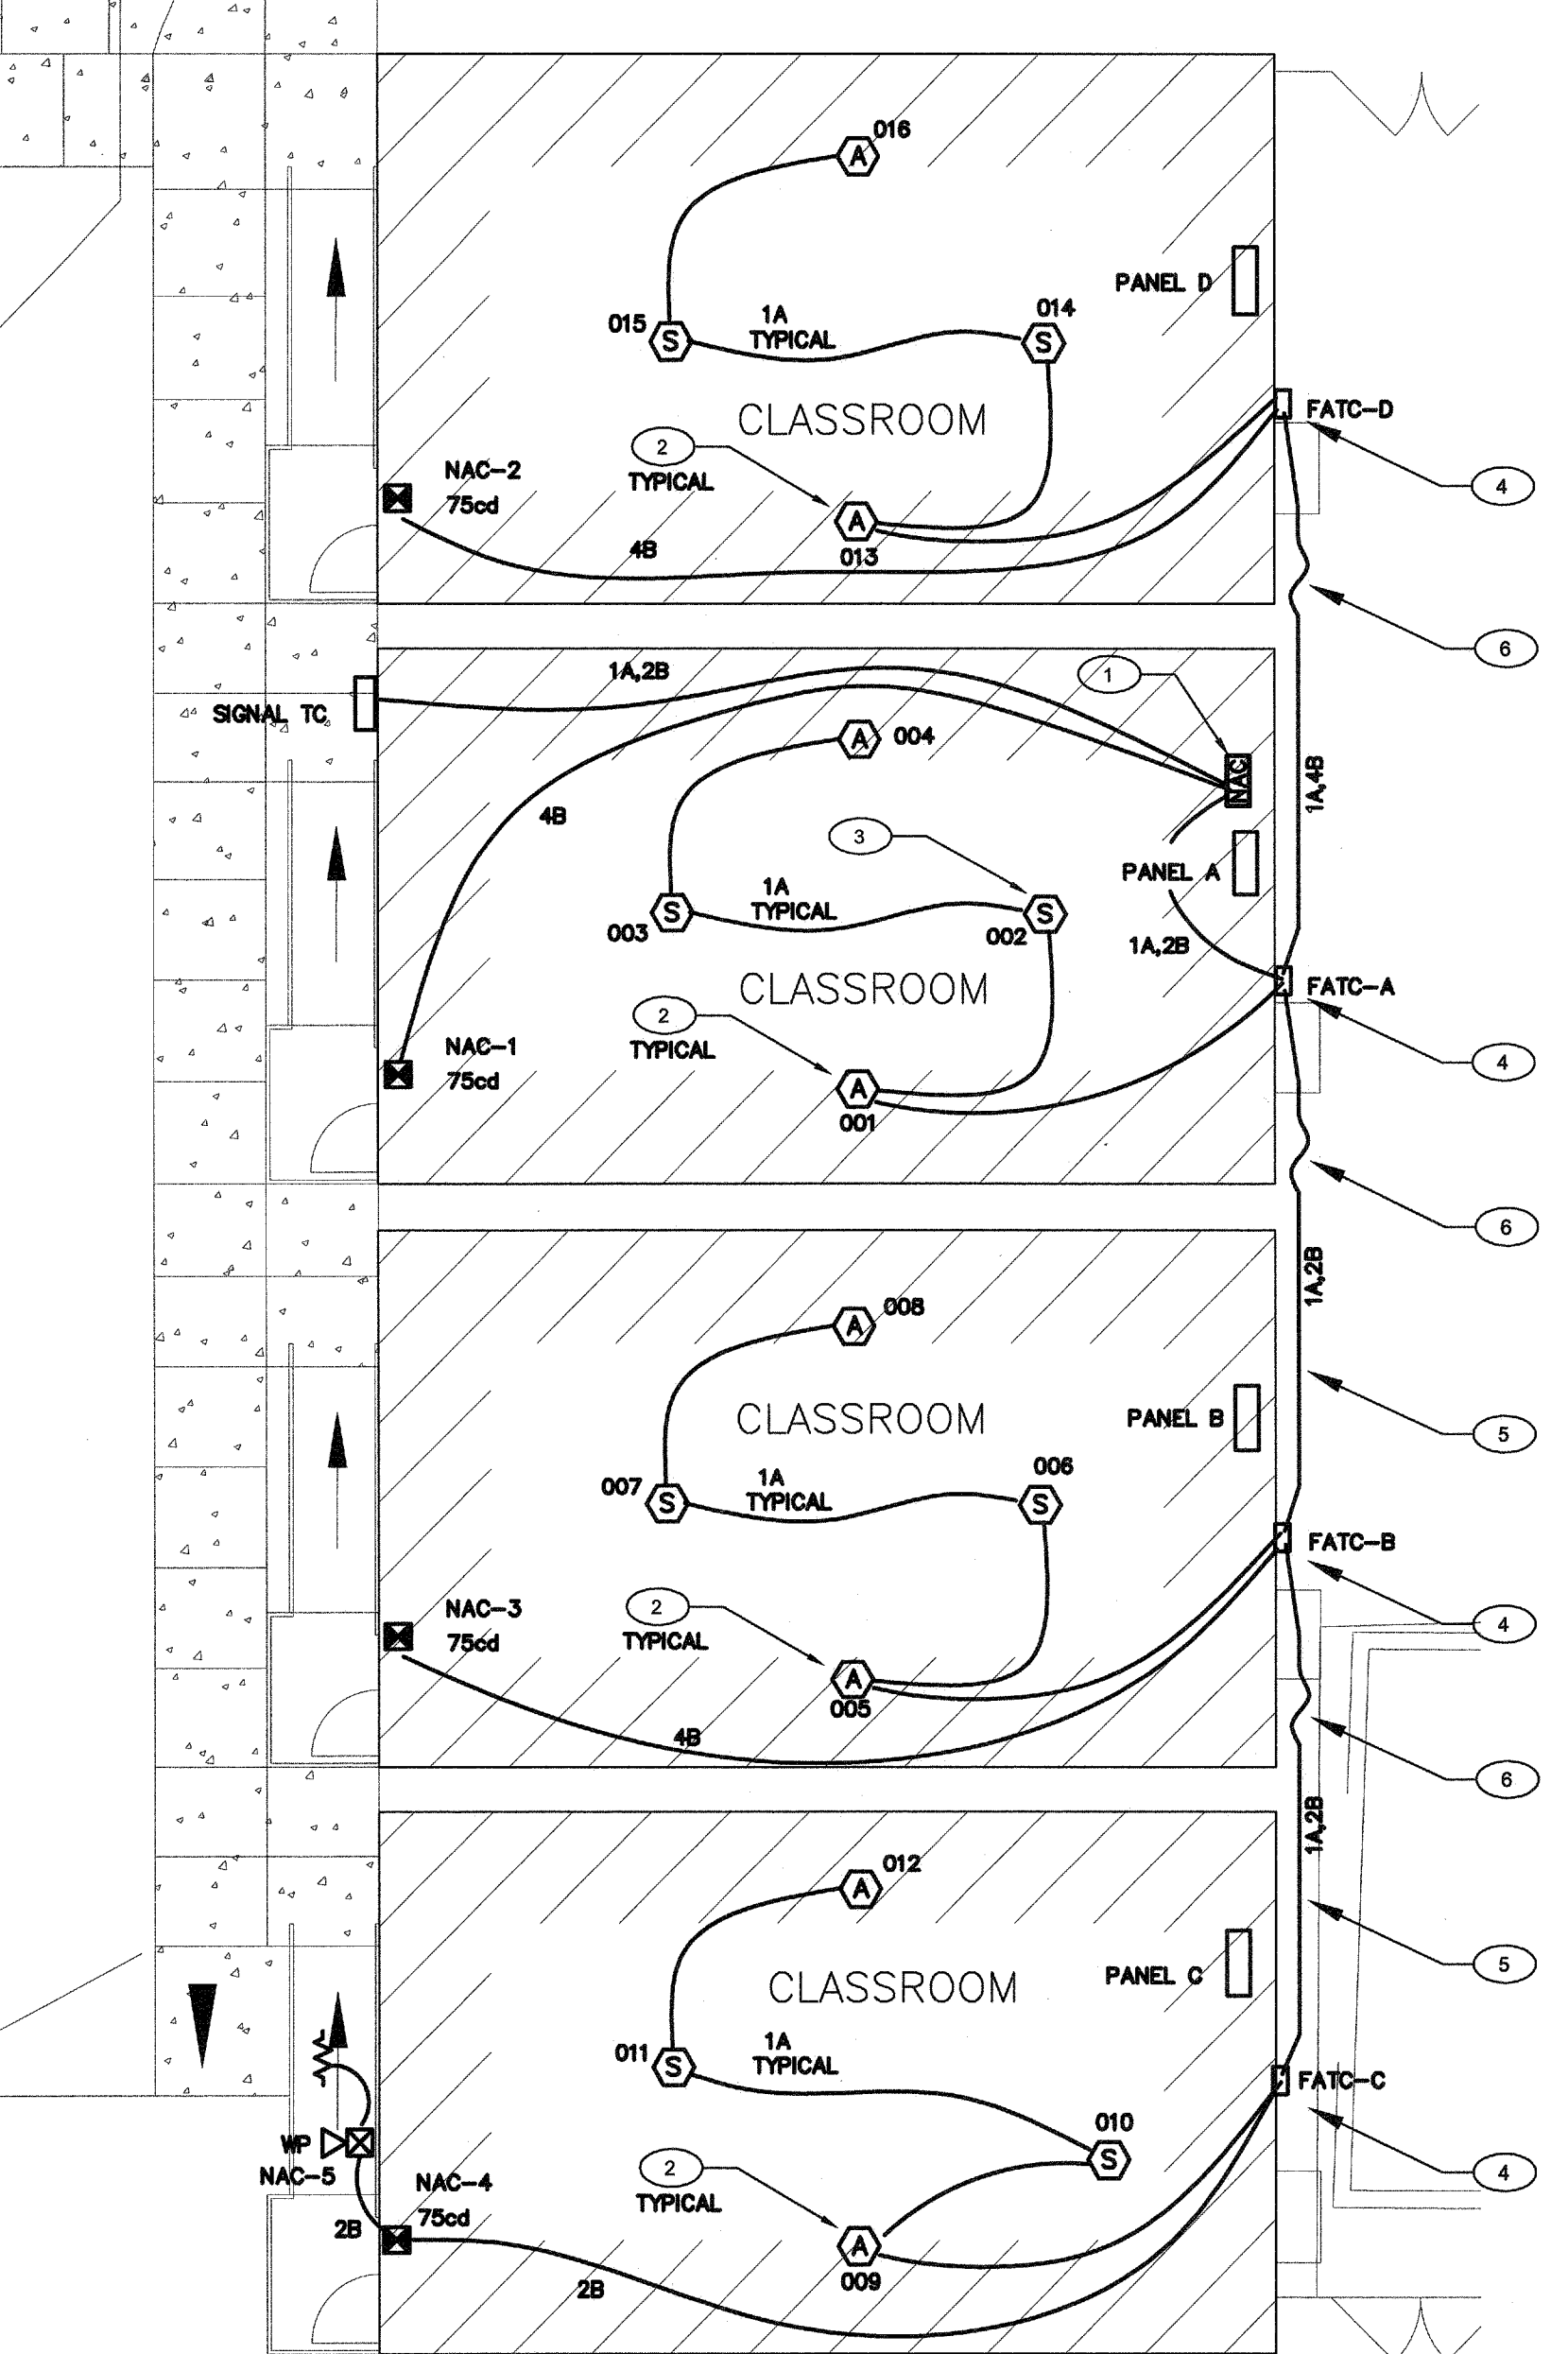

FIRE ALARM PLAN

SCALE: 1/8" = 1' - 0"

ITEM	DESCRIPTION	MODEL NUMBER	CSFM NUMBER	MOUNT	BACK BOX
□	EMERGENCY FACP (FOR REFERENCE ONLY)	HOCHIKI #FIRENET 4127	7165-0410:0159	+60"	EQUIPMENT CABINET
□	VOICE EVACUATION PANEL	HOCHIKI #VAC-SD	6911-0410:0178	+60"	EQUIPMENT CABINET
□	NAC SIGNAL & VOICE VAC BOOSTER PANEL SIGNAL EXPANDER	WHELOCK #SPB 80/4	6911-0785:0157	+60"	EQUIPMENT CABINET
⊗	SPEAKER STROBE 150cd 300cd 750cd 110cd	HOCHIKI #SPKSTROBE	7320-0410:0195	+80"	4"SQ X 2 1/2"D
⊗ WP	OUTDOOR SPEAKER	NOTIFIER #SPRK	7320-1652:0201	+90"	4"SQ X 2 1/2"D
⊗	ADDRESSABLE CEILING SMOKE DETECTOR WITH BASE	HOCHIKI #ALK-V /YBN-NSA-4	7272-0410:0173	CEILING	4"SQ X 2 1/2"D
⊗	ATTIC HEAT DETECTOR 190°F TEMP WITH BASE AND MONITOR MODULE	HOCHIKI #DFE 190°F/HSC-300L #FRME-4	7270-0410:0119 7300-0410:0150	ATTIC	4"SQ X 2 1/2"D
—	FIRE ALARM CABLE POWER LIMITED	WEST PENN AQ SERIES	7161-0859:0101		
—	END OF LINE RESISTOR	N/A	N/A	LAST DEVICE	4"SQ X 2 1/2"D

BATTERY POWER CALCULATIONS

NEW FIRE ALARM CONTROL PANEL (FACP)

DEVICE	NO. OF DEVICE	CURRENT PER DEVICE	STANDBY CURRENT	ALARM CURRENT
NEW UNIT	1	0.125A	1.25A	1.25A
EXISTING SIGNAL EXPANDER	3	0.012A	0.012A	0.036A
EXISTING OUTDOOR HORN	20	0.0004A	0.055A	0.0004A
EXISTING HEAT DETECTOR	170	0.0003A	0.0065A	0.051A
EXISTING SMOKE DETECTOR	280	0.0003A	0.0065A	0.084A
EXISTING MANUAL PULLS	4	0.00003A	0.0069A	0.00012A
EXISTING 75cd VISUALS	15	0.000A	0.157A	0.0000A
EXISTING 300cd VISUALS	10	0.000A	0.065A	0.0000A
NEW NAC/SIGNAL EXPANDER	1	0.012A	0.012A	0.012A
NEW SMOKE DETECTOR	8	0.0003A	0.0065A	0.0024A
NEW HEAT DETECTOR	8	0.0003A	0.0065A	0.0024A
SUB-TOTAL			0.3129A	0.975A

24 HOUR STANDBY CURRENT: 7.510AH
15 MINUTE LED CURRENT (0.25 HR): 2.282AH
SUBTOTAL: 9.792AH
20% SAFETY FACTOR: 1.858AH
TOTAL NEW ADDITIONAL AMPS-HRS REQUIRED: 11.735AH
REPLACE EXISTING BATTERY WITH NEW (2)18AH BATTERY

BATTERY POWER CALCULATIONS

NEW NAC SIGNAL BOOSTER PANEL

DEVICE	NO. OF DEVICE	CURRENT PER DEVICE	STANDBY CURRENT	ALARM CURRENT
UNIT	1	0.075A	0.175A	0.175A
OUTDOOR SPEAKER	1	---	0.050A	---
INDOOR SPEAKER (SPEAKER STROBE)	4	---	0.050A	---
SPEAKER STROBE 75cd	4	---	0.157A	---
SUB-TOTAL			0.075A	1.053A

24 HOUR STANDBY CURRENT: 1.800AH
15 MINUTE ALARM CURRENT (0.25 HR): 0.263AH
SUBTOTAL: 2.063AH
20% SAFETY FACTOR: 0.413AH
TOTAL AMPS-HRS REQUIRED: 2.476AH
PROVIDE BATTERY WITH NEW (2)12AH BATTERY

BATTERY POWER CALCULATIONS

NEW AUDIO AMPLIFIER IN ADMIN OFFICE

DEVICE	NO. OF DEVICE	CURRENT PER DEVICE	STANDBY CURRENT	ALARM CURRENT
UNIT	1	0.130A	1.0A	1.0A
SUB-TOTAL			0.130A	1.0A

24 HOUR STANDBY CURRENT: 3.120AH
15 MINUTE ALARM CURRENT (0.25 HR): 0.250AH
SUBTOTAL: 3.370AH
20% SAFETY FACTOR: 0.674AH
TOTAL NEW AMPS-HRS REQUIRED: 4.044AH
PROVIDE BATTERY WITH (2)12AH BATTERIES


VOLTAGE DROP CALCULATION

WORST CASE VOLTAGE DROP AT THE LAST DEVICE

SIGNAL CKT NO.	AMPERES	APPROX LENGTH	RESISTIVITY DSH	WIRE AWG	AREA CM	VOLTS DROPPED	% VOLTS DROP
001	0.77A	60'	21.6	12	6530	1.579V	6.6%

SIGNAL CIRCUIT LOAD SUMMARY

OUT. #	OUTDOOR SPEAKER	INDOOR SPEAKER	SPEAKER STROBE	SPEAKER STROBE	SPEAKER STROBE	SPEAKER STROBE	NEW NAC SIGNAL EXPANDER	NEW NAC SIGNAL EXPANDER	NEW NAC SIGNAL EXPANDER	NEW NAC SIGNAL EXPANDER	NEW NAC SIGNAL EXPANDER	NEW NAC SIGNAL EXPANDER	TOTAL
001	0	0	0	0	4	0	0	0	0	0	0	0	0.77A

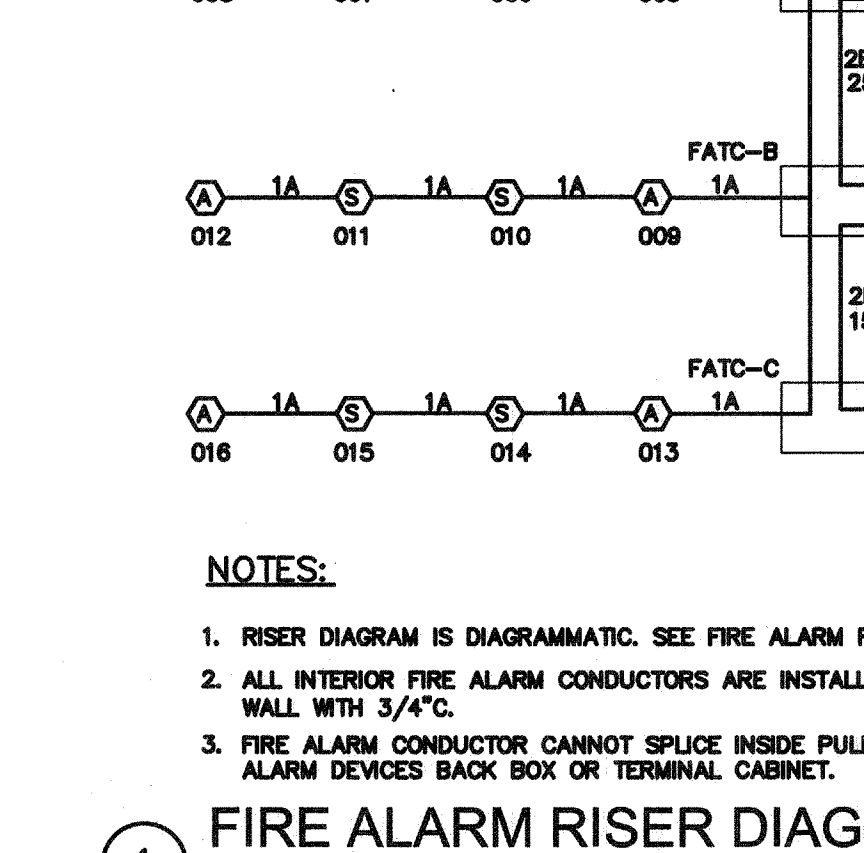

FIRE ALARM RISER DIAGRAM

FIRE ALARM SEQUENCE OF OPERATIONS

MANUAL PULL STATION	SMOKE DETECTORS	HEAT DETECTORS	DUCT DETECTOR	FIRE SPRINKLER WATERFLOW SWITCH	FIRE SPRINKLER TAMPER SWITCH	POST INDICATOR VALVE	WIRING CONDITIONS	SIGNALING LINE CIRCUIT (SLC)	INITIATING DEVICE CIRCUIT (IDC)	NOTIFICATION APPLIANCE CIRCUIT (NAC)	LOSS OF 120VAC POWER	RESET FACP
ALL (EXCEPT LISTED BELOW)	ALL (EXCEPT LISTED BELOW)	ALL (EXCEPT LISTED BELOW)						WIRE-TO-WIRE SHORT	WIRE-TO-WIRE SHORT	WIRE-TO-WIRE SHORT	WIRE-TO-WIRE SHORT	

NOTE: SOME SEQUENCE OF OPERATIONS SHOWN MAY NOT APPLY

BATTERY POWER CALCULATIONS

NEW NAC SIGNAL BOOSTER PANEL

DEVICE	NO. OF DEVICE	CURRENT PER DEVICE	STANDBY CURRENT	ALARM CURRENT
UNIT	1	0.075A	0.175A	0.175A
OUTDOOR SPEAKER	1	---	0.050A	---
INDOOR SPEAKER (SPEAKER STROBE)	4	---	0.050A	---
SPEAKER STROBE 75cd	4	---	0.157A	---
SUB-TOTAL			0.075A	1.053A

24 HOUR STANDBY CURRENT: 1.800AH
15 MINUTE ALARM CURRENT (0.25 HR): 0.263AH
SUBTOTAL: 2.063AH
20% SAFETY FACTOR: 0.413AH
TOTAL AMPS-HRS REQUIRED: 2.476AH
PROVIDE BATTERY WITH NEW (2)12AH BATTERY

DURING THE FINAL TESTING, MEASURE EXACT STANDBY AND ALARM CURRENT, VOLTAGE DROP FOR EACH SIGNAL CIRCUITS, SEND OWNER AND ENGINEER ONE COPY RECORD FOR REVIEW, AND PLASTIC LAMINATED ONE COPY INSIDE CABINET DOOR.

BATTERY POWER CALCULATIONS

NEW AUDIO AMPLIFIER IN ADMIN OFFICE

DEVICE	NO. OF DEVICE	CURRENT PER DEVICE	STANDBY CURRENT	ALARM CURRENT
UNIT	1	0.130A	1.0A	1.0A
SUB-TOTAL			0.130A	1.0A

24 HOUR STANDBY CURRENT: 3.120AH
15 MINUTE ALARM CURRENT (0.25 HR): 0.250AH
SUBTOTAL: 3.370AH
20% SAFETY FACTOR: 0.674AH
TOTAL NEW AMPS-HRS REQUIRED: 4.044AH
PROVIDE BATTERY WITH (2)12AH BATTERIES

VOLTAGE DROP CALCULATION

WORST CASE VOLTAGE DROP AT THE LAST DEVICE

SIGNAL CKT NO.	AMPERES	APPROX LENGTH	RESISTIVITY DSH	WIRE AWG	AREA CM	VOLTS DROPPED	% VOLTS DROP
001	0.77A	60'	21.6	12	6530	1.579V	6.6%

FA CABLE SCHEDULE

TYPE	DESCRIPTION
A	INITIATING CIRCUIT CABLE 2#16 AWG SOLID COPPER PVC JACKET POWER LIMITED FPLR CABLE FOR INDOOR VIA J-HOOK AND OUTDOOR VIA MIN. 3/4" CONDUIT INSTALLATION, WEST PENN #0990 OR EQUAL.
B	NAC SIGNAL CIRCUIT CABLE 2#12 AWG SOLID COPPER PVC JACKET POWER LIMITED FPLR CABLE FOR INDOOR VIA J-HOOK AND OUTDOOR VIA MIN. 3/4" CONDUIT INSTALLATION, WEST PENN #A0227 OR EQUAL. CSFM# 7161-0859:0101

F.A. MONITORING NOTES

- THE AUTOMATIC FIRE ALARM SYSTEMS SHALL TRANSMIT THE ALARM, SUPERVISORY AND TROUBLE SIGNALS TO AN APPROVED SUPERVISING STATION AS REQUIRED BY NEPA 72 AND AMENDED EITHER LUMP SUM OR LULUS BY UNDERWRITERS OF FACTORY MUTUAL RESEARCH APPROVAL STANDARD 3011. SUPERVISION OF SYSTEM AND LEASED TELEPHONE LINES SHALL BE ARRANGED BY OWNER.

COMPLETE AUTOMATIC FIRE ALARM PLAN SUBMITTAL

- THE FIRE ALARM SYSTEM SHOWN ON THESE PLANS HAS BEEN SUBMITTED AND APPROVED BY DIVISION OF THE STATE ARCHITECT. ANY SUBSTITUTION OF THE FIRE ALARM SYSTEM SHALL BE RESUBMITTED TO THE ARCHITECT FOR REVIEW AND APPROVAL. THE ARCHITECT SHALL PAY ANY ADDITIONAL FEES THAT ARE INCURRED DUE TO THIS SUBSTITUTION.
- THE AUTOMATIC FIRE ALARM SYSTEM SHALL COVER ALL ROOMS AND AREAS AND UPON ACTIVATION OF AN INITIATING DEVICE ALERT ALL OCCUPANTS AND TRANSMIT THE ALARM, SUPERVISORY AND TROUBLE SIGNALS TO AN APPROVED SUPERVISING STATION. (EXCEPTION: SMOKE DETECTORS ARE NOT REQUIRED IN NON-ACCESSIBLE AREAS AS DEFINED IN EMERGENCY EXPRESS TERMS OF PROPOSED S.F.M. AMENDMENTS TO 2013 C.F.C. SECTION 210 (C.F.C. SECTIONS 1006.2.4.2.2.1.1 AND 1006.2.4.2.2.1.5)

SHEET NOTES

- PROVIDE NEW FIRE ALARM SIGNAL AND AUDIO BOOSTER PANEL AND CONNECT TO (OFF) FACP PER RISER DIAGRAM. PROVIDE 110V POWER CONNECTION AND DEVIATED CIRCUIT FROM PANEL A-24. PROVIDE FIRE ZONE MAP, MEASURE ACTUAL LOAD CURRENT AND VOLTAGE DROP FOR EACH NAC SIGNAL CIRCUITS, AND STANDBY CURRENT AND ALARM CURRENT. SEND THE REPORT TO OWNER AND ENGINEER FOR REVIEW, AND PLASTIC LAMINATED ONE COPY INSIDE CABINET DOOR. SEE FA RISER DIAGRAM FOR DETAIL.
- LOCATE HEAT DETECTOR IN ATTIC AND SURFACE MOUNT ON THE BOTTOM OF RAFTER. DETECTOR COVERAGE WILL BE DERATED 50% ACROSS THE RAFTER. FIELD VERIFY LOCATION WITH GENERAL CONTRACTOR AND PROVIDE ATTIC HEAT DETECTOR IN EACH BAY OF STRUCTURAL.
- EXISTING CEILING SMOKE DETECTOR 5 FEET FROM EXISTING NAC SIGNAL EXPANDER PANEL. SEE DSA APP#03-115001 FA DRAWINGS.
- NEW 6"x6"x4" NEARBY FACP ON BUILDING EXTERIOR WALL. EXTEND NEW FA CONDUIT AND WIRING TO NEW BUILDINGS PER PLANS. FIELD VERIFY LOCATION.
- 3/4" FC CONDUIT ON BUILDING EXTERIOR WALL. FIELD VERIFY LOCATION.
- PROVIDED 3/4" WEATHERPROOF FLEX CONDUIT BETWEEN BUILDING.
- PROVIDE NEW FIRE ALARM DIGITAL VOICE COMMAND CENTER AND INTER CONNECT TO EXISTING FIRE ALARM CONTROL PANEL AND SURFACE MOUNT NEXT TO #0 FACP. FIELD VERIFY EXACT LOCATION.

F.A SYSTEM SCOPE OF WORK

- PROVIDE AUTOMATIC FIRE ALARM SYSTEM WITH VOICE EVACUATION DEVICES FOR THE NEW CLASSROOM BUILDINGS PER PLANS.
- EMERGENCY FACP IS 24VDC ADDRESSABLE, AND CLASS B WIRING SYSTEM, AND WITH OFF SITE MONITORING SERVICE VIA AUTO DUAL LINE DIALER AND TELEPHONE LINES.
- DURING THE FINAL TESTING, MEASURE ALL FIRE ALARM CIRCUITS, SEND OWNER AND ENGINEER ONE COPY RECORD FOR REVIEW, AND PLASTIC LAMINATED ONE COPY INSIDE FACP CABINET DOOR.
- COMPLETE FIRE ALARM DRAWING SUBMITTAL IS PROVIDED.

FIRE ALARM NOTES

- APPLICABLE STANDARD 2013 NFPA 72
- INSTALLATION OF THE SYSTEMS SHALL NOT BE STARTED UNTIL DETAILED DESIGN DOCUMENTS AND SPECIFICATIONS, INCLUDING STATE FIRE MARSHAL LISTING NUMBERS FOR EACH COMPONENT OF THE SYSTEM HAS BEEN APPROVED BY DSA.
- COMPLETION OF THE INSTALLATION OF THE SYSTEMS, A SATISFACTORY TEST OF THE ENTIRE SYSTEM SHALL BE MADE IN THE PRESENCE OF A DSA PROJECT INSPECTOR.
- A STAMPED SET OF APPROVED FIRE ALARM DESIGN DOCUMENTS SHALL BE ON THE JOB SITE AND USED FOR INSTALLATION.
- ANY DISCREPANCIES BETWEEN THE DRAWINGS AND THE CODE OR RECOGNIZED STANDARDS SHALL BE BROUGHT TO THE ATTENTION OF DSA AND THE ARCHITECT/ENGINEER OF THE PROJECT.
- DSA, ARCHITECT/ENGINEER AND OWNER SHALL BE NOTIFIED A MINIMUM OF 48 HOURS PRIOR TO THE FINAL INSPECTION AND/OR TESTING.
- PENETRATIONS THROUGH RATED ASSEMBLIES, REQUIRING OPENING PROTECTION SHALL BE PROVIDED WITH A PENETRATION FIRE STOP SYSTEM AS IDENTIFIED IN CSC CHAPTER 7, UL OR OTHER LAB TESTING CRITERIA. APPROVED TYPE OF MATERIALS SHALL BE IDENTIFIED WITHIN THE SPECIFICATION WITHIN THE FIRE ALARM SECTION.
- PENETRATIONS THROUGH RATED ASSEMBLIES, REQUIRING OPENING PROTECTION SHALL BE PROVIDED WITH A PENETRATION FIRE STOP SYSTEM AS IDENTIFIED IN CSC CHAPTER 7, UL OR OTHER LAB TESTING CRITERIA. APPROVED TYPE OF MATERIALS SHALL BE IDENTIFIED WITHIN THE SPECIFICATION WITHIN THE FIRE ALARM SECTION.
- WALL MOUNTED VISUAL NOTIFICATION DEVICES SHALL HAVE THEIR BOTTOMS MOUNTED AT 80" MINIMUM AND 96" MAXIMUM FROM FINISHED FLOOR.
- WALL MOUNTED AUDIBLE NOTIFICATION DEVICES SHALL HAVE THEIR BOTTOMS MOUNTED AT 80" MINIMUM AND 100" MAXIMUM FROM FINISHED FLOOR AND NO CLOSER THEN 6" TO A HORIZONTAL STRUCTURE.
- WALL MOUNTED AUDIBLE NOTIFICATION DEVICES SHALL HAVE THEIR BOTTOMS MOUNTED AT 80" MINIMUM AND 100" MAXIMUM FROM FINISHED FLOOR AND NO CLOSER THEN 6" TO A HORIZONTAL STRUCTURE.
- ALL FIRE ALARM CIRCUITS SHALL BE IN CONDUIT, SURFACE RACEWAY OR OPEN RUN ABOVE CEILING, UNDER FLOORS AND IN WALLS IN A NEAT AND PROTECTED MANNER AS INDICATED ON DESIGN DOCUMENTS. EXPOSED CIRCUITS ARE ONLY PERMITTED WHEN NOTED AS EXPOSED ON DESIGN DOCUMENTS.
- PER NEC STANDARDS, ALL WIRING IS TO BE PULLED THROUGH EACH JUNCTION BOX AND CONNECTED DIRECTLY TO EACH FIRE DEVICE. DO NOT SPLICE THE WIRE. ALL BOXES TO BE SIZED PER NEC.
- SMOKE DETECTORS SHALL NOT BE ANY CLOSER THAN 1" FROM FIRE SPRINKLERS OR 3" FROM ANY SUPPLY DIFFUSER. IN AREA OF CONSTRUCTION OF DANE/CONTAMINATION OR NEWLY INSTALLED FIRE ALARM DEVICES SHALL BE COVERED UNTIL THAT AREA IS READY TO BE TURNED OVER TO THE OWNER.
- ALL FIRE ALARM CIRCUITS SHALL BE IN CONDUIT, SURFACE RACEWAY OR OPEN RUN ABOVE CEILING, UNDER FLOORS AND IN WALLS IN A NEAT AND PROTECTED MANNER AS INDICATED ON DESIGN DOCUMENTS. EXPOSED CIRCUITS ARE ONLY PERMITTED WHEN NOTED AS EXPOSED ON DESIGN DOCUMENTS.
- FIRE ALARM PANEL, REMOTES, AND COMPONENTS SHALL BE SECURED TO MOUNTING SURFACES PER MANUFACTURERS SPECIFICATIONS. NO SINGLE DEVICE SHALL EXCEED THE WEIGHT OF 20 LBS. WITHOUT SPECIAL MOUNTING DETAILS.
- A DEDICATED BRANCH CIRCUIT SHALL BE PROVIDED FOR FIRE ALARM EQUIPMENT. THIS CIRCUIT SHALL BE ENERGIZED FROM THE COMMON USE AREA PANEL AND SHALL HAVE NO OTHER OUTLETS. THE BREAKER SHALL HAVE A RED LOCKING DEVICE TO BLOCK THE HANDLE IN THE 'ON' POSITION. THE CIRCUIT BREAKER SHALL BE LABELED "FIRE ALARM CIRCUIT CONTROL". CIRCUIT ID TO BE LABELED AT FIRE PANEL/EXTENDERS.
- THE INSTALLING CONTRACTOR SHALL PROVIDE A RECORD OF COMPLETION PER NFPA 72, FIGURE 10.18.2.1.1.
- CONTROL PANELS, REMOTE ANNUNCIATORS SHALL BE INSTALLED WITH THEIR BOTTOMS MOUNTED AT 48"
- THE INSTALLING CONTRACTOR SHALL PROVIDE SYSTEM PROGRAMMING FOR SUPERVISORY MONITORING PER CSC SECTION 901.6.2.
- SUPERVISORY MONITORING SHALL BE TESTED AND VERIFIED AS SENDING CORRECT SIGNALS IN CONJUNCTION WITH FINAL ACCEPTANCE TEST.
- OWNER SHALL BE RESPONSIBLE FOR ESTABLISHING A FIRE SYSTEM MONITORING CONTRACT OR PROVISIONS.

Ownership of Documents
This document, the ideas and designs incorporated herein, as an instrument of Professional Service is the property of Integrated Designs by SOMAM, Inc. and is not to be used, in whole or in part for any other project without written authorization. © COPYRIGHT 2013

Integrated designs by SOMAM, Inc.
ARCHITECTURE - ENGINEERING - INTERIOR DESIGN - CONSTRUCTION MANAGEMENT
101 N. Fremont, Suite 150 - Fresno, California 93710
Phone: (559) 436-0681 Fax: (559) 436-0687 E-Mail: design@somam.com
www.integrateddesigns.com

FIRE ALARM PLAN

Project Name & Address:
MT. VERNON ELEMENTARY SCHOOL
4 RELOCATABLE CLASSROOMS
BAKERSFIELD CITY SCHOOL DISTRICT
2161 POTOMAC AVE., BAKERSFIELD, CA

Issue Date: 00/00/14
Date: 05/28/14
Designer: J. CHONG
D.R.: J. CHONG
P.C.: CAM

Agency Approval Stamp:
FILE #15-6
IDENTIFICATION STAMP
DIV. OF THE STATE ARCHITECT
OFFICE OF REGULATION SERVICES
03-117168
AC: JLS
DATE: 10/5 0 4 2018
TRACKING #: DSA TRACKING NO

Stamp(s):



Job No.: **5125**

Sheet No.: **E-3**

Release:

CONSULTING ENGINEERS
JOHN CHONG ENGINEERING
3071 E. DELAUR AVE. FRESNO CA 93710
(559) 325-2366 - FAX 357-9441
jchong@jce.com

REGISTERED PROFESSIONAL ENGINEER
JOHN S. CHONG
E 14419
Exp. 6/30/2016
ELECTRICAL
STATE OF CALIFORNIA

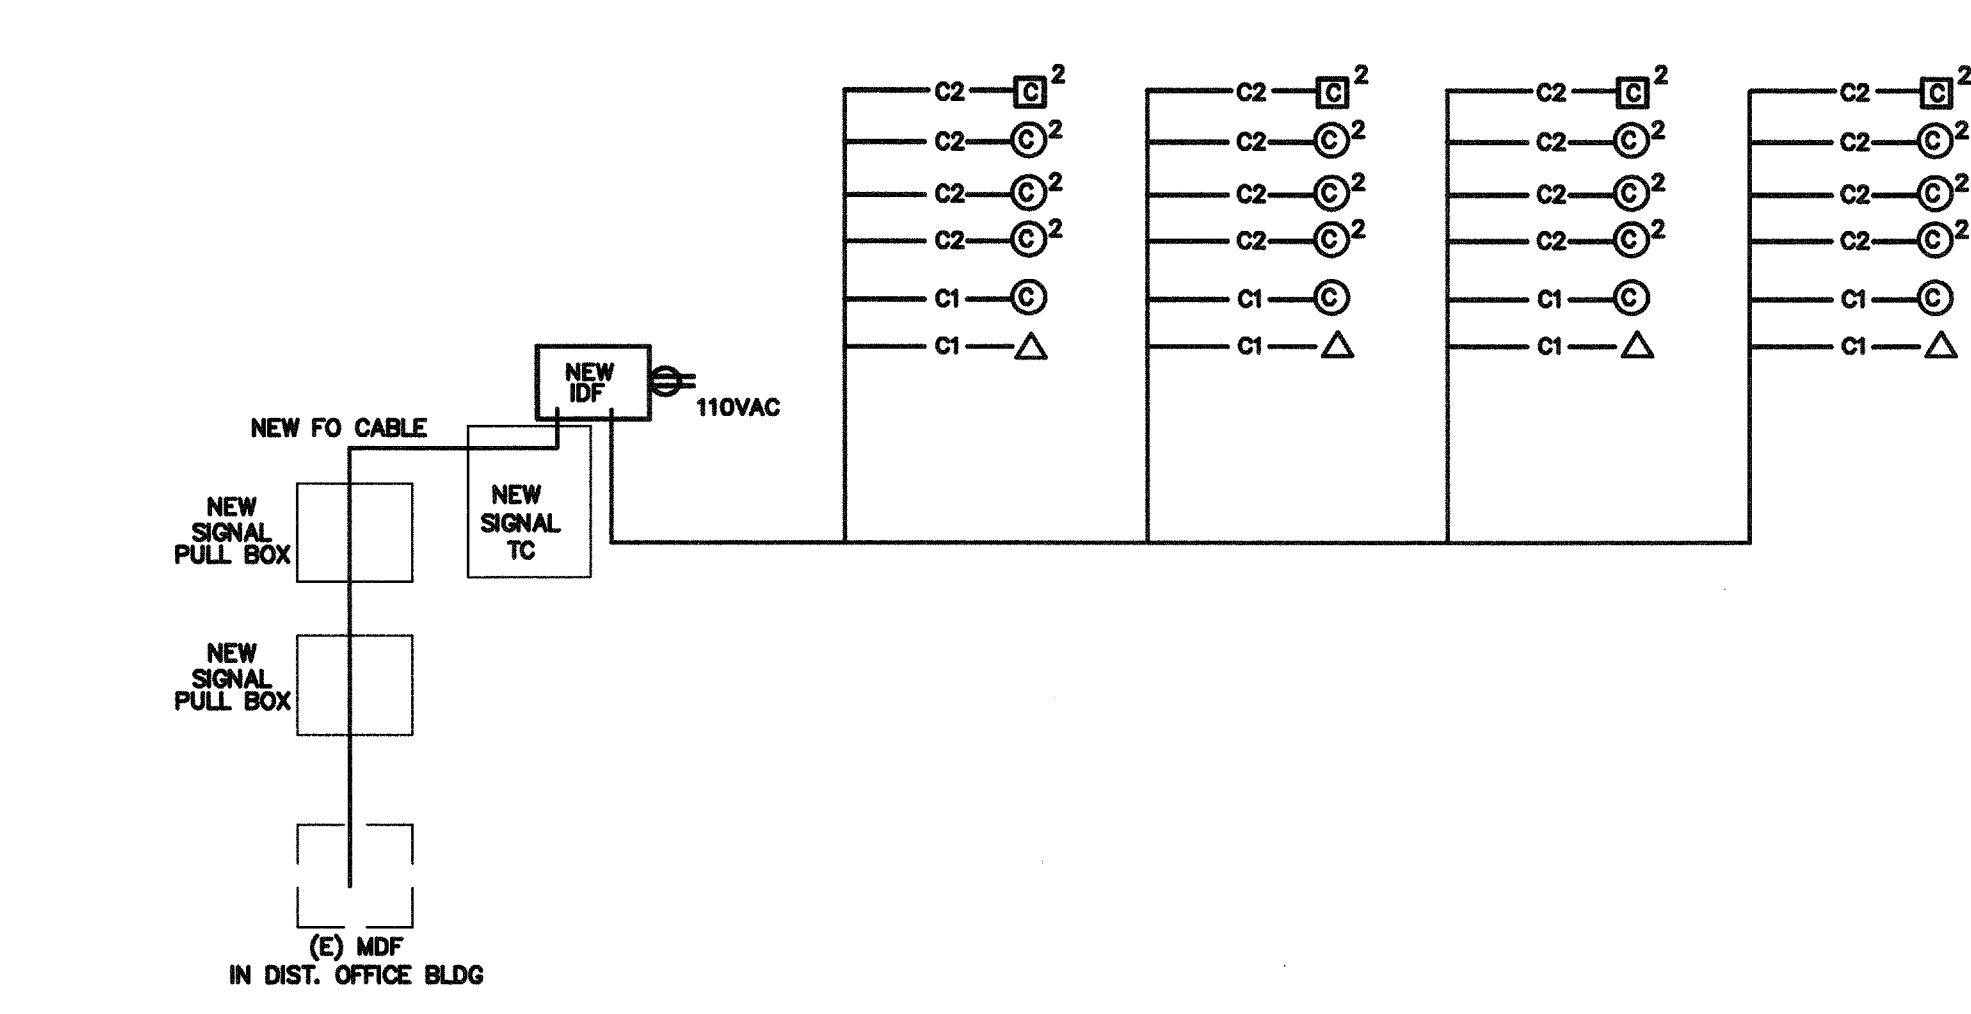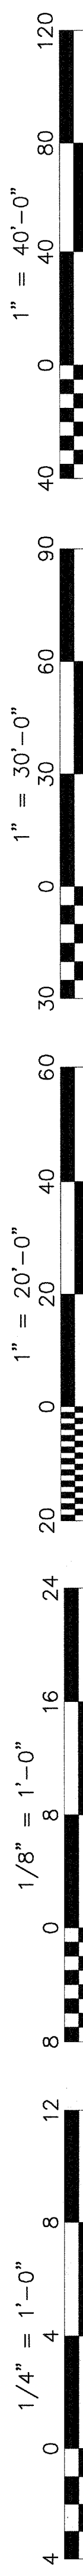


FIBER OPTIC CABLE
 THREE MULTIMODE PAIRS (SIX STRANDS) AND THREE SINGLE-MODE PAIRS (SIX STRANDS)
 OPTICAL CABLE COMPANY # DX 12/0650-8W35B/1UC-6SYMC-YMD/900-OFNR OF EQUAL
PLATE CABLE
 BENDP424-9L-BER-PV OR EQUAL
CABLE TESTING
 ALL FIBER OPTIC CABLE MUST BE TESTED TO SUPPORT 1000BASE-FX FULL DUPLEX STANDARDS,
 ALL CAT 5E CABLE MUST BE TESTED TO SUPPORT 100BASE-TX.
 TEST RESULTS ARE TO BE PROVIDED TO SCHOOL TECHNOLOGICAL SERVICES FOR REVIEW AND APPROVAL.

IDU SWITCH EQUIPMENT
 F/O CISCO WS-C2950G-24 W/ WS-C5484 GBIC
 TP CISCO WS-C2950-24
 CABINETS SOUTH WESTERN DATA PRODUCT SWE 4000-18UBDLK OR EQUAL
 JACKS ALLEN TEL AT55-16 OR EQUAL
 FACEPLATE ALLEN TEL AT30-2-09 OR EQUAL
 PATCH PANEL ALLEN TEL ATPHL-24 OR EQUAL


LABELING IDENTIFICATION
 ALL INSTALLED EQUIPMENT, CABLES, TERMINATIONS, ETC. WILL BE PERMANENTLY AND UNIQUELY MARKED. CABLES
 WILL BE MARKED USING A CONVENTION THAT WILL IDENTIFY ITS ORIGIN AND DESTINATION. LAN TERMINATIONS WILL
 SIMILARLY BE MARKED TO UNIQUELY IDENTIFY THEM WHILE PROVIDING THE SOURCE AND DESTINATION OF CABLE.
 IDENTIFICATIONS MUST BE SUCH THAT THEY WILL NOT RUB OFF, FALL OFF, OR EASILY BREAK AWAY.

DATA COMMUNICATION SYSTEM NOTES
 1. CONTRACTOR TO PROVIDE ALL EQUIPMENT, PATCH CABLE AND ACCESSORY FOR A FULLY FUNCTIONAL SYSTEM.
 2. NEW DATA JACK WIRING CONFIGURATION MUST BE MATCHED EXISTING SYSTEM. FIELD VERIFY PRIOR TO
 INSTALLATION.
 3. ADMINISTRATIVE NODE TO BE RED IN COLOR WITH THE INSTRUCTIONAL NODE TO BE BLUE IN COLOR. NODE
 LOCATION MUST BE 12" WITHIN POWER RECEPTACLE AND FIELD VERIFY EXACT LOCATION WITH OWNER PROJECT
 COORDINATOR OR TECHNOLOGICAL SERVICES PERSONNEL PRIOR TO INSTALLATION.
 4. ALL EQUIPMENT DOCUMENTATION AND WARRANTY INFORMATION WILL BE PROVIDED TO OWNER TECHNOLOGICAL
 SERVICES. WARRANTY CARDS WILL BE PROVIDED TO VUSD TECHNOLOGICAL SERVICES FOR FILING WITH
 MANUFACTURERS UPON COMPLETION OF INSTALLATION.


7 DATA COMMUNICATION SYSTEM RISER DIAGRAM N.T.S

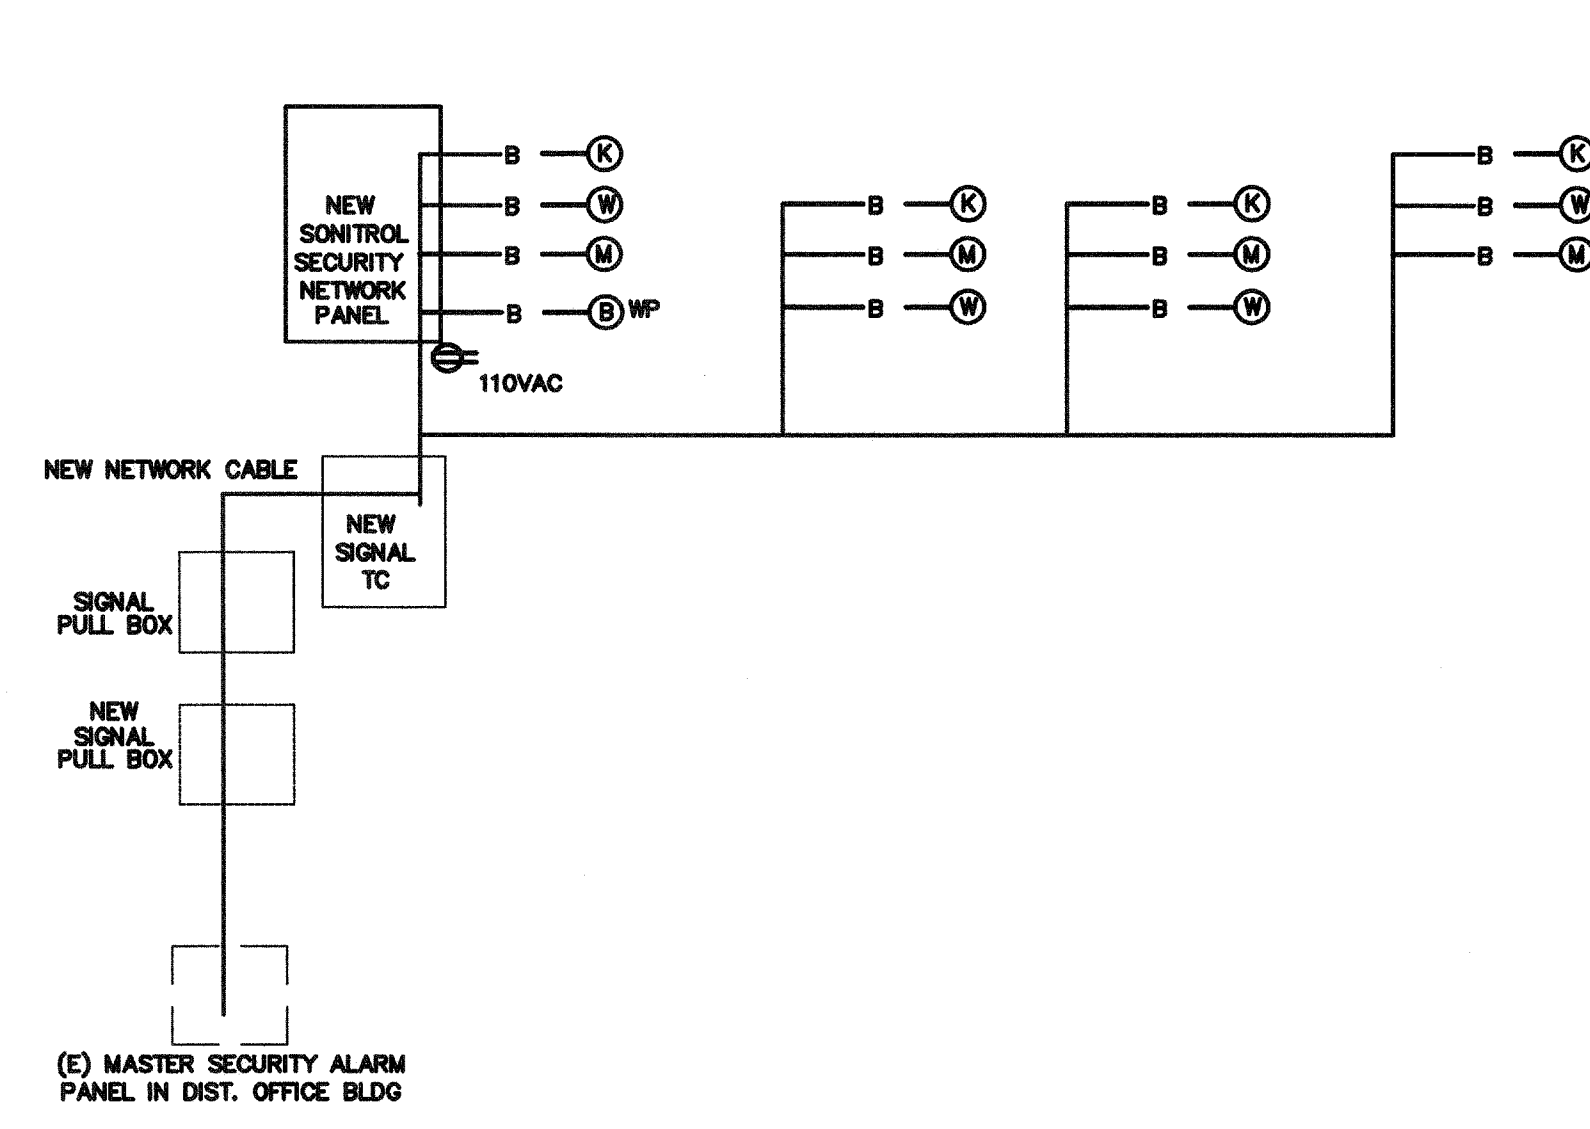

5 SECURITY ALARM SYSTEM RISER DIAGRAM N.T.S


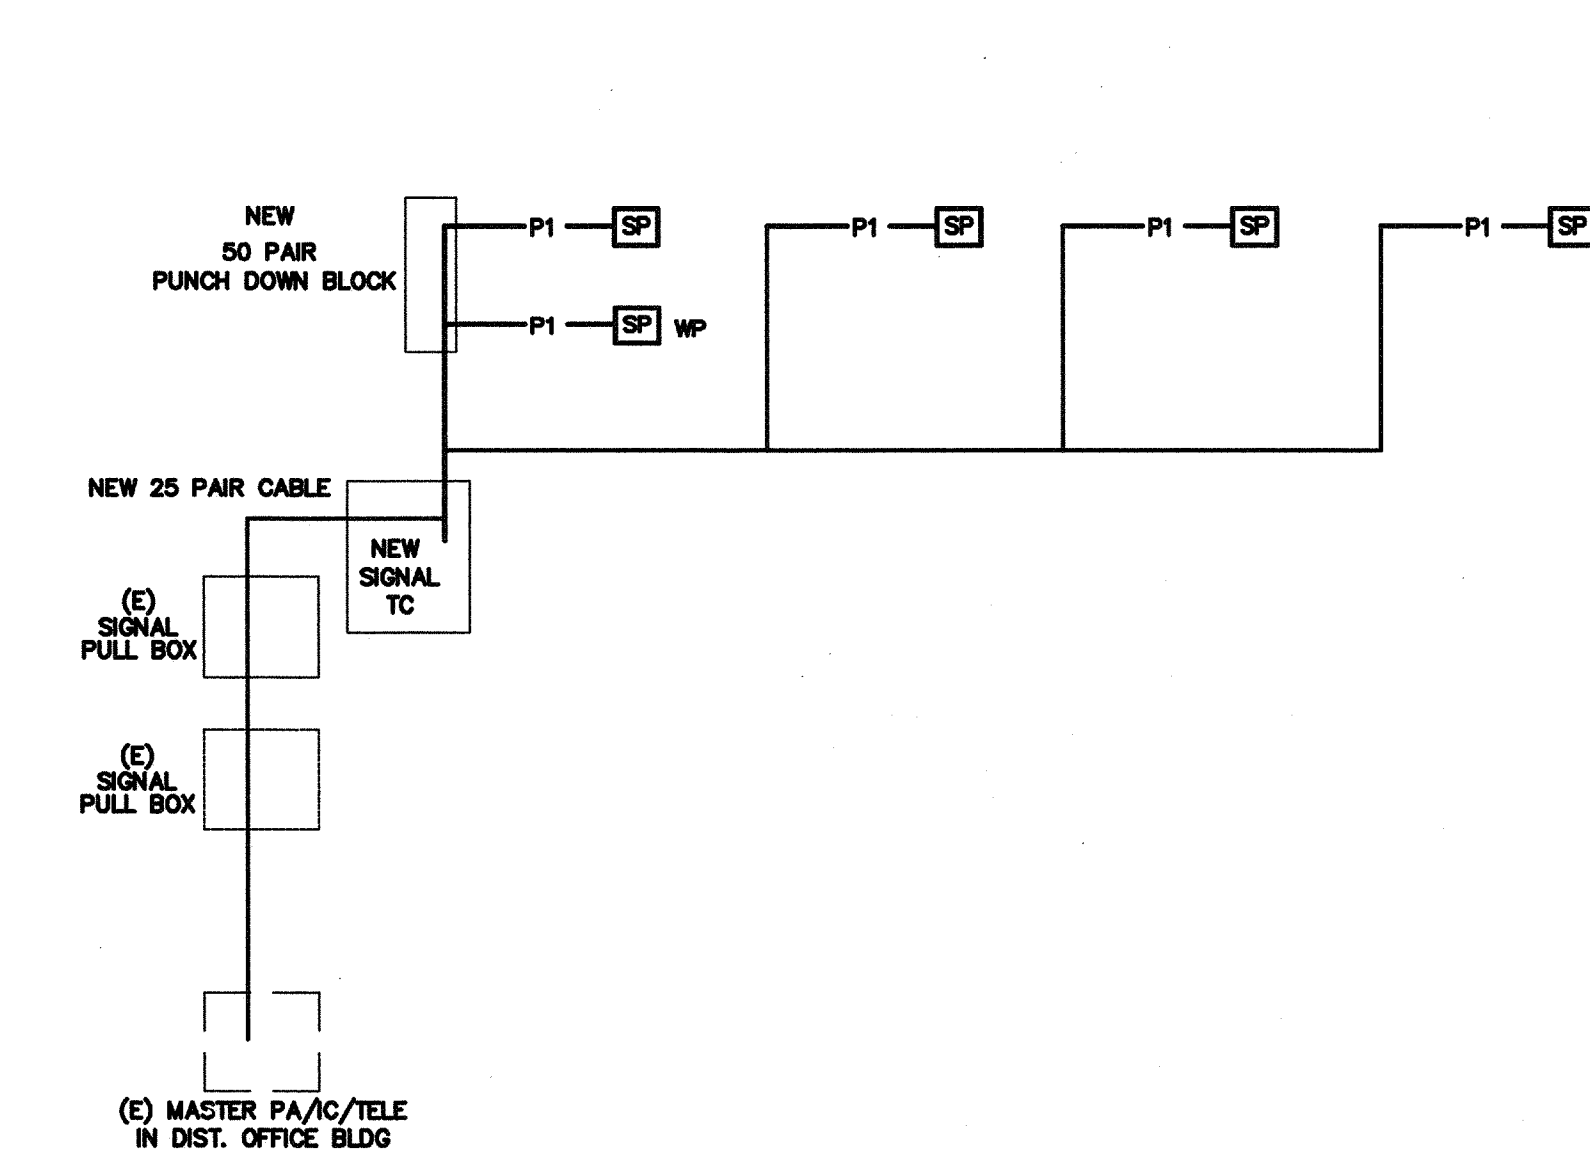


2 PA/IC/TELE SYSTEM RISER DIAGRAM N.T.S

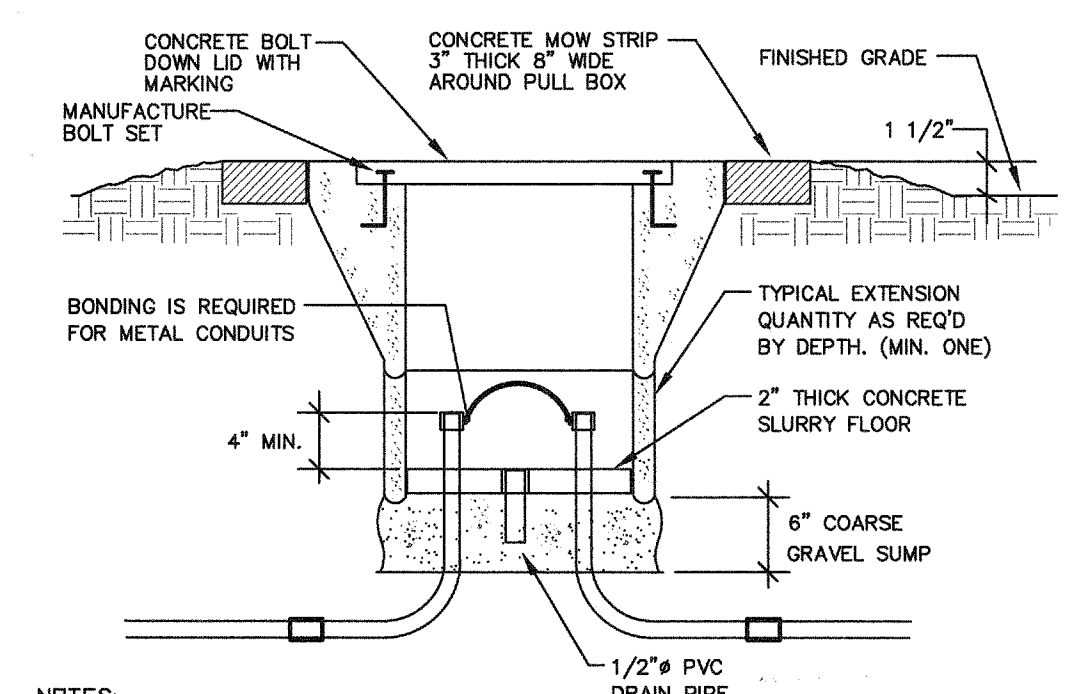


NOTES:
 WHERE PULL BOX IS LOCATED WITH IN 30" OF A FOUNDATION OR SIDE
 WALK, PULL BOX SHALL BE SET FLUSH WITH THE ADJACENT SURFACE, MOW
 STRIP CONCRETE SHALL BE POURED FLUSH WITH FOUNDATION OR SIDE WALK.

4 PULL BOX AT OPEN YARD DETAIL N.T.S

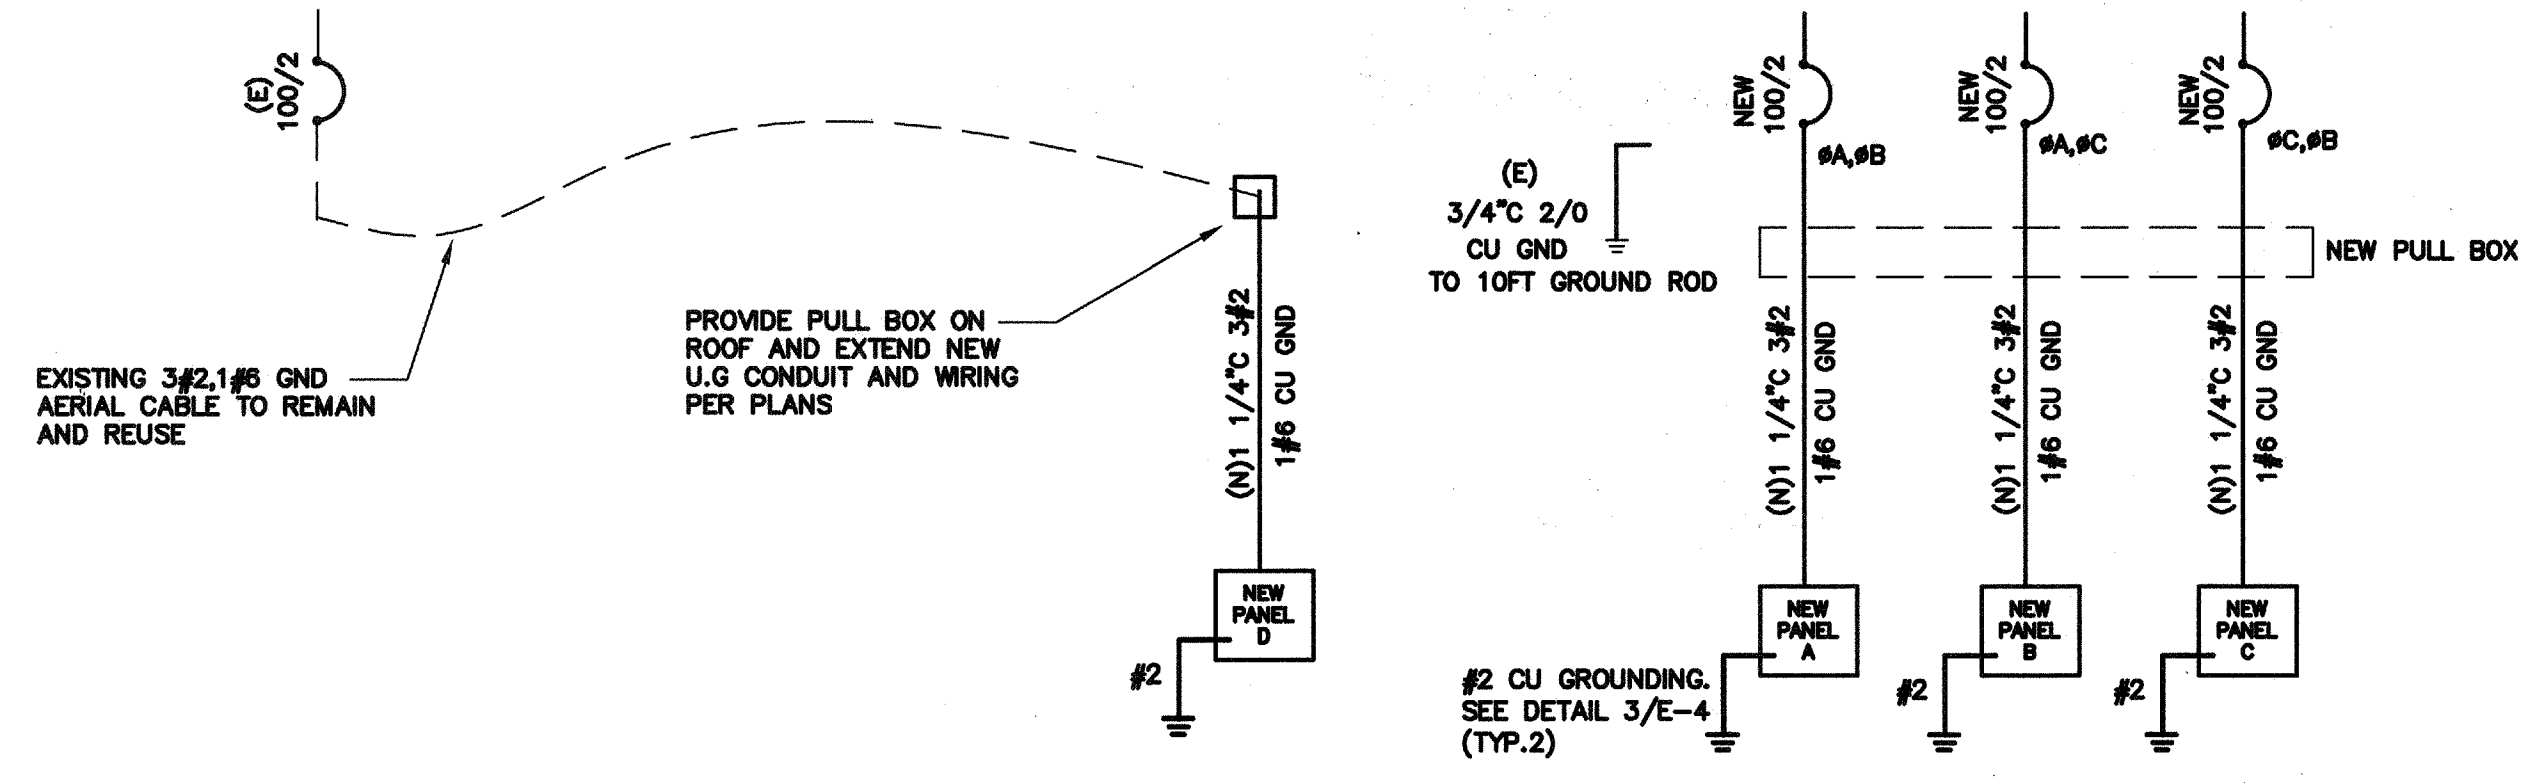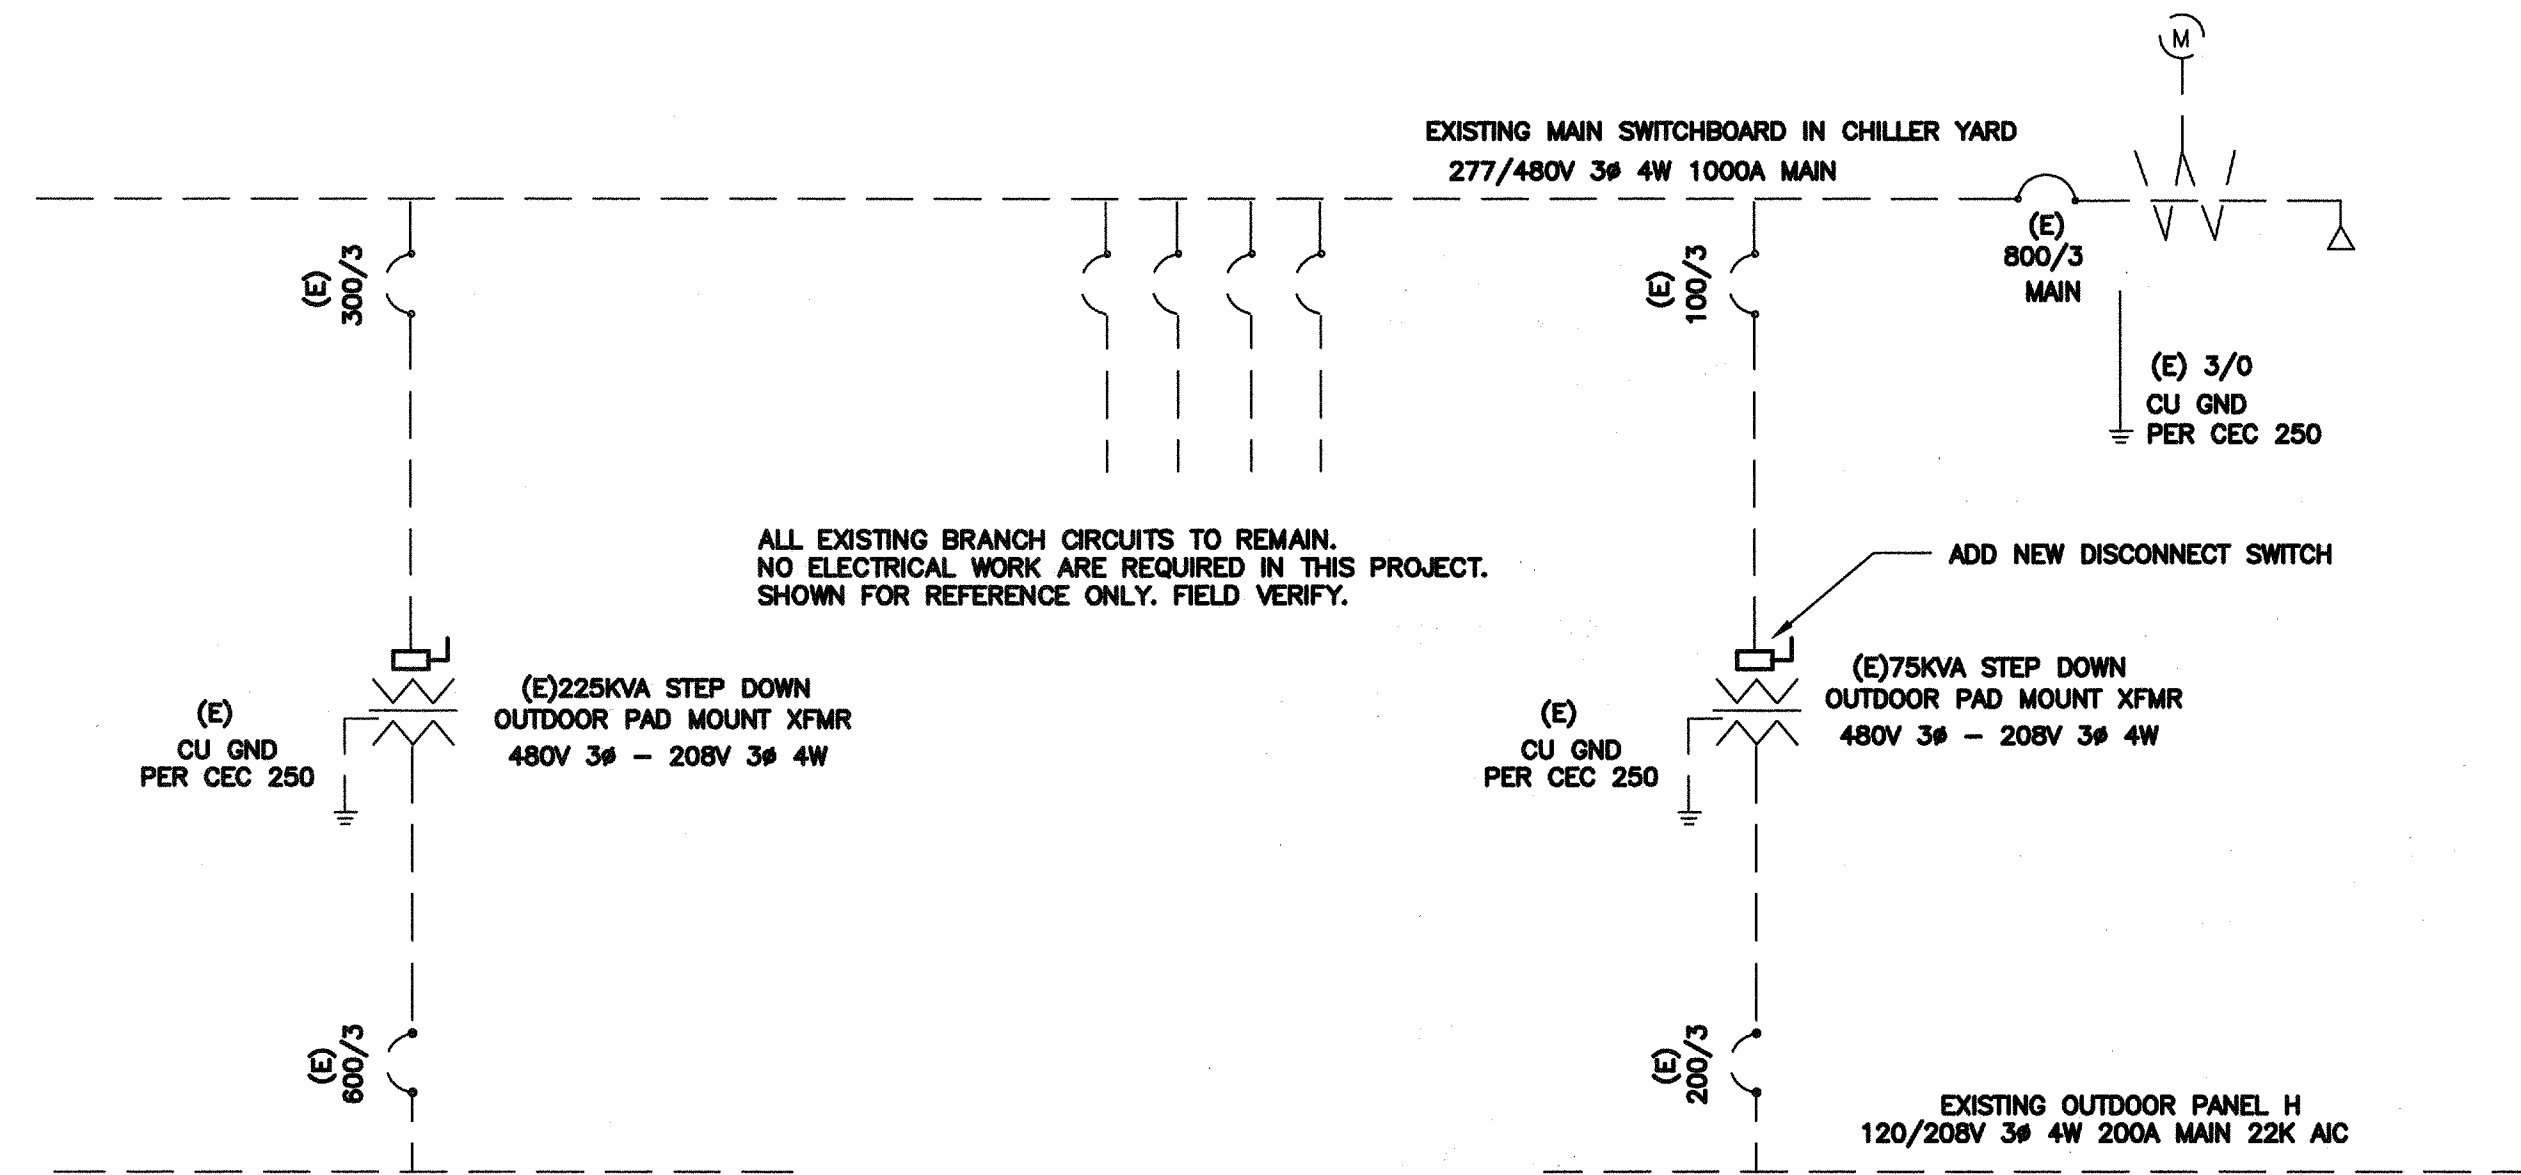


NOTES:
 1. PROVIDE NEW MATCHING BREAKERS, FEEDERS AND PANELS PER PLANS.
 2. ALL NEW CONDUCTOR SHALL BE 75°C THIN-2 COPPER IN CONDUIT. (AMPACITY FOR CONDUCTOR SELECTION MUST BE
 DETERMINED/DERATED BY THE ALLOWED TERMINATION RATINGS MARKED/APPROVED ON EACH DEVICES, MOTOR, APPLIANCE, XFMR
 O.C.P.C. PANEL, ETC. CONDUCTORS INSTALLED IN U.G OR WET LOCATIONS SHALL BE MARKER 'W'. PER 2013 CEC 110-14(C)(1).
 3. ALL WIRING OVER 100 VOLT SHALL BE INSTALLED IN RACEWAY CONDUIT, EMT ABOVE GRADE, PVC SCH. 40 BELOW GRAD AND STEEL
 CONDUIT ON EXPOSE SURFACE BELOW 8' AFF. FOR PHYSICAL PROTECTION.
 4. STEEL BACK BOX SHALL BE PROVIDE FOR ALL NEW ELECTRICAL DEVICES SUCH AS SWITCH, OUTLET AND CONDUCTOR SPLICE.
 5. ELECTRICAL CONTRACTOR IS RESPONSIBLE TO VERIFY THE EXISTING SWITCHBOARD AND PANELS ARE INSTALL PER ONE LINE
 DIAGRAM PRIOR TO WORKING, AND REPORT TO ENGINEERS IF ANY DISCREPANCY ARE FOUND.

1 SINGLE LINE DIAGRAM N.T.S

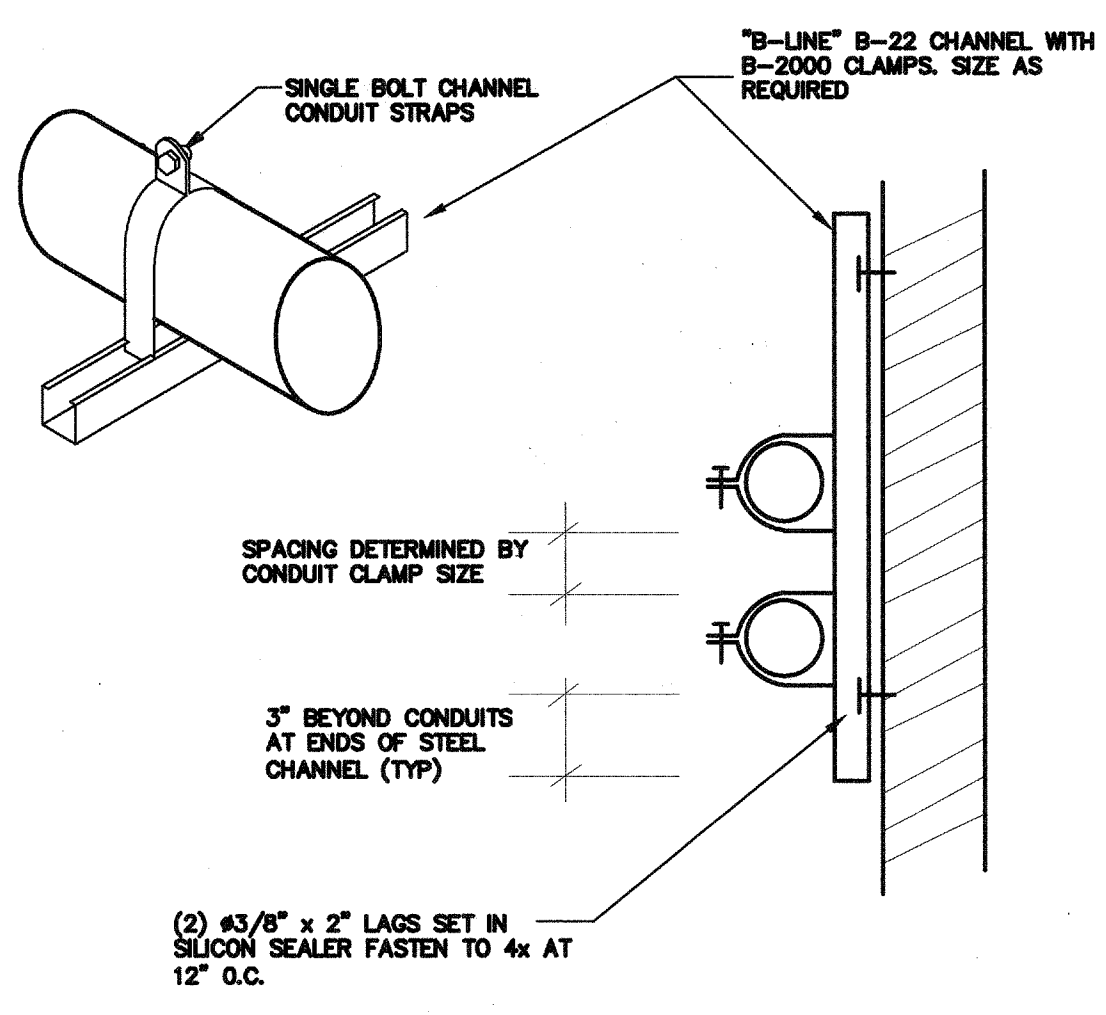

6 CONDUIT SUPPORT DETAIL N.T.S

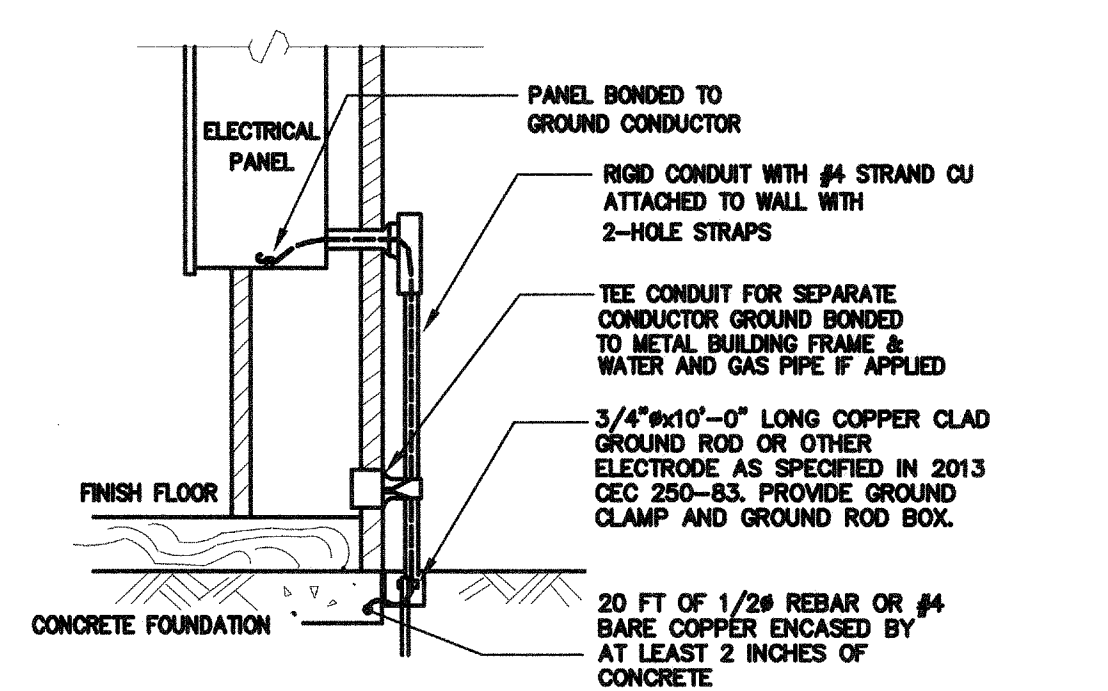

NOTES:
 1. SIZE OF CONDUCTORS SHALL COMPLY WITH 2013 CEC TABLE 250-66.
 2. BOND SEPARATE CONDUCTORS FROM GROUND ROD TO ELECTRICAL PANEL AND TO
 METAL BUILDING FRAME PER 2013 CEC 250-50. IN ADDITION TO THE DETAIL SHOWN
 ABOVE BOND THE ELECTRICAL GROUND TO METAL WATER PIPE EMBEDDED AT LEAST
 10 FT. IN SOIL IF AVAILABLE (CEC 250-50, 250-52).
 3. ALL MADE OF METAL FRAME BUILDINGS SHALL BE ELECTRICALLY BONDED TOGETHER,
 BOND TO HAND RAIL AND WATER PIPE IF APPLIED. (BOLTING ONLY IS NOT
 ACCEPTABLE BONDING).
 4. CHECK RESISTANCE TO GROUND. IF RESISTANCE EXCEED 25 OHMS, INSTALL
 ADDITIONAL GROUND RODS WITH CONDUCTORS AS SHOWN SEPARATED AT LEAST
 6'-0" UNTIL RESISTANCE IS REDUCED TO 25 OHMS OR LESS (2013 CEC 250-84).
 5. FIELD INSPECTOR SHALL WITNESS GROUNDING TEST.

3 GROUNDING DETAIL N.T.S

Ownership of Documents
 This document, the ideas and designs incorporated herein, as an instrument of Professional Service is the property of Integrated Designs by SOMAM, Inc. and is not to be used, in whole or in part for any other project without written authorization.
 © COPYRIGHT 2013

integrated designs by SOMAM, Inc.
 ARCHITECTURE • ENGINEERING • INTERIOR DESIGN • CONSTRUCTION MANAGEMENT
 1011 N. Fremont, Suite 130 - Fresno, California 93710
 Phone (559) 438-0881 Fax (559) 438-0887
 www.integrateddesigns.com E-Mail: design@somam.com


Rev. No.	Rev. Date	Revision Description

Issue Date: 00/00/14
 Date: 05/28/14
 Designer: J CHONG
 Drafter: J CHONG
 P.C.: CJM

Agency Approval Stamp:
 FILE # 15-6
 IDENTIFICATION STAMP
 DIV. OF THE STATE ARCHITECT
 OFFICE OF REGULATION SERVICES
 03-117168
 AC: FLS
 DATE: AUG 04 2018
 TRACKING #: DSA TRACKING NO

Job No: **5125**
 Sheet No: **E-4**
 Release:

CONSULTING ENGINEERS
JOHN CHONG ENGINEERING
 JOHN S. CHONG
 E 14419
 Exp. 8/30/2018
 ELECTRICAL
 STATE OF CALIFORNIA
 2071 E. REGATUR AVE. FRESNO CA 93710
 (559) 935-2266 • FAX 557-3441
 jcong1n@aol.com

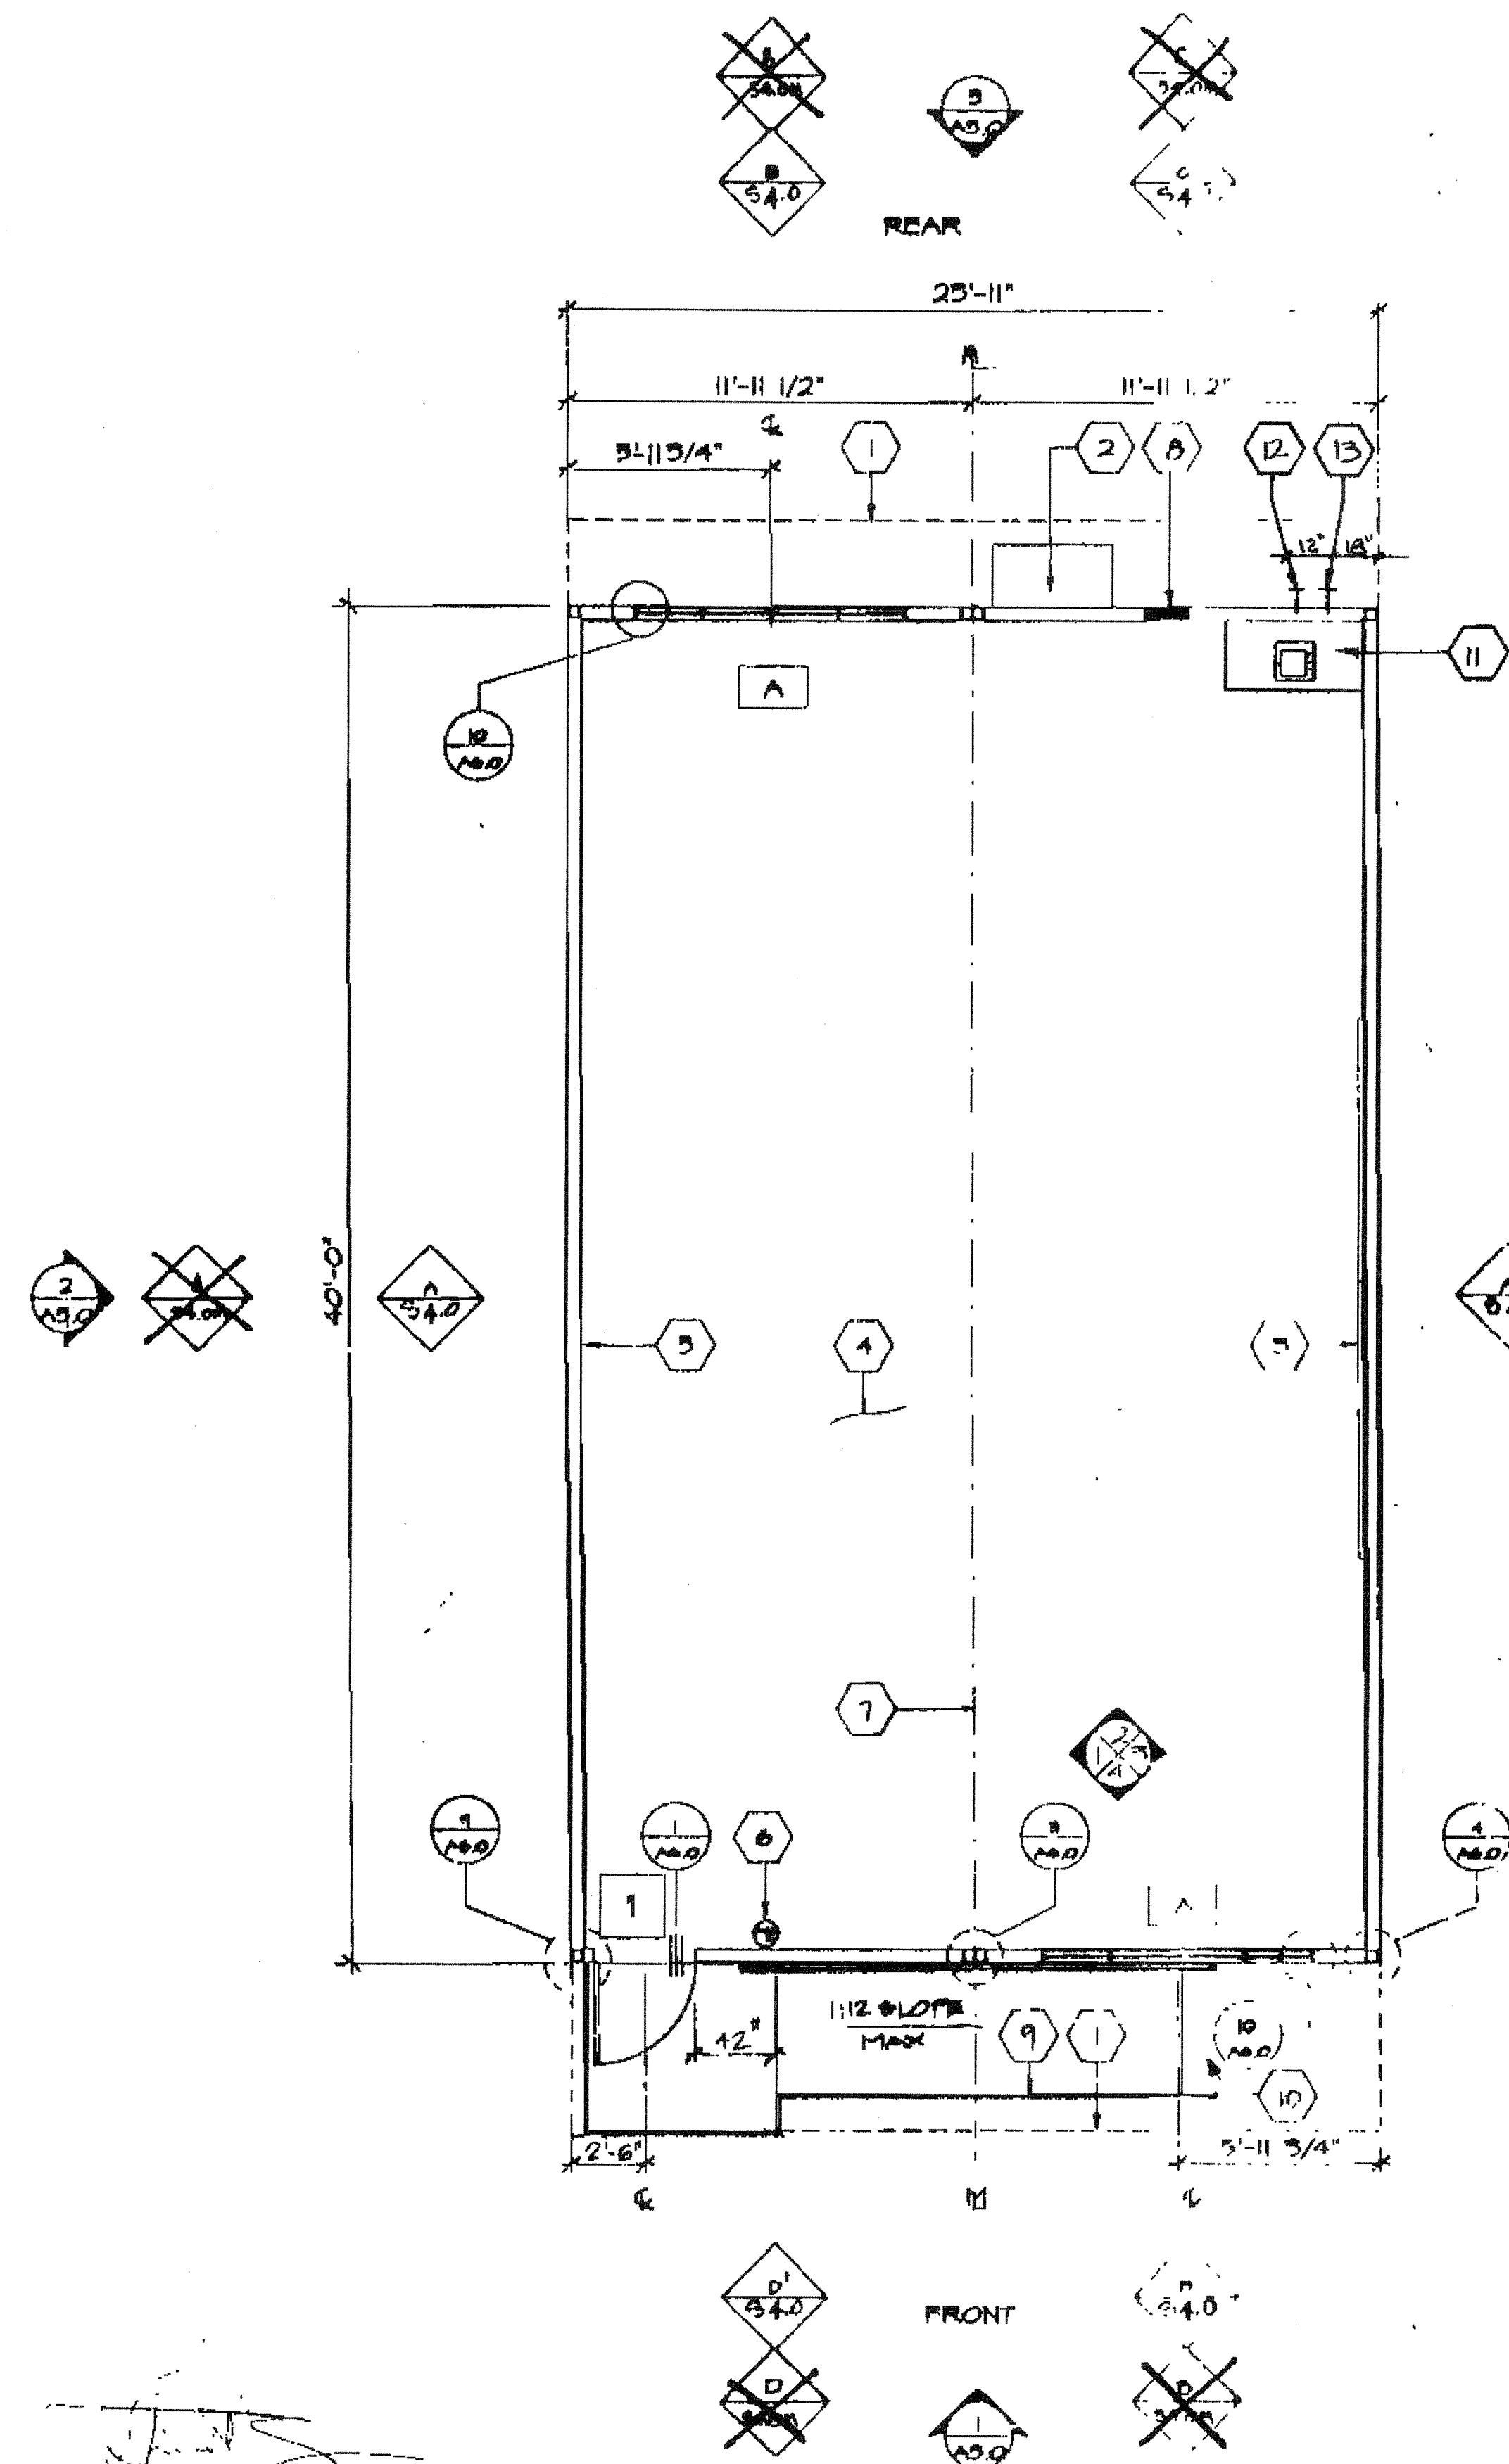

'A' SHOWN
'B' OPPOSITE
FLOOR PLAN

INTERIOR REFERENCE
SHEET A4.0

SCALE 1/4"=1'-0"


LEGEND

- 1 EXTERIOR DOOR SEE DOOR SCHEDULE
- A WINDOW (SEE SCHED. A5.0)


KEY NOTES

- 1 ROOF OVERHANG
- 2 HVAC UNIT - SEE M-1.0
- 3 2- 8'X4' MARKER BOARDS (SEE SPEC'S FOR TYPE)
- 4 FINISH FLOORING (SEE FINISH SCHED.)
- 5 TYPICAL INTERIOR FINISH (SEE FINISH SCHED.)
- 6 FIRE EXTINGUISHER - 5 LBS. DRY CHEMICAL WITH 2A-10BC UL RATING ON HALL MTD. RE. HANDLE AT 40"
- 7 MODLINE (X TYPICAL)
- 8 ELECTRICAL PANEL (SEE E1.0)
- 9 RAMP (SEE R1.0 & R2.0)
- 10 RAMP LANDING (SEE DET. 11 on Sht. R2.0)
- 11 ACCESSIBLE SINK CABINET. SEE A4.0 SINK. CRA-1725-A-GR 5" DEEP FAUCET: CHICAGO 350. BUBBLER: USB 10
- 12 COLD WATER POC.
- 13 WASTE POC.
- A METAL TAG ON ALL MODULES. MECHANICALLY ATTACHED TO REAR EXTERIOR OF BUILDING SHOWING DSA APPLICATION NUMBER, MANUFACTURER'S NAME AND SERIAL NUMBER AND ROOF & FLOOR DESIGN LIVE LOAD.

NOTE:
SINK CABINET OPTIONAL

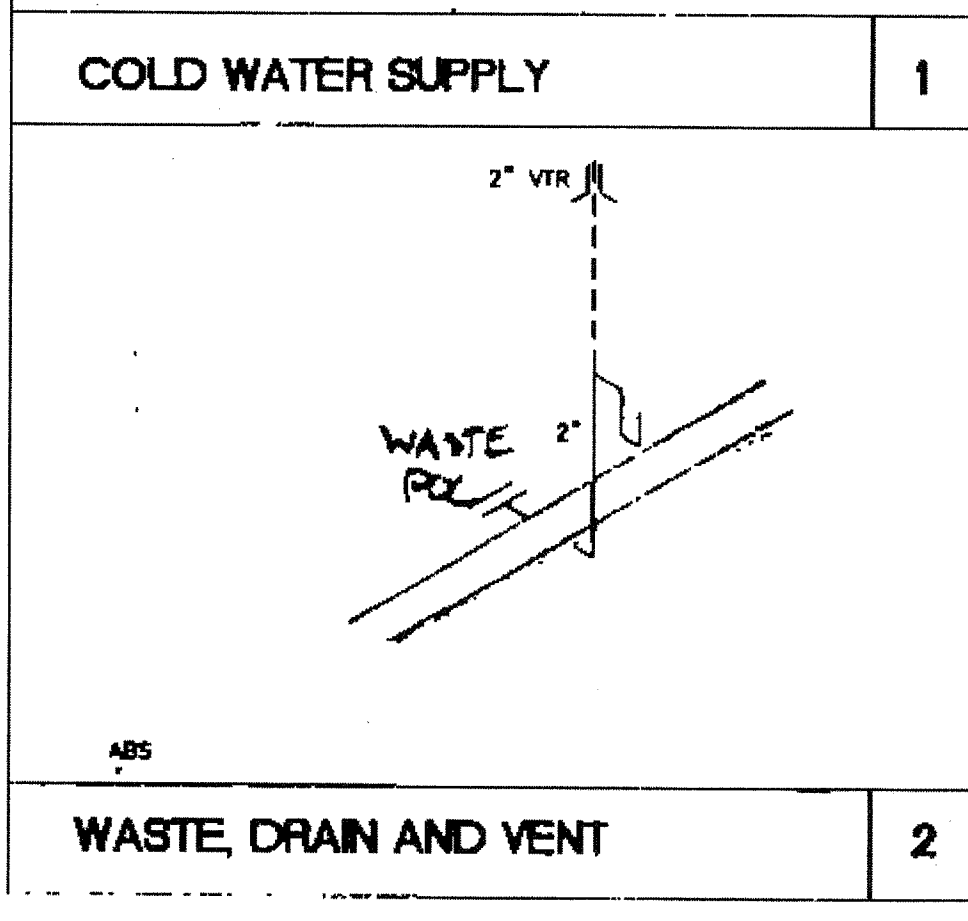


REVISED

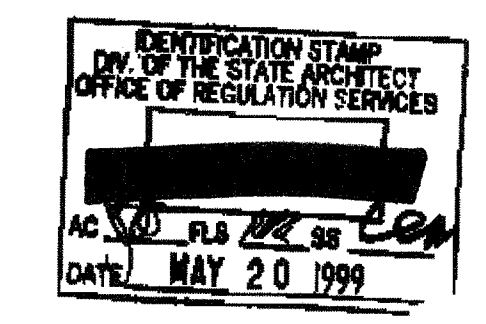

IDENTIFICATION STAMP
DIV. OF THE STATE ARCHITECT
OFFICE OF REGULATION SERVICES
APP#3 117168
Date AUG 04 2018

1/30/15 OBA HANDICAP ENVIRONMENT

ARCHITECT	ELECTRICAL	STRUCTURAL	MECHANICAL	FIRE MARSHAL	ACCESS COMPLIANCE	STRUCTURAL SAFETY

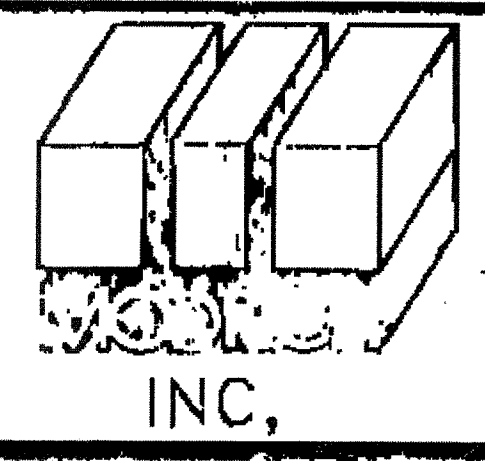

FLOOR PLAN


A1.0A

LEGEND

- 1 EXTERIOR DOOR (SEE DOOR SCHED)
- A EXTERIOR WINDOW (SEE FINISH SCHED)


KEY NOTES

- 1 TYPICAL EXTERIOR SIDING (SEE FINISH SCHED)
- 2 EXTERIOR LIGHT FIXTURE (SEE SPECIFICATIONS)
- 3 TOP OF SKIRTING
- 4 RAMP AND LANDING SEE SHT R-1.0
- 5 HVAC UNIT SEE SHT M-1
- 6 DOWNSPOUT (TYP) FASTEN TO DLOG TYP 2 PLACES (SEE (YAG.))
- 7 CONTINUOUS GUTTER WITH DOWNSPOUT (LOCATION OF DOWNSPOUT SHOWN ON ROOF PLAN A2.0)
- 8 SPLASH BLOCK (BY OTHERS)
- 9 FINISH FLOOR LINE
- 10 BOTTOM FLANGE OF FLOOR BEAM
- 11 ROOF HEADER
- 12 VENT SEE FOUNDATION PLAN
- 13 FINISH GRADE
- 14 ROOF BEAM (SEE STRUCTURAL)
- 15 COLUMN (SEE STRUCTURAL)
- 16 ELECTRICAL STUD-OUT (1/4"Ø) (TYPICAL)
- 17 GROUND STUD-OUT 1/2"Ø (TYPICAL)
- 18 FIRE ALARM HORN NIC.
- 19 NEMA 6"X6" GUTTER BOX
- 20 P.I.D.U.T.E

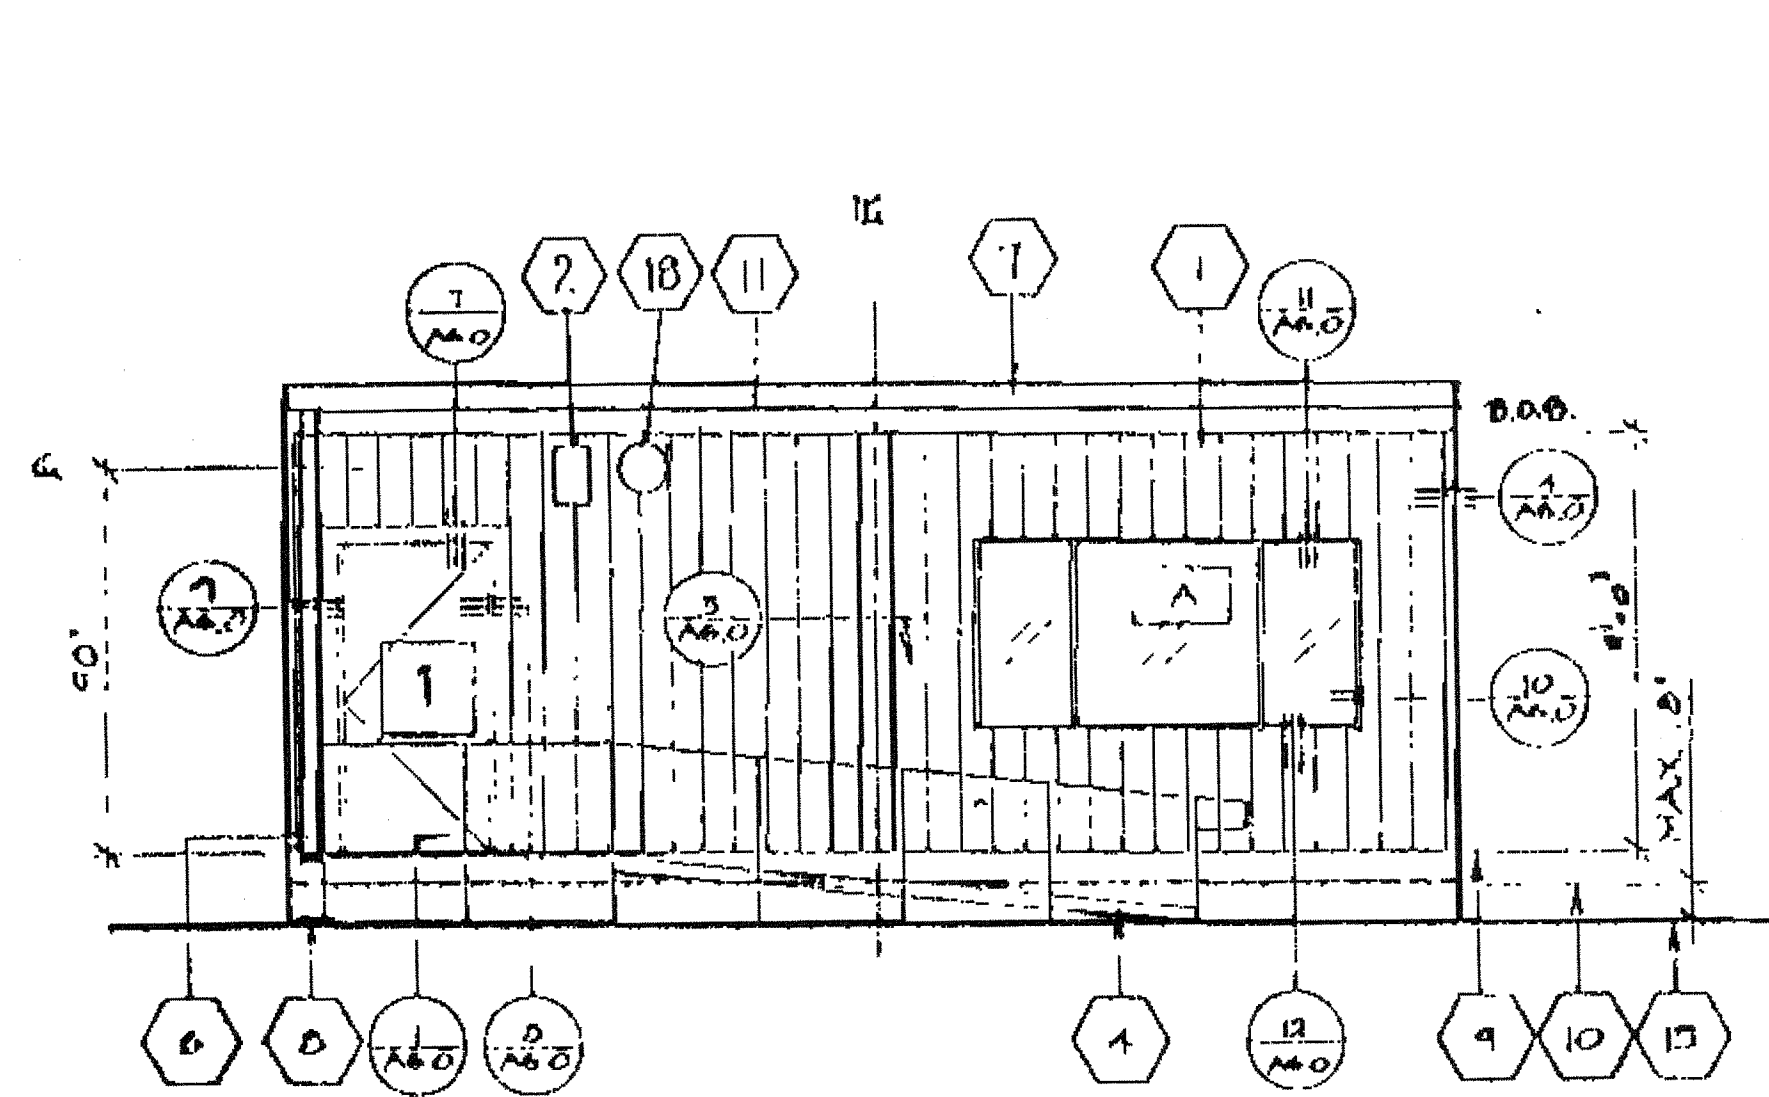


① FRONT ELEVATION

SCALE 1/4"=1'-0"

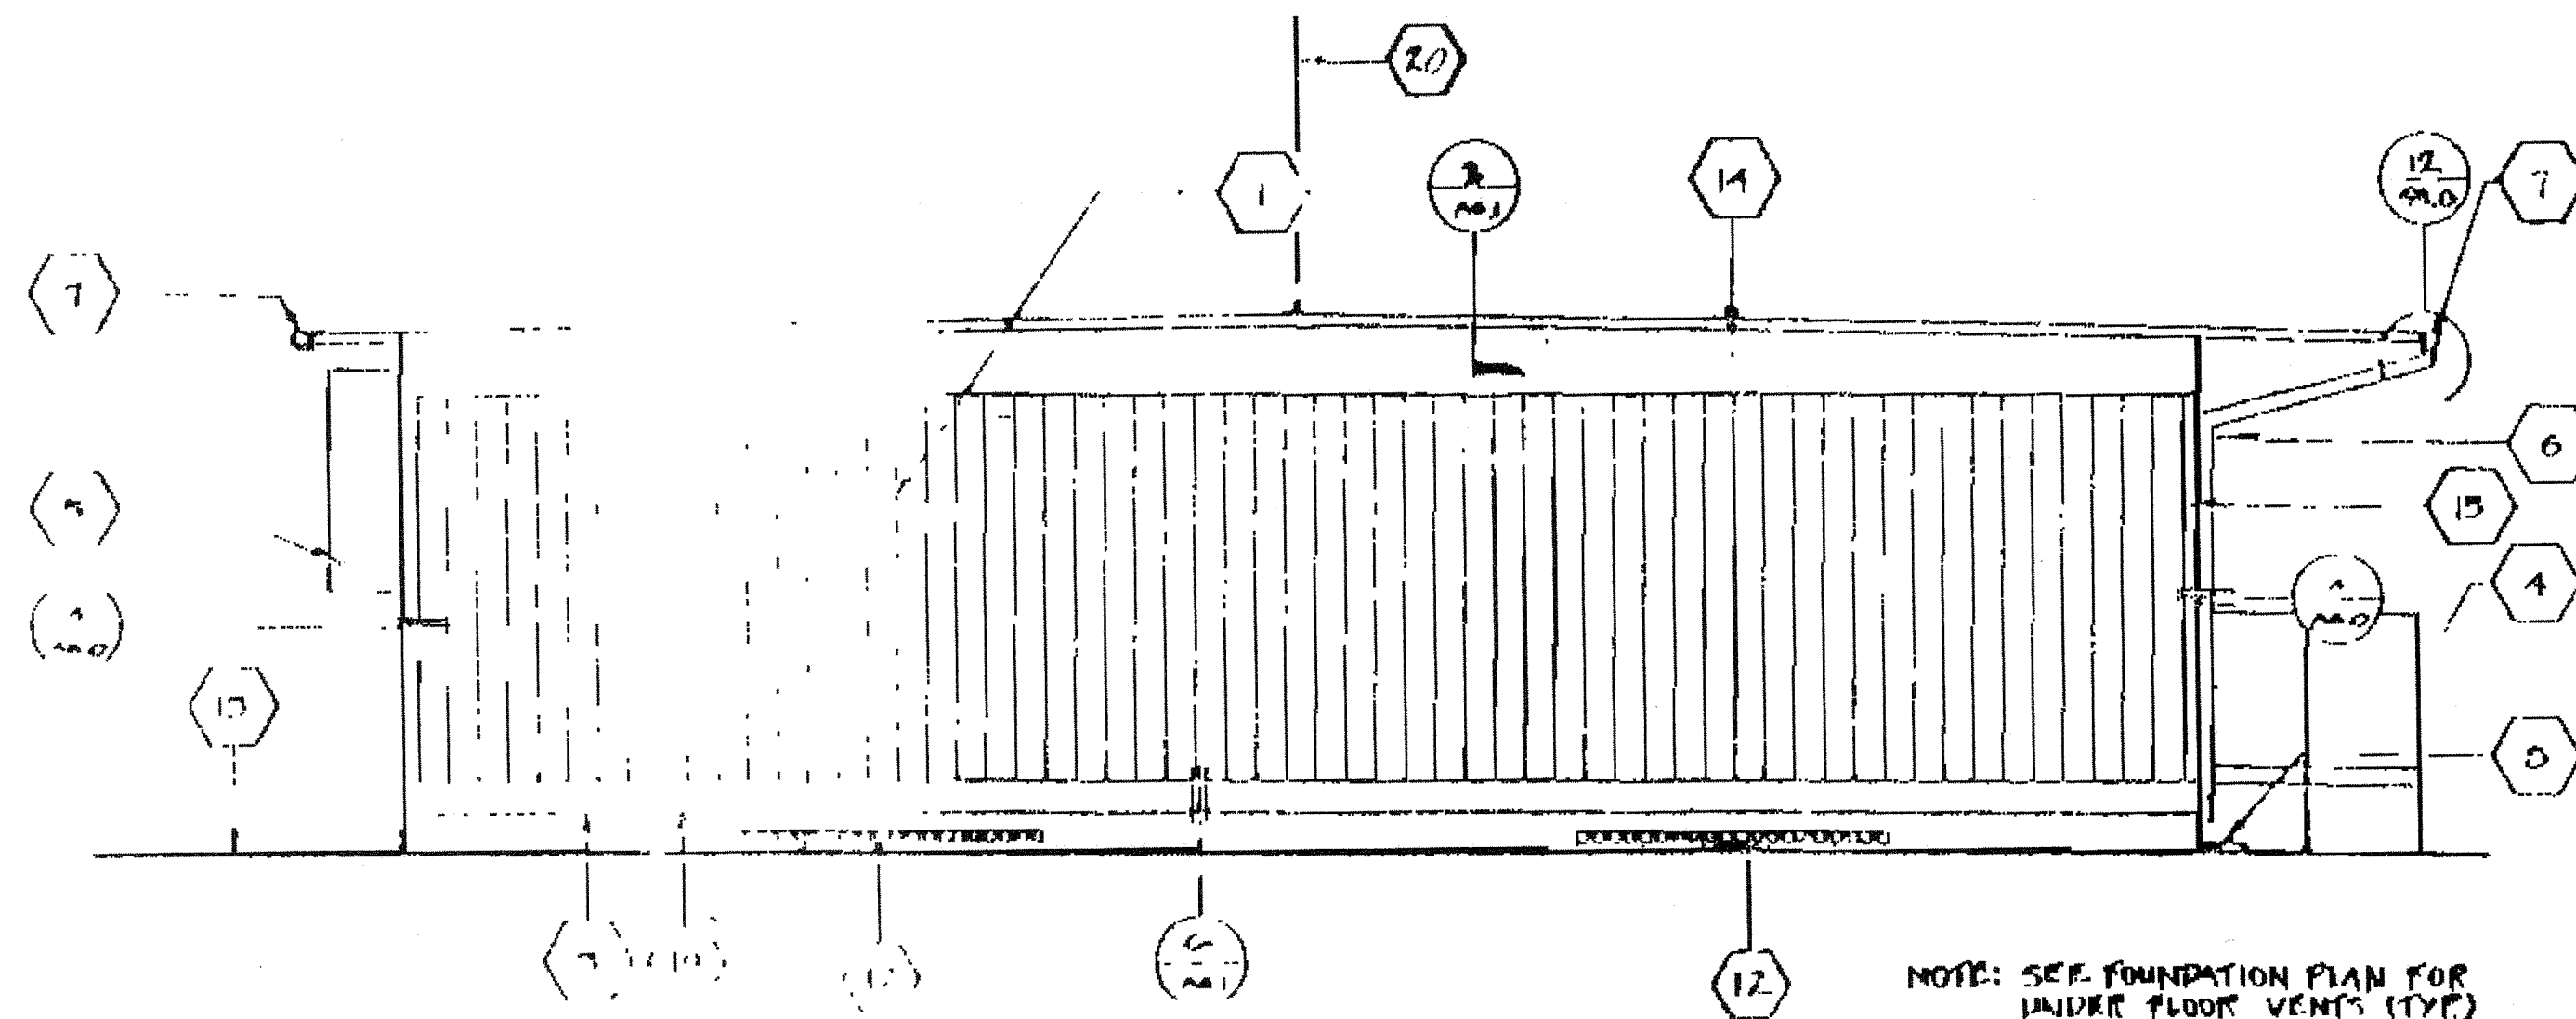


② SIDE ELEVATION

SCALE 1/4"=1'-0"

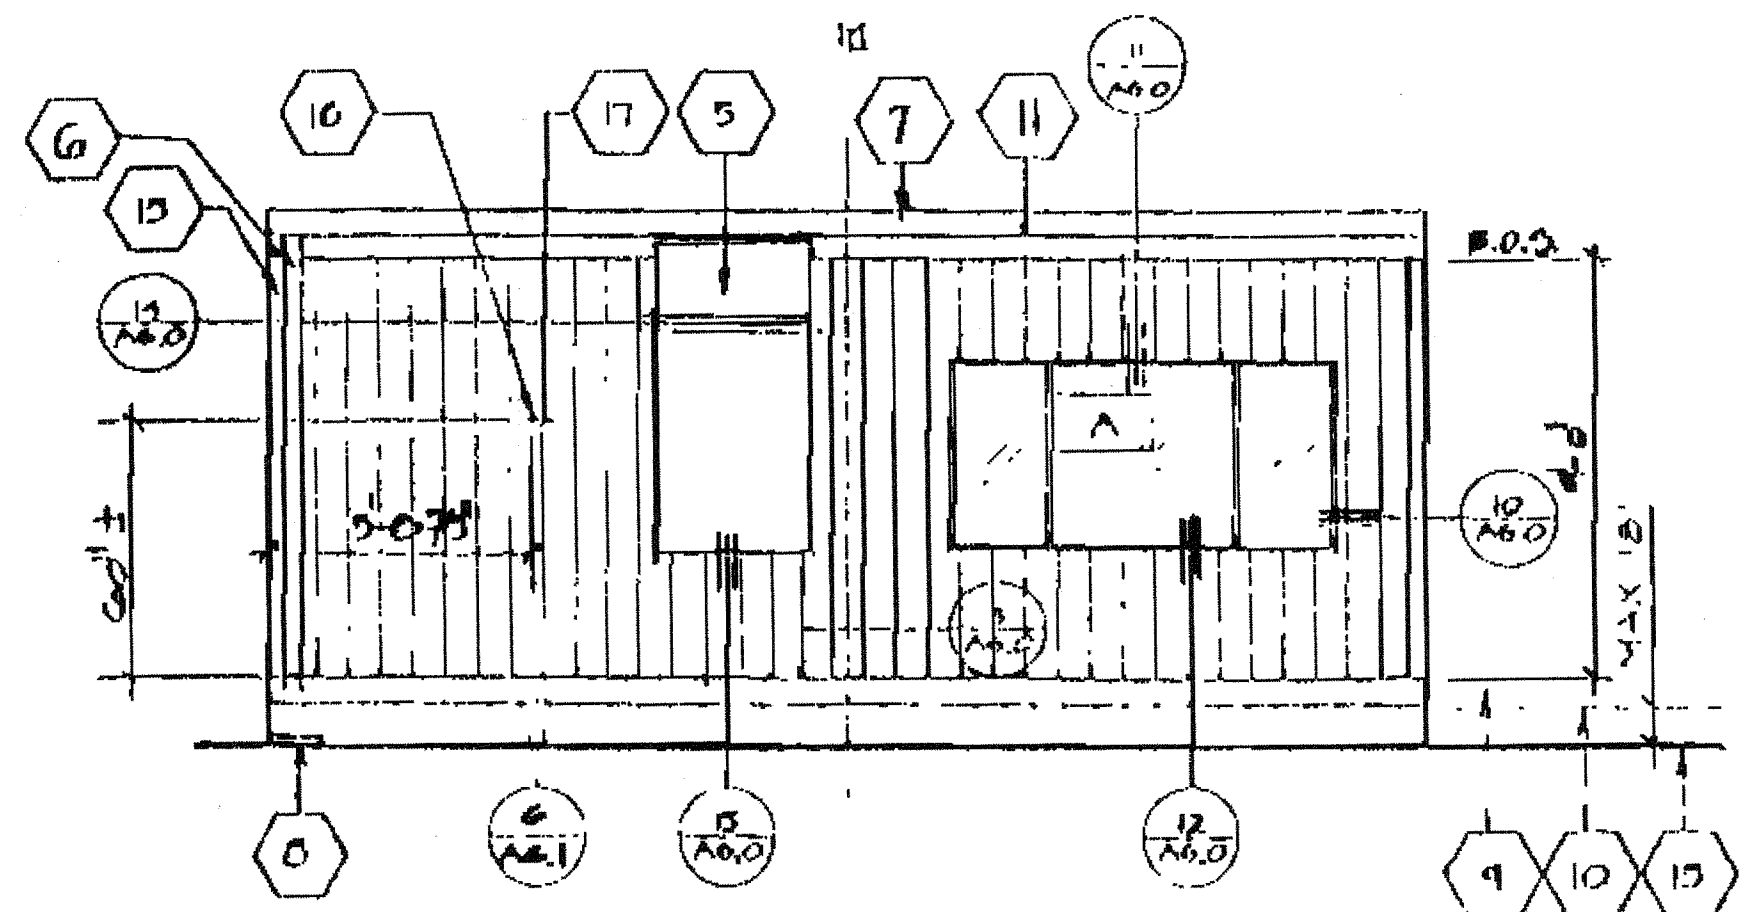

③ REAR ELEVATION

SCALE 1/4"=1'-0"

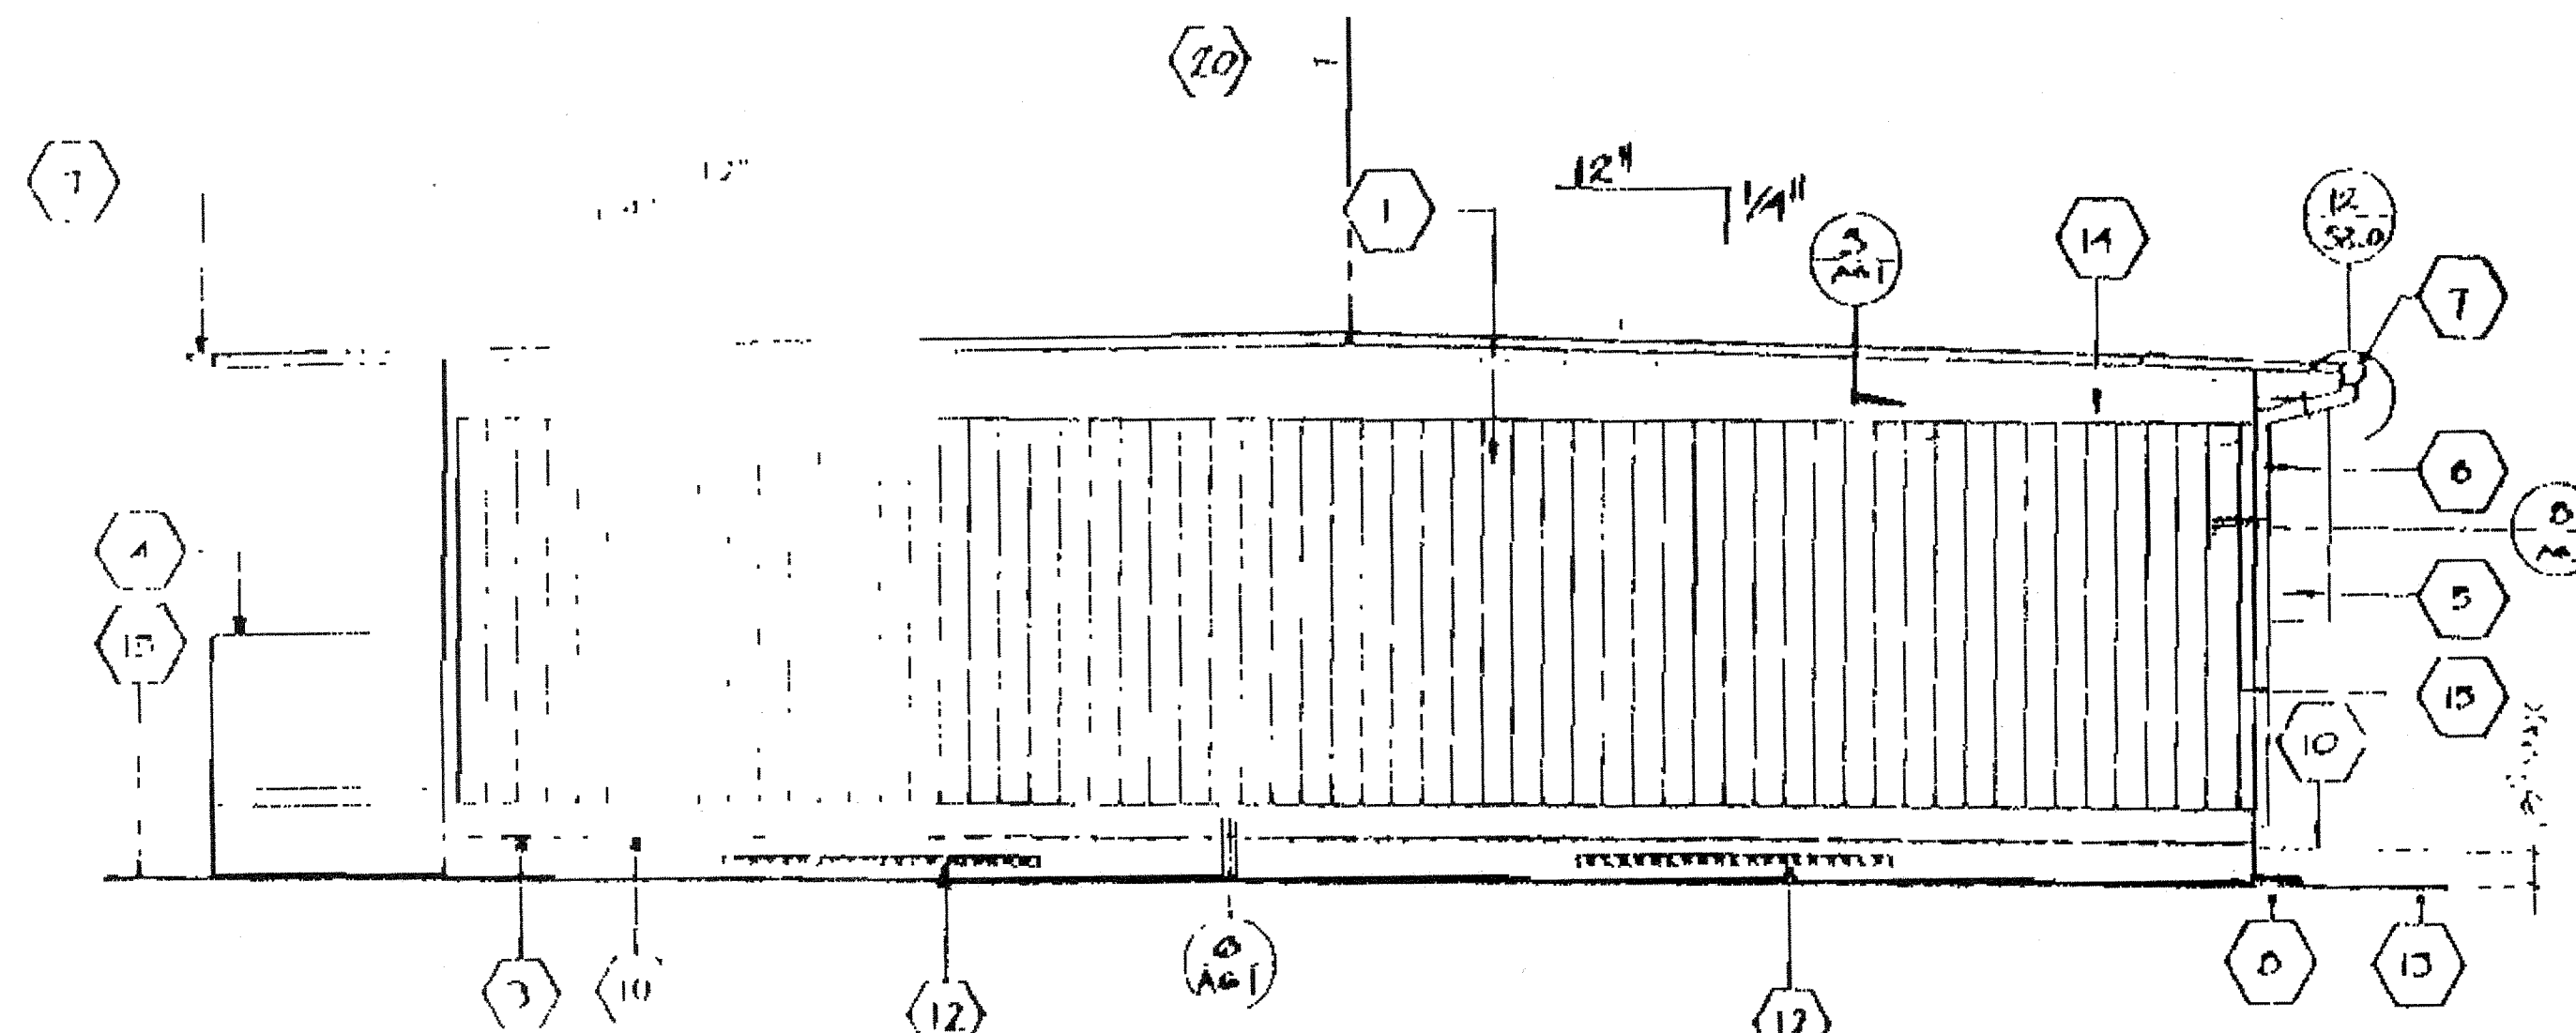

④ SIDE ELEVATION

SCALE 1/4"=1'-0"

NOTES:
SEE FOUNDATION PLAN FOR
SIZE & LOCATION OF VENTS.

"A" SHOWN
"B" OPPOSITE




IDENTIFICATION STAMP
DIV. OF THE STATE ARCHITECT

APP#3 117168

AC / FLS / SS TH
Date AUG 04 2018



ARCHITECT	ELECTRICAL	STRUCTURAL	MECHANICAL	FIRE MARSHAL	ADDITIONAL COMPLIANCE	STRUCTURAL SAFETY
-----------	------------	------------	------------	--------------	-----------------------	-------------------

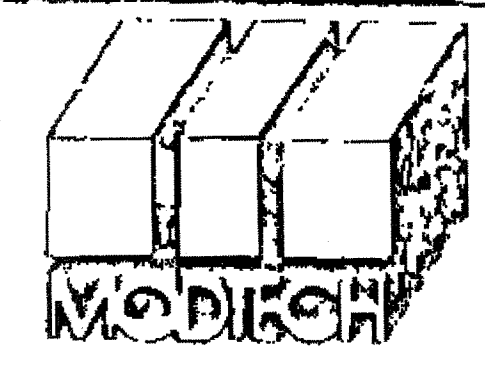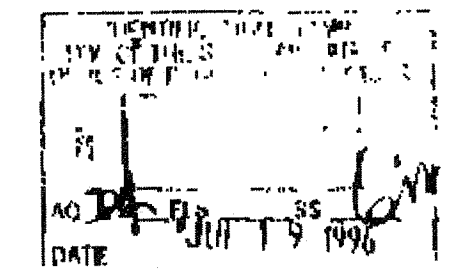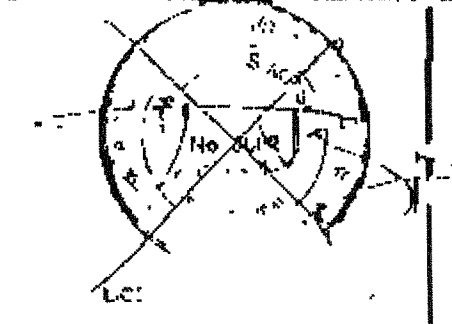


DRAWN BY	DATE
CHECKED BY	DATE

24'X40' DUAL PITCH A3.0A

"MACHINE APPLIED 16d FASTENERS SHALL HAVE AN EMBEDMENT OF NOT LESS THAN 1/2" INTO SECOND MEMBER, AND SHALL BE NOT LESS THAN 3" IN OVERALL LENGTH"

THE ABOVE NAILS SHALL ALSO BE ACCEPTABLE FOR HAND NAILING, PROVIDED THE REQUIRED EMBEDMENT IS MAINTAINED

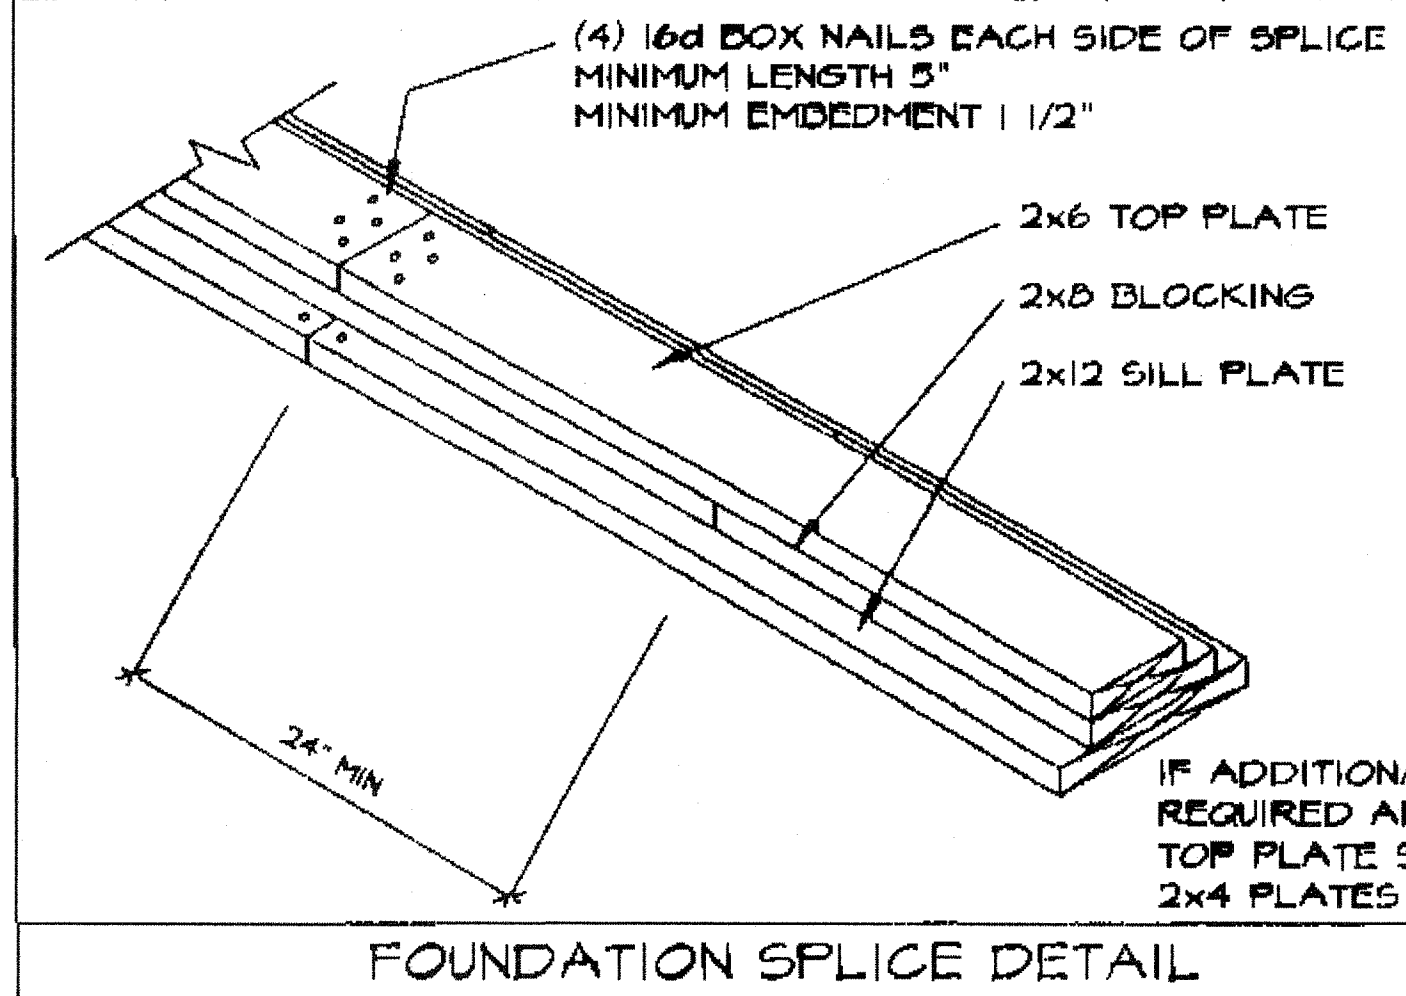


KEY NOTES

- 1 2"x6" SILL PLATE (END WALL)
- 2 6- 2X12X30" LONG SILL PADS
- 3 PIPE TO GRADE (TYP.)
- 4 3" HIGH BY 6'-6" LONG VENT
- 5 2X12 SILL PLATE (SIDE WALL)
- 6 4-2X12X30" LONG SILL PADS
- 7 6"x12"x10 GA. PLATES
- 8 1" Ø PIPE EA. END EA. PAD AT ADJ. BLDG. LINE
- 9 5/8" Ø X4" LAG (4-PER BLDG. MIN.)
- 10 6- 2X12X30" LONG SILL PADS


GENERAL NOTES:

- A. SOIL RESTRAINT: ON A.C. PAVING AND ON SOIL 1" O.D. GALVANIZED PIPE AT 10'-0" 12" PENETRATION BELOW SURFACE VERTICALLY. DRILL SILL 1-1/4" MAX. PIPE MAY BE DRIVEN MAX. OF 45° ANGLE TO VERTICAL. (18-1/2" LONG PIPE REQUIRED FOR PENETRATION AT 45° ANGLE)
- B. ON CONCRETE PAVING HILTI D5 D2-P10 THRU SILL PLATE:
END WALLS: 8" O.C.
SIDE WALLS: 22" O.C.
- C. WHERE SHIM STOCK IS REQUIRED FOR LEVELING USE 1/4", 1/2", OR 3/4" THICK PLYWOOD SAME WIDTH AS BLOCK. P.T.
- D. VERIFY DRAINAGE TO PREVENT WATER FROM FONDING BENEATH THE STRUCTURE. WITH DISTRICT ARCHITECT SITE PLANS
- E. ALL FOUNDATION MATERIAL SHALL BE HEM FIR
GROUND CONTACT: LP-22 (CCA 40)
ABOVE GROUND: LP-2 (CCA 25)
- F. FOUNDATION DESIGNED FOR 1000 PSF SOIL BEARING PRESSURE PER ORS IR 23-6.
ABOVE GROUND: LP-2

3" X 24" END WALL VENTS AS REQUIRED FOR ADJACENT BUILDING APPLICATIONS MIN. 10" FROM BLDG. CORNERS MIN. 10" FROM MODLINES MIN. 12" BLOCKING BETWEEN VENTS

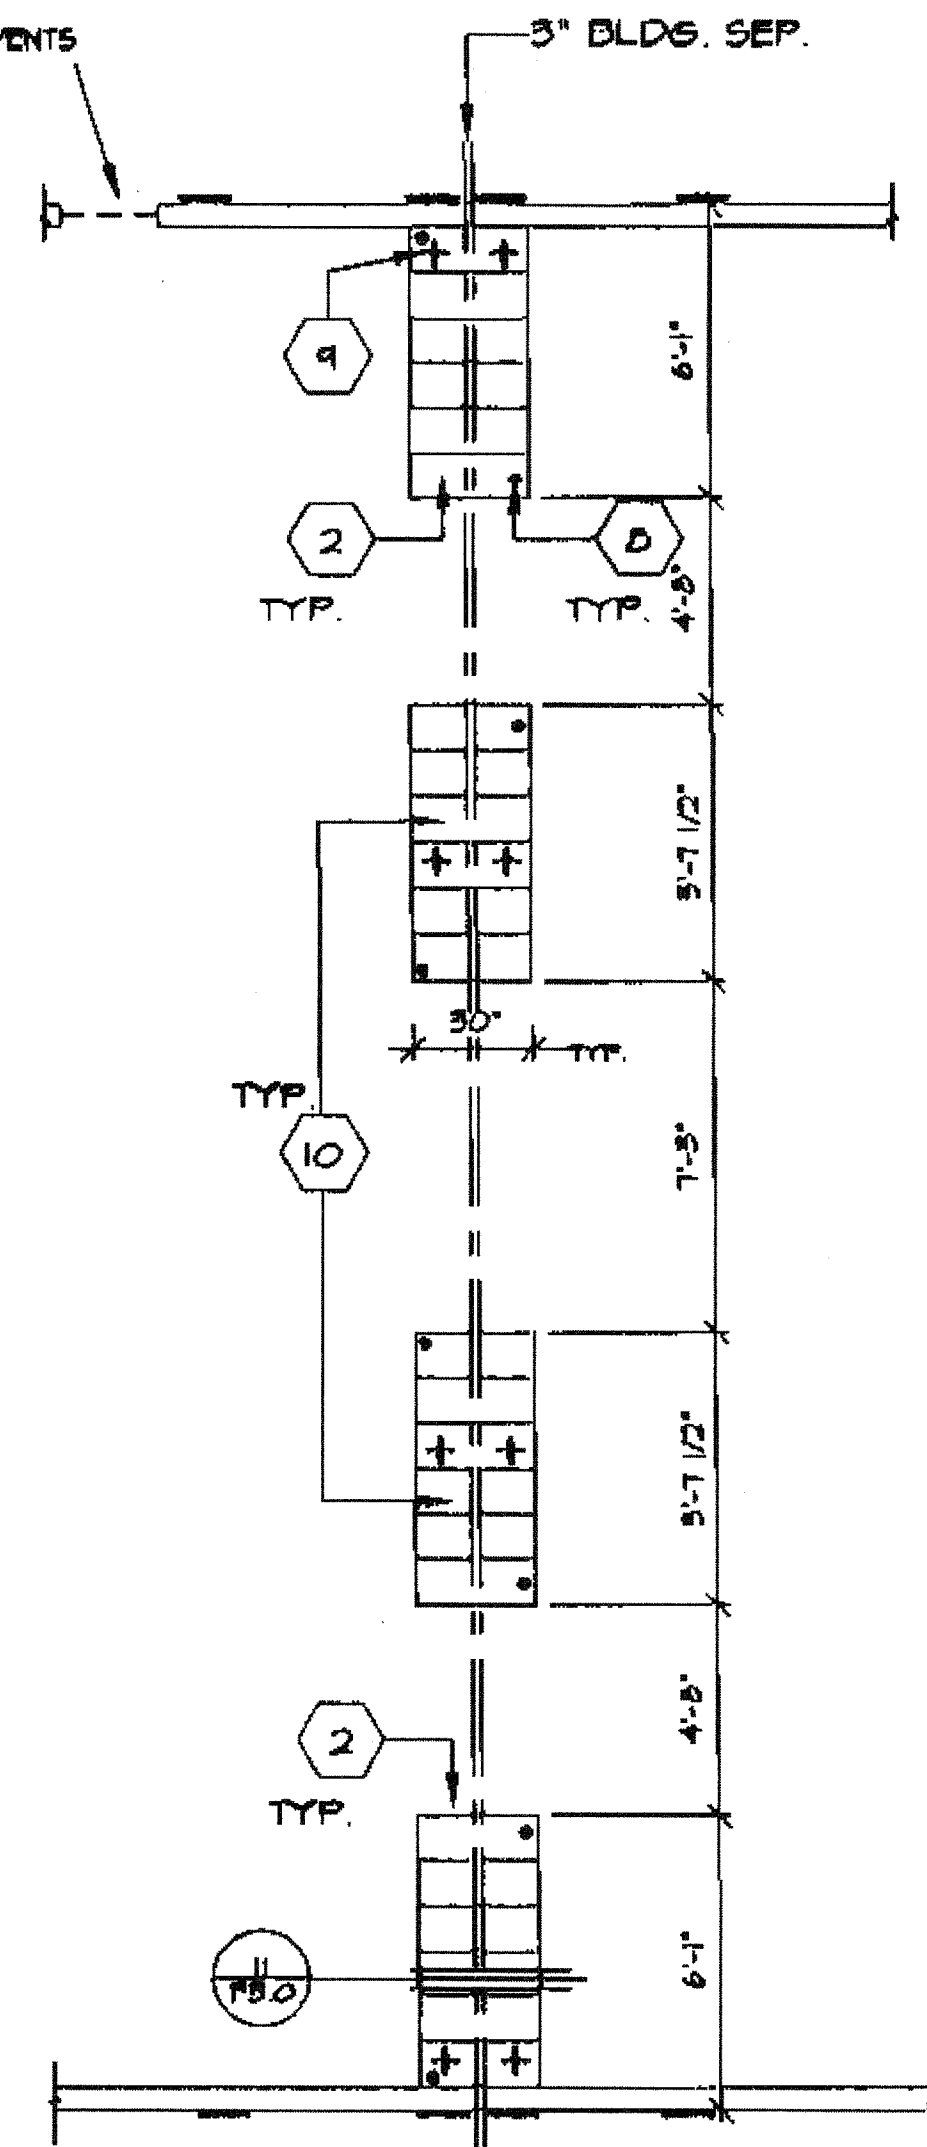

PAD FTG'S AT ADJ. BLDG.

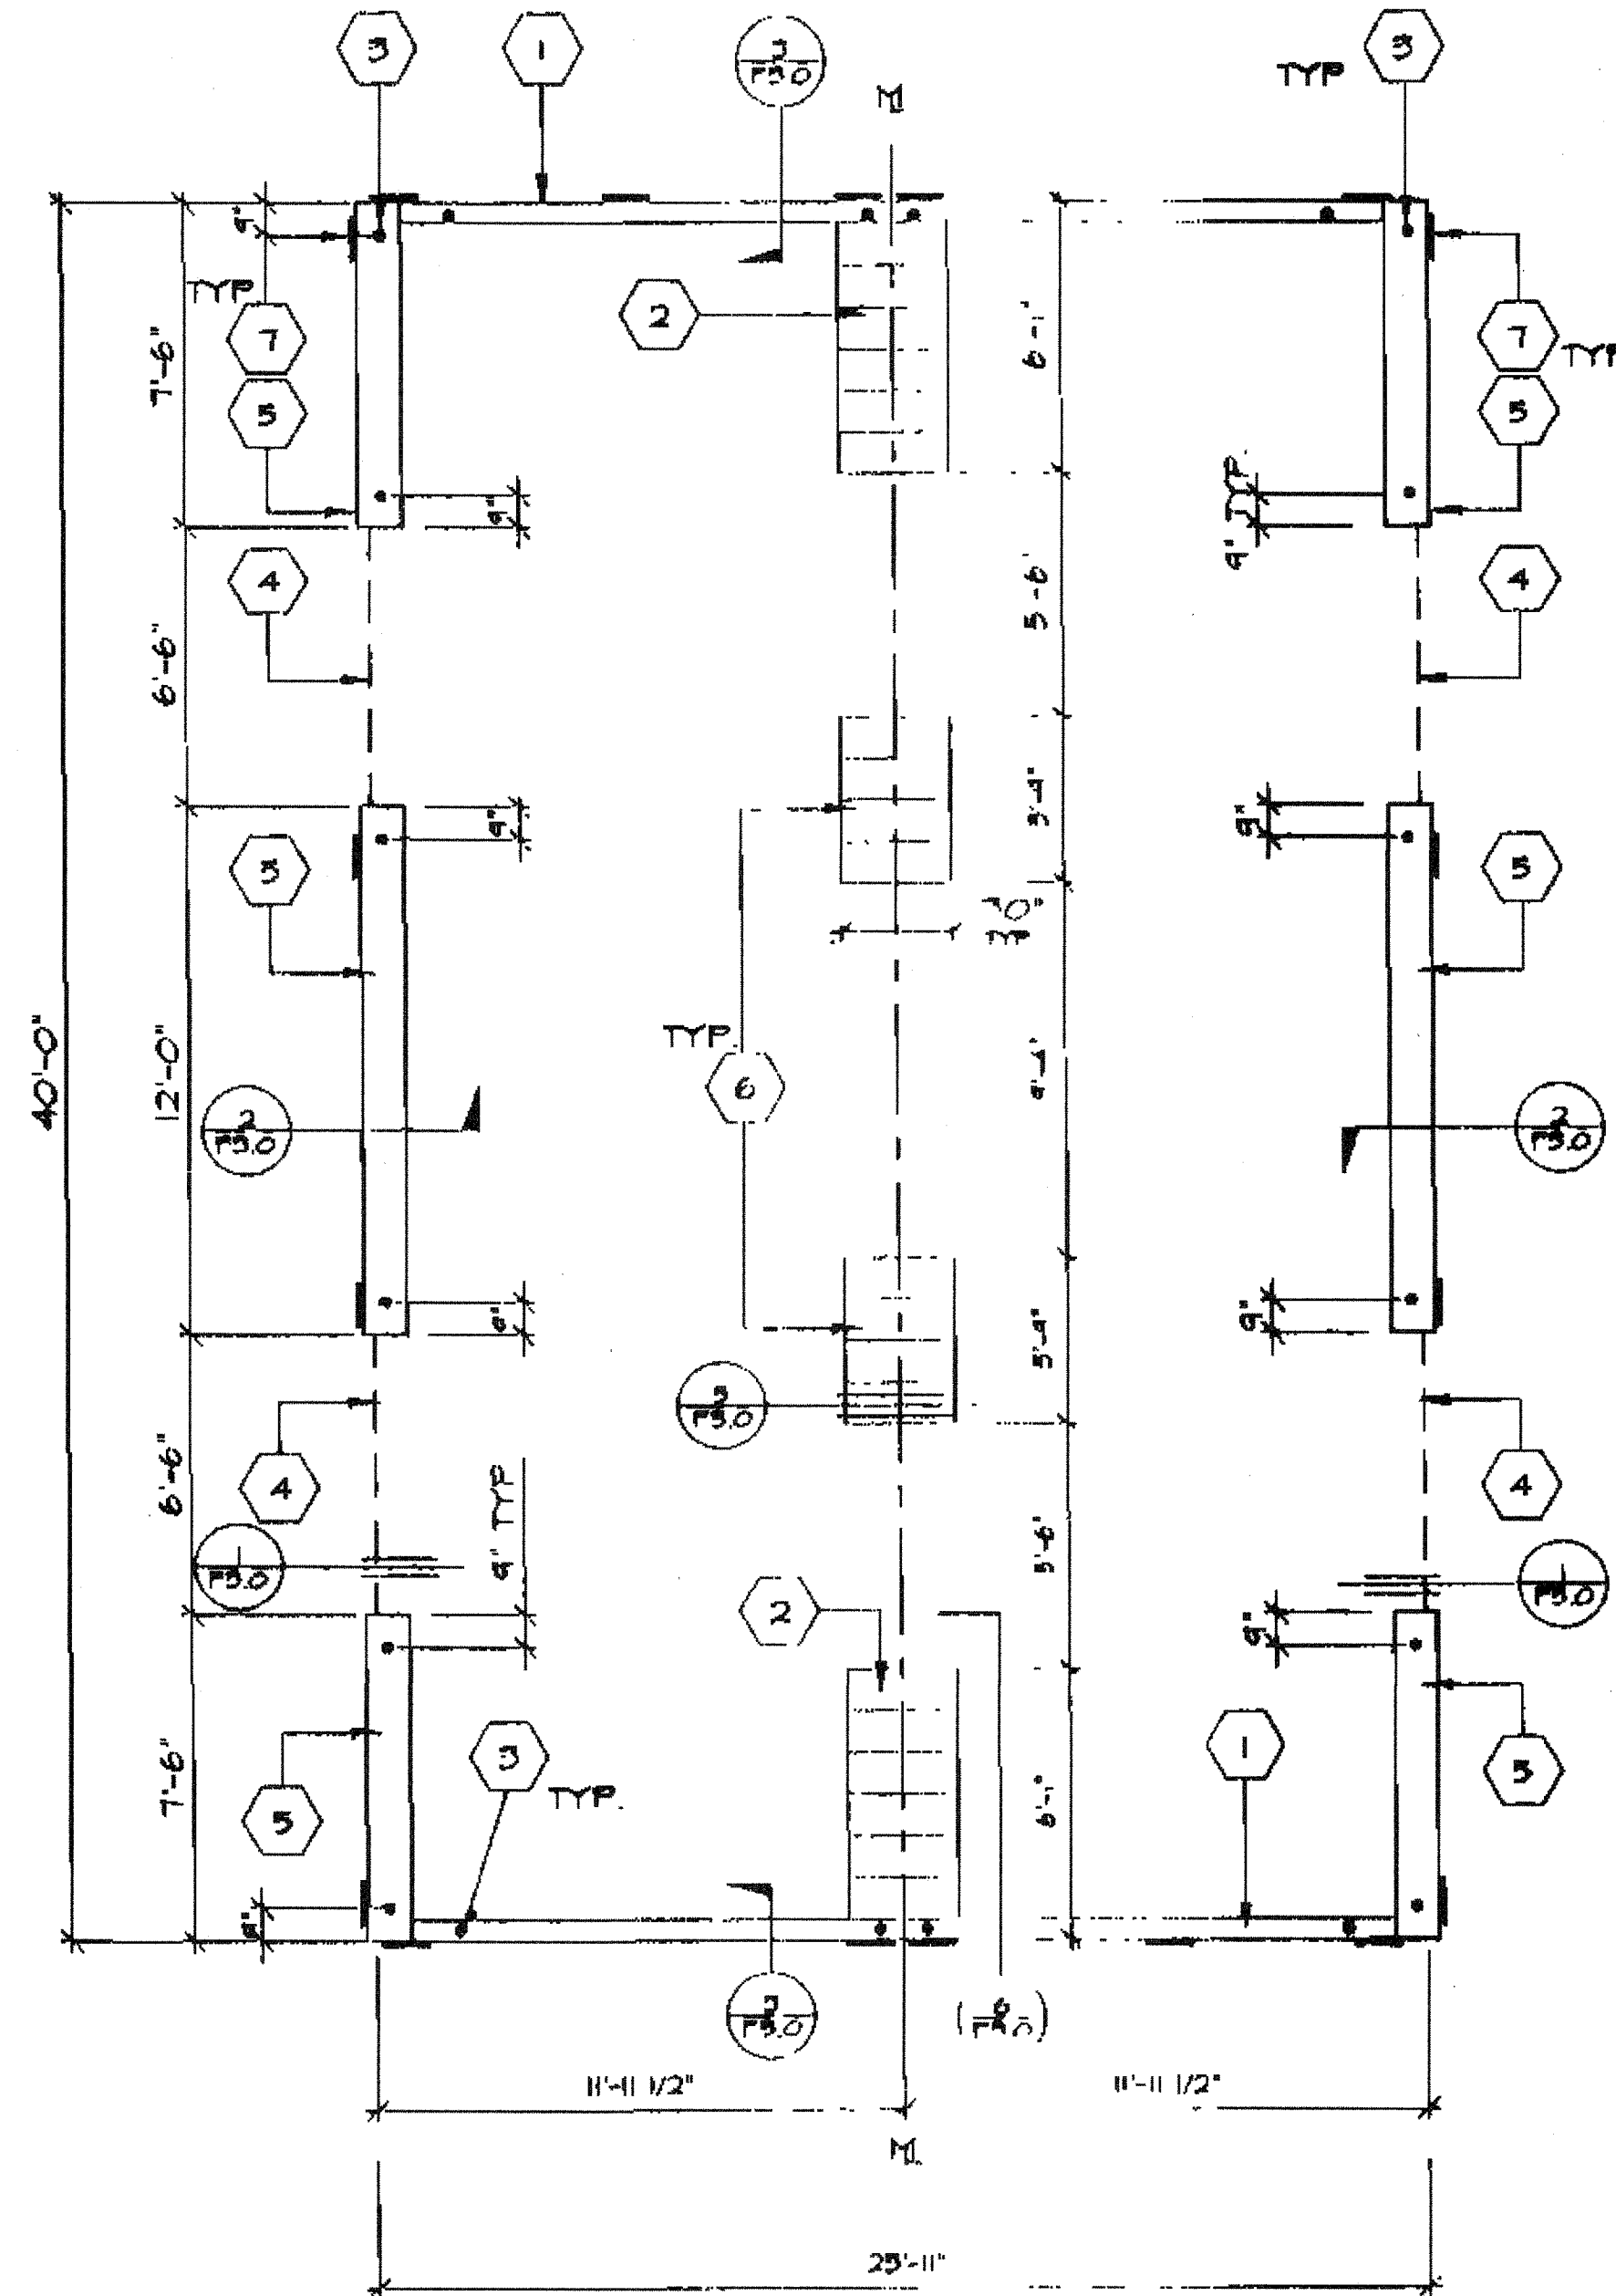

VENT CALCS.


BLDG'S SIZE 24' X 40' = 960 sq
 VENTILATION REQD 960 ÷ 150 = 6.4 sq
 3" X 6'-6" VENT = 1.625 sq
 4 VENTS X 1.625 sq = 6.5 sq
 6.5 sq > 6.4 sq

FOUNDATION (WOOD SILL)


24 x 40 - 50 PSF LL

SCALE 1/4"=1'-0"


REVISIONS ▲ ▲ ▲ ▲ ▲ ▲	ELECTRICAL	MECHANICAL	STRUCTURAL	ARCHITECT	DIVISION OF THE STATE ARCHITECT	 MODTECH INC. 2830 BARRETT AVE. PERRIS, CA. 92572 PH. (909) 943-4014 FX. (909) 940-0427 CONFIDENTIAL - THIS DOCUMENT AND THE INFORMATION CONTAINED HEREIN ARE THE PROPERTY OF MODTECH INC. UNAUTHORIZED COPYING, DISCLOSURE, OR OTHER UNAUTHORIZED USES ARE PROHIBITED.	JOB NO. IDENTIFICATION STAMP DIV. OF THE STATE ARCHITECT APP#3 117168 AC / FLS / SS / TN Date: DEC 1 1996	 REVISED APR 27 1996 PC 275 DATE: 7-19-96	DRAWN BY DATE CHECKED BY DATE FOI

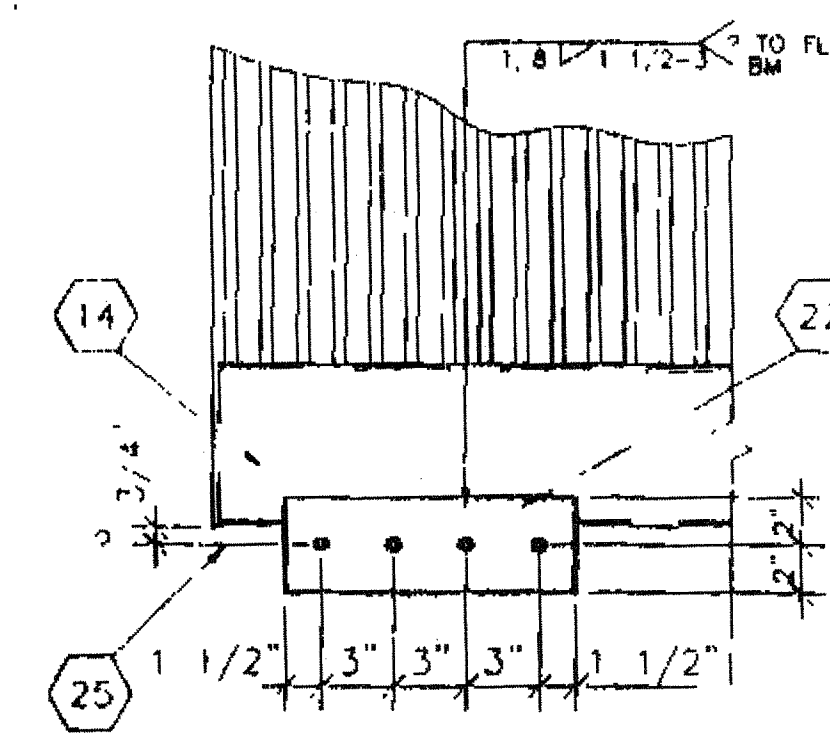


9 SCALE: 1 1/2"=1'-0"
ALTERNATE HOLD DOWN

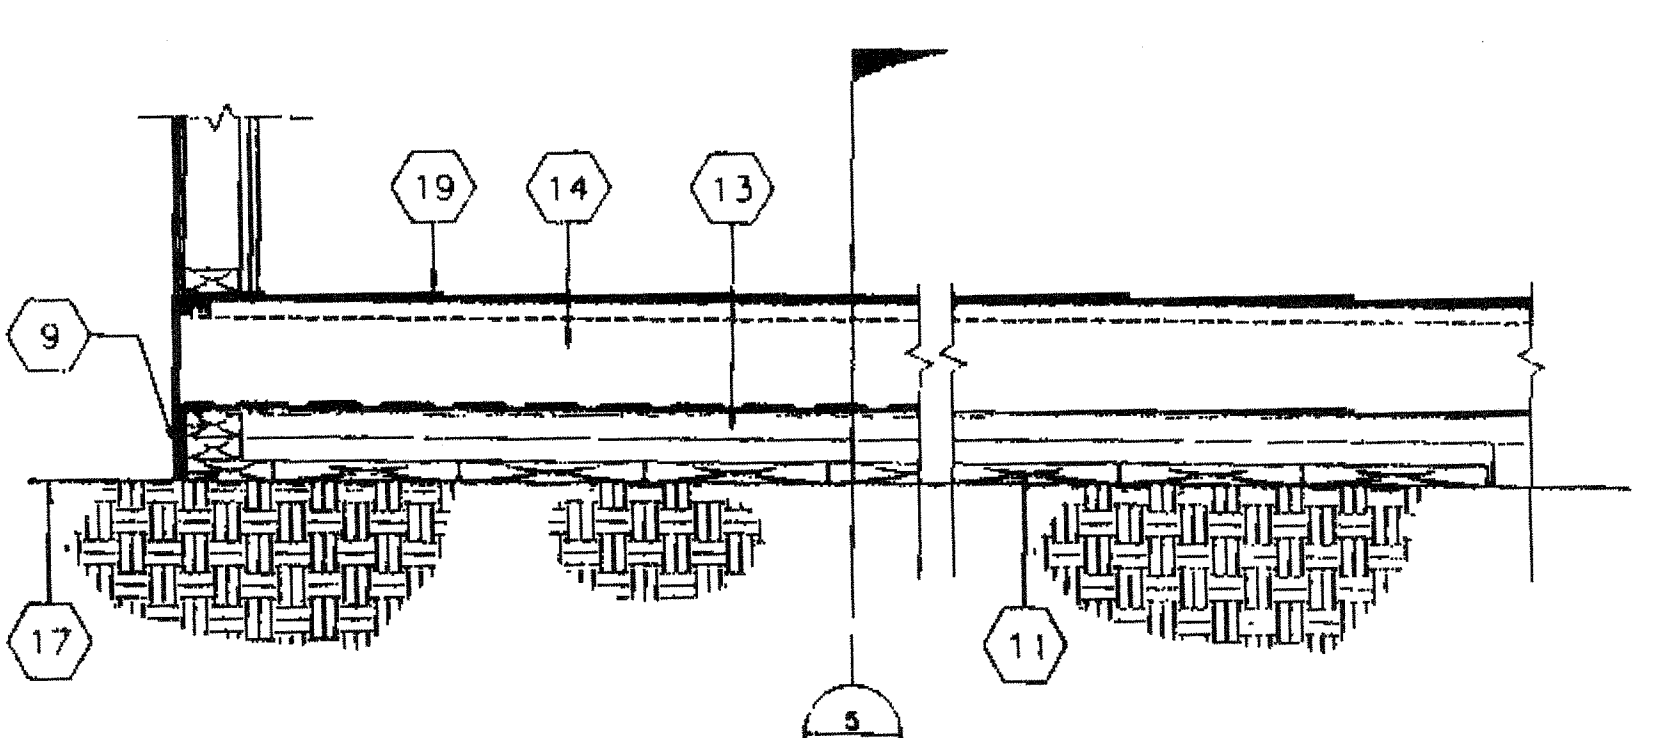


6 SCALE: 1 1/2"=1'-0"
MODLINE PAD @ END WALL

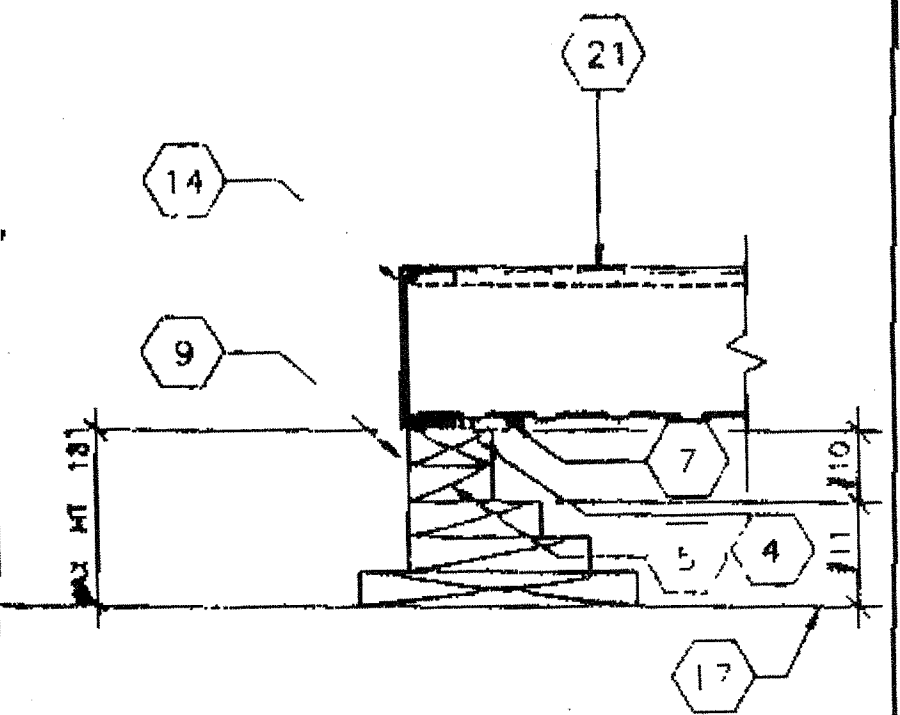


10 SCALE: 1 1/2"=1'-0"
ADD BLK'S/SHIMS TO LEVEL FOUND.

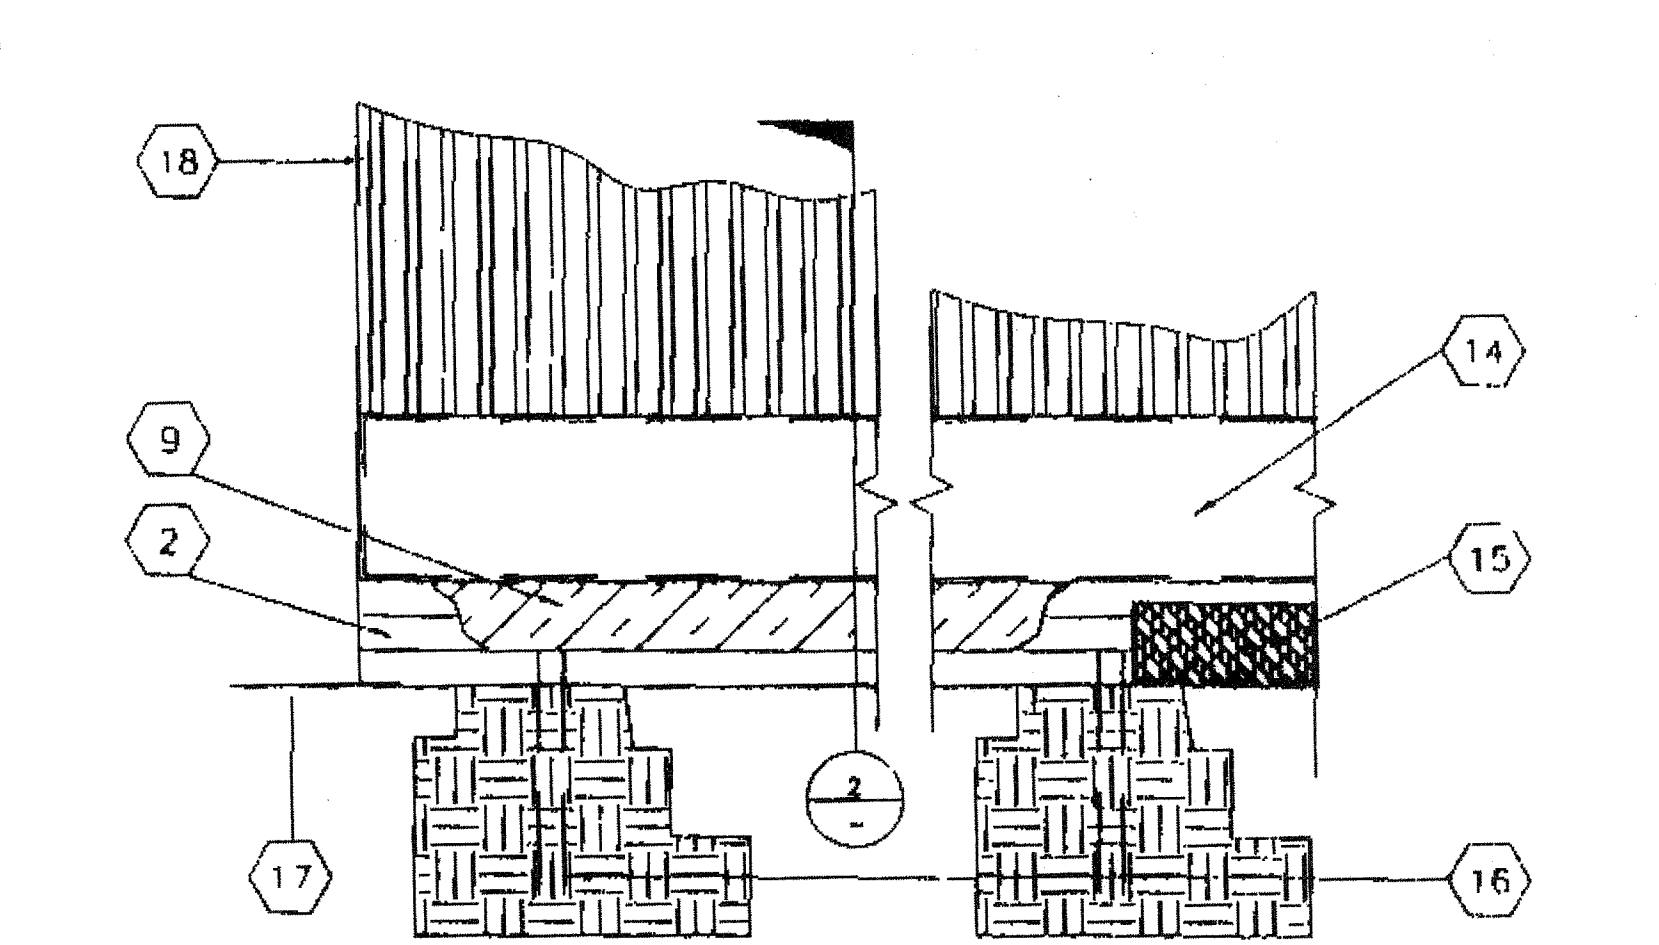


7 SCALE: 1 1/2"=1'-0"
FOUNDATION ELEVATION @ SIDE WALL

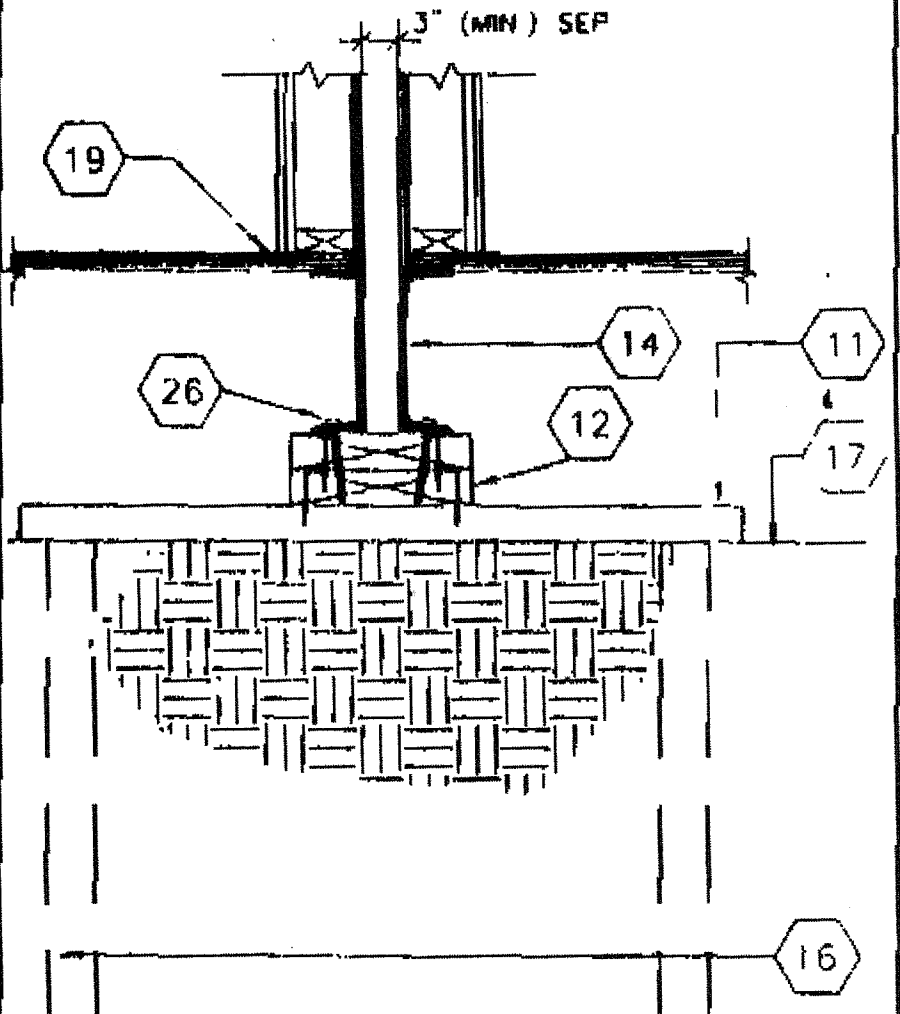


11 SCALE: 1 1/2"=1'-0"
FOUND. AT ADJ. BLDG

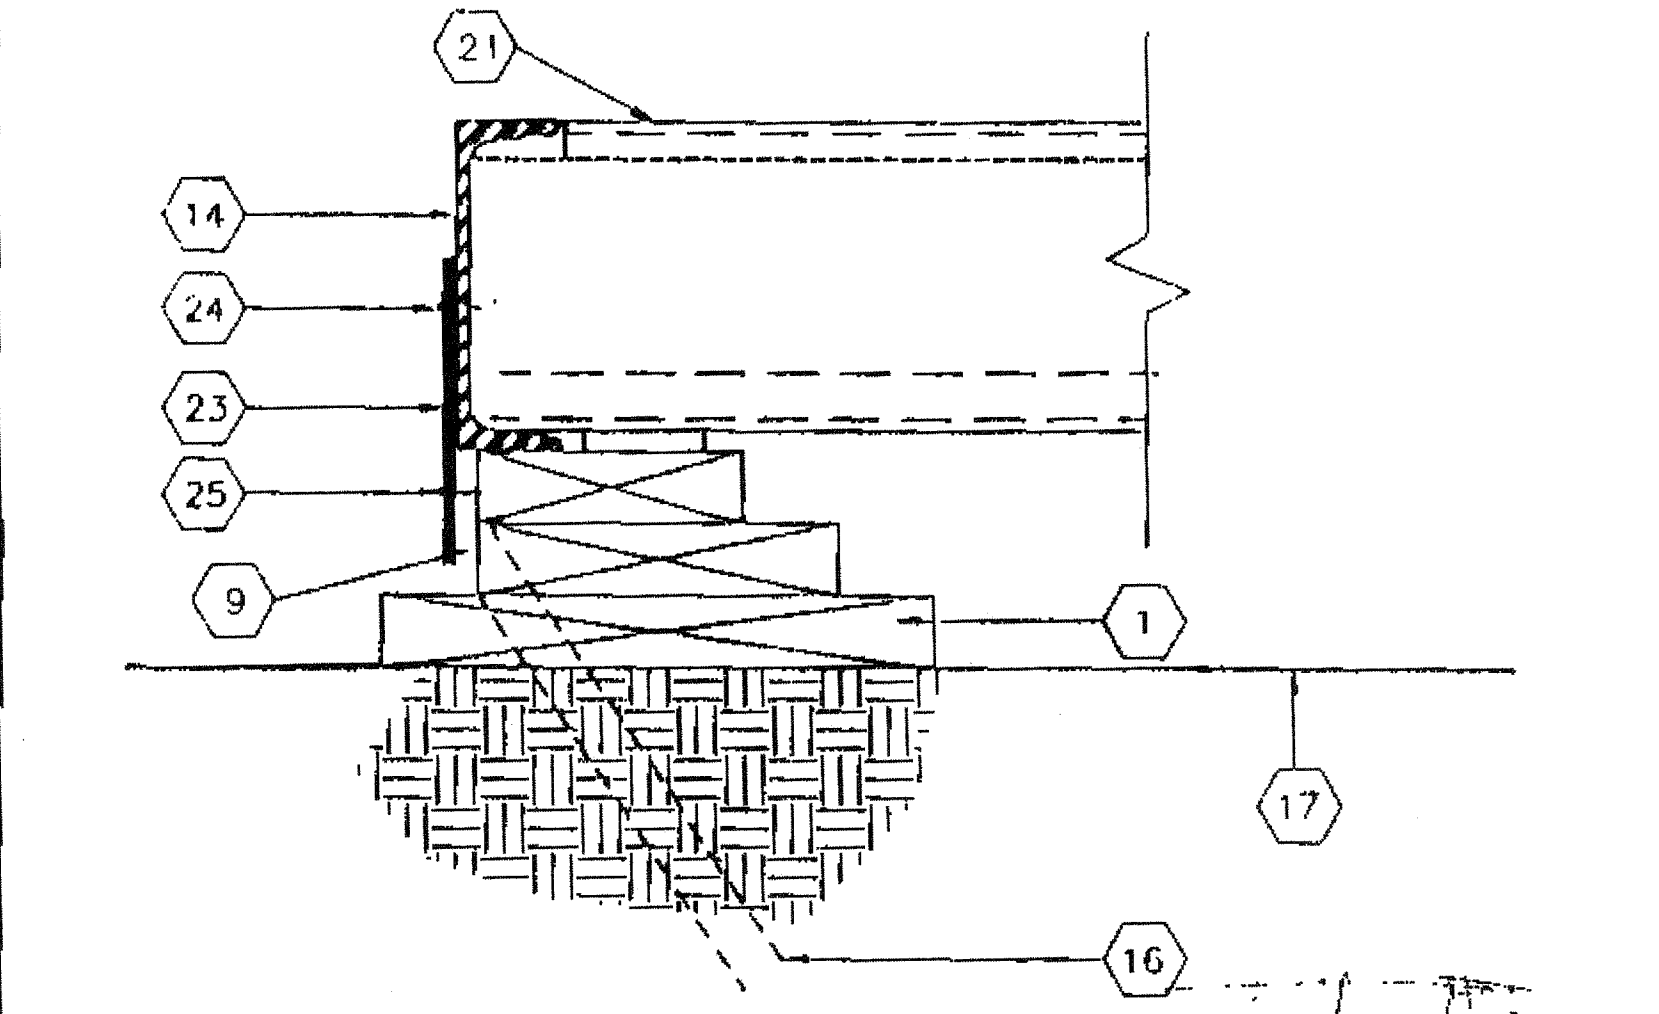


8 SCALE: 3"=1'-0"
TYPICAL TIE PLATE

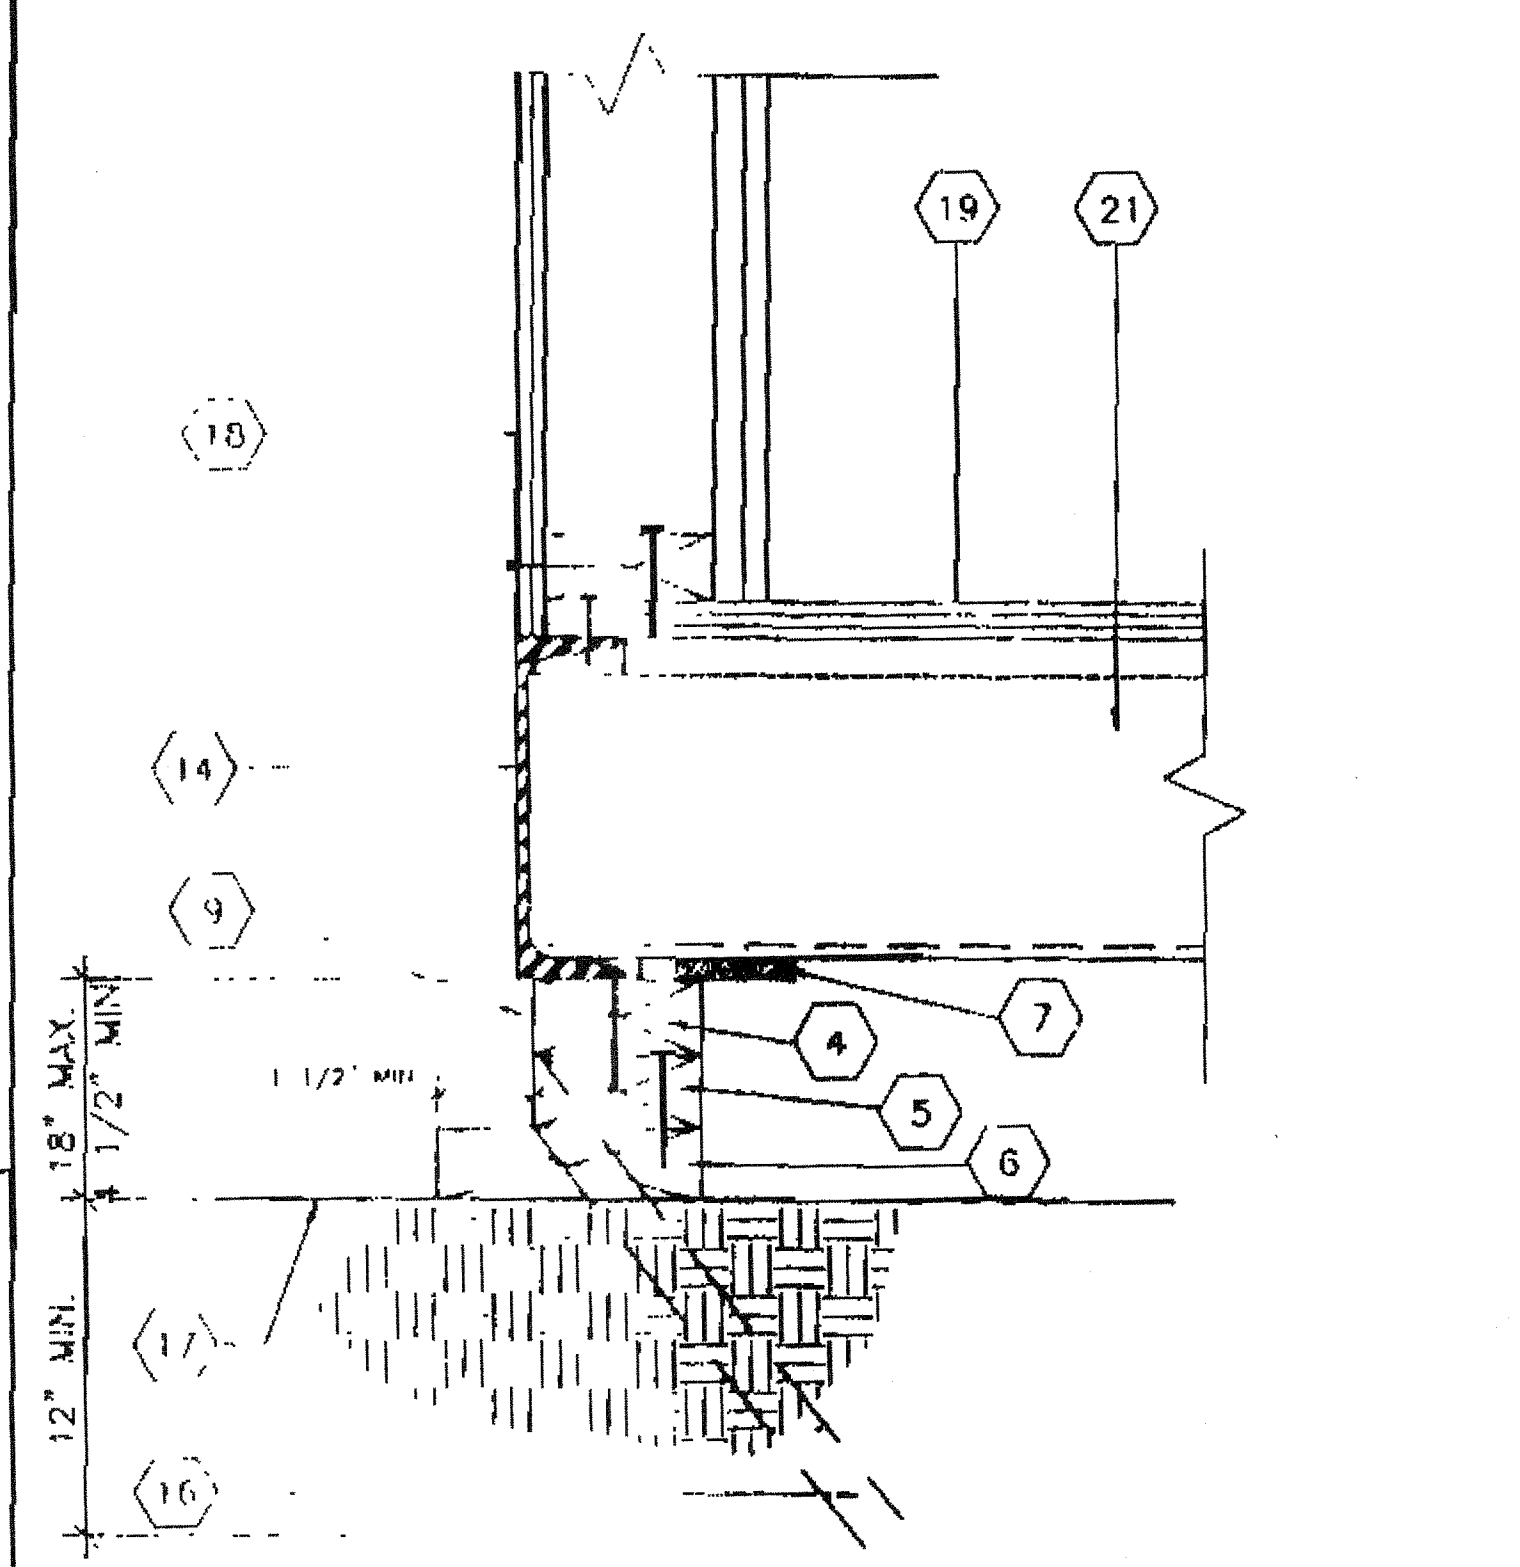


3 SCALE: 3"=1'-0"
FOUNDATION @ END WALL

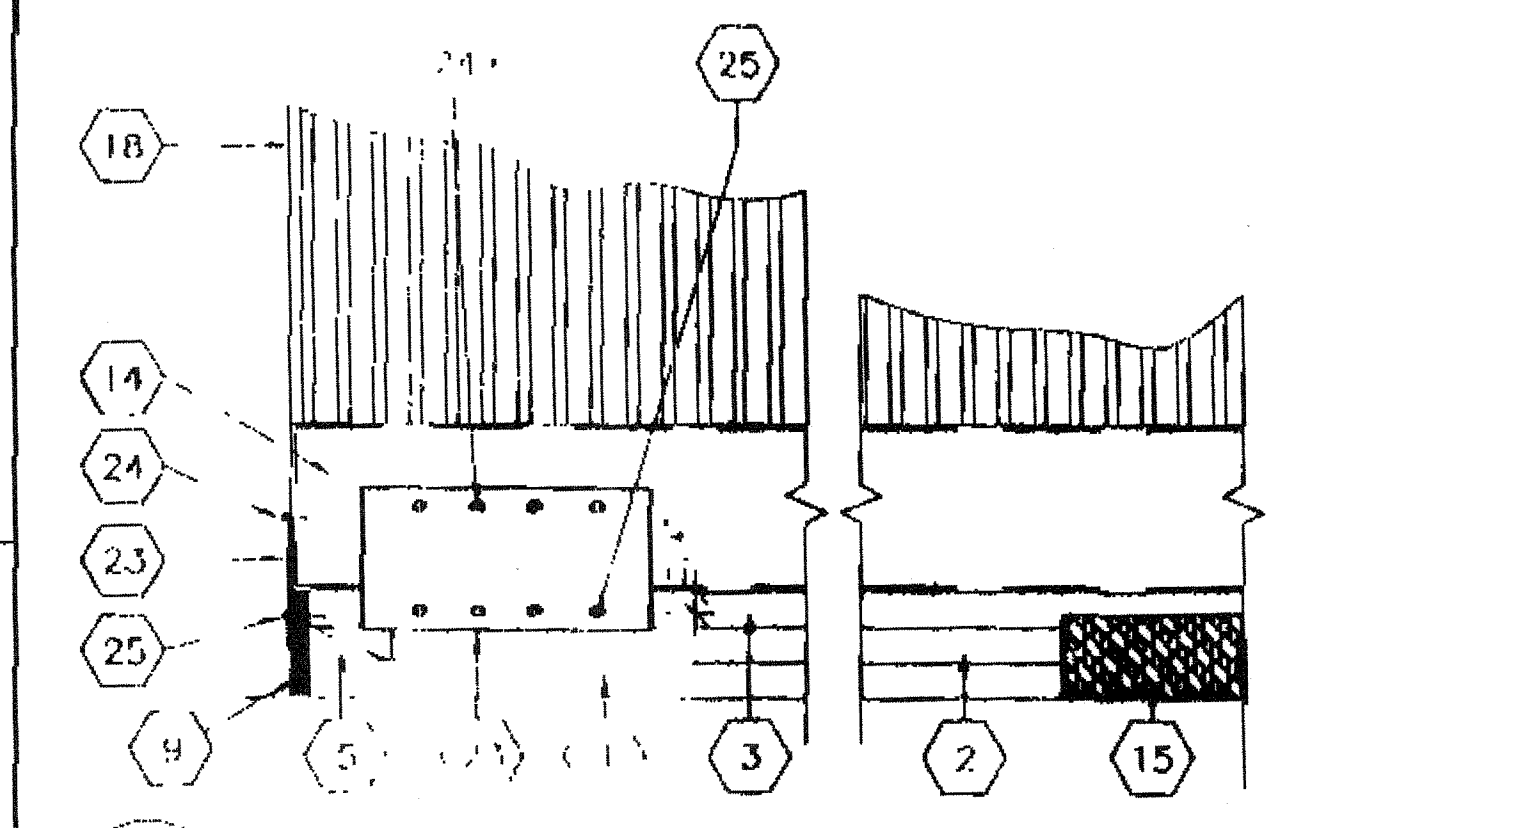


4 SCALE: 1 1/2"=1'-0"
DETAIL @ FOUNDATION CORNER

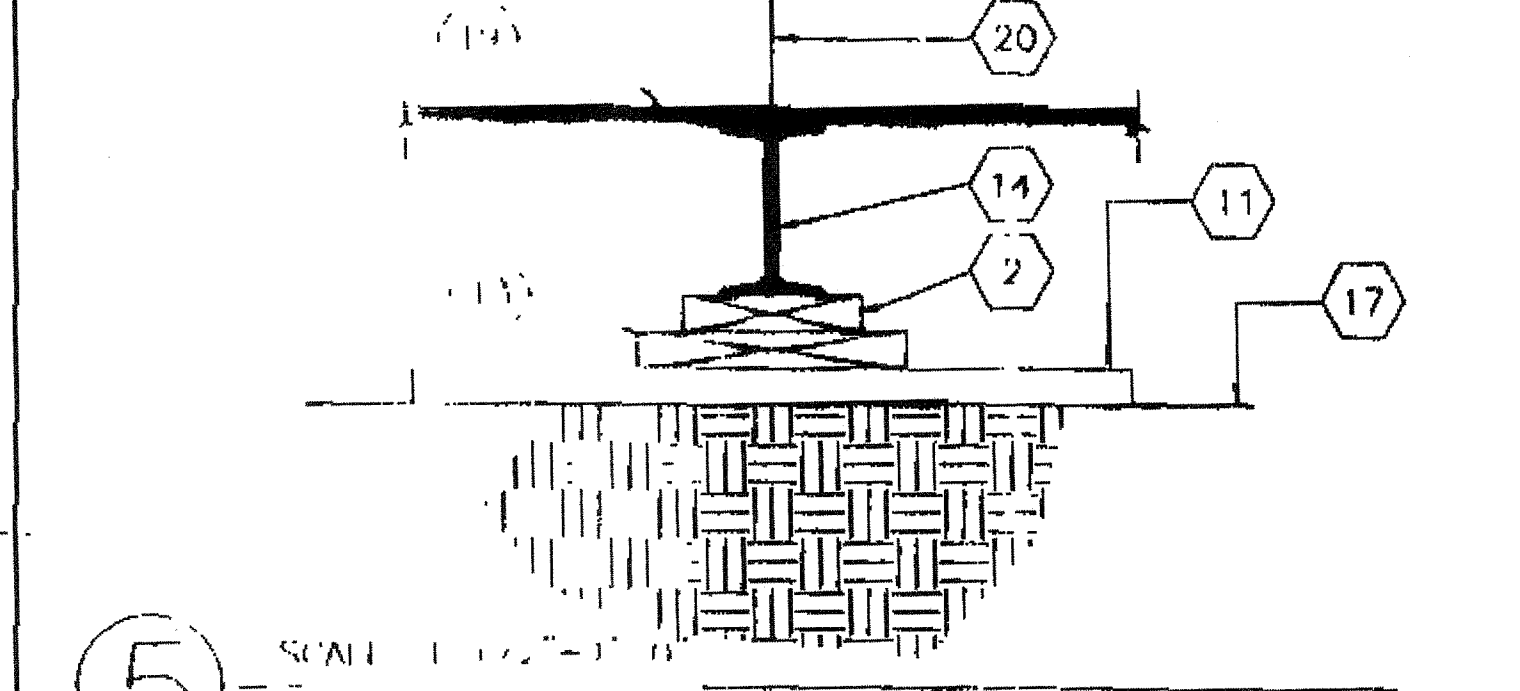

5 SCALE: 1 1/2"=1'-0"
FOUNDATION PAD @ MODLINE

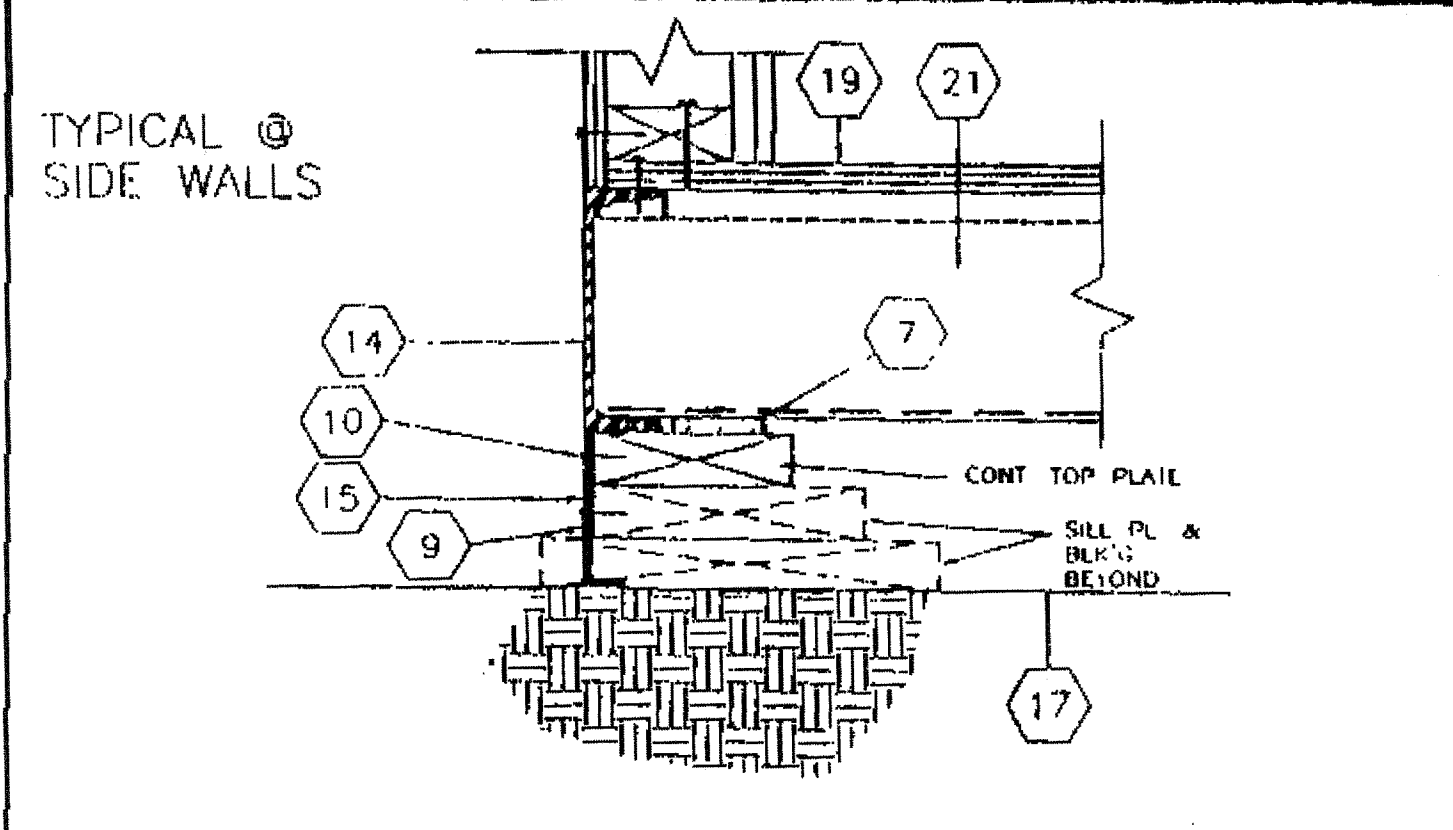


1 SCALE: NTS
FOUNDATION VENT

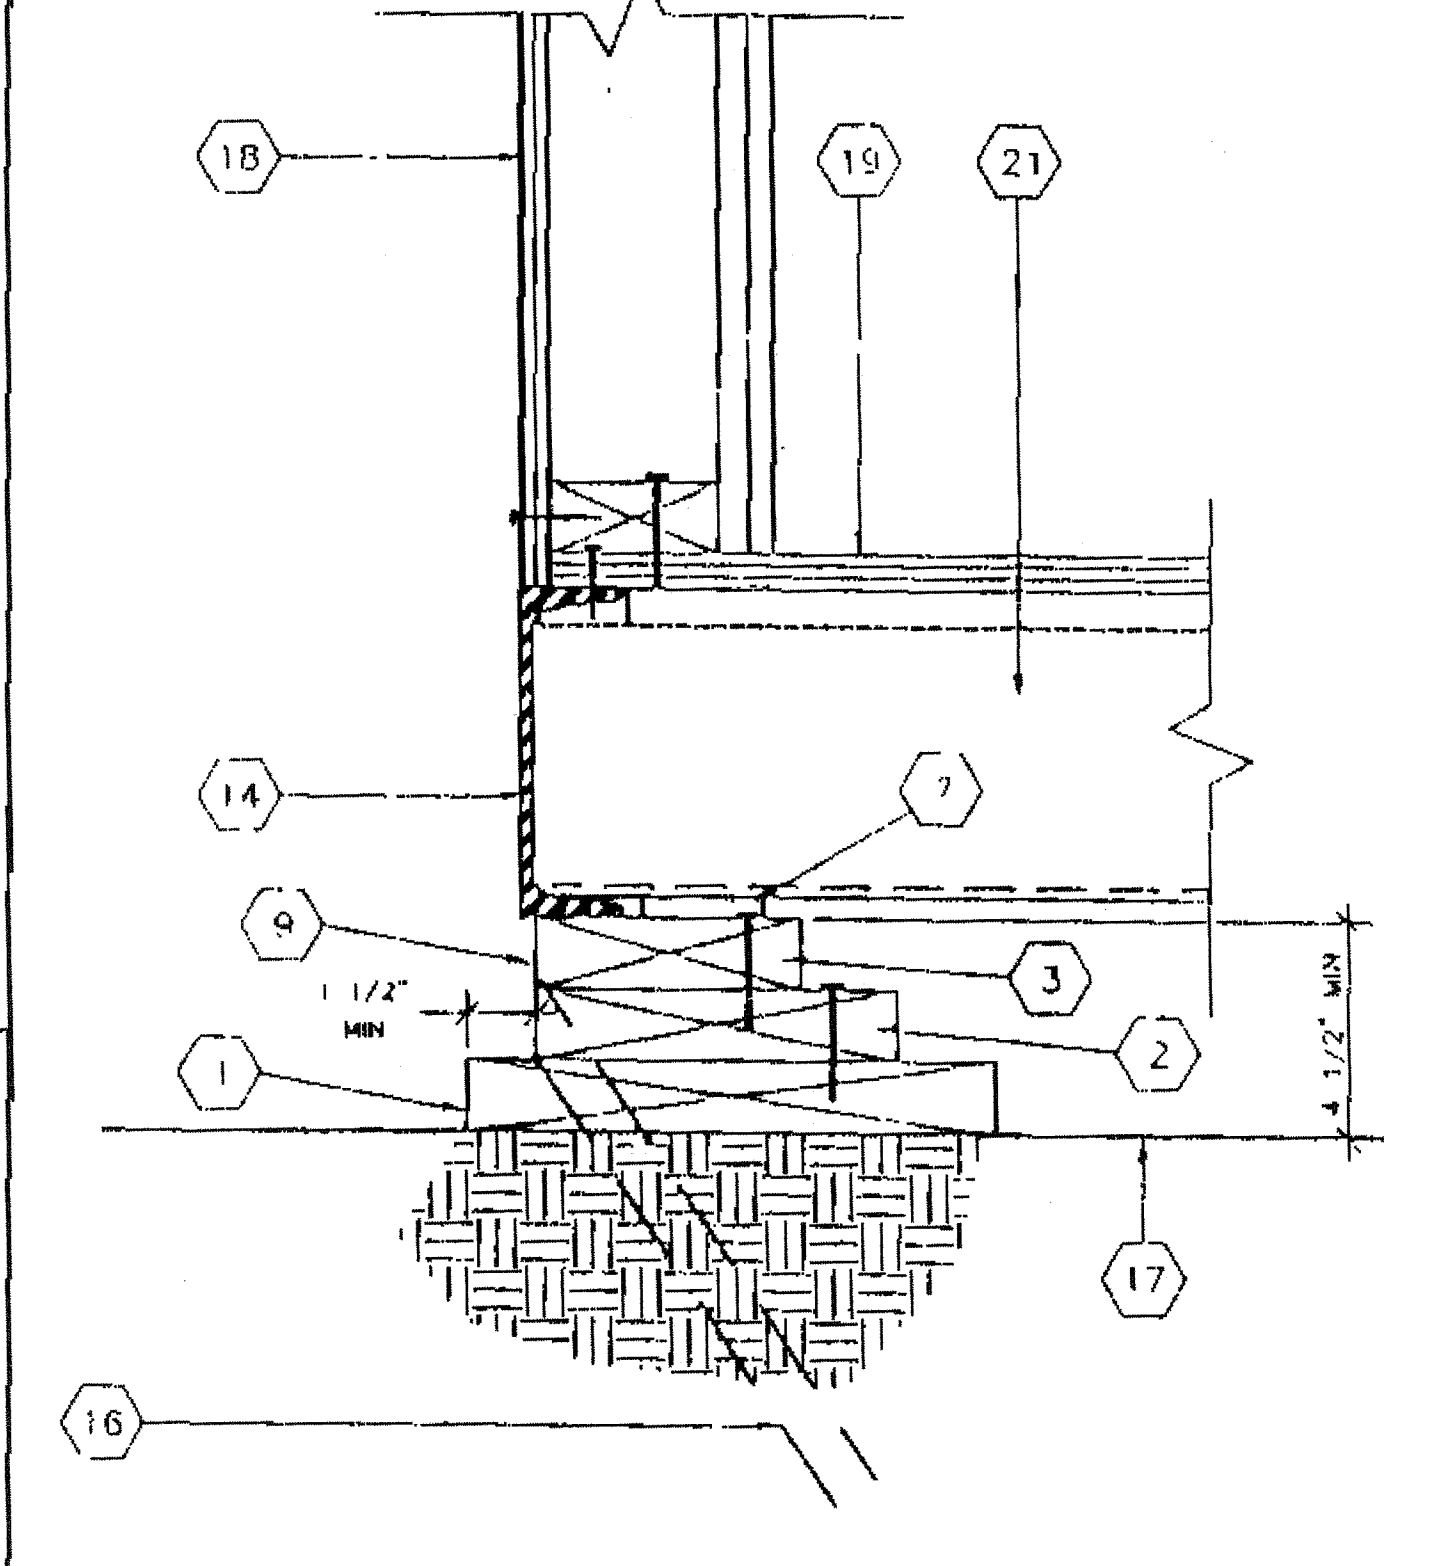

2 SCALE: 3"=1'-0"
FOUNDATION @ SIDE WALL

- KEY NOTES**
- 1 2X12 SILL PLATE SEE FOUND. PLAN FOR LENGTH
 - 2 2X8 BLOCKING W/16d @ MAX 5" O.C. TO SILL PLATE
 - 3 2X6 TOP PLATE W/16d @ MAX 5" O.C. TO BLOCKING
 - 4 2X4 TOP PLATE W/16d @ MAX 5" O.C. TO BLOCKING
 - 5 2X4 BLOCKING W/16d MAX 5" O.C. TO SILL PLATE
 - 6 2X6 SILL PLATE SEE FOUND PLAN FOR LENGTH
 - 7 5/8"x2 1/2" SHIM (WHEN REQ)
 - 8 INSERT REQ'D 2X4 BLK'NG OR PLYWD. SHIM W/16d @ 12" O.C. FACE NAIL
 - 9 OPTIONAL - MIN. 3/8" PLYWOOD SHIRTING W/ 10d @ MIN. 4" O.C. @ ENDWALLS & 6" O.C. @ SIDEWALLS E.N. & TYP. 12" O.C. FN. PLATE TO PLATE NAILING FOR THE FOUNDATION MEMBERS CAN BE DECREASED TO 12" O.C. AND FOUNDATION BLOCKING SHALL BE RECESSED SUCH THAT THE SKIRTING SHALL BE INSTALLED FLUSH WITH THE PERIMETER FLOOR CHANNEL.
 - 10 10d GALV NAIL @ MAX. 4" O.C
 - 11 2X12x2'-6" SILL PLATE SEE FOUND. PLAN FOR QUANTITY REQ'D
 - 12 2 X 10 PLATES W/ 2-16D BOX @ 6" D.C.
 - 13 2X10 BLK'NG FACE OR TOE NAIL 16d @ MAX 12" O.C. ADD BLKS. OR SHIMS AS REQ'D
 - 14 FLOOR FRAME BEAM SEE STRUCTURAL
 - 15 TYPICAL FOUNDATION VENT (SEE FOUNDATION PLAN FOR SIZES AND LOCATIONS).
 - 16 SILL RESTRAINT 1" @ PIPE SEE FOUND FOR LOCATION
 - 17 FINISH GRADE
 - 18 EXTERIOR FINISH
 - 19 PLYWOOD SUBFLOOR
 - 20 MOD-LINE
 - 21 FLOOR-JOIST
 - 22 4"x12"x10 GA. PLATE
 - 23 6"x12"x10 GA. PLATE
 - 24 1/4" @ S.T.S. TYP. 4-PLACES
 - 25 1/4" @ X3" LG. LAG SCREW TYP. 4-PLACES
 - 26 5/8" @ X4" LAGS (FOR LOCATION SEE PLAN)

FOUNDATION LUMBER TO BE PRECUT AT FACTORY, LUMBER GRADES & PRESSURE TREATING TO BE VERIFIED BY INPLANT INSPECTOR

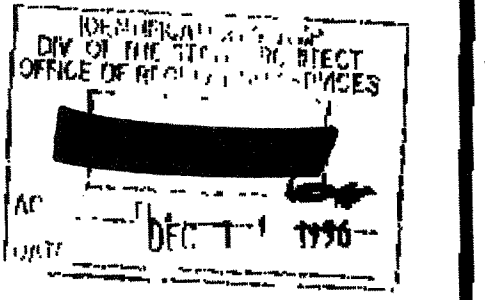


REVISIONS

ELECTRICAL	MECHANICAL	STRUCTURAL	ARCHITECT	DIVISION OF THE STATE ARCHITECT
				<p>REUSED</p> <p>11-775</p> <p>2-19-96</p>


MODTECH INC.
 2830 BARRETT AVE
 PERRIS, CA. 92512
 PH (909) 943-4014
 FX. (909) 940-0427

CONFIDENTIAL - THIS DOCUMENT AND THE INFORMATION CONTAINED HEREIN ARE THE PROPERTY OF MODTECH INC. UNAUTHORIZED COPYING, DISCLOSURE, OR OTHER UNAUTHORIZED USES ARE PROHIBITED.


JOB NO.	IDENTIFICATION STAMP DIV OF THE STATE ARCHITECT APP#3 117168 AC / FLS / SS / TV Date 11/9/2018	DRAWN BY DATE CHECKED BY DATE
FOUNDATION DETAILS		F3.0

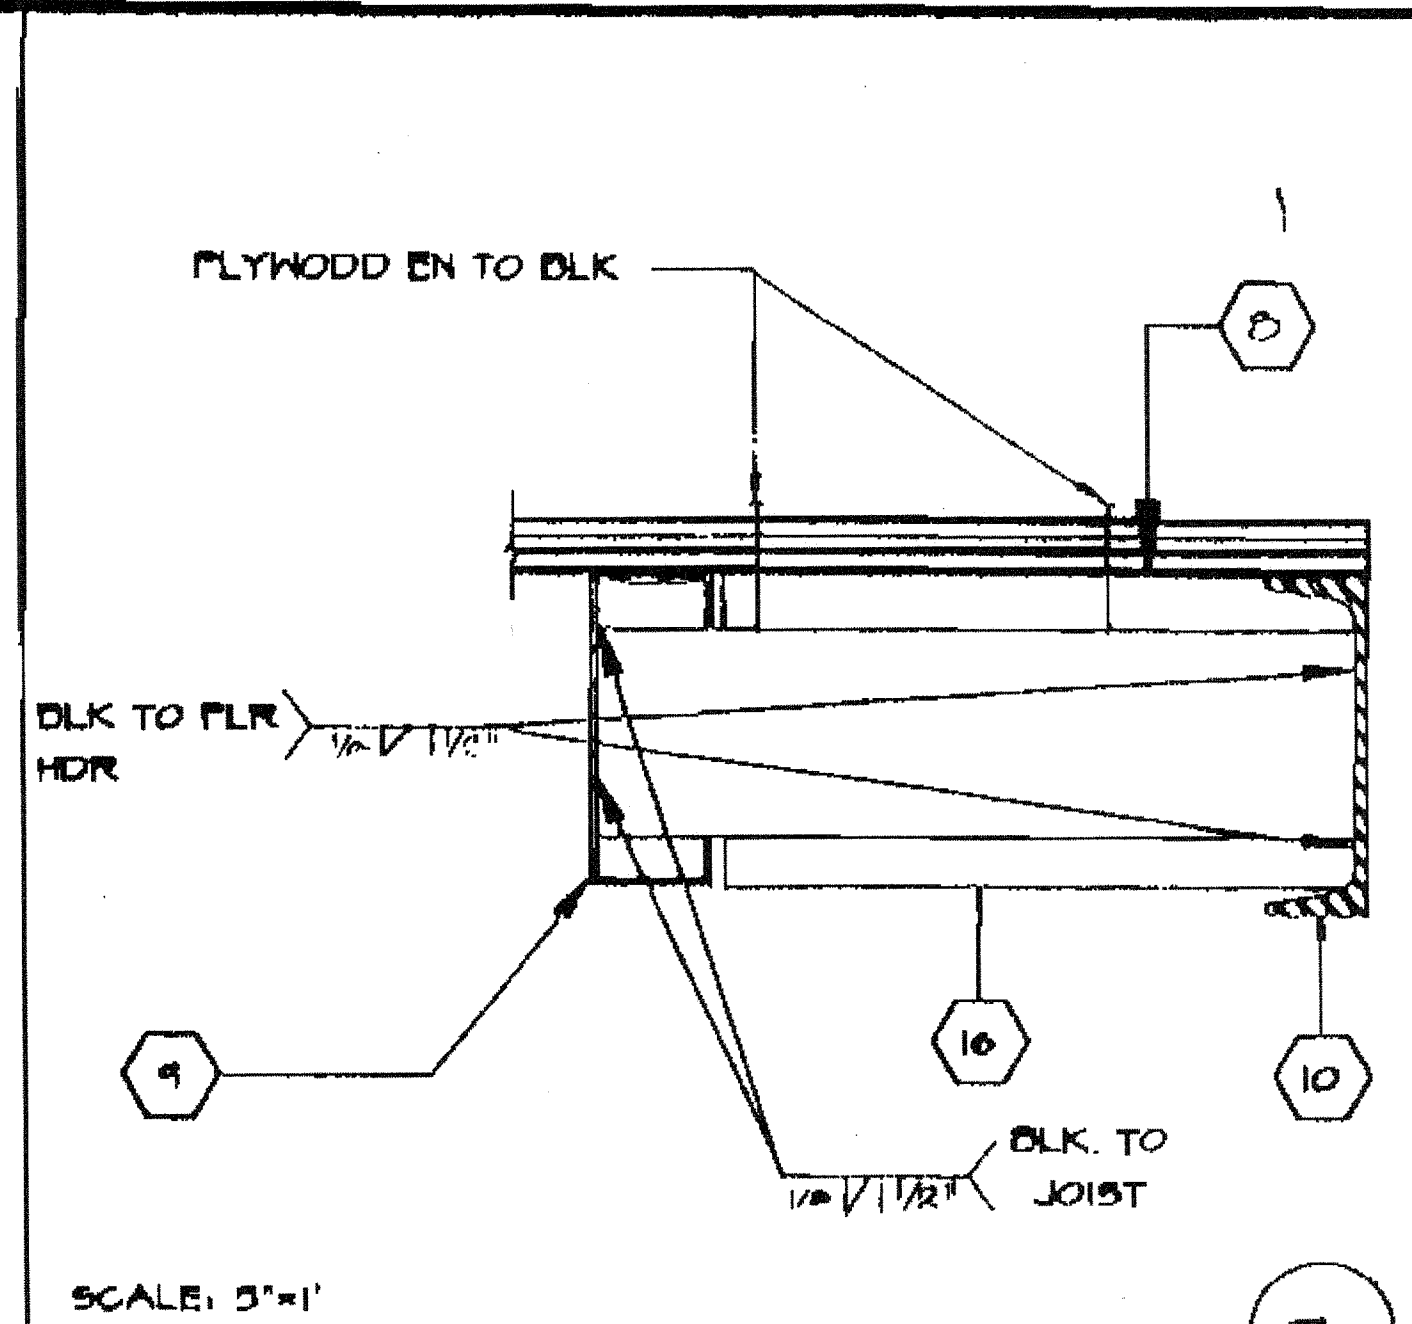


SCALE: 3"=1'
BLOCK @ MIDSPAN

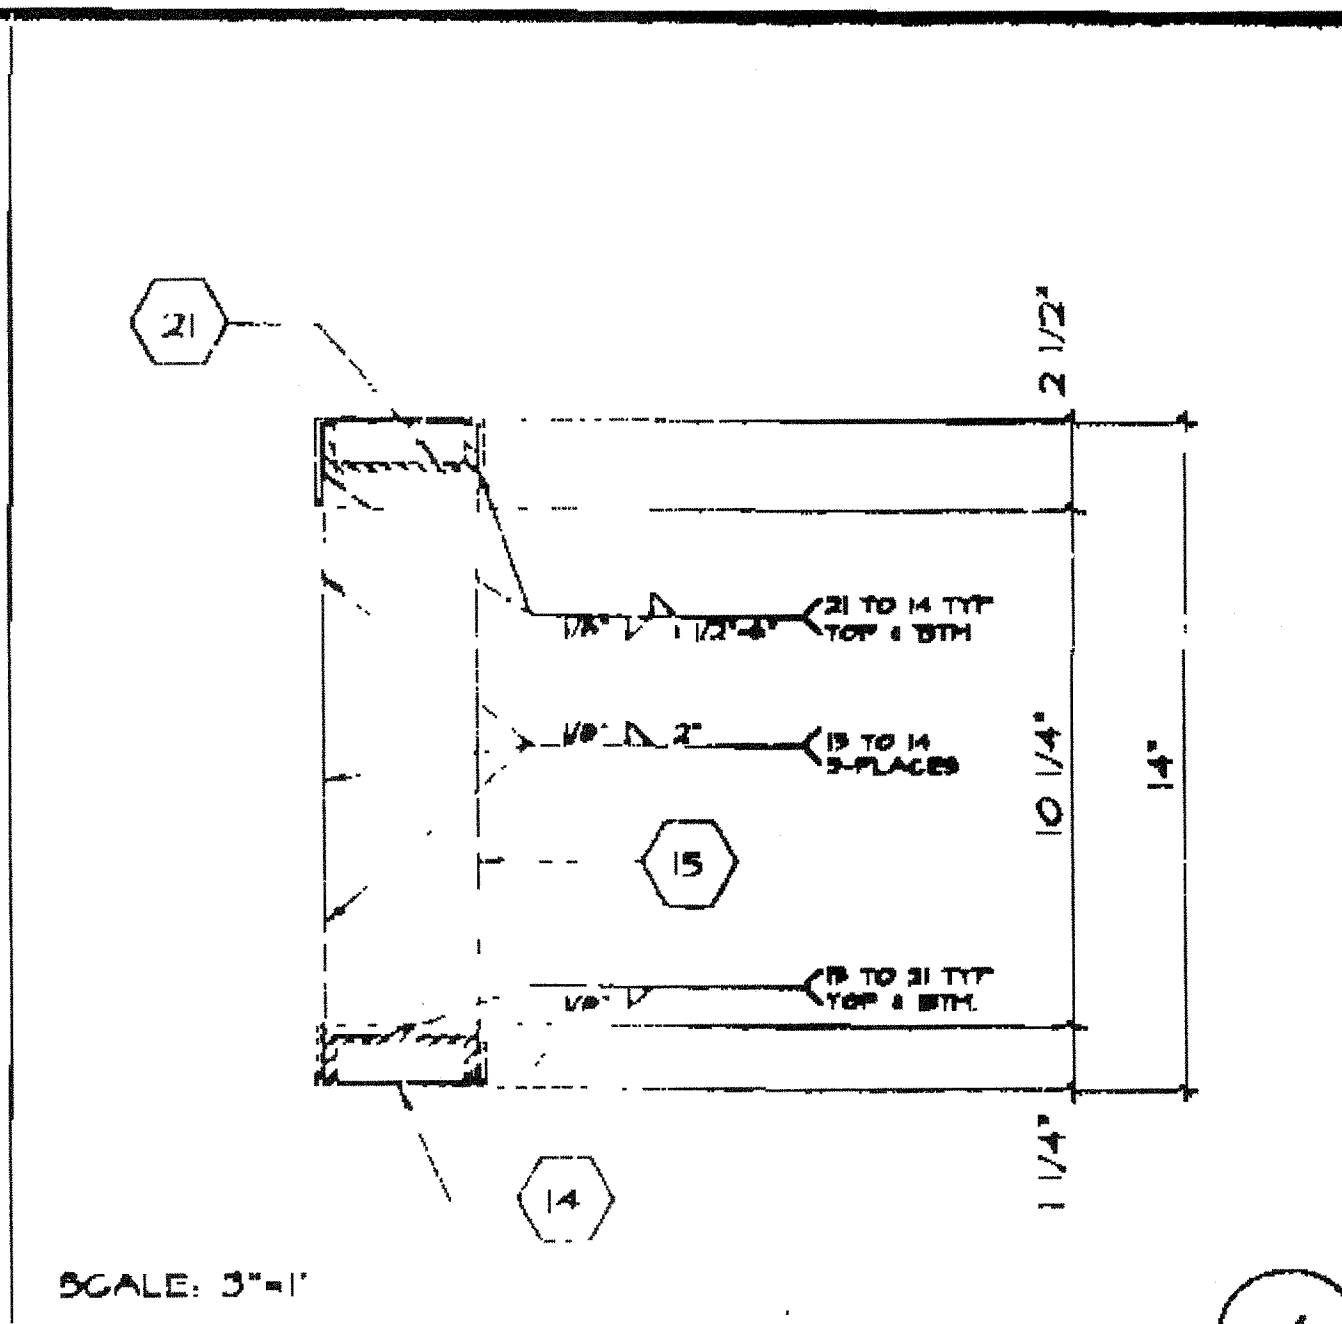


SCALE: 3"=1'
MECH. DUCT OPENING IN HEADER

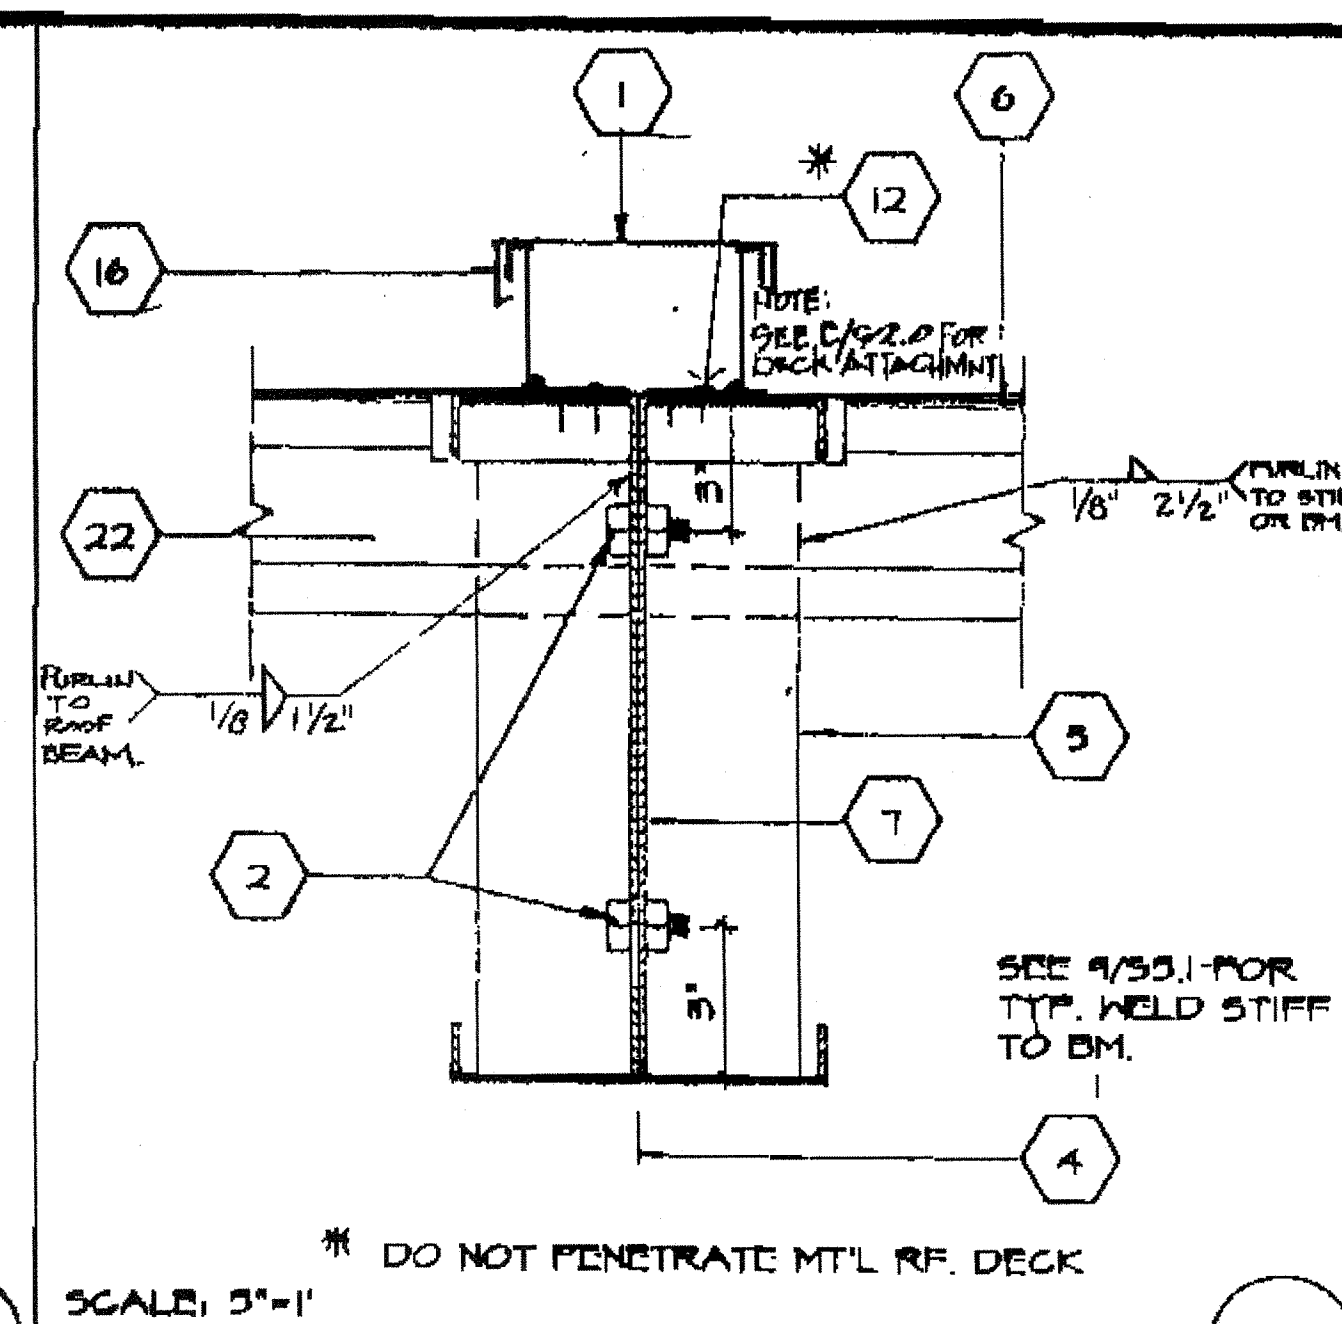


SCALE: 3"=1'
ROOFING @ MODLINE

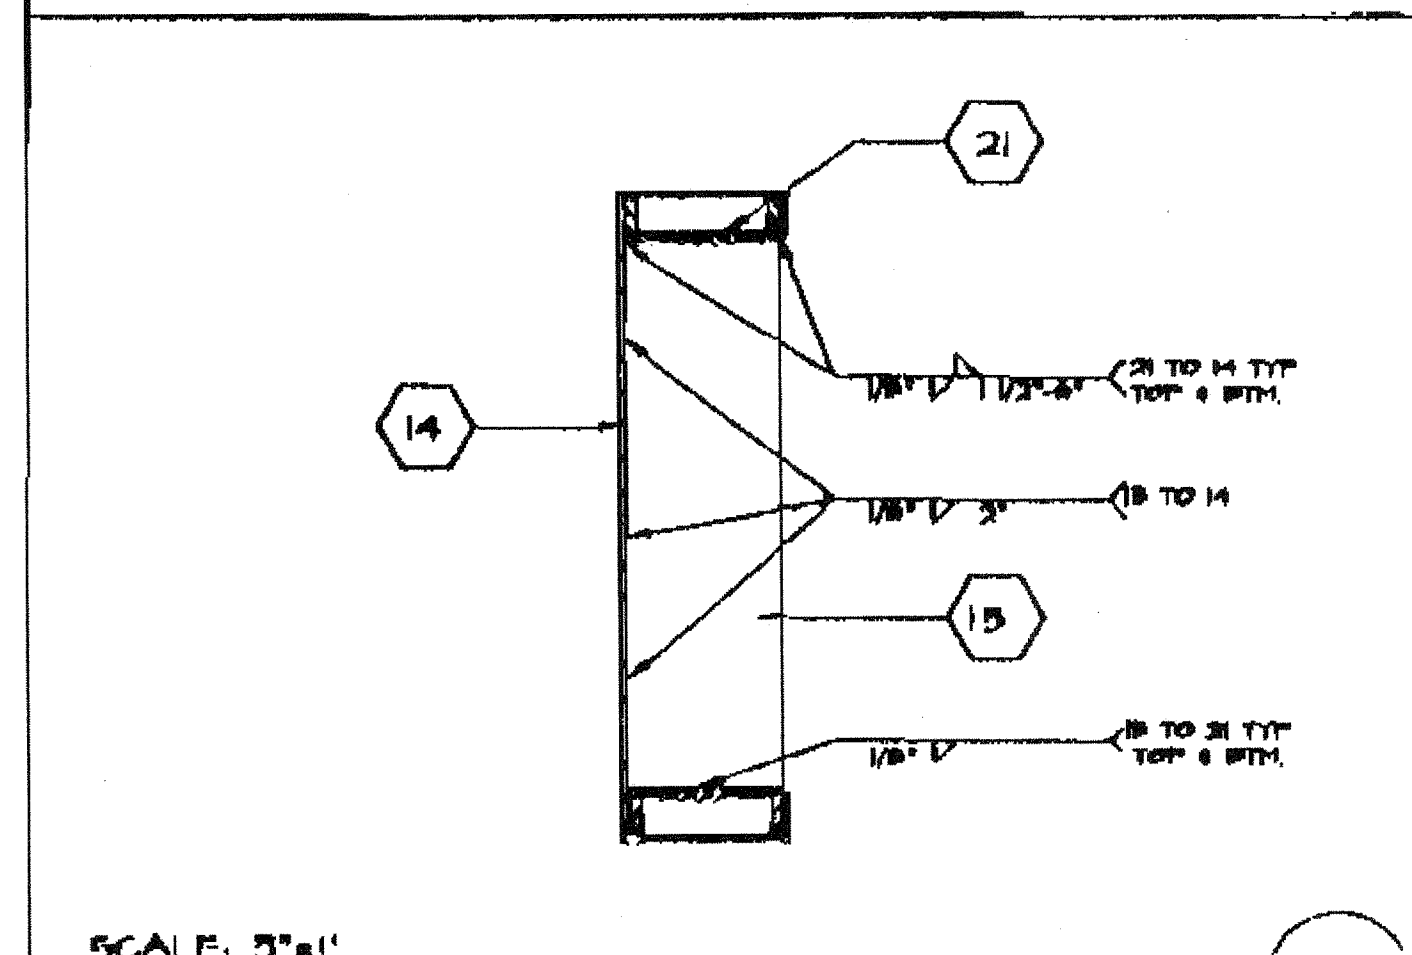


SCALE: 3"=1'
HEADER REINF. @ A.C. OPENING

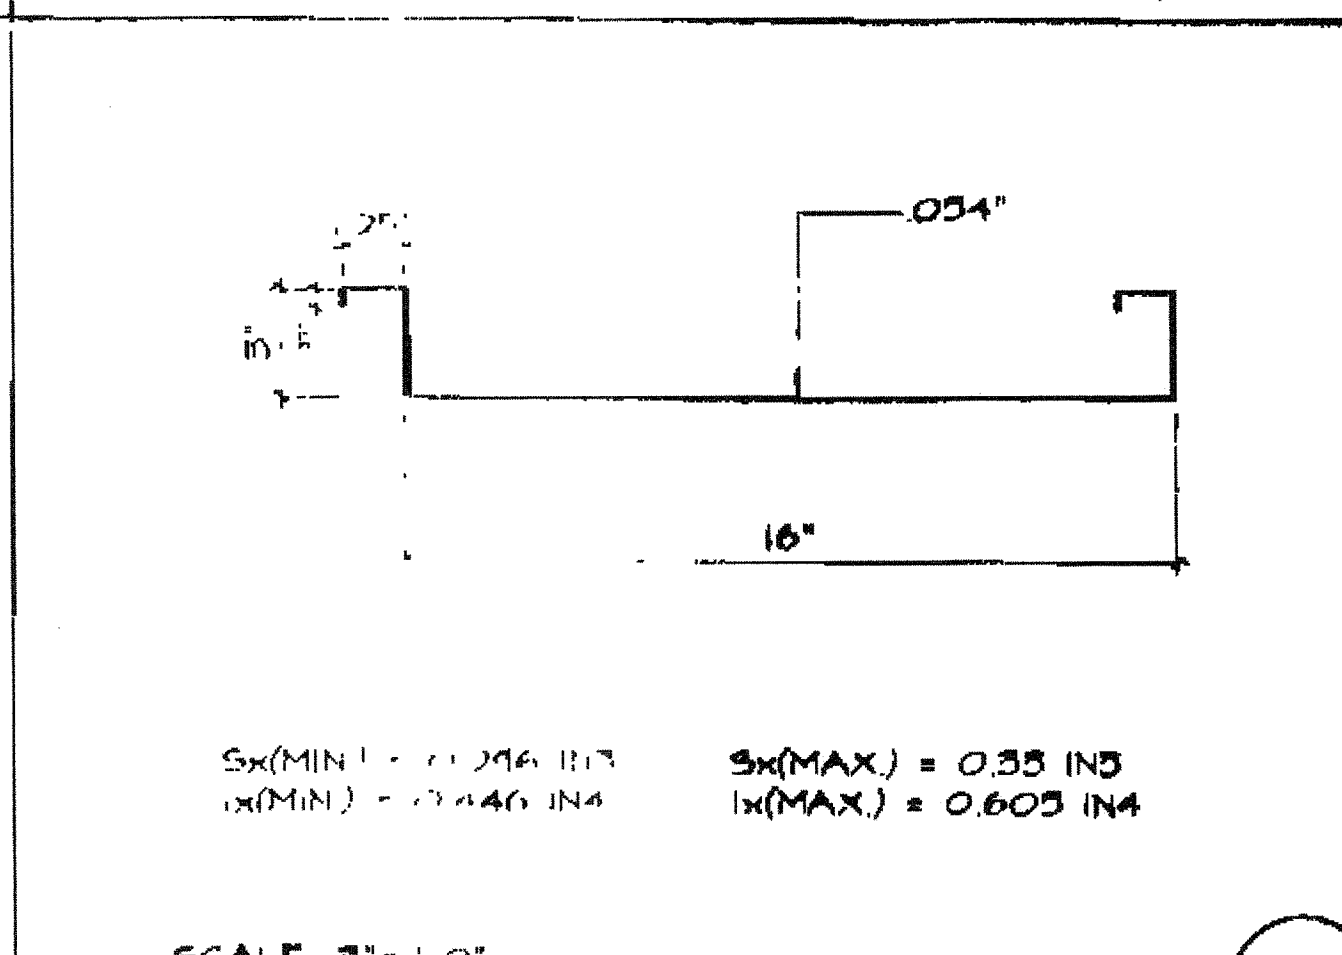


SCALE: 3"=1'
ROOT PAN (22GA.)

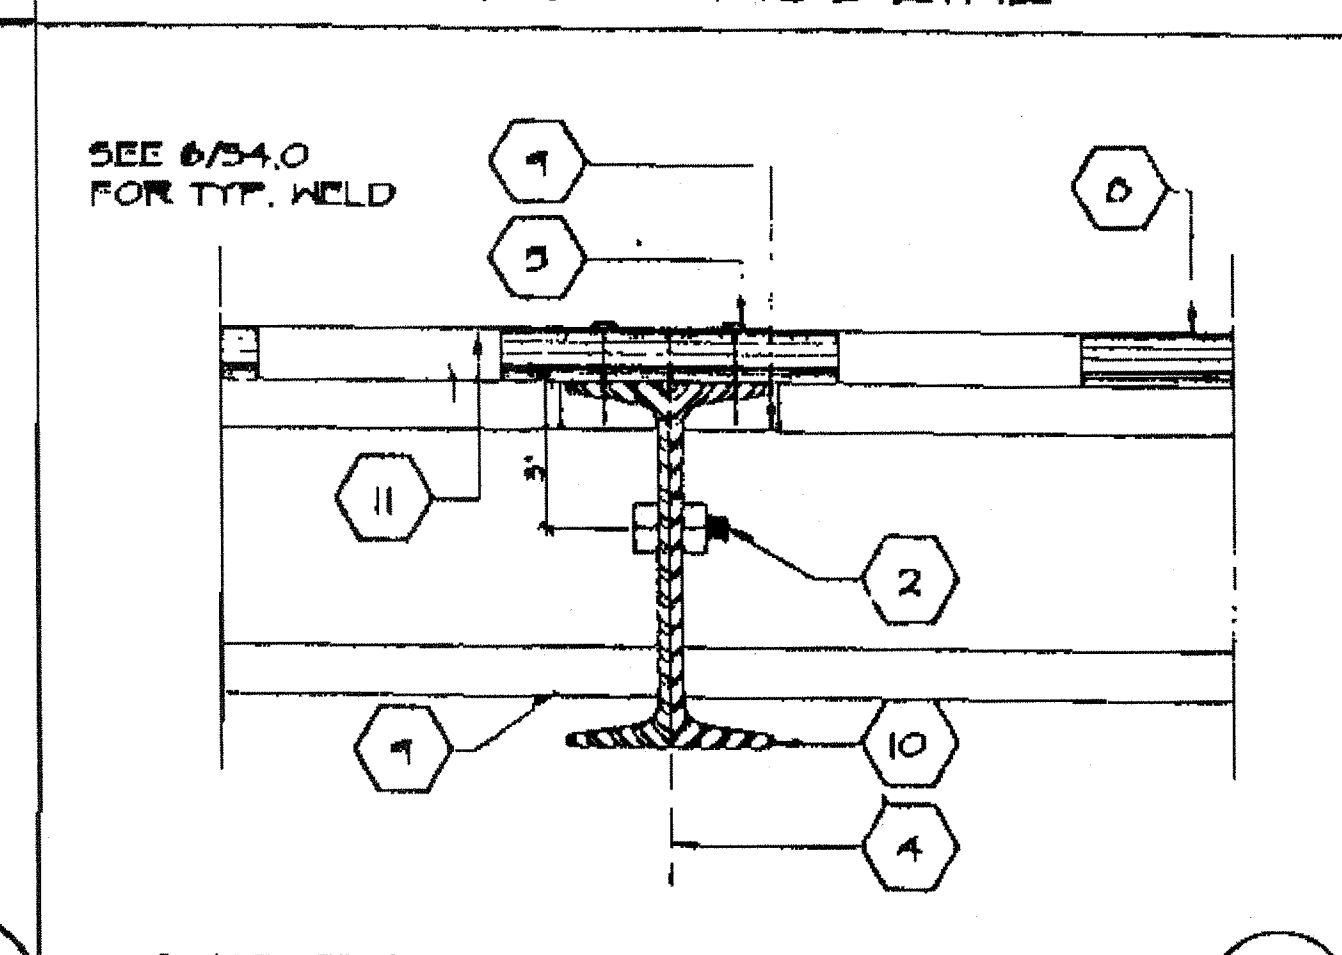


SCALE: 3"=1'
MODULE JOINT @ FLR.

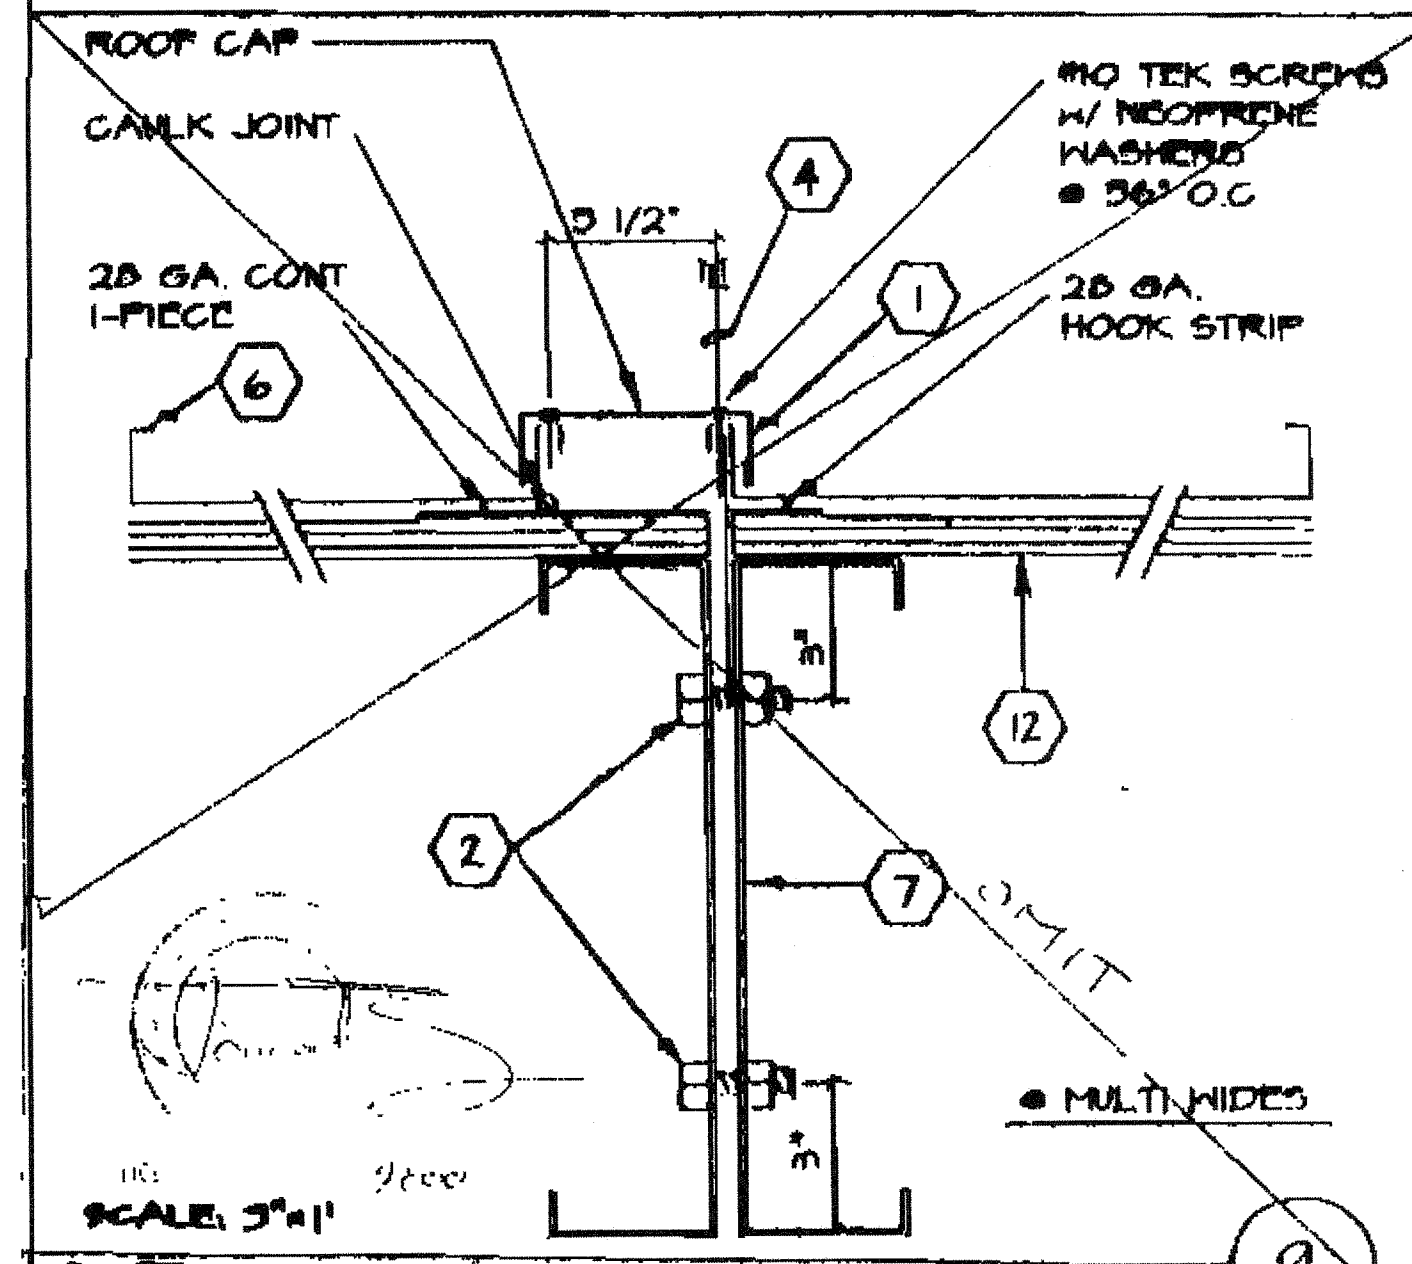

SCALE: 3"=1'
ALT. ROOFING @ MODLINE

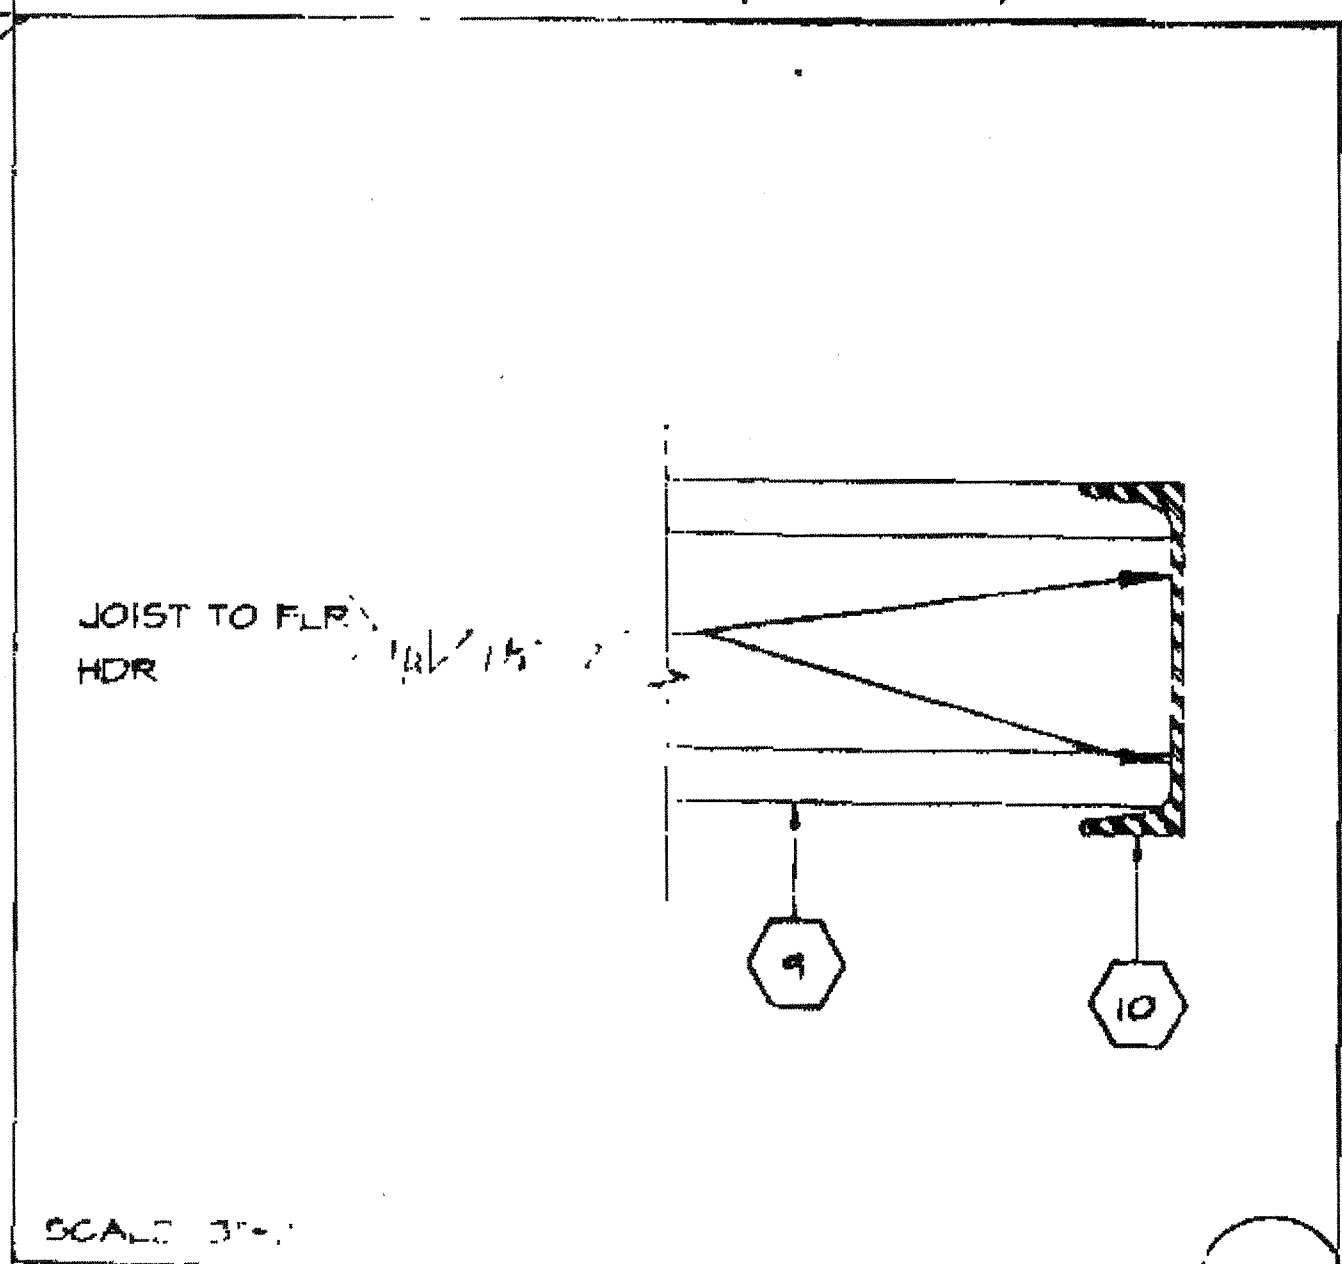

SCALE: 3"=1'
FLOOR JOIST TO BEAM

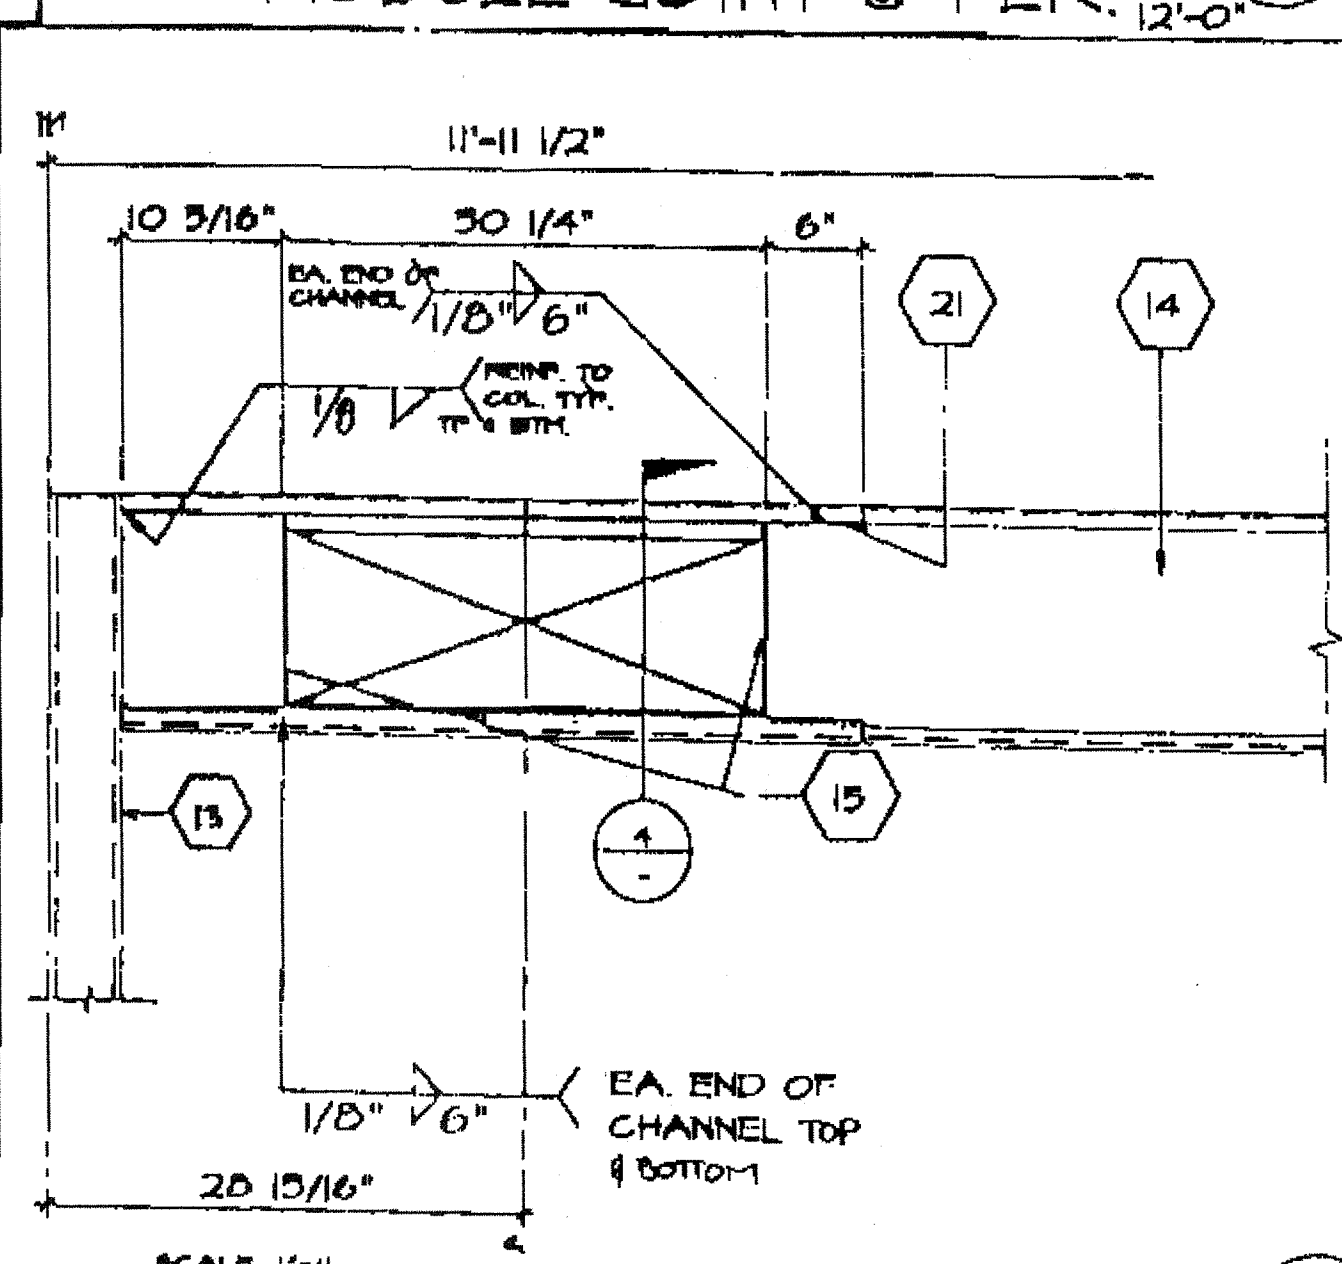

SCALE: 1"=1'
ELEVATION-OPENING



KEY NOTES

- 1 CAP CLOSURE @ MODLINE 26GA. GALV. W/ #10 TYPE FASTENERS W/ NEOPRENE WASHERS TO RID BOTH SIDES OF MODLINE SET CAP IN SEALANT
- 2 5/8" M.B. ABOUT MODULE JOINT (SEE STRUCTURAL PLAN FOR LOCATION) @ 0" O.C.
- 3 EN
- 4 MODULE JOINT
- 5 1/4" @ 0" O.C. FULL DEPTH STIFFENER PLATE (SEE 4/52.1)
- 6 STANDING SEAM ROOF (SEE A2.0)
- 7 ROOF BEAM (SEE STRUCTURAL) SEE 3/52.1 & 12/52.1
- 8 PLYWOOD FLOOR SHEATHING
- 9 FLOOR JOIST 6/52.1
- 10 FLOOR BEAM (SEE STRUCTURAL 5/52.1)
- 11 HAND-HOLE @ BOLT LOCATION
- 12 #14 STMS
- 13 3 1/2"X3 1/2"X1/4" STEEL TUBE COLUMN
- 14 ROOF HEADER (SEE STRUCTURAL 1/52.1)
- 15 1/4" STIFFENER PLATE SEE 4/52.1 FOR TYP. WELD
- 16 CAP CLOSURE AT RIDGE 26GA. GALV. W/ #10 STMS AT 48" O.C. W/ NEOPRENE WASHER TO RID SET BOTH SIDES OF CAP IN SEALANT
- 17 NOT USED
- 18 NOT USED
- 19 NOT USED
- 20 2"X2"X3/16" L
- 21 3 1/4"X1"X45 1/16" LX106A CHANNEL TOP & BOTTOM CENTER OF OPENING
- 22 ROOF FURLIN SEE 2/52.1
- 23 TUBE STEEL (SEE NOTE #13)

IDENTIFICATION STAMP
DIV. OF THE STATE ARCHITECT
APP#3 117168
AC/FLS/SS/JH
Date AUG 04 2016

DATE DEC 11 1996


ARCHITECT ELECTRICAL STRUCTURAL MECHANICAL FIRE MARSHAL ACCESS COMPLIANCE STRUCTURAL SAFETY

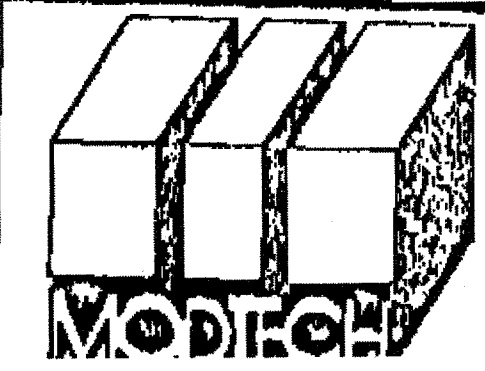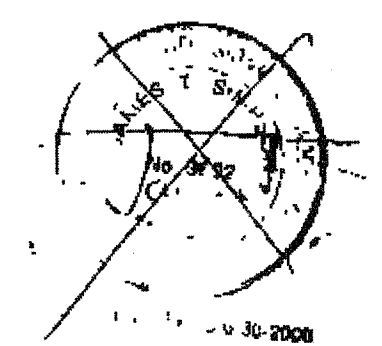


© MODTECH INC. 1994

DRAWN BY
DATE
CHECKED BY
DATE


S1.0

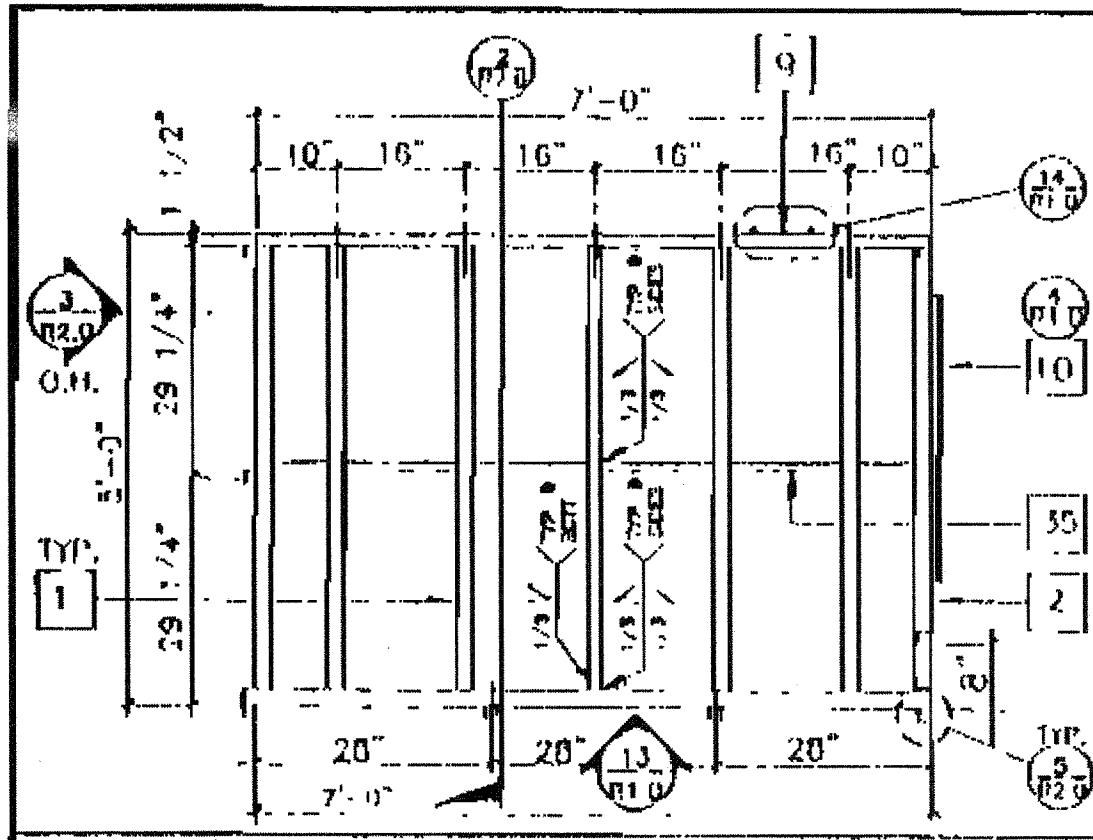


LANDING FRAME 12

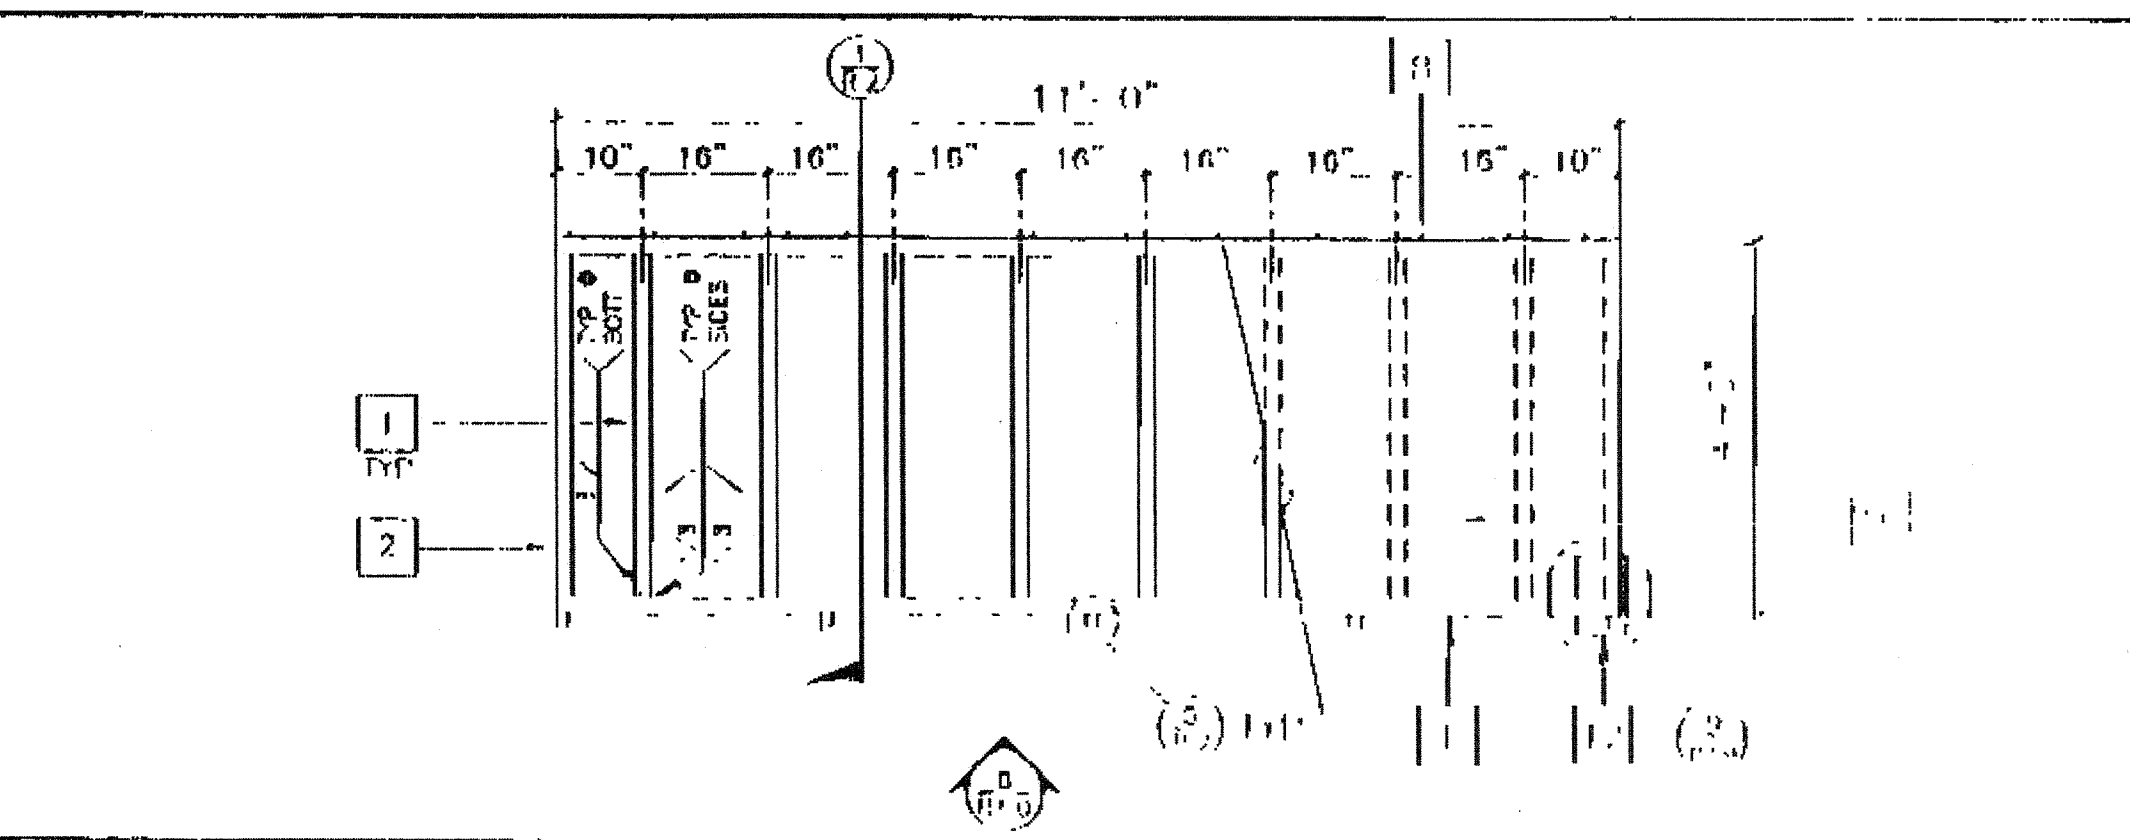


RAMP FRAME 13

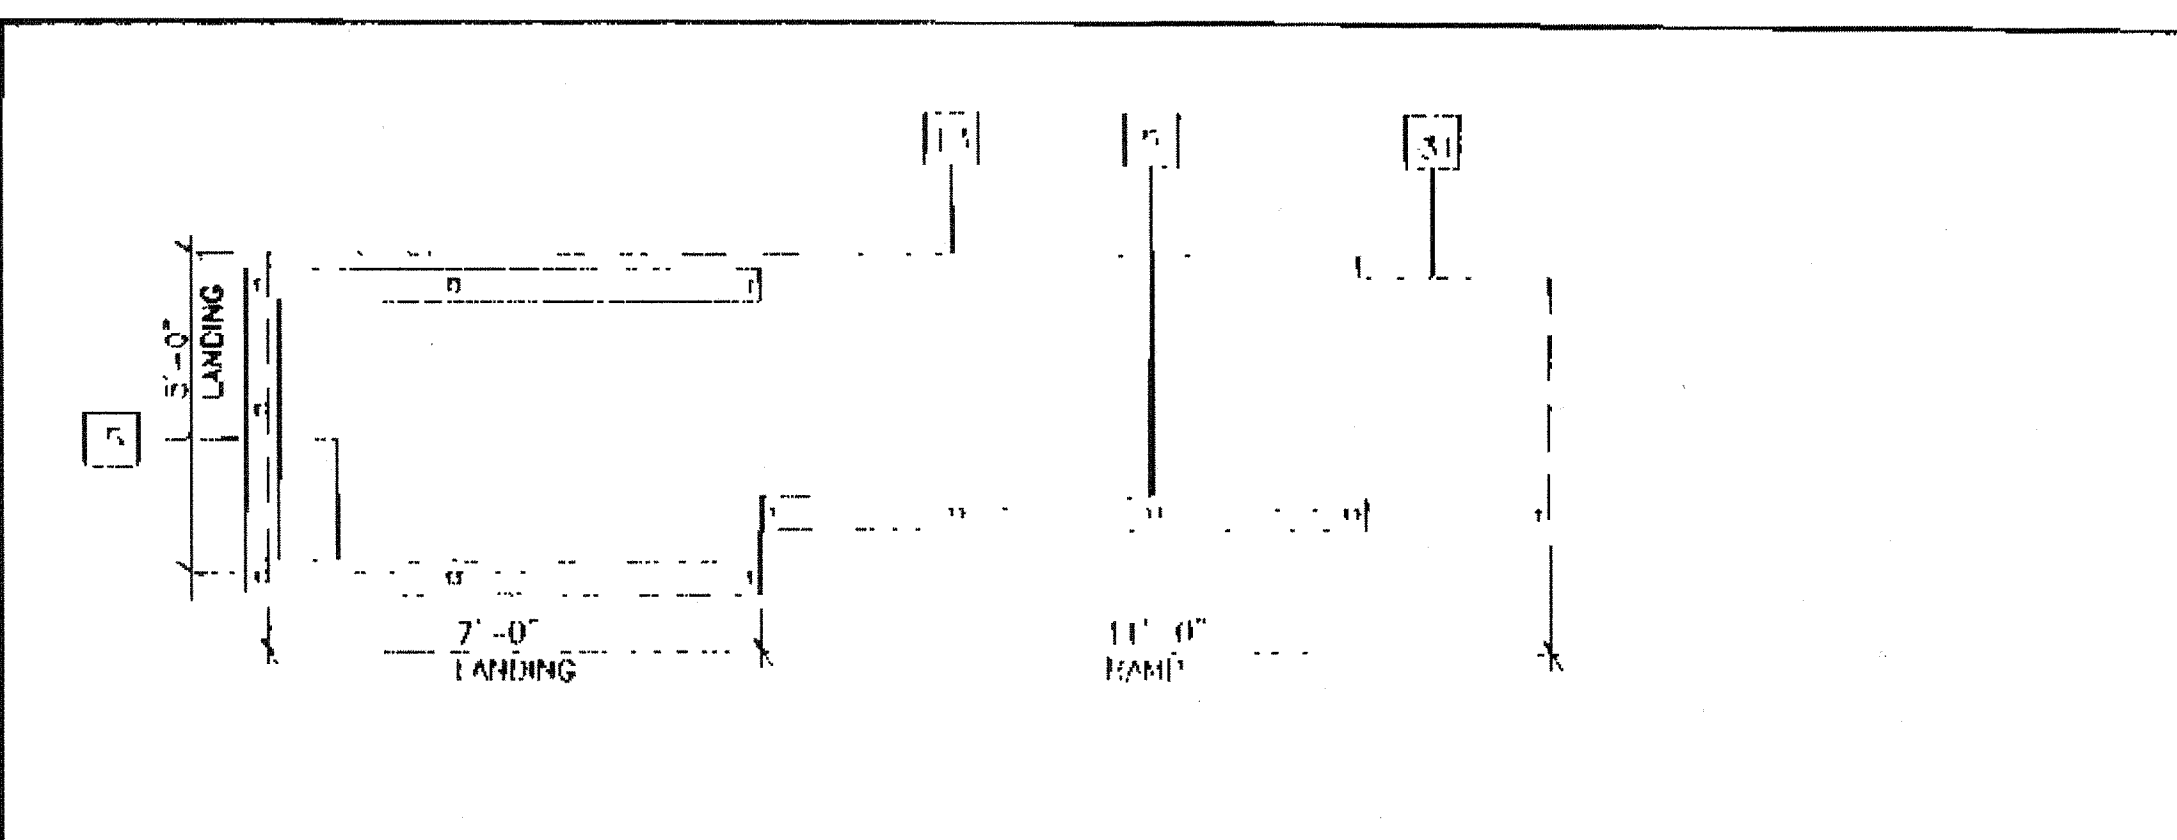


SILL PLAN FOR RAMP AND LANDING 14

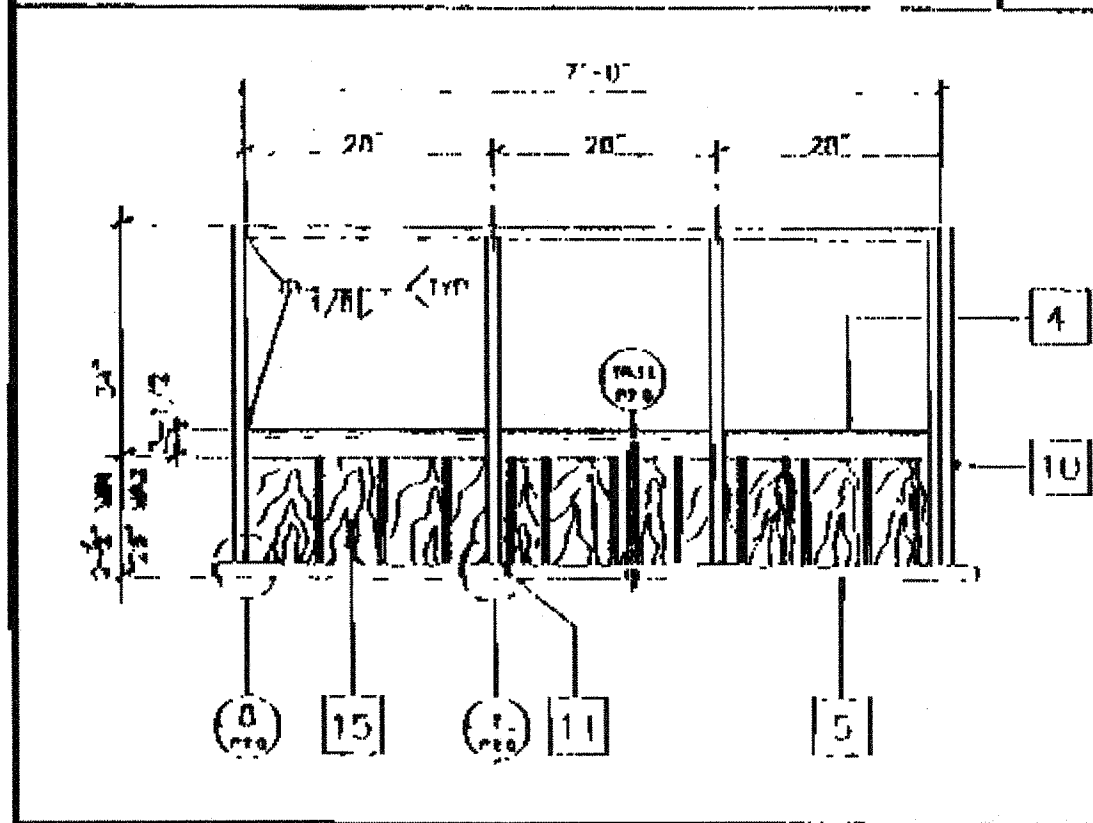


LANDING ELEVATION 15

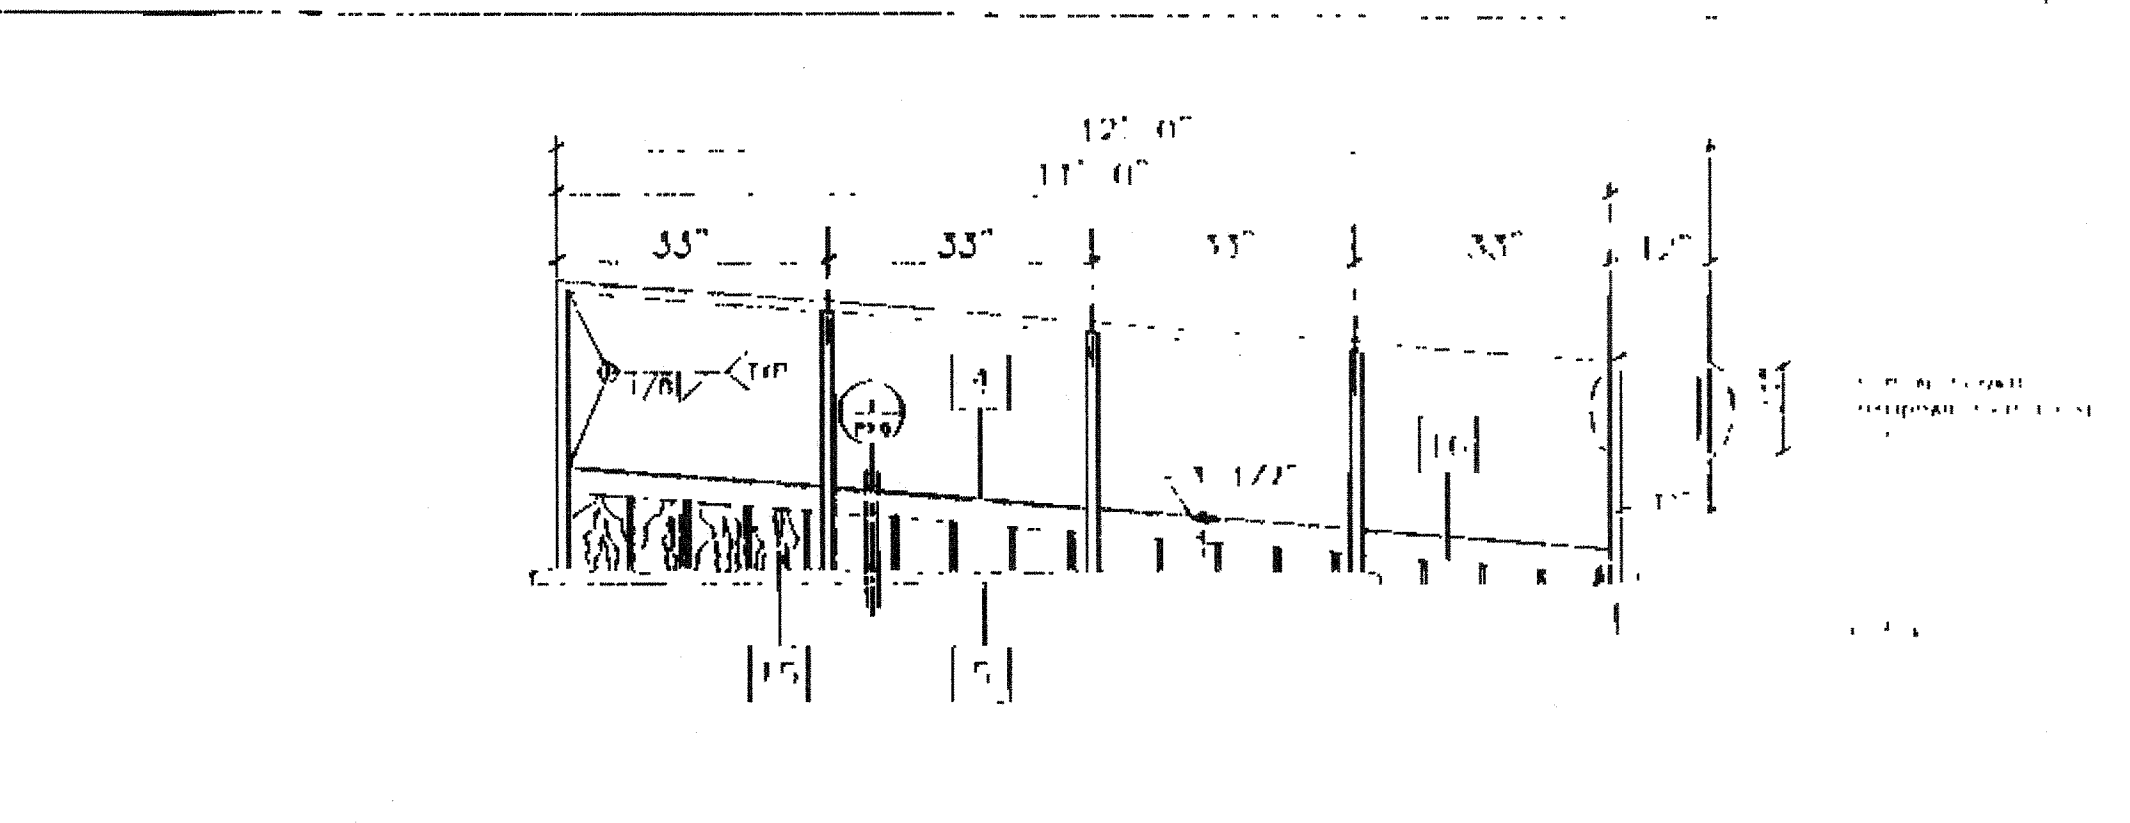


RAMP ELEVATION 16

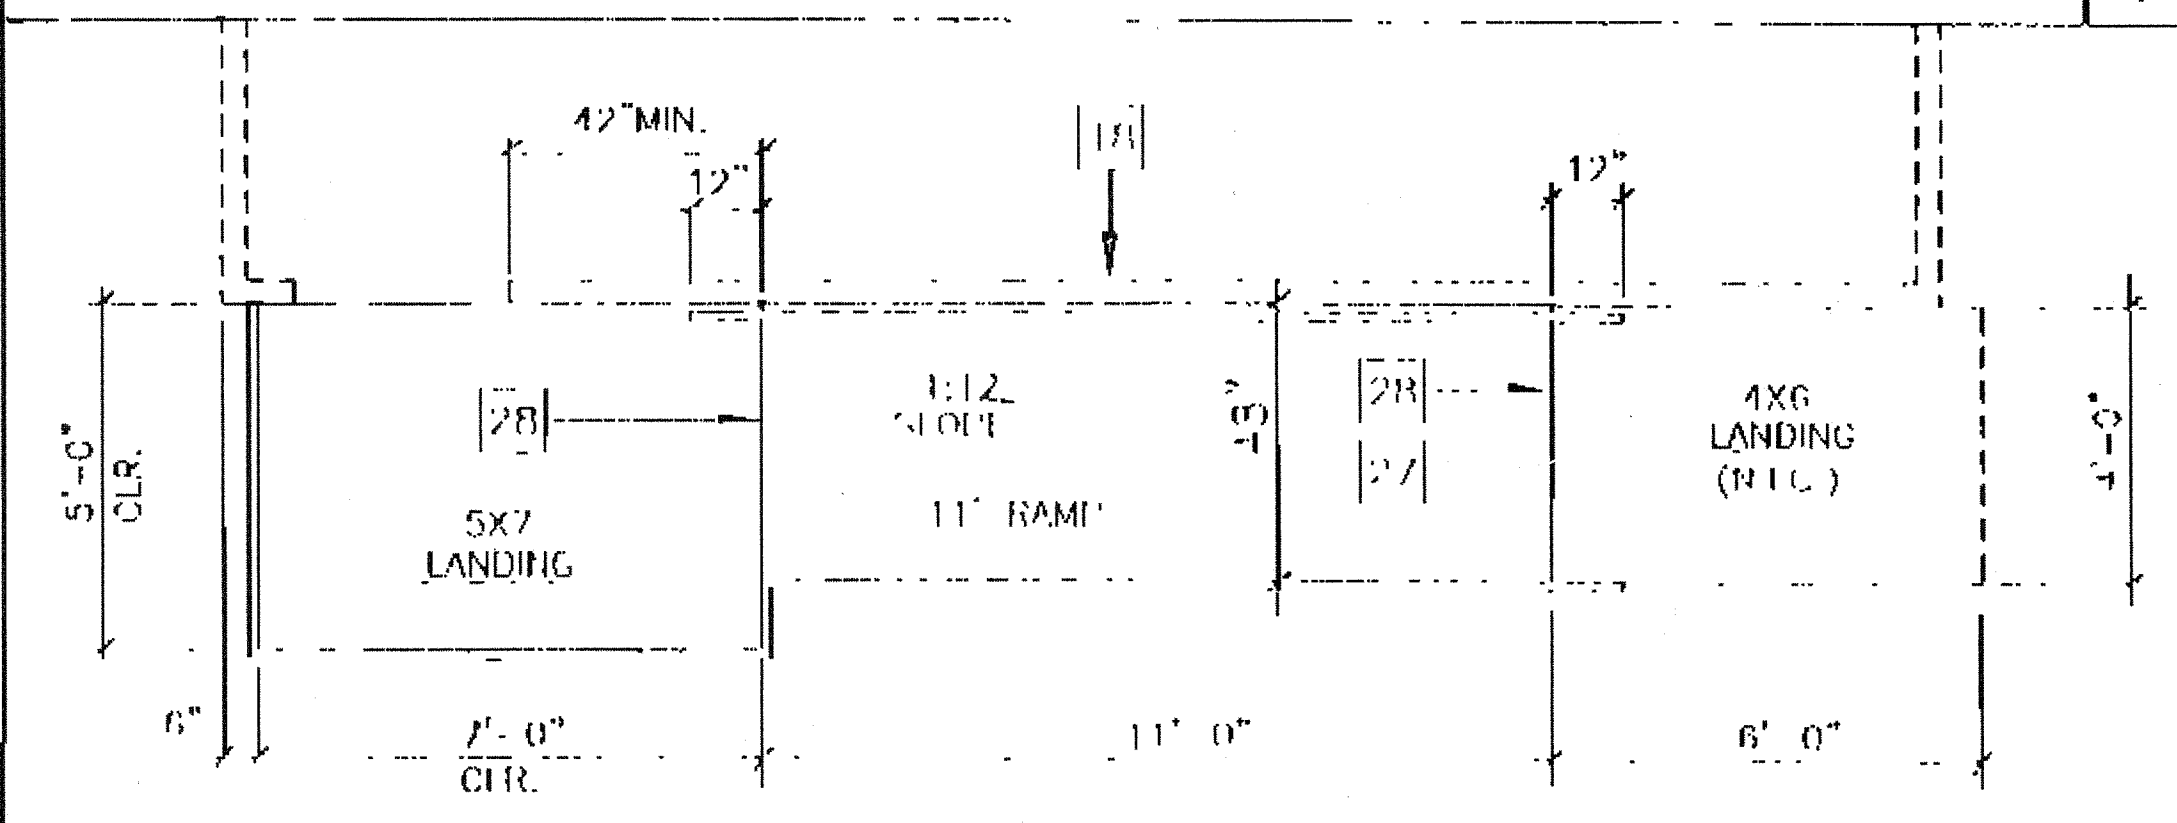


RAMP AND LANDING AT BUILDING 17

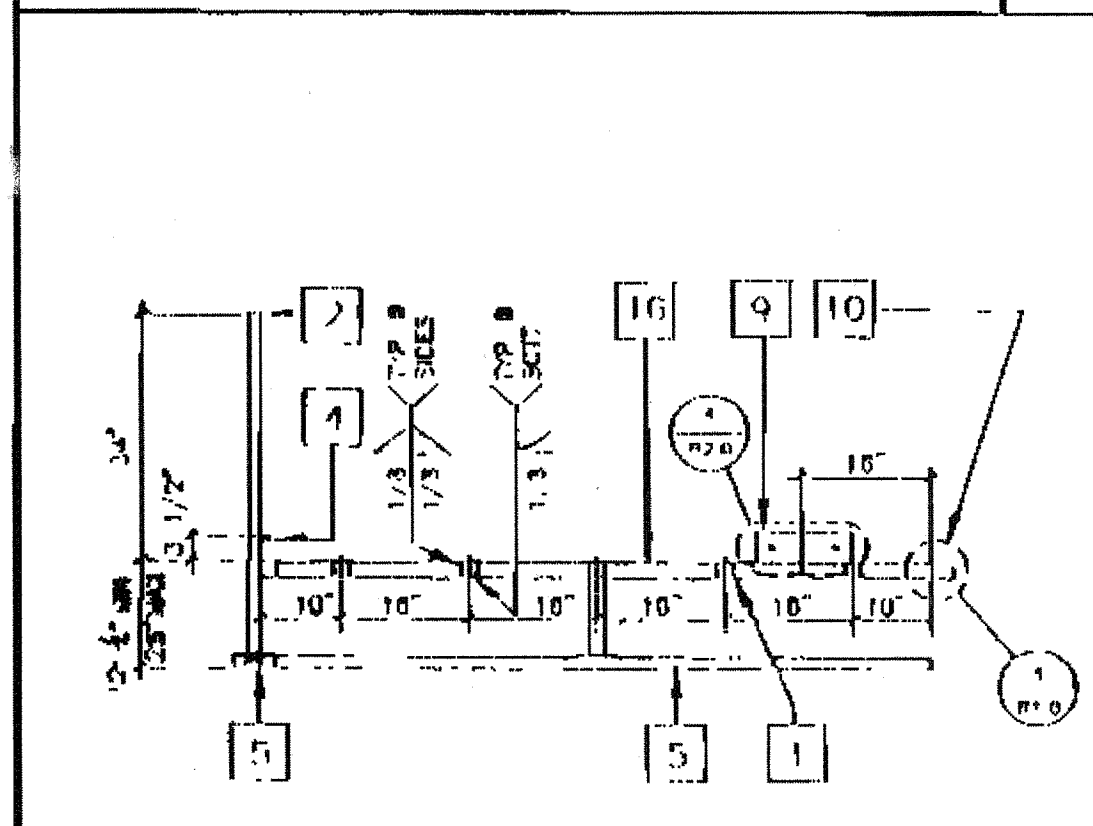


LONG. SECTION @ LANDING 18

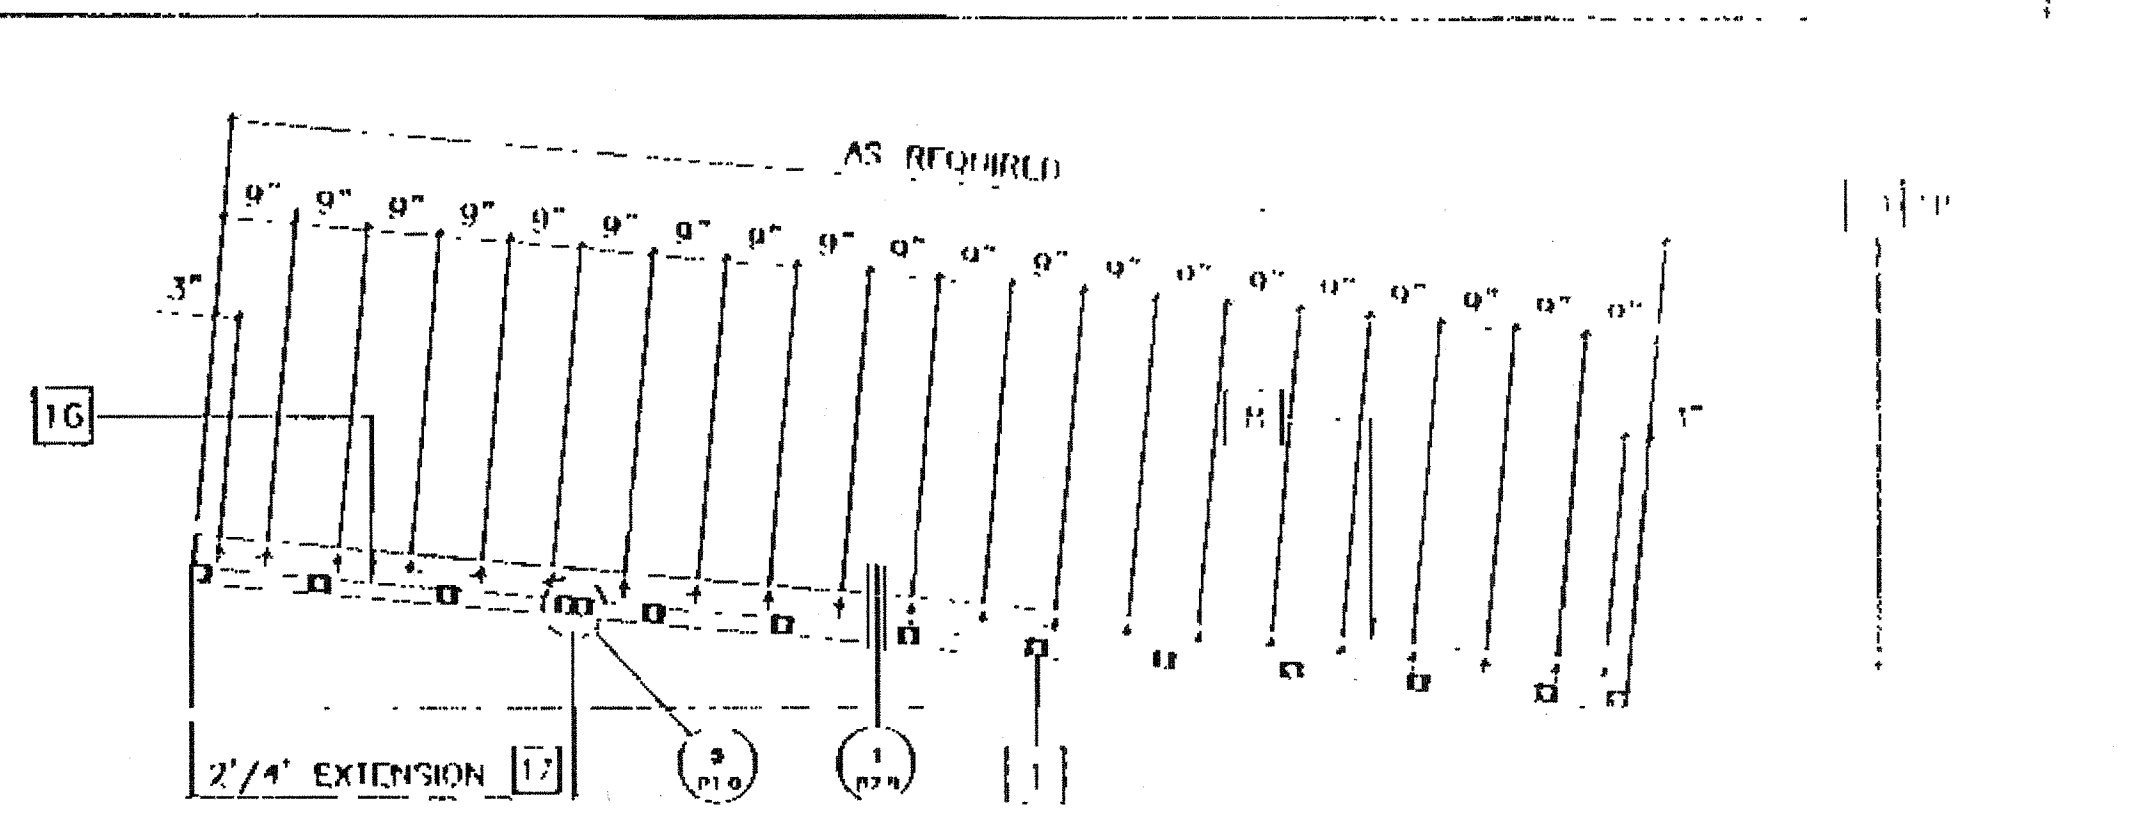


LONGITUDINAL SECTION @ RAMP 19

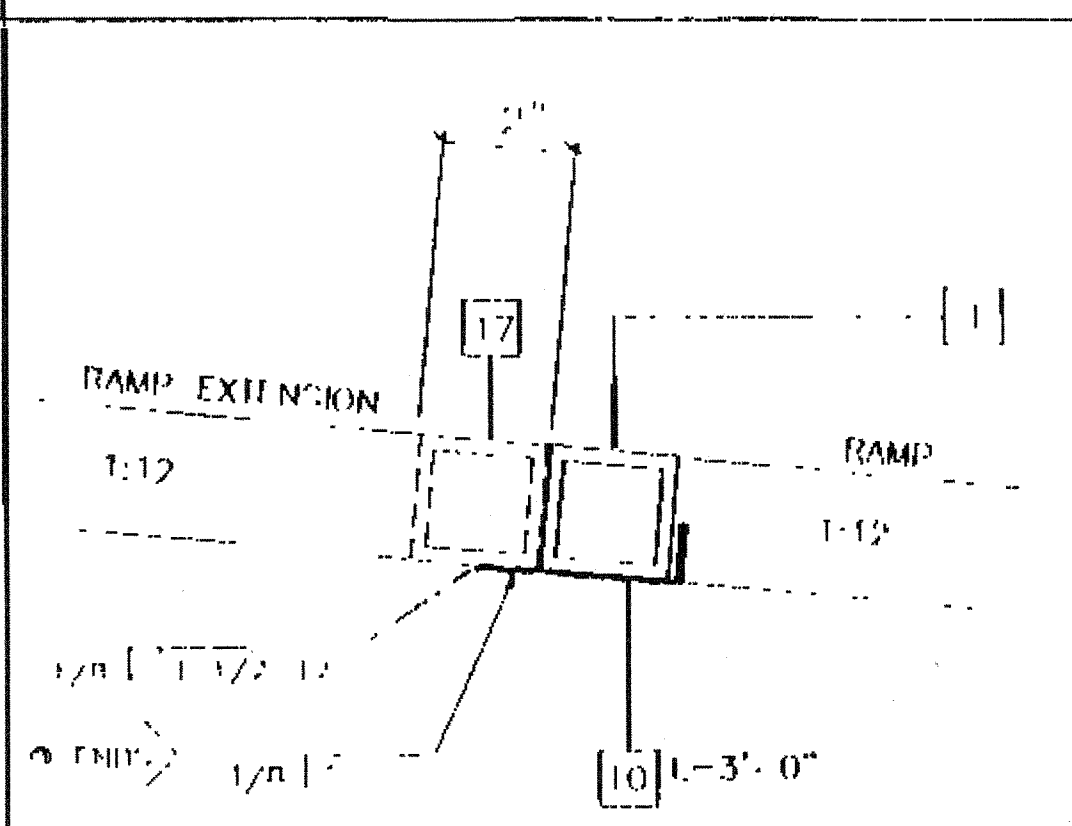


RAMP EXTENSION TO RAMP 20

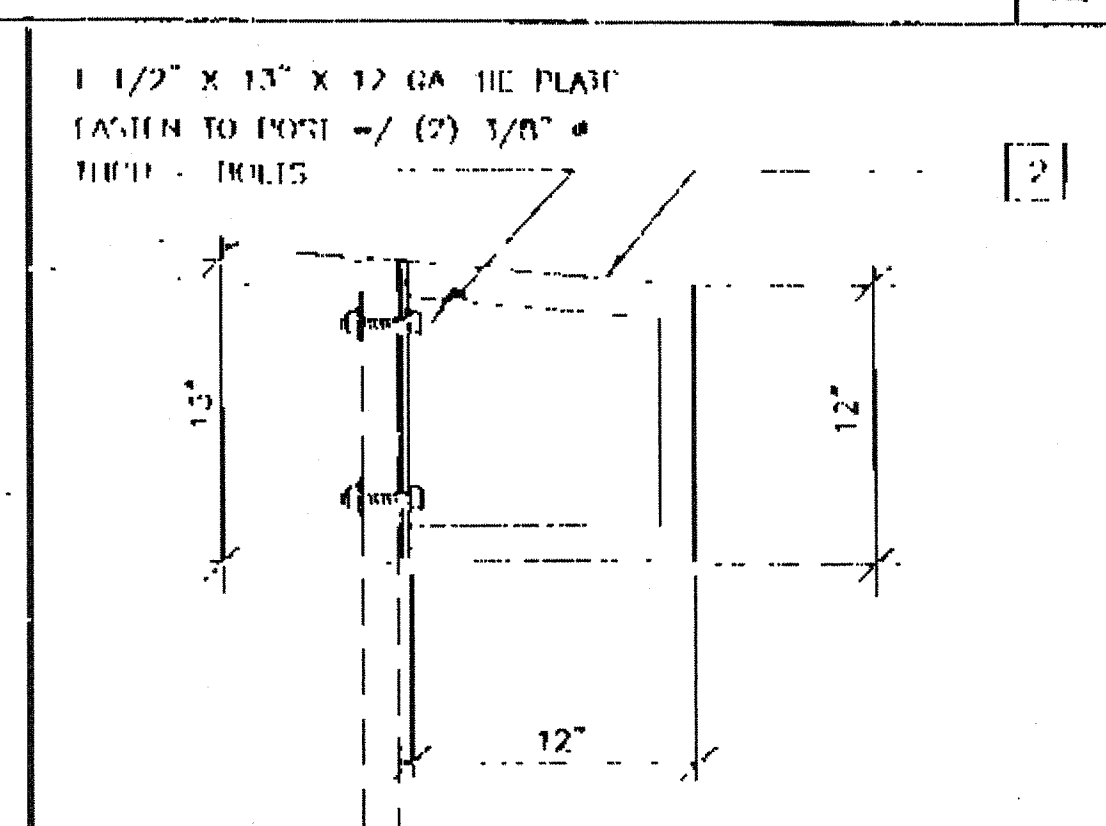

GUARD RAIL EXTENSION 21

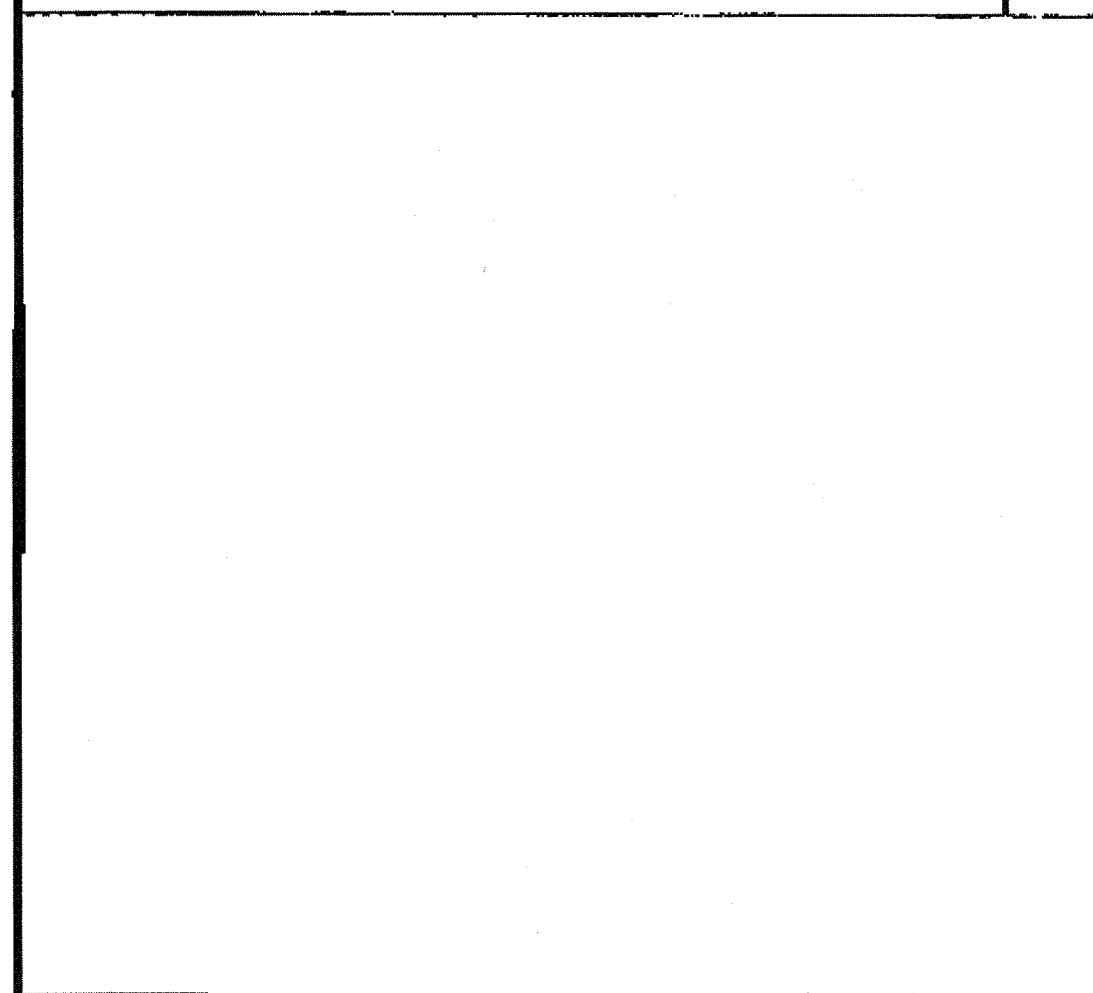

LANDING TO RAMP 22

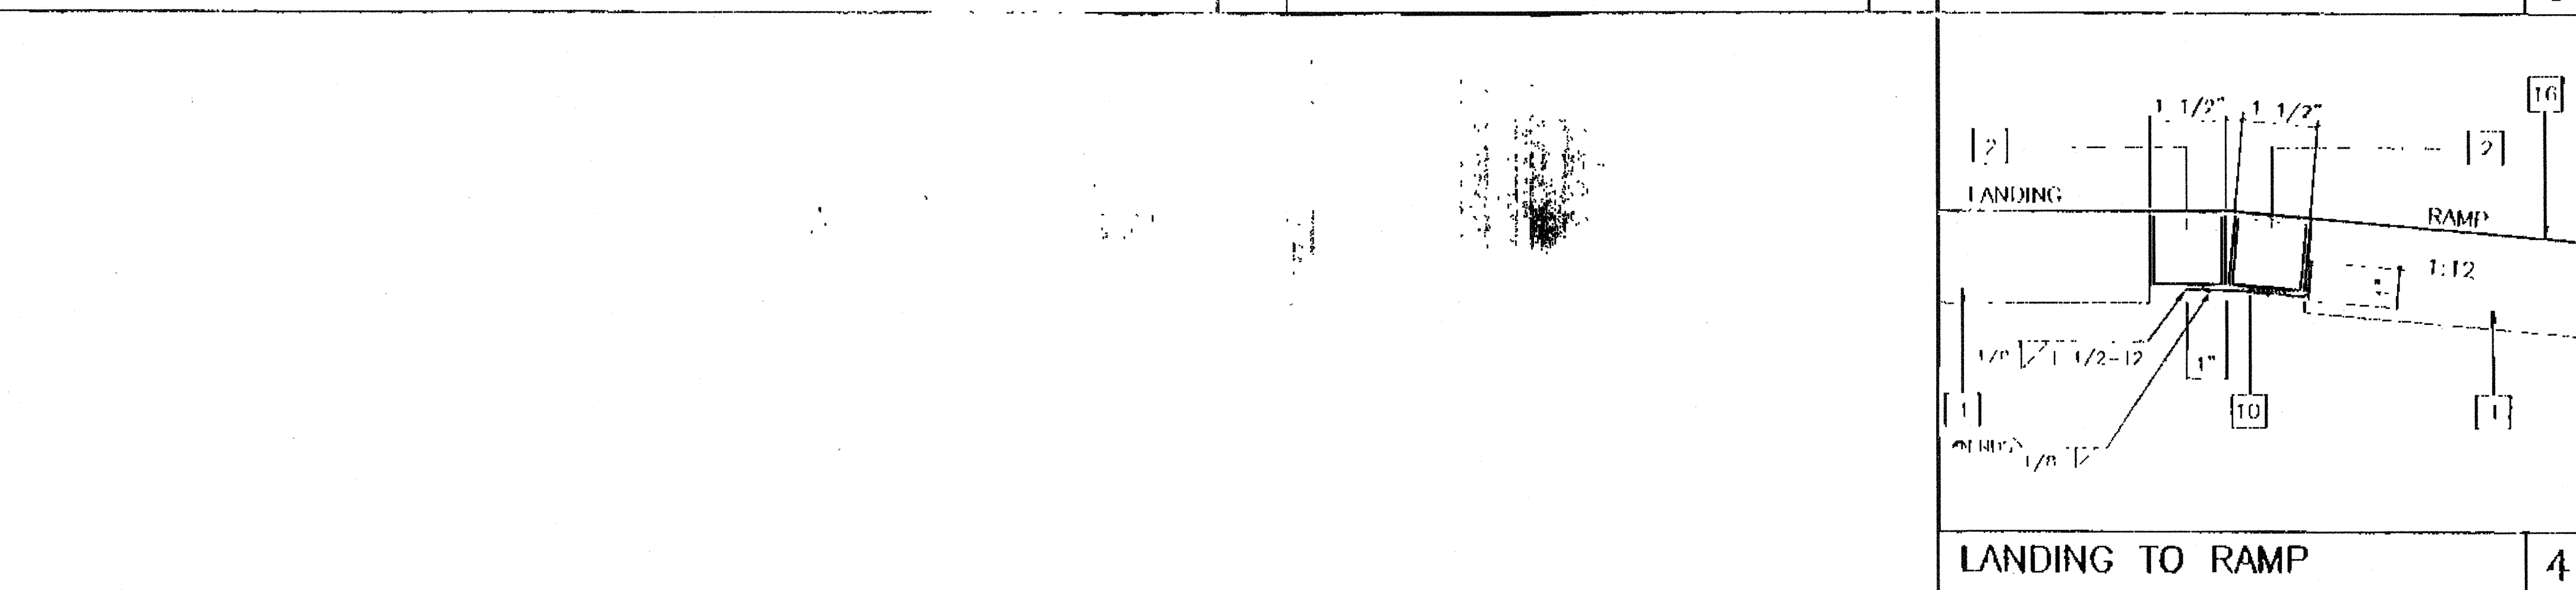

RAMP / LANDING 23

- KEY NOTES**
- TS 2" x 2" x 14ga
 - TS 1 1/2" x 1 1/2" x 14ga (Fy = 39KSI)
 - TS 1" x 1" x 10ga WHEELCHAIR GUID
 - 2 x 4 PI SILL PLATE
 - 6" x 10ga CONT. PLATE W/ 1/4" x 2" TEK SCREWS @ 9" OC INTO WOOD OR FOUND. BLOCKS OR #14 x 2" TEK SCREWS INTO STEEL @ 9" OC
 - 6" x 12" x 10ga PLATE W/ 2-1/4" x 3" LAGS TO STRUCTURAL FRAME OF BUILDING
 - 3" x 1" x 3'-0" x 10ga BENT PLATE
 - 2" x 4" x 12ga BASE PLATE W/ 2-1/4" x 1" LAGS
 - 6" x 10" x 12ga BASE PLATE @ RAMP TOP
 - LINE OF RAMP/LANDING ABOVE
 - LOWER LANDING BY DISTRICT
 - SKIRTING: PLYWOOD TO MATCH BUILDING SIDING BLOCK ALL EDGES, ATTACH W/ #14 @ 6" OC EDGES AND 12" OC FIELD. AT EDGE CONNECTION TO S.S. USE #14 x 2" TEK SCREWS @ 6" OC
 - 12ga METAL DECK: NON-SLIP SURFACE. DESIGN COEFFICIENT OF FRICTION GREATER THAN 0.8, MAINTAINABLE FOR 1 YR.
 - RAMP EXTENSION FRAME.
 - EXISTING BUILDING.
 - RAMP BY MODTECH
 - FLUSH TRANSITION
 - NOTCH BOTTOM PLATE (MUD SILL) AS REQUIRED TO CLEAR RAMP TOP. MAX NOTCH 1 1/2" x 4'-0" LONG.
 - TS 1" x 1" x 10ga

VERIFICATION STAMP
 APP#3 117168
 Date: AUG 04 2008

- NOTES**
- RAMPS: RAMPS SHALL NOT SLOPE MORE THAN 1" IN 12"
 - HANDRAILS: HANDRAILS AT BOTH SIDES OF RAMP AT 34" HT.
 - SURFACE: LANDING & RAMP TO HAVE NON SLIP SURFACE AMCOR GRIP II AS MANUFACTURED BY AMERICAN CHEMICAL COMPANY (OR EQUAL)
 - GROUNDING: PROVIDE GROUNDING OF RAMP TO BING FRAME W/ #6 CU TO BOTH GROUND LUGS.
 - ARCHITECT SITE / RAMP / LANDING PLANNING: DUE TO VARYING SITE CONDITIONS THE MAXIMUM HEIGHT OF FINISH FLOOR FROM GRADE IS 26" THEREFORE IT IS POSSIBLE THAT THE ACCESS RAMP ATTACHED TO THE BUILDING COULD BE 26'-0" AT A SLOPE OF 1:12 ARCHITECT MUST TAKE INTO ACCOUNT THAT THE RAMP SUPPLIED BY MODTECH INC. IS 11'-0" AT A SLOPE OF 1:12 THEREFORE THE ARCHITECT WILL HAVE TO DESIGN AND PROVIDE SUFFICIENT DETAILS OF RAMP EXTENSIONS AND BOTTOM LANDING DEPENDING ON PARTICULAR SITE CONDITIONS. IN NO WAY IS MODTECH INC. RESPONSIBLE FOR ANY RAMP EXTENSION EXCEEDING THE ORIGINAL PLAN AS SHOWN ON SHEET R-1.
 - ALL 1 1/4" AND 1 1/2" TUBE SIZES TO BE OF ASTM A513 GRADE A STEEL (Fy = 39 KSI)


REVISIONS	Electrical Engineer's Seal	Mechanical Engineer's Seal	Structural Engineer's Seal	Architect's Seal

Job Number: PC 275 © MODTECH, INC. 1997

MODTECH INC.
 2030 BARRETT AVENUE
 PERRIS, CALIF. 92572
 PH (909) 943-4014
 FAX (909) 940-0427

drawn by: [Signature]
 date: 11/98
 checked by: [Signature]
 date: [Signature]
 Modtech project no: [Signature]
 MODTECH DRAWING No. **R1.0**

RAMP / LANDING

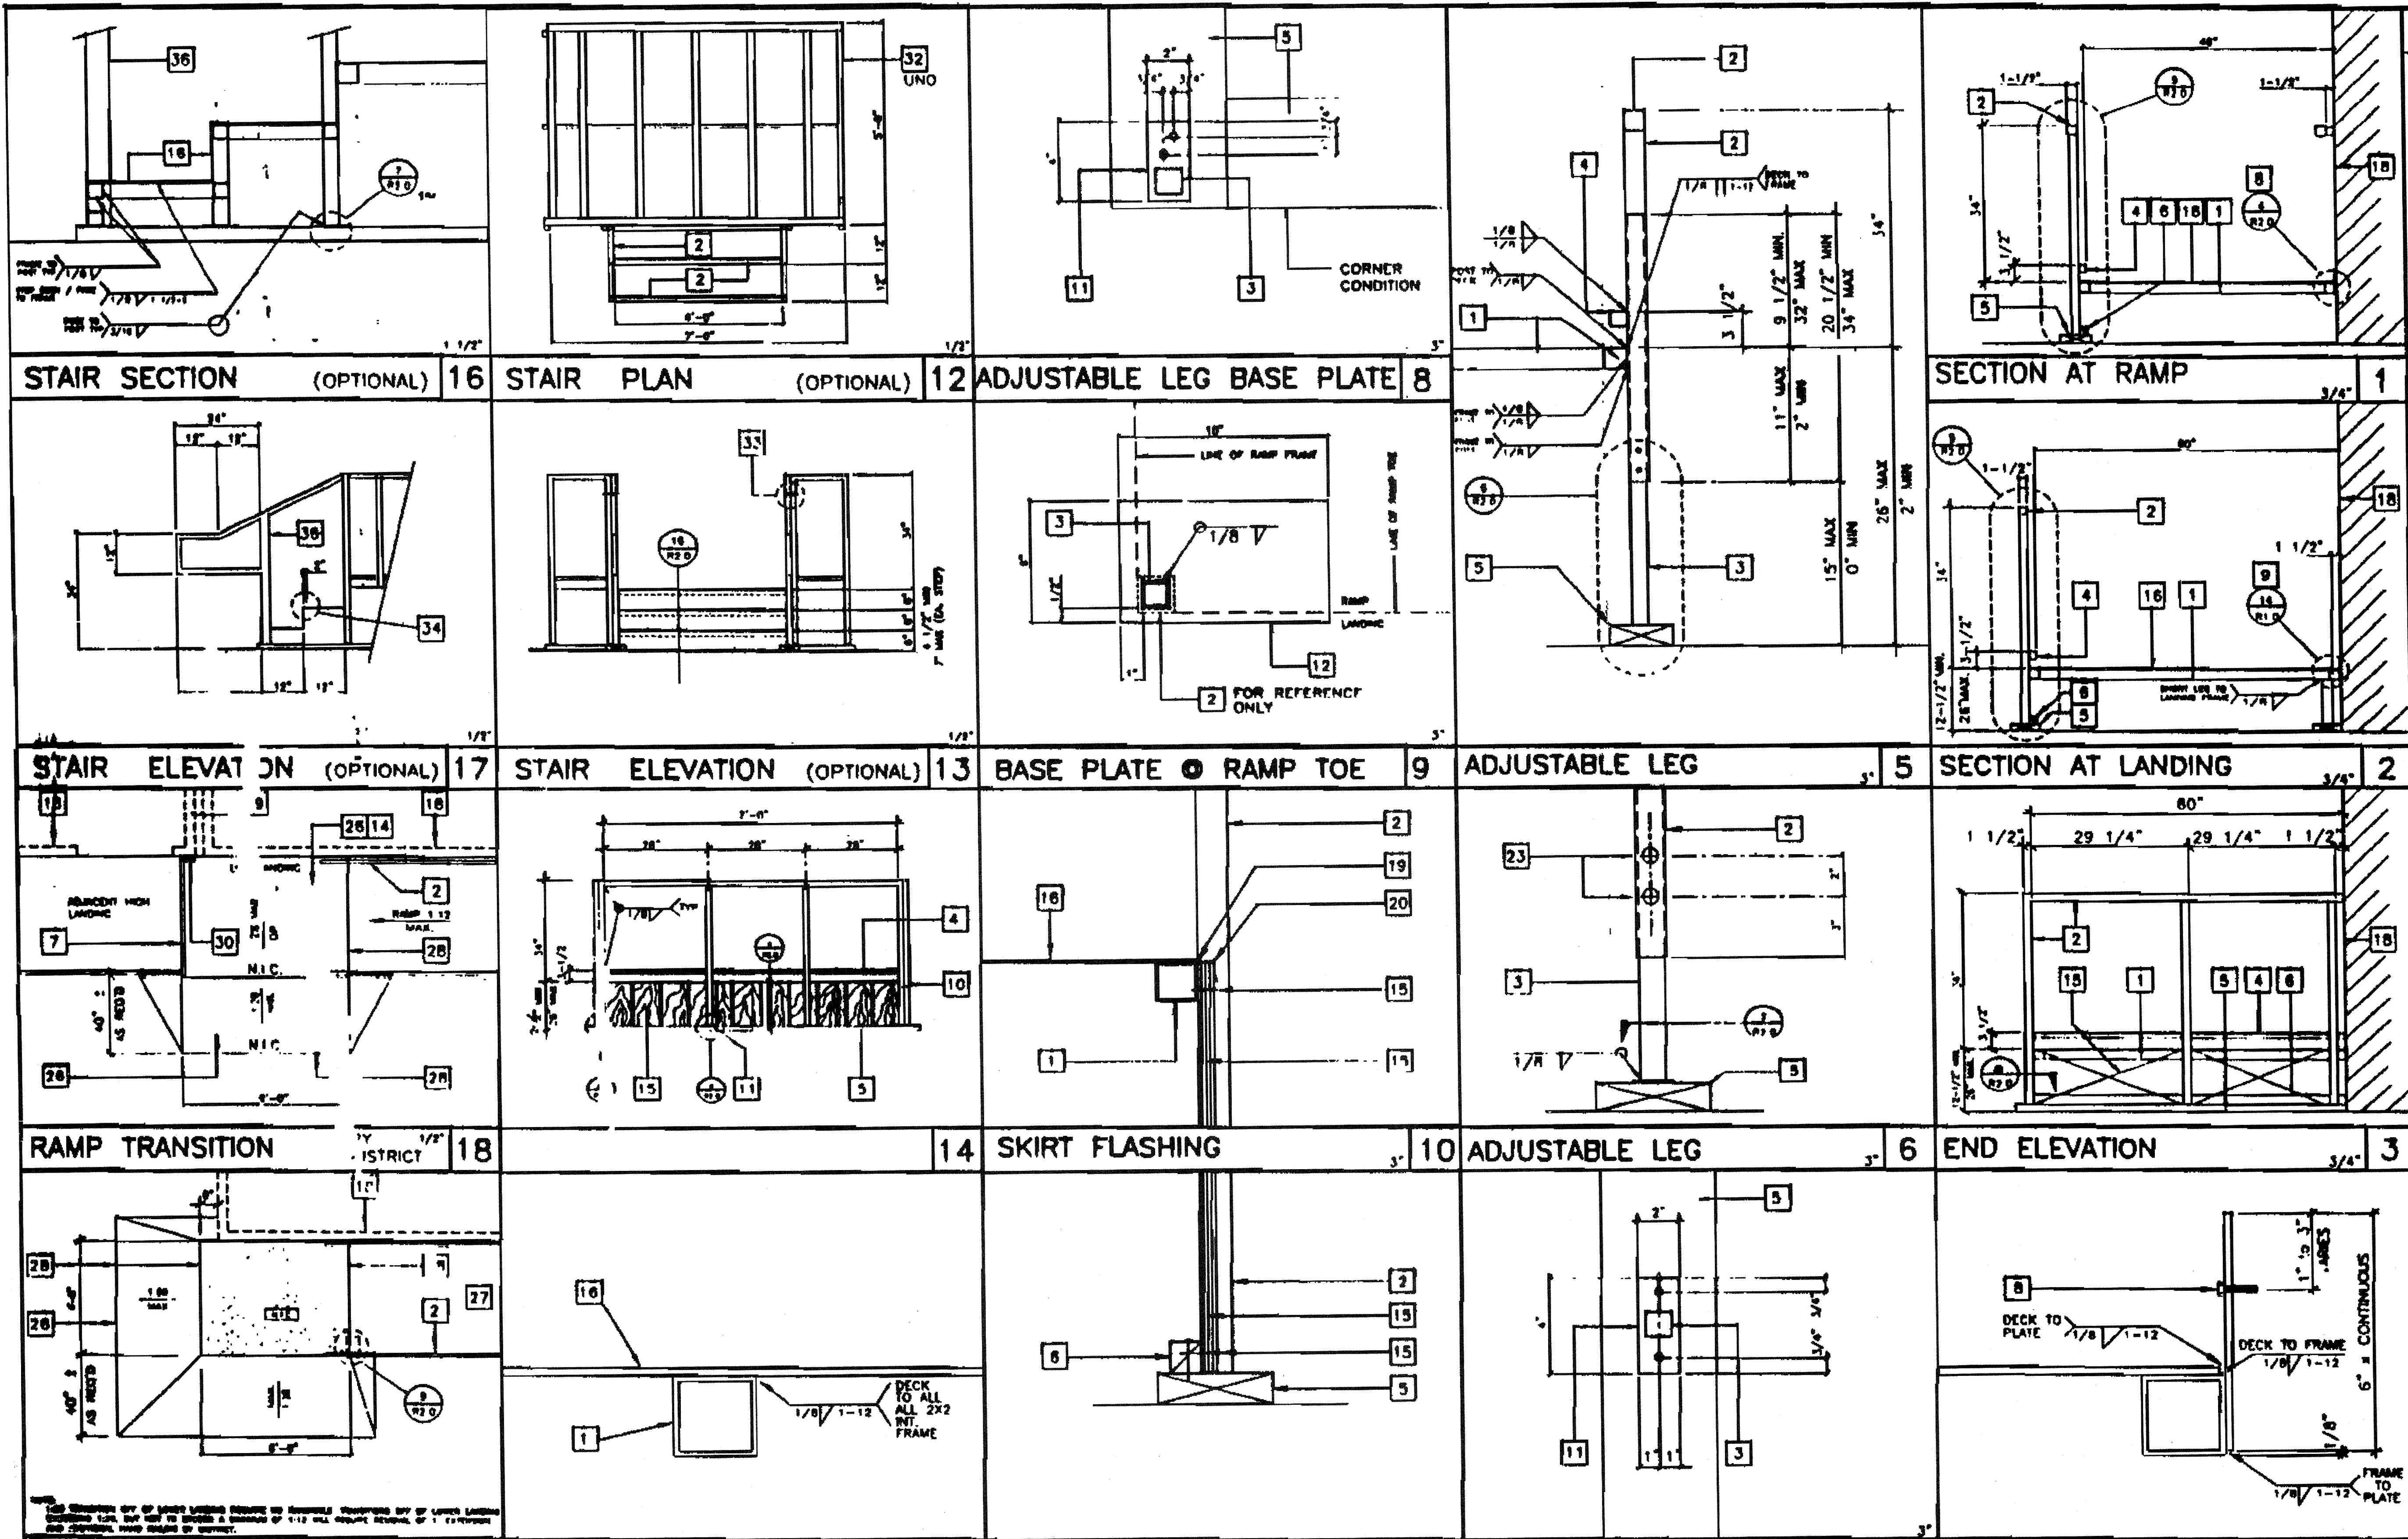

KEY NOTES

- TS 2" x 2" x 14ga
- TS 1 1/2" x 1 1/2" x 14ga (Fy = 36 KSI)
- TS 1 1/4" x 1 1/4" x 14ga (Fy = 36 KSI)
- TS 1" x 1" x 16ga WHEELCHAIR GUIDE
- 2 x 8 FT SILL PLATE
- 2 x 2 HALER W/104 @ 12" OC
- 2 x PW HEADER BY DISTRICT
- 6" x 10ga CONTINUOUS PLATE W/1/4" x 2" TEK SCREWS @ 9" OC INTO WOOD OR TOLERATION BLOCKS OR #14 @ 5" TEK SCREWS INTO METAL W 9" OC
- 2" x 4" x 12ga BASE PLATE W/2-1/4" x 1" LAGS
- 6" x 10" x 12ga BASE PLATE @ RAMP TOE
- LOWER LANDING BY DISTRICT
- EXISTING BUILDING TO MATCH BUILDING EDGE BLOCK
- ALL EDGES, ATTACH W/1/4" x 8" CS EDGES AND 1/4" CS FIELD. AT EDGE CONNECTION TO U.S. USE #14 x 5" TEK SCREWS @ 9" OC
- 12ga METAL DECK: NON-SLIP SURFACE, DESIGN COEFFICIENT OF FRICTION GREATER THAN 0.8. MAINTAINABLE FOR 1 YR EXISTING BUILDING.
- CALLING
- 26 ga FLASHING
- 3/8" dia x 2" LONG MB W/NUT & WASHERS
- PAVE BY DISTRICT.
- RAMP BY MODTECH
- FLUSH TRANSITION
- 3" MINIMUM BUILDING SEVERATION
- PROVIDE DRAINAGE FOR WATER FROM DOWNSPOUT FOR THE CONNECTION. BY DISTRICT
- FOR LANDING DETAILS AND RAMP ATTACHMENT SEE 12/RT.8
- PASTER POSTS W/ 3/8" x THRU BOLT. TYPICAL
- 3" MINIMUM STUDS MAX 1" FROM EVERY STAIR nosing. USE CONTRASTING COLOR.
- TS 2 1/2" x 1 1/2" x 8ga ASTM A500 GRADE A

REVISIONS

1		
2		
3		
Structural Engineer's Seal
Mechanical Engineer's Seal
Structural Engineer's Seal
Architect's Seal

IDENTIFICATION STAMP
DIV. OF THE STATE ARCHITECT
OFFICE OF REGULATION SERVICES
PC 275
DATE: JUN 21 1997
REVISED

MODTECH INC.
2830 BARRETT AVENUE
PERRIS, CALIF. 92572
PH (909) 943-4014
FAX (909) 940-0427

Job Number: PC 275
© MODTECH, INC. 1997
drawn by: [Signature]
checked by: [Signature]
DATE: 11/94

RAMP/STAIR DETAILS R2.0

JOB # 3405

MODTECH DESIGN MT-2440

PC 04-101419

RELOCATABLE CLASSROOM BUILDINGS

BUILDING SIZE: 24'x40'

FOR

WILLIAMS SCOTSMAN

(56) BUILDINGS

STOCKPILE

BUILDING DATA

STRUCTURAL DESIGN: RIGID FRAME
TYPE OF CONSTRUCTION: V-N
WIND LOAD (EXP C): 80 MPH
FLOOR LIVE LOAD: 50 PSF
ROOF LIVE LOAD: 20 PSF
OCCUPANCY: 24'x40' CLASSROOM: E-2

BUILDING AREA:
24'x40' BUILDING - 960 SF

APPLICABLE CODES

- TITLE 24, CCR, PART 2, 1995 CBC (97 UBC W/98 CA AMENDMENTS)
- 1997 UBC & 1998 CA AMENDMENTS (98 CBC - PART 2, TITLE 24, CCR)
- 1998 NEC & 1998 CA AMENDMENTS (98 CEC - PART 3, TITLE 24, CCR)
- 1997 UMC & 1998 CA AMENDMENTS (98 CMC - PART 4, TITLE 24, CCR)
- 1997 UPC & 1998 CA AMENDMENTS (98 CPC - PART 5 TITLE 24, CCR)
- 1997 UFC & 1998 CA AMENDMENTS (98 CFC - PART 9, TITLE 24, CCR)
- 1998 CA BUILDING STANDARDS CODE
- TITLE 19, CCR, PUBLIC SAFETY, STATE FIRE MARSHAL REGULATIONS.

LEGEND

SYMBOL	DESCRIPTION
	DETAIL (1) ON SAME SHEET AS SYMBOL
	DETAIL (1) ON SHEET (2)
	KEY NOTE (1) ON SAME SHEET AS SYMBOL
	SECTION "A" ON SHEET (2)
	REVISION/CHANGE IN DRAWING. (1) IS FIRST REVISION
	HIGHLIGHTS CHANGED AREA
	DOOR REFERENCE
	WINDOW REFERENCE
	ELECTRICAL ITEM(S) SEE ELECTRICAL DRAWINGS
	HEATING/VENTILATING & AIR CONDITIONING ITEM(S) SEE MECHANICAL DRAWINGS
	PLUMBING ITEM(S) SEE MECHANICAL DRAWINGS
	STRUCTURAL ITEM(S) SEE STRUCTURAL DRAWINGS
	FINISH ITEM(S) SEE FINISH SCHEDULE
	RAMP - SEE RAMP DRAWINGS

ABBREVIATIONS

- AGC - ABOVE GRADE CONCRETE
- BGC - BELOW GRADE CONCRETE
- DIA - DIAMETER
- CLR - CLEAR
- GA - GAUGE
- SIM - SIMILAR
- MAX - MAXIMUM
- MIN - MINIMUM
- NIC - NOT IN CONTRACT
- NTS - NOT TO SCALE
- OC - ON CENTER
- OD - OUTSIDE DIAMETER
- OSB - ORIENTED STRAND BOARD
- ROH - ROOF OVERHANG
- SIM - SIMILAR
- STS - SELF TAPPING SCREW
- STSMS - SELF TAPPING SHEET METAL SCREW
- TYP - TYPICAL
- UN - UNLESS OTHERWISE NOTED

WITH THE SIGNING OF THESE DRAWINGS, WE ACKNOWLEDGE THAT WE HAVE REVIEWED THESE PLANS AND SPECIFICATIONS AND HAVE FOUND THEM TO BE IN GENERAL COMPLIANCE WITH THE BID DRAWINGS, SPECIFICATIONS AND ASSOCIATED ADDENDA, WHEN THESE PLANS AND SPECIFICATIONS HAVE BEEN APPROVED BY THE DIVISION OF THE STATE ARCHITECT. THEY SHALL PRESIDE OVER CONFLICTING AREAS IN THE BID DRAWINGS AND SPECIFICATIONS, AND ANY ADDENDA THERETO.

CONFIDENTIAL - THIS DOCUMENT AND THE INFORMATION CONTAINED HEREIN ARE THE PROPERTY OF MODTECH, INC. UNAUTHORIZED COPYING, DISCLOSURE OR OTHER UNAUTHORIZED USES ARE PROHIBITED.

SHEET INDEX

ARCHITECTURAL

A.0	TITLE SHEET
A1.0	FLOOR PLAN 24'x40'
A2.0	ROOF PLAN (DUAL PITCH) 24'x40'
A3.0	EXTERIOR ELEVATIONS (DUAL PITCH) 24'x40' W/ FASCIA
A4.0	INTERIOR ELEVATIONS 24'x40'
A5.0	DUAL MINIMUM TORSION MAXIMUM MINIMUM
A6.0	MULTI-PARTITION DESIGN (TYPICAL)
A7.0	ARCHITECTURAL DETAILS (TYPICAL)

REFLECTED CEILING PLAN (SCHEDULE) (1) IS UNIFORM

REFLECTED CEILING PLAN

STRUCTURAL

F1.0	FOUNDATION PLAN (24 x 40) 50 PSF LL (WOOD)
F2.0	FOUNDATION DETAILS (WOOD)
S1.0	FLOOR FRAMING PLAN 50 PSF LL
S1.2	FLOOR FRAMING DETAILS (TYPICAL)
S2.0	ROOF FRAMING PLAN (DUAL PITCH) W/ FASCIA
S2.1	ROOF FRAMING DETAILS (TYPICAL)
S3.0	STRUCTURAL ELEVATIONS & DETAILS (DUAL PITCH)
S4.0	WALL FRAMING (WOOD)
S5.0	WALL FRAMING DETAILS (WOOD)

MECHANICAL

M1.0	MECHANICAL (HVAC) PLAN 24'x40' 2 1/2" TUB
------	---

ELECTRICAL

E1.0	ELECTRICAL PLAN 24'x40'
------	-------------------------

RAMP

R1.00	RAMP/LANDING PLAN W/ 11" RAMP
R1.02	RAMP/STAIRS DETAILS

IDENTIFICATION STAMP
DIV. OF THE STATE ARCHITECT
APP#3 117168
AC / FLS / SS / TH
Date AUG 8 2016

IDENTIFICATION STAMP
DIV. OF THE STATE ARCHITECT
OFFICE OF REGULATION SERVICES
AC / FLS / SS / TH
DATE MAR 19 2016
PLS: E.P. 10/22/99
ACP: G. 12/05
SS: C.P. 10/22/99

JOB # 3405

CBC 1997

PC

REVISIONS

NO.	DESCRIPTION	DATE	BY


Electrical Engineer's Seal

Mechanical Engineer's Seal

Architect's Seal



IDENTIFICATION STAMP
DIV. OF THE STATE ARCHITECT
OFFICE OF REGULATION SERVICES
PC-04
101419
DATE: 10/22/99
ACP: D. PENNELL
PW: E.P. 10/22/99

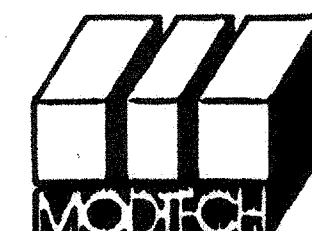

MODTECH INC.
2830 BARRETT AVENUE
PERRIS, CALIF. 92572
PH (909) 943-4014
FAX (909) 940-0427

PROJECT NUMBER: 3405




© MODTECH, INC. 1999

DRAWN BY: SS
DATE: 10/22/99
CHECKED BY: SS
DATE: 10/22/99
MODTECH Index No.

COVER SHEET

A.0

3405

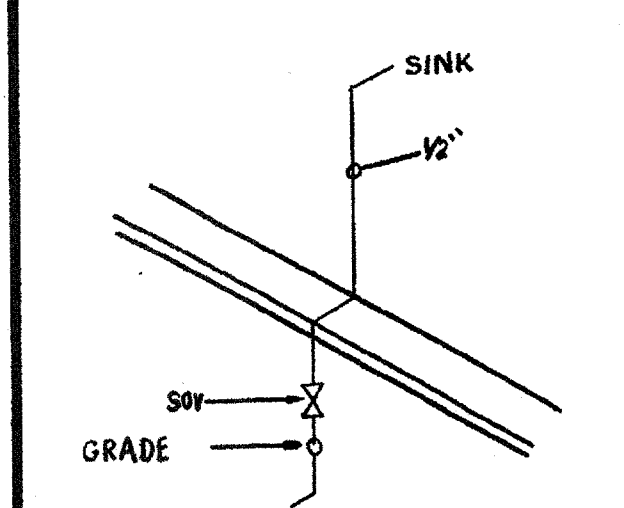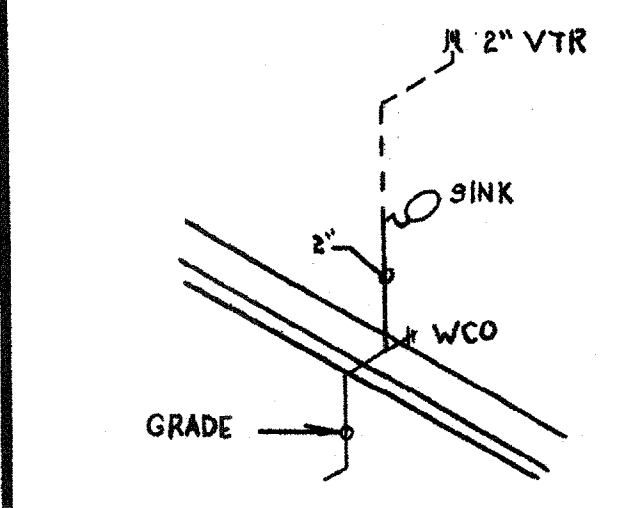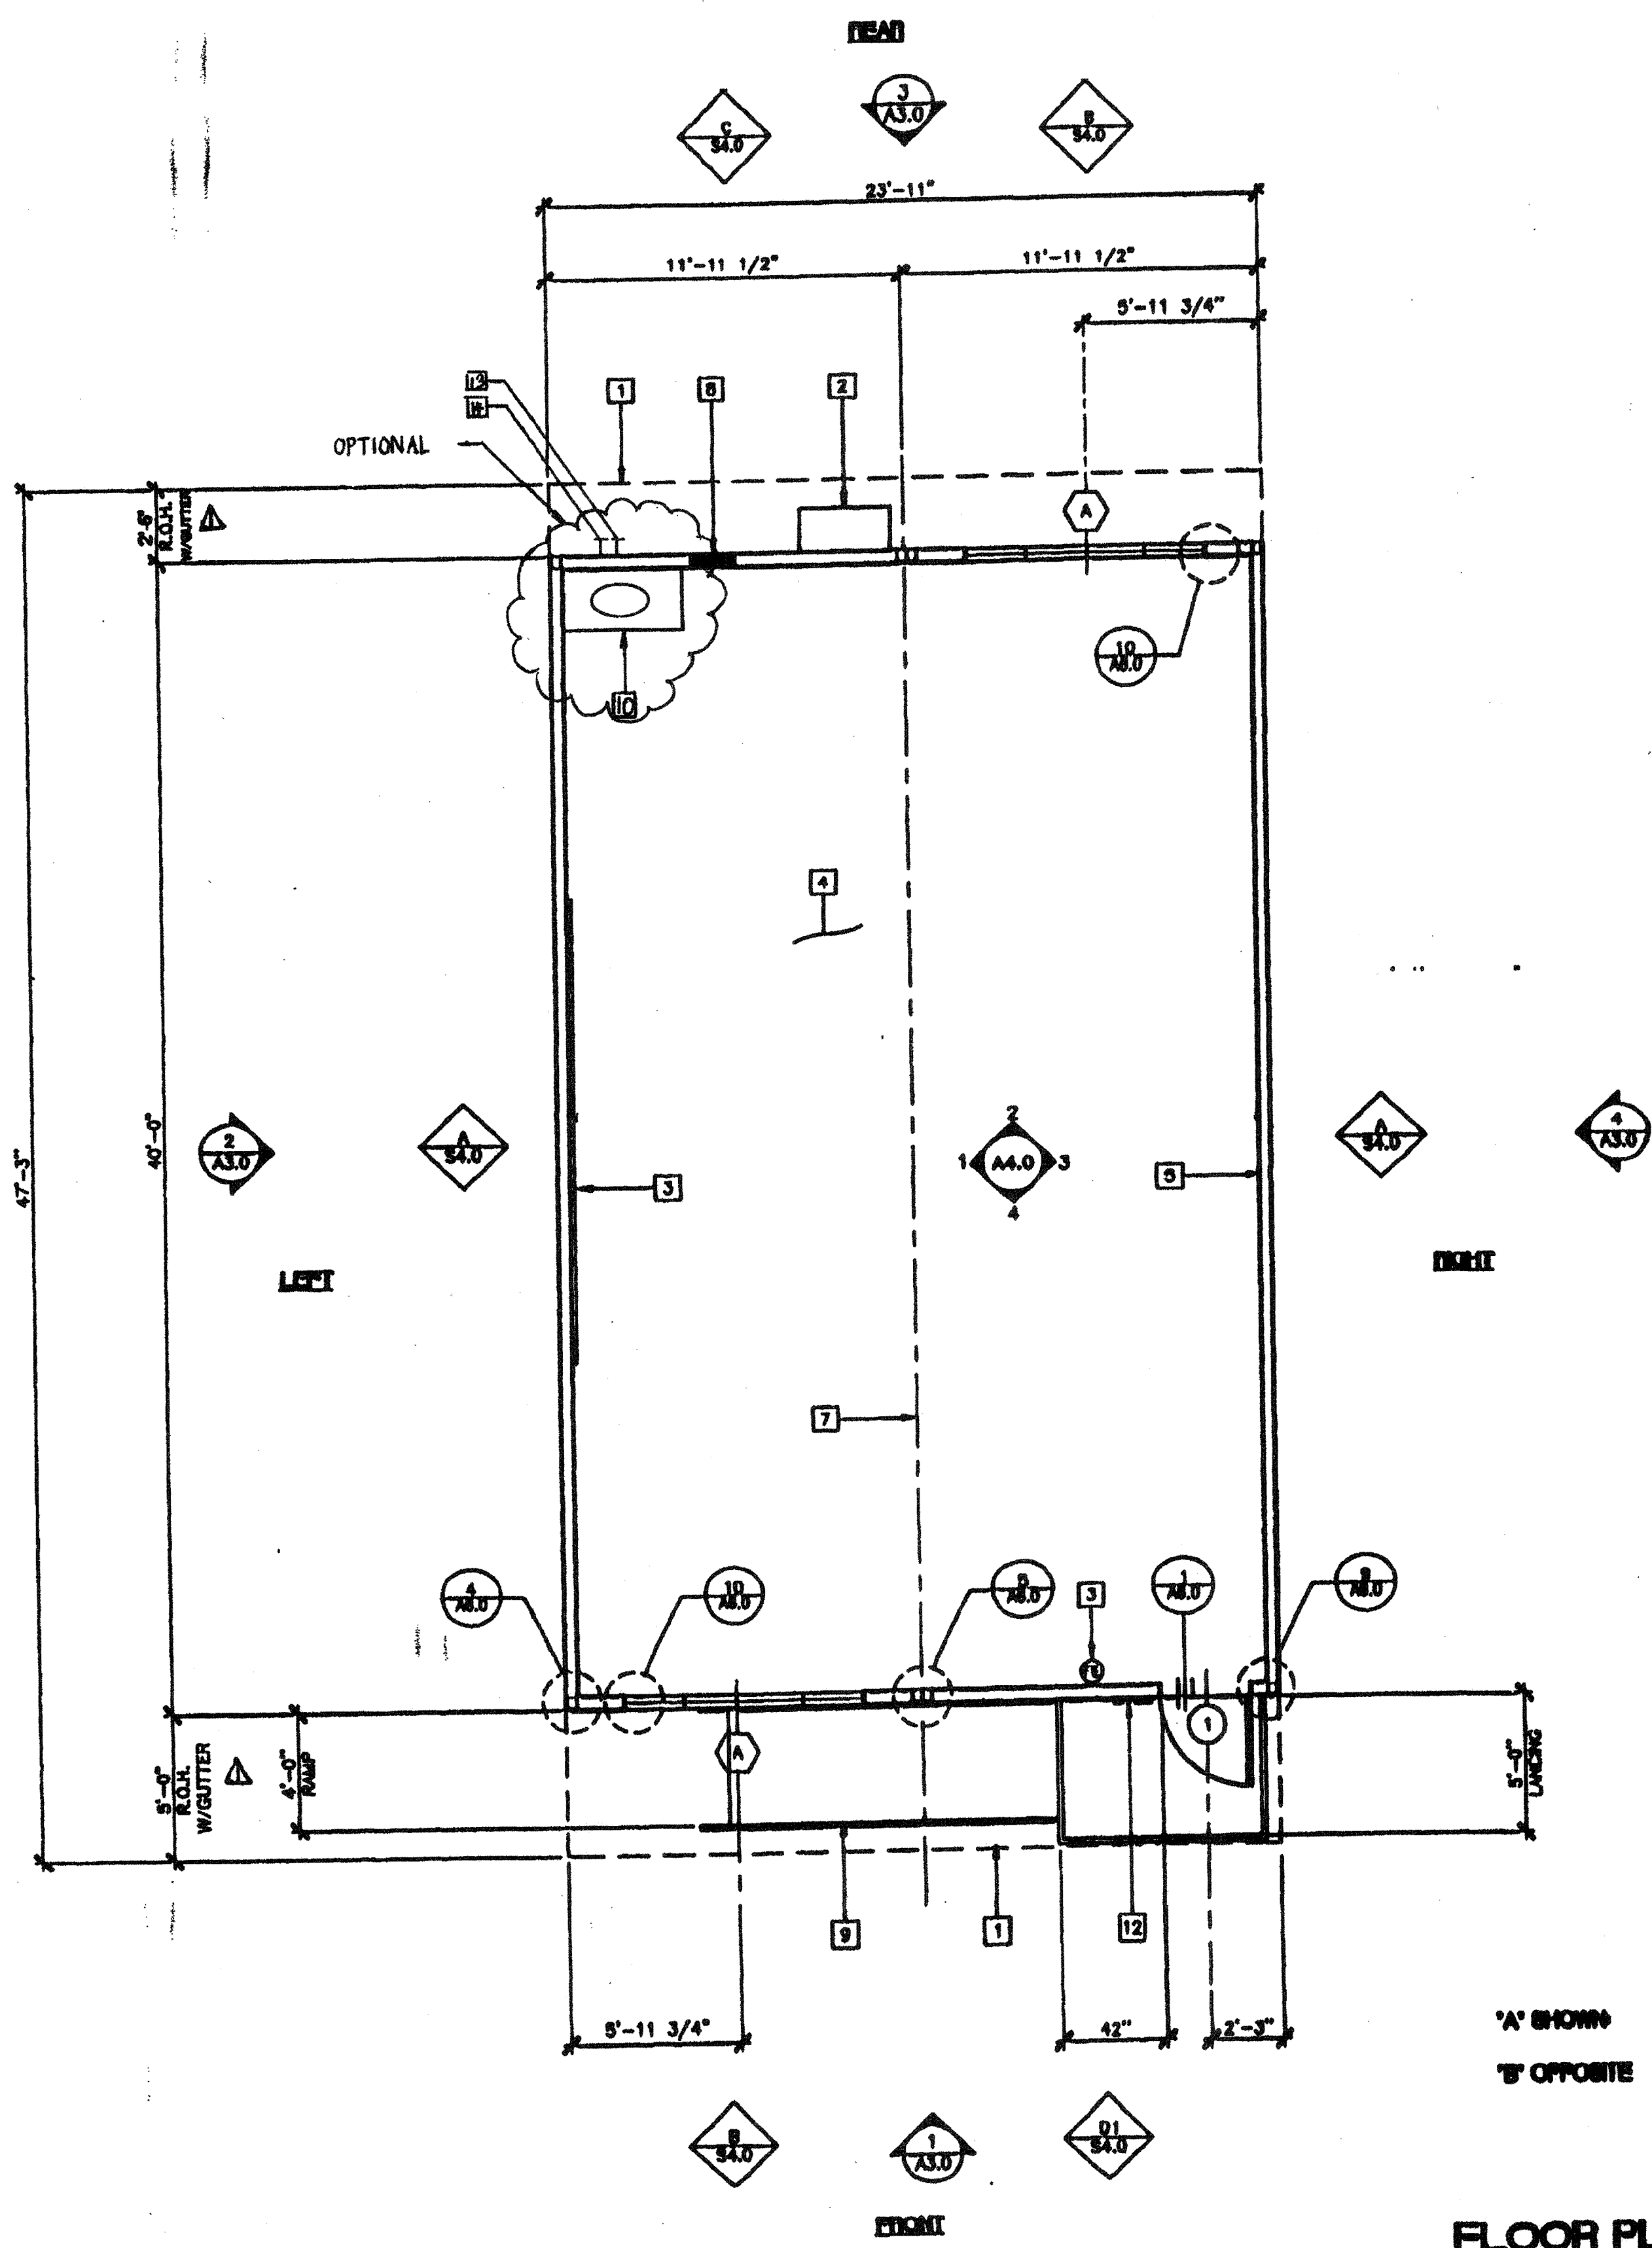

- ### KEY NOTES
- 1 ROOF OVERHANG
 - 2 HVAC UNIT (HV)
 - 3 2 - 8"x4" MARKER BOARDS (SEE SPEC'S FOR TYPE)
 - 4 FINISH FLOORING (FF)
 - 5 INTERIOR FINISH (IF)
 - 6 FIRE EXTINGUISHER - 5 LBS DRY CHEMICAL WITH 2A-10BC UL RATING WALL MOUNTED BRACKET, HANDLE AT 48" AFF
 - 7 MODLINE (M)
 - 8 ELECTRICAL PANEL
 - 9 RAMP/LANDING (RM)
 - 10 SINK CABINET OPTIONAL LAV: KOHLER # K-2867 FAUCET CHICAGO 833-669
 - 11 NOT USED
 - 12 SIGNAGE PROVIDED AND INSTALLED BY DISTRICT PRIOR TO OCCUPANCY, SEE AS.O.
 - 13 COLD WATER SUPPLY
 - 14 WASTE AND VENT P.O.C.

- ### NOTES
1. METAL TAG ON ALL MODULES, MECHANICALLY ATTACHED TO REAR EXTERIOR OF BUILDING SHOW D.S.A. APPLICATION NUMBER, MANUFACTURER'S NAME AND SERIAL NUMBER.
 2. METAL TAG MIN. 3 1/2"x1 1/2" METAL I.D. W/
1. DESIGN WIND LOAD
2. DESIGN ROOF LOAD
 3. PROVIDE MIN. 3 1/2"x1 1/2" METAL TAG INSTALLED INSIDE THE ELECTRICAL PANEL SHOWING OPSC NUMBER AND DSA NUMBER.

FLOOR PLAN 24x40
SCALE: 1/4" = 1'-0"


IDENTIFICATION STAMP
DIV. OF THE STATE ARCHITECT
OFFICE OF REGULATION SERVICES
AC 6 FLS SS TN
DATE MAR 07 2001

IDENTIFICATION STAMP
DIV. OF THE STATE ARCHITECT
APP#3 117168
AC 6 FLS SS TN
Date AUG 04 2018

REVISIONS	Electrical Engineer's Seal	Mechanical Engineer's Seal	Architect's Seal
1. CLARIFY OVERHANGS			

Electrical Engineer's Seal


Mechanical Engineer's Seal

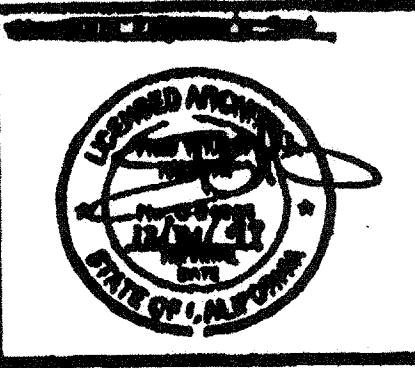

Architect's Seal

PC
CBC 1998

REGISTERED CIVIL ENGINEER
DIV. OF THE STATE ARCHITECT
OFFICE OF REGULATION SERVICES
PC-04
10149
DATE 06/23/12

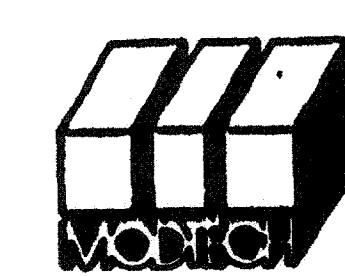

MODTECH INC.
2830 BARRETT AVENUE
PERRIS, CALIF. 92572
PH (909) 943-4014
FAX (909) 940-0427

PROJECT NUMBER:

© MODTECH, INC. 1999

DRAWN BY:
DATE:
CHECKED BY: SS
DATE: 10/22/18


FLOOR PLAN

A1.0

FILE PATH: 2140-0-A1-01.DWG


3.0.5

PROJECT NO. PC-04-101419

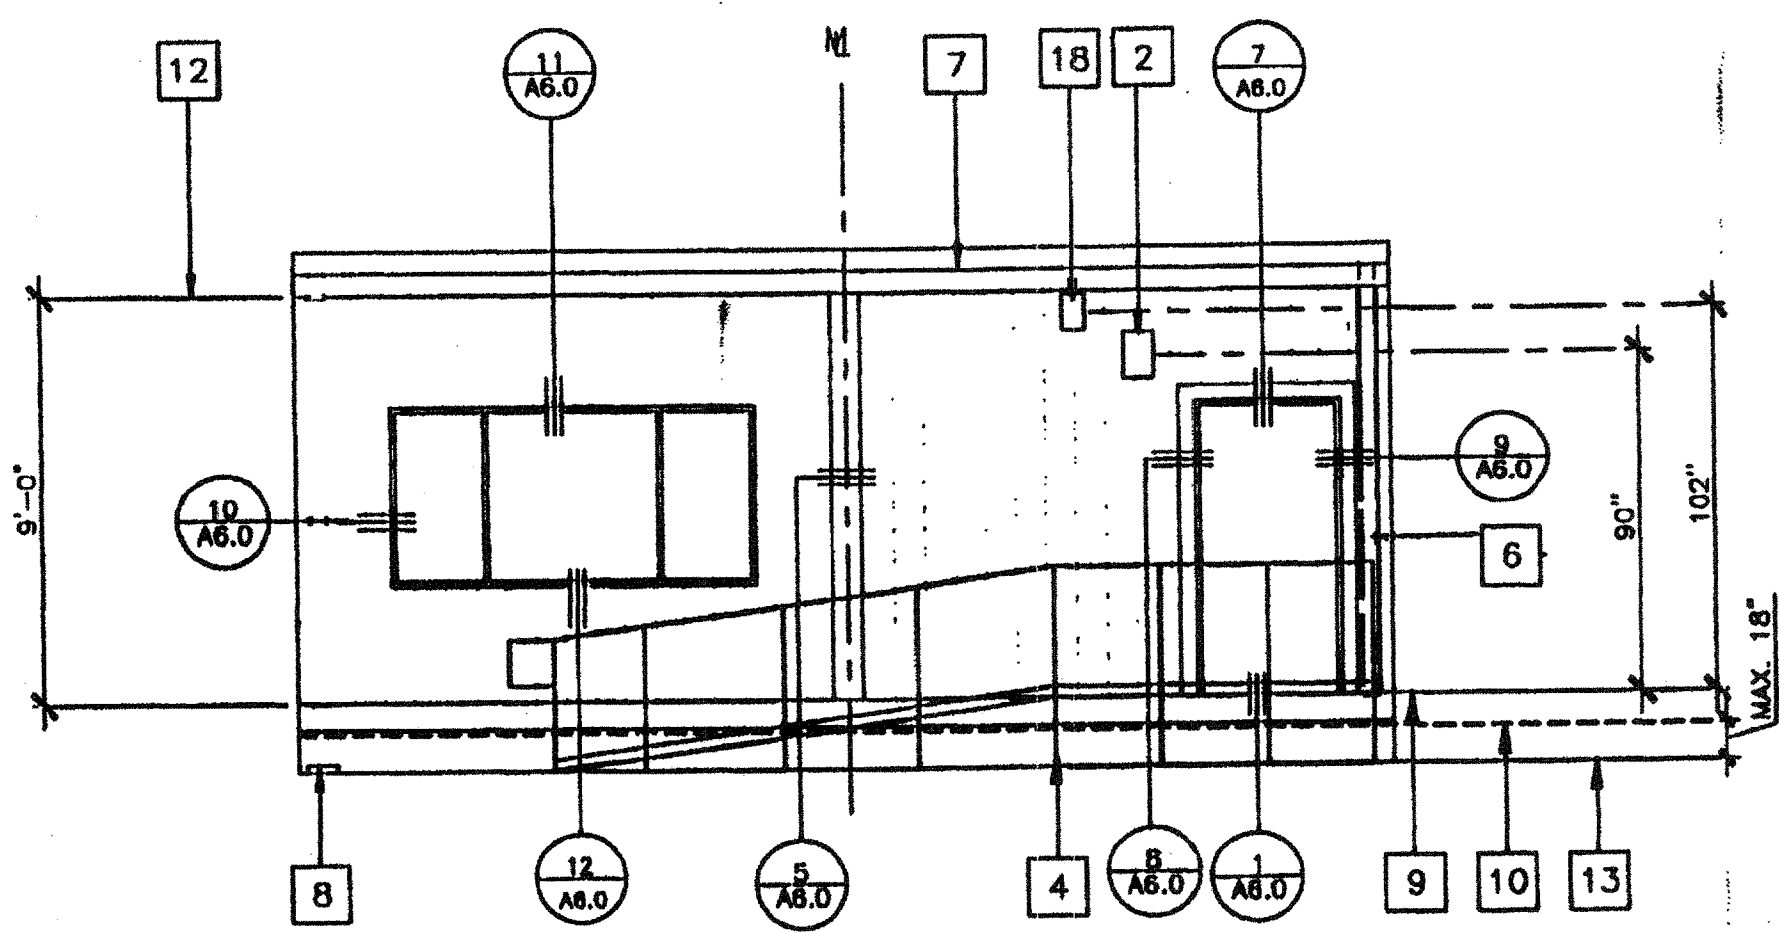


1 FRONT ELEVATION

1/4" = 1'-0"

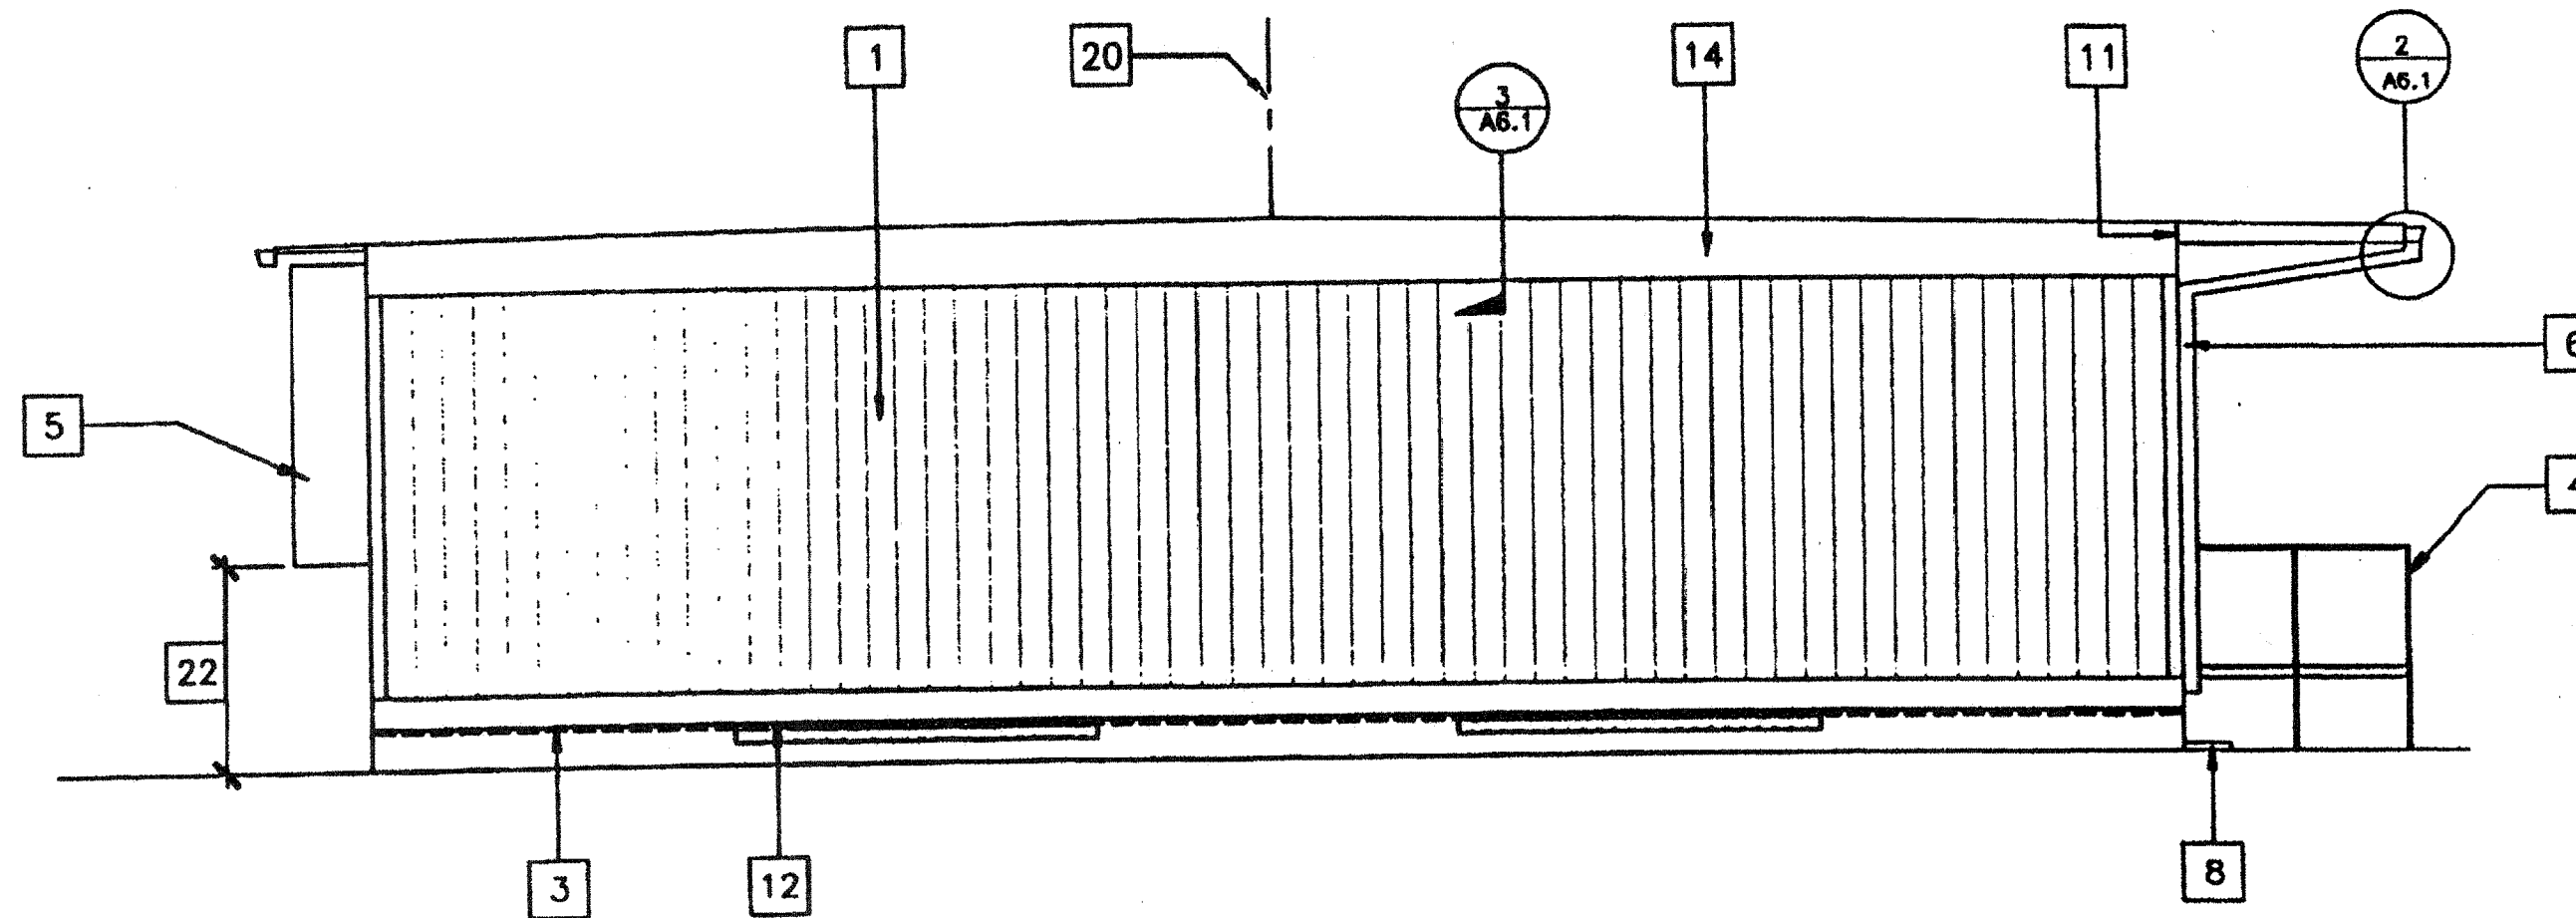


2 LEFT ELEVATION

1/4" = 1'-0"

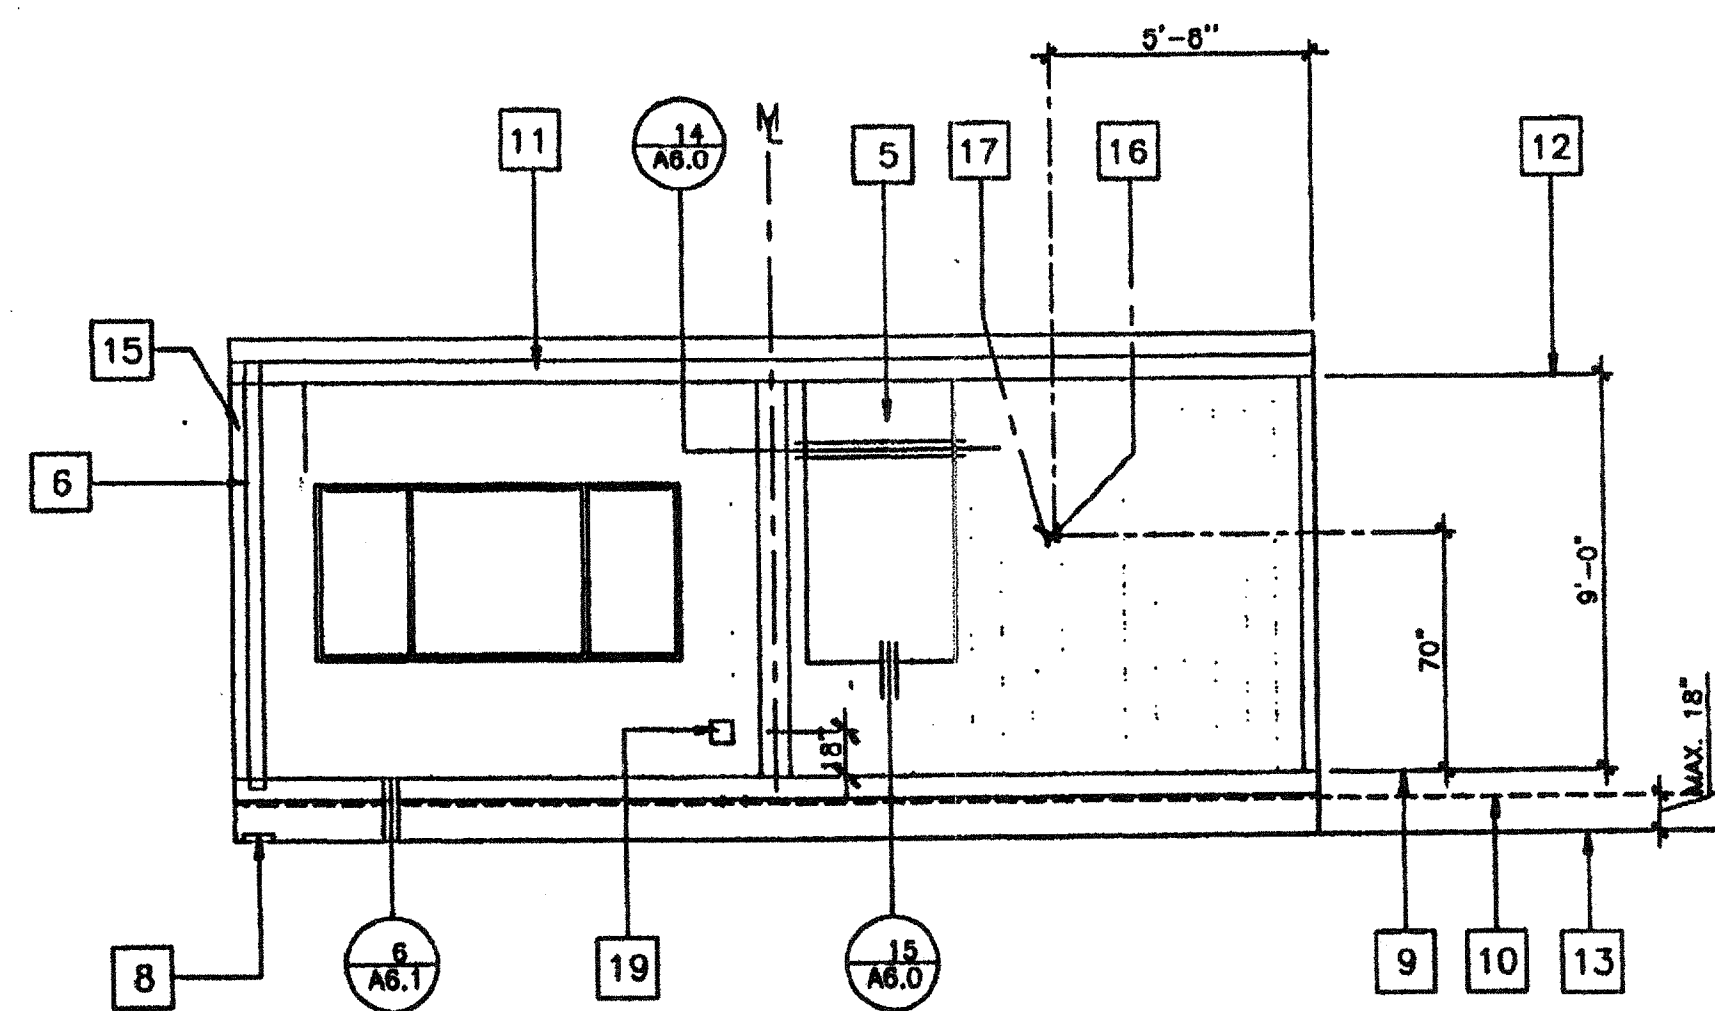

3 REAR ELEVATION

1/4" = 1'-0"

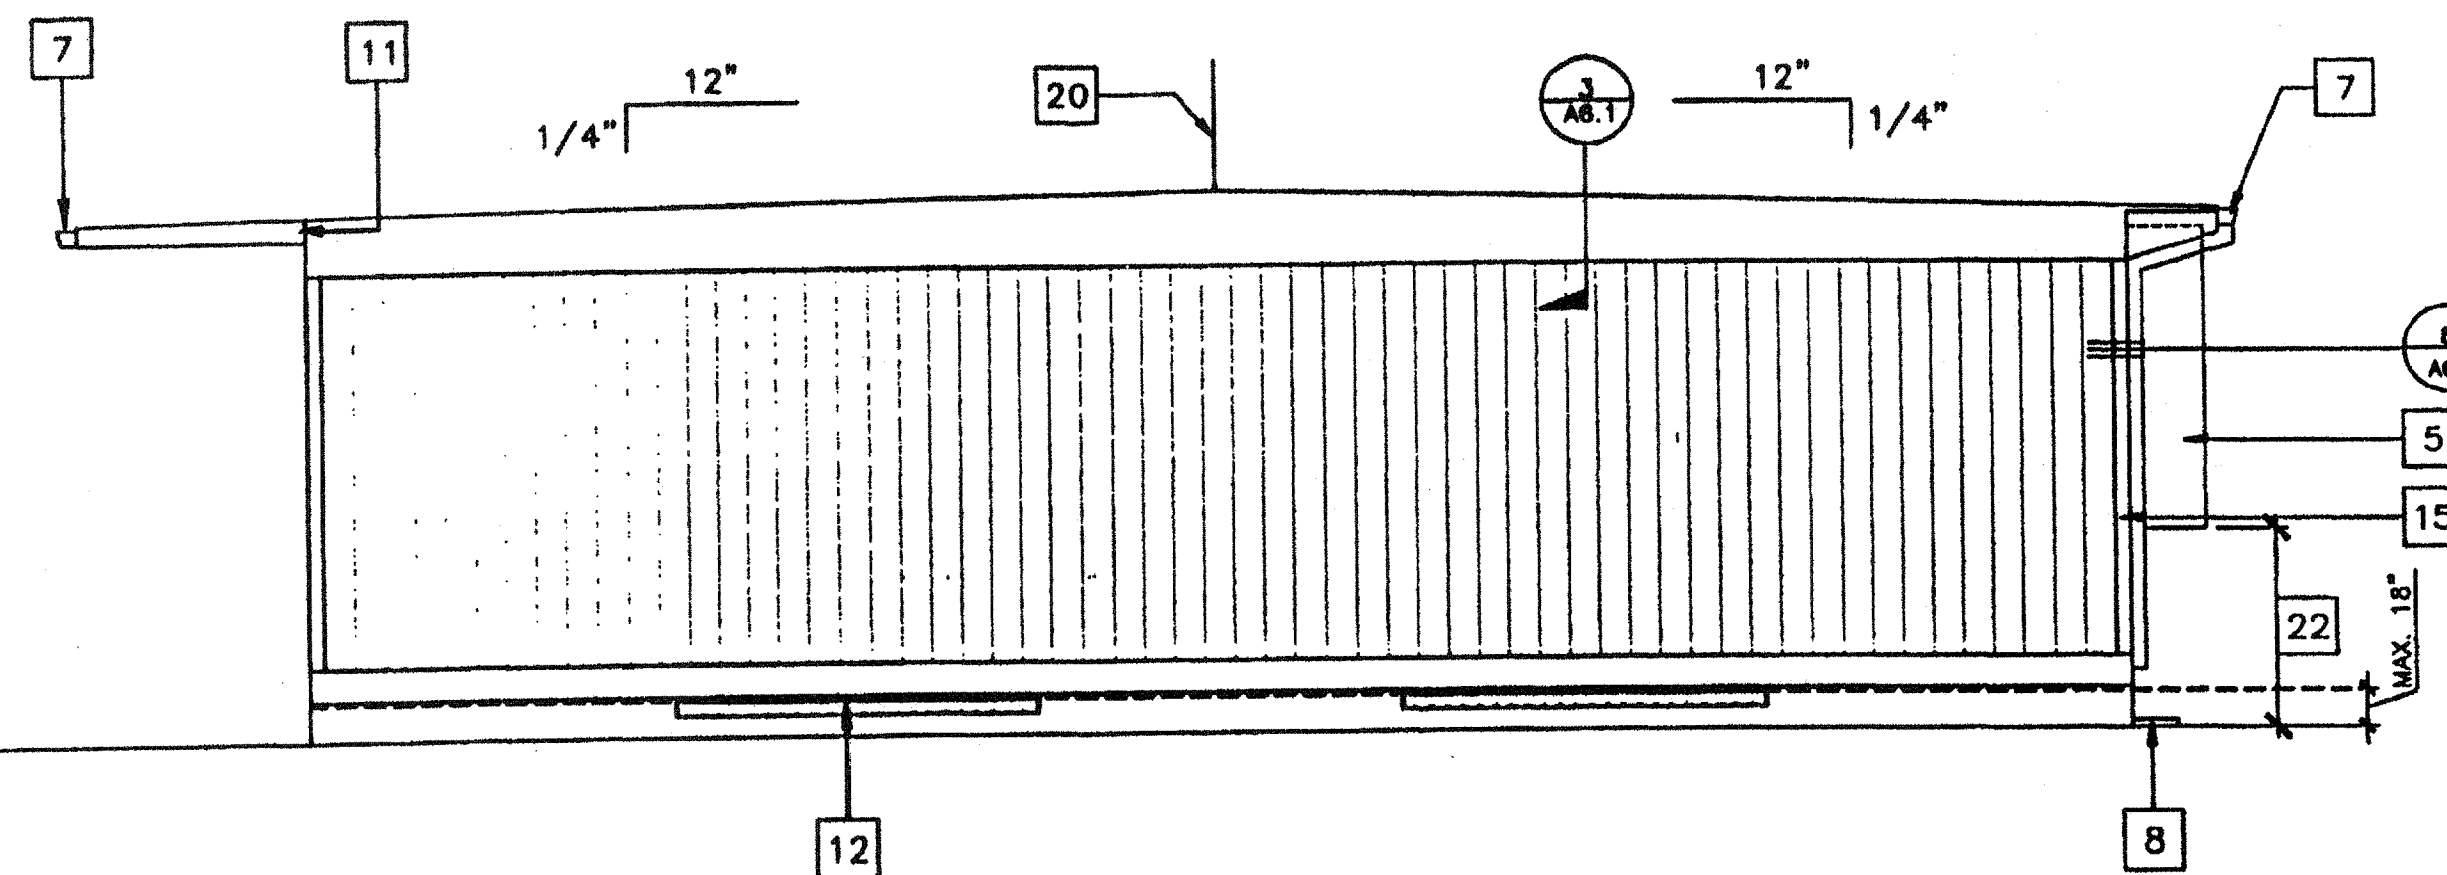

4 RIGHT ELEVATION

1/4" = 1'-0"

"A" = SHOWN
"B" = OPPOSITE

KEY NOTES

- 1 TYPICAL EXTERIOR SIDING (SEE A5.0)
- 2 EXTERIOR LIGHT FIXTURE (SEE SPEC'S)
- 3 TOP OF SKIRTING
- 4 RAMP AND LANDING SEE SHT. R-1
- 5 HVAC UNIT. SEE HW
- 6 DOWNSPOUT (TYP.) FOR (2). FASTEN TO BLD'G. TYP 3 PLACES (SEE 8/A6.1)
- 7 CONTINUOUS GUTTER WITH DOWNSPOUT (LOCATION OF DOWNSPOUT SHOWN ON ROOF PLAN) SEE A2.0
- 8 SPLASH BLOCK (BY OTHERS)
- 9 FINISH FLOOR LINE
- 10 BOTTOM FLANGE OF FLOOR BEAM
- 11 ROOF HEADER
- 12 VENT. SEE FOUNDATION PLAN
- 13 FINISH GRADE
- 14 ROOF BEAM SEE STR
- 15 COLUMN SEE STR
- 16 ELECTRICAL STUB-OUT SEE EL
- 17 GROUND STUB-OUT SEE EL
- 18 J BOX FOR EXT. FA HORN SEE EL
- 19 NEMA 6" X 6" GUTTER BOX SEE EL
- 20 RIDGE
- 21 NOT USED
- 22 IF HVAC UNIT IS LOCATED IN ANY PATH OF TRAVEL OR CIRCULATION AREA AND HEIGHT FROM GRADE TO BOTTOM OF UNIT EXCEEDS 27" THEN PROTECTION MUST BE PROVIDED.

NOTES

- 1. SEE FOUNDATION PLAN FOR SIZE AND LOCATION OF UNDER FLOOR VENTS.


IDENTIFICATION STAMP
DIV. OF THE STATE ARCHITECT
OFFICE OF REGULATION SERVICES
AC: FLS SS
DATE: MAR 09 2002

IDENTIFICATION STAMP
DIV. OF THE STATE ARCHITECT
APP#3 117168
AC: FLS SS TN
Date: AUG 04 2019

CBC 1998

PC

IDENTIFICATION STAMP
DIV. OF THE STATE ARCHITECT
OFFICE OF REGULATION SERVICES
PC-04
101419
AC: FLS SS
DATE: OCT 25 1999

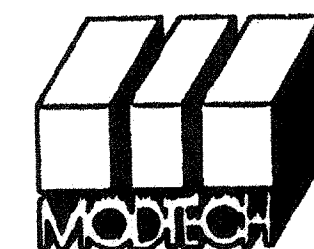

MODTECH INC.
2830 BARRETT AVENUE
PERRIS, CALIF. 92572
PH (909) 943-4014
FAX (909) 940-0427

PROJECT NUMBER:


© MODTECH, INC. 1999

DRAWN BY:
DATE:
CHECKED BY: SS
DATE: 10/22/99
MODTECH Index No.



EXTERIOR ELEVATIONS

A3.0

REVISIONS	Electrical Engineer's Seal	Mechanical Engineer's Seal	Architect's Seal
▲			
▲			
▲			
▲			

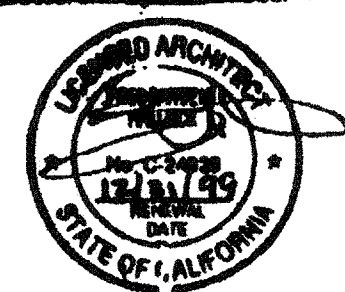

PROJECT NO. PC-04-101419

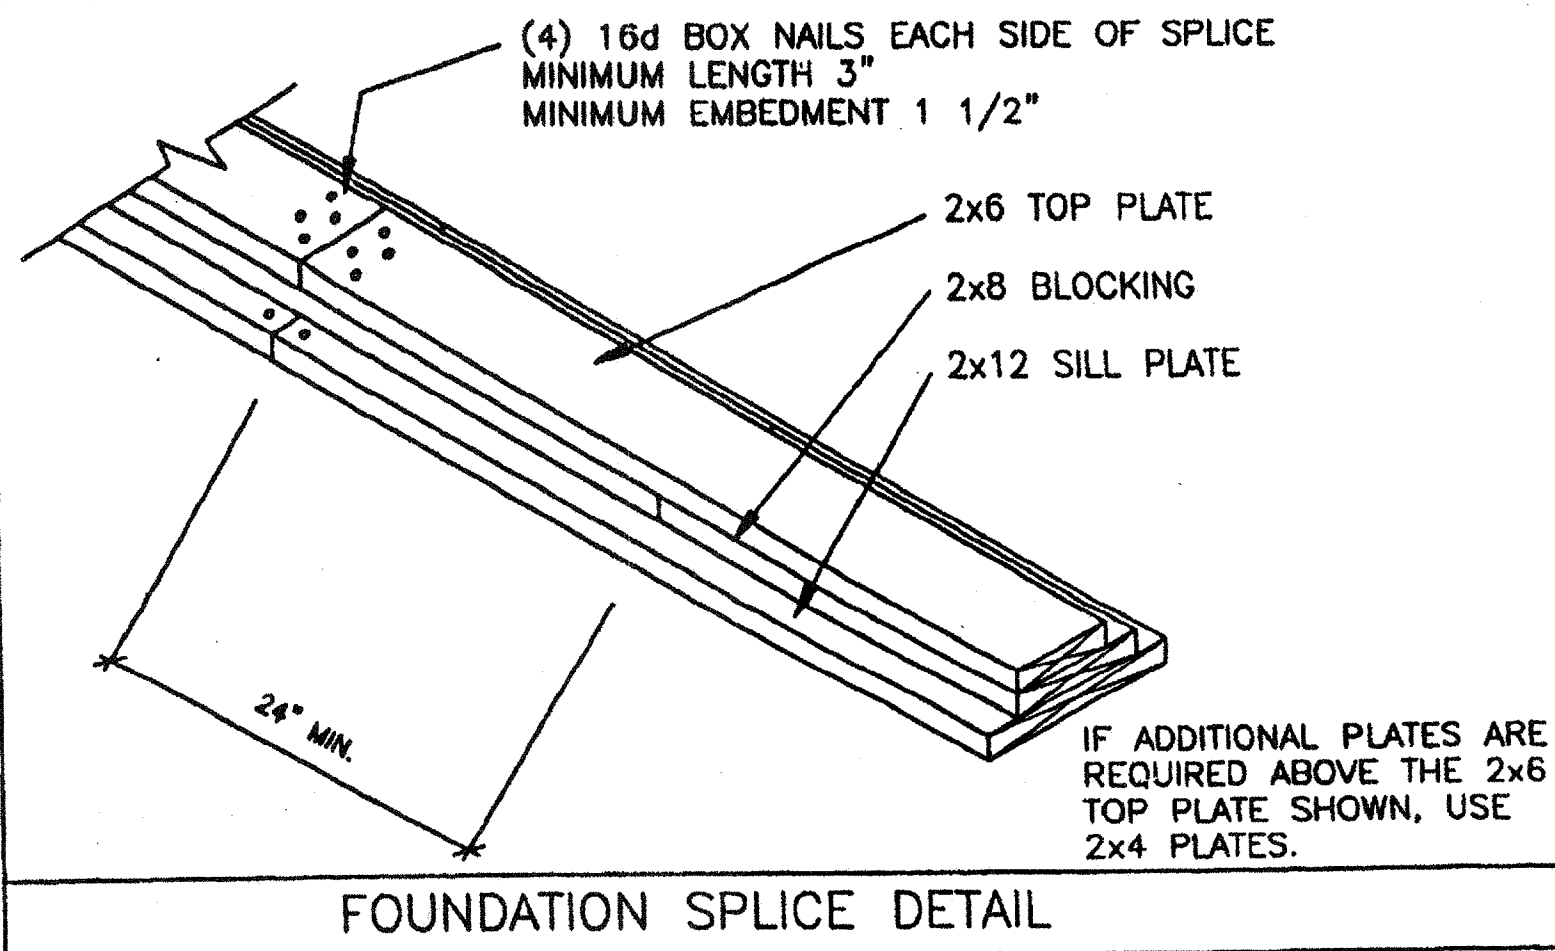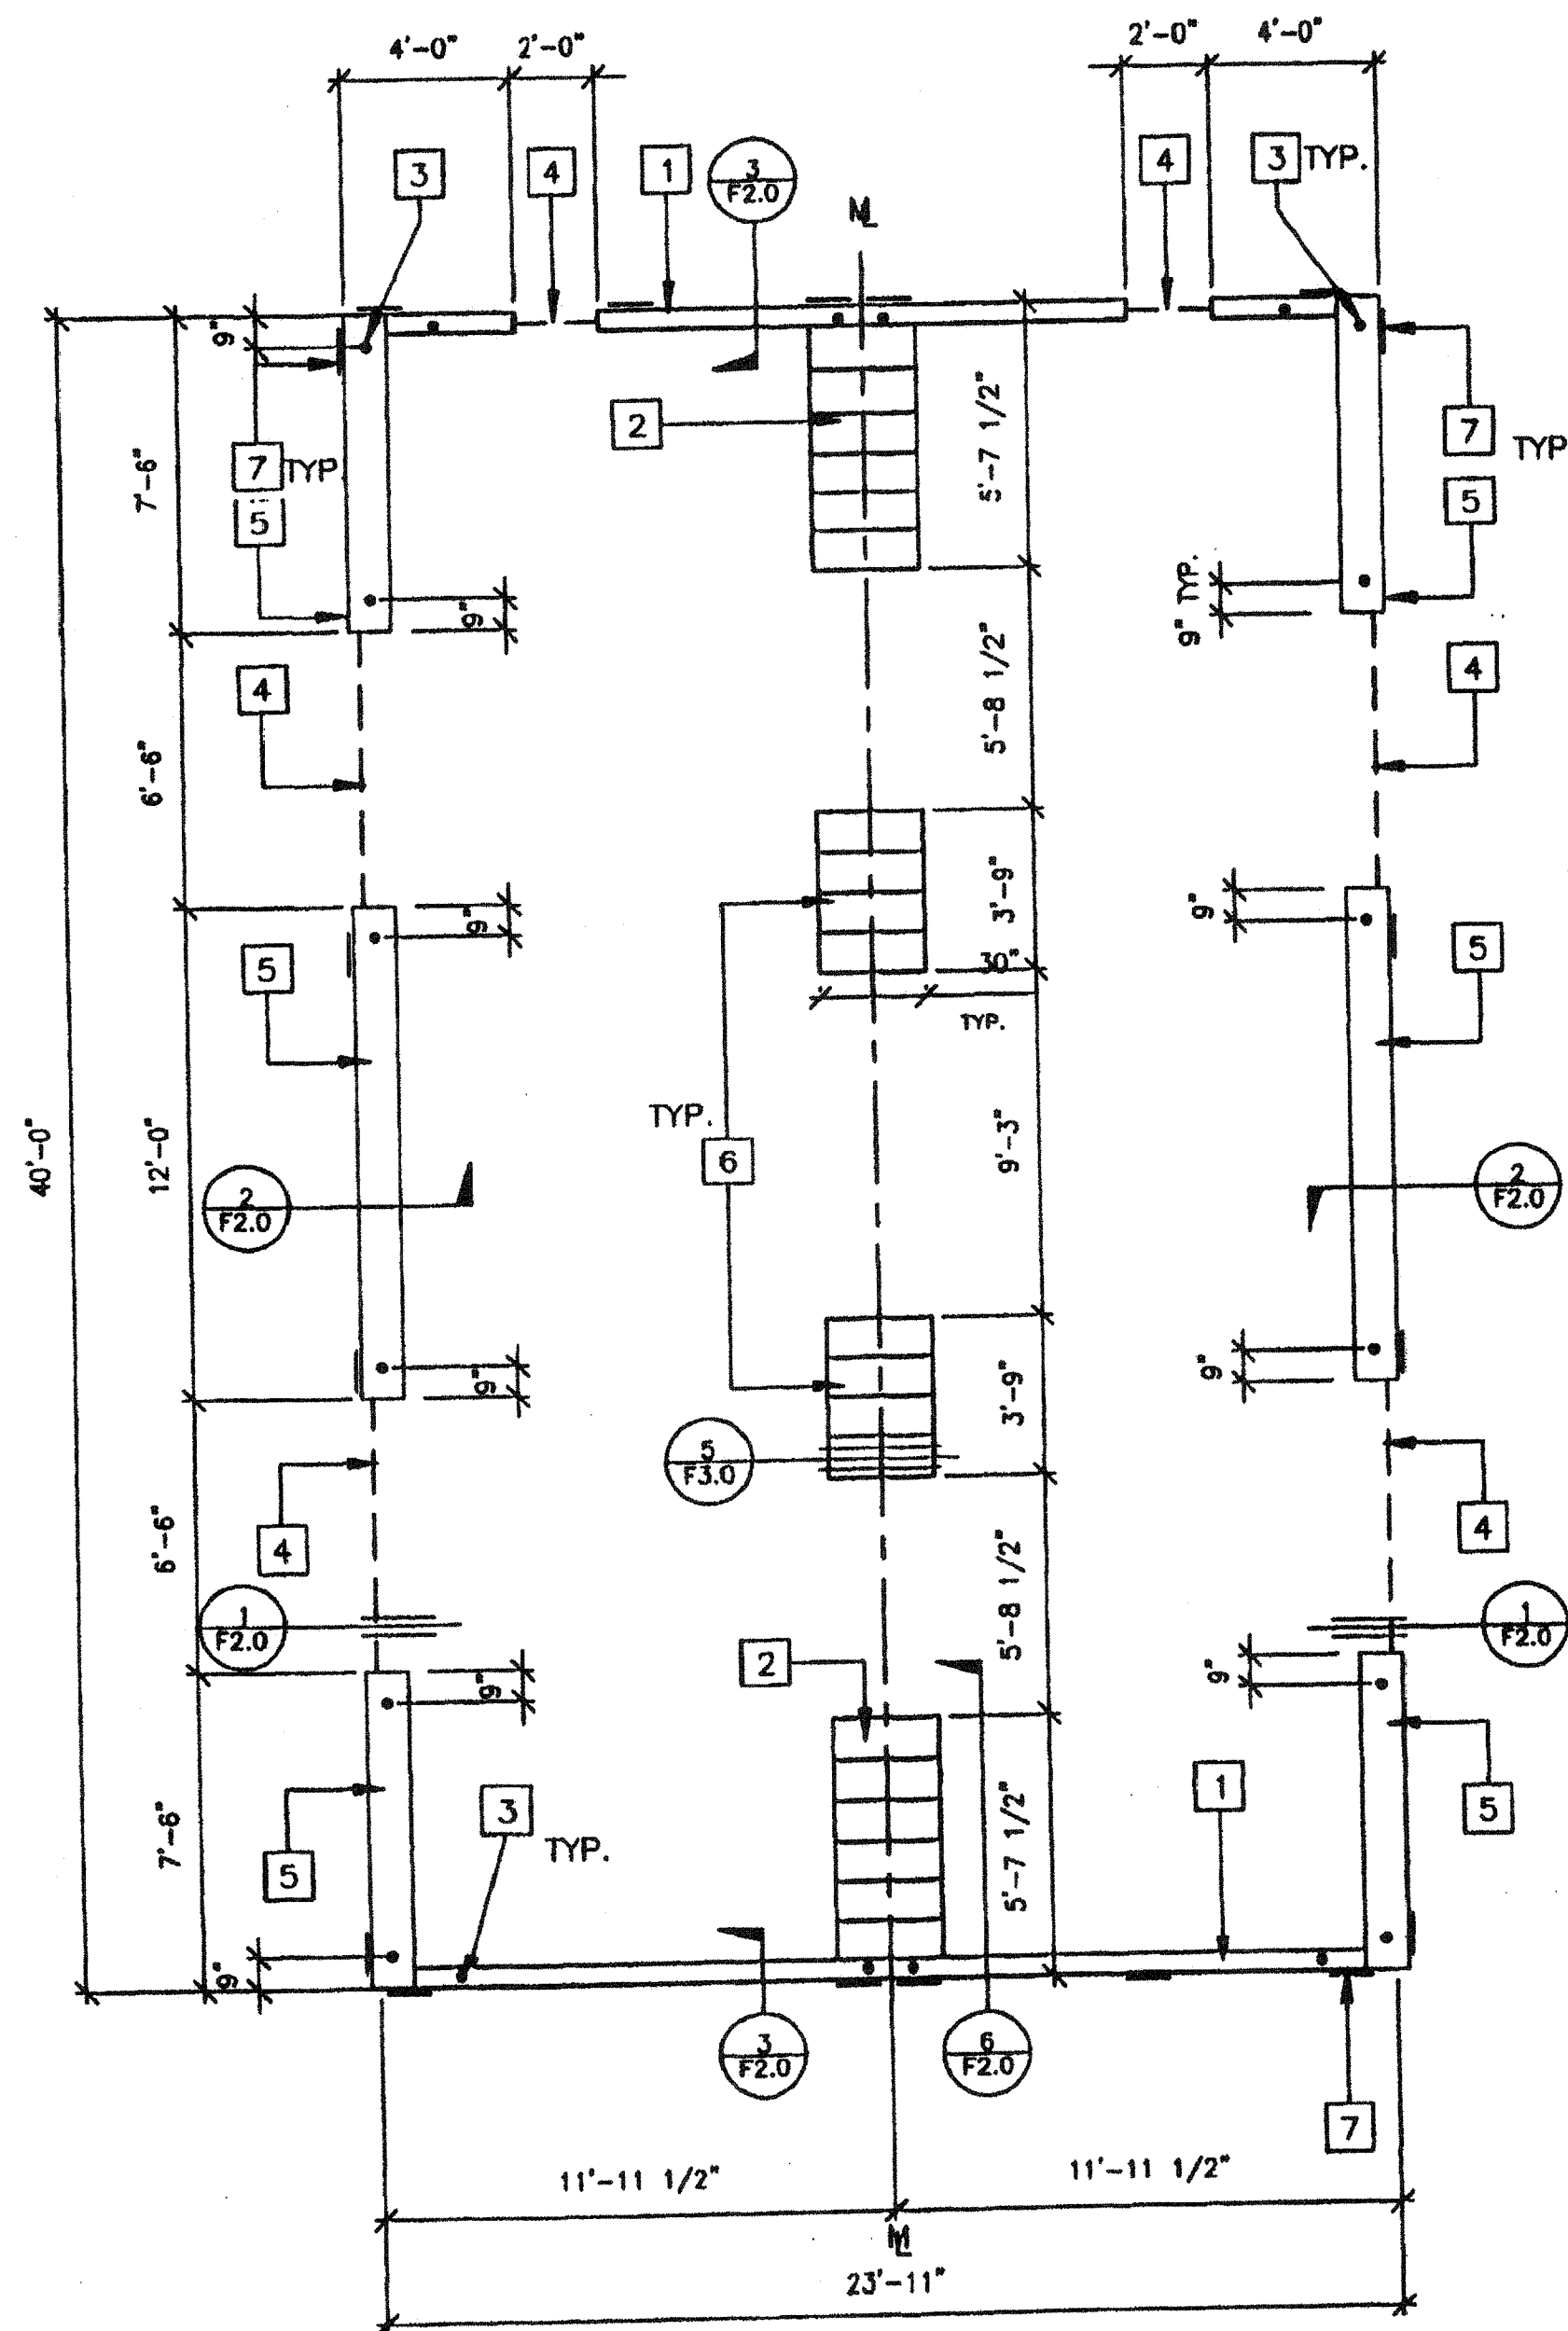

VENT CALCS.
BLD'G SIZE 24' X 40' = 960
VENTILATION REQ'D 960 + 150 = 6.4SF
3"X6"-6" VENT=1.625SF X 4 = 6.5SF
3"X2'-0" = 0.5 SF X 2 = 1.0 SF
TOTAL VENTING PROVIDED = 7.5 SF

KEY NOTES

- 1 2"x6" SILL PLATE (END WALL)
- 2 6- 2X12X30" LONG SILL PADS
- 3 PIPE TO GRADE (TYP.)
- 4 3" HIGH BY 6'-6" LONG VENT @ SIDEWALLS
3" HIGH BY 2'-0" LONG VENT @ ENDWALLS
- 5 2X12 SILL PLATE (SIDE WALL)
- 6 4-2X12X30" LONG SILL PADS
- 7 6"x12"x10 GA. PLATES
5 @ ENDWALL, 4 @ SIDEWALL
- 8 NOT USED
- 9 NOT USED

NOTES

- 1. SILL RESTRAINT: ON A.C. PAVING AND ON SOIL 1" O.D. GALVANIZED PIPE AT 10'-0" 12" PENETRATION BELOW SURFACE. VERTICALLY, DRILL SILL 1-1/4" MAX. PIPE MAY BE DRIVEN MAX. OF 45° ANGLE TO VERTICAL. (18-1/2" LONG PIPE REQUIRED FOR PENETRATION AT 45° ANGLE.)
 - 2. ON CONCRETE PAVING HILTI DS 82-P10 THRU SILL PLATE:
END WALLS: 8" O.C.
SIDE WALLS: 22" O.C.
 - 3. WHERE SHIM STOCK IS REQUIRED FOR LEVELING USE 1/4", 1/2", OR 3/4" THICK PLYWOOD SAME WIDTH AS BLOCK. P.T.
 - 4. VERIFY DRAINAGE TO PREVENT WATER FROM PONDING BENEATH THE STRUCTURE. WITH DISTRICT ARCHITECT SITE PLANS
 - 5. ALL FOUNDATION MATERIAL SHALL BE DOUGLAS FIR
GROUND CONTACT: LP-22 (CCA .40)
ABOVE GROUND: LP-2 (CCA .25)
 - 6. ALLOWABLE SOIL BEARING: 1000 1'SI
 - 7. "MACHINE APPLIED 16d FASTENERS SHALL HAVE AN EMBEDMENT OF NOT LESS THAN 1 1/2" INTO SECOND MEMBER, AND SHALL BE NOT LESS THAN 3" IN OVERALL LENGTH"
- THE ABOVE NAILS SHALL ALSO BE ACCEPTABLE FOR HAND NAILING, PROVIDED THE REQUIRED EMBEDMENT IS MAINTAINED.

FOUNDATION - WOOD SILL 24' X 40' 50 PSF LL
SCALE 1/4" = 1'

CBC 1999
PC

IDENTIFICATION STAMP
DIV. OF THE STATE ARCHITECT
OFFICE OF REGULATION SERVICES
DATE MAR 09 2000
APP#3 117168
AC FLS SS TN
Date AUG 04 2019

REVISIONS	Electrical Engineer's Seal	Mechanical Engineer's Seal	Architect's Seal


IDENTIFICATION STAMP
DIV. OF THE STATE ARCHITECT
OFFICE OF REGULATION SERVICES
PC-04
10419
DATE 11-7-19

MODTECH INC.
2830 BARRETT AVENUE
PERRIS, CALIF. 92572
PH (909) 943-4014
FAX (909) 940-0427


PROJECT NUMBER:
© MODTECH, INC. 1999

DRAWN BY:
DATE:
CHECKED BY: SS
DATE: 10/22/99
MODTECH Index No.
F1.0


FILE PATH: 240-0-F1-01.R5 PROJECT NO: 24-04-101419

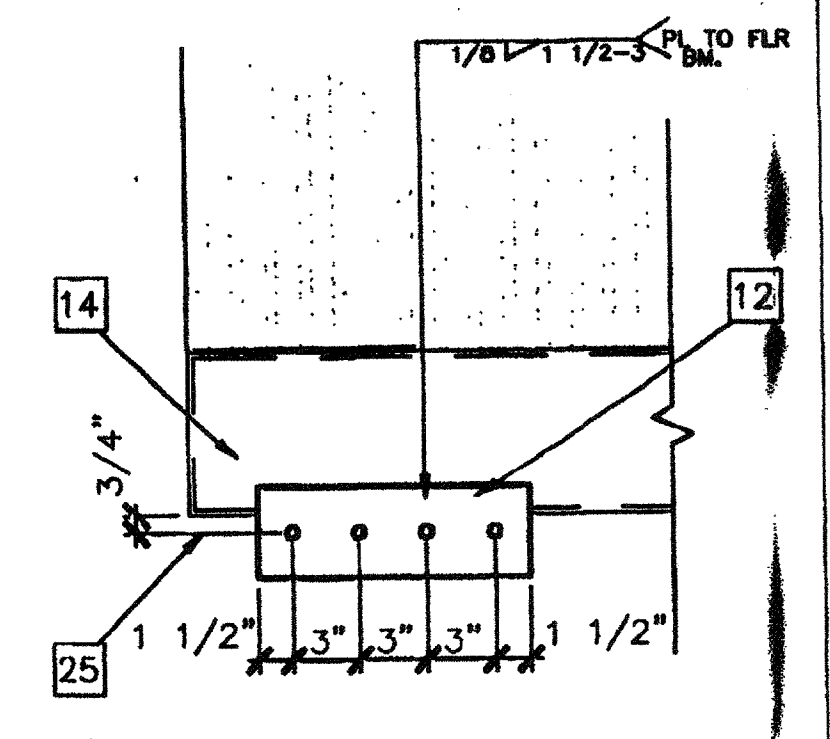


9 SCALE: 1 1/2"=1'-0"
ALTERNATE TIE PLATE

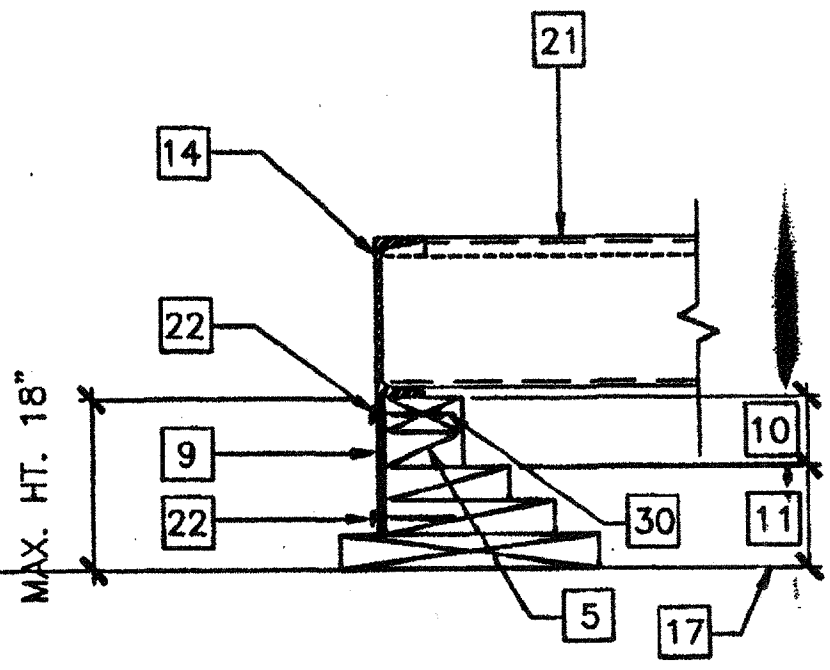


10 SCALE: 1 1/2"=1'-0"
ADD BLK'S/SHIMS TO LEVEL FOUND.

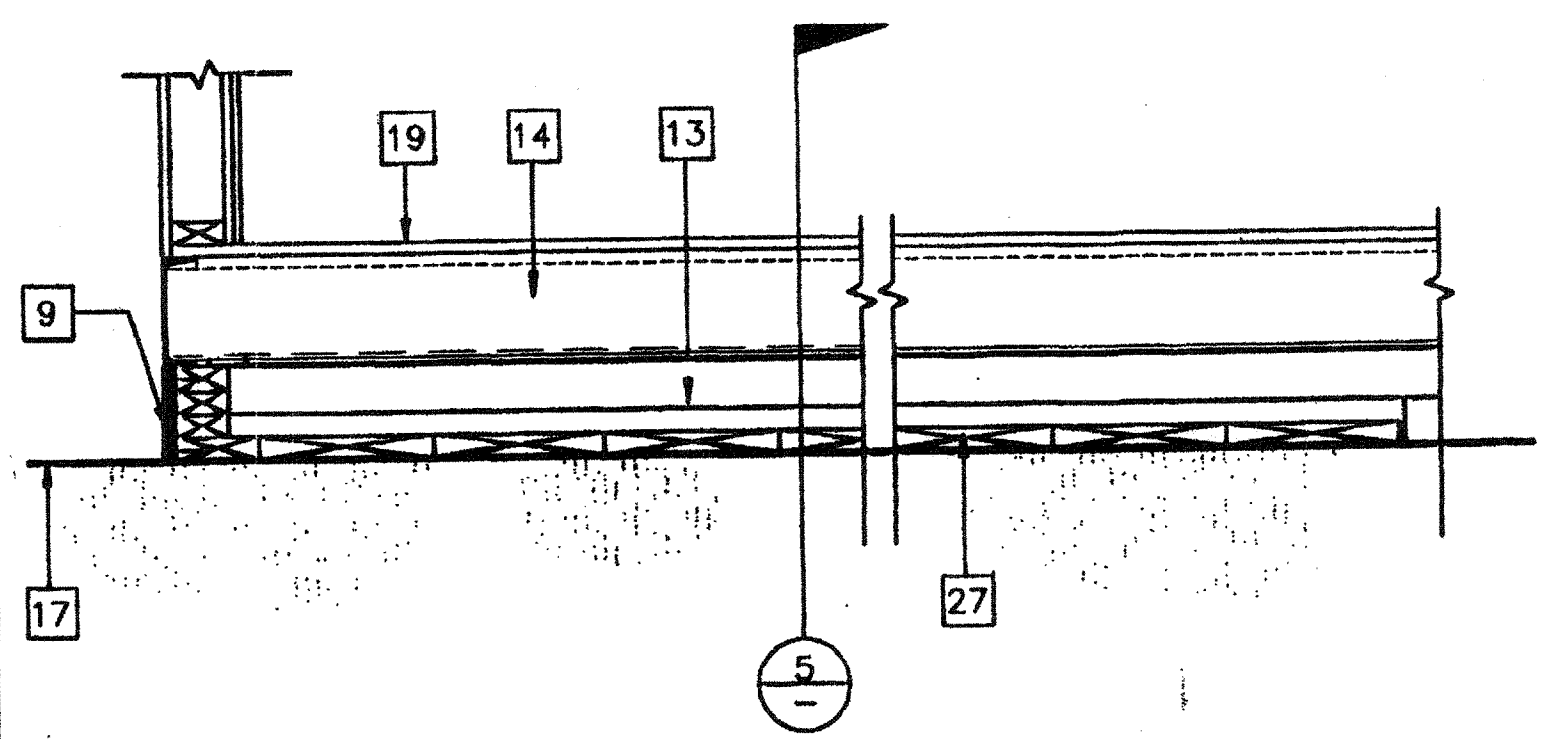


6 SCALE: 1 1/2"=1'-0"
MODLINE PAD @ END WALL

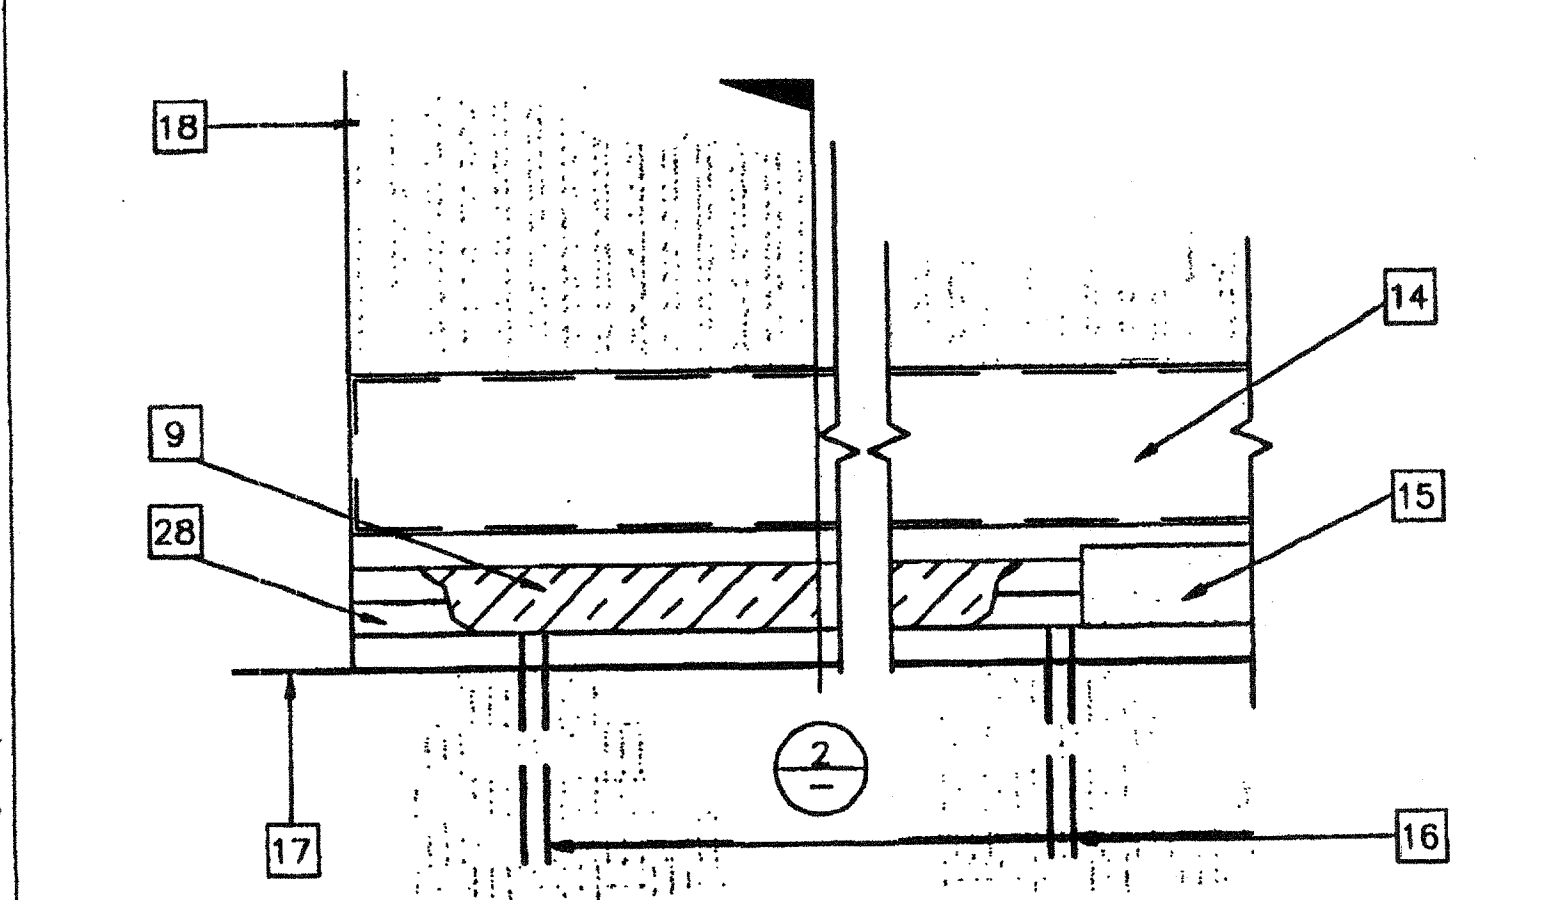


7 SCALE: 1 1/2"=1'-0"
FOUNDATION ELEVATION @ SIDE WALL

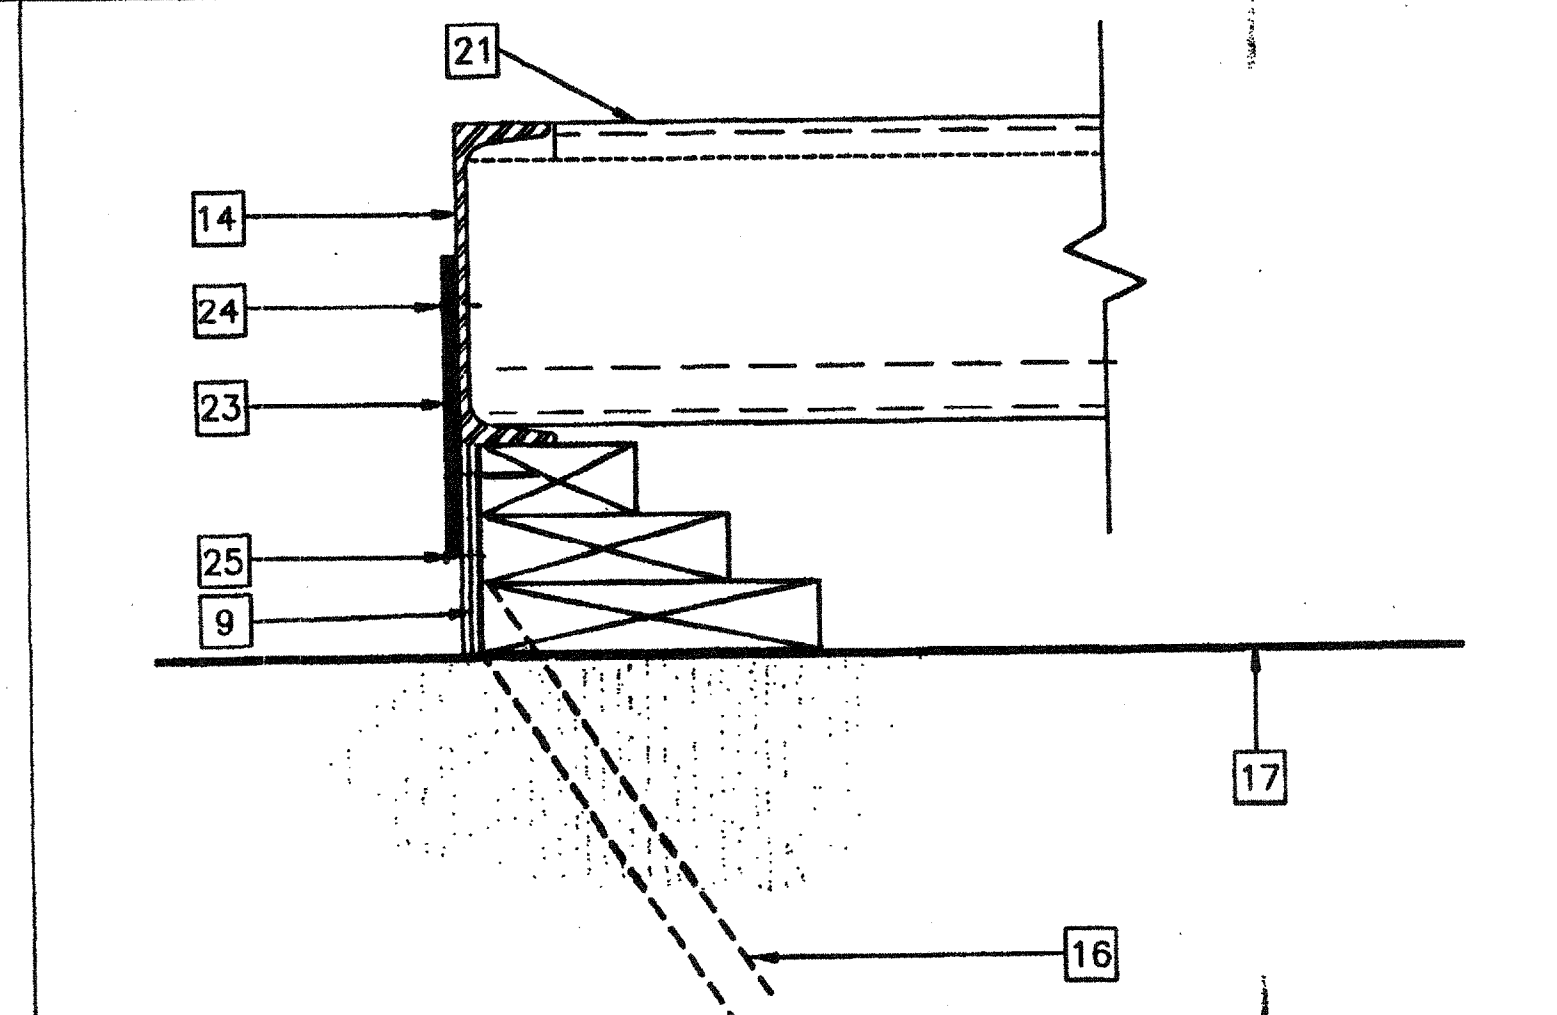


8 SCALE: 3"=1'-0"
TYPICAL TIE PLATE

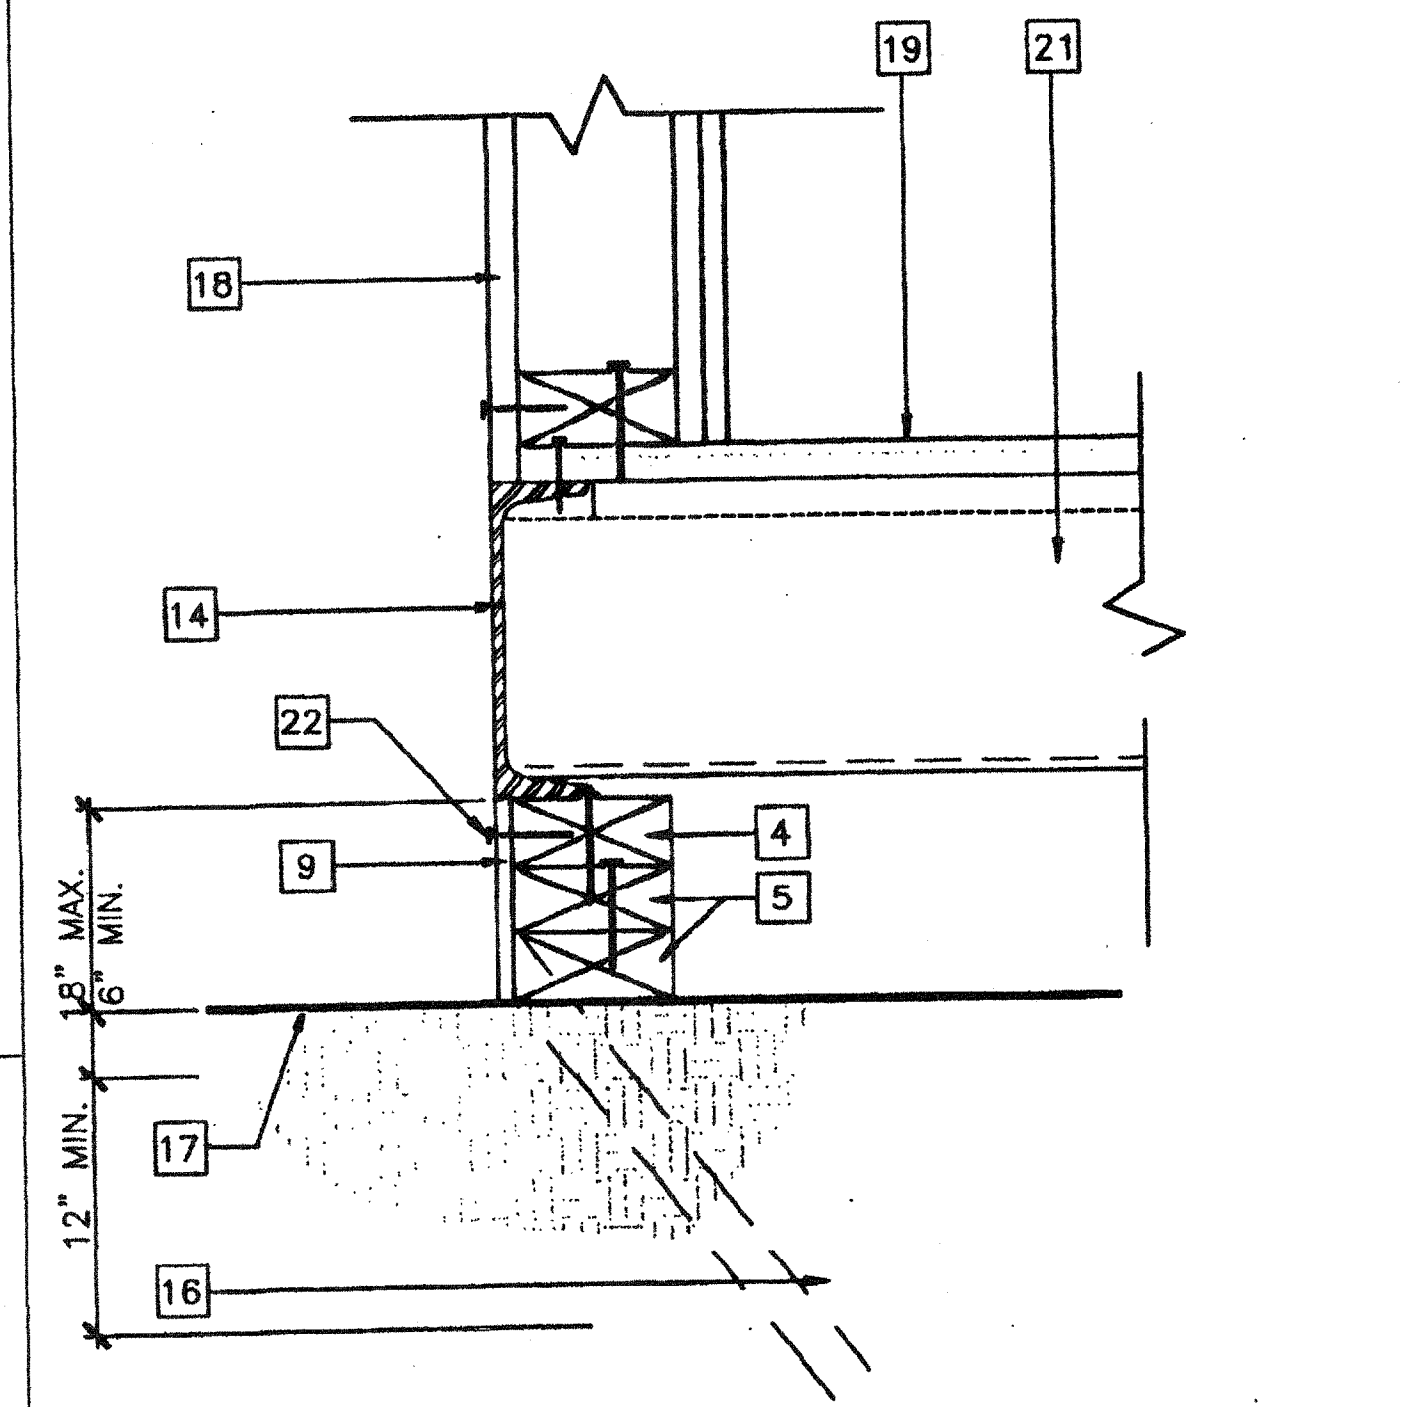


3 SCALE: 3"=1'-0"
FOUNDATION @ END WALL

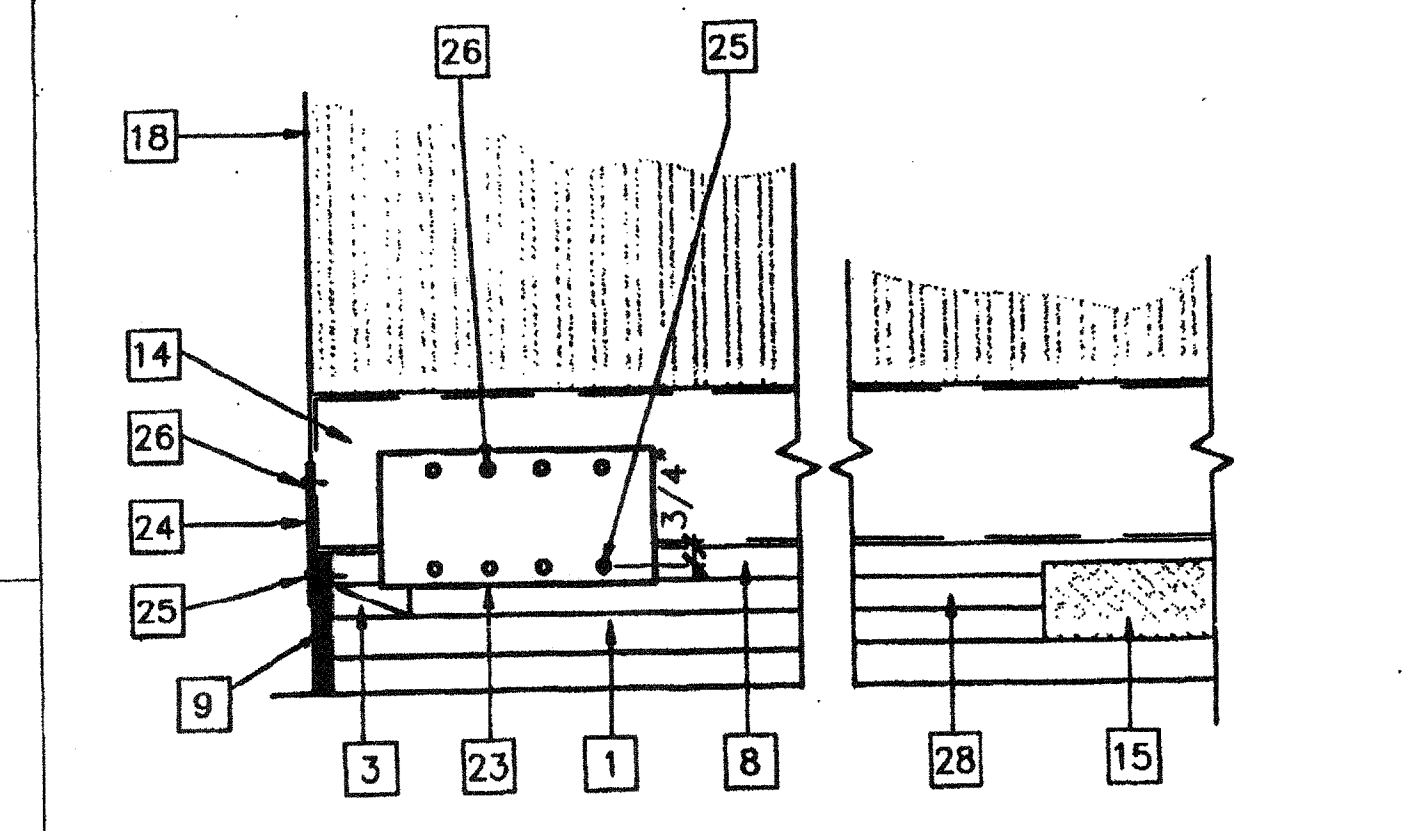


4 SCALE: 1 1/2"=1'-0"
DETAIL @ FOUNDATION CORNER

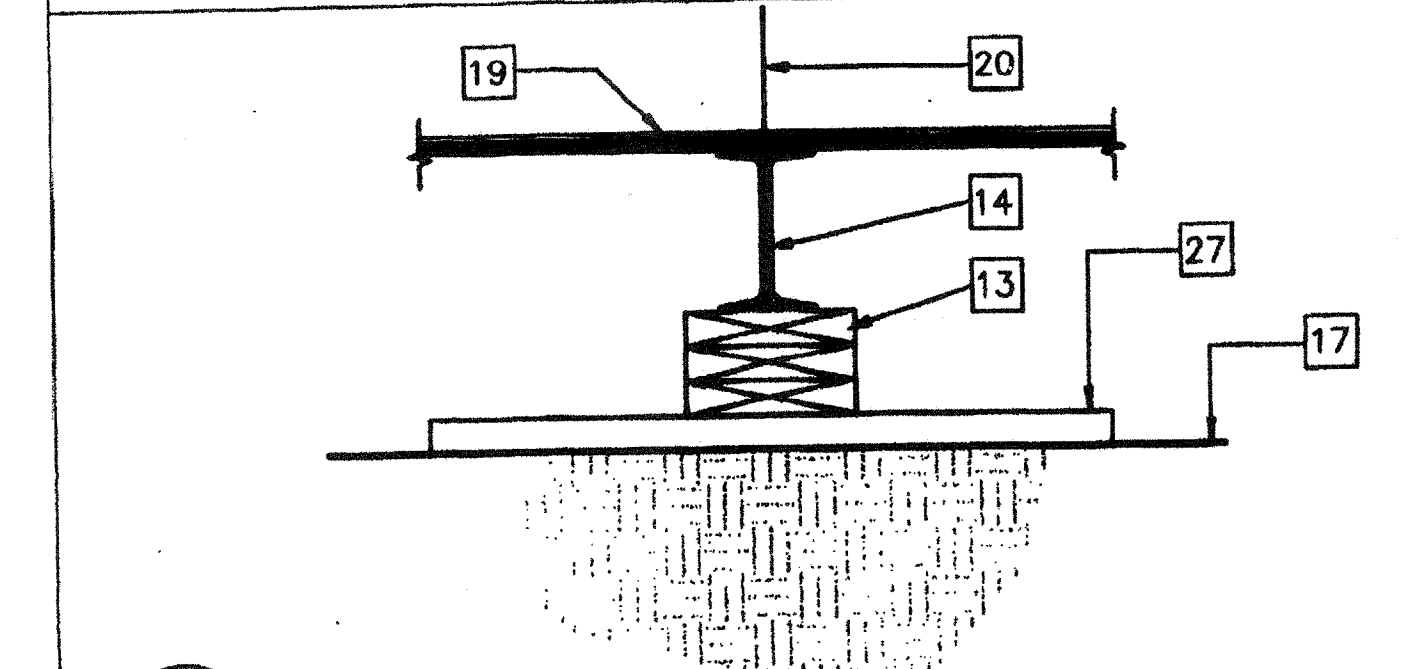

5 SCALE: 1 1/2"=1'-0"
FOUNDATION PAD @ MODLINE

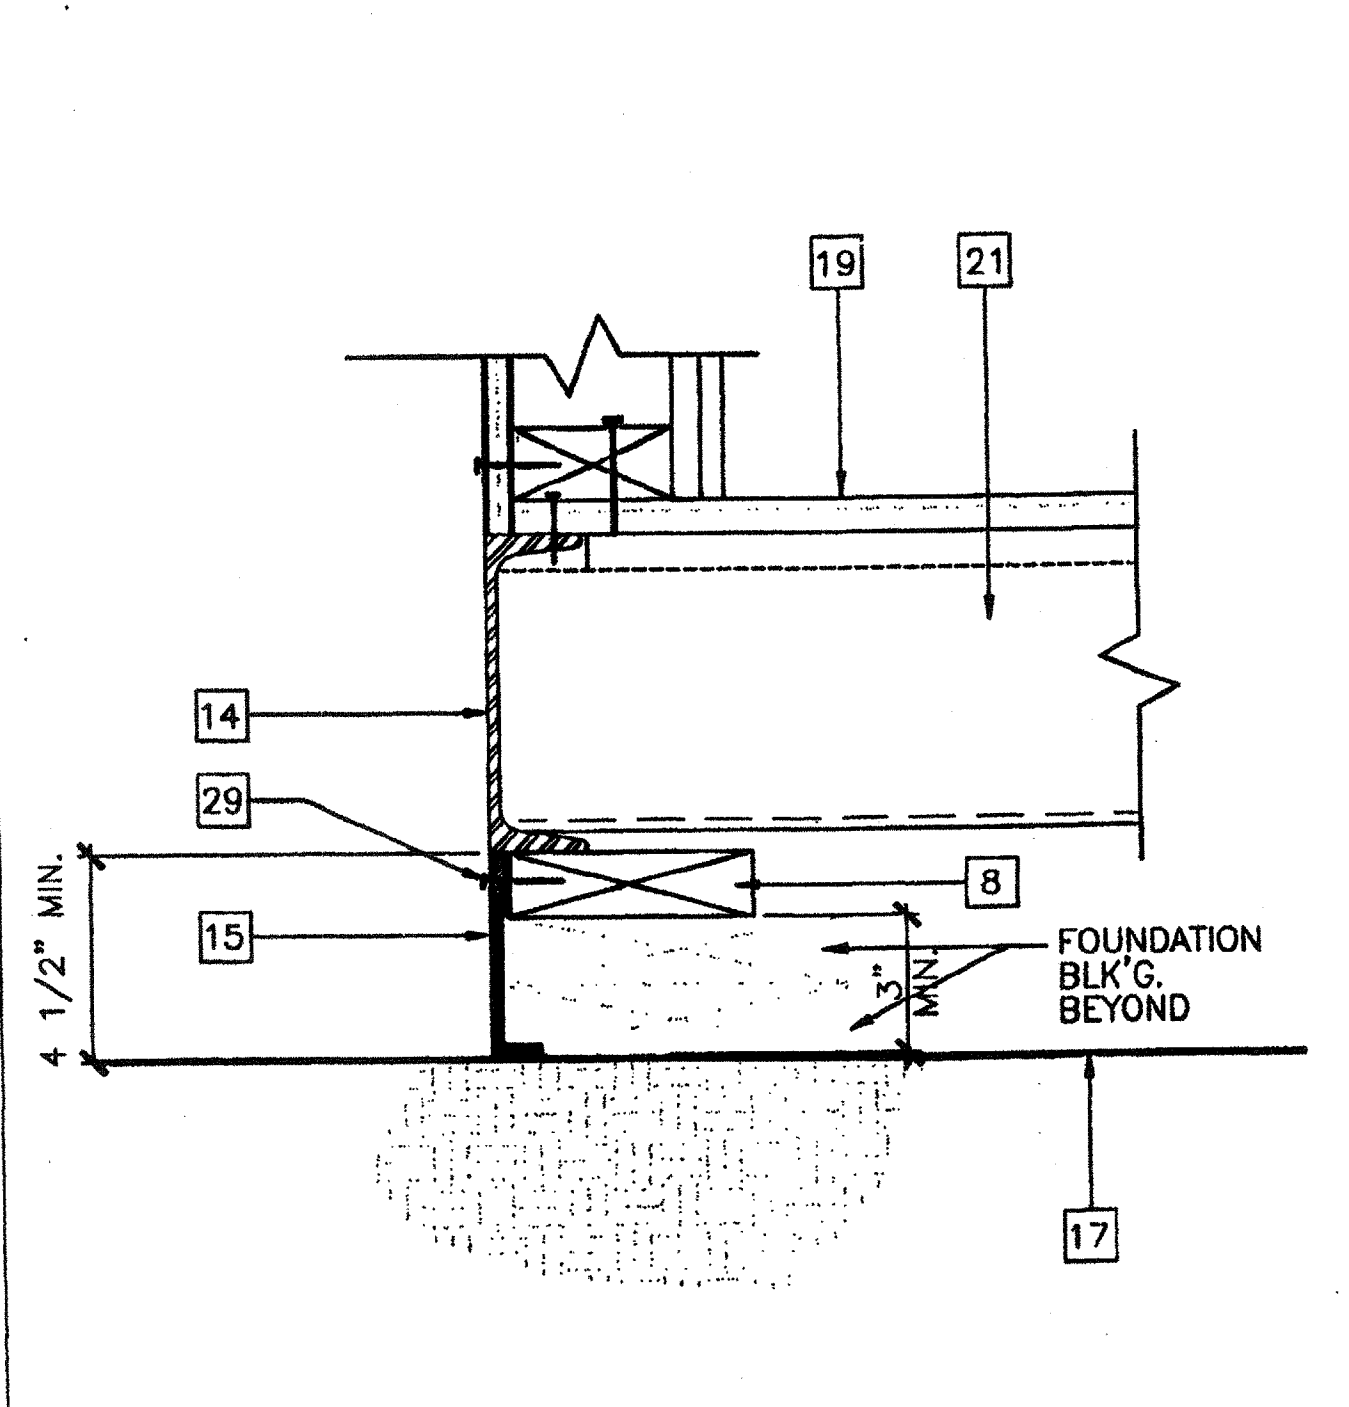

1 SCALE: 3"=1'-0"
FOUNDATION VENT

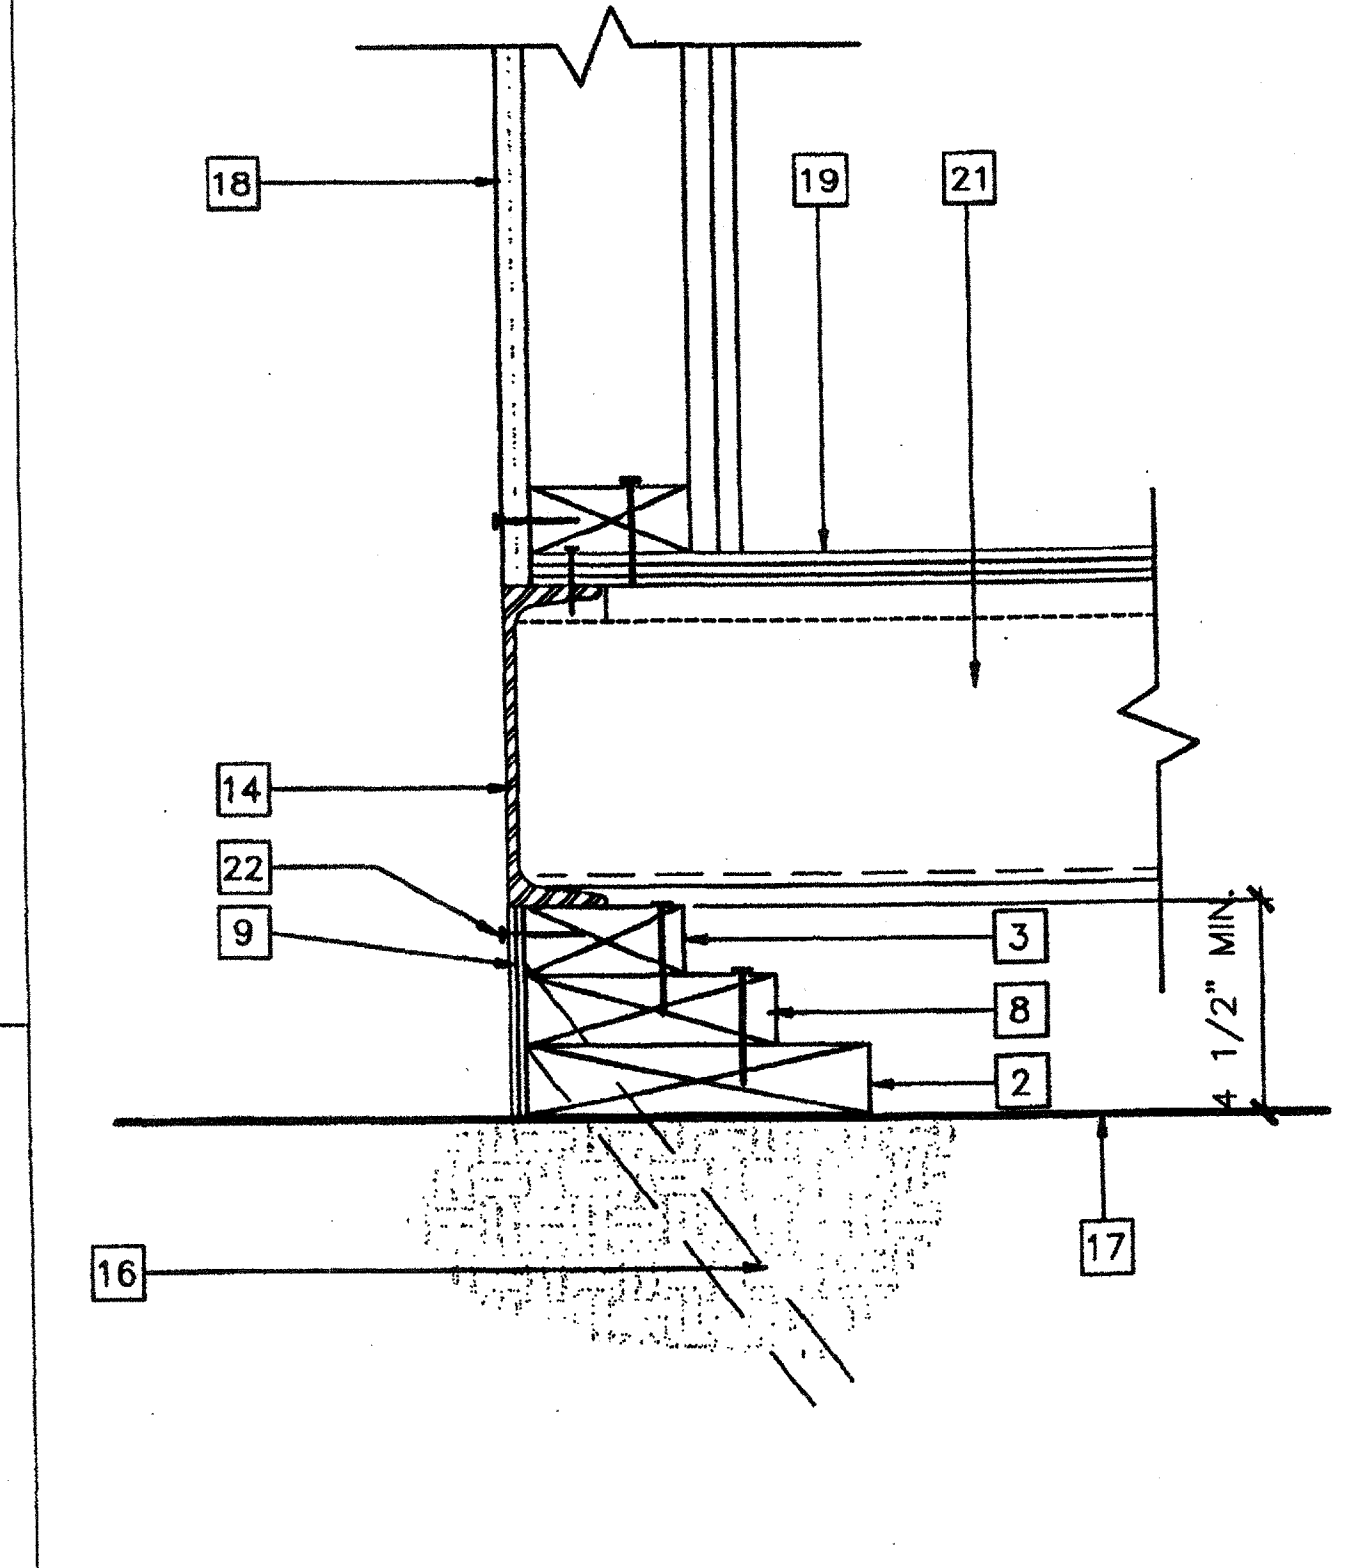

2 SCALE: 3"=1'-0"
FOUNDATION @ SIDE WALL

- KEY NOTES**
- 1 2X12 SILL PLATE SEE FOUND. PLAN FOR LENGTH
 - 2 2X8 TOP PLATE W/16d AT MAX. 5" O.C. TO SILL PLATE
 - 3 2X4 CONT. TOP PLATE W/16d AT MAX. 12" O.C.
 - 4 2X4 TOP PLATE CONT. W/16d AT MAX. 12" O.C.
 - 5 2X4 BLOCKING W/16d MAX. 12" O.C. TO SILL PLATE
 - 6 NOT USED
 - 7 NOT USED
 - 8 2X6 BLOCKING W/16d AT MAX. 12" O.C.
 - 9 MIN. 5/8" PLYWOOD SKIRTING W/10d BOX @ MIN. 4" O.C. AT ENDWALLS & 8" O.C. AT SIDEWALLS E.N. & TYP. 12" O.C. FN.
 - 10 ADD BLOCKING OR SHIMS AS REQ. TO MAX. HT. SEE DETAIL #2
 - 11 MIN. FOUNDATION HEIGHT. SEE DETAIL #2
 - 12 10 GA. PLATE 4" X 12"
 - 13 2X8 BLOCKING FACE OR TOE NAIL 16d AT MAX. 12" O.C. ADD BLKS. OR SHIMS AS REQ'D
 - 14 FLOOR FRAME BEAM. SEE STRUCTURAL
 - 15 VENT MIN. 3" X 6'-6" TYP. 4-PLACES = 6.5 SF. 2 VENTS AT 3" X 2'-0" = 1.0 SF. = 7.5 SQ. FT. TOTAL
 - 16 SILL RESTRAINT 1" DIA. PIPE. SEE FOUND. PLAN FOR LOCATION - 24" LONG
 - 17 FINISH GRADE
 - 18 EXTERIOR FINISH
 - 19 PLYWOOD SUBFLOOR
 - 20 MOD-LINE
 - 21 FLOOR-JOIST
 - 22 EN SEE NOTE #9
 - 23 6" X 12" X 10GA. PLATE W/(4) #10 SMS TO FLR & (4) 1/4" DIA. X 3" LAG TO FOUND. TOP PLATE
 - 24 6" X 12" X 10 GA. PLATE
 - 25 1/4" DIA. X 3" LG. LAG SCREW TYP. 4-PLACES
 - 26 #10 S.T.S. TYP. 4-PLACES
 - 27 2" X 12" X 2'-6" SILL PLATE. SEE FOUND. PLAN FOR QUANTITY REQ'D
 - 28 2X8 BLOCKING W/16d AT MAX. 6" O.C. MIN. 3 PER BLOCK. (MAY VARY ACCORDING TO SITE)
 - 29 10d GALV. BOX NAIL AT MAX. 4" O.C.
 - 30 INSERT REQ'D 2X4 BLOCKING OR PLYWOOD SHIM W/16d AT 12" O.C. FACE NAIL
 - 31 NOT USED
 - 32 NOT USED

IDENTIFICATION STAMP
DIV. OF THE STATE ARCHITECT
OFFICE OF REGULATION SERVICES
AC FLS SS
DATE MAR 09 2000

IDENTIFICATION STAMP
DIV. OF THE STATE ARCHITECT
APP#3 117468
AC FLS SS TV
DATE AUG 04 2019

REVISIONS	Electrical Engineer's Seal	Mechanical Engineer's Seal	Architect's Seal

PC
CBC 1998

IDENTIFICATION STAMP
DIV. OF THE STATE ARCHITECT
OFFICE OF REGULATION SERVICES
PC-04
10419
AC FLS SS
DATE OCT 24 2019

MODTECH INC.
2830 BARRETT AVENUE
PERRIS, CALIF. 92572
PH (909) 943-4014
FAX (909) 940-0427


PROJECT NUMBER: _____ © MODTECH, INC. 1999

DRAWN BY: _____
DATE: _____
CHECKED BY: SS
DATE: 10/22/19


MODTECH Index No. _____

F2.0


FILE PATH: 2440-0-F2-0.DWG PROJECT NO. PC-04-101419

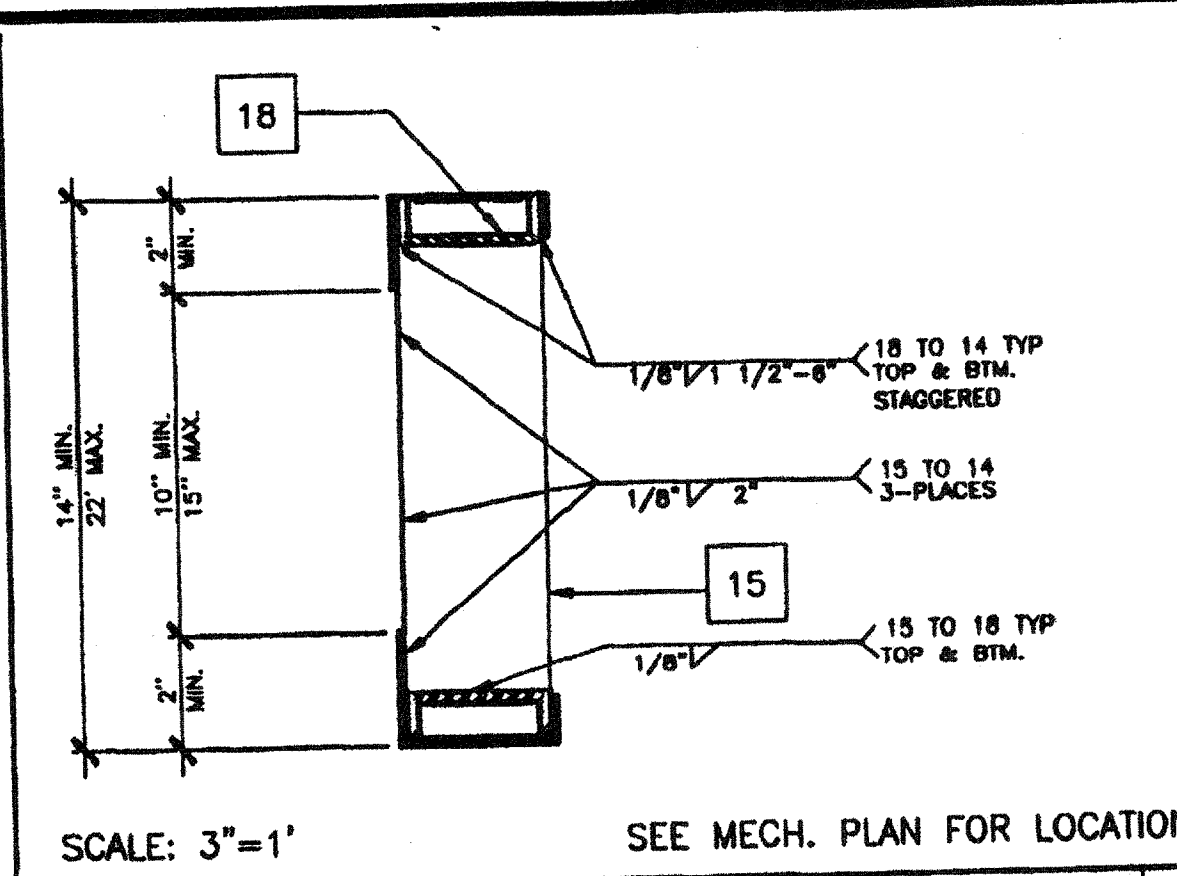


MECH. DUCT OPENING IN ROOF BM. 8

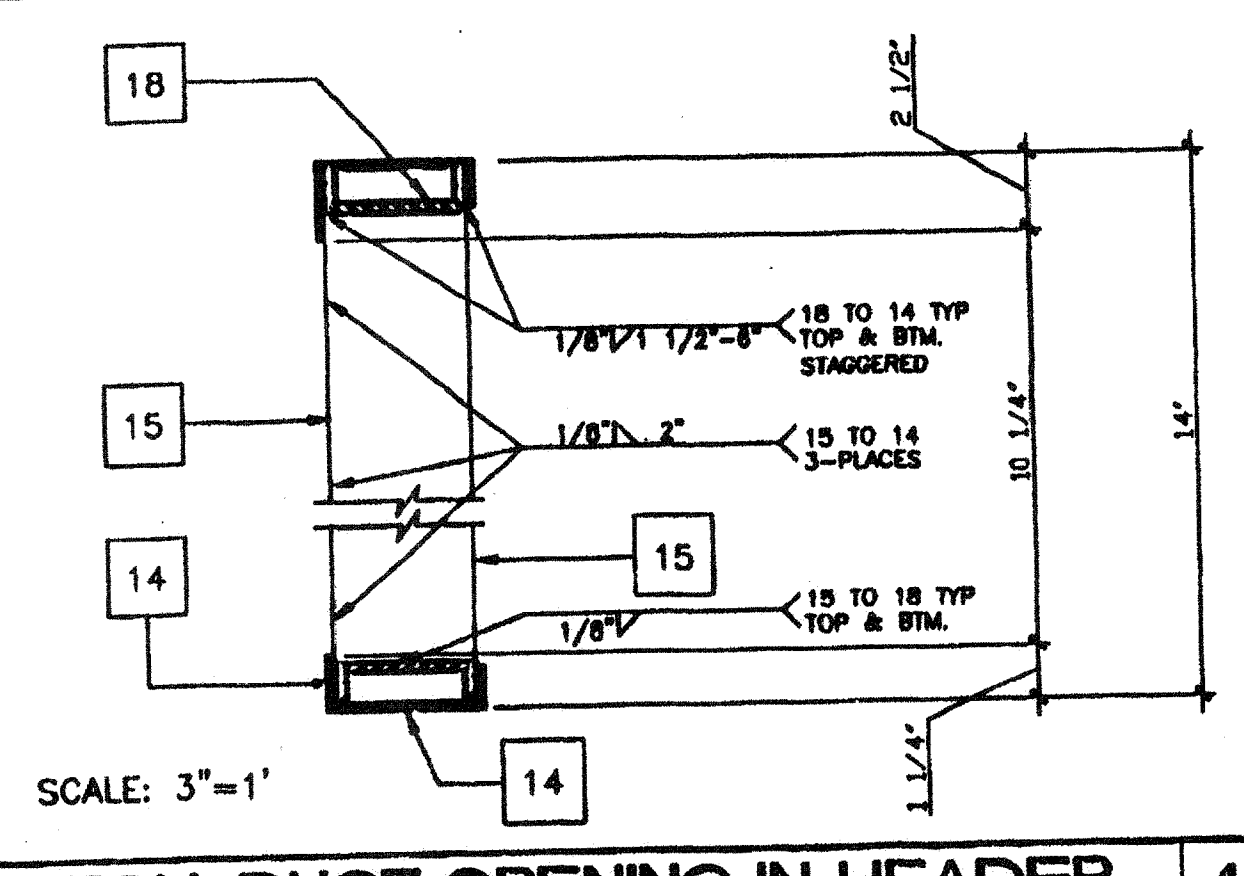


MECH. DUCT OPENING IN HEADER

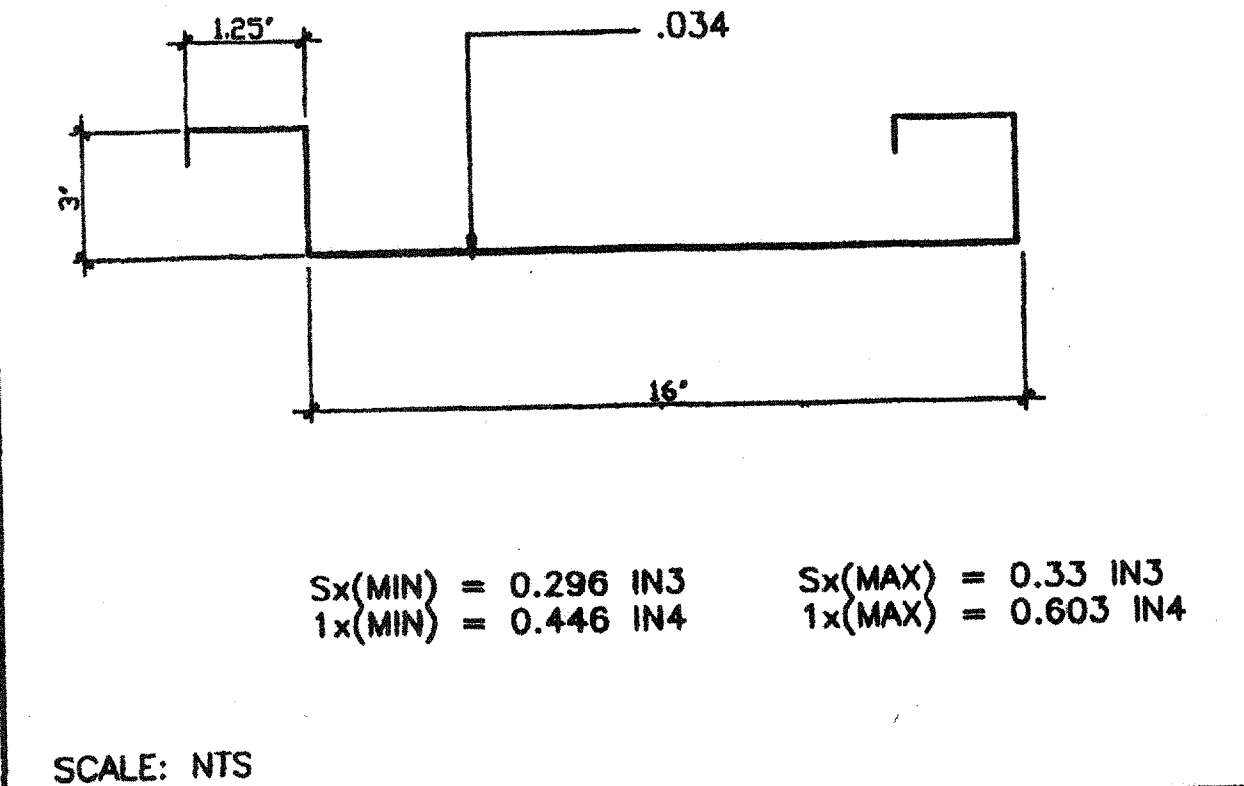


ROOF PAN (22GA.)

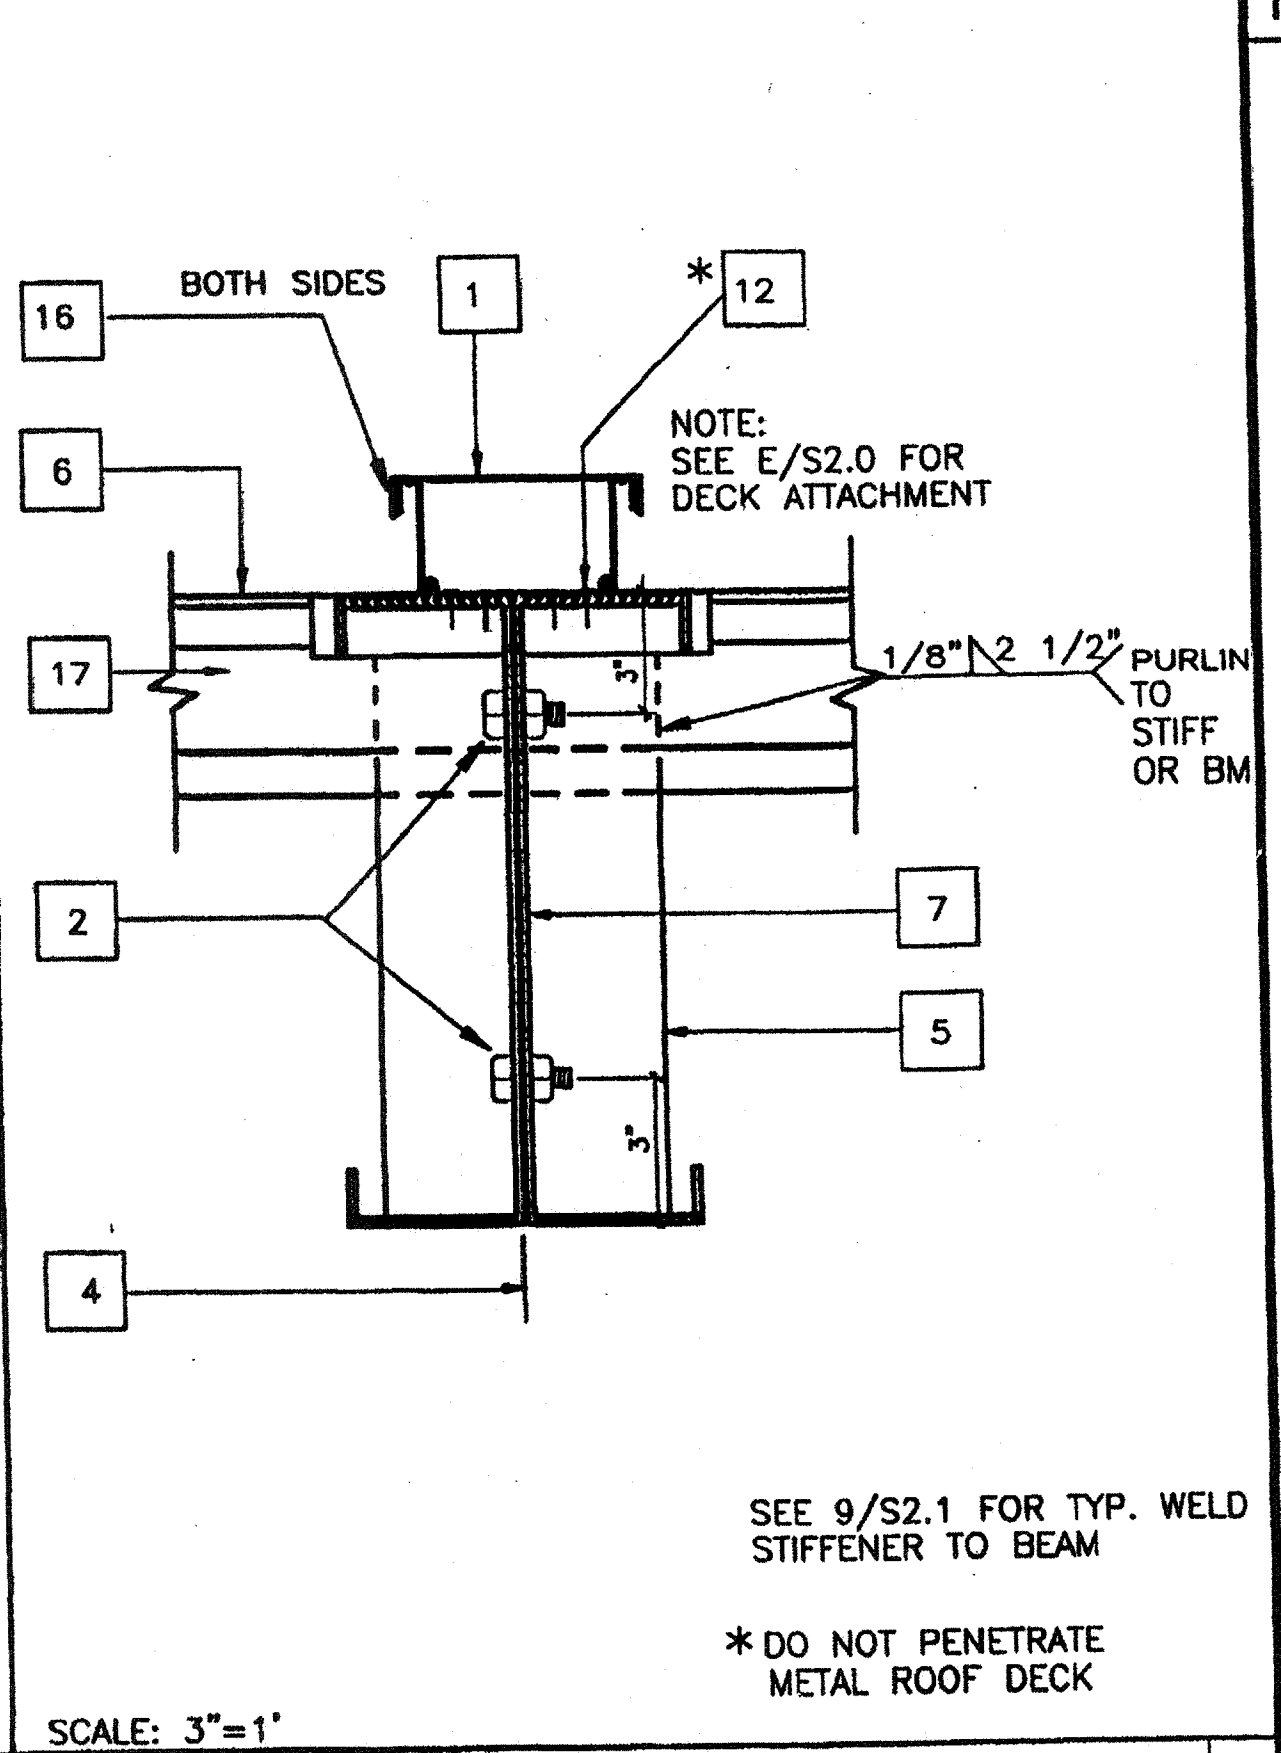


ROOFING • MODLINE

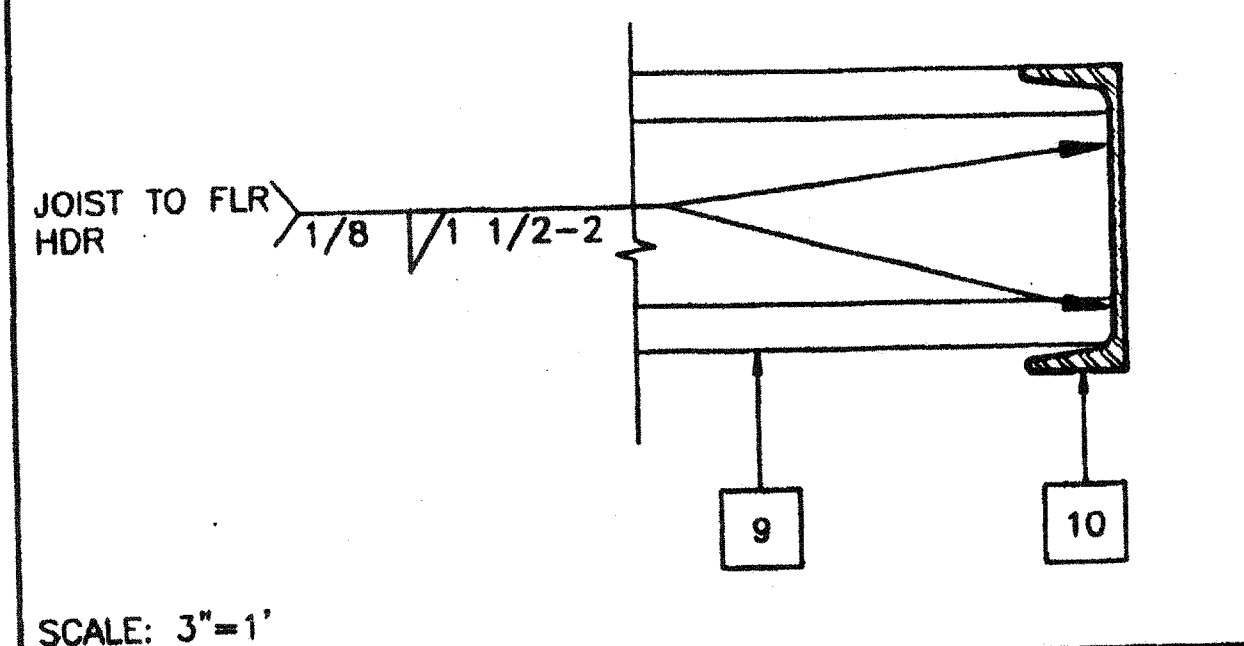


FLOOR FRAME/JOIST TO BEAM

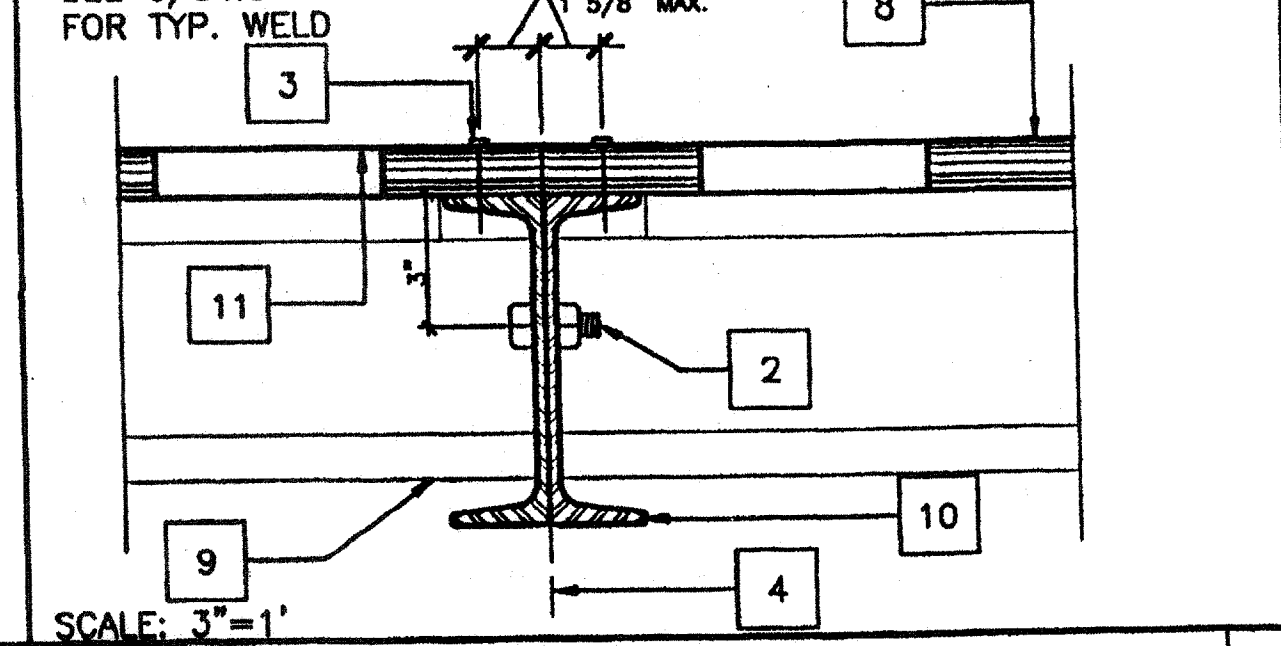

MODULE JOINT AT FLR. 12'-0"

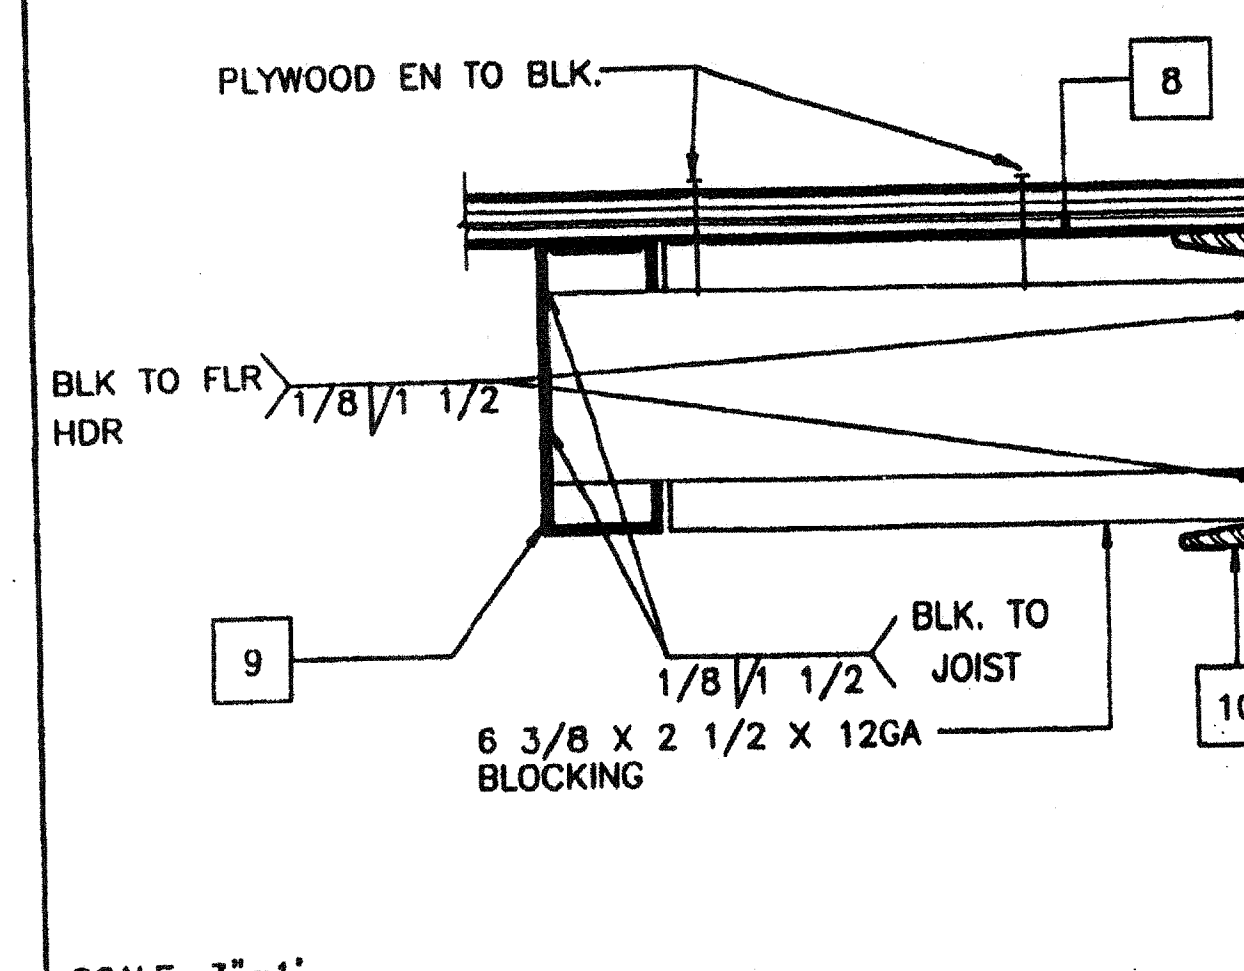

BLOCK AT MIDSPAN

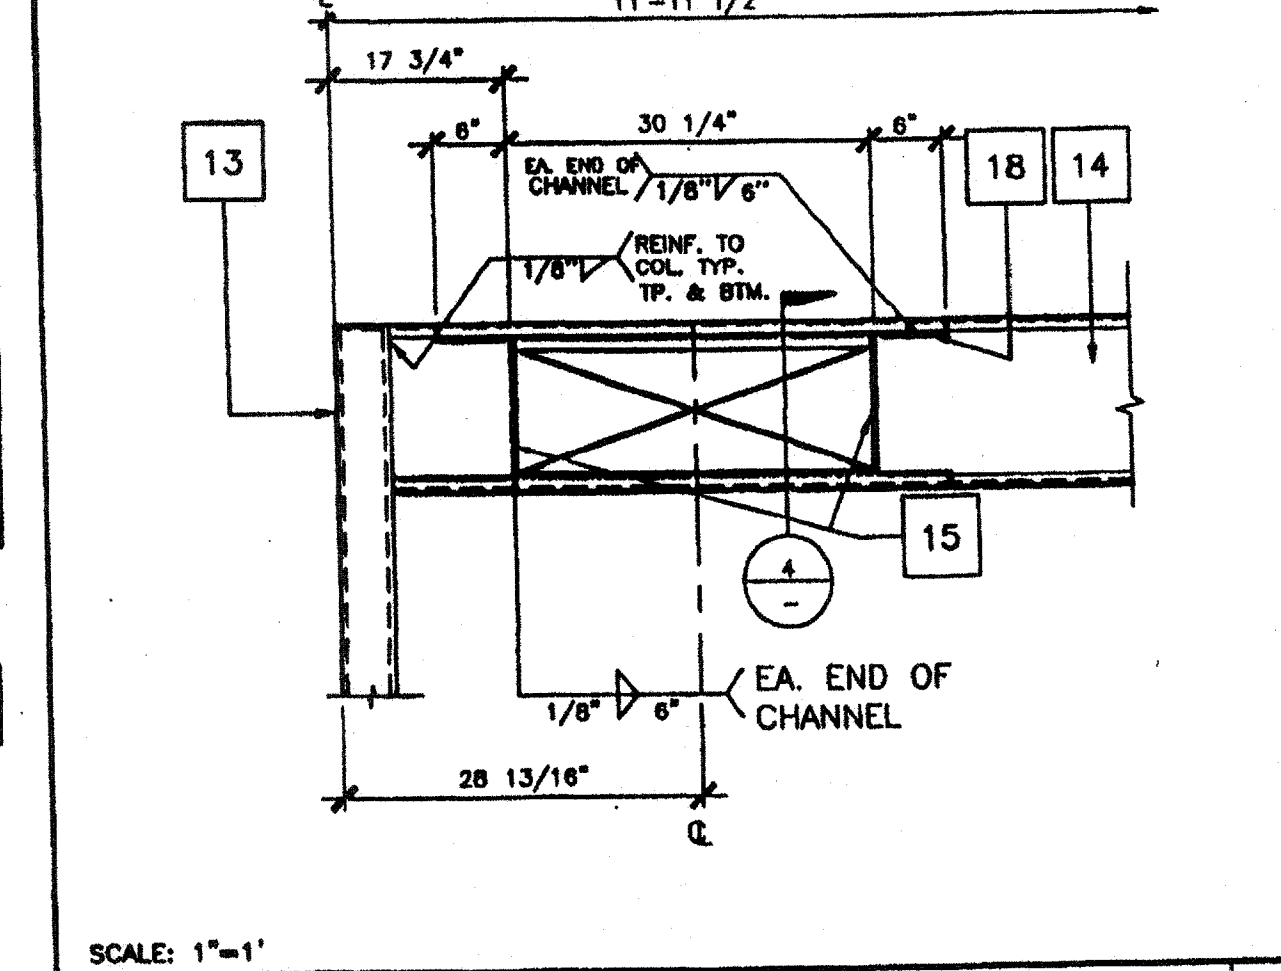

ELEVATION-OPENING

- KEY NOTES**
- 1 CAP CLOSURE AT RIDGE 26GA. GALV. W/#10 TYPE FASTENERS W/NEOPRENE WASHERS TO RIB BOTH SIDES OF MODLINE. SET CAP IN SIAMANT. BOTH SIDES
 - 2 5/8" M.B. A307 MODULE JOINT (SEE STRUCTURAL PLAN FOR LOCATION) AT 8" O.C.
 - 3 E.N.
 - 4 MODULE JOINT
 - 5 1/4" THK X 3" FULL DEPTH STIFFENER PLATE AT RIDGE ONLY (SEE 9/S2.1)
 - 6 STANDING ROOF SEAM (SEE A2.0)
 - 7 ROOF BEAM SEE 1/S2.1 & 7/S2.1
 - 8 PLYWOOD FLOOR SHEATHING
 - 9 FLOOR JOIST SEE 6/S2.1
 - 10 FLOOR BEAM SEE 5/S2.1
 - 11 HAND HOLE AT BOLT LOCATION
 - 12 #14 STSMS.
 - 13 3 1/2 X 3 1/2 X 1/4" STEEL TUBE COLUMN. SEE 12/S2.1
 - 14 ROOF HEADER SEE 3/S2.1
 - 15 1/4" STIFFENER PLATE SEE 9/S2.1 FOR TYP. WELD
 - 16 SEALANT
 - 17 ROOF PURLIN SEE 2/S2.1
 - 18 3 1/4" X 1" X 45 11/16" LG X 10GA CHANNEL TOP AND BOTTOM OF OPENING

CBC 1993
PC

IDENTIFICATION STAMP
DIV. OF THE STATE ARCHITECT
OFFICE OF REGULATION SERVICES
AC FLS SS
DATE MAR 09 2000

IDENTIFICATION STAMP
DIV. OF THE STATE ARCHITECT
OFFICE OF REGULATION SERVICES
APP#3 117168
AC FLS SS TV
DATE AUG 04 2016

REVISIONS	Electrical Engineer's Seal	Mechanical Engineer's Seal	Structural Engineer's Seal	Architect's Seal
1				
2				
3				
4				

IDENTIFICATION STAMP
DIV. OF THE STATE ARCHITECT
OFFICE OF REGULATION SERVICES
PC-04
101419
AC FLS SS
DATE OCT 25 1999

MODTECH INC.
2830 BARRETT AVENUE
PERRIS, CALIF. 92572
PH (909) 943-4014
FAX (909) 940-0427

PROJECT NUMBER: _____

© MODTECH, INC. 1999

DRAWN BY: _____
DATE: _____

CHECKED BY: SS
DATE: 10/22/99

MODTECH Index No. _____

STRUCTURAL DETAILS

S1.2

PROJECT NO. PC-04-101419

ELECTRICAL PANEL SCHEDULE

LOAD	WATTS		BREAKER				BREAKER				WATTS		LOAD
	Ap	Bp	Amps	P	Q	R	S	T	U	V	W	Xp	
RECEPTACLE (4)	720		20	1	1							3360	HVAC (3 1/2T)
RECEPTACLE/CLOCK (5)		720	20	1	3							3360	HVAC (3 1/2T)
												2500	HEAT STRIPS (8KW)
												2500	HEAT STRIPS (8KW)
INT/EXT LIGHTS (11)	780		20	1	9							40	FIRE ALARM (DEDICATED)
INT. LIGHTS (10)		700	20	1	11							5800	5800
WATTS/PHASE	A = 7340	1480	1420									B = 7320	WATTS/PHASE
TOTAL	14810	WATTS	82	AMPS	120/240	VOLTS							
NCL =	13080	WATTS											



GENERAL GROUNDING NOTES

- EACH BUILDING SHALL BE SEPARATELY GROUNDING WITH A 3/4" RD. 2" COPPERCLAD STEEL GROUND ROD, WHERE ROCK BOTTOM IS ENCOUNTERED, ROD SHALL BE DRIVEN AT AN ANGLE NOT TO EXCEED 45 DEGREE'S FROM THE VERTICAL, OR SHALL BE BURIED IN A TRENCH THAT IS AT LEAST 30" DEEP (BY SITE ELECTRICAL)
- TESTING: TEST FOR RESISTANCE TO GROUND. IF RESISTANCE EXCEEDS 25 OHMS, INSTALL ADDITIONAL GROUND RODS SEPARATED AT LEAST 8'-0" UNTIL RESISTANCE IS REDUCED TO 25 OHMS OR LESS. (BY SITE ELECTRICAL)
- APPROVAL OF THIS PLAN DOES NOT CONSTITUTE APPROVAL OF THIS FIRE ALARM FOR ALL SITES. THE FIRE ALARM SYSTEM AND/OR COMPONENTS MAY BE REQUIRED TO BE CHANGED DUE TO SITE LOCATION, EXISTING CONDITIONS OR INCOMPATIBLE COMPONENTS.
- GROUND MG TEST SHALL BE DONE IN THE PRESENCE OF THE PROJECT INSPECTOR. ALL GROUNDING SHALL BE IN ACCORDANCE WITH CEC ARTICLE 250.


ELECTRICAL LEGEND

- 2'x4' 4 TUBE FLUORESCENT LIGHT FIXTURE
- EXTERIOR LIGHT FIXTURE AT +93" AFF
- ⚡ SWITCH AT +48" AFF
- ⊕ DUPLEX WALL RECEPTACLE 15A 125V 3 WIRE AT +18" AFF UNW
- ⊖ HVAC UNIT (HV)
- ⊠ 4SD J-BOX FOR FIRE ALARM PULL STATION AT +48" AFF, 3/4" CD TO ○ OR □ PULLSTRING
- ⊡ 4SD J-BOX FOR FIRE ALARM STROBE AT +18" AFF, 3/4" CD TO □ PULLSTRING
- ⊣ 4SD J-BOX FOR FIRE ALARM HORN AT +18" AFF, 3/4" CD TO □ PULLSTRING
- ⊞ WEATHER PROOF GUTTER BOX (8"x6"x4") AT +18" AFF RECEIVE 3/4" CD FROM FA DEVICE, PULLSTRING
- ⊟ ELECTRICAL PANEL AT +60" AFF TO CENTERLINE 1 1/4" PWR NIPPLE POC, GND JUMPER BY SITE ELECT
- ⌚ CLOCK AT +90" AFF
- Ⓜ DATA LINE
- Ⓢ 4SD J-BOX FOR OPTIONAL SMOKE DETECTOR (CFL)
- Ⓣ 4SD J-BOX FOR OPTIONAL SMOKE DETECTOR (MTR)

* SMOKE & HEAT DETECTORS SHOWN ARE FOR OPTION AUTOMATIC DETECTION. IF ELECTED AS AN OPTION THEY MUST BE PROVIDED BY DISTRICT. NO PROVISIONS WILL BE MADE UNDER THIS CONTRACT.

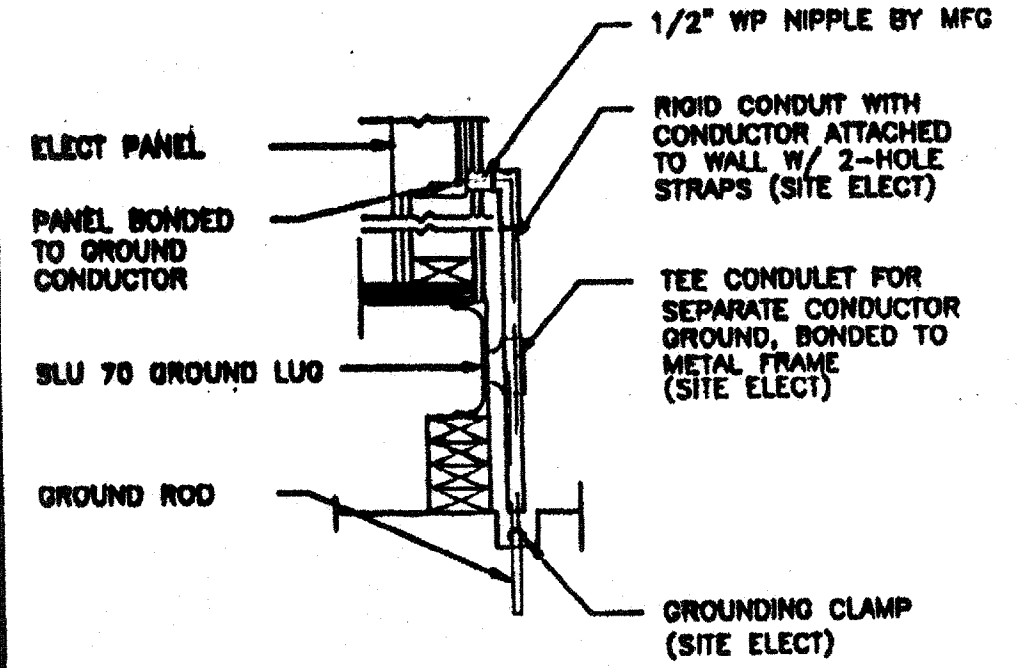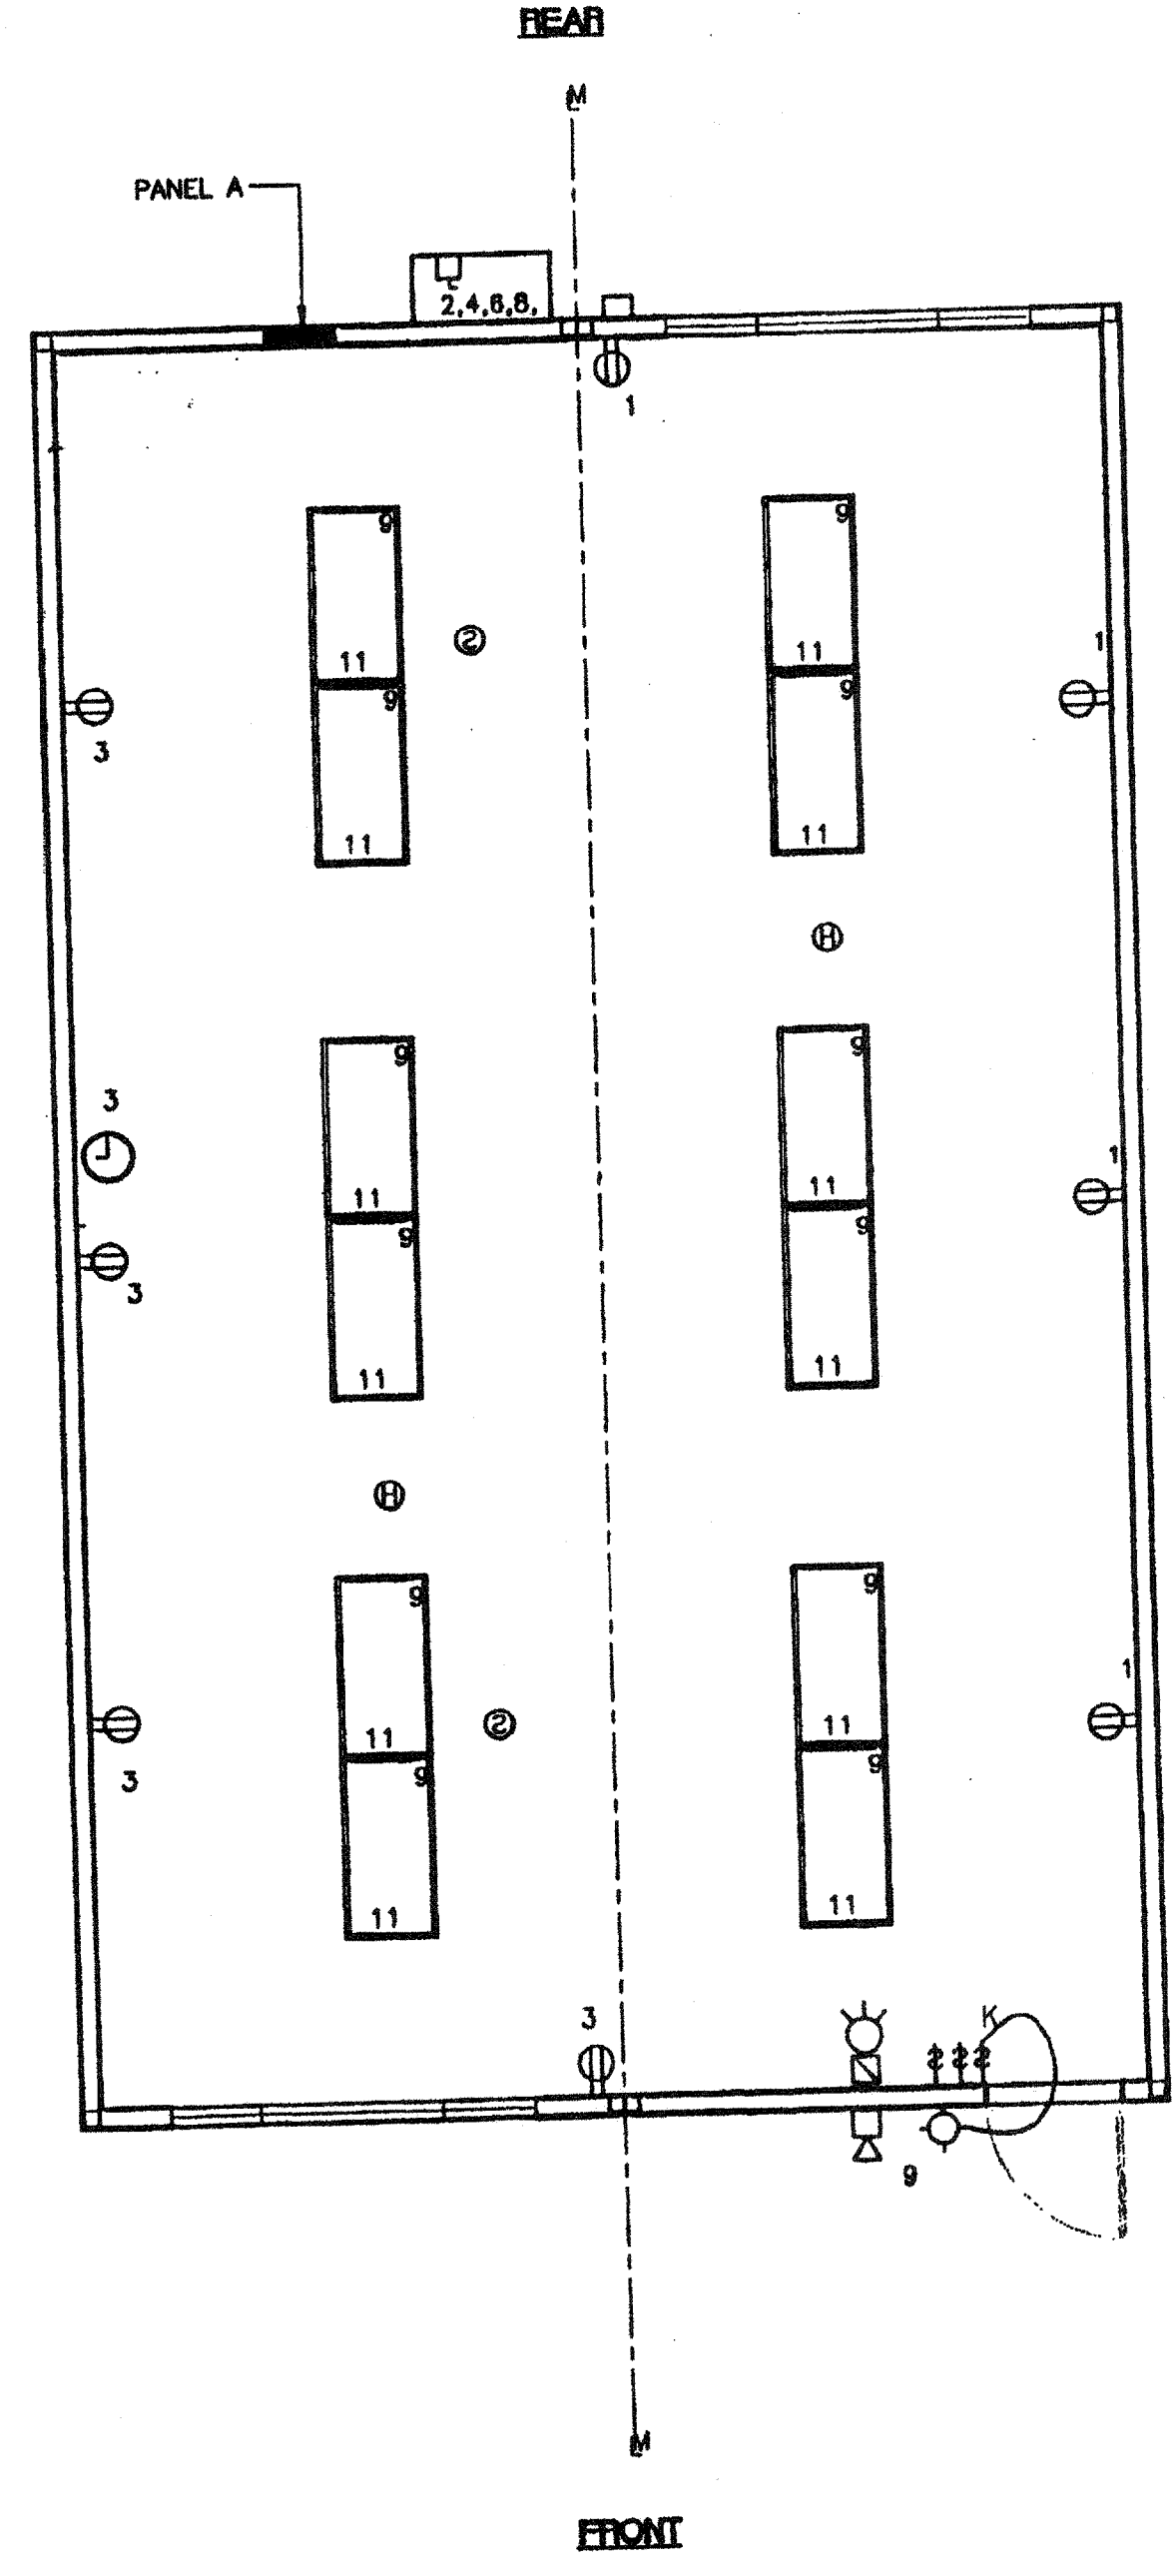


TYP GROUNDING DETAIL 1

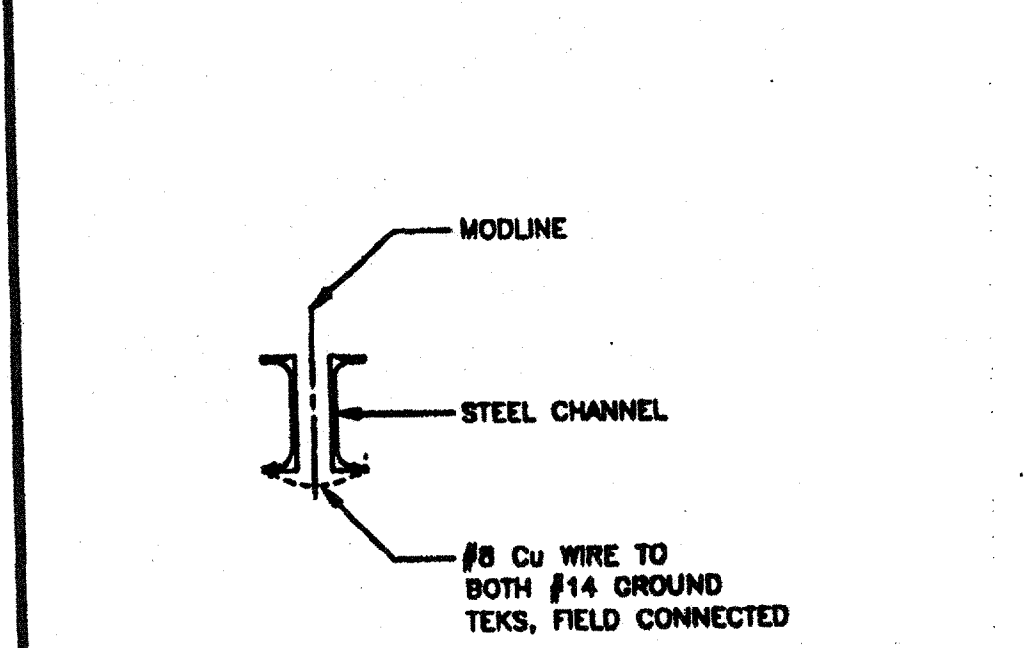

GROUND JUMPER • MOD LINE 2

NOTES

- SCHOOL EQUIPMENT ANCHORAGE
THE FOLLOWING IS FOR THE ARCHITECTS INFORMATION ONLY:
THE SEISMIC ANCHORAGE OF ELECTRICAL EQUIPMENT SHALL CONFORM TO CCR TITLE 24, SECTION 1832A AND TABLE 18A-0. ANCHORAGE DETAILS FOR ROOF/FLOOR MOUNTED EQUIPMENT WEIGHING LESS THAN 400 LBS & HUNG EQUIPMENT WEIGHING LESS THAN 20 LBS MAY BE OMITTED FROM THE PLANS.
FOR ELECTRICAL DRAWINGS:
ALL ELECTRICAL EQUIPMENT SHALL BE BRACED OR ANCHORED TO RESIST A HORIZONTAL FORCE ACTING IN ANY DIRECTION USING THE FOLLOWING CRITERIA:
EQUIPMENT ON GRADE: 20% OF OPERATING WEIGHT
EQUIPMENT ON STRUCTURE: 30% OF OPERATING WEIGHT
FOR FLEXIBLY MOUNTED EQUIPMENT USE 4 TIMES THE ABOVE VALUES, AND FOR SIMULTANEOUS VERTICAL FORCE USE 1/3 TIMES THE HORIZONTAL FORCE.
THE ABOVE VALUES ARE FOR AN IMPORTANCE FACTOR, I = 1.0 AND SEISMIC ZONE, Z = 4
WHERE ANCHORAGE DETAILS ARE NOT SHOWN ON THE DRAWINGS THE FIELD INSTALLATION SHALL BE SUBJECT TO THE APPROVAL OF THE ARCHITECT AND THE FIELD ENGINEER OF THE OFFICE OF THE STATE ARCHITECT.

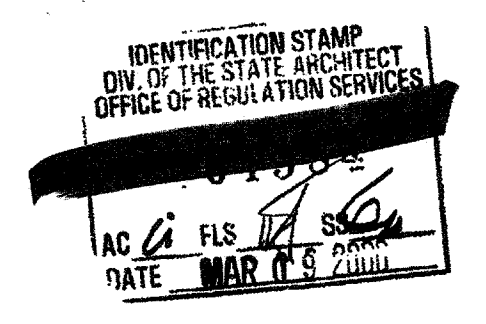

IDENTIFICATION STAMP
DIV. OF THE STATE ARCHITECT
OFFICE OF REGULATION SERVICES
APP#3 117168
AC / FLS / SS / TN
Date MAR 04 2010

ELECTRICAL PLAN (24'x40')
SCALE: 1/4" = 1'-0"

CBC 1998

REVISIONS

1		
2		
3		
4		
5		

Electrical Engineer's Seal
Mechanical Engineer's Seal
Architect's Seal


PG
OFFICE OF REGULATION SERVICES
PC-04
10419
DATE OCT 23 1999

MODTECH INC.
2830 BARRETT AVENUE
PERRIS, CALIF. 92572
PH (909) 943-4014
FAX (909) 940-0427

PROJECT NUMBER: © MODTECH, INC. 1999

DRAWN BY:
DATE:
CHECKED BY:
DATE: 10/23/99


ELECTRICAL PLAN w/o DATA 24'x40' **E1.0**

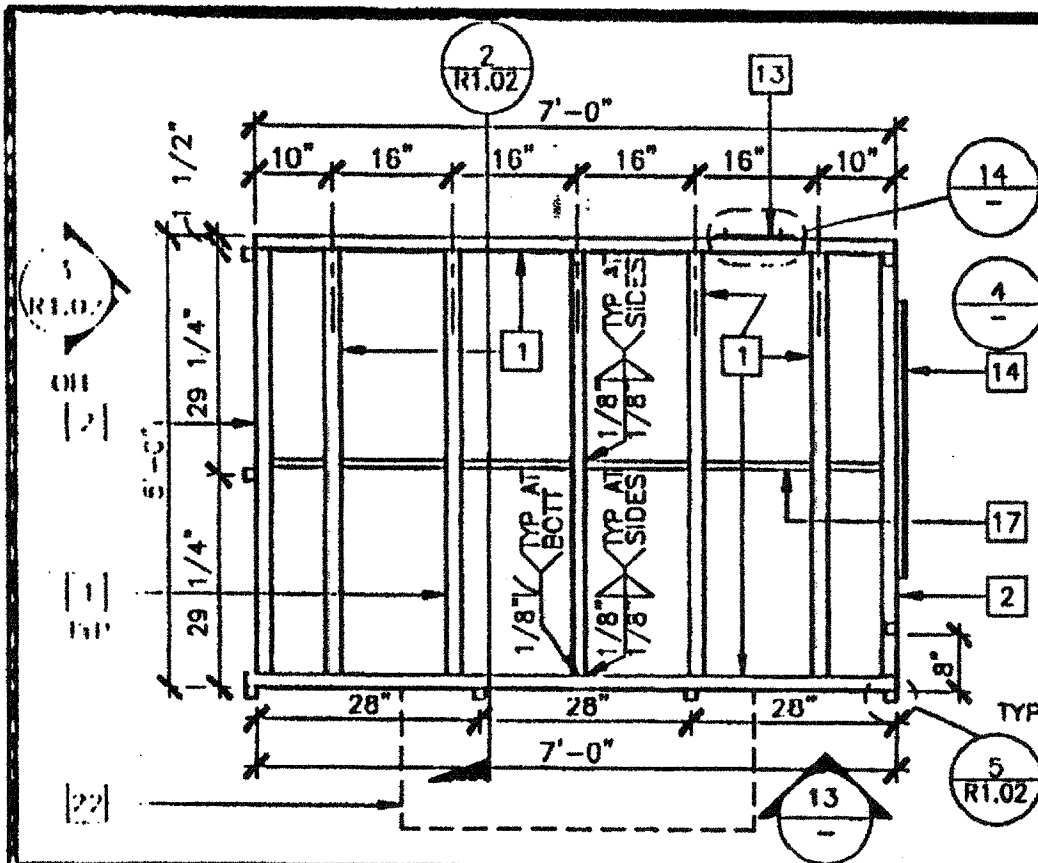

SCALE: NTS



12 LANDING FRAME

7 RAMP FRAME

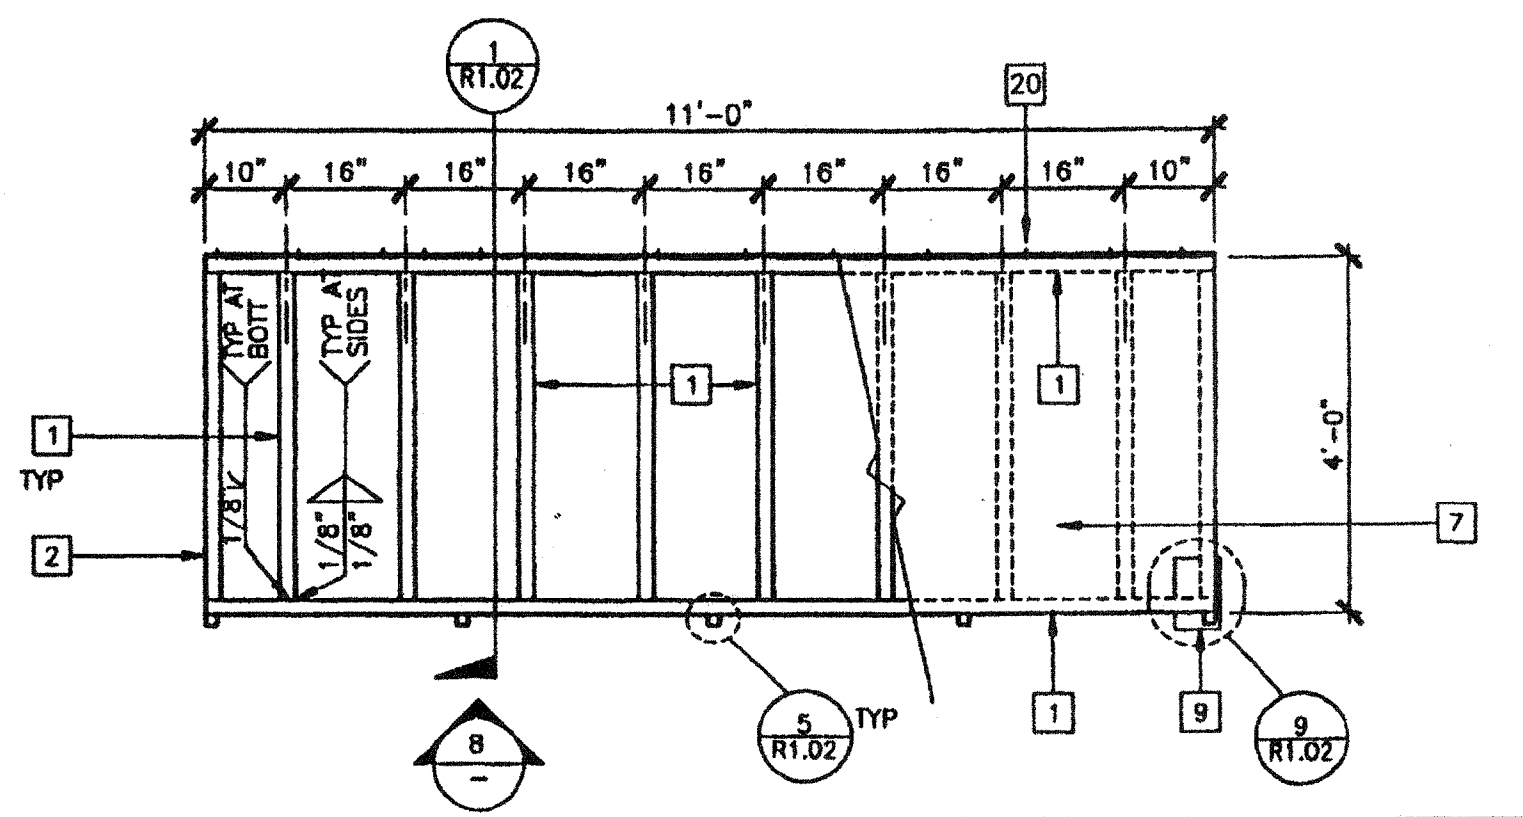

SCALE: 3/8"=1'-0"

1 SILL PLAN FOR RAMP AND LANDING

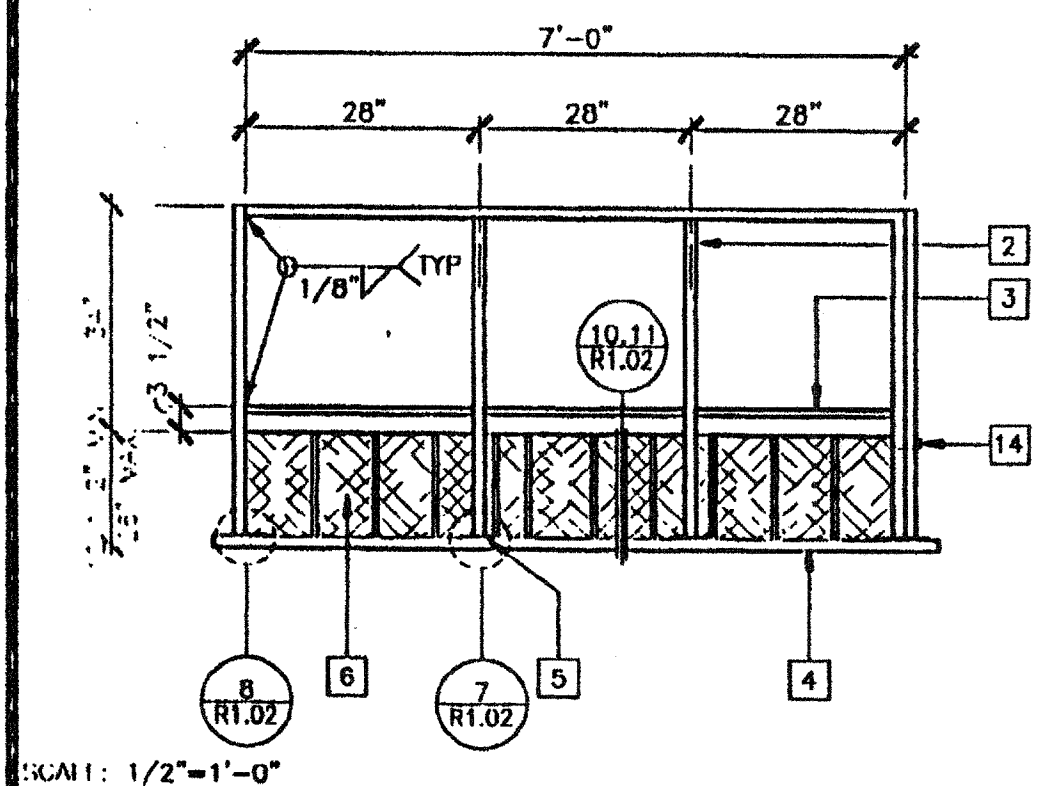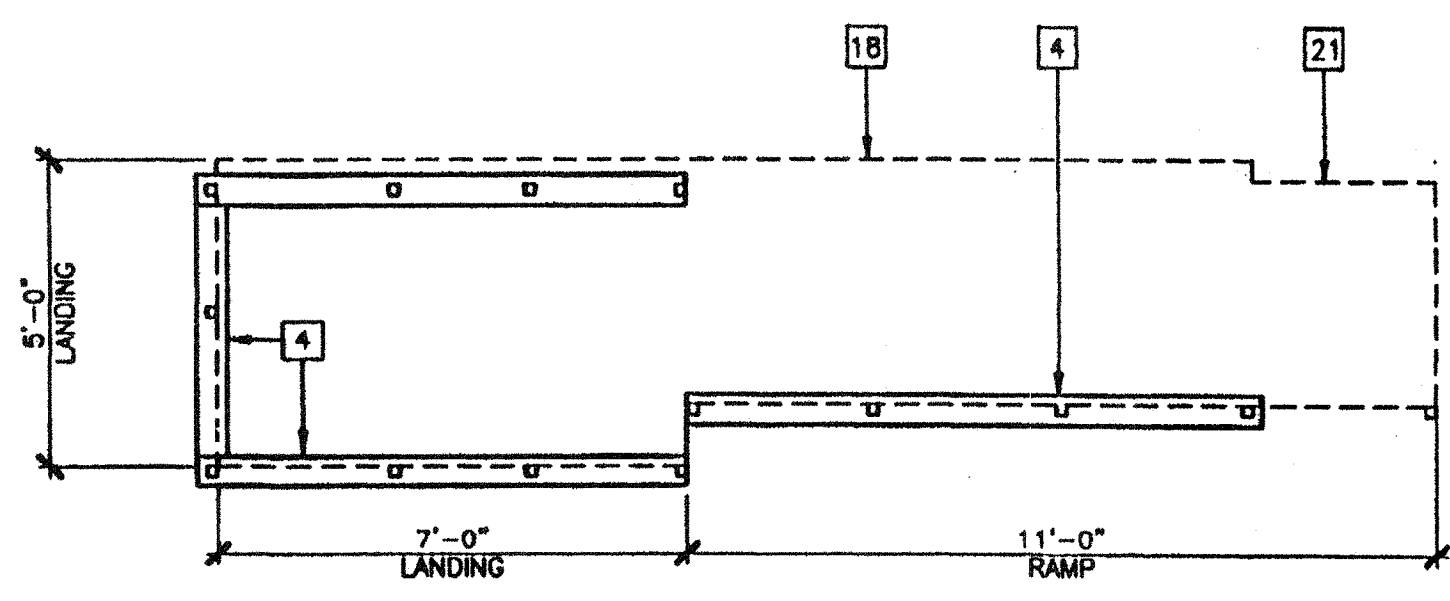


SCALE: 1/2"=1'-0"

13 LANDING ELEVATION



SCALE: 1/2"=1'-0"

8 RAMP ELEVATION

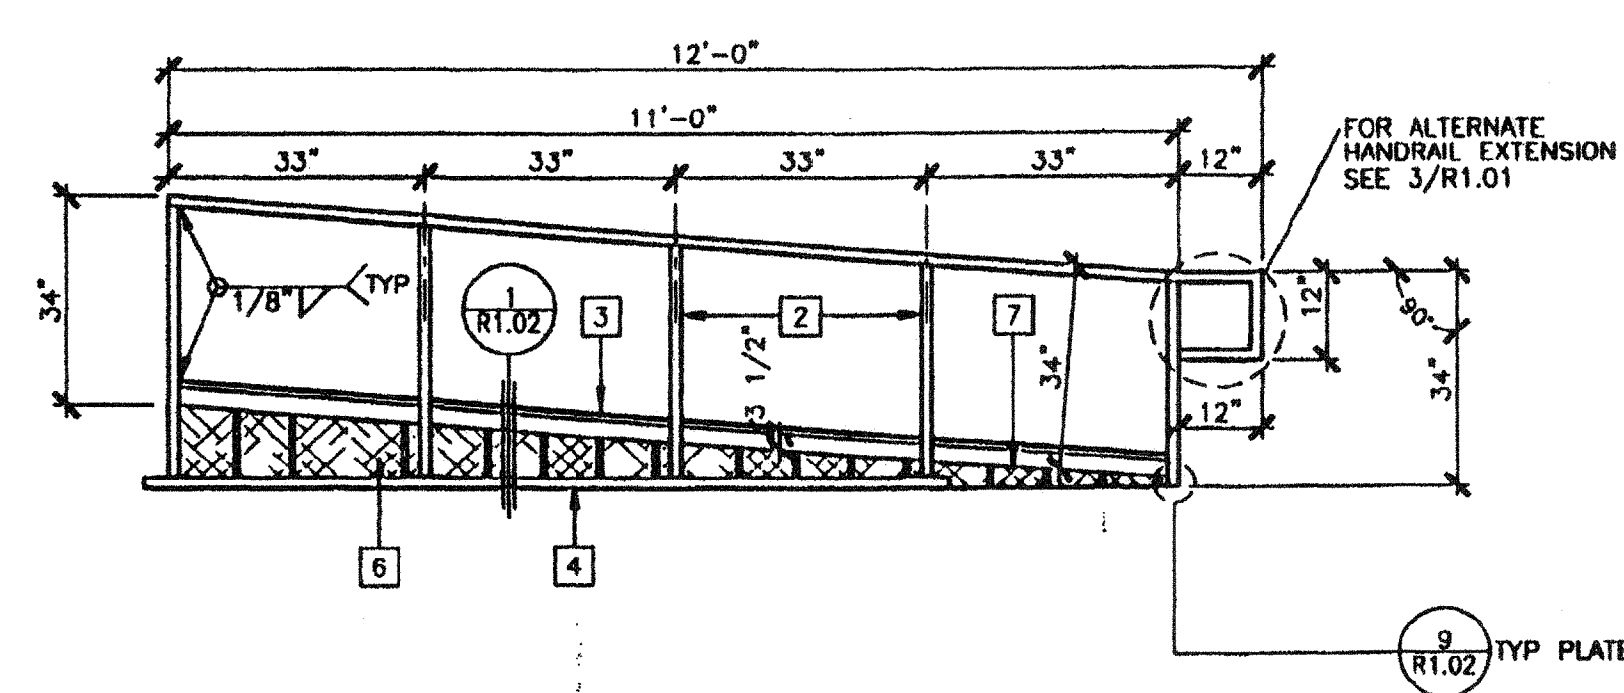

SCALE: 3/8"=1'-0"


2 RAMP AND LANDING AT BUILDING

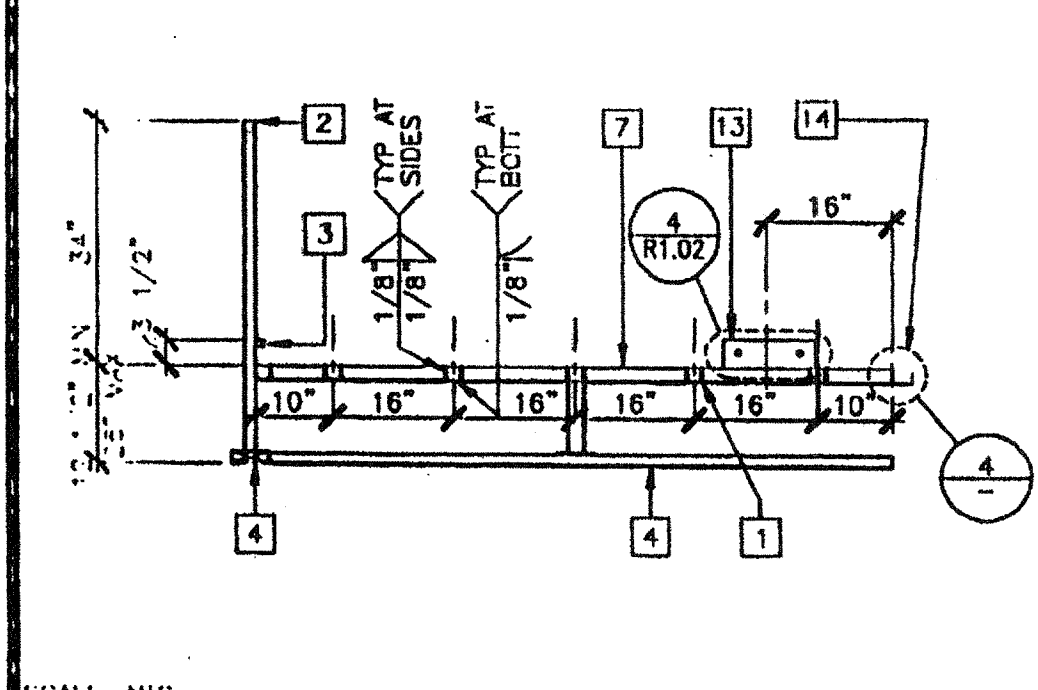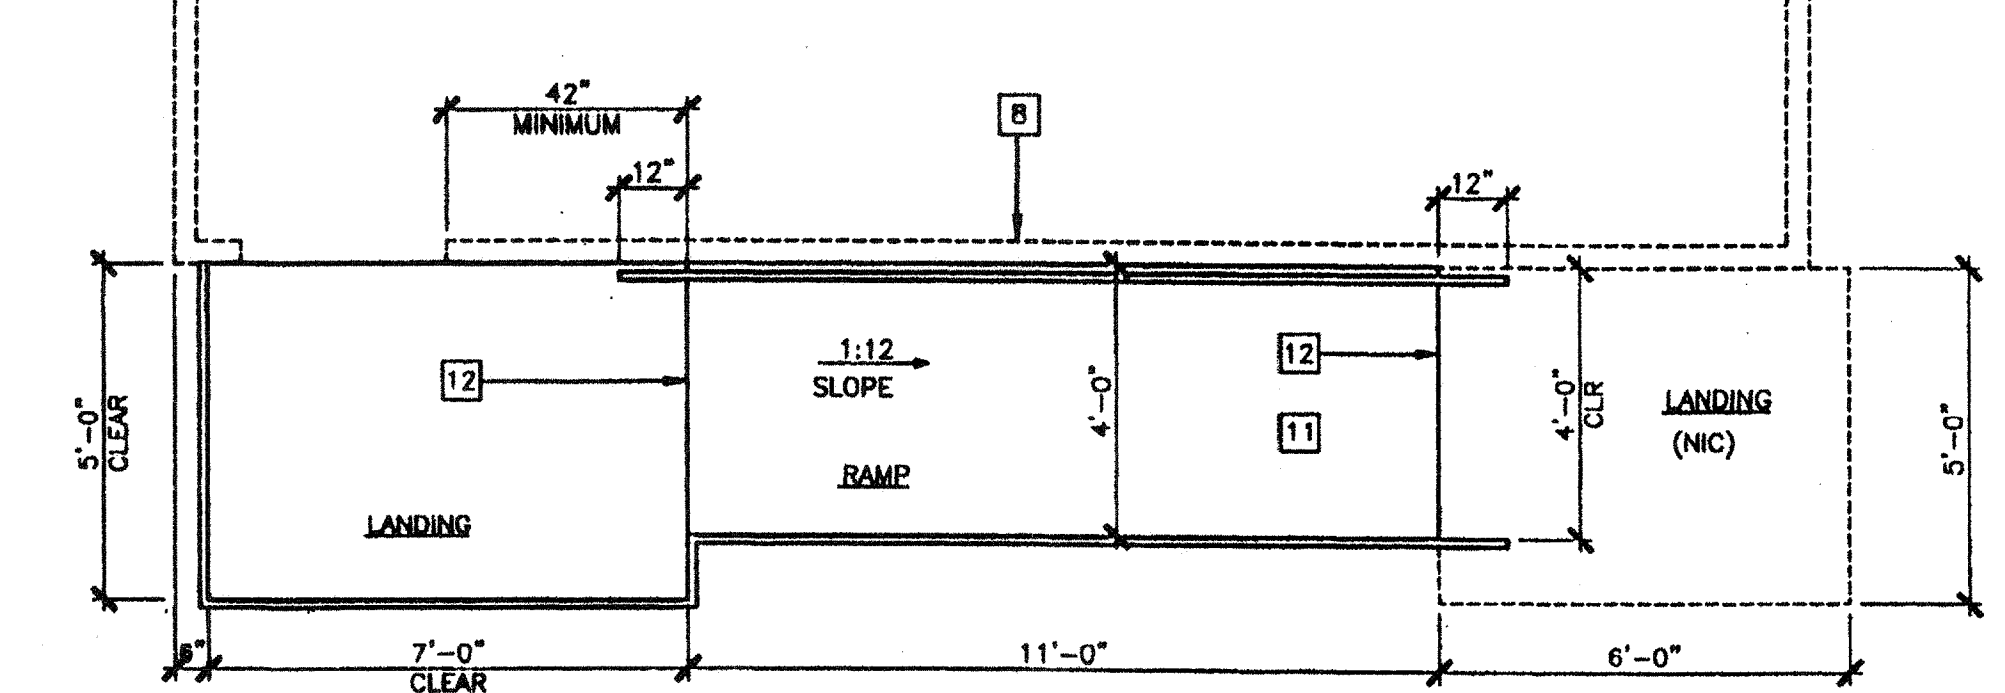

SCALE: NTS

14 SECTION AT LANDING

9 LONGITUDINAL SECTION AT RAMP



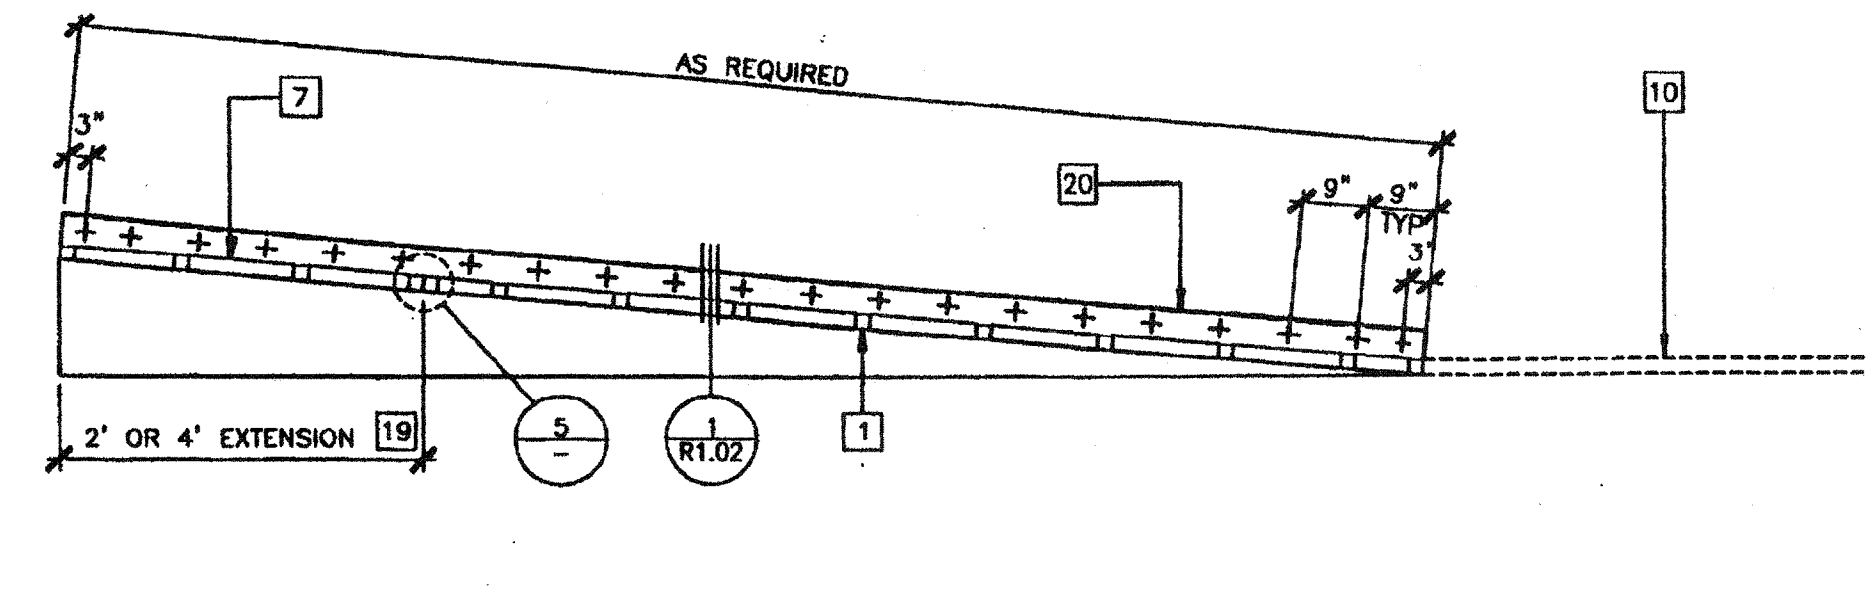


SCALE: NTS

SCALE: NTS

5 RAMP EXTENSION TO RAMP


3 ALTERNATE GUARD RAIL EXTENSION

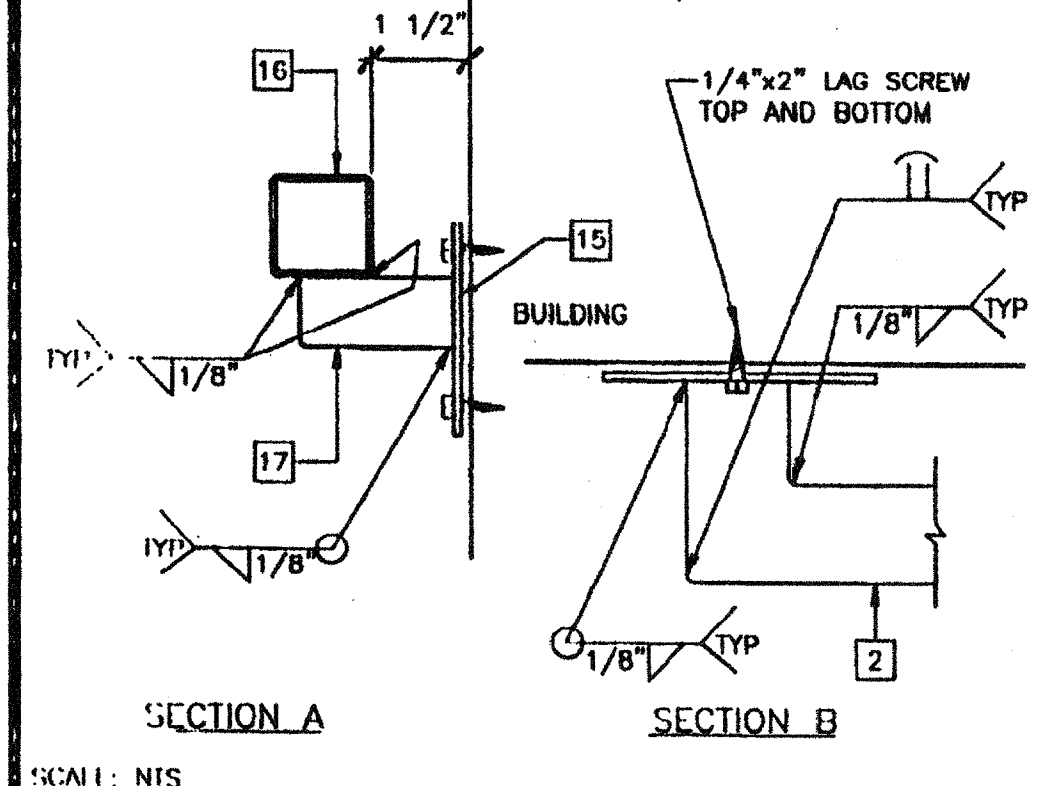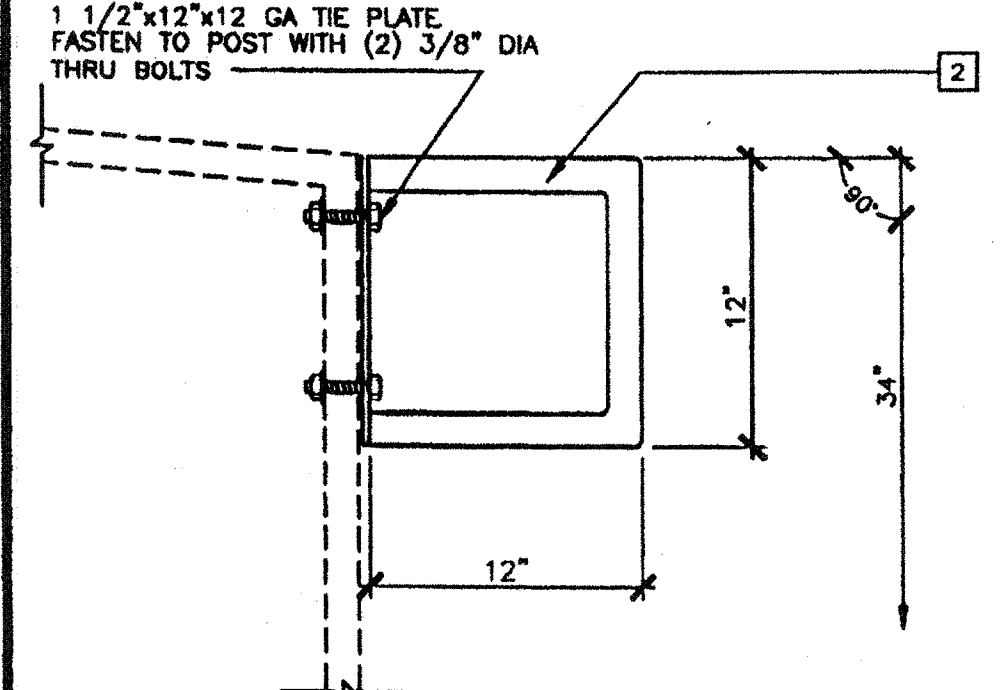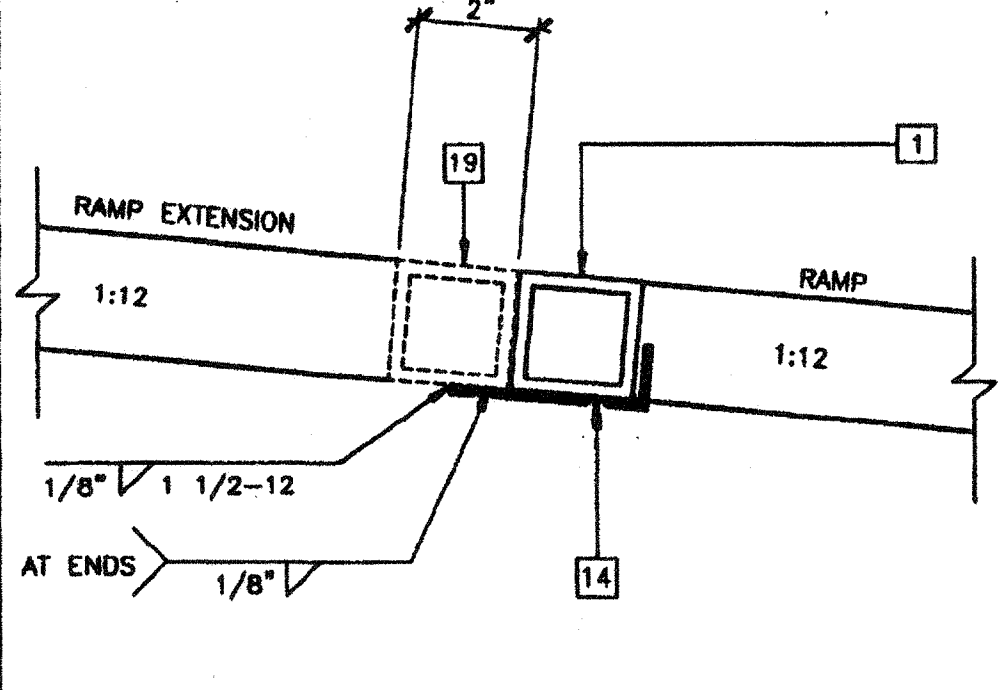


SCALE: NTS

15 HANDRAIL CONNECTION

6 HANDRAIL ATTACHED TO BUILDING (OPTIONAL)

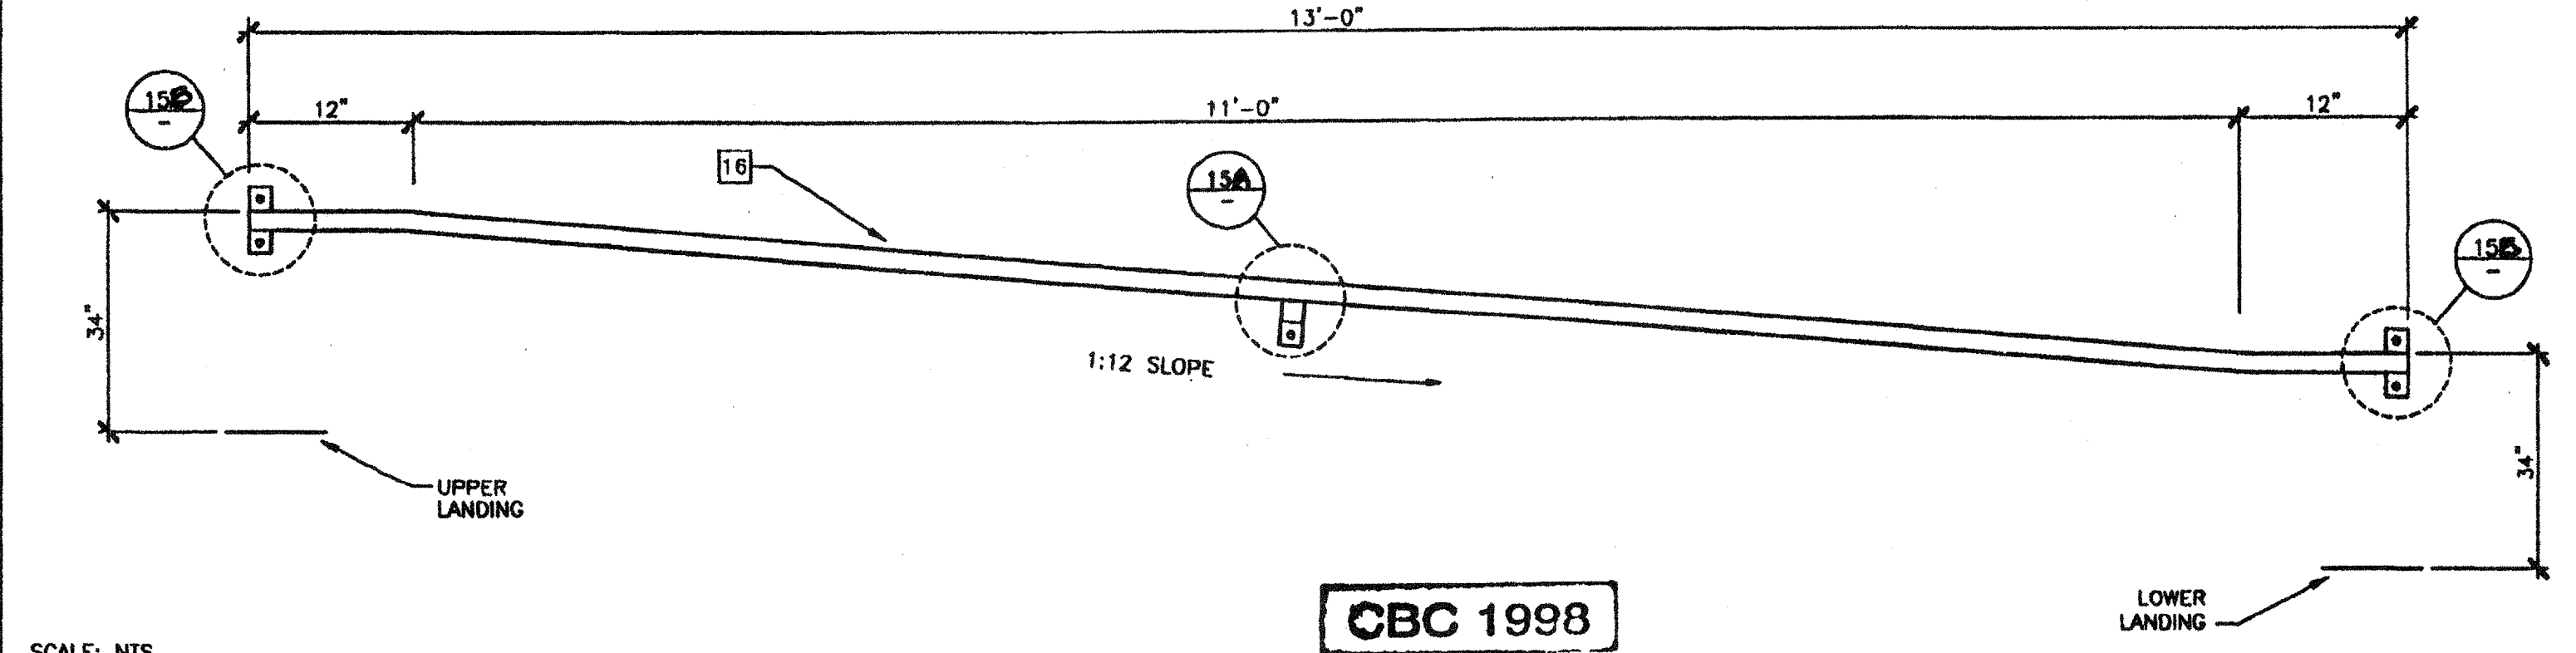

SCALE: NTS

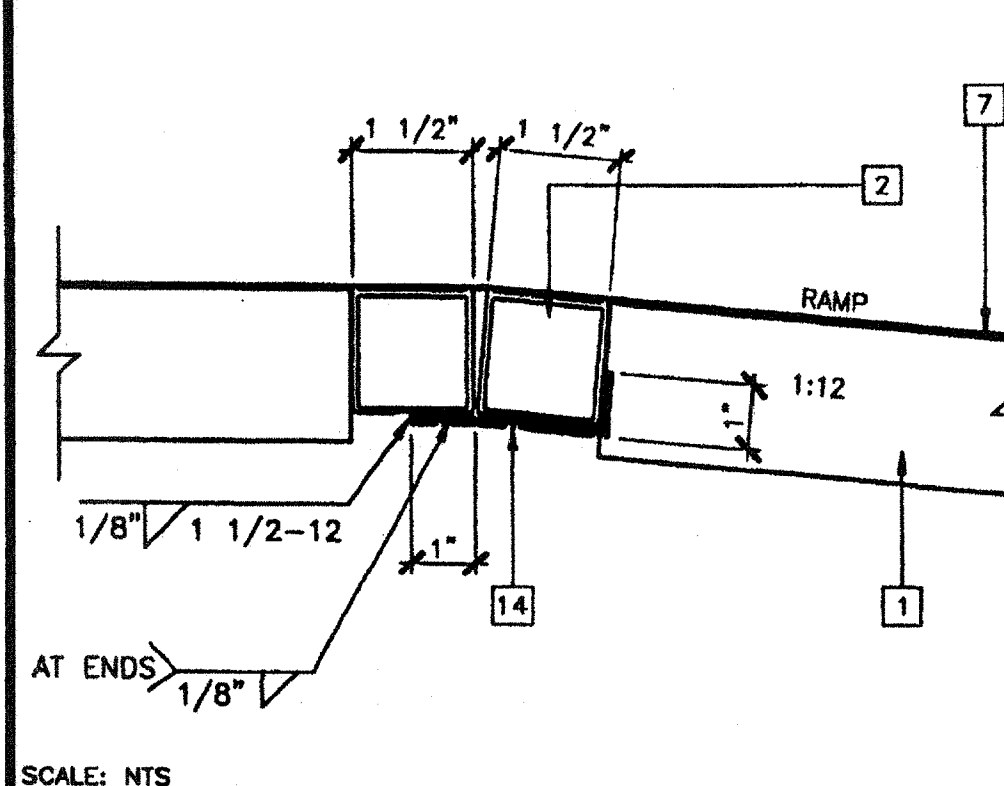


SCALE: NTS

4 RAMP AT LANDING

KEY NOTES

- 1 TS 2"x2"x14 GA
- 2 TS 1 1/2"x1 1/2"x14 GA (Fy = 39KSI), ROUNDED OR BEVELLED AT CORNERS
- 3 TS 1"x1"x16 GA WHITE CHAIR GUIN
- 4 2"x6" PRESSURE TREATED SILL PLATE
- 5 2"x4"x12 GA BASE PLATE WITH (2) 1/4"x1" LAGS
- 6 SKIRTING: PLYWOOD TO MATCH BUILDING SIDING. BLOCK ALL EDGES. ATTACH WITH 8d AT 6" OC EDGES AND 12" OC FIELD. AT EDGE CONNECTION TO TUBE STEEL USE #14x2" TEK SCREWS AT 6" OC
- 7 12 GA METAL DECK: NON-SLIP SURFACE. DESIGN COEFFICIENT OF FRICTION GREATER THAN 6%. MAINTAINABLE FOR 1 YEAR
- 8 EXISTING BUILDING
- 9 6"x10"x12 GA BASE PLATE AT RAMP 101
- 10 LOWER LANDING BY DISTRICT
- 11 RAMP BY MODTECH
- 12 FLUSH TRANSITION
- 13 6"x12"x10 GA PLATE WITH (2) 1/4"x3" LAGS TO STRUCTURAL FRAME OF BUILDING
- 14 3"x1"x3'-0"x10 GA BENT PLATE
- 15 2"x4"x 1/8" PLATE
- 16 TS 1 1/2"x1 1/2"x14 GA HANDRAIL - CONTINUOUS AND UNINTERRUPTED, ROUNDED OR BEVELLED AT CORNERS
- 17 TS 1"x1"x16 GA RAIL SUPPORT
- 18 LINE OF RAMP/LANDING ABOVE
- 19 RAMP EXTENSION FRAME
- 20 6"x10 GA CONTINUOUS PLATE WITH 1/4"x2" ILK SCREWS AT 9" OC INTO WOOD OR FOUNDATION BLOCKS OR #14x2" TEK SCREWS INTO STEEL AT 9" OC
- 21 NOTCH BOTTOM PLATE (MUD SILL) AS REQUIRED TO CLEAR RAMP TOE. MAX NOTCH 1 1/2"x4'-0" LONG.
- 22 NOTCH BOTTOM PLATE (MUD SILL) AS IN REQUIRED TO CLEAR RAMP TOE. MAX NOTCH 1 1/2"x4'-0" LONG.
- 23 LINE OF STAIR OPTION - 12,13/R1.02

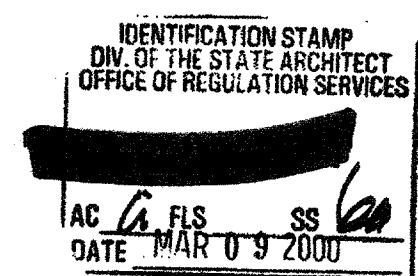

IDENTIFICATION STAMP
DIV. OF THE STATE ARCHITECT
OFFICE OF REGULATION SERVICES
DATE: MAR 09 2000

APP#3 117168

AC / FLS / SS / TN
Date: MAR 09 2000

NOTES

1. RAMP: RAMP SHALL NOT SLOPE MORE THAN 1" IN 12"
2. HANDRAILS: HANDRAILS AT BOTH SIDES OF RAMP AT 34" HEIGHT.
3. SURFACE: LANDING & RAMP TO HAVE NON-SLIP SURFACE AMCOR GRIP II AS MANUFACTURED BY AMERICAN CHEMICAL COMPANY (OR EQUAL)
4. GROUNDING: PROVIDE GROUNDING OF RAMP TO BUILDING FRAME WITH #8 COPPER TO BOTH GROUND LUGS.
5. ARCHITECT SITE/RAMP/LANDING PLANNING: DUE TO VARYING SITE CONDITIONS THE MAXIMUM HEIGHT OF FINISH FLOOR FROM GRADE IS 26". THEREFORE IT IS POSSIBLE THAT THE ACCESS RAMP ATTACHED TO THE BUILDING COULD BE 26'-0" AT A SLOPE OF 1:12. ARCHITECT MUST TAKE INTO ACCOUNT THAT THE RAMP SUPPLIED BY MODTECH INC. IS 11'-0" AT A SLOPE OF 1:12. THEREFORE THE ARCHITECT WILL HAVE TO DESIGN AND PROVIDE DETAILS OF RAMP EXTENSIONS AND BOTTOM LANDING DEPENDING ON PARTICULAR SITE CONDITIONS. IN NO WAY IS MODTECH INC RESPONSIBLE FOR ANY RAMP EXTENSION EXCEEDING THE ORIGINAL PLAN AS SHOWN ON THIS SHEET
6. ALL 1 1/4" AND 1 1/2" TUBE STEEL TO BE (1) ASTM A500 GRADE A STEEL (Fy = 39 KSI)

REVISIONS	Electrical Engineer's Seal	Mechanical Engineer's Seal	Structural Engineer's Seal	Architect's Seal

PC-04
101419
DATE: OCT 23 1999

MODTECH INC.
2830 BARRETT AVENUE
PERRIS, CALIF. 92572
PH (909) 943-4014
FAX (909) 940-0427

PROJECT NUMBER: _____
© MODTECH, INC. 1999

DRAWN BY: _____
CHECKED BY: SS
DATE: 10/22/99
MODTECH Index No. _____

R1.00

RAMP/LANDING 11' RAMP

JOB # 2986 # 3022 # 2377 # 2506
3183

RELOCATABLE BUILDING(S)

FROM STOCKPILE TO SITE SPECIFIC
RELOCATION PACKAGE

FOR
CLASS LEASING BAKERSFIELD CITY SD
STOCKPILE # 42 MT. VERNON
121- 24 x 40 CLASSROOMS CL2870

- ~~(9) SERIAL # 20829-20846~~
- ~~(23) SERIAL # 37318-37363~~
- (35) SERIAL # 38012-38031 / (38072-38073)
- ~~(12) SERIAL # 39704-39727~~
- ~~(25) SERIAL # 38523-38572~~
- ~~(11) SERIAL # 25607-25620~~
- ~~(1) SERIAL # 41569-41570~~
- ~~(4) SERIAL # 41008-41015~~
W/ SINK CABINET
- ~~(1) SERIAL # 41016-41017~~

121 RELOCATABLE BLDG'S TOTAL

PC-266

24' x 40'

~~36' x 40'~~

~~48' x 40'~~


REVISED

BUILDING DATA			SHEET INDEX	
BUILDING SIZE	24' X 40'	36' X 40'	48' X 40'	ARCHITECTURAL
OCCUPANCY	E - 2	E - 1	E - 1	A0 COVER SHEET
TYPE OF CONSTRUCTION	V - N	V - N	V - N	A1.0 FLOOR PLAN (24'X40')
WIND LOAD	70 MPH. EXP. "C"	70 MPH. EXP. "C"	70 MPH. EXP. "C"	A2.0 FLOOR PLAN (36'X40')
FLOOR LIVE LOAD	50/50 + 20 PSF	50/50 + 20 PSF	50/50 + 20 PSF	A3.0 FLOOR PLAN (48'X40')
ROOF LIVE LOAD	20 PSF	20 PSF	20 PSF	A4.0 ROOF PLAN (MONO PITCH) (24'X40')
BUILDING AREA	960 SF	1440	1920	A5.0 ROOF PLAN (MONO PITCH) (36'X40')
STRUCTURAL DESIGN	RIGID FRAME	RIGID FRAME	RIGID FRAME	A6.0 ROOF PLAN (MONO PITCH) (48'X40')
APPLICABLE CODES				A7.0 EXTERIOR ELEVATIONS (MONO PITCH) (24'X40')
TITLE 24. CCR. PART 2. 1995 CBC (94 UBC W/95 CA AMENDMENTS)				A7.1 EXTERIOR ELEVATIONS (MONO PITCH) (36'X40')
1994 UBC & 1995 CA AMENDMENTS (95 CBC - PART 2, TITLE 24, CCR)				A8.0 INTERIOR ELEVATIONS (MONO PITCH) (24'X40')
1993 NEC & 1995 CA AMENDMENTS (95 CEC - PART 3, TITLE 24, CCR)				A8.1 INTERIOR ELEVATIONS (MONO PITCH) (36'X40')
1994 UBC & 1995 CA AMENDMENTS (95 CMC - PART 4, TITLE 24, CCR)				A9.0 DOOR, WINDOW, FINISH, HARDWARE SCHEDULES
1994 UBC & 1995 CA AMENDMENTS (95 CPC - PART 5 TITLE 24, CCR)				A9.1 ARCHITECTURAL DETAILS (WOOD STUDS)
1994 UNIFORM FIRE CODE W/ STATE AMENDMENTS (CALIFORNIA FIRE CODE - PART 9, TITLE 24, CCR)				A9.2 ARCHITECTURAL DETAILS (WOOD STUDS)
1994 BUILDING STANDARDS CODE (95 STATE REFERENCED STANDARDS CODE - PART 12, TITLE 24, CCR)				A10.0 REFLECTED CEILING PLAN (24'X40')
TITLE 19, CCR, PUBLIC SAFETY, STATE FIRE MARSHALL REGULATIONS.				A10.1 REFLECTED CEILING DETAILS
LEGEND			STRUCTURAL	
SYMBOL	DESCRIPTION		F0.0 FOUNDATION PLAN (24' X 40) 50 + 20 PSF LL (WOOD)	
⊕	DETAIL ON SAME SHEET AS SYMBOL		F1.0 RELOCATION FOUNDATION PLAN & DETAILS - CL PC 04-113776	
①	DETAIL NUMBER (1) ON SHEET NUMBER (2)		F2.1 RELOCATION FOUNDATION PLAN & DETAILS - CL PC 04-113776	
Ⓚ	KEY NOTE (1) ON SAME SHEET AS SYMBOL		F3.0 FOUNDATION DETAILS (WOOD)	
Ⓚ	KEY NOTE NUMBER (4) ON SHEET NUMBER (5)		F4.0 FOUNDATION DETAILS (WOOD)	
Ⓚ	WALL PANEL TYPE "A" ON SHEET (1)		F5.0 FOUNDATION DETAILS (WOOD)	
Ⓚ	SECTION "A" ON SHEET (2)		F6.0 FOUNDATION DETAILS (WOOD)	
Ⓚ	REVISION / CHANGE IN DRAWING. NO. (1) IS FIRST REVISION		F7.0 FOUNDATION DETAILS (WOOD)	
CLOUD	HIGHLIGHTS CHANGED AREA		S41.0 FLOOR FRAMING PLAN 50+20 PSF LL	
Ⓚ	DOOR REFERENCE		S42.0 ROOF FRAMING PLAN (MONO PITCH)	
Ⓚ	WINDOW REFERENCE		S43.0 STRUCTURAL ELEVATIONS & DETAILS (MONO PITCH)	
EL	ELECTRICAL ITEM(S) SEE ELECT. DRAWINGS		S44.0 STRUCTURAL ELEVATIONS & DETAILS (MONO PITCH)	
MV	HEATING/VENTILATING & AIR CONDITIONING ITEM(S) SEE MECHANICAL DRAWINGS		S45.0 STRUCTURAL DETAILS	
PLG	PLUMBING ITEM(S) SEE MECHANICAL DRAWINGS		S5.0 WALL FRAMING (WOOD)	
STR	STRUCTURAL ITEM(S) SEE STRUCTURAL DRAWINGS		S5.1 WALL FRAMING DETAILS (WOOD)	
			S5.2 WALL FRAMING DETAILS (WOOD)	
			S6.0 MECHANICAL	
			M1.0 HVAC PLAN (24'X40')	
			ELECTRICAL	
			E1.0 ELECTRICAL PLAN (24'X40')	
			RAMP	
			R1.0 RAMP / LANDING PLAN	
			R2.0 RAMP / STAIRS DETAILS	
<p>WITH THE SIGNING OF THESE DRAWINGS, WE ACKNOWLEDGE THAT WE HAVE REVIEWED THESE PLANS AND SPECIFICATIONS AND HAVE FOUND THEM TO BE IN GENERAL COMPLIANCE WITH THE BID DRAWINGS, SPECIFICATIONS AND ASSOCIATED ADDENDA. WHEN THESE PLANS AND SPECIFICATIONS HAVE BEEN APPROVED BY THE DIVISION OF THE STATE ARCHITECT, THEY SHALL PRESIDE OVER CONFLICTING AREAS IN THE BID DRAWINGS AND SPECIFICATIONS, AND ANY ADDENDA THERETO.</p> <p>CONFIDENTIAL - This document and the information contained herein are the property of MODTECH, INC., unauthorized copying, disclosure or other unauthorized user are prohibited.</p>			<p>IDENTIFICATION STAMP DIV. OF THE STATE ARCHITECT OFFICE OF REGULATION SERVICES</p> <p>APPROVED FOR THE STATE ARCHITECT DATE: JAN 07 1999 FLS: P. ALCAIRE ACP: J. Schirck</p> <p>8/19/99 REVISED ACP: G. LORE FLS: P. ALCAIRE SSS J.P.</p> <p>IDENTIFICATION STAMP DIV. OF THE STATE ARCHITECT</p> <p>APP#3 117168 AC: FLS/SS/IN Date: AUG 04 2018 STKP-42 11/23/98</p>	

REVISIONS	Electrical Engineer's Seal	Mechanical Engineer's Seal	Structural Engineer's Seal	Architect's Seal	Division of the State Architect	MODTECH INC.	PROJECT NUMBER:	MODTECH, INC. 1997	drawn by: 4012-088
△					IDENTIFICATION STAMP DIV. OF THE STATE ARCHITECT OFFICE OF REGULATION SERVICES	2830 BARRETT AVENUE PERRIS, CALIF. 92572	JOB # 2986	2- 24 x 40 CLASSROOM A# 04-100929	date: 05 JAN 99
△					PC-266	PH (909) 943-4014	CLASS LEASING	SERIAL # STOCKPILE 42	date: 2506
△					DATE: 105.10.1998	FAX (909) 940-0427	BRENTWOOD UNION SCHOOL DISTRICT	MODTECH Index No.	2486
△					SS: G. HAM				


PROJECT NUMBER:		MODTECH, INC. 1997	drawn by: 4012-088
JOB # 2986	2- 24 x 40 CLASSROOM A# 04-100929	checked by: 05 JAN 99	date: 2506
CLASS LEASING	SERIAL # STOCKPILE 42	date: 2486	2486
BRENTWOOD UNION SCHOOL DISTRICT	MODTECH Index No.		
COVER SHEET		A0.0	

PROJECT NO. JOB # 2986 24X40 CLASS LEASING (Brentwood) STKP-42
PC-266 3022 3183

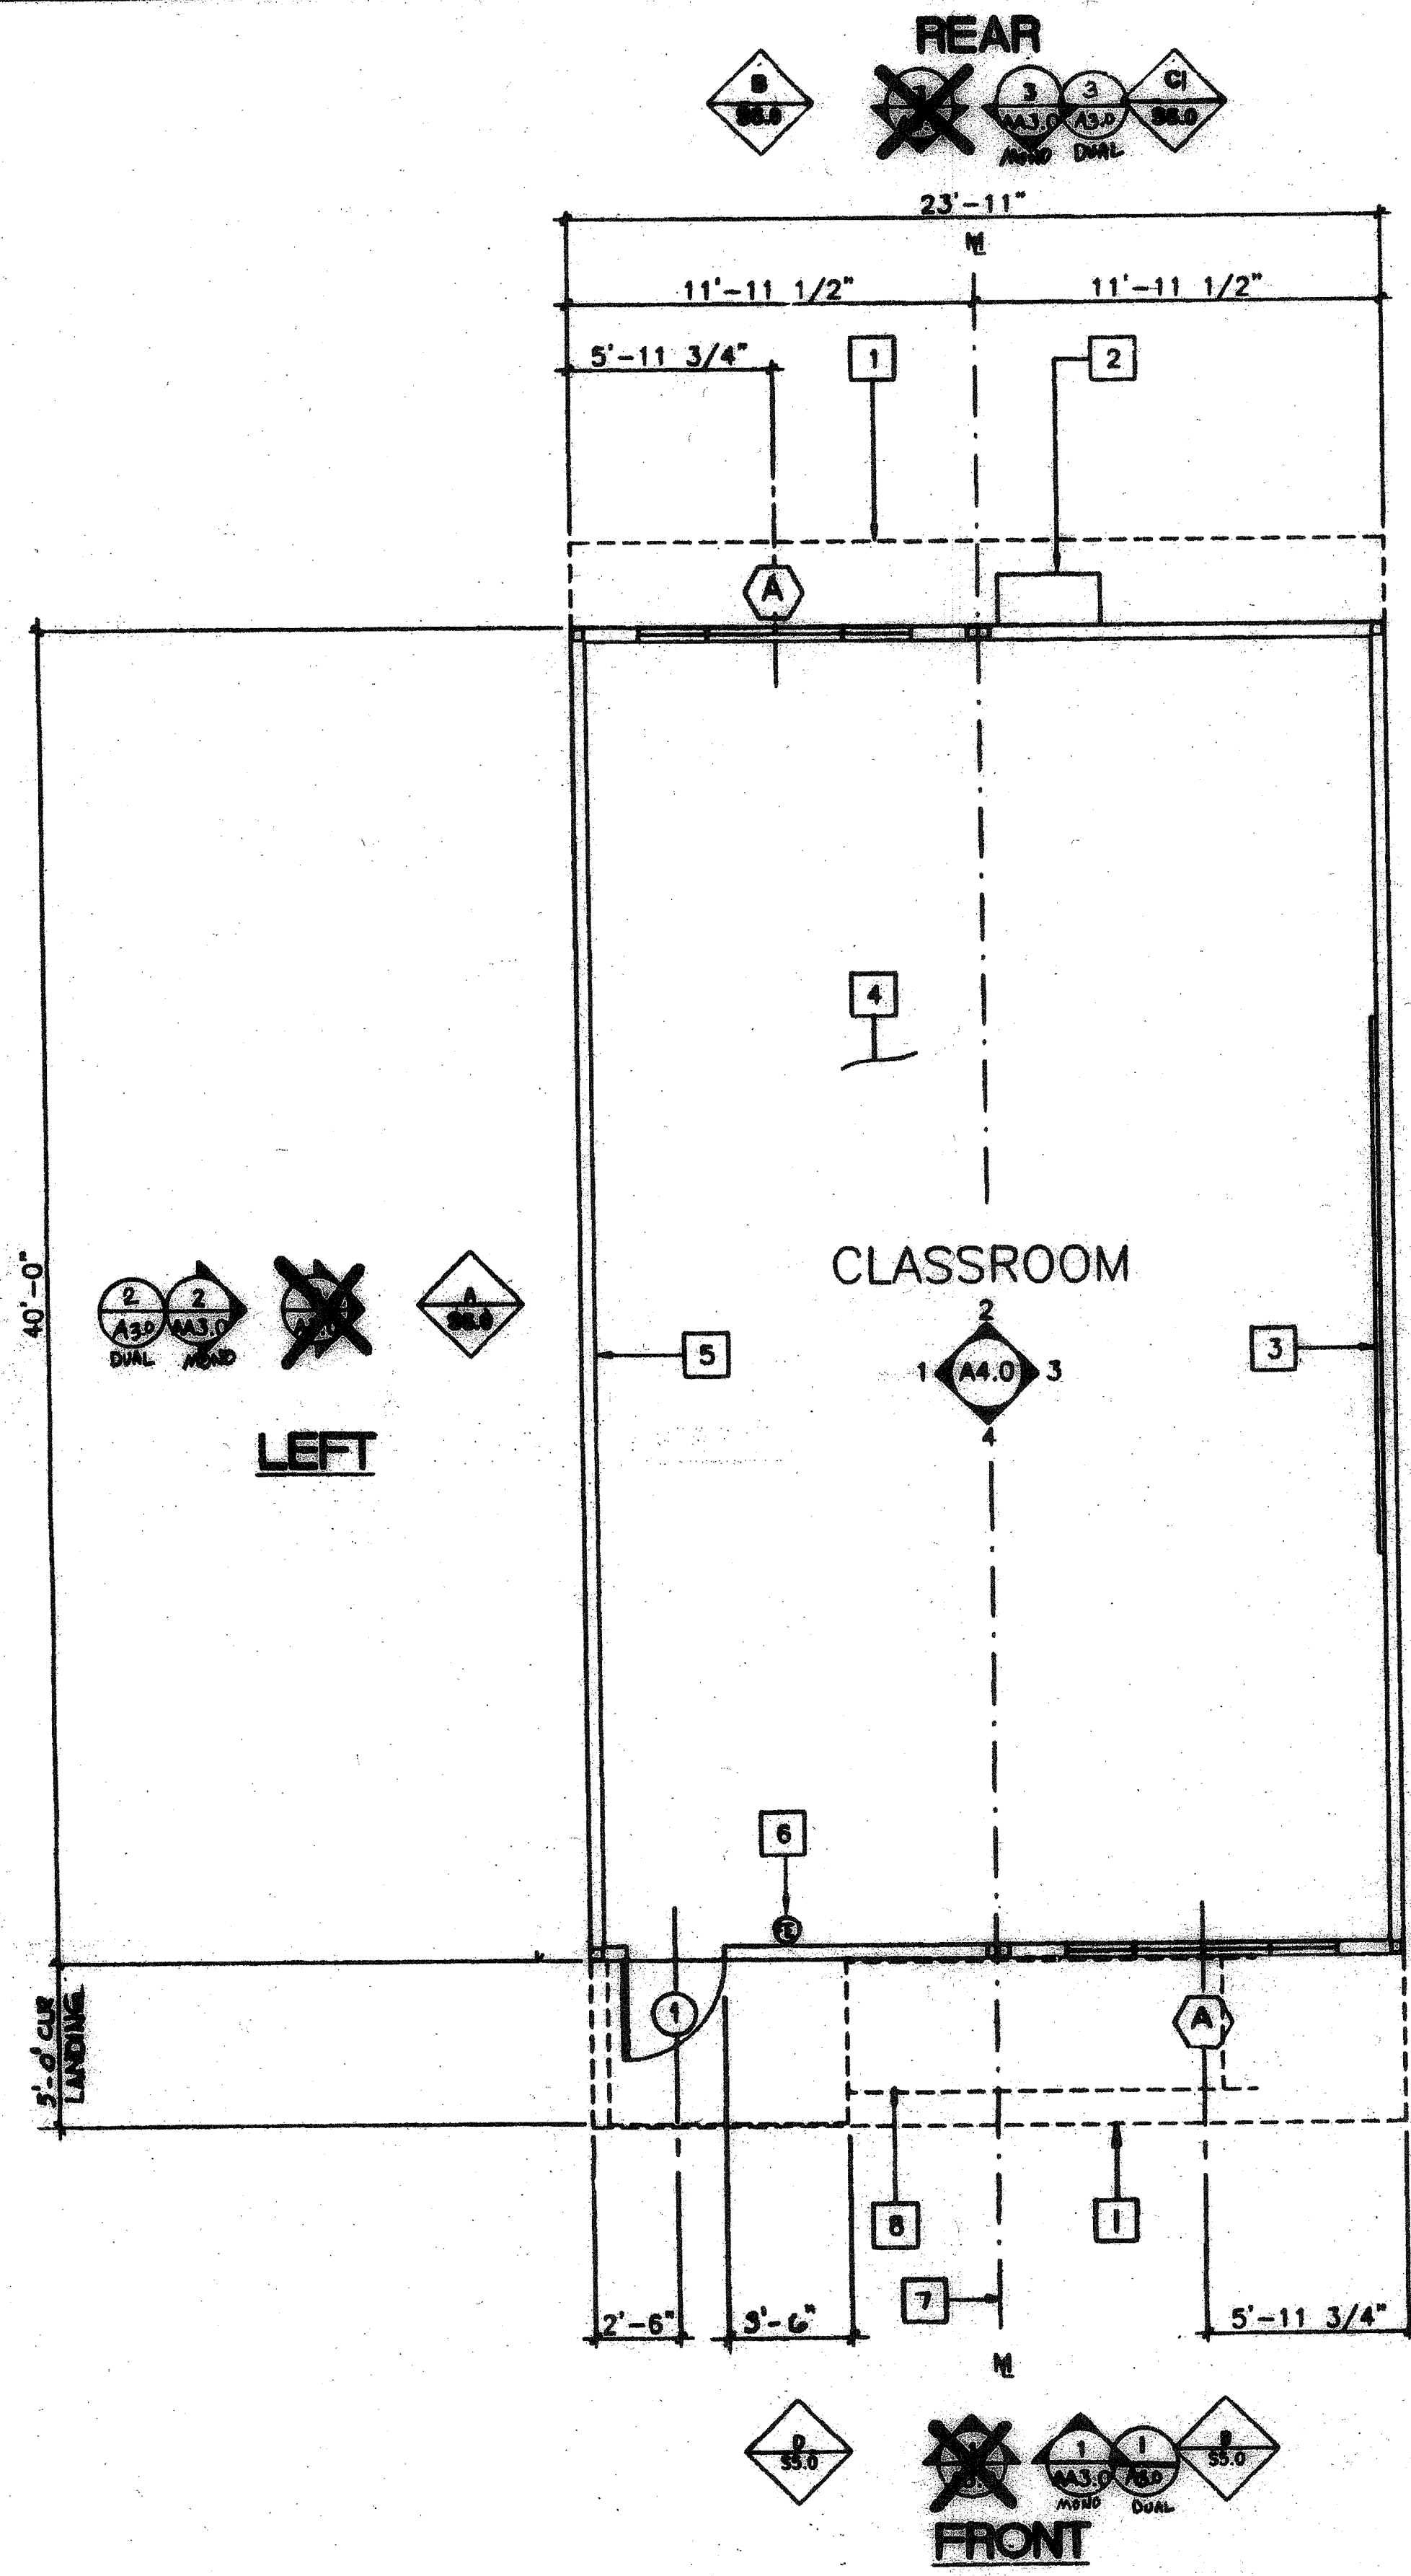

- ### KEY NOTES
- 1 ROOF OVERHANG
 - 2 HVAC UNIT - SEE MECH. SHEET
 - 3 2- 8'X4' MARKER BOARDS (SEE SPEC'S)
 - 4 FINISH FLOORING: (SEE FINISH SCHED.) A5.0
 - 5 TYPICAL INTERIOR FINISH (SEE FINISH SCHEDULE) A5.0
 - 6 FIRE EXTINGUISHER - 5 LBS. DRY CHEMICAL WITH 2A-10BC U.L. RATING ON WALL MTD. BRACKET. HANDLE AT 48" A.F.F.
 - 7 MODLINE (M. TYPICAL)
 - 8 LINE OF RAMP/LANDING SEE R1.0 & R2.0 RAMP EXTENSIONS MAYBE ADDED TO WORK WITH FINISH GRADES.

- ### NOTES
1. METAL TAG ON ALL MODULES. MECHANICALLY ATTACHED TO REAR EXTERIOR OF BUILDING SHOW D.S.A. APPLICATION NUMBER, MANUFACTURER'S NAME AND SERIAL NUMBER, ROOF & FLOOR DESIGN LIVE LOAD, AND DESIGN WIND LOAD.
 2. INSULATION MATERIALS INSTALLED WITHIN FLOOR-CEILING ASSEMBLIES, ROOF-CEILING ASSEMBLIES, WALLS, CRAWL SPACES, OR ATTICS SHALL HAVE A FLAMESPREAD RATING NOT TO EXCEED 25 AND A SMOKE DENSITY NOT TO EXCEED 450. EXCEPTIONS: 1. FOAM PLASTIC INSULATION SHALL COMPLY WITH SEC. 2602.2. WHEN MATERIALS ARE INSTALLED IN CONCEALED SPACES OF TYPES I, II, IV, AND V CONSTRUCTION, THE FLAME SPREAD AND SMOKE-DEVELOPED LIMITATIONS DO NOT APPLY TO FACINGS IF THE FACING IS INSTALLED IN SUBSTANTIAL CONTACT WITH THE UNEXPOSED SURFACE OF THE CEILING, FLOOR OR WALL FINISH. (SEC. 707.3 CBC.)
 3. FRONT WALL
A: AS SHOWN
B: OPPOSITE

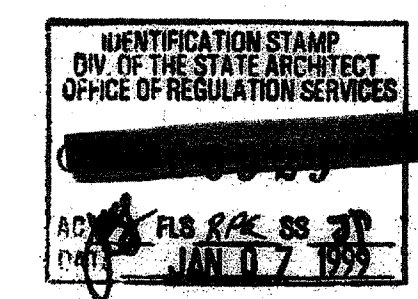

IDENTIFICATION STAMP
DIV. OF THE STATE ARCHITECT

APP#3 117168
AC / FLS / SS / TN
Date: AUG 04 2018

STRIP 42
11/24/98
3027 3183
2506
2377

FLOOR PLAN (24' X 40')

A: AS SHOWN B: OPPOSITE SCALE 1/4"=1'-0"

REVISIONS	Electrical Engineer's Seal	Mechanical Engineer's Seal	Structural Engineer's Seal	Architect's Seal	Division of the State Architect	MODTECH INC.	PROJECT NUMBER:	DATE	PROJECT NO.
							2986	11/24/98	3027 3183


Electrical Engineer's Seal

Mechanical Engineer's Seal

Structural Engineer's Seal

Architect's Seal
George C. Edinger
LICENSURE ARCHITECT
STATE OF CALIFORNIA

Division of the State Architect
OFFICE OF REGULATION SERVICES
DATE: JAN 25 1999

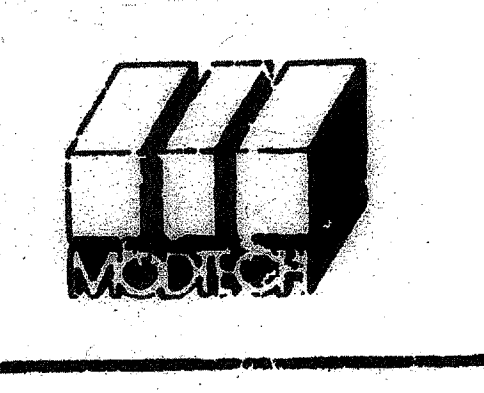

MODTECH INC.
2830 BARRETT AVENUE
PERRIS, CALIF. 92572
PH (909) 943-4014
FAX (909) 940-0427

PROJECT NUMBER: 2986

© MODTECH, INC. 1997


drawn by: 4012-088
checked by: 05 JAN 99
date: 11/24/98
project no: 2506
2377

FLOOR PLAN

A1.0

PROJECT NO. 2377

FILE # P256A20.DWG

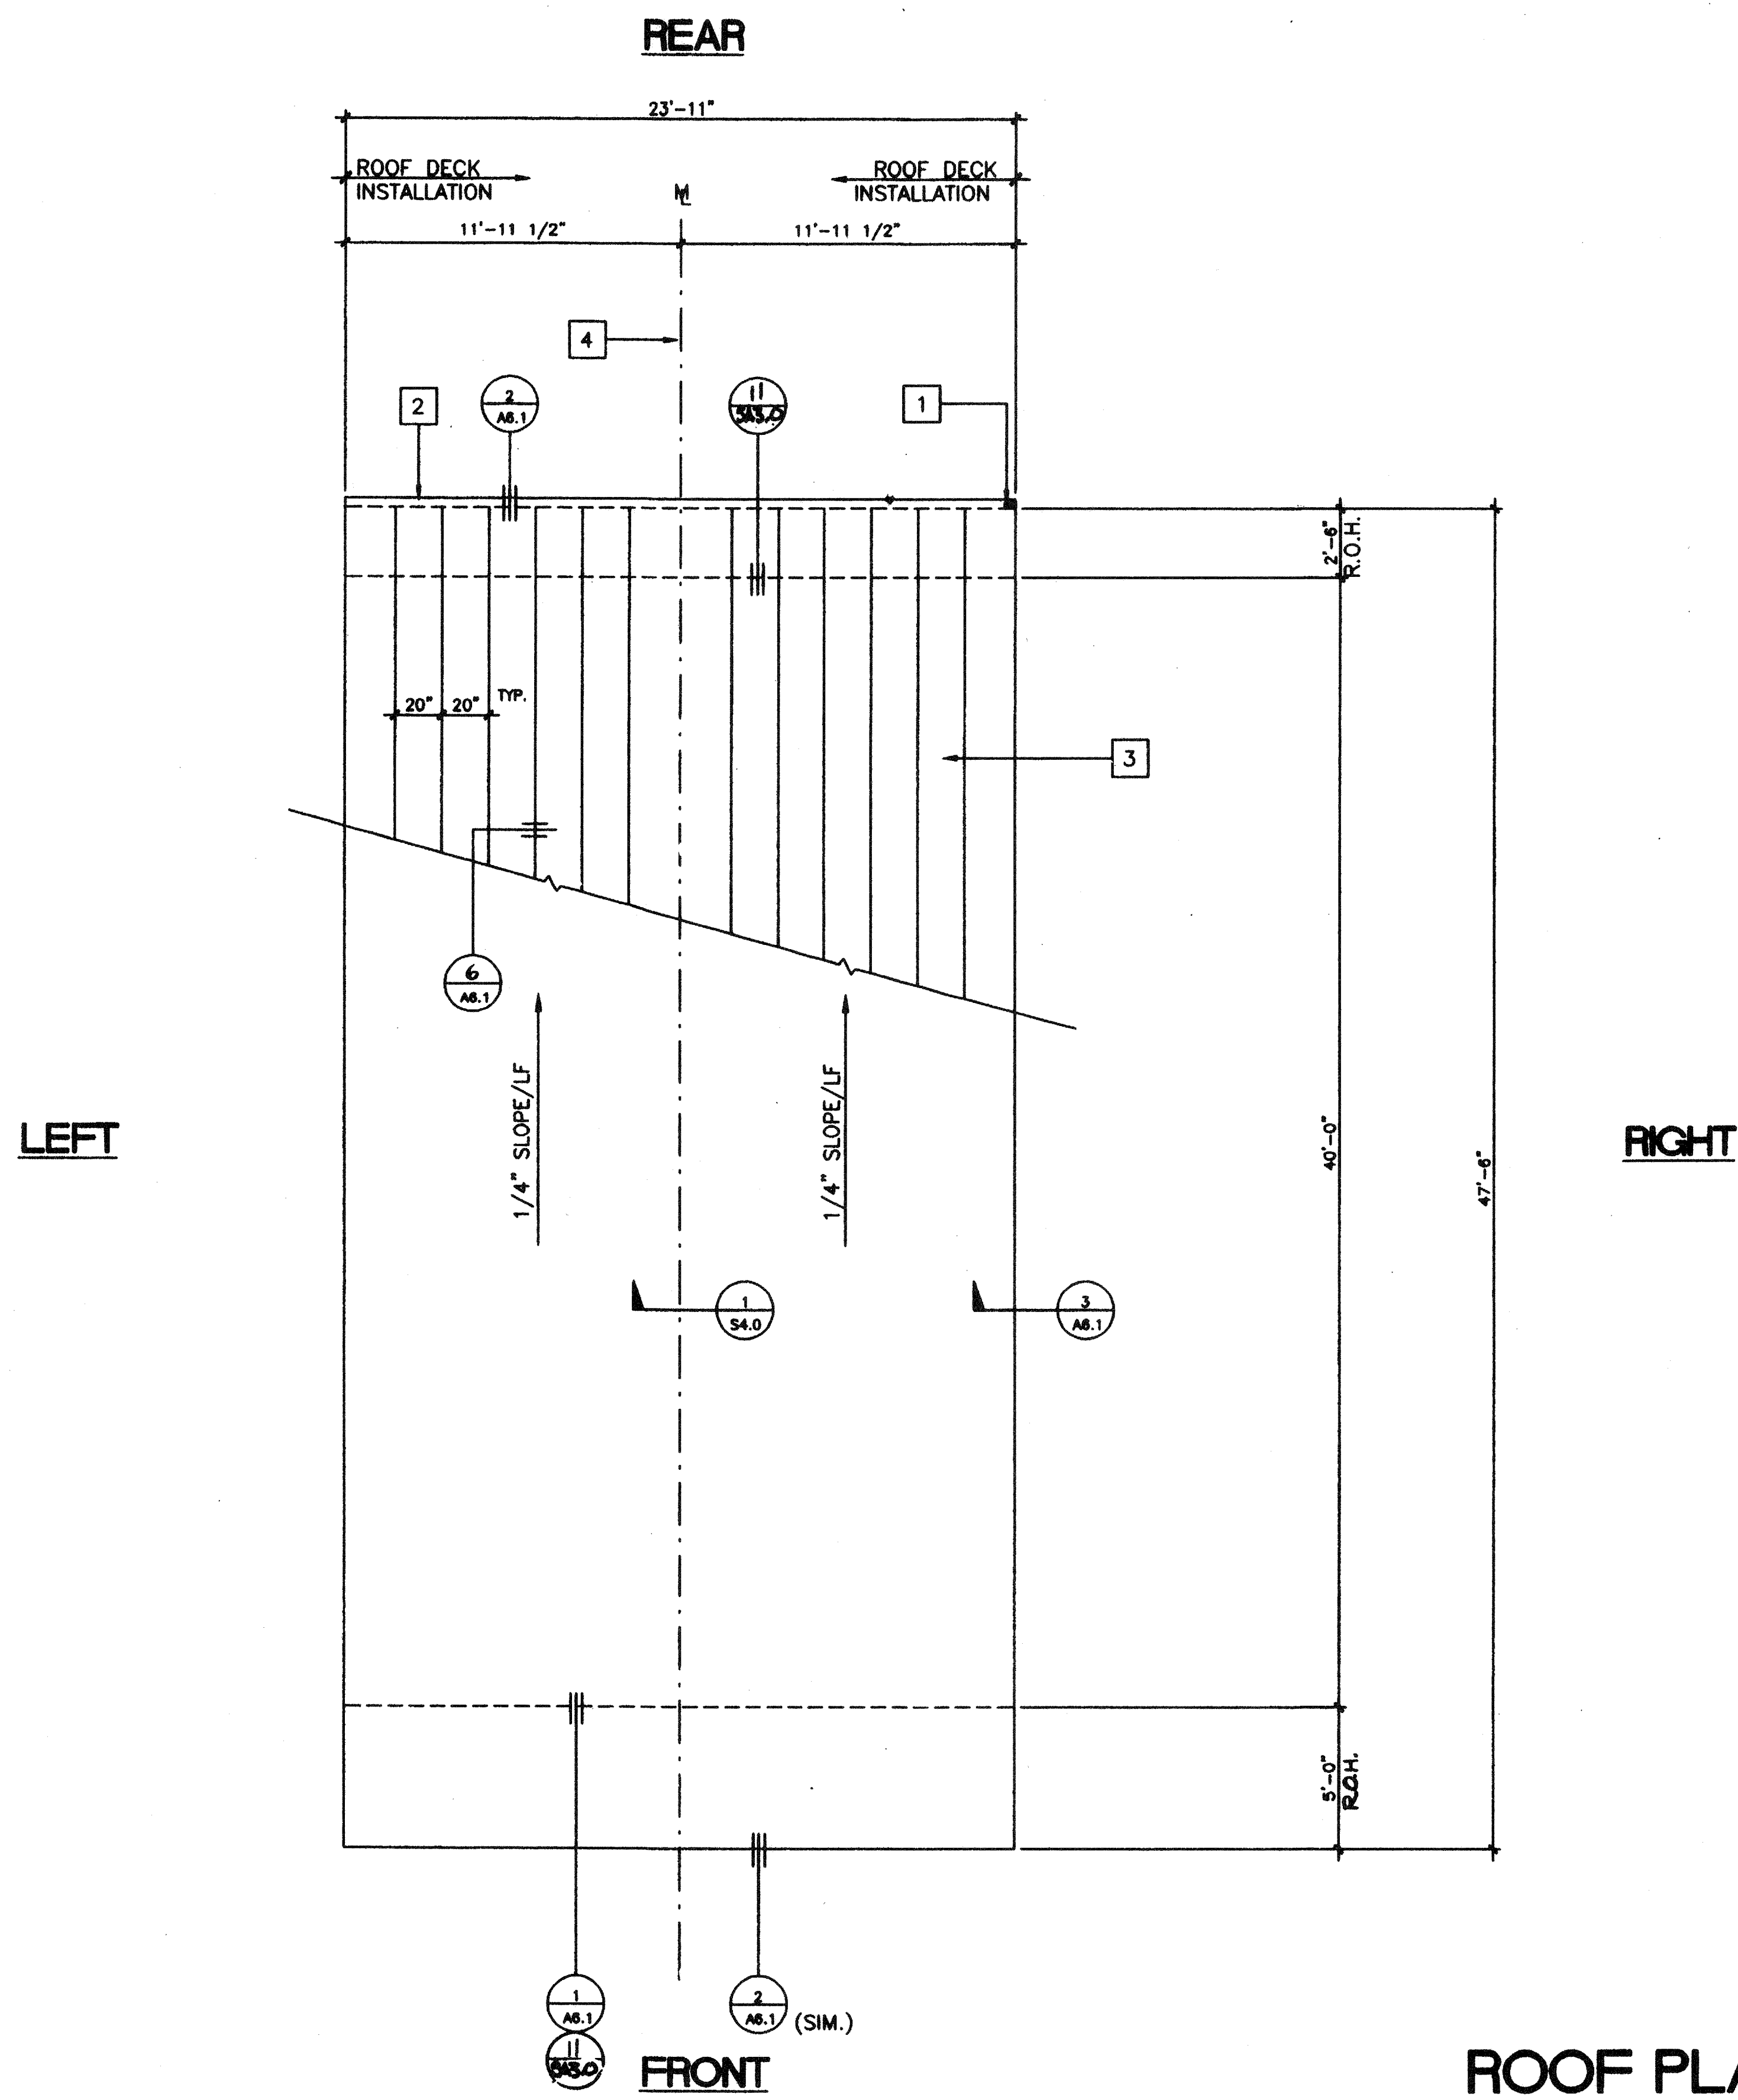

- ### KEY NOTES
- 1 DOWNSPOUT TYPICAL FOR (1) SEE 8/A6.1
 - 2 CONTINUOUS GUTTER
 - 3 26GA. MIN. INTERLOCKING ROOF PANELS OVER 3/4" CDX PLYWOOD OVER AQUA BAR 15 (MH1) ROOFING UNDERLAYMENT RADCO LISTING #1109
 - 4 MODLINE
 - 5 NOT USED

NOTES

1. BUILDING HOUSING GROUP E OCCUPANCIES SHALL HAVE ROOF COVERINGS AS SPECIFIED IN TABLE 15A. C.B.C. CLASS A

IDENTIFICATION STAMP
 DIV. OF THE STATE ARCHITECT
 OFFICE OF REGULATION SERVICES
 AC FLS RPL SS TN
 DATE JAN 07 1999

IDENTIFICATION STAMP
 DIV. OF THE STATE ARCHITECT
 APP#3 117168
 AC FLS RPL SS TN
 Date JAN 07 1999

ROOF PLAN (MONO SLOPE)

(24' X 40')

SCALE 1/4"=1'-0"

REVISED

STKP-42M 11/24/98

REVISIONS	Electrical Engineer's Seal	Mechanical Engineer's Seal	Structural Engineer's Seal	Architects Seal	Division of the State Architect	PROJECT NUMBER:	2986	© MODTECH, INC. 1997	drawn by:	4012-088	checked by:	05 JAN 99	date:	05 JAN 99	Modtech project no:	AA2.0
1																
2																
3																
4																
5																

Electrical Engineer's Seal

Mechanical Engineer's Seal

Structural Engineer's Seal

Architects Seal
 LICENSED ARCHITECT
 GEORGE C. EDWARDS
 STATE OF CALIFORNIA
 9-30-98

Division of the State Architect
 IDENTIFICATION STAMP
 DIV. OF THE STATE ARCHITECT
 OFFICE OF REGULATION SERVICES
 PC 266
 AC FLS RPL SS TN
 DATE JUN 23 1997

MODTECH INC.
 2830 BARRETT AVENUE
 PERRIS, CALIF. 92572
 PH (909) 943-4014
 FAX (909) 940-0427

PROJECT NUMBER: 2986
 © MODTECH, INC. 1997



drawn by: 4012-088
 checked by: 05 JAN 99
 date: 05 JAN 99
 Modtech project no: AA2.0

PROJECT NO. 2986

ROOF PLAN



PROJECT NO. 2986

FILE # P268A30

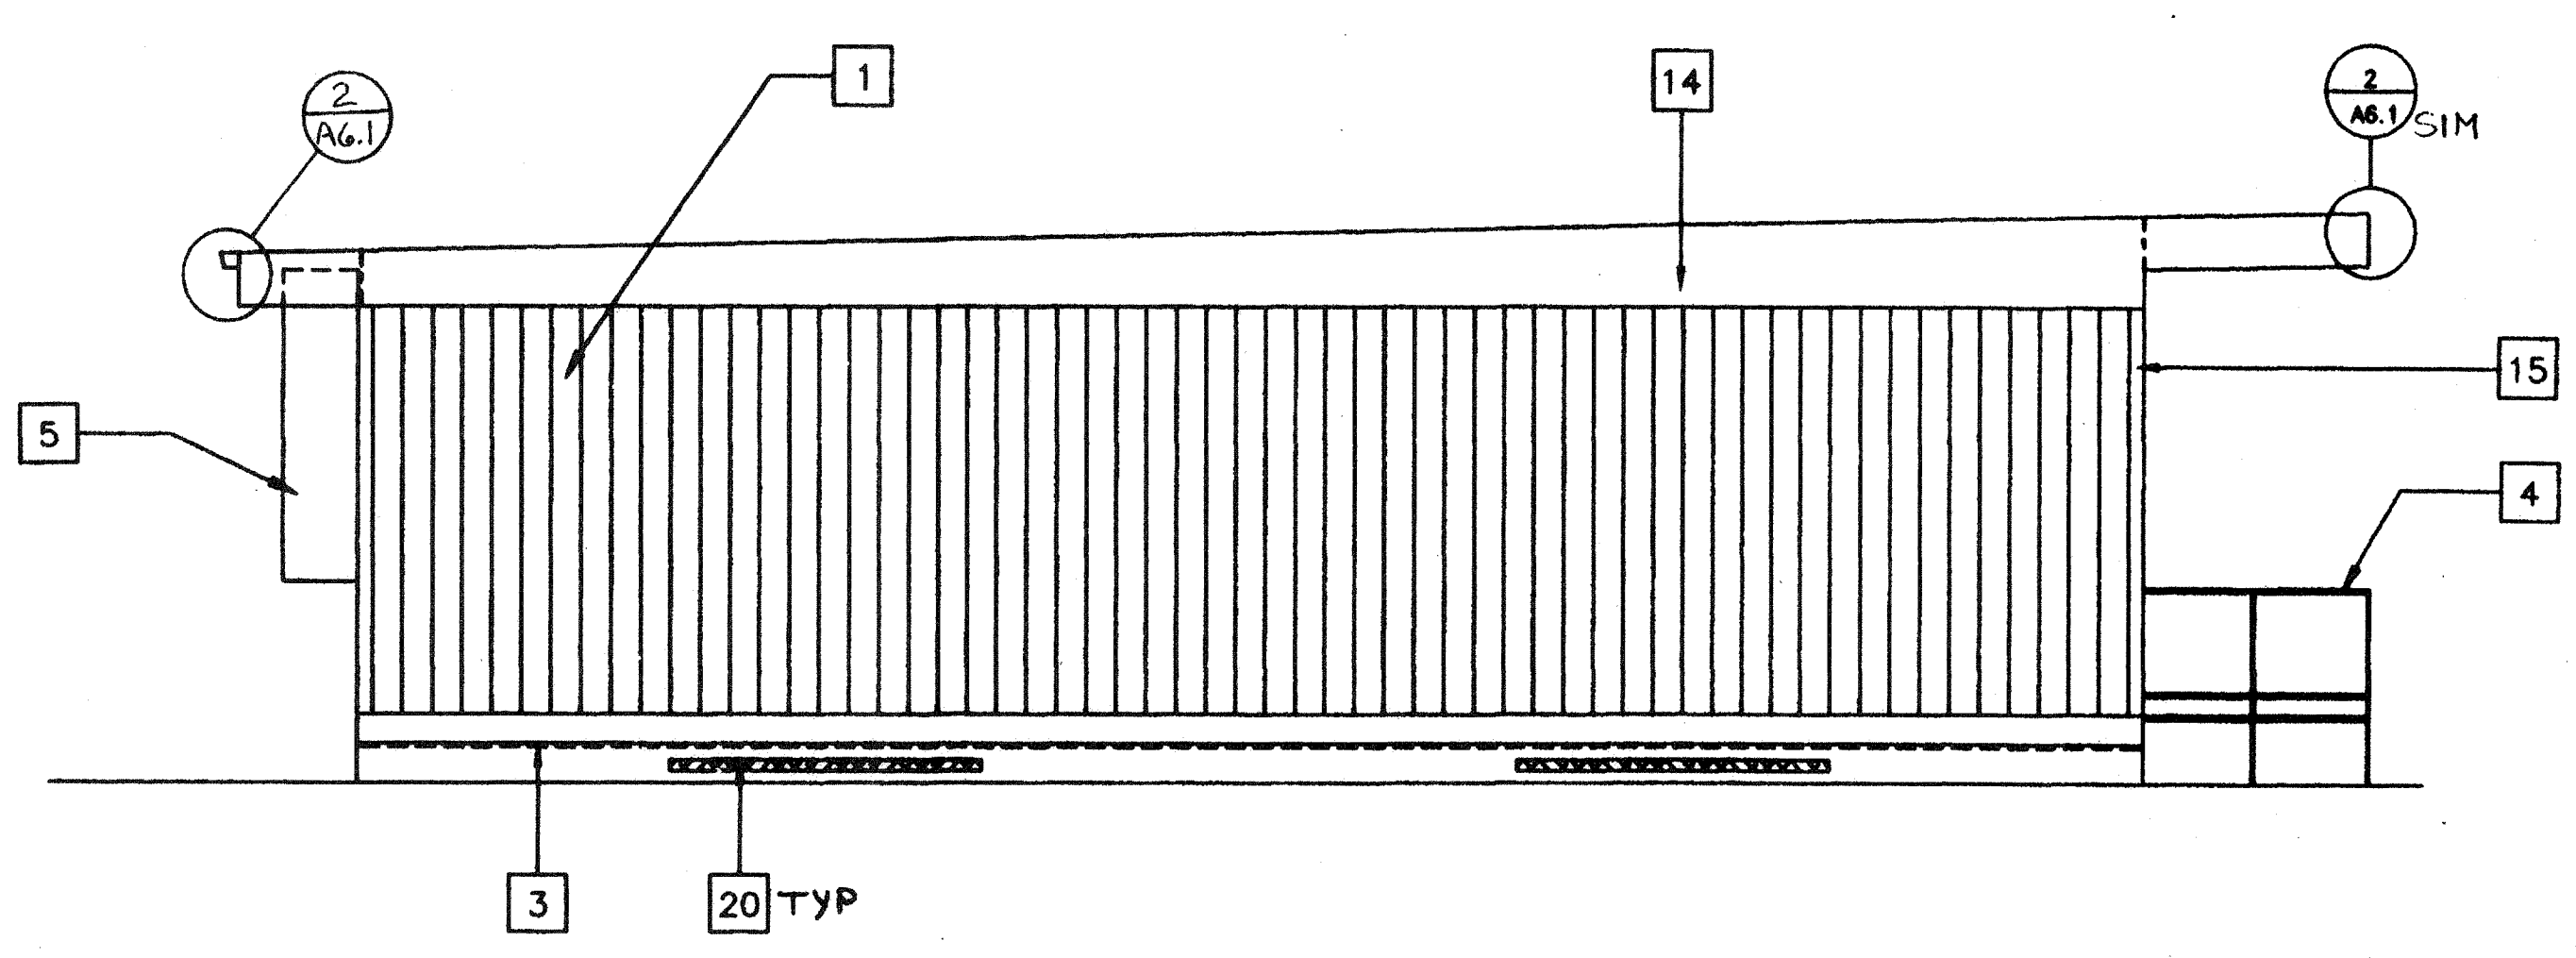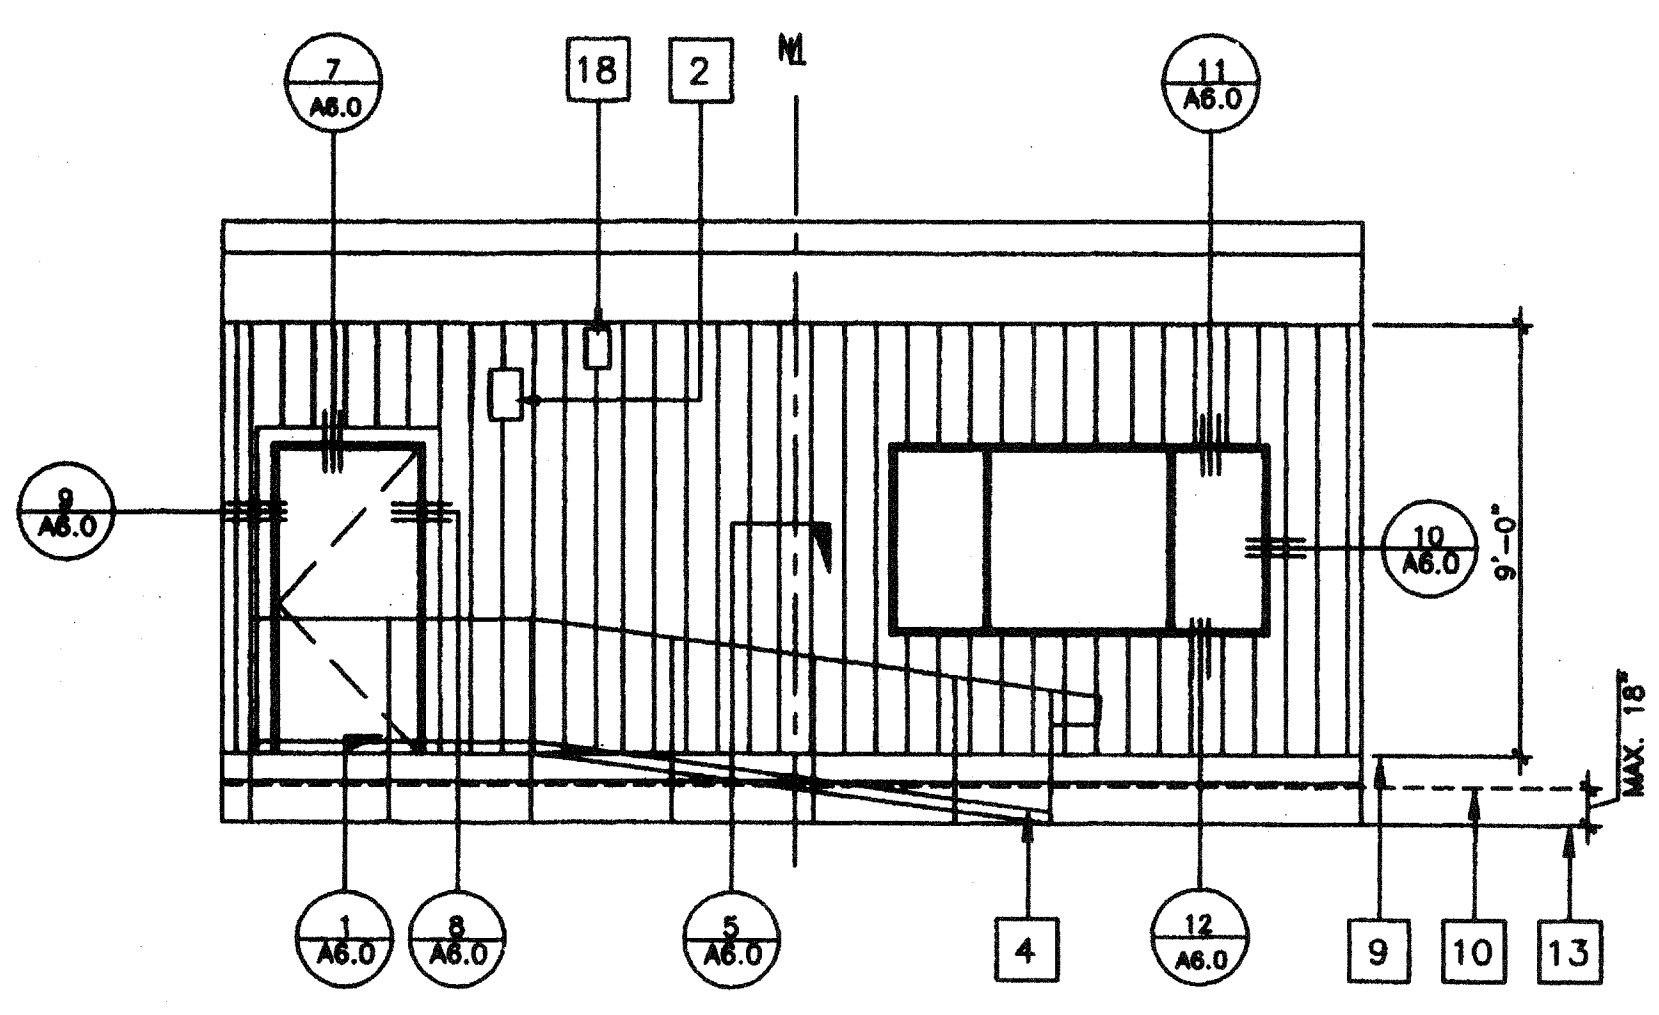

1 FRONT ELEVATION
SCALE 1/4"=1'-0"

2 LEFT SIDE ELEVATION
SCALE 1/4"=1'-0"

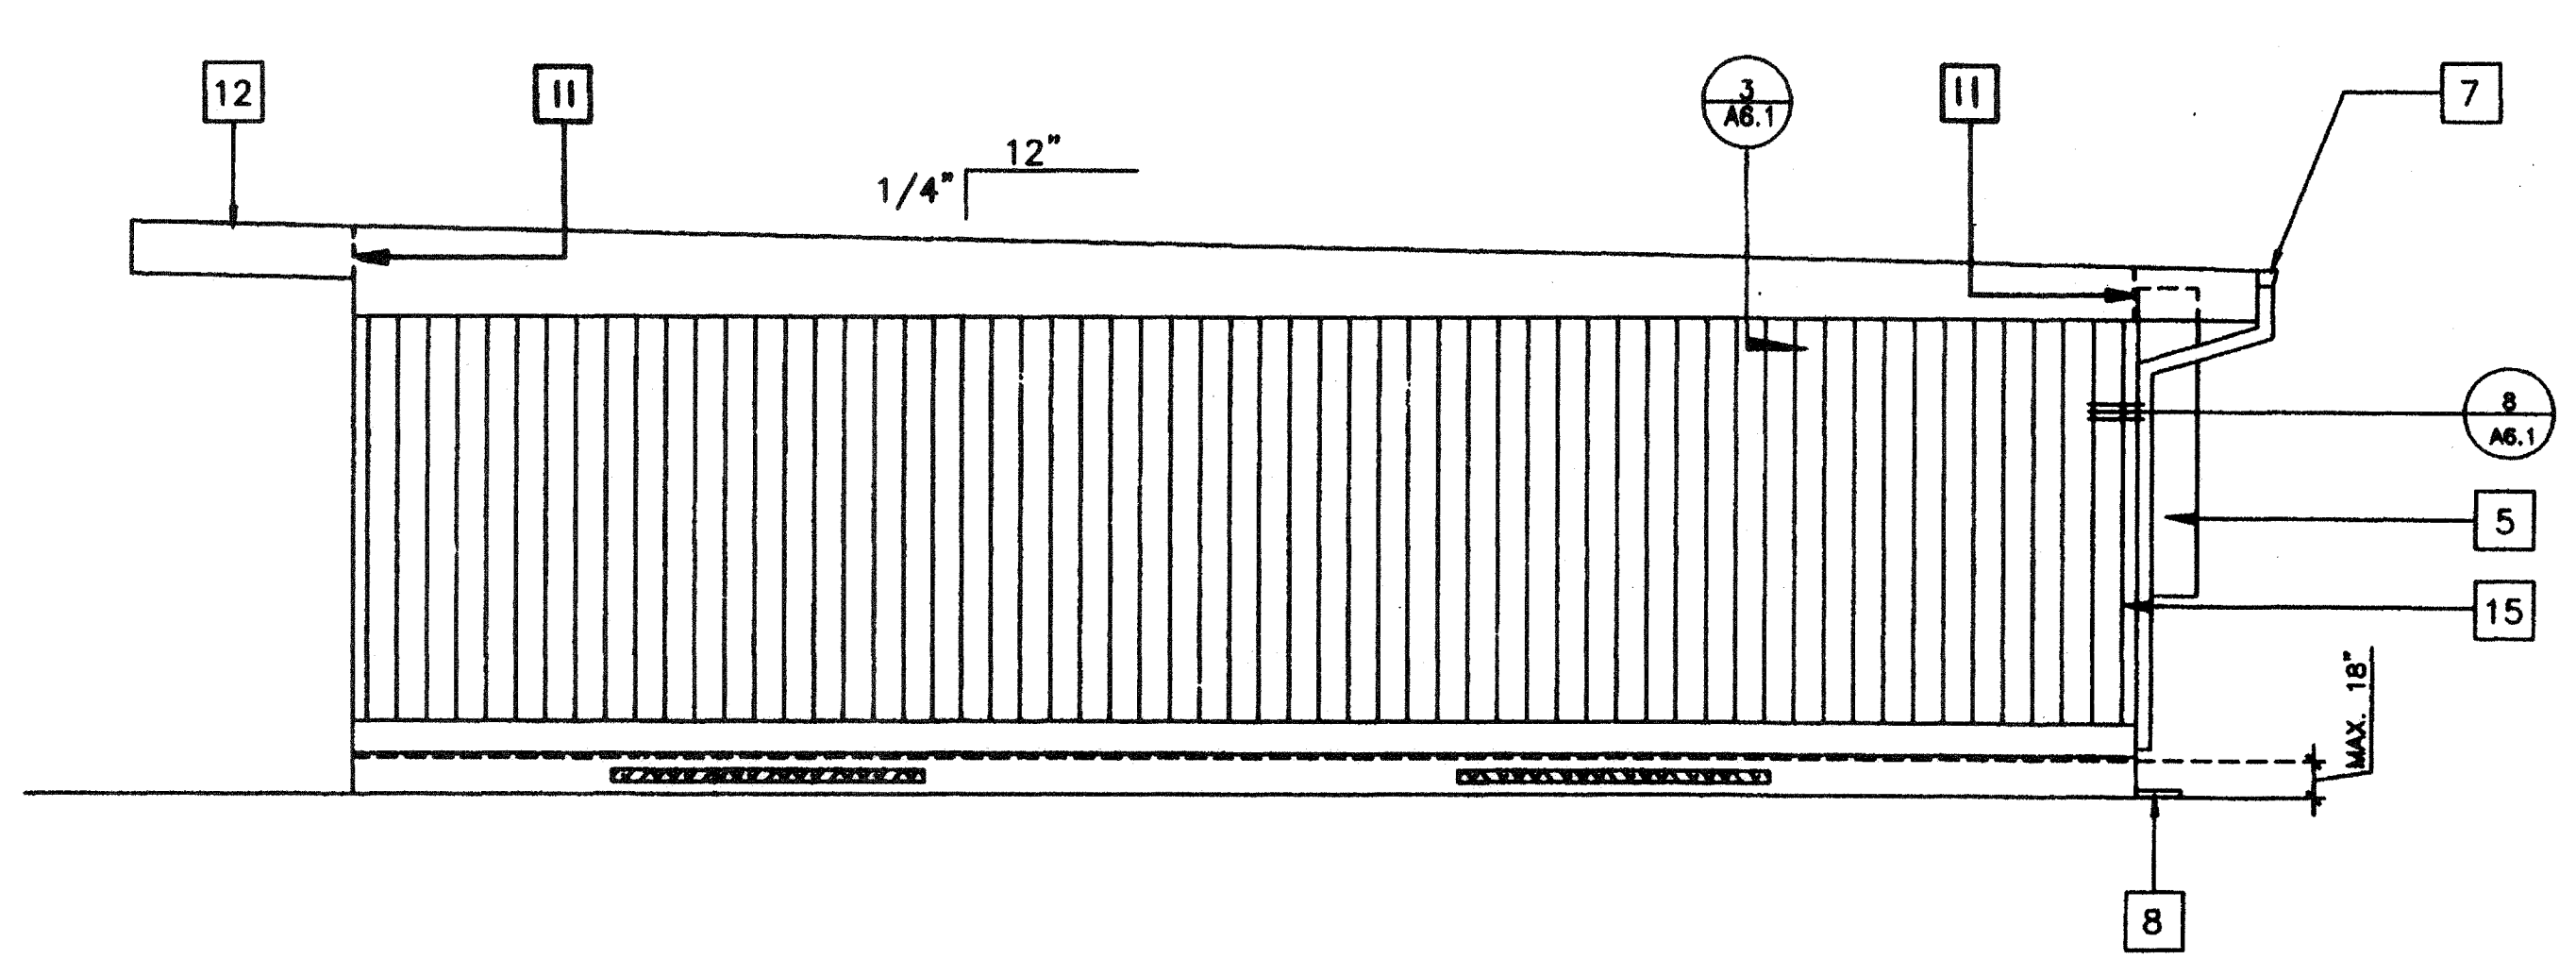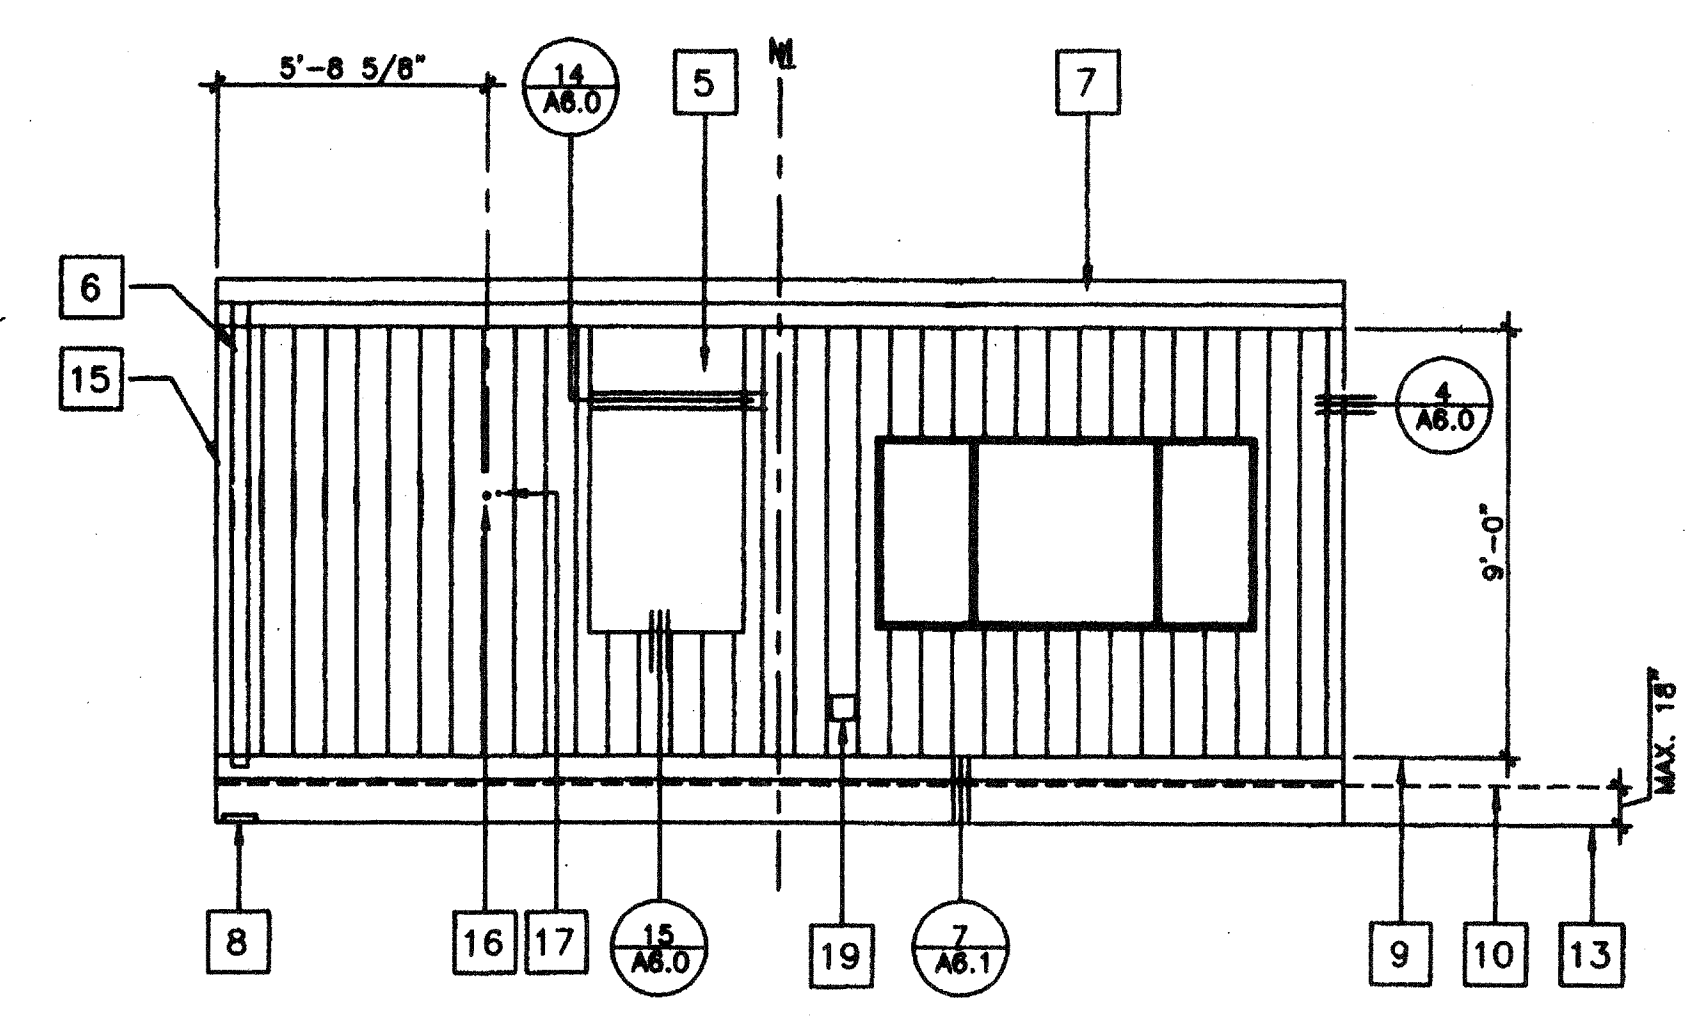


3 REAR ELEVATION
SCALE 1/4"=1'-0"

4 RIGHT SIDE ELEVATION
SCALE 1/4"=1'-0"

KEY NOTES

- 1 TYPICAL EXTERIOR SIDING (SEE SPEC'S)
- 2 EXTERIOR LIGHT FIXTURE (SEE SPEC'S)
- 3 TOP OF SKIRTING
- 4 RAMP AND LANDING SEE SHT. R-1
- 5 HVAC UNIT (HV)
- 6 DOWNSPOUT (TYP.) FOR (1). FASTEN TO BLDG. TYP. 3 PLACES (SEE 8/A6.1)
- 7 CONTINUOUS GUTTER WITH DOWNSPOUT (LOCATION OF DOWNSPOUT SHOWN ON ROOF PLAN)
- 8 SPLASH BLOCK (BY OTHERS)
- 9 FINISH FLOOR LINE
- 10 BOTTOM FLANGE OF FLOOR BEAM
- 11 ROOF HEADER
- 12 ROOF OVERHANG
- 13 FINISH GRADE
- 14 ROOF BEAM (STR)
- 15 COLUMN (STR)
- 16 ELECTRICAL STUB-OUT (EL)
- 17 GROUND STUB-OUT (EL)
- 18 J BOX FOR FA HORN (EL)
- 19 GUTTER BOX (EL)
- 20 FOUNDATION VENT (SEE FOUNDATION PLAN FOR SIZE & LOCATION)

NOTES

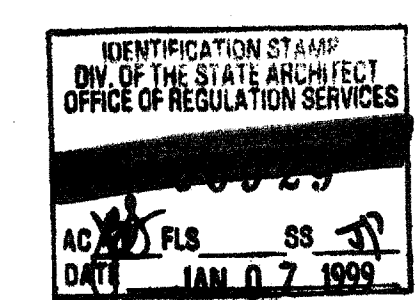

IDENTIFICATION STAMP
DIV. OF THE STATE ARCHITECT
APP#3 117168
AC / FLS / SS / TN
Date AUG 04 2018
STKP-42M
11/24/98

REVISED

24' X 40' (MONO SLOPE)

REVISIONS	Electrical Engineer's Seal	Mechanical Engineer's Seal	Structural Engineer's Seal	Architect's Seal	Division of the State Architect	PROJECT NUMBER: 2986	© MODTECH, INC. 1997	drawn by: 4012-088
1								date: 05 JAN 99
2								checked by:
3								date:
4								ModTech project no:
5								MODTECH Index No.
6								


Electrical Engineer's Seal

Mechanical Engineer's Seal

Structural Engineer's Seal

Architect's Seal
LICENSED ARCHITECT
GEORGE C. EDWARDS
STATE OF CALIFORNIA
NOV 9 30 AM
JAN 25 1997

Division of the State Architect
IDENTIFICATION STAMP
DIV. OF THE STATE ARCHITECT
OFFICE OF REGULATION SERVICES
PC-266
AC / FLS / SS / TN
DATE JUN 25 1997

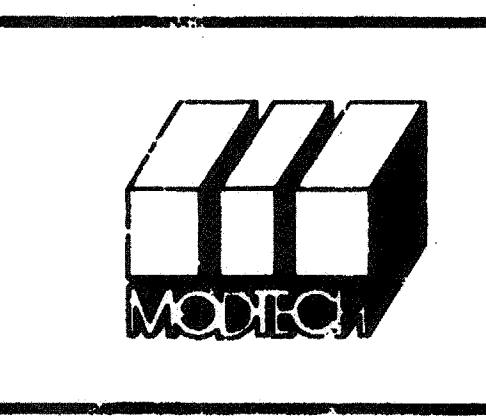

MODTECH INC.
2830 BARRETT AVENUE
PERRIS, CALIF. 92572
PH (909) 943-4014
FAX (909) 940-0427

PROJECT NUMBER: 2986
© MODTECH, INC. 1997
drawn by: 4012-088
date: 05 JAN 99
checked by:
date:
ModTech project no:
MODTECH Index No.

drawn by: 4012-088
date: 05 JAN 99
checked by:
date:
ModTech project no:
MODTECH Index No.

drawn by: 4012-088
date: 05 JAN 99
checked by:
date:
ModTech project no:
MODTECH Index No.


EXTERIOR ELEVATIONS

AA3.0


PROJECT NO. 2986
2.506
PC-266

KEY NOTES


- 1 TYPICAL INTERIOR FINISH (SEE A5.0)
- 2 CLOSURE AT MODULAR JOINT
- 3 DUPLEX WALL RECEPTACLE (EL)
- 4 FIRE ALARM PULL STATION (EL)
- 5 LIGHT SWITCH (EL)
- 6 TOP SET BASE (TYPICAL) SEE FINISH SCHED.
- 7 RETURN AIR GRILL
- 8 ELECTRICAL PANEL (EL)
- 9 FINISH FLOOR
- 10 THERMOSTAT (HV)
- 11 MODULAR JOINT
- 12 8040 MARKBOARD. TYPICAL FOR (2)
- 13 FIRE EXTINGUISHER: 5LBS. DRY CHEMICAL WITH 2A-10BC U.L. RATING ON WALL MTD. BRACKET, HANDLE AT 48" A.F.F.
- 14 12" DIA. ELECTRIC CLOCK (EL)

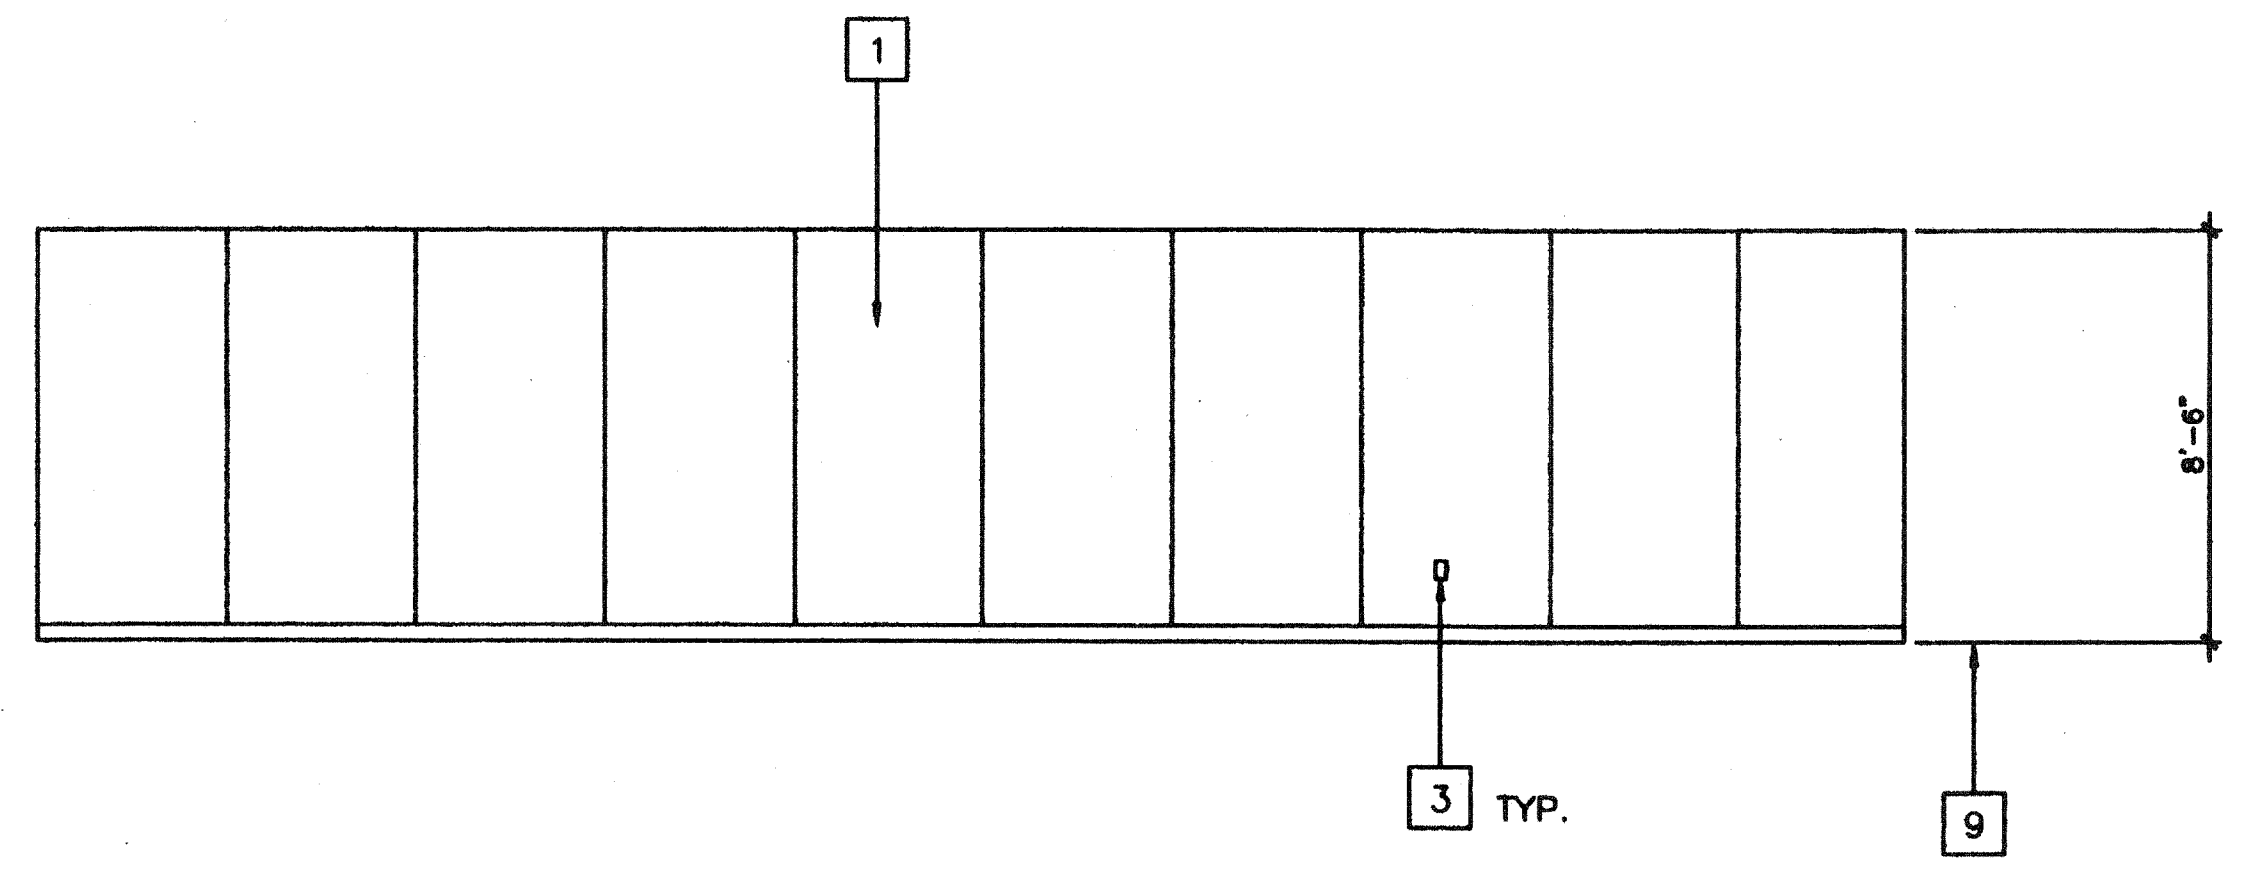


1

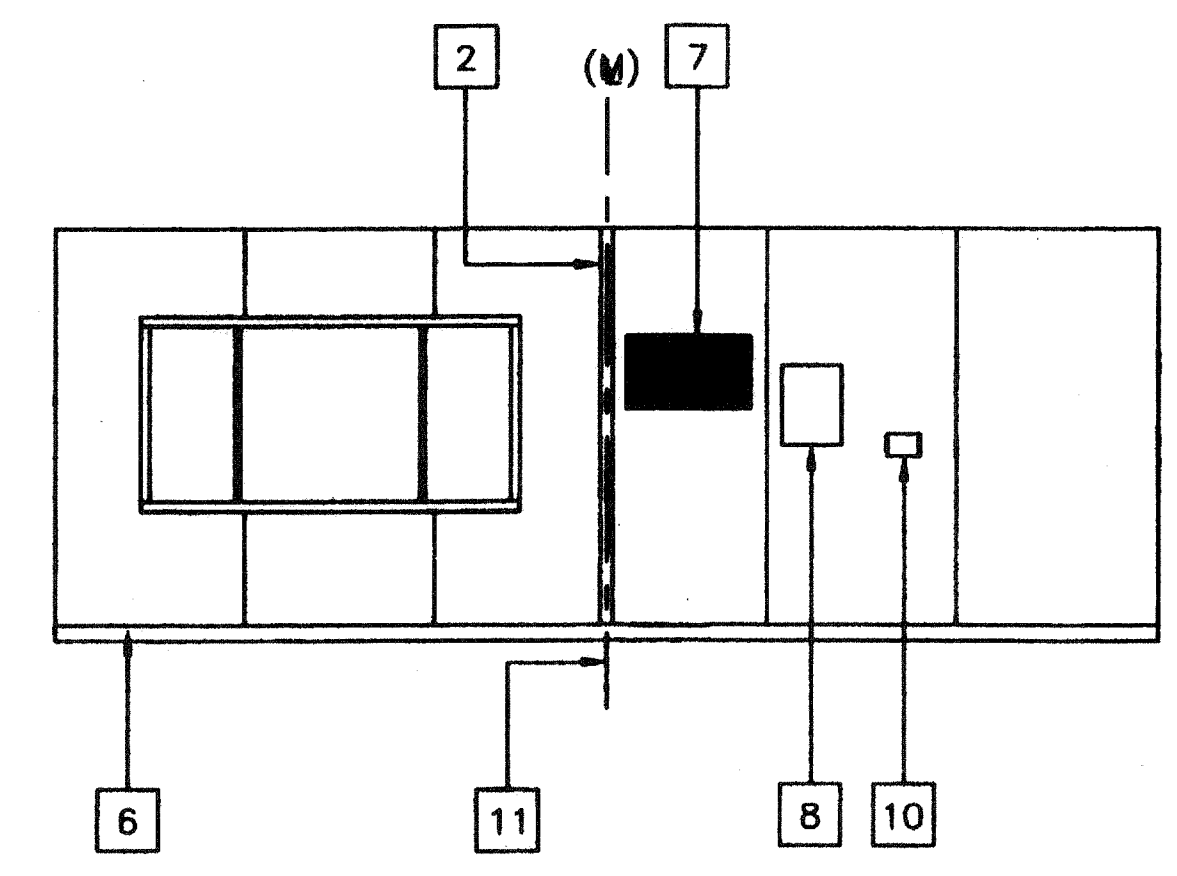

2

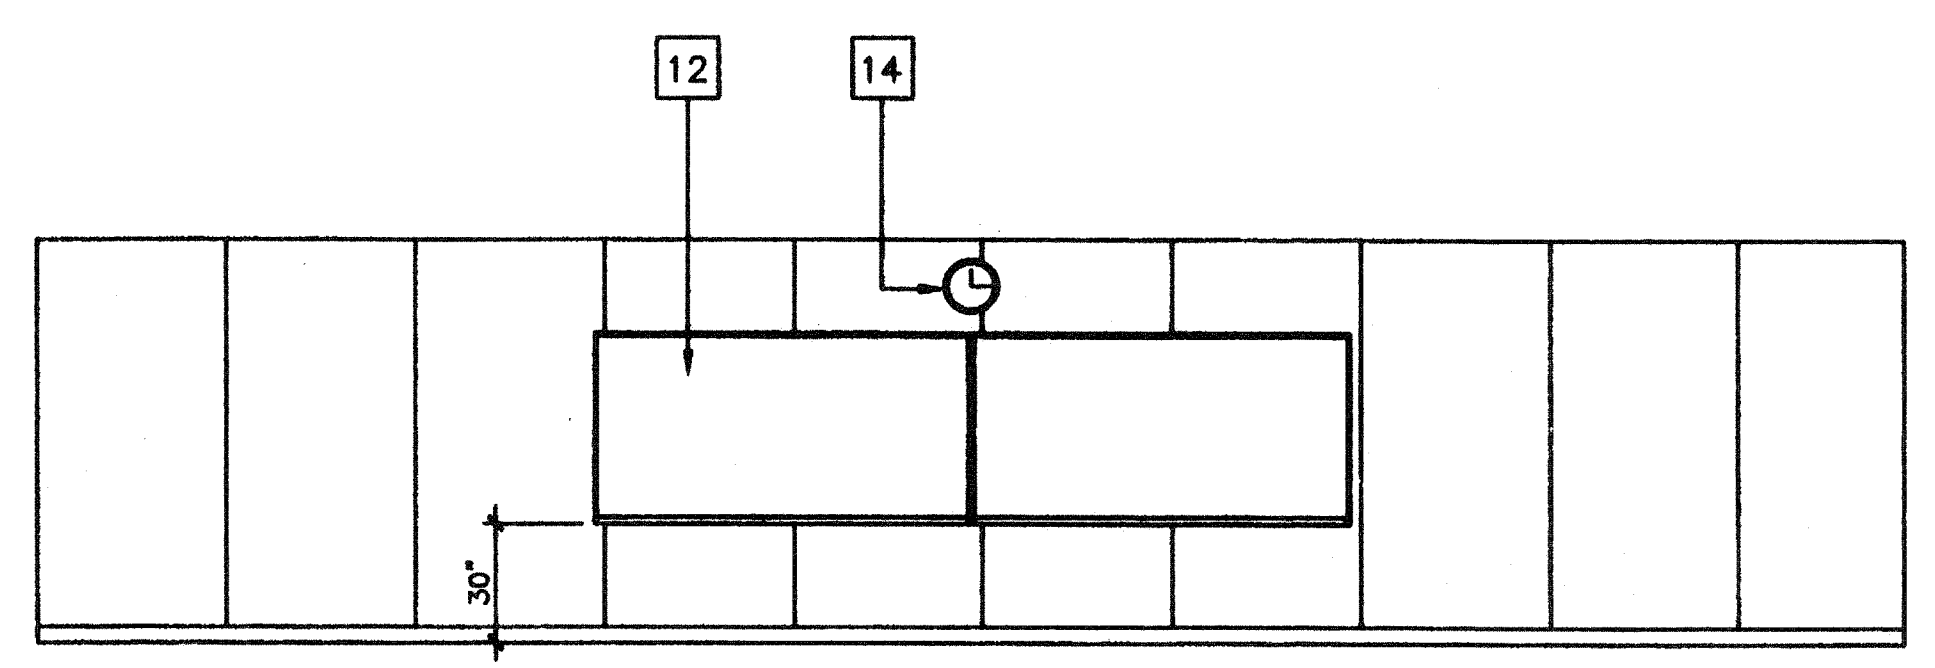

3

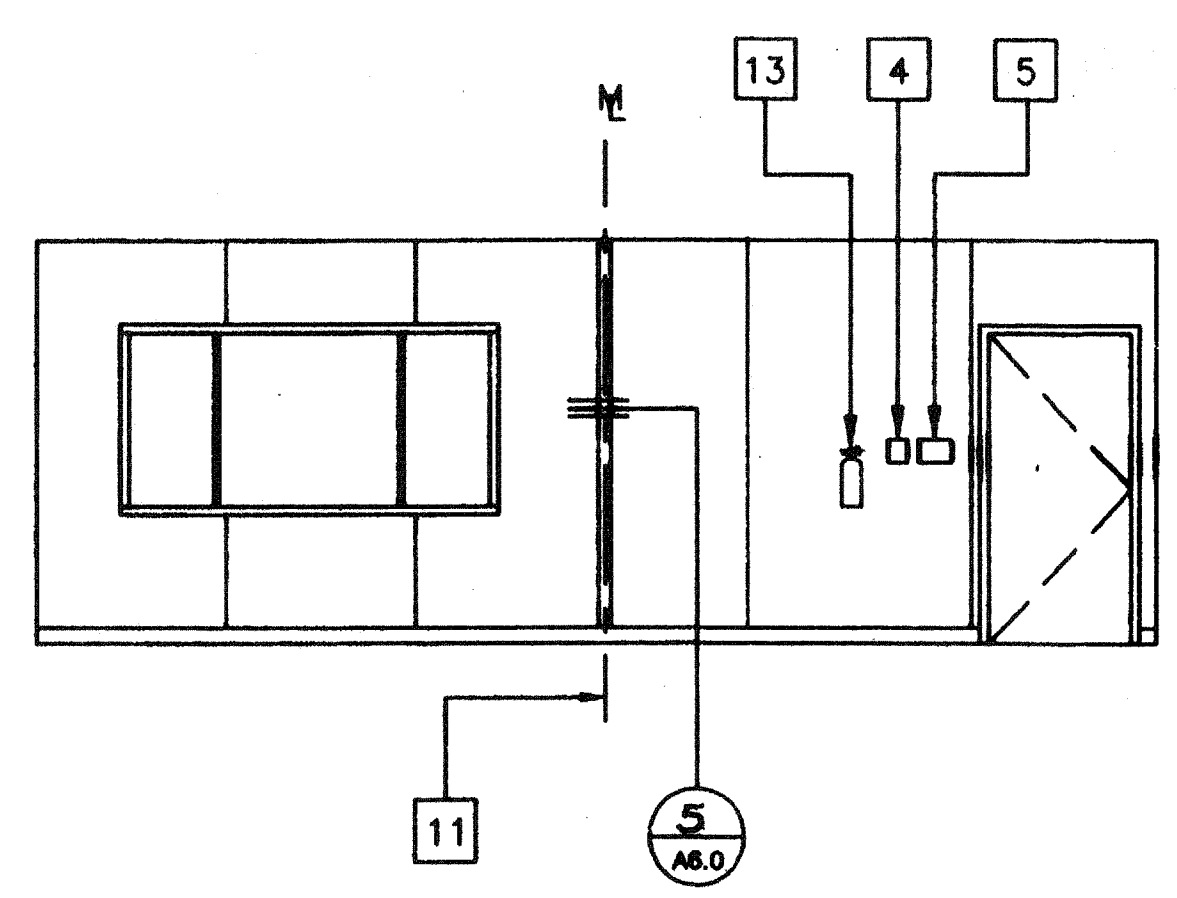

4

INTERIOR ELEVATIONS (24' X 40')

SCALE 1/4"=1'-0"

IDENTIFICATION STAMP
DIV. OF THE STATE ARCHITECT
OFFICE OF REGULATION SERVICES
AC: [Signature] FLS: [Signature] SS: [Signature] J1
DATE: JAN 07 1999

IDENTIFICATION STAMP
DIV. OF THE STATE ARCHITECT
APP#3 117168
AC: [Signature] FLS: [Signature] SS: [Signature] TN
Date: AUG 04 2018
STKP-42
11/24/98

REVISED

REVISIONS	Electrical Engineer's Seal	Mechanical Engineer's Seal	Structural Engineer's Seal	Architect's Seal	Division of the State Architect


Electrical Engineer's Seal

Mechanical Engineer's Seal

Structural Engineer's Seal

Architect's Seal
LICENSED ARCHITECT
GEORGE C. EDWARDS
PEN. 9-30-97
STATE OF CALIFORNIA

Division of the State Architect
IDENTIFICATION STAMP
DIV. OF THE STATE ARCHITECT
OFFICE OF REGULATION SERVICES
PC-966
AC: [Signature] FLS: [Signature] SS: [Signature] J1
DATE: JUN 23 1997

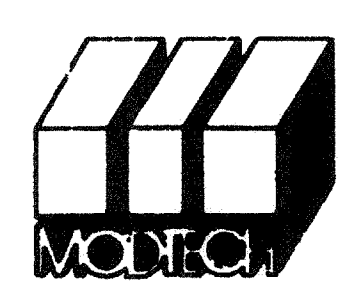

MODTECH INC.
2830 BARRETT AVENUE
PERRIS, CALIF. 92572
PH (909) 943-4014
FAX (909) 940-0427

PROJECT NUMBER: 2986

© MODTECH, INC. 1997

drawn by: 4012-088
checked by: 05 JAN 99
date: 05 JAN 99
project no: 2986


INTERIOR ELEVATIONS

A4.0

DOOR SCHEDULE **WINDOW SCHEDULE** **ROOM FINISH SCHEDULE** **NOTES**


DOORS					FRAMES					NOTE NO.	
DOOR NUMBER	FRAME OPENING SIZE	MATERIAL	TYPE	FIRE RATING	HARDWARE SET NO.	QUANTITY	MATERIAL	HEAD DETAIL	JAMB DETAIL		SILL DETAIL
1	3'-0" X 6'-8"	HM	A	NA	1		HM	7/A6.0	8/A6.0	1/A6.0	5-1/8"

HM - HOLLOW METAL
 AL - ALUMINUM
 SST - STAINLESS STEEL
 STL - STEEL FRAME, 16ga, FULLY WELDED, GALV • EXTERIOR, REPUBLIC "ME" SERIES. PAINT TO
 WWF - WINDOW WALL FRAME
 SC - SOLID CORE WOOD
 HC - HOLLOW CORE WOOD
 SCL - SOLID CORE WOOD (LEGACY)

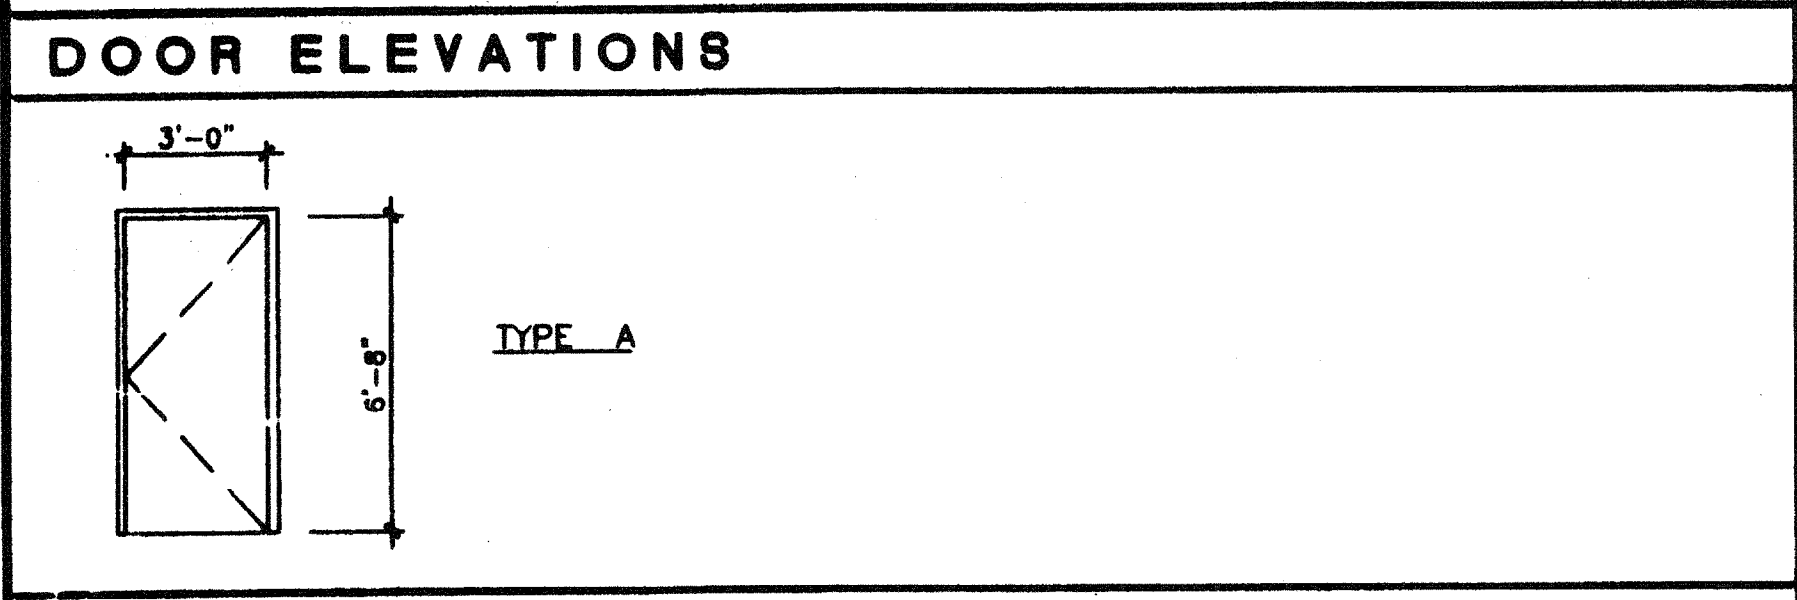

- DOOR NOTES**
- DOOR HANDLES FOR LOCKSETS TO BE CENTERED • 40" AFF & DEADBOLTS • 44" AFF. HARDWARE TO BE OPENABLE FROM THE INSIDE WITHOUT ANY SPECIAL KNOWLEDGE OR EFFORT LEVERS TO RETURN TO WITHIN 1/2" OF DOOR.
 - ALL DOORS SHALL BE 1-3/4" THICK UNO DOUBLE LETTERS IN SCHEDULE, INDICATES A PAIR OF DOORS.
 - CLOSURE SHALL BE SET FOR MAXIMUM OPENING PRESSURE OF 8.5 LBS • EXTERIOR DOORS AND 5.0 LBS • INTERIOR DOORS.
 - PLACE SIGN OVER EXIT DOORS: "THESE DOORS TO REMAIN UNLOCKED DURING BUSINESS HOURS" SIGNAGE IS NOT IN MODTECH CONTRACT

AMT.	TYPE	WIDTH	HEIGHT	FINISH	GLASS TYPE	WIN. NO.
2	I	8'-0"	4'-0"	ANODIZED	7/32" MIN, SOLAR GRAY 46%, DUAL GLAZE	A

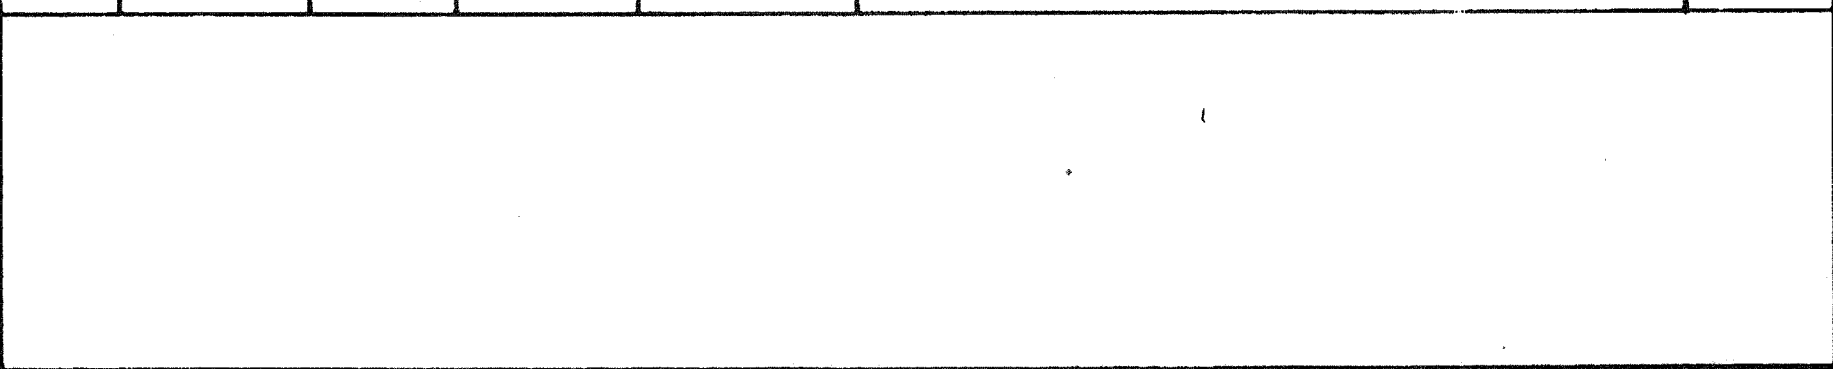

- WINDOW NOTES**
- 8040 XOX ANODIZED ALUMINUM, DUAL GLAZING, 7/32" MIN TEMPERED GLASS OF SOLAR GRAY WITH A LIGHT TRANSMISSION FACTOR OF 46%, ALL OPERABLE SASH SHALL HAVE SCREENS.



- WINDOW NOTES**
- 8040 XOX ANODIZED ALUMINUM, DUAL GLAZING, 7/32" MIN TEMPERED GLASS OF SOLAR GRAY WITH A LIGHT TRANSMISSION FACTOR OF 46%, ALL OPERABLE SASH SHALL HAVE SCREENS.

ROOM NUMBER	ROOM NAME	FINISHES							REMARKS
		FLOOR	BASE	WALLS			CEILING	CEILING HEIGHT	
1	CLASSROOM	A	D	F	F	F	F	L	8'-6"

- FINISH NOTES**
- SUB-FLOOR PREP:**
 PREPARATION FOR SUB FLOOR TO ACCEPT FINISH FLOORING IS BY FLOORING CONTRACTOR. PLYWOOD SUB FLOOR IS 2.4.1 PLYWOOD. OUTER PLY IS PLUGGED AND TOUCH SANDED, ANY DEFORMITIES DUE TO STANDARD CONSTRUCTION PRACTICES SHALL BE FILLED AND SANDED BY FLOORING CONTRACTOR. THE JOINT AT THE MODULE JOINING SHALL NOT BE LARGER THAN 1/8" AND SHALL BE FILLED AND SANDED BY FLOORING CONTRACTOR.

1. ALL FINISHES SHALL COMPLY WITH C.B.C. CHAPTERS 3,6,7,8, & 10 & C.F.C. & TITLE 19 C.C.R.

- HARDWARE SCHEDULE**
- HARDWARE SET #1 (For 30x40 BLDGS. & 40x40 BLDGS. USE HARDWARE SET #7)**
- LOCKSET - SCHLAGE D70PD, RHODES LEVER, OR EQUAL
 - BUTTS - 1-1/2 PAIR HAGER 1279 BB 4-1/2 x 4-1/2 NRP 26D OR EQUAL
 - CLOSER - NORTON 8501 BFD / 900 BFD CAL ROYAL OR EQUAL
 - THRESHOLD - PEMCO 271A OR EQUAL
 - DOOR BOTTOM - PEMCO 216AV OR EQUAL
 - WEATHERSTRIP - PEMCO 299AV OR EQUAL
- HARDWARE SET #2 (INTERIOR PASSAGE)**
- LOCKSET - SCHLAGE D10S WITH RHODES LEVER, OR EQUAL
 - BUTTS - 1-1/2 PAIR HAGER 1279 4-1/2 x 4-1/2 OR EQUAL
- HARDWARE SET #3 (INTERIOR / OFFICE LOCKABLE)**
- LOCKSET - SCHLAGE D53PD, WITH RHODES LEVER OR EQUAL
 - BUTTS - 1-1/2 PAIR HAGER 1279 4-1/2 x 4-1/2 26D
- HARDWARE SET #4 (INTERIOR / DOUBLE CLASSROOM LOCKABLE)**
- LOCKSET - SCHLAGE D66PD, WITH RHODES LEVER OR EQUAL
 - BUTTS - 1-1/2 PAIR HAGER 1279 4-1/2 x 4-1/2 26D
- HARDWARE SET #5 (INTERIOR TOILET ROOM / PRIVACY)**
- LOCKSET - SCHLAGE D40S OR EQUAL
 - BUTTS - 1-1/2 PAIR HAGER 1279 4-1/2 x 4-1/2 26D
- HARDWARE SET #6 (INTERIOR STOREROOM)**
- LOCKSET - SCHLAGE D80PD WITH RHODES LEVER OR EQUAL
 - BUTTS - 1-1/2 PAIR HAGER 1279 4-1/2 x 4-1/2 26D
- HARDWARE SET #7 (PANIC)**
- LOCKSET - VON DUPRIN 99L PANIC HARDWARE OR EQUAL
 - BUTTS - 1-1/2 PAIR HAGER 1279 BB 4-1/2 x 4-1/2 NRP 26D OR EQUAL
 - CLOSER - NORTON 8501 BFD / 900 BFD CAL ROYAL OR EQUAL
 - THRESHOLD - PEMCO 271A OR EQUAL
 - DOOR BOTTOM - PEMCO 216AV OR EQUAL
 - WEATHERSTRIP - PEMCO 299AV OR EQUAL

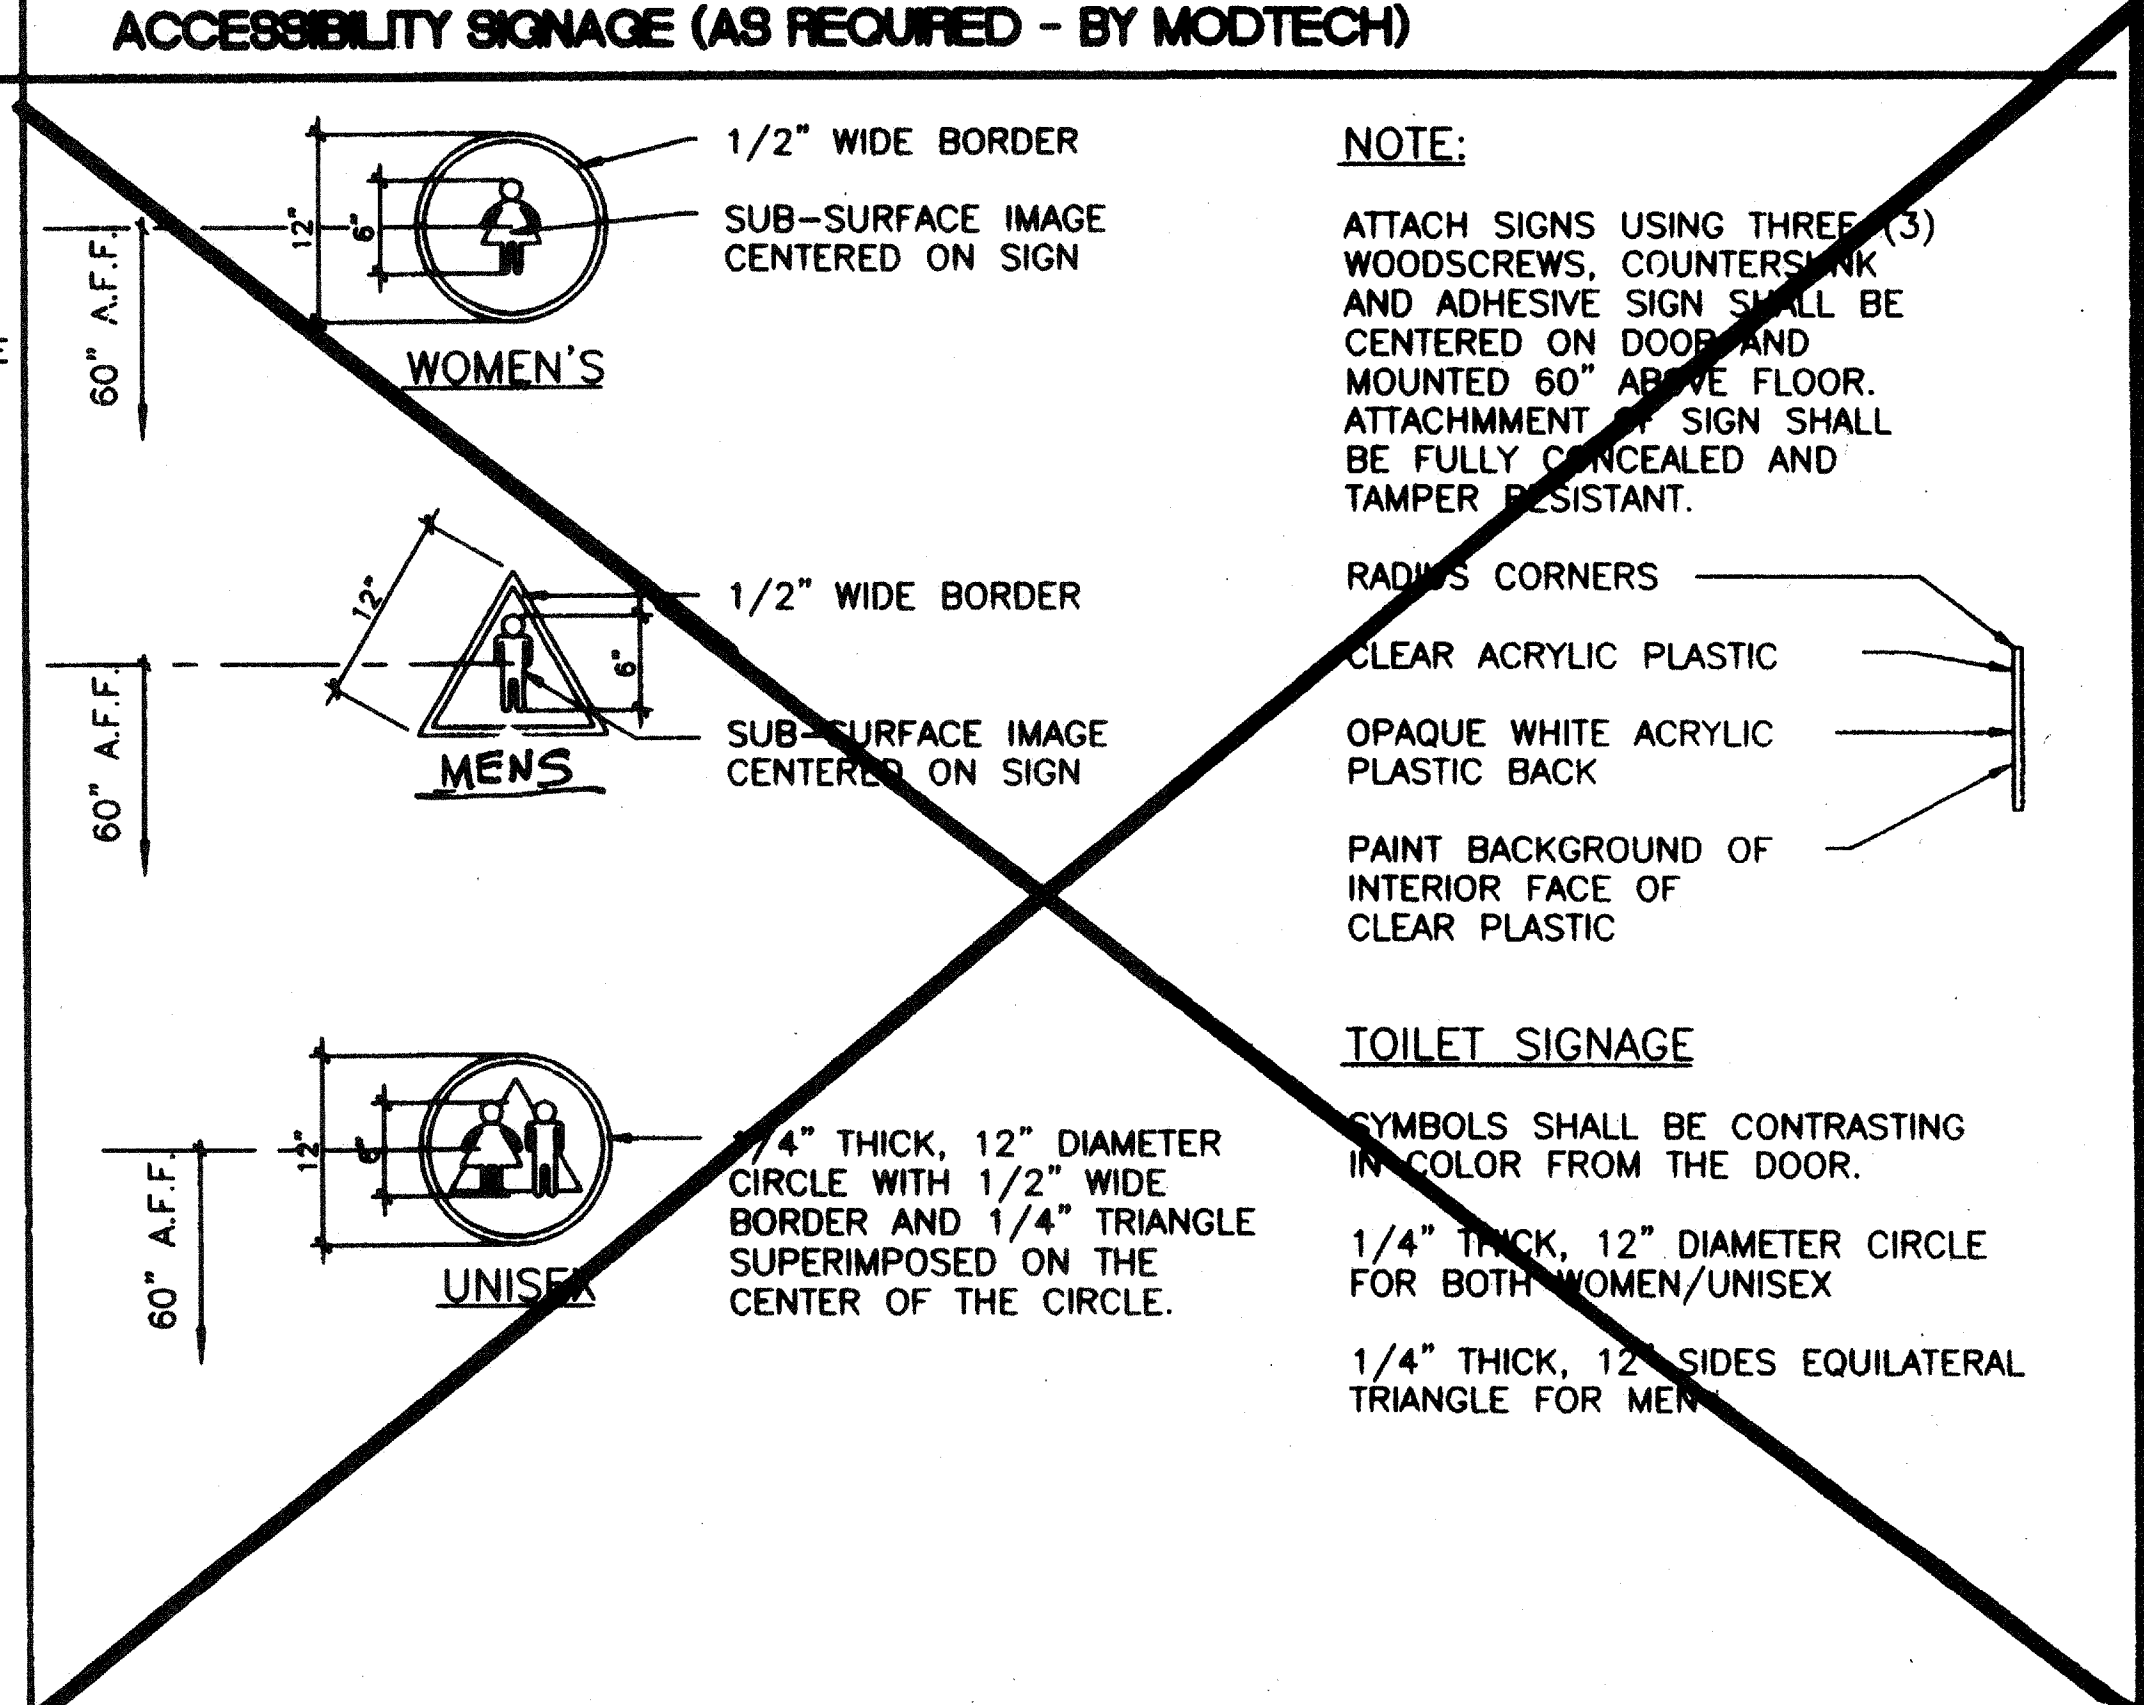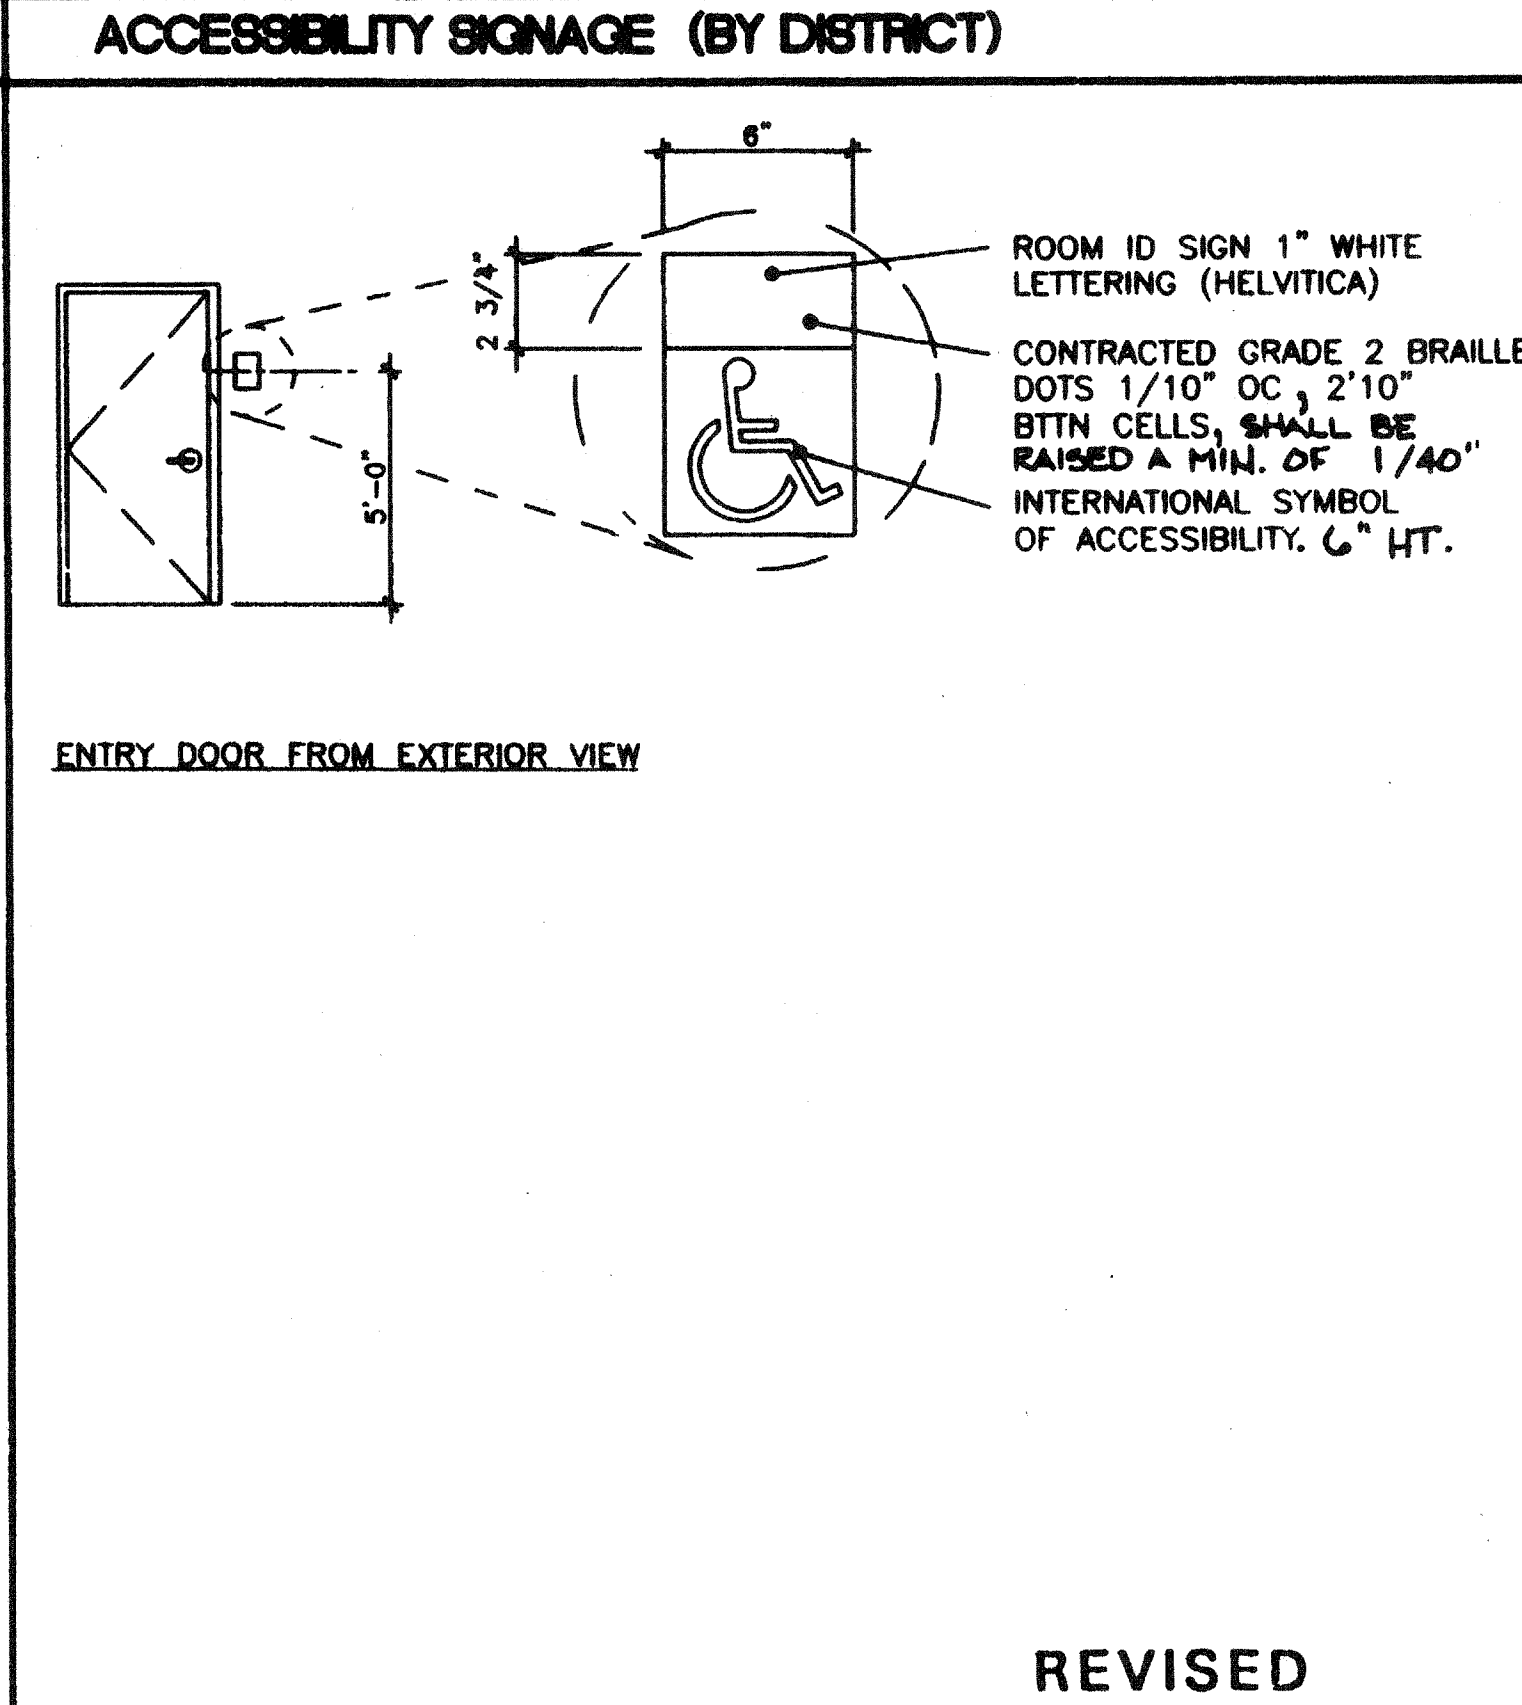

REVISIONS

1		
2		
3		
4		
5		

Electrical Engineer's Seal Mechanical Engineer's Seal Structural Engineer's Seal Architect's Seal Division of the State Architect

PC-206 DATE: JUN 15 1997

MODTECH INC.
 2830 BARRETT AVENUE
 PERRIS, CALIF. 92572
 PH (909) 943-4014
 FAX (909) 940-0427

PROJECT NUMBER: 2986 © MODTECH, INC. 1997

drawn by: 4012-088
 checked by: 05 JAN 99
 Modtech project no:
 MODTECH Index No.


IDENTIFICATION STAMP
 DIV. OF THE STATE ARCHITECT
 OFFICE OF REGULATION SERVICES
 DATE: JAN 07 1999

APP#3 117168
 AC / FLS / SS / TN
 Date: AUG 04 2016

STKP-42
 11/24/98

A5.0

PROJECT NO. 2986

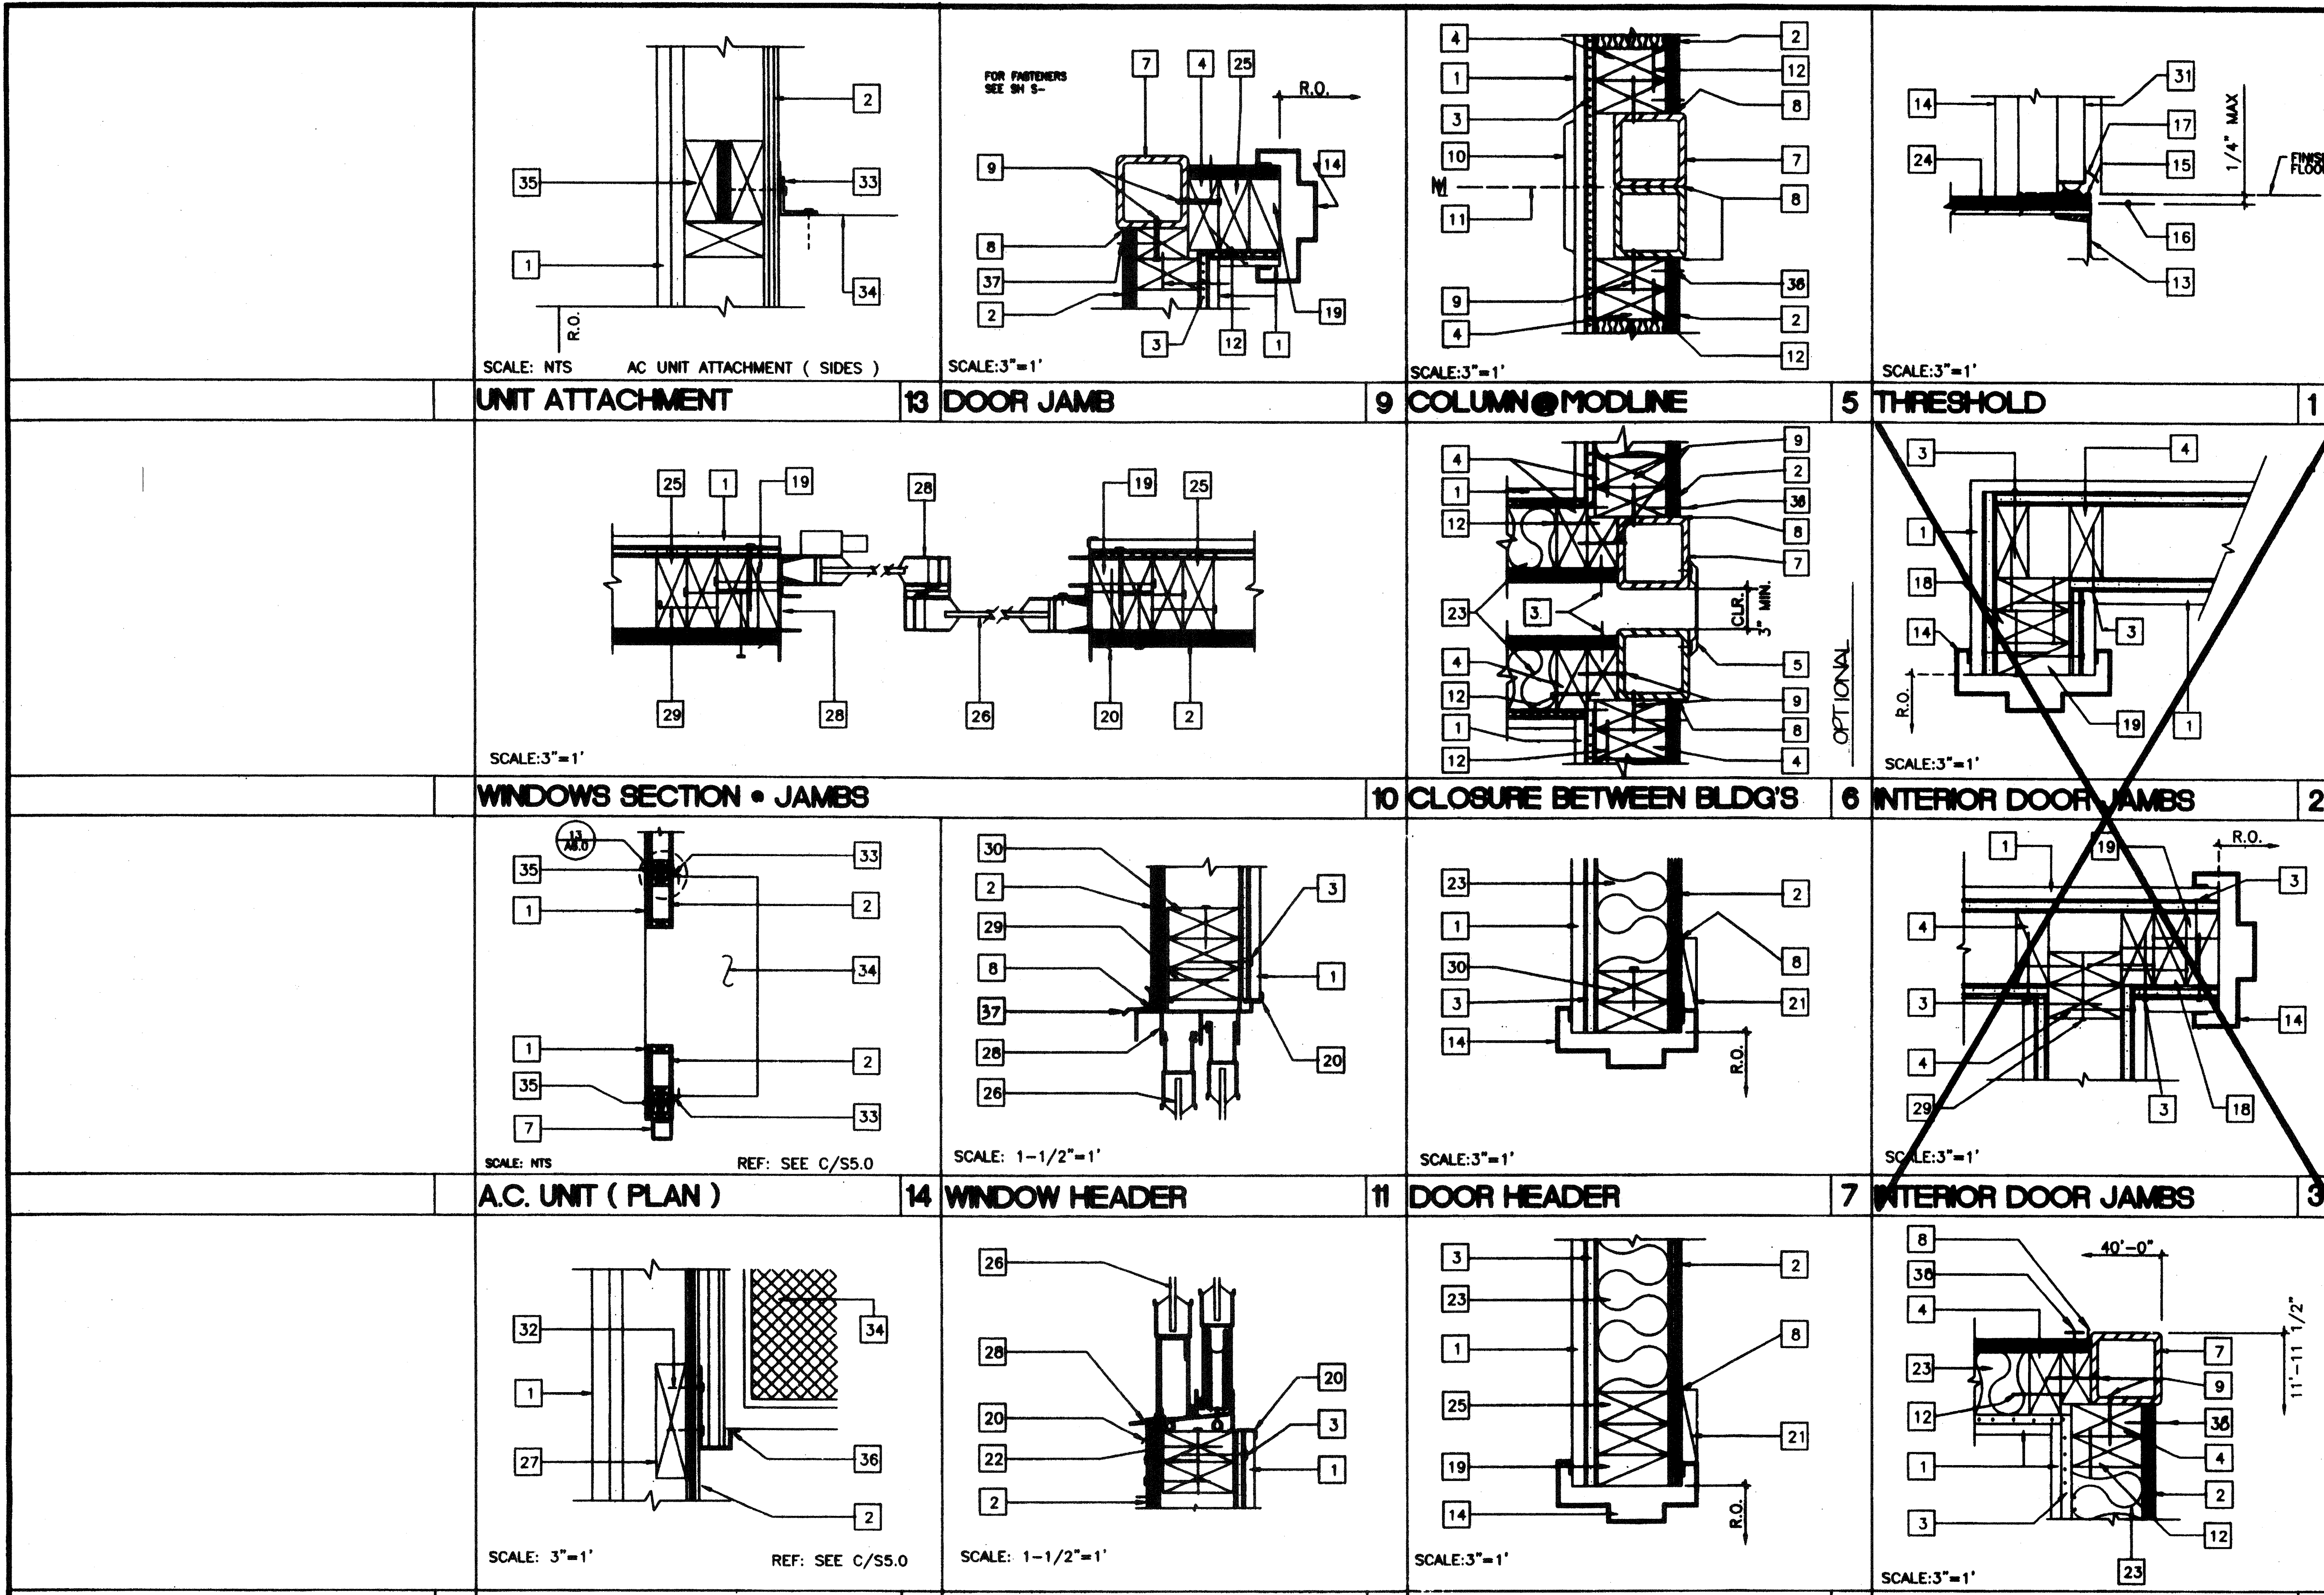

- ### KEY NOTES
- 1 TYP. INTERIOR FINISH (SEE FINISH SCHEDULE.)
 - 2 TYP. EXTERIOR FINISH
 - 3 1/2" GYPSUM BOARD BACKING W/ 7d COOLER NAILS @ MAX 7" O.C. TYP. • EA. STUD
 - 4 2X4 STUD TYP. @ 16" O.C. MAX.
 - 5 WIRE MESH CLOSURE. ATTACH TO COLUMN W/#10 STMS @ 12" O.C.
 - 6 NOT USED
 - 7 TUBE STEEL COLUMN (SEE STRUCTURAL)
 - 8 SEALANT TYP. (SEE SPECS.)
 - 9 #10 S.T.S.M.S. @ MAX. 24" O.C. (ALT. HILT. 0.145 SHOT PIN) 2X FILLER TO COLUMN
 - 10 VINYL CLOSURE
 - 11 MODULE JOINT
 - 12 16d @ 24" O.C. FACE NAIL OR 16d @ 12" O.C. TOE NAIL (SEE SHT. S5.2)
 - 13 FLOOR BEAM (SEE STRUCTURAL)
 - 14 PRESSED STEEL FRAME (K.D. TYPE SEE A5.0)
 - 15 ALUMINUM THRESHOLD (SEE HARDWARE SCHEDULE)
 - 16 FINISH LANDING SEE FLOOR PLAN & FOUNDATION FOR TYPE AND FINISH
 - 17 DOOR BOTTOM (SEE HARDWARE SCHEDULE)
 - 18 (2) 2X4 KING STUD NAILING SCHEDULE (SEE SHT. S5.1 FOR NAILING)
 - 19 2X4 TRIMMER (SEE SHT. S5.1 NAILING SCHEDULE FOR NAILING)
 - 20 CORNER MOLDING
 - 21 1X4 WOOD TRIM W/6d ELECTRO GALV. @ 12" O.C.
 - 22 2-2X4 SILL PLATE W/16d @ 16" O.C.
 - 23 INSULATION (SEE SPECS. FOR SIZE AND TYPE)
 - 24 FINISH FLOORING (SEE FINISH SCHEDULE SHT. A5.0)
 - 25 2X4 JAMB STUDS (SEE SHT. S5.1 DETAILS FOR NUMBER OF STUDS REQUIRED AND NAILING SCHEDULE FOR NAILING)
 - 26 WINDOW GLAZING (SEE WINDOW SCHEDULE SHEET A5.0)
 - 27 2 X 6 LET IN (SEE WALL FRAMING SHT. S5.0)
 - 28 ALUMINUM WINDOW FRAME WITH NAIL-ON FINISH. INSTALL W/MIN. 3" BLDG. PAPER BTWN. FIN. AND FRAMING. INSTALL WITH 6d @ MAX 24" O.C.
 - 29 16d BOX STAGGERED @ MAX 24" O.C.
 - 30 HEADER (SEE SHT. S5.1 WALL FRAMING DETAILS)
 - 31 DOOR (SEE DOOR SCHED.)
 - 32 6-3/8" @ X 2" GALV. LAG SCREWS
 - 33 L 1 1/2"x1 1/2"x1/8"x18" LONG (BY HVAC MFR) ATTACHED TO A/C W/4-#10 SELF TAPPING SHEET METAL SCREWS & ATTACH TO WALL W/3" @ X 2" GALV. LAG SCREWS.
 - 34 SIDE OF HVAC UNIT (SEE SHEET M-1)
 - 35 (3) 2X4 W/ PLYWOOD SPACER- BUILT- UP POST. 6d @ O.C. STAGGERED SPACER TO FIRST 2 X 4. 16 d @ 12" O.C. 2 nd 2 X 4. 12d @ 12" O.C. STAGGERED Jrd. 2 x 4. ALTERNATE USE 4 X 4 POST.
 - 36 11GA X 24" STEEL SUPPORT BRACKET.
 - 37 DRIP FLASH
 - 38 6d EN @ 6" O.C.

NOTES

1. EN 6d ELECTRO GALV. @ 6" O.C.
2. FN 6d ELECTRO GALV. @ 12" O.C.
3. SEE SHEET S5.1 FOR TYPICAL WALL FRAMING NAILING

REVISIONS	Electrical Engineer's Seal	Mechanical Engineer's Seal	Structural Engineer's Seal	Architect's Seal	Division of the State Architect

MODTECH INC.
 2830 BARRETT AVENUE
 PERRIS, CALIF. 92572
 PH (909) 943-4014
 FAX (909) 940-0427

PROJECT NUMBER: 2986

DATE: JAN 07 1999

APPROVED BY: [Signature]

DATE: JAN 07 1999

ARCHITECTURAL DETAILS

A6.0

STKP-42

11/29/98

PROJECT NO. 2486
FILE # P286 A6.1 LOW
PC-286












- ### KEY NOTES
- 1 TYP. INTERIOR FINISH
 - 2 TYP. EXTERIOR FINISH
 - 3 E.N. RF. PLYWOOD TO BEAM (STR)
(DO NOT PENETRATE METAL ROOFING)
 - 4 2X4 STUD TYP.
 - 5 CAP CLOSURE @ RIDGE 26GA. GALV. W/#10 STSMS
@ 12" TAGGER W/NEOPRENE WASHERS TO RIB
BOTH SIDES OF MODLINE SET CAP IN SEALANT.
 - 6 TUBE STEEL (STR)
 - 7 #10 S.T.S.M.S. @ 6" O.C. EN & 12" O.C. FN /
ALT. USE AEROSMITH AKN 144.0175 DRIVE PIN.
 - 8 SEALANT TYP. (SEE SPECIFICATIONS)
 - 9 EXTERIOR WALL (SEE S5.2 FOR CONNECTIONS)
 - 10 SOFFIT (SEE SPECIFICATIONS)
 - 11 ROOF BEAM (STR)
 - 12 .080 X 1 1/2" SCREW SHANK NAILS ROOF CLIP TO
ROOF DECKING (SEE NOTE 18 FOR ROOF CLIP)
 - 13 PLYWOOD ROOF SHEATHING (STR)
 - 14 FULL DEPTH STIFFENER PLATE (SEE STR
FOR LOCATION)
 - 15 ANCHOR CLIPS @ 24" O.C. & WITHIN 6" @ END
OF ROOF DECKING
 - 16 ROOF HEADER (STR)
 - 17 G.I. FLASHING 22GA.
 - 18 STANDING SEAM ROOF (SEE A2.0 FOR GA.)
 - 19 ROOF PURLIN (STR)
 - 20 CONTINUOUS 2X4 TOP PLATE
 - 21 GALV. FLASHING (ONLY AT CONCRETE BELOW
GRADE FOUNDATION)
 - 22 CONTINUOUS 26GA. GUTTER
 - 23 WEATHERPROOF MEMBRANE
(25-30LBS. ASPHALT COATED)
 - 24 FLOOR BEAM (STR)
 - 25 2X4 SILL PLATE ATTACHED PER 4/S5.2
 - 26 SEALANT @ END OF SEAM
 - 27 ATTACHMENT BRACKET (TYP. 3-PLACES, TOP, BTM.,
& MIDSPAN W/2-#10STSMS BRACKET TO COLUMN)
 - 28 POP RIVETS MIN. 1/8"
 - 29 DOWNSPOUT
 - 30 PLYWOOD FLOOR SHEATHING
 - 31 ROOF FACIA HEADER (STR)
 - 32 1/2"X1 1/2"X14GA. < TACK WELD IN PLANT
 - 33 GALVANIZED COUNTER FLASHING (BY OTHERS)
 - 34 EN (8d ELECTRO GALV. @ 6" O.C.)
- IDENTIFICATION STAMP
DIV. OF THE STATE ARCHITECT
OFFICE OF REGULATION SERVICES

AC FLS SS 3
DATE JAN 07 1999

IDENTIFICATION STAMP
DIV. OF THE STATE ARCHITECT
OFFICE OF REGULATION SERVICES

APP#3 117160
AC FLS SS TN
Date AUG 04 2018

STKP-42 11/29/98

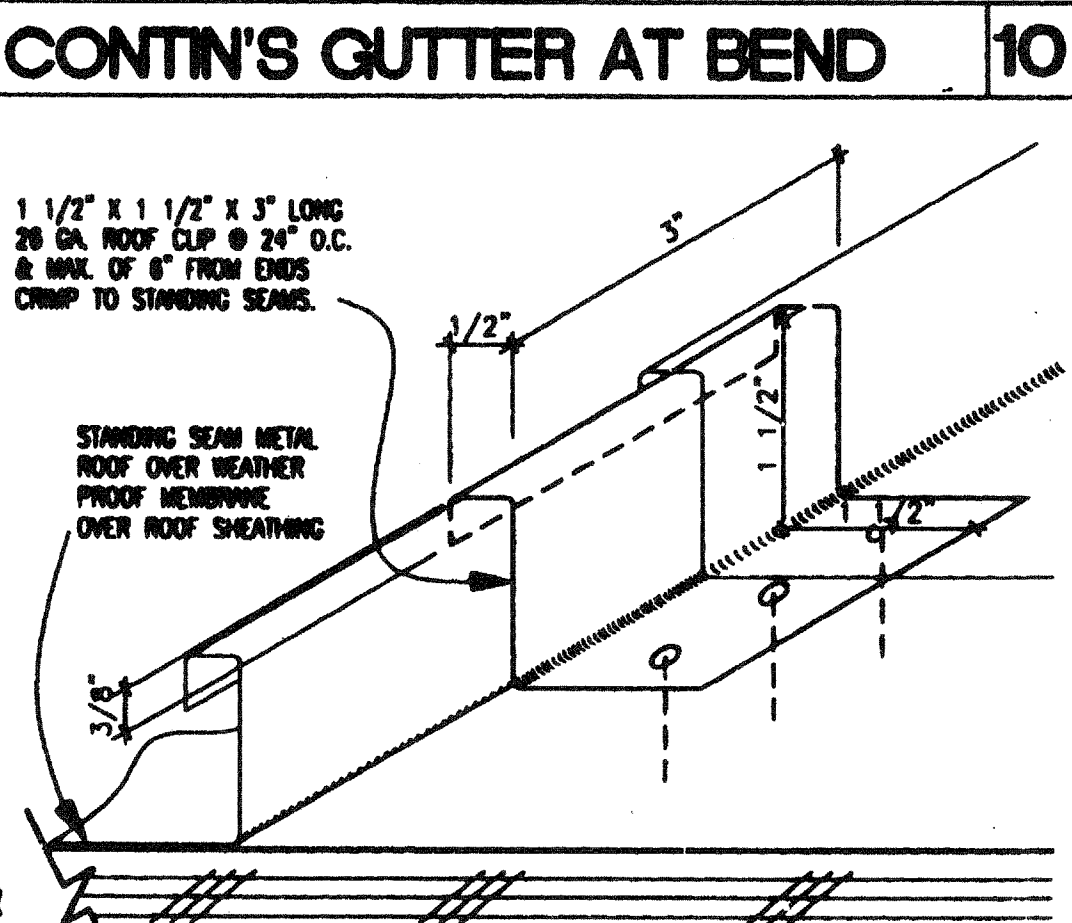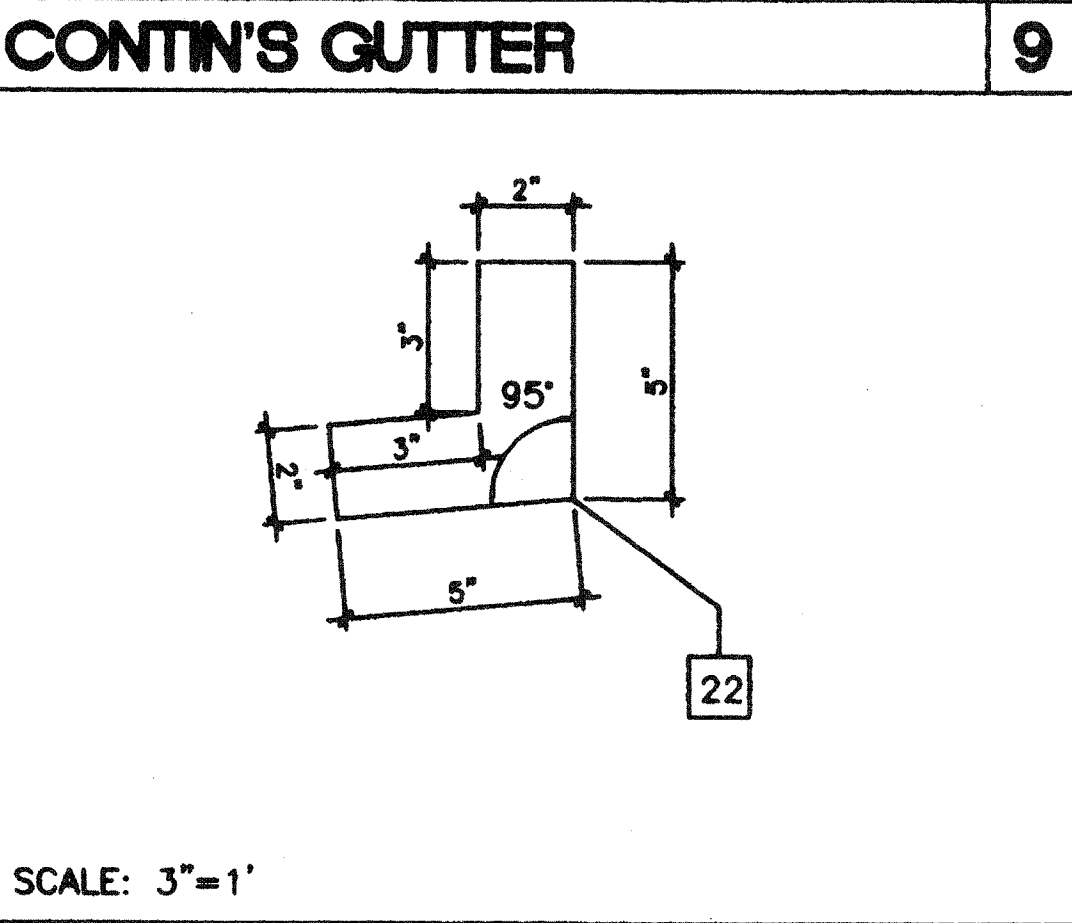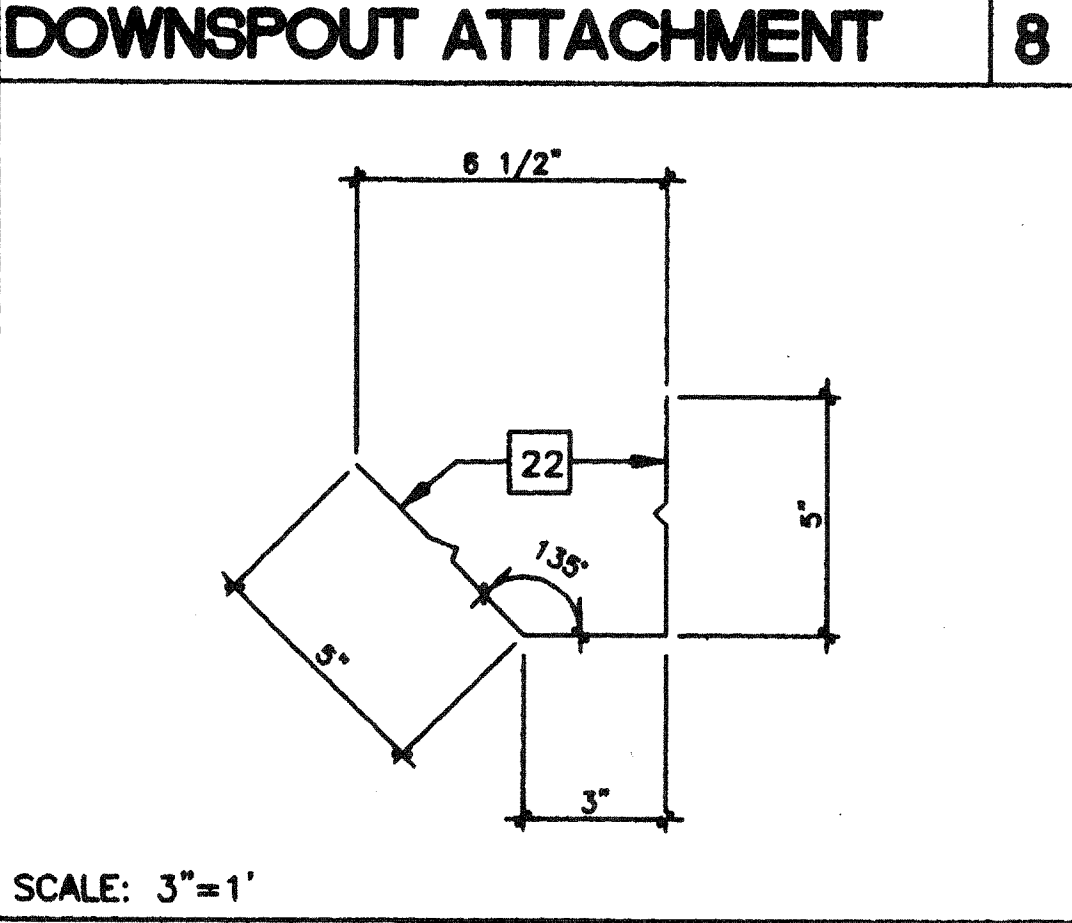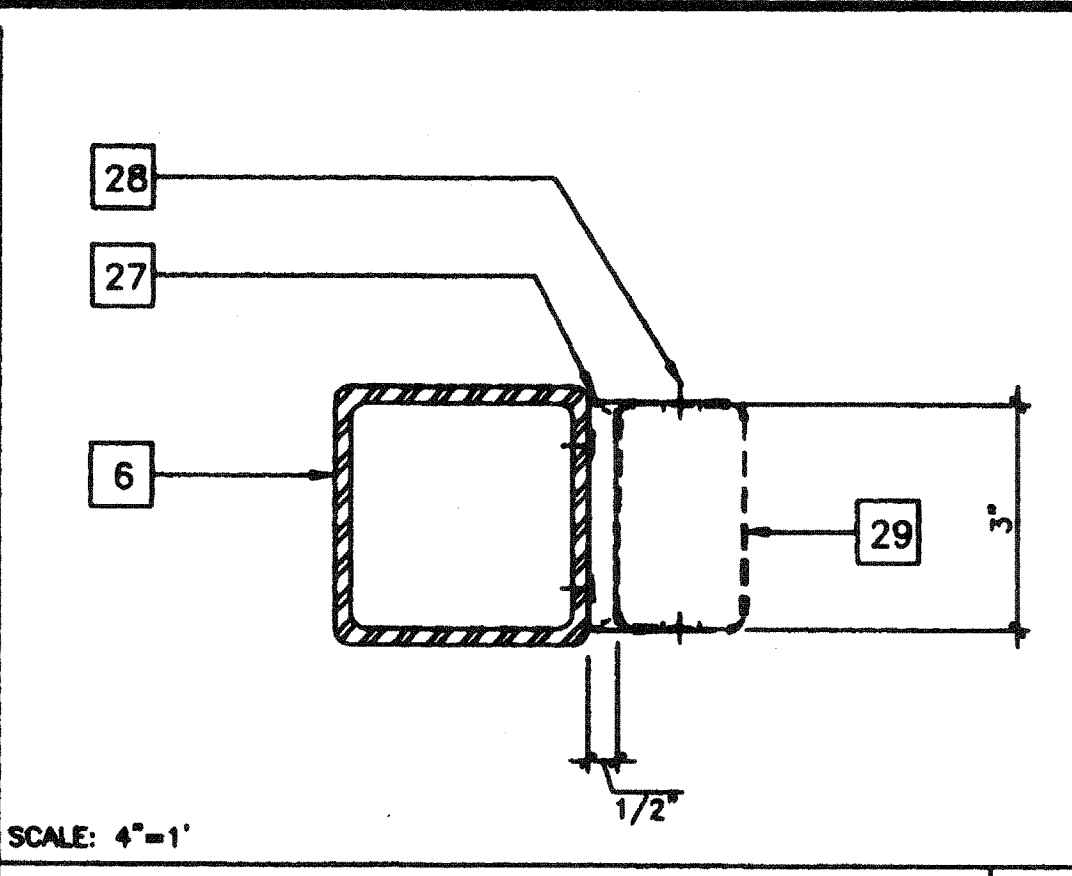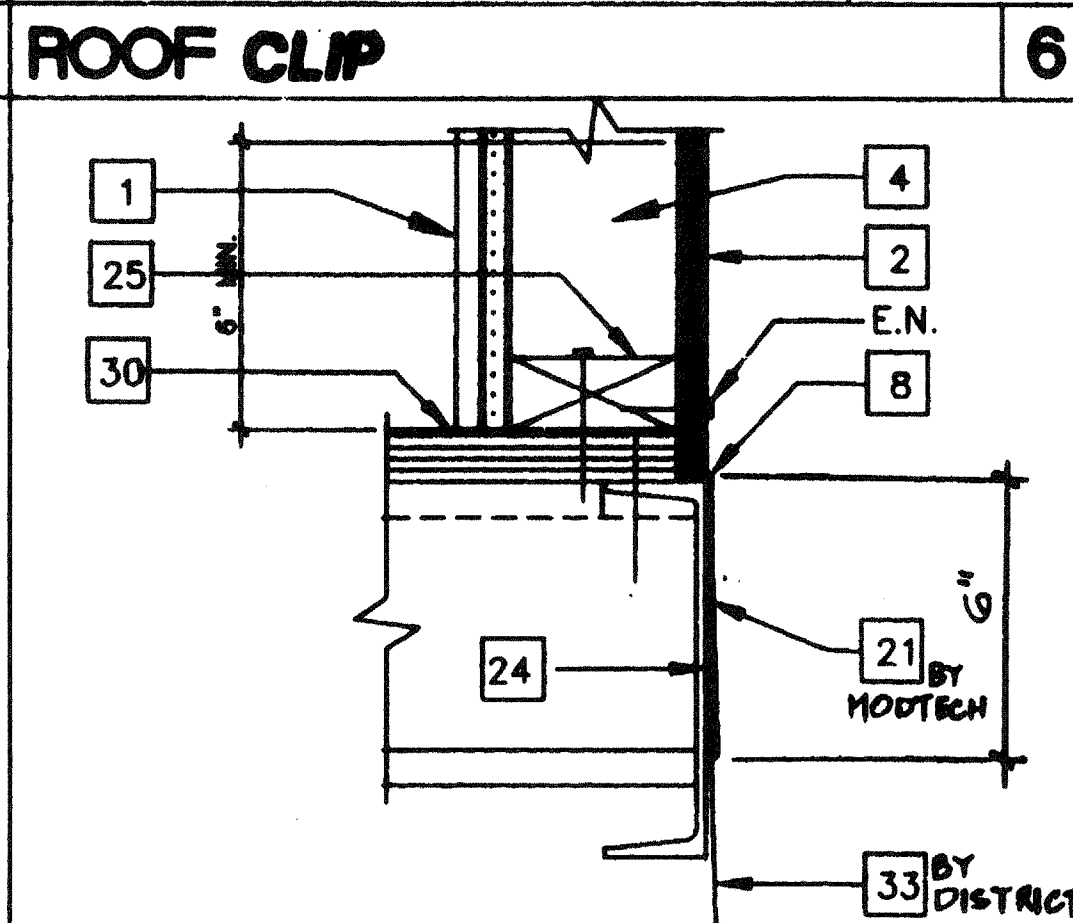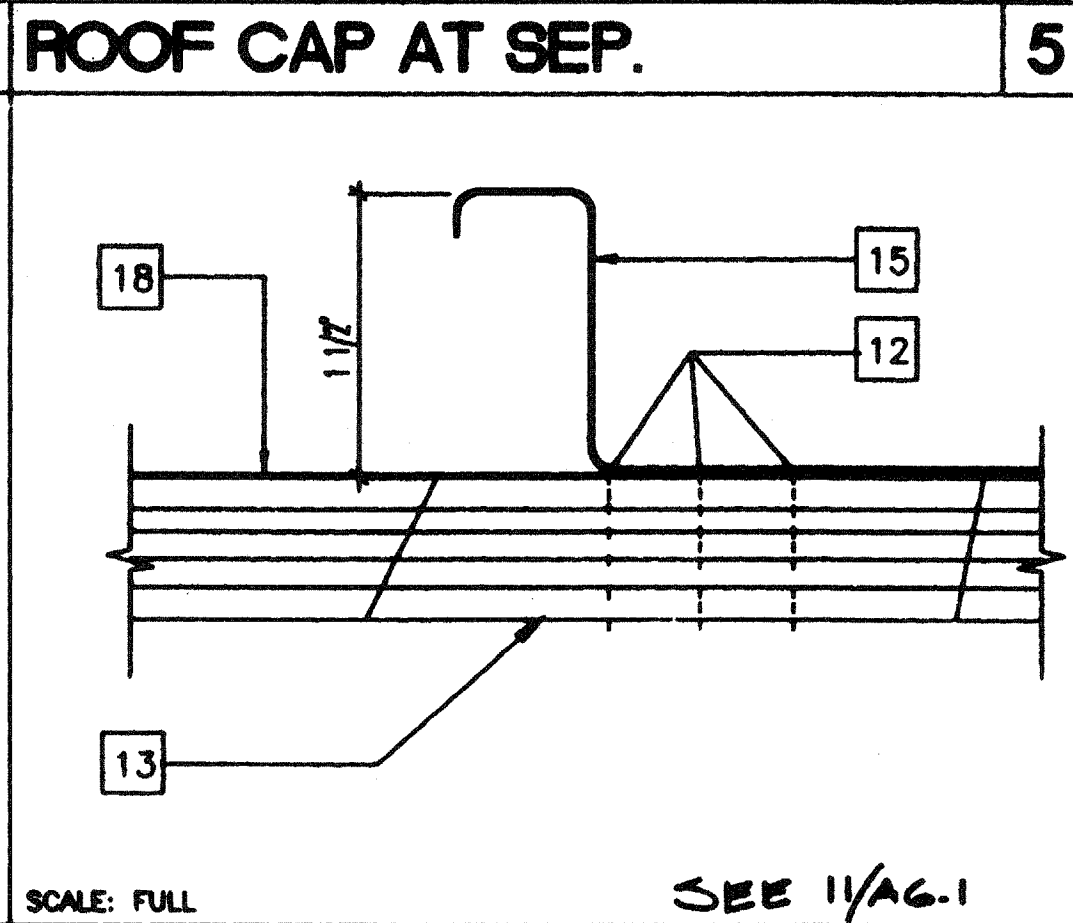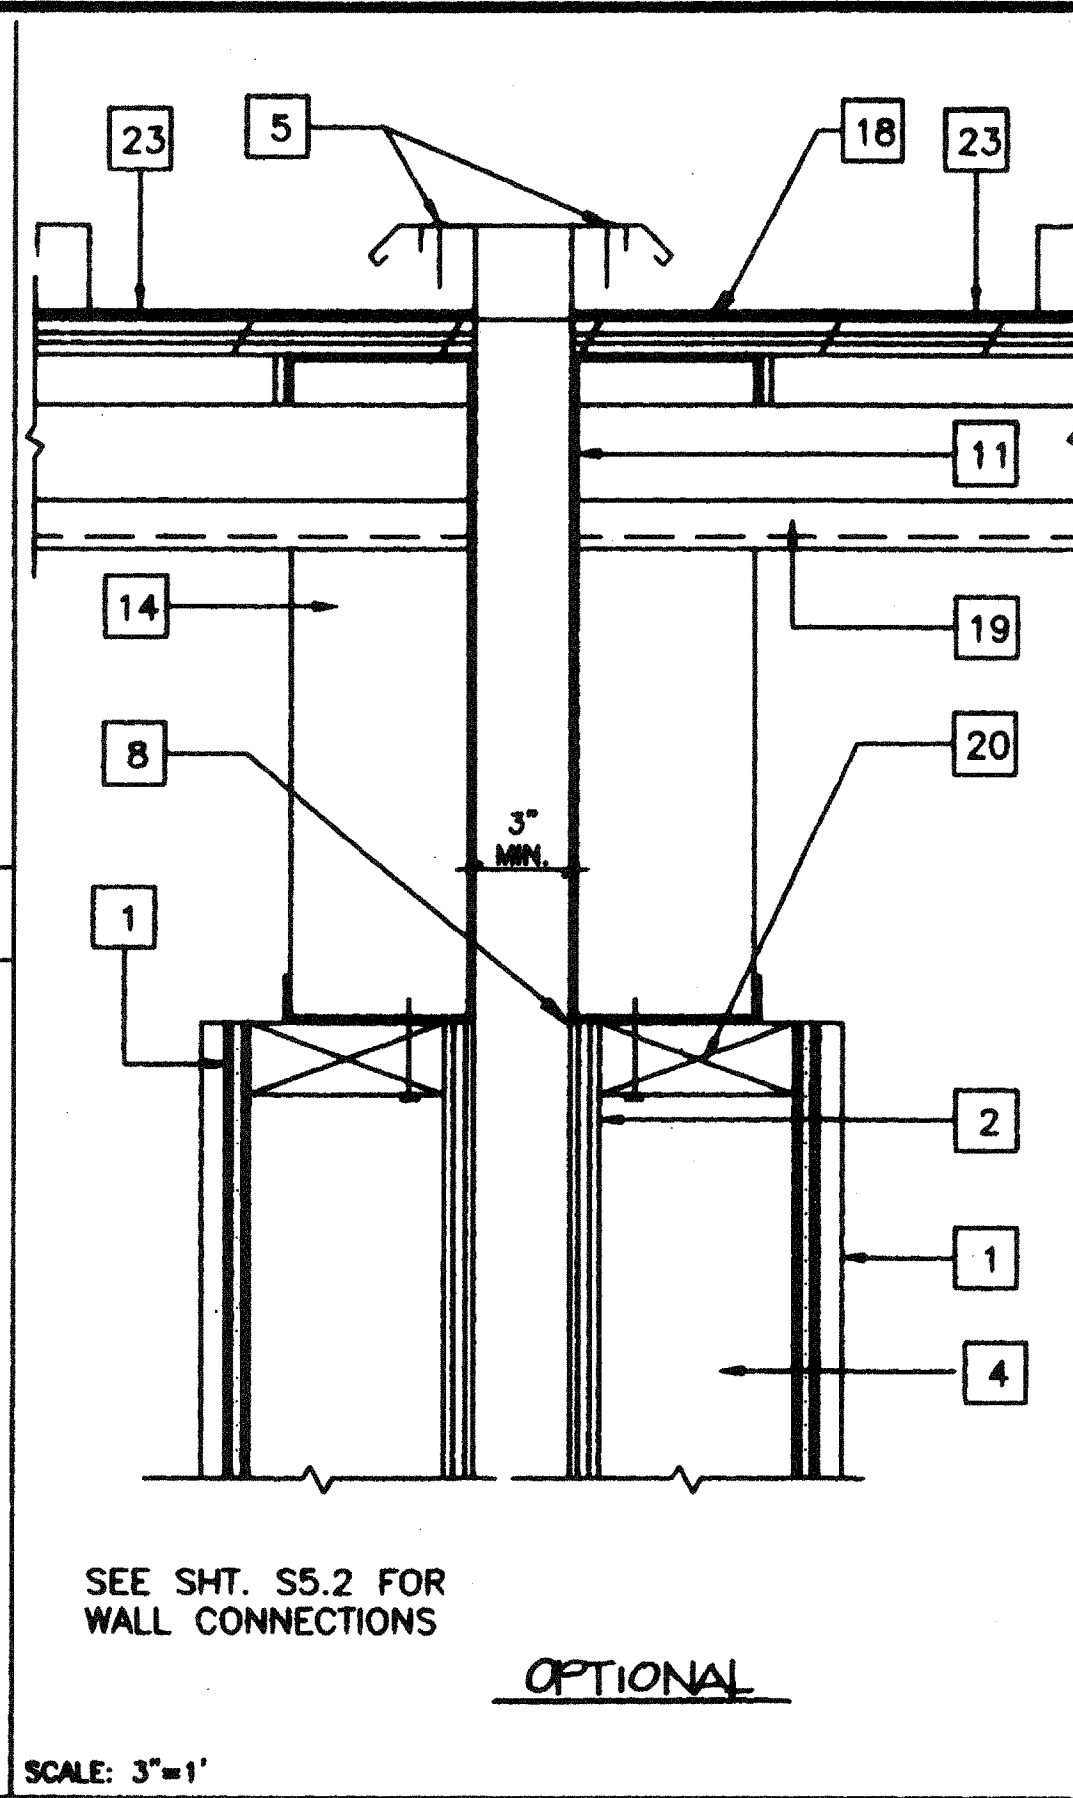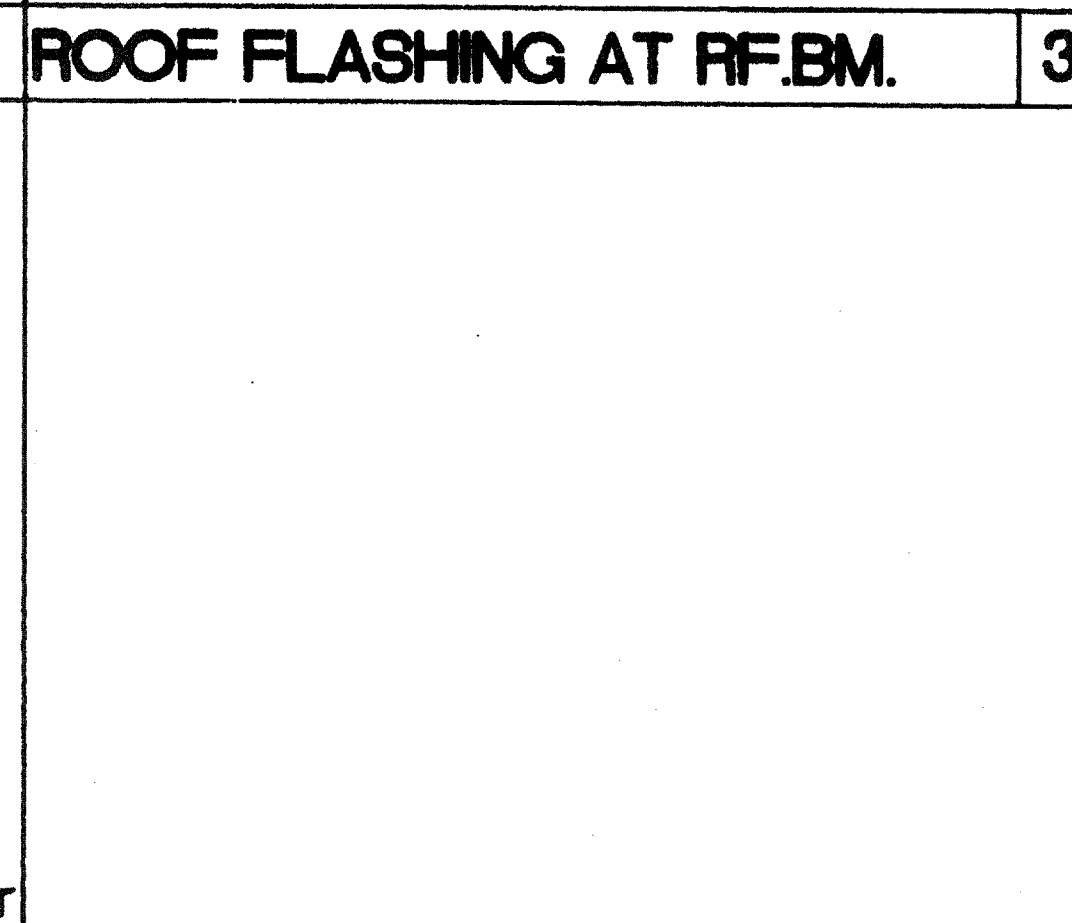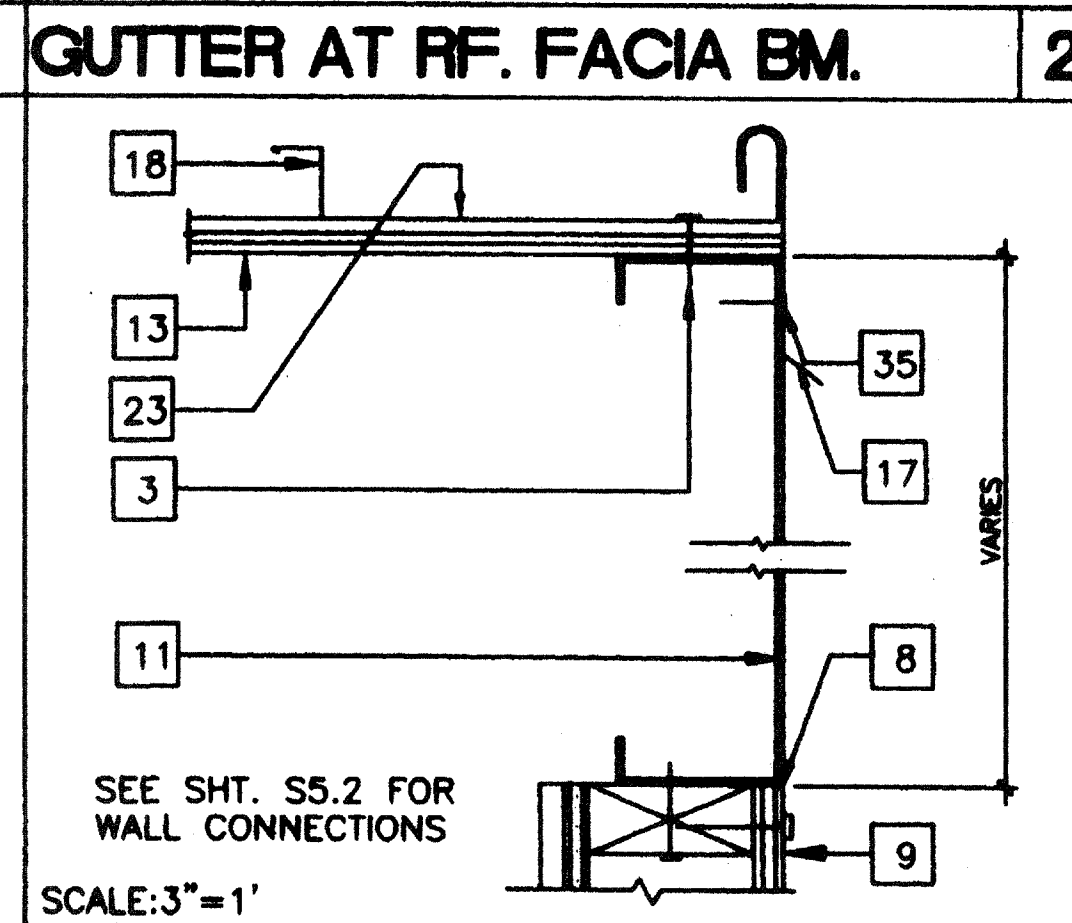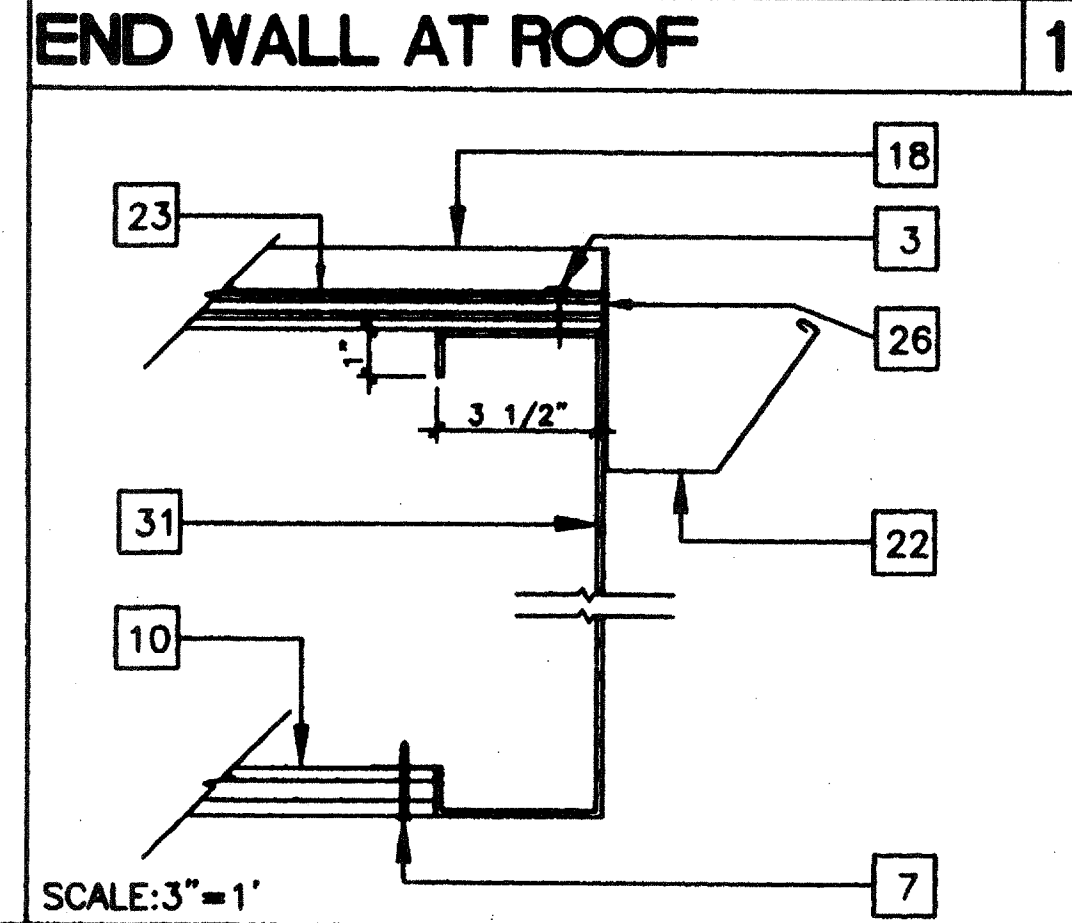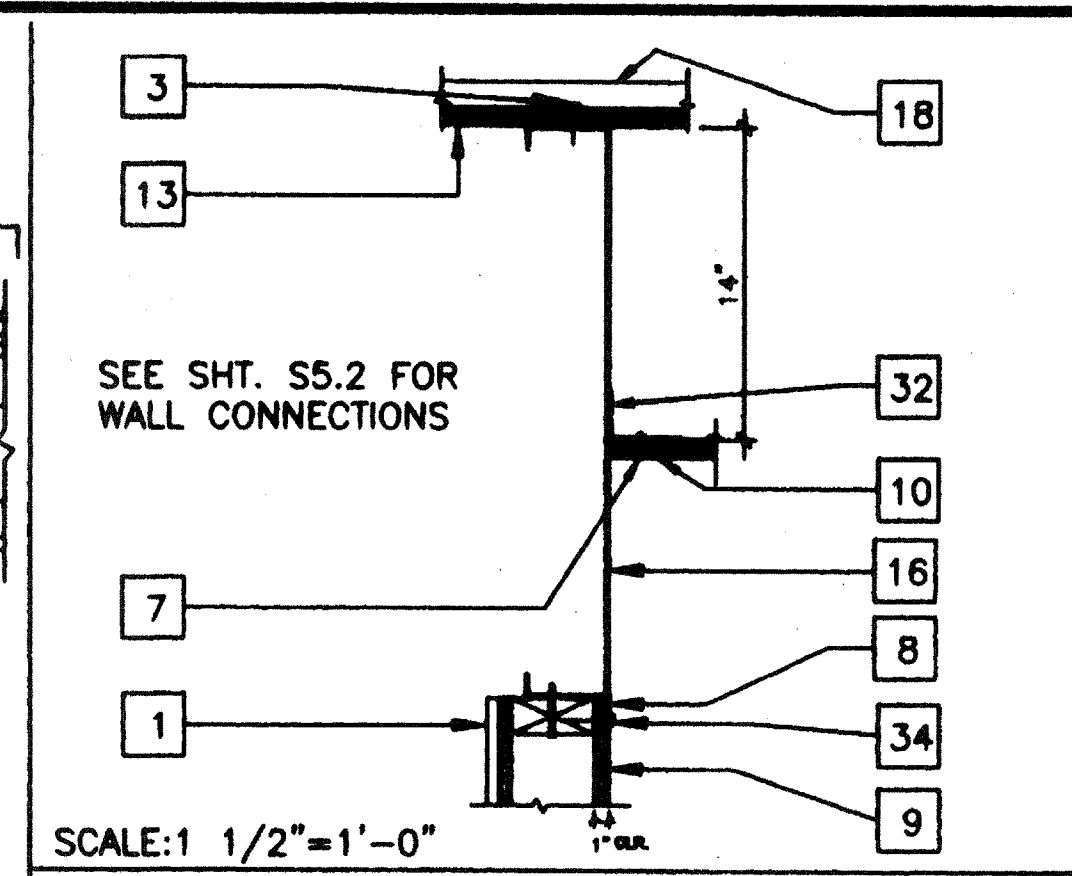


		DOWNSPOUT ATTACHMENT	8				
		CONTIN'S GUTTER	9	ROOF CAP AT SEP.	5	GUTTER AT RF. FACIA BM.	2
		CONTIN'S GUTTER AT BEND	10	ROOF CLIP	6	ROOF FLASHING AT RF. BM.	3
				REVISIONS	11	TYPICAL SILL AT FLOOR	7
							4

REVISIONS																																																		
<table border="1" style="width: 100%; border-collapse: collapse;"> <tr> <td style="width: 10px;">▲</td> <td style="width: 10px;"> </td> <td style="width: 10px;"> </td> <td style="width: 10px;"> </td> <td style="width: 10px;"> </td> <td style="width: 10px;"> </td> <td style="width: 10px;"> </td> <td style="width: 10px;"> </td> <td style="width: 10px;"> </td> <td style="width: 10px;"> </td> </tr> <tr> <td>▲</td> <td> </td> <td> </td> <td> </td> <td> </td> <td> </td> <td> </td> <td> </td> <td> </td> <td> </td> </tr> <tr> <td>▲</td> <td> </td> <td> </td> <td> </td> <td> </td> <td> </td> <td> </td> <td> </td> <td> </td> <td> </td> </tr> <tr> <td>▲</td> <td> </td> <td> </td> <td> </td> <td> </td> <td> </td> <td> </td> <td> </td> <td> </td> <td> </td> </tr> <tr> <td>▲</td> <td> </td> <td> </td> <td> </td> <td> </td> <td> </td> <td> </td> <td> </td> <td> </td> <td> </td> </tr> </table>	▲										▲										▲										▲										▲									
▲																																																		
▲																																																		
Electrical Engineer's Seal 	Mechanical Engineer's Seal 	Structural Engineer's Seal 	Architects Seal 	Division of the State Architect 	<p>MODTECH INC. 2830 BARRETT AVENUE PERRIS, CALIF. 92572 PH (909) 943-4014 FAX (909) 940-0427</p>
--------------------------------	--------------------------------	--------------------------------	---------------------	-------------------------------------	--

PROJECT NUMBER: 2986	© MODTECH, INC. 1997	drawn by: 4012-088 checked by: 05 JAN 99 date: 05 JAN 99 project no: 2986 MODTECH Index No.
ARCHITECTURAL DETAILS		A6.1

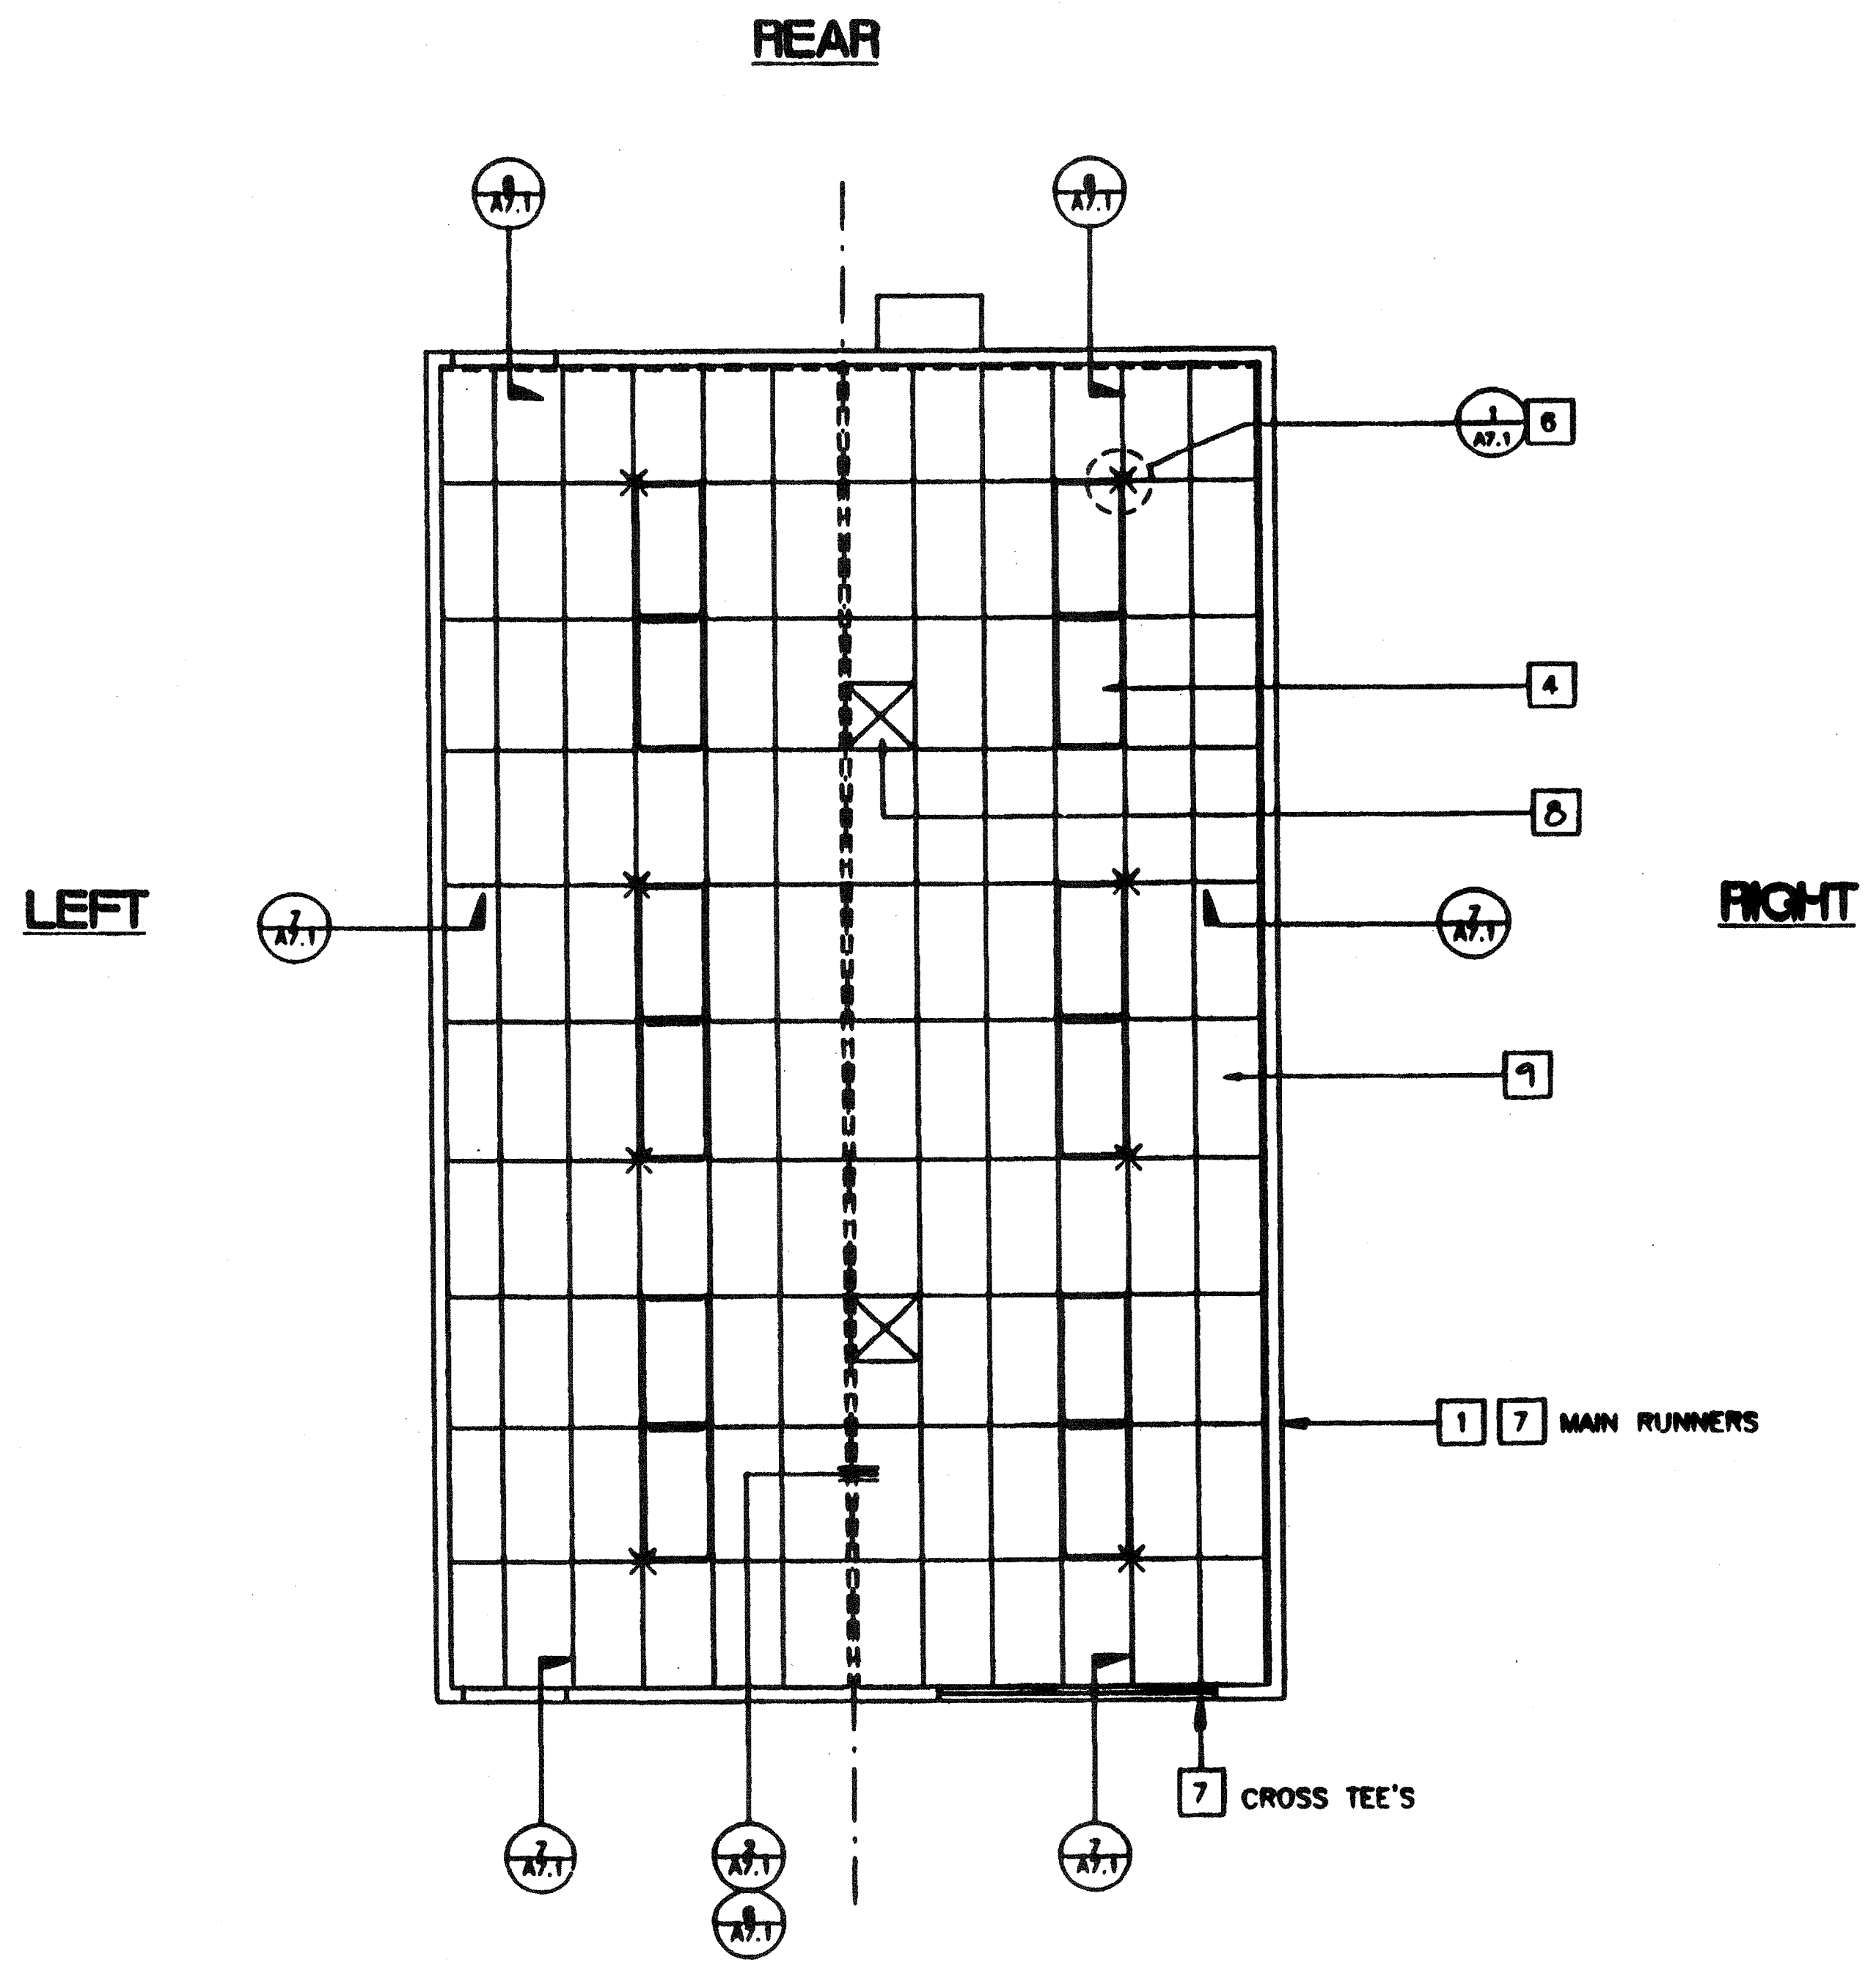

KEY NOTES

- 1 MAIN RUNNERS • 4'-0" W/12GA. HANGER WIRES • END OF EACH RUNNER.
- 2 NOT USED
- 3 NOT USED
- 4 PROVIDE 2-12GA. SLACK WIRES TO HOUSING OF ALL LIGHT FIXTURES AT DIAGONAL CORNERS. WIRES SHALL BE ATTACHED TO STRUCTURE OF LIGHT FIXTURES: 2" X 4" RECESSED, ATTACH FIXTURE TO GRID W/1-#8 SHEET METAL SCREW AT EACH CORNER.
- 5 NOT USED
- 6 CEILING AREAS SHALL HAVE 4-WAY SPLAYS PER DETAIL 1 ON SHEET A7.1 IN LOCATIONS INDICATED ON DRAWING WIRES TAUT BUT NOT TO DISTORT GRID.

T-BAR PART NUMBERS

	APPROXIMATE PA-DIM	APPROXIMATE W/THICK	W/THICK
RUNNER	7301	200	DS 26
4" CROSS	7342	1210	DX 422
2" CROSS	7328	1226	DX 216
WALL ANGLE	7800	1420-01	M-7

- 7
- 8 REGISTERS SHALL BE POSITIVELY ATTACHED W/4-10GA SHEET METAL SCREWS. (TYP. 1- • EA. CORNER)
- 9 CEILING PANELS: 2 X 4 LAY-IN PANELS. ASTM FLAME SPREAD CLASS 1 (0-25). FLAME SPREAD SMOKE DEVELOPMENT DENSITY LESS THAN 450 (TYP.)

NOTES

- 1. AT THE END OF ROWS OF RUNNERS A 12GA. HANGER WIRE SHALL BE ATTACHED WITHIN 8" OF WALL OR SOFFIT.
- 2. VERTICAL WIRES MORE THAN 1-IN-8 OUT OF PLUMB SHALL HAVE COUNTERBRACING WIRES
- 3. RUNNERS MAY BE ATTACHED TO WALLS OR MOLD AT 2-ADJACENT WALLS. OTHER WALLS NO ATTACHMENT. CLEARANCE OF 1/2" BETWEEN END OF RUNNERS AND FACE OF WALL.
- 4. DUCTWORK SHALL BE RIGIDLY ATTACHED TO BUILDING AND SHALL NOT BE CLOSER THAN 6" TO HANGER WIRES.

LEGEND

- T & T BAR CEILING
- 2' X 4' ELEC. FIXTURE RECESSED
- SUPPLY AIR DIFFUSER
- SPLAY WIRE
- INDICATES FIXED SIDE (SEE DETAIL 7/A7.1)
- INDICATES FREE SIDE (SEE DETAIL 6/A7.1)

IDENTIFICATION STAMP
 DIV. OF THE STATE ARCHITECT
 OFFICE OF REGULATION SERVICES
 DATE JAN 07 1999

REFLECTED CEILING PLAN

24' X 40'

SCALE 1/4"=1'-0"

REVISED


REVISIONS

Professional seals for Electrical, Mechanical, Structural, and Architectural engineers, along with the State Architect's stamp and Modtech Inc. logo.


MODTECH INC.
 2830 BARRETT AVENUE
 PERRIS, CALIF. 92572
 PH (909) 943-4014
 FAX (909) 940-0427

PROJECT NUMBER 2986
 APP#3 117168
 AC / FLS / SS / TN


© MODTECH, INC. 1997
 DIV. OF THE STATE ARCHITECT
 drawn by 4012-088
 checked by 05 JAN 99
 PROJECT no. 2986
A7.0

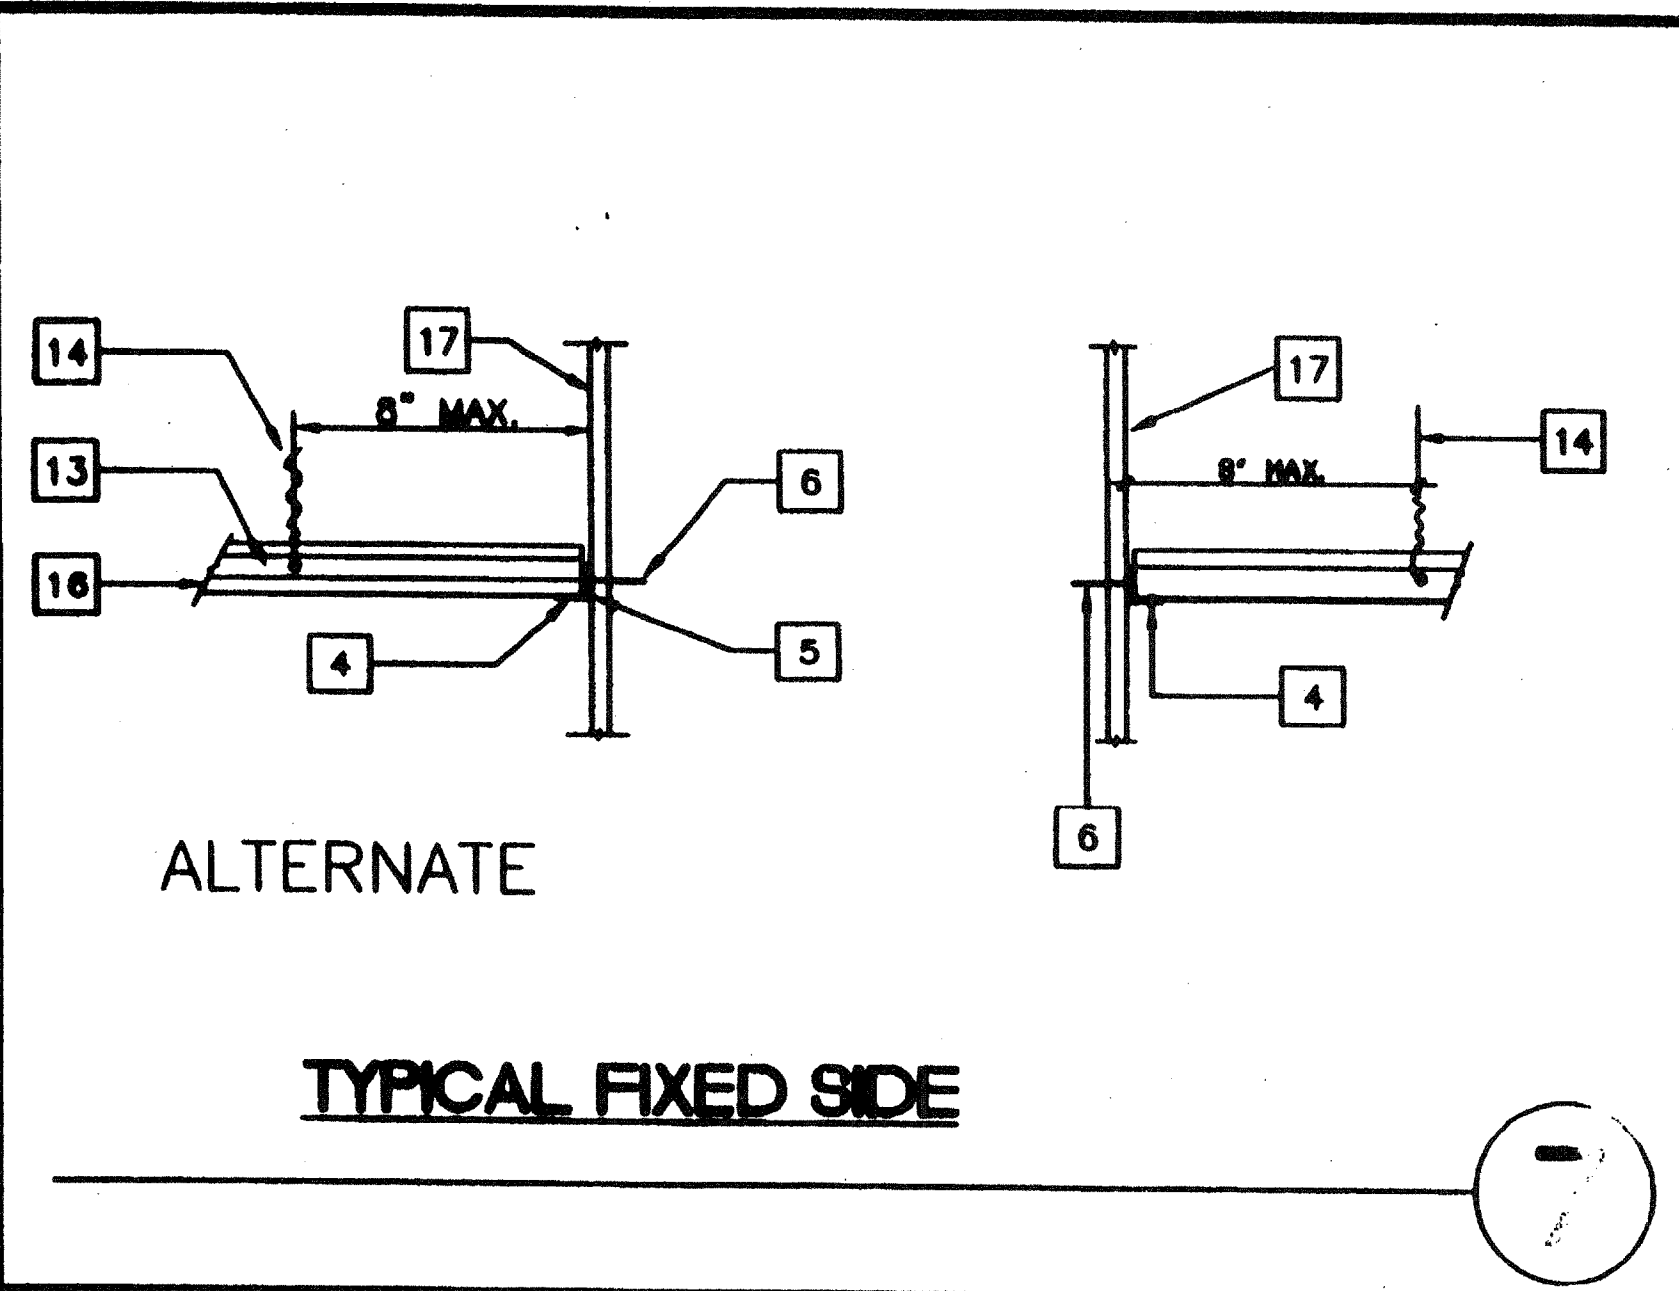


7

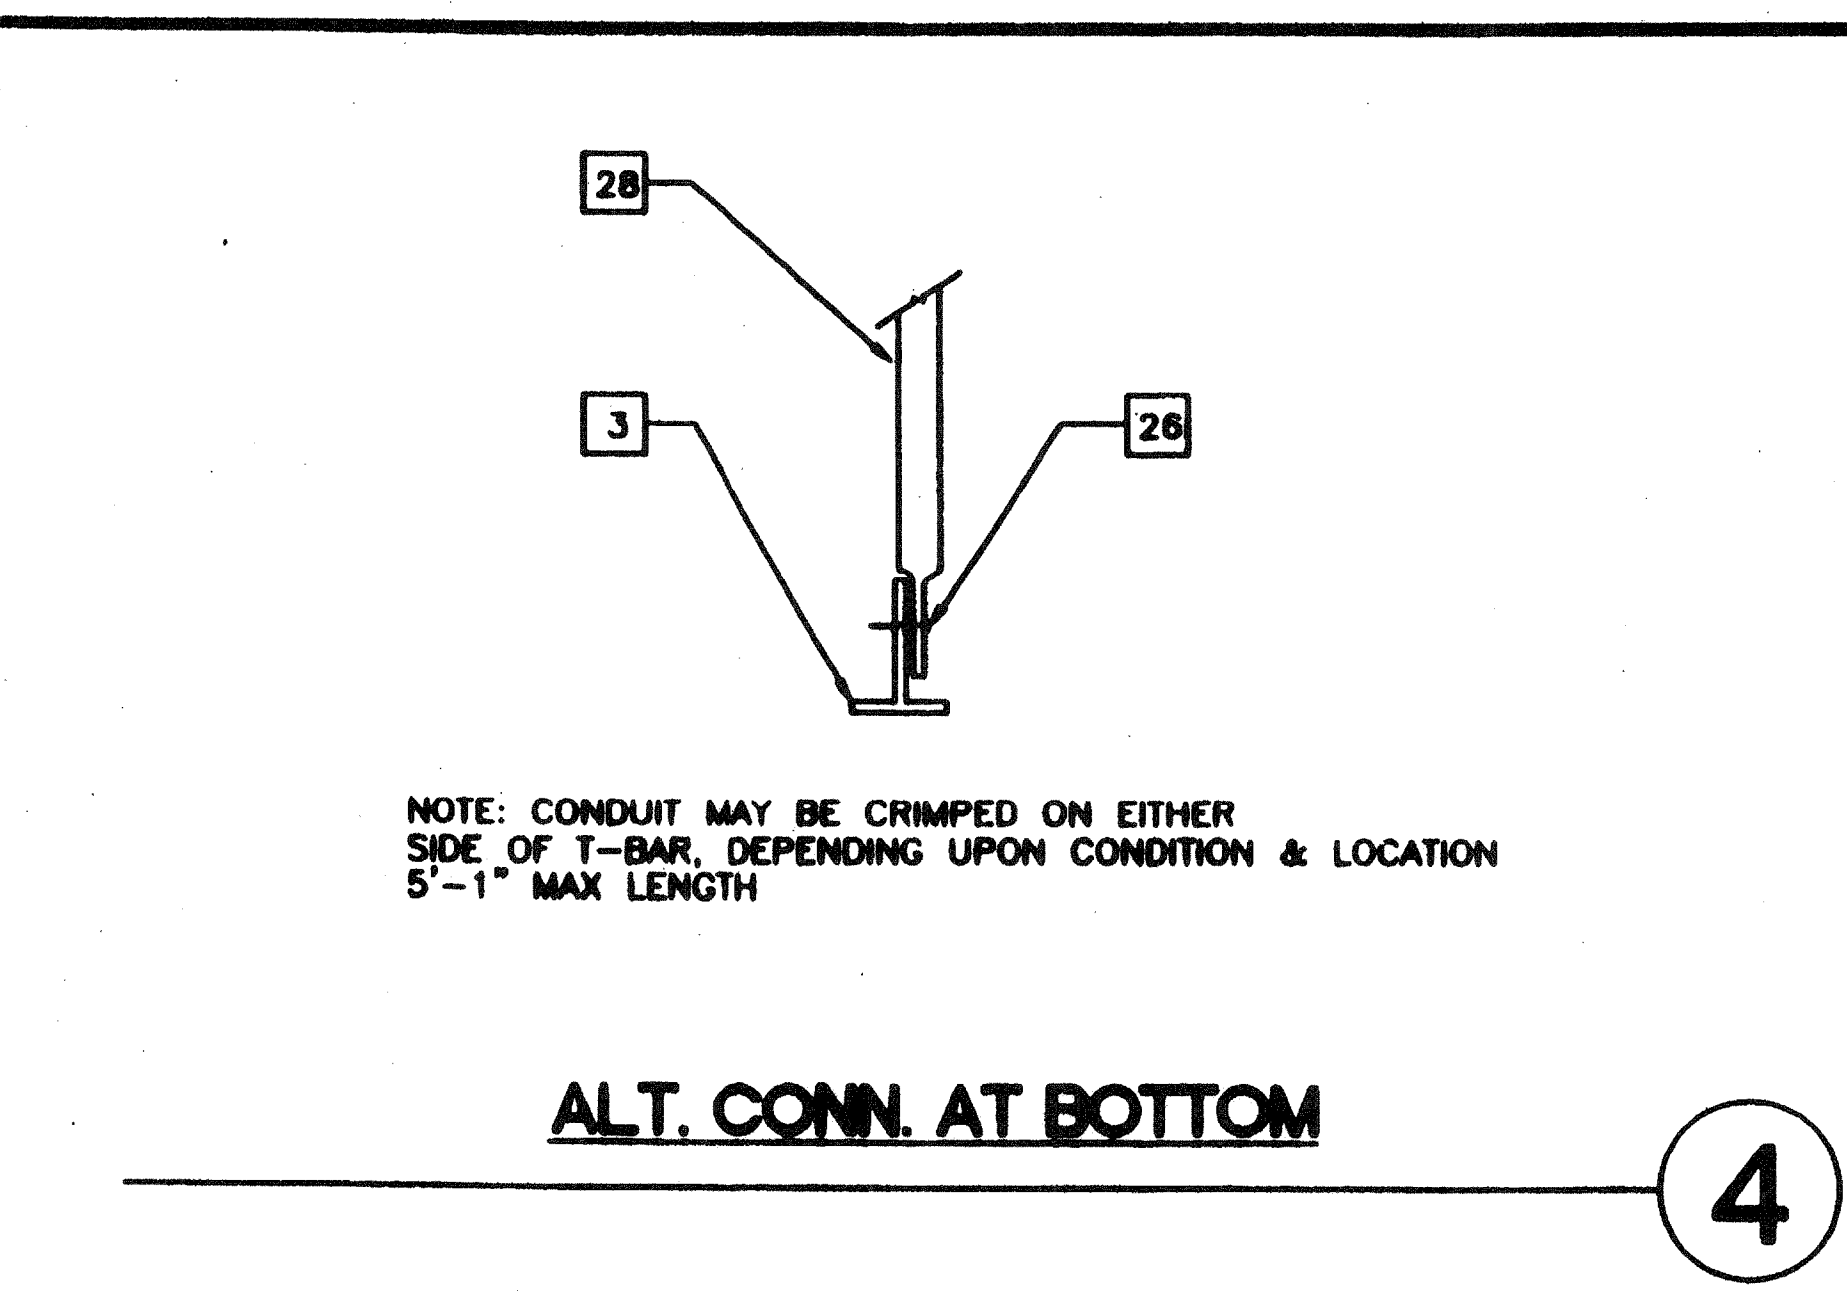


4

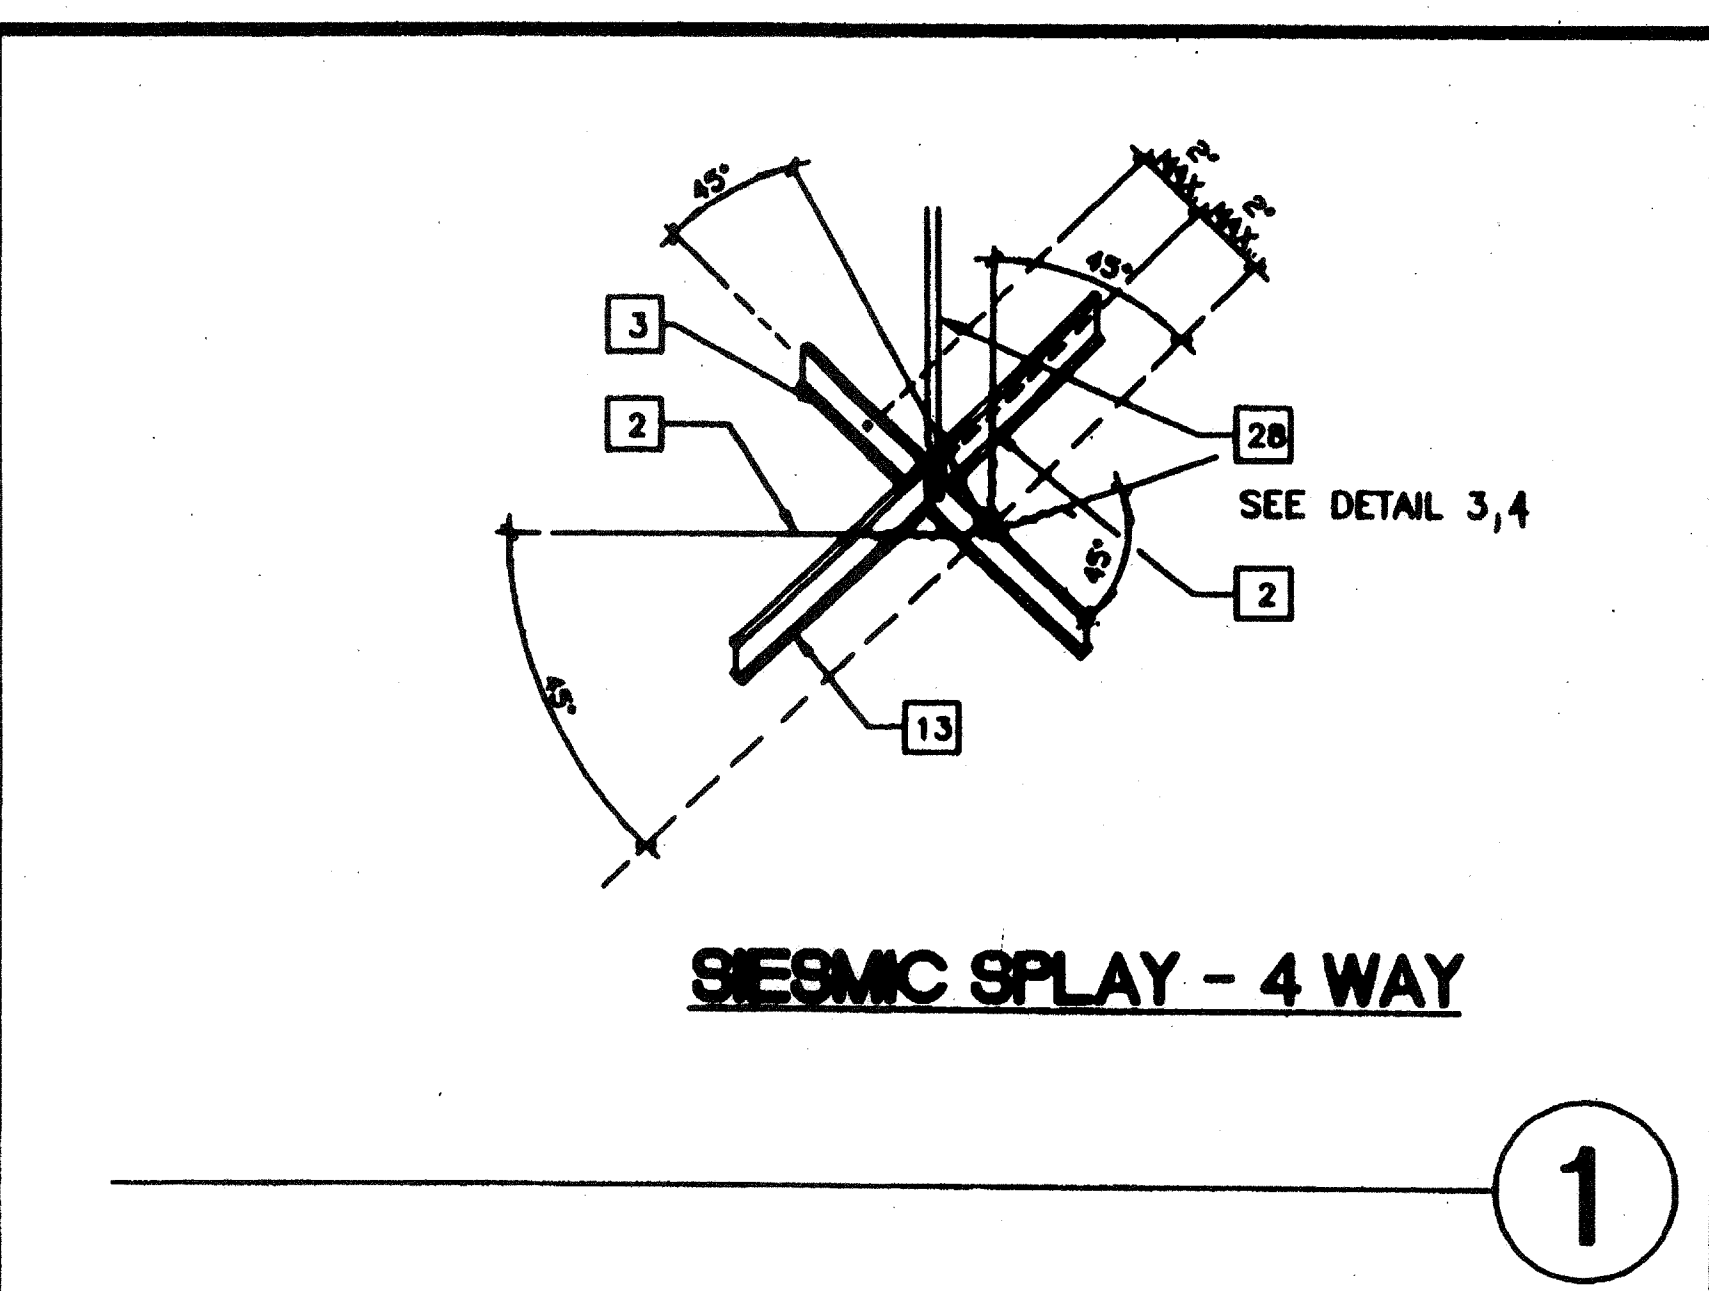


1

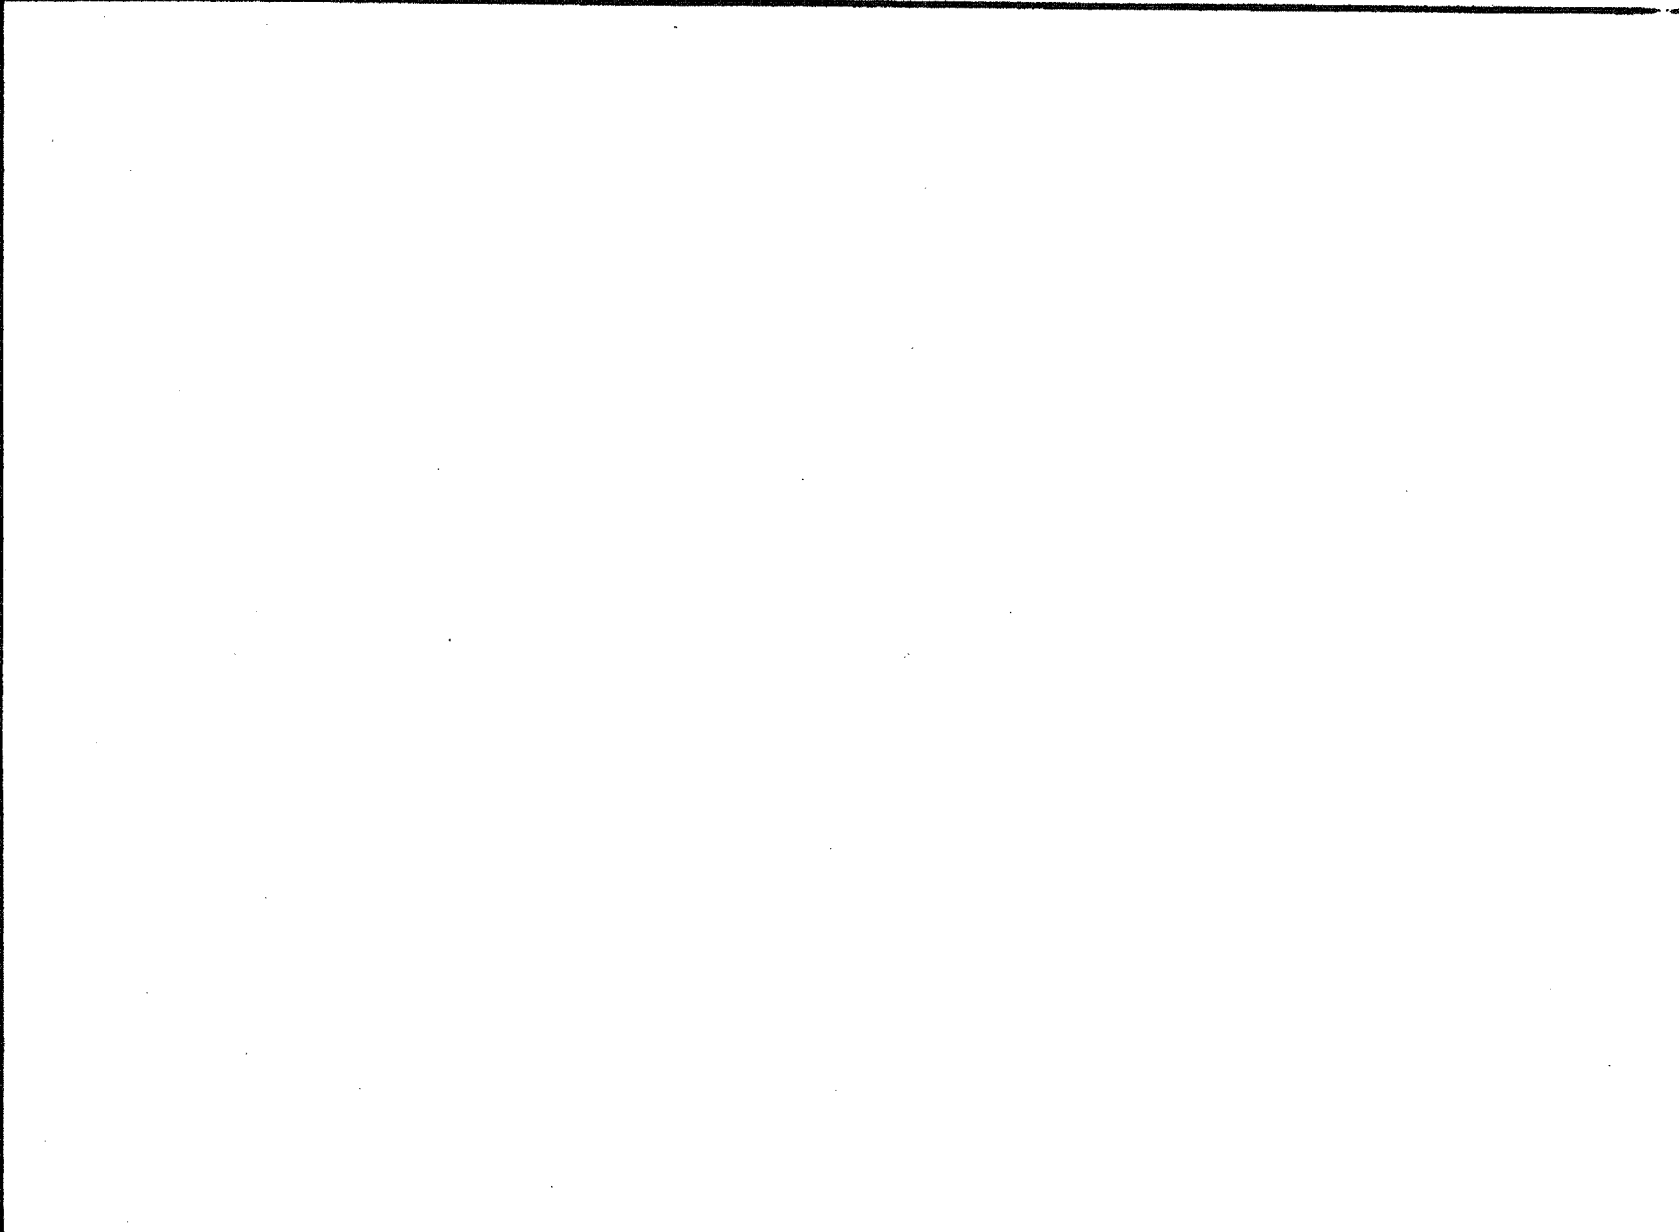


5

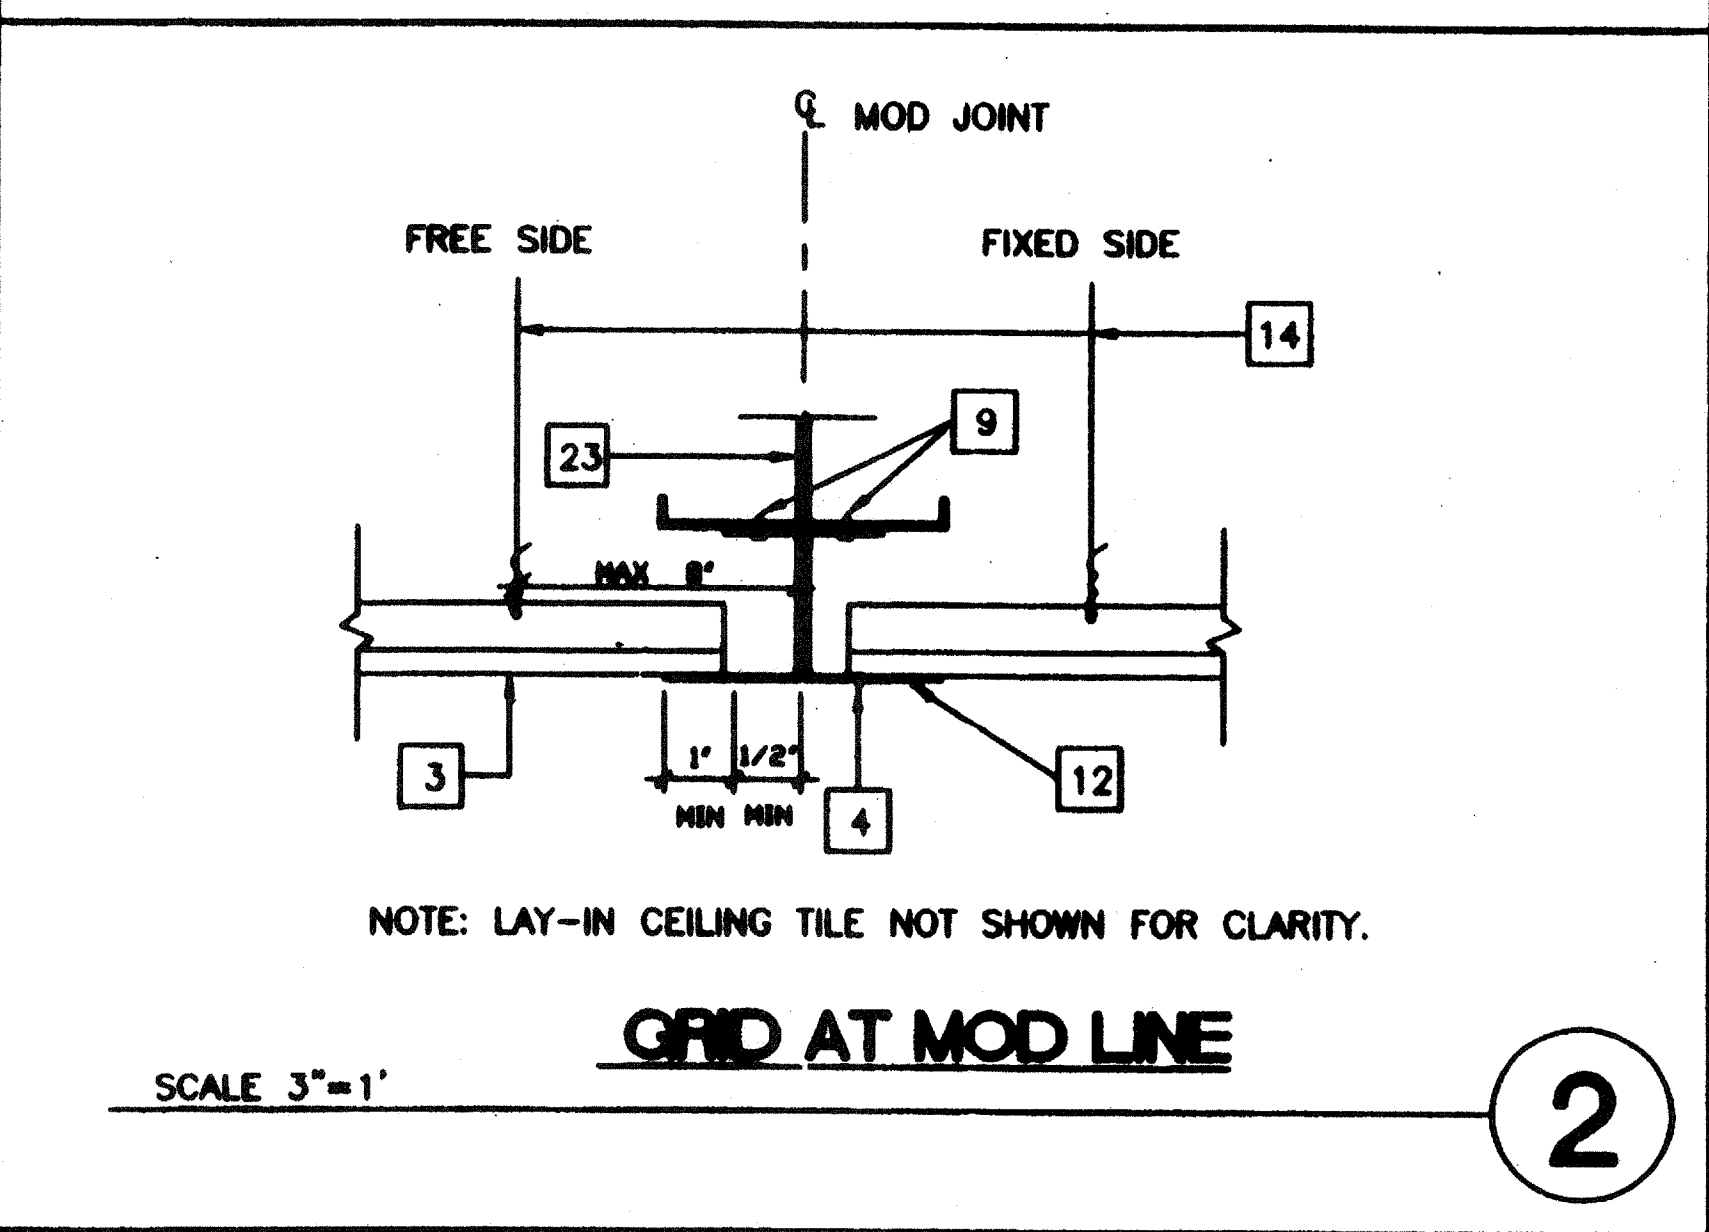

2


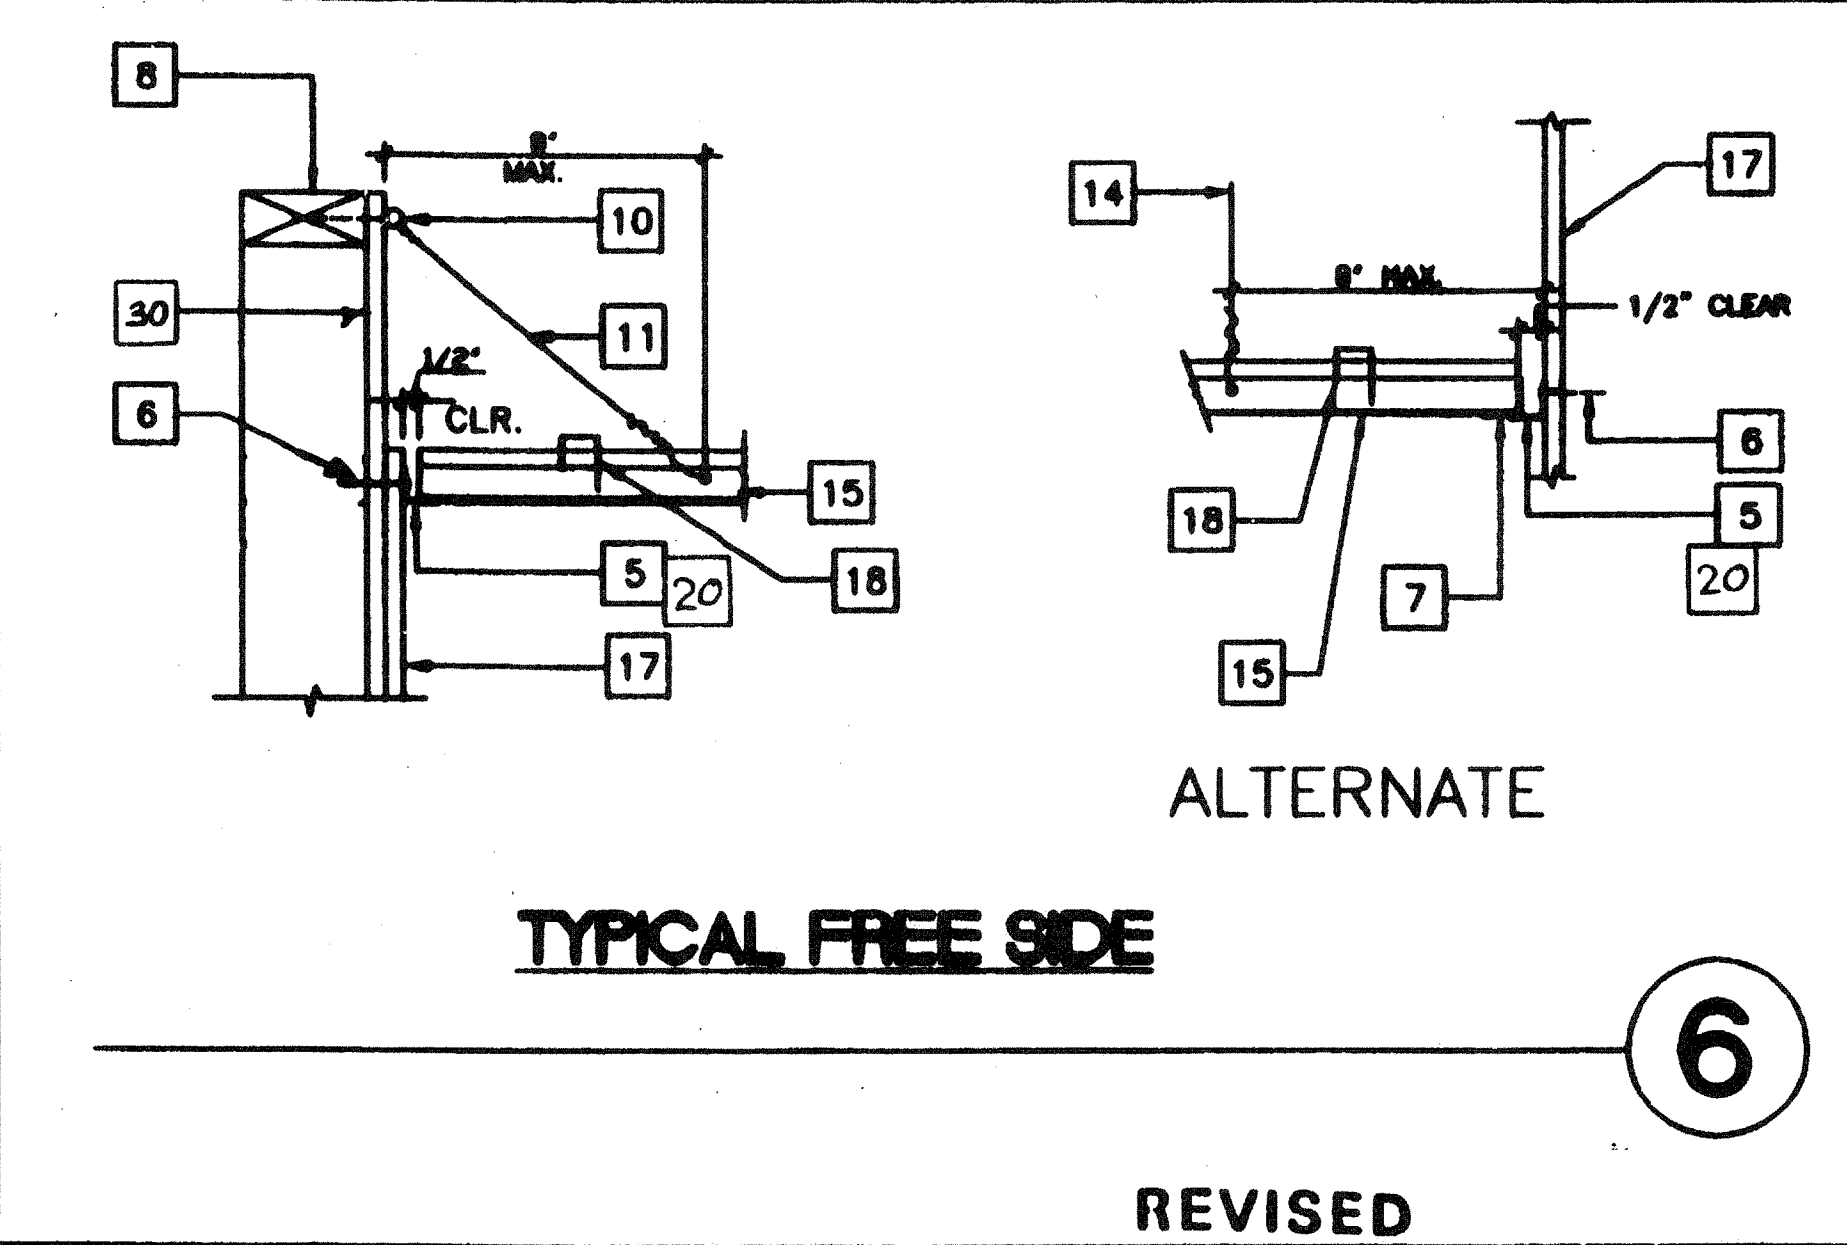


6

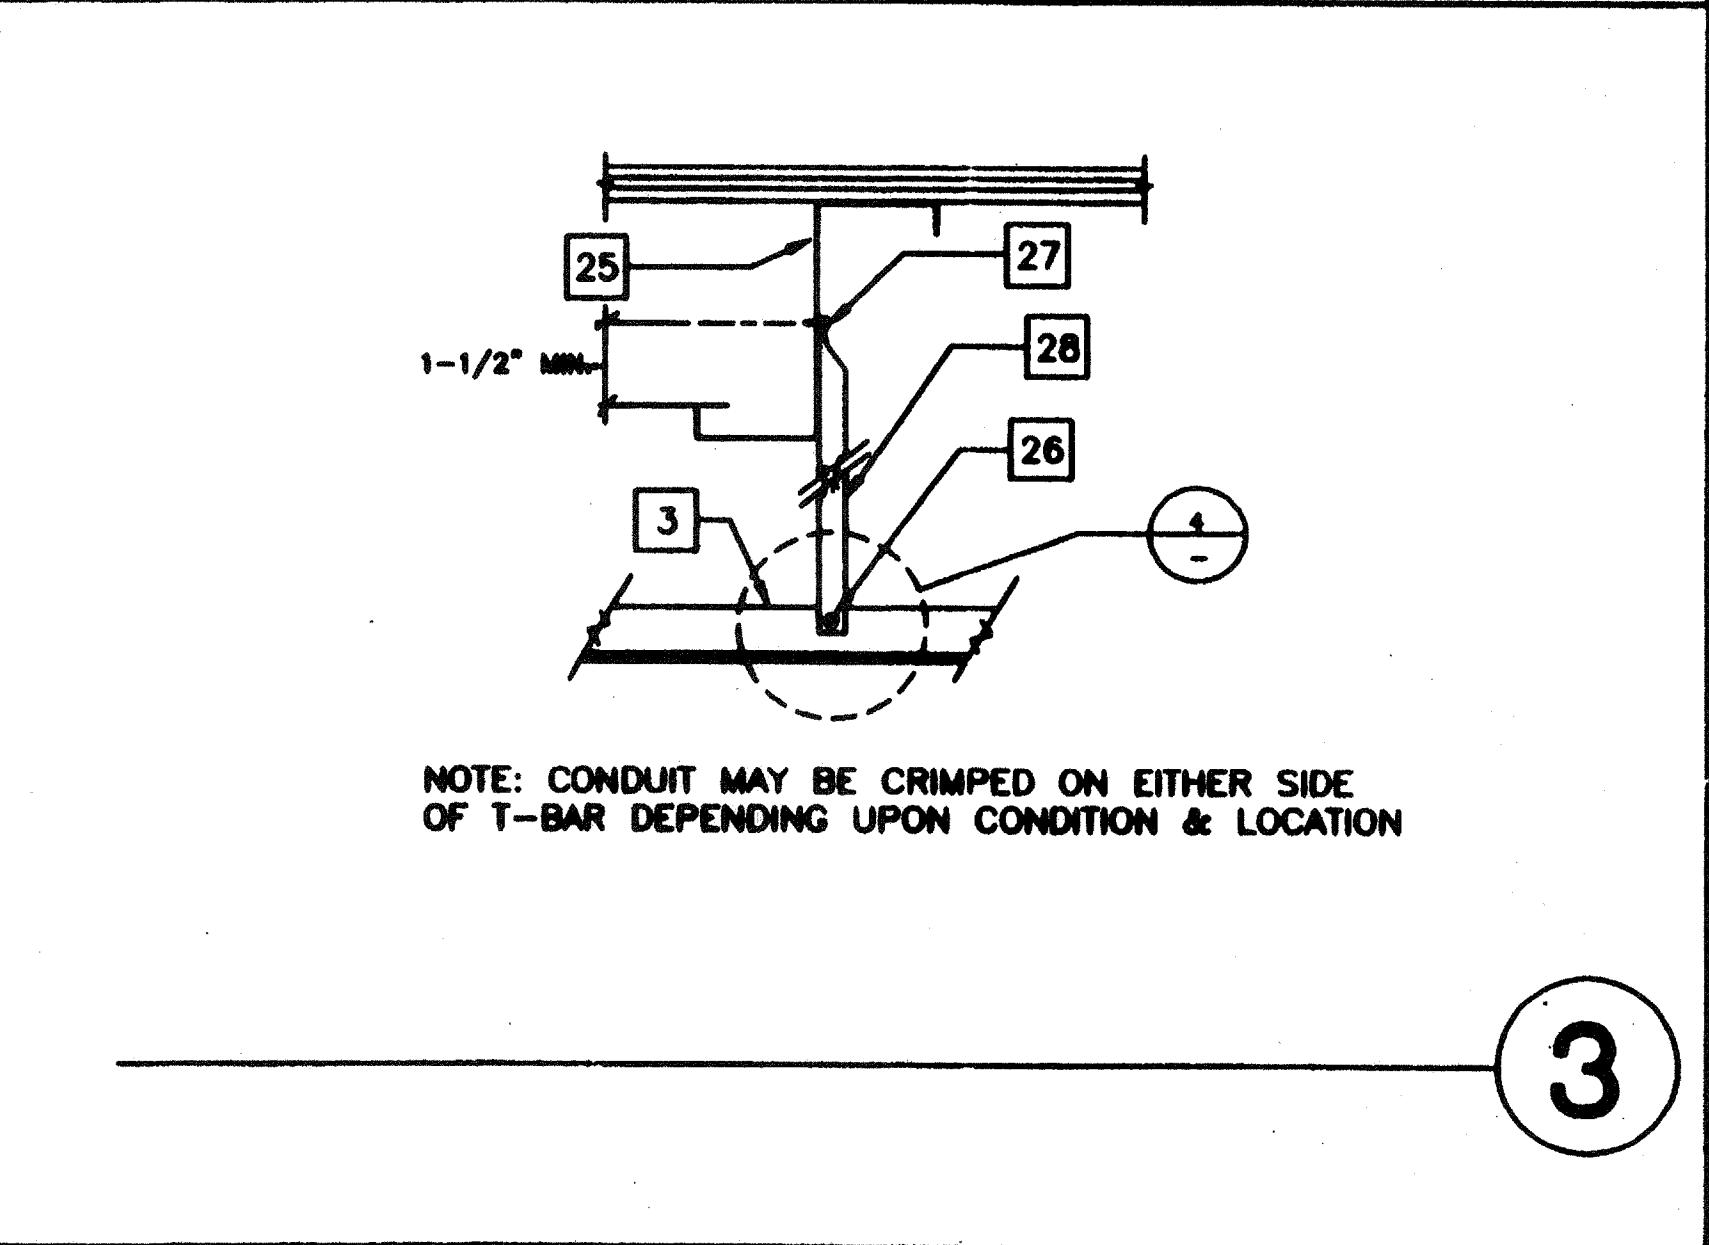

3

- ### KEY NOTES
- 1 12GA. HANGER WIRE @ 4'-0" O.C. IN PUNCHED OR DRILLED HOLE
 - 2 12GA. WIRE WITH 4 WRAPS IN 1 1/2" (TYP.) WIRE TO RUN PERPENDICULAR TO MAIN TEE
 - 3 MAIN RUNNER
 - 4 1/8" POP RIVET TO EACH T-BAR
 - 5 WALL ANGLE
 - 6 6d 16" FRAMING TO WALL STUD
 - 7 ANGLE WITH 1/8" POP RIVET TO EACH T-BAR NO CONNECTION TO WALL ANGLE
 - 8 TOP PLATE
 - 9 #10 S.T.S.M.S. @ 4' O.C.
 - 10 3"x1/4" EYED SCREW W/2" EMBEDMENT
 - 11 HANGER TO WALL WHERE NO RAFTER ABOVE MAX SLOPE 1" IN 6"
 - 12 26 GA. REFLECTED CEILING MOUNT X 2" C
 - 13 CROSS TEE
 - 14 12GA. HANGER WIRE AT THE END ON EACH RUNNER MIN. 4 WRAPS IN MAX 1 1/2"
 - 15 MAIN RUNNERS OR CROSS TEES
 - 16 ACOUSTICAL BOARD
 - 17 FINISH WALL
 - 18 HORIZONTAL STRUTS SHALL RUN CONTINUOUS AT ALL PERIMETERS, NOT POP RIVETED TO THE WALL ANGLE ARMSTRONG #7425 OR #7445 WITH SPRING STEEL SNAP TO RUNNER PER IR 47-4
 - 19 NOT USED
 - 20 NO POP RIVETS
 - 21 NOT USED
 - 22 NOT USED
 - 23 NOT USED
 - 24 NOT USED
 - 25 ROOF PURLIN
 - 26 CRIMP CONDUIT AND ATTACH TO T-BAR GRID W/#8 TEKSCREWS
 - 27 CRIMP CONDUIT TO RAFTER W/2-#8 TEKSCREW
 - 28 3/4" E.M.T. CONDUIT
 - 29 NOT USED
 - 30 EXTEND GYP BRD TO ROOF

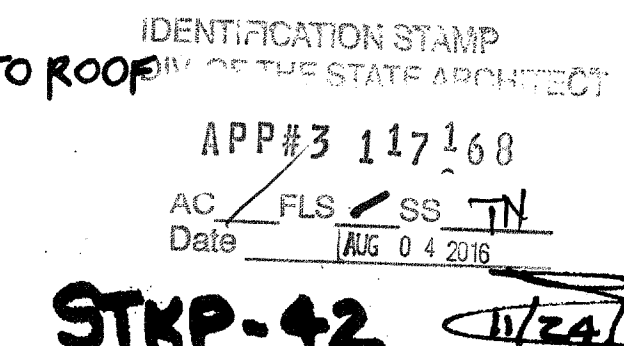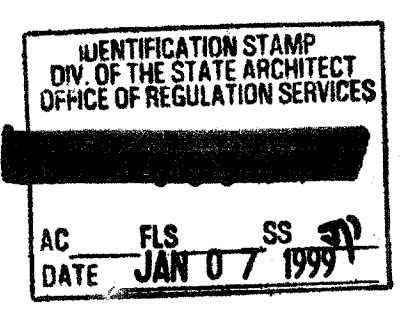

REVISIONS	Electrical Engineer's Seal	Mechanical Engineer's Seal	Structural Engineer's Seal	Architect's Seal	Division of the State Architect	MODTECH INC.	PROJECT NUMBER:	© MODTECH, INC. 1997	drawn by:
							2986		1012-088
									05 JAN 99


Electrical Engineer's Seal

Mechanical Engineer's Seal

Structural Engineer's Seal

Architect's Seal

Division of the State Architect

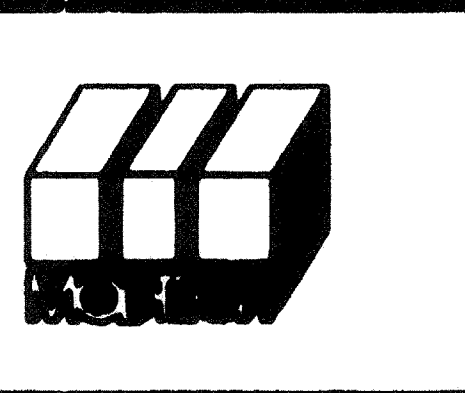

MODTECH INC.
2830 BARRETT AVENUE
PERRIS, CALIF. 92572
PH (909) 943-4014
FAX (909) 940-0427

PROJECT NUMBER: 2986

© MODTECH, INC. 1997

drawn by: 1012-088
checked by: 05 JAN 99
date: 05 JAN 99
project no: 2986

REFLECTED CEILING DETAILS

A7.1

FILE # P286 A7.1.DWG

PROJECT NO. PC-286

CLASS LEASING, LLC.

1221 Harley Knox Blvd. Perris, CA 92571-7408
(951) 943-1908 Fax (951) 943-5768

SPECIFICATIONS RELOCATABLE CLASSROOMS

3.01 CARPENTRY:

1. **Scope of Work:** Contractor shall provide all labor, materials and services to install carpentry.

2. Workmanship:

- FRAMING: securely nailed, bridged and blocked to form rigid structure. Work cut, fitted and assembled level, plumb and true to line. Trim in as long lengths as possible with all standing trim in one piece. Trim sealed at all edges.
- NAILING: in accordance with the title 24 CCR-Table 2304.9.1. Nails shall be corrosion resistant box nails.
- Machine applied nailing shall have prior demonstration and approval by DSA Field Inspector and the Architect. The approval is subject to continuous satisfactory performance. Plywood shall have a minimum thickness of 3/8". If nail heads penetrate the outer ply more than would be normal for a hand hammer or if minimum allowable edge distances are not maintained, the performance will be deemed unsatisfactory.
- TRIM: sealed at all edges. Sealant painted to match trim or siding.

4.01 MATERIAL SPECIFICATIONS:

- Structural framing shall be Hem Fir-Larch graded in accordance with the standard grading rules of the Western Wood Products Association or standard grading rules No. 16 of the West Coast Lumber Inspection Bureau, latest editions. Grades shall be as follows unless noted otherwise on the drawings. (Hem Fir South is not allowed). Each piece shall be grade marked and no piece may fall below grades indicated. All framing except as noted Hem Fir No. 2
- Plywood shall be as shown on these drawings with exterior glue in accordance with U.S. Product Standard PS 1-07. All panels shall be marked with an APA grade mark with an identification index as shown on drawings. Use 4'x8' panels minimum, except at boundaries and at framing changes where minimum panel dimension shall be 24" at roofs and 80" and 12" at walls.
- Bolts for timber connections shall conform to ANSI/ASME Standard B18.2.1-2012 & 2012 edition of NDS (the National Design Specification for Wood Construction by the National Forest Products Association). Bolts shall be installed in accordance with the requirement of 2012 NDS. Bolt holes shall be 1/32 to 1/16 inch larger than bolt diameter. Bolts shall be full body steel bolts with minimum yield strength of 45,000 PSI. Re-tighten bolts before closing in work.
- Lag screws shall be steel and conform to ANSI/ASME Standard B18.2.1 and 2012 NDS. Holes for lag screw shanks shall be bored the same depth and diameter as the shank. The remaining depth of penetration of the screw shall be bored to 70% of the shank diameter. One quarter inch (1/4") diameter lag screws need not have pre-drilled holes if it can be shown that wood members are not damaged during installation. Provide full diameter body lag screws with bending yield strengths per Table 11.4 in NDS
- Provide malleable iron washers or equivalent cut plate washers (not less than a standard cut washer) under nuts and bolt or lag screw heads which bear on wood.
- Wood screws shall conform to ANSI/ASME Standard B18.6.1 and the requirements of the 2012 NDS. Galvanized or other corrosion resistant coating where exposed to weather or used in foundations. Screws shall be steel with tensile and bending yield strengths per Table 11L in NDS.
- Wood members shall be cut or notched only as shown on structural drawings.
- When required nailing tends to split wood members, nail holes shall be pre-bored to 3/4 of the nail diameter.
- Structural nailing shall be with BOX NAILS per all requirements of 2012 NDS. Nailing not specifically indicated shall comply with CCR Title 24, Part 2, Table 2304.9.1. All nails shall be galvanized or other corrosion resistant coating where exposed to weather. In foundations and as noted on plans, per the requirements of CCR Title 24, Part 2, with minimum bending yields per Table 11N in NDS. (See nail schedule below.)
Nail equivalence:
provide minimum nail lengths as required for equivalent penetration, TYPICAL: U.N.O.)
6d equals .113" DIA. - provide 1.38" minimum point penetration
8d equals .131" DIA. - provide 1.57" minimum point penetration
- Pressure preservative treatment shall be per Section 2303.1.5, CCR Title 24, Part 2. Provide quality mark on all treated foundation members that comply with CBC 2303.1.6.1. All foundation members shall be marked as "For ground contact" or "For above ground use" as appropriate. Pressure treated material shall comply with ANPA Standard L1 as required by CBC 2303.1.8. Treat all cut ends of pressure treated members with an approved preservative. (Millard W/S Copper Green 2% or an approved equivalent). Where noted, members below the sub floor that are not a part of the foundation shall be pressure treated.
- Only material in contact with ground needs to be pressure treated, all other foundation lumber can be DF or HFW2 or equal.
- If machine nailing is utilized for this project, contractor shall comply with all requirements of CCR Title 24, Part 2. Machine nailing is subject to approval by the Structural Engineer or Architect and the Division of the State Architect.
- Fasteners for pressure-preservative treated and fire-retarded treated wood shall comply with Section 2304.9 of CBC.
- Nails and spikes used in wet or exterior locations shall comply with Section 2304.9.1.1 of CBC.
- Shim material shall be plywood CD EXP 1 or equal (not pressure treated).
- Used lumber in good condition is acceptable for use in foundation system.
- The plates shall conform to A-1011 Grade 33.

5.01 SITE INSTALLATION REQUIREMENTS FOR DSA CLASSROOM BUILDINGS:

In the case of equipment located in the State of California, the LESSEE (School District) is responsible for the site being cleared (free of grass, trees, shrubs, etc) and graded to within 4 1/2" of level grade for each building. If the site exceeds the 4 1/2" level grade requirement additional costs may be charged to lessee.

Under no circumstances should the site be greater than 9" from level grade or have less than a 1000 PSF MINIMUM SOIL BEARING PRESSURE.

Prior to delivery, the lessee shall mark the four corners of the building on the site, including door location. Should special handling be required to either place, install or relocate the classroom on the lessee's site due to site obstruction such as fencing, landscaping, other classrooms, etc., additional costs will be charge to the lessee.

6.01 TEST AND INSTALLATION:

1. Provide Electrical Grounding Test per DSA IR-1.

2. Field Welding for welded tie plate option. (If used, requires Test and Inspection.)

The example form DSA 103's shown on this sheet are for illustration purposes only. A form DSA 103 is to be completed for each application that this PC is being incorporated into and all example form DSA-103's are to be crossed out on this drawing.

3. No other tests and inspections are required.

1.01 GENERAL REQUIREMENTS:

- The requirements of the general conditions of the agreement and these General Requirements apply to the several trade sections with the same force as though fully repeated in each section.
- Name brands are indicated to establish a standard of quality. Items of equal or better quality may be substituted for the listed brand named products.

1.02 SCOPE OF WORK:

- The work consists of installing on-site, modular relocatable buildings as defined herein, shown and detailed on the drawings.
- All requirements of CCR (California Code of Regulation) Title 19 and 24 relating to inspections and verified reports shall be complied with and shall include:
 - General responsible charge of Field Administration by the Architect of Record.
 - Inspection during the course of construction by an inspector approved by DSA (Division of the State Architect) and the District Architect. The inspector shall be responsible for and approved to inspect the general construction, welding, mechanical and electrical work. Cost of these inspections shall be borne by the School District.
 - On site inspection of the building installation, electrical and utility of the building installation or connection by an inspector approved by the DSA and related by the School District.
 - Other special tests or inspections as may be required by DSA. Cost of these inspections/tests shall be borne by the School District.

1.03 WORK NOT INCLUDED:

- All on-site or off-site utilities and the connection of them to the building unless indicated on the drawings.
- All leveling, grading or other site preparation (except concrete or wood leveling strips, where Required) unless otherwise indicated on the drawings.
- Fire alarm system, program bell, clock, public address system, intercom system, TV system, computer data or any other low voltage system, unless otherwise indicated on the drawings or the lease agreement.

1.04 ACCESSIBILITY OF SITE:

The School District shall provide access to the site for the installation of the building. Removal of trees, shrubs, fencing, sidewalks, etc., necessary for move-in and removal of the buildings shall be the responsibility of the School District.

2.01 SITE ASSEMBLY:

- Scope of Work:** Contractor shall provide all labor, materials and services to prepare the building elements, transport them from the plant to the site and to complete the assembly at the site.
The condition of the site, such as drainage and soil bearing capacity, shall be the responsibility of the School District and the District Architect.
- Assembly of Elements:**
 - In a location on the site as determined by the District Architect. The contractor shall place the foundation as detailed on the drawings.
 - The elements shall be brought to the site on wheel assembly and transferred to the prepared site. Great care shall be taken to avoid damage to the elements by racking or bumping.
 - Connection of the elements together shall be done according to instructions on the drawings. Flashing, trim and other loose items shall be installed per plans and details of the original building manufacturer's drawings.

Item	Description	Test	Lab	Inspector	Date
1	SOILS	Table 1708.3			
2	CONCRETE	Table 1708.3			
3	MASONRY	Table 1708.3			
4	STEEL	Table 1708.3			
5	WELDING	Table 1708.3			
6	FIELD WELDING	Table 1708.3			
7	WOOD	Table 1708.3			
8	OTHER	Table 1708.3			

Test	By	Date	Inspector	Date
Soils				
Concrete				
Masonry				
Steel				
Welding				
Field Welding				
Wood				
Other				

Test	By	Date	Inspector	Date
Soils				
Concrete				
Masonry				
Steel				
Welding				
Field Welding				
Wood				
Other				

Test	By	Date	Inspector	Date
Soils				
Concrete				
Masonry				
Steel				
Welding				
Field Welding				
Wood				
Other				

APPLICABLE BUILDING CODES

ALL NEW WORK SHALL COMPLY AND CONFORM TO THE REQUIREMENTS OF THE 2013 CBC

2013 CALIFORNIA CODE OF REGULATIONS (CCR) As of January 01, 2014:

- 2013 CALIFORNIA BUILDING STANDARDS ADMINISTRATIVE CODE PART 1, TITLE 2 (2012 INTERNATIONAL BUILDING CODE VOLUMES 1-2 WITH 2013 CALIFORNIA AMENDMENTS)
- 2013 CALIFORNIA ELECTRICAL CODE (CEC) PART 3, TITLE 2, CCR (2011 NATIONAL ELECTRICAL CODE WITH 2013 CALIFORNIA AMENDMENTS)
- 2013 CALIFORNIA MECHANICAL CODE (CMC) PART 4, TITLE 24, CCR (2012 UNIFORM MECHANICAL CODE WITH 2013 CALIFORNIA AMENDMENTS)
- 2013 CALIFORNIA PLUMBING CODE (CPC) PART 5, TITLE 24, CCR (2012 UNIFORM PLUMBING CODE WITH 2013 CALIFORNIA AMENDMENTS)
- 2013 CALIFORNIA ENERGY CODE (CEC) PART 6, TITLE 24, CCR*
- 2013 CALIFORNIA FIRE CODE PART 9, TITLE 24, CCR (2012 INTERNATIONAL FIRE CODE WITH 2013 CALIFORNIA AMENDMENTS)
- 2013 CALIFORNIA REFERENCED STANDARDS CODE PART 12, TITLE 24, CCR TITLE 19 CCR PUBLIC SAFETY, STATE FIRE MARSHALL REGULATIONS.

DESIGN DATA:

FLOOR LIVE LOAD = 50 PSF, 50 x 20 PSF PARTITIONS, 100 PSF
ROOF LIVE LOAD = 20 PSF REDUCIBLE FOR TRIBUTARY AREA
WIND SPEED = 120 MPH (V) (3 SECOND GUST), Kz = 1.0
SNOW LOAD: PROJECT IS NOT LOCATED IN A SNOW REGION.
BUILDING CODES = 2012 IBC AND CBC 2013

SEISMIC DESIGN DATA:

Basic Seismic-Force-Resisting System = STEEL MOMENT FRAME
ANALYSIS PROCEDURE USED = EQUIVALENT LATERAL FORCE
Seismic Design Category = E (per CBC Section 1013A.6.6)
Design Base Shear: 2840 BUILDING = 3480 # (Roof, Floor, Walls & Partitions)
2840 BUILDING = 1492 # (Roof, Floor, Walls & Partitions)
4840 BUILDING = 1820 # (Roof, Floor, Walls & Partitions)

S = 1.0 Csa = 0.411 R = 3.5 SITE CLASS = D
Sa = 2.7 mapped value / 0.8 Sa = 2.16 (Per Design)
S1 = 1.3 per CBC Figure 1013A.6.2 S1 = 1.3 To Approval

MOMENT FRAME PC'S

Basic Seismic-Force-Resisting System = WOOD PANEL SHEAR WALLS
ANALYSIS PROCEDURE USED = EQUIVALENT LATERAL FORCE
Seismic Design Category = E (per CBC Section 1013A.6.6)
Design Base Shear: 2840 BUILDING = 3480 # (Roof, Floor, Walls & Partitions)
2840 BUILDING = 1492 # (Roof, Floor, Walls & Partitions)
4840 BUILDING = 1820 # (Roof, Floor, Walls & Partitions)

S = 1.0 Csa = 0.222 R = 6.5 SITE CLASS = D p = 1.3
Sa = 2.7 mapped value / 0.8 Sa = 2.16 (Per Design)
S1 = 1.3 per CBC Figure 1013A.6.2 S1 = 1.3 To Approval

ROOF WALL PC'S

Basic Seismic-Force-Resisting System = WOOD PANEL SHEAR WALLS
ANALYSIS PROCEDURE USED = EQUIVALENT LATERAL FORCE
Seismic Design Category = E (per CBC Section 1013A.6.6)
Design Base Shear: 2840 BUILDING = 3480 # (Roof, Floor, Walls & Partitions)
2840 BUILDING = 1492 # (Roof, Floor, Walls & Partitions)
4840 BUILDING = 1820 # (Roof, Floor, Walls & Partitions)


S = 1.0 Csa = 0.222 R = 6.5 SITE CLASS = D p = 1.3
Sa = 2.7 mapped value / 0.8 Sa = 2.16 (Per Design)
S1 = 1.3 per CBC Figure 1013A.6.2 S1 = 1.3 To Approval

LIMITATIONS FOUNDATION PC ONLY:

FOUNDATION ONLY PC IS DESIGNED TO SUPPORT THE SUPERSTRUCTURE FOR THE RELOCATABLE BUILDINGS AS LISTED ON THIS DRAWING.

THE DESIGN CALCULATIONS ARE BASED ON THE FOLLOWING:

- DSA APPROVED STOCKPILE BUILDINGS
- ROOF OVERHANGS OF 6'-0" MAXIMUM
- SINGLE SLOPE OR DUAL SLOPE BUILDINGS:
WALL HEIGHT: 9'-0" MAXIMUM ON DUAL SLOPE BUILDING.
WALL HEIGHT: 10'-0" MAXIMUM ON SINGLE SLOPE BUILDING.
(HEIGHT DETERMINED FROM FINISH FLOOR IN BUILDING TO BOTTOM OF STEEL ROOF STRUCTURE: BEAMS OR ROOF HEADERS)
WALL HEIGHT: 9'-10" MAXIMUM ON SHEAR WALL-DUAL SLOPE BUILDING
- WALL DEAD LOAD OF 10 PSF (NO STUCCO)
- FLOOR DEAD LOAD OF 8 PSF

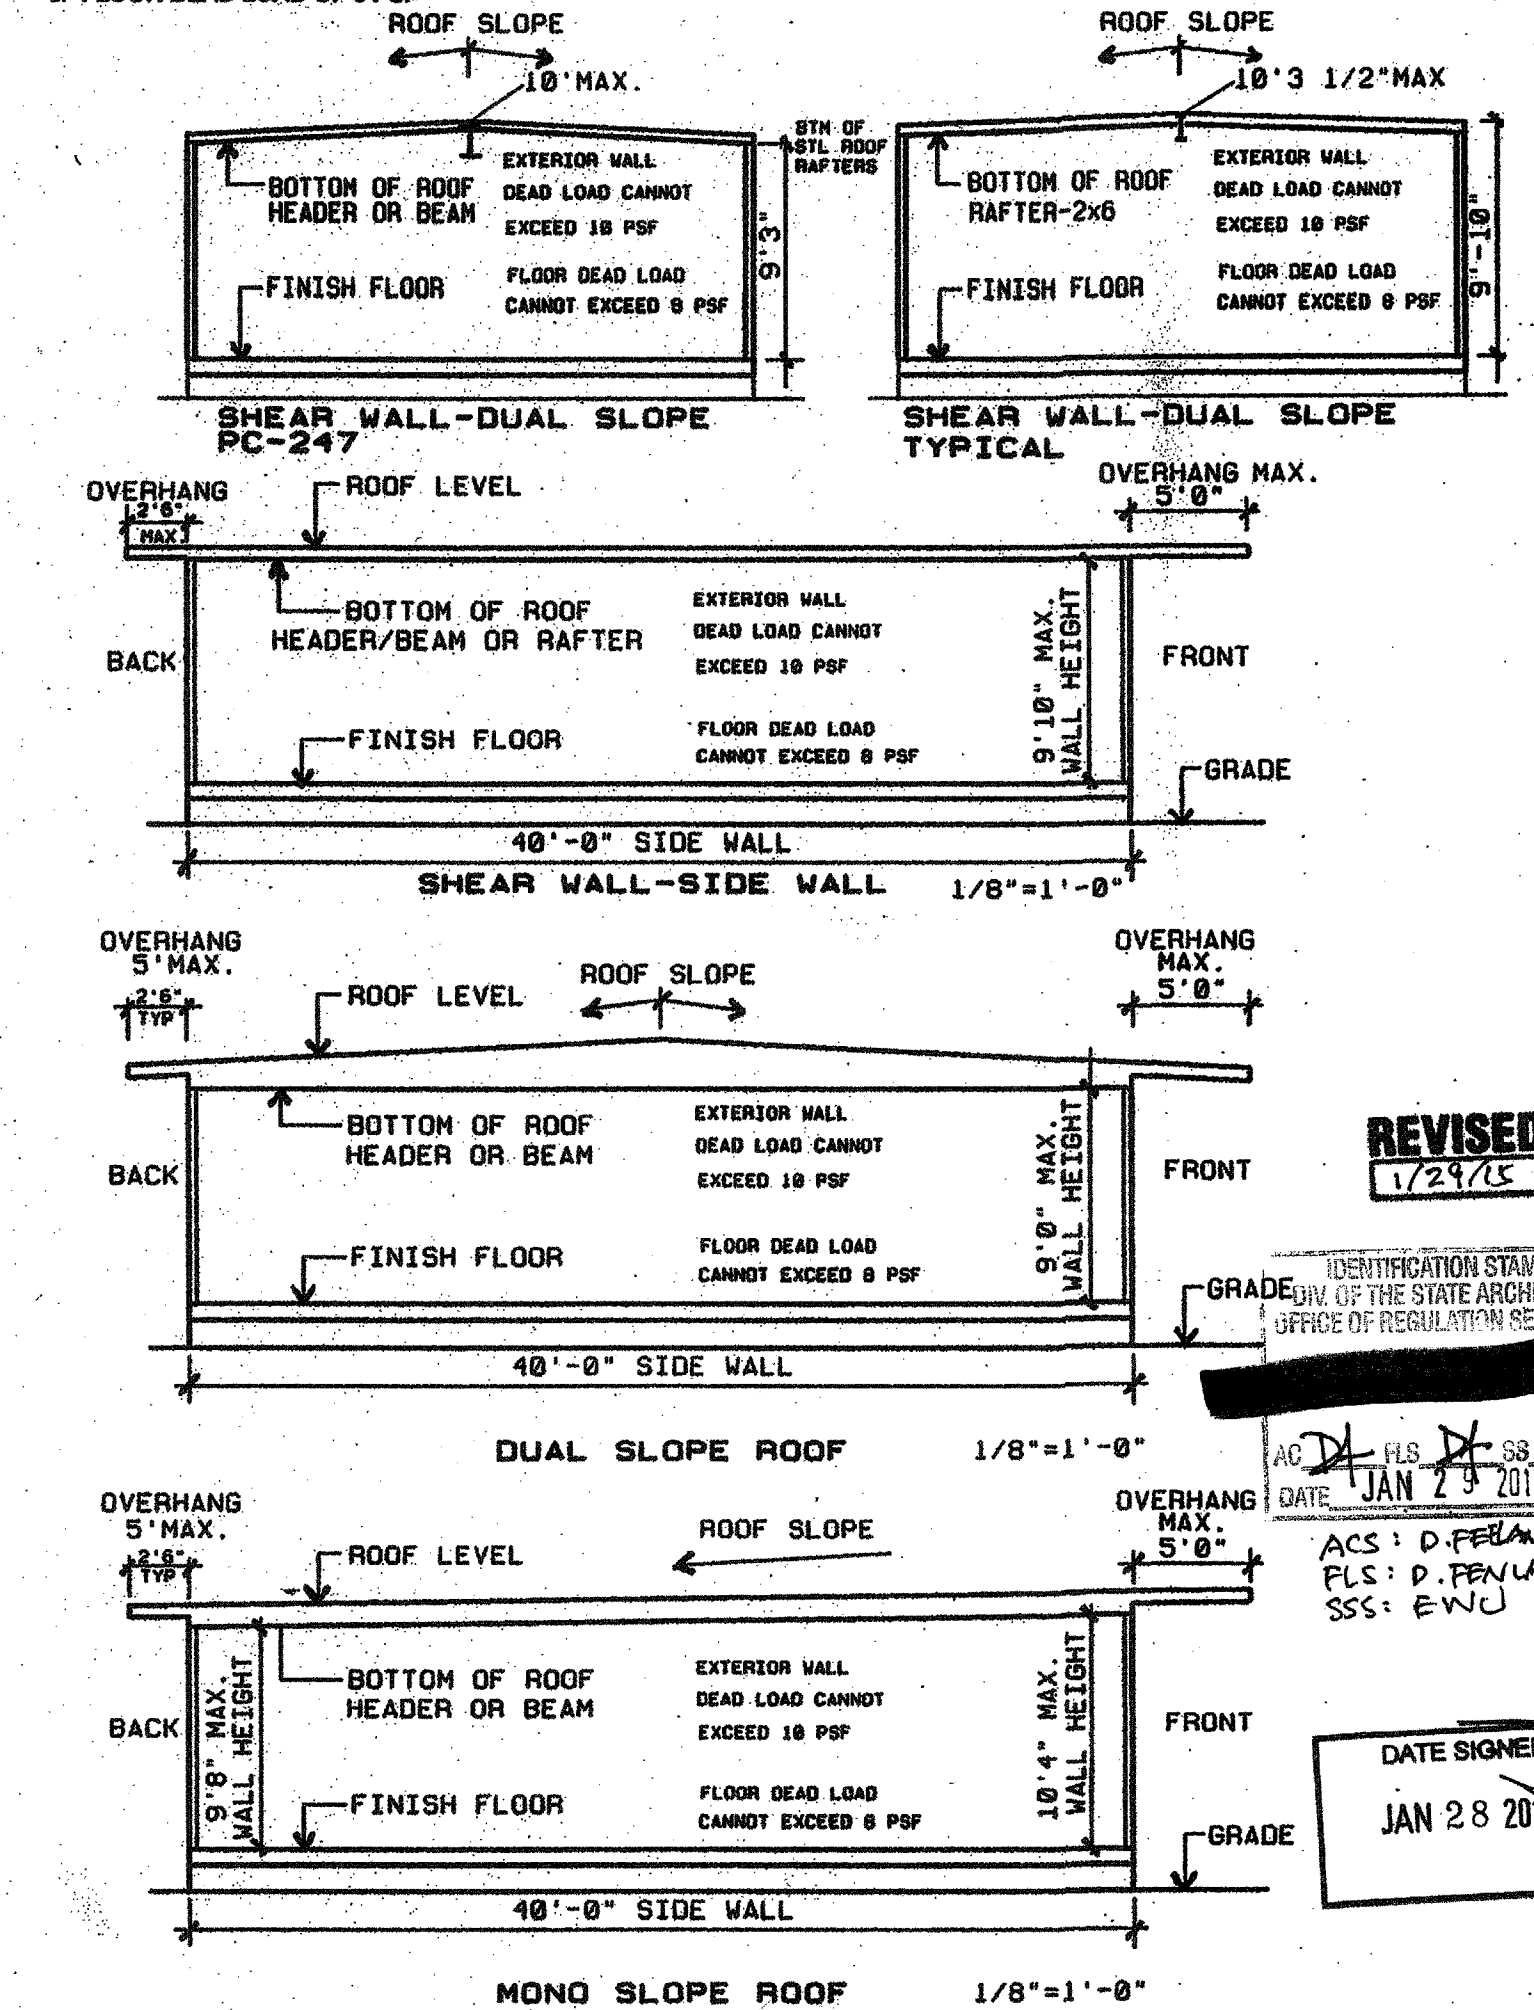

TYPICAL ELEVATIONS ARE SHOWN TO CLARIFY FOUNDATION PC ONLY LIMITATIONS. DOCUMENTATION SHALL BE PROVIDED BY ENGINEER OF GENERAL RESPONSIBLE CHARGE TO BE REVIEWED AND APPROVED BY THE DSA STRUCTURAL PLAN REVIEWER.

SCOPE OF WORK: DSA FOUNDATION PLANS FOR EXISTING STOCKPILE BUILDINGS FOR CLASS LEASING, LLC.
SHEET INDEX: STOCKPILE BUILDING FOUNDATION- 2013 CODE UPDATE

F1.0 COVER SHEET, BUILDING DATA, STOCKPILE APPROVAL INDEX	FOUNDATION PLAN AND DETAILS, ADJACENT BUILDING PAD
F2.0 24x40 50 PSF	FOUNDATION PLAN AND DETAILS, ADJACENT BUILDING PAD
F2.1 24x40 50+20 PSF	FOUNDATION PLAN AND DETAILS, ADJACENT BUILDING PAD
F2.2 36x40 50 PSF	FOUNDATION PLAN AND DETAILS, ADJACENT BUILDING PAD
F3.1 36x40 50+20 PSF	FOUNDATION PLAN AND DETAILS, ADJACENT BUILDING PAD
F3.2 36x40 100 PSF	FOUNDATION PLAN AND DETAILS, ADJACENT BUILDING PAD
F4.0 48x40 50 PSF	FOUNDATION PLAN AND DETAILS, ADJACENT BUILDING PAD
F4.1 48x40 50+20 PSF	FOUNDATION PLAN AND DETAILS, ADJACENT BUILDING PAD
F4.2 48x40 100 PSF	FOUNDATION PLAN AND DETAILS, ADJACENT BUILDING PAD

SHEET INDEX:

BELOW GRADE CONCRETE FOUNDATION - DESIGNED FOR MODTECH BUILDINGS ONLY

C1.0 COVER SHEET, BUILDING DATA, STOCKPILE APPROVAL INDEX	CONCRETE FOUNDATION PLAN & DETAILS, ADJACENT BUILDING PAD
C2.0 24 x 40 - 50 PSF	CONCRETE FOUNDATION PLAN & DETAILS, ADJACENT BUILDING PAD
C2.1 24 x 40 - 50+20 PSF	CONCRETE FOUNDATION PLAN & DETAILS, ADJACENT BUILDING PAD
C3.0 36 x 40 - 50 PSF	CONCRETE FOUNDATION PLAN & DETAILS, ADJACENT BUILDING PAD
C3.1 36 x 40 - 50+20 PSF	CONCRETE FOUNDATION PLAN & DETAILS, ADJACENT BUILDING PAD
C3.2 36 x 40 - 100 PSF	CONCRETE FOUNDATION PLAN & DETAILS, ADJACENT BUILDING PAD
C4.0 48 x 40 - 50 PSF	CONCRETE FOUNDATION PLAN & DETAILS, ADJACENT BUILDING PAD
C4.1 48 x 40 - 50+20 PSF	CONCRETE FOUNDATION PLAN & DETAILS, ADJACENT BUILDING PAD
C4.2 48 x 40 - 100 PSF	CONCRETE FOUNDATION PLAN & DETAILS, ADJACENT BUILDING PAD

ADJACENT BUILDINGS: ONLY THOSE BUILDINGS MANUFACTURED BY THE SAME COMPANY MAY BE PLACED ADJACENT TO EACH OTHER


CLASS LEASING-APPROVED STOCKPILE A NUMBERS FOR THIS FOUNDATION PC

BUILDING DATA - 24 X 40 SHEAR WALL	STKP #	DSA #	PC-BASE	DATE	SIZE	FLOOR LOAD	BLDG MFG
STKP 029	02923	SHR	10-21-1989	24 X 40	50+20P	MODTECH	
STKP 02	02512	4813B-SHR	11-09-1989	24 X 40	50P	MODTECH	
STKP 01	02813	4813B-SHR	11-09-1989	24 X 40	50P	MODTECH	
STKP 03	02814	SHR	11-09-1989	24 X 40	50P	MODTECH	
STKP 06	02816	4840-SHR	12-07-1989	24 X 40	50P	AURORA	
STKP 04	02916	SHR PC 28HR	12-07-1989	24 X 40	50P	MODTECH	
STKP 22	05113	PC 28	03-18-1990	24 X 40	50P	MODTECH	
STKP 24	05209	PC 28	05-14-1994	24 X 40	50P	MODTECH	
STKP 13	01907	PC 247	08-29-1994	24 X 40	50P	MODTECH	
STKP 77	07970	PC 247	11-10-1997	24 X 40	50P	MODTECH	

BUILDING DATA - 24 X 40 RIGID FRAME

BUILDING DATA - 24 X 40 RIGID FRAME	STKP #	DSA #	PC-BASE	DATE	SIZE	FLOOR LOAD	BLDG MFG
STKP 11	02402	SHR	08-12-1991	24 X 40	50+20P	MODTECH	
STKP 20	55031	PC 79	09-19-1990	24 X 40	50P	MODTECH	
STKP 21	55032	PC 79	09-19-1990	24 X 40	50P	MODTECH	
STKP 23	55347	PC 79	11-28-1990	24 X 40	50P	MODTECH	
STKP 5W	57194	PC 79	11-08-1991	24 X 40	50+20P	MODTECH	
STKP 14	57879	PC 98	03-19-1992	24 X 40	50P	MODTECH	
STKP 18	63298	PC 243	05-04-1998	24 X 40	50P	MODTECH	
STKP 19	63321	PC 242	06-11-1998	24 X 40	50P	MODTECH	
STKP 27	65483	PC 266	07-31-1998	24 X 40	50P	MODTECH	
STKP 31	66318	PC 269	11-12-1999	24 X 40	50+20P	MODTECH	
STKP 33	67333	PC 266	08-11-1997	24 X 40	50P	MODTECH	
STKP 35	04-10417	PC 266	01-15-1999	24 X 40	50+20P	MODTECH	
STKP 39	04-10098	PC 275	08-10-1998	24 X 40	50+20P	MODTECH	
STKP 37	04-10098	PC 266	08-10-1998	24 X 40	50+20P	MODTECH	
STKP 40	04-10099	PC 282	09-03-1998	24 X 40	50+20P	MODTECH	
STKP 42	04-10029	PC 296	01-07-1999	24 X 40	50+20P	MODTECH	
STKP 43	04-10055	PC 276	09-09-1999	24 X 40	50P	MODTECH	
STKP 44	04-10160	PC 266	09-30-1999	24 X 40	50+20P	MODTECH	
STKP 48	04-10178	PC 101268	12-16-1999	24 X 40	50P	MODTECH	
STKP 51	04-10201	PC 101268	03-18-2000	24 X 40	50P / 50+20P	MODTECH	
STKP 53	04-10235	PC 101268	07-06-2000	24 X 40	50+20P	MODTECH	
STKP 55	04-10264	PC 101268	12-21-2000	24 X 40	50P	MODTECH	
STKP 62	04-10418	PC 101268	04-18-2002	24 X 40	50+20P	MODTECH	
STKP 67	04-10481	PC 101268	12-08-2002	24 X 40	50+20P	MODTECH	
STKP 70	04-10529	PC 104801	05-22-2003	24 X 40	50+20P	MODTECH	
STKP 7							

REVISIONS	BY

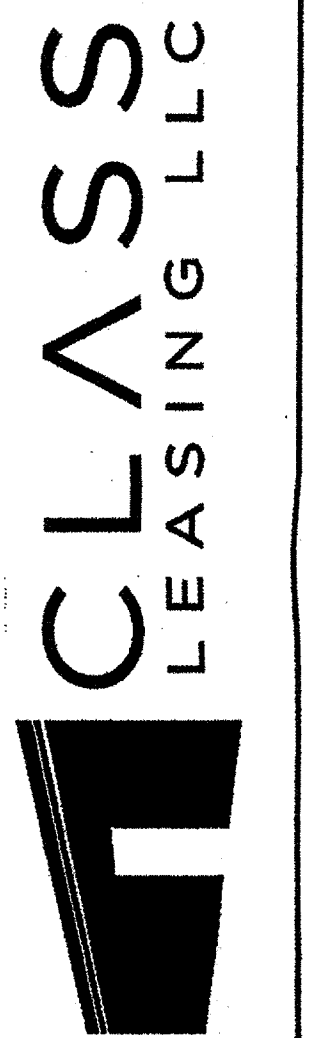

Class Leasing, LLC
 1221 Hanley Knox Blvd. Perris, CA 92571-7408
 VOICE (951)943-1908 FAX (951)943-5768

CLASS LEASING, INC.
 STOCKPILE CLASSROOM
 24x40 - 50+20 PSF RELOCATION
 FOUNDATION PLAN & DETAILS

DATE	09-29-2014
SCALE	
DRAWN	LAM-CLLS
JOB	24x40 50+20 PSF
SHEET	F2.1


- KEY NOTES 24x40- 50+20 PSF FLOOR LOAD**
- FOUNDATION AT SIDE WALL**
- TOP PLATE: 2x8 CONTINUOUS W/ (1) 16d NAIL AT 4" O.C. TO BLOCKING PLATE BELOW
 - BLOCKING: 2x6 CONTINUOUS W/ (1) 16d NAIL AT 4" O.C. TO BLOCKING OR SILL PLATE BELOW
 - SILL PLATE: 2x12 (PT) WITH SILL RESTRAINT PER GENERAL NOTE #A.
- FOUNDATION AT END WALL**
- TOP PLATE: 2x4 CONTINUOUS W/ (1) 16d NAIL AT 4" O.C. TO BLOCKING PLATE BELOW
 - BLOCKING: 2x4 CONTINUOUS W/ (1) 16d NAIL AT 4" O.C. TO BLOCKING OR SILL PLATE BELOW
 - SILL PLATE: 2x6 (PT) WITH SILL RESTRAINT PER GENERAL NOTE #A.
 - SILL RESTRAINT- PIPE TO GRADE (TYP) SEE GENERAL NOTE #A
 - SKIRTING: 3/8" PLYWOOD, ATTACH WITH 10d NAILS, EDGE NAILING 4" O.C. AT END WALLS AND 6" O.C. AT SIDE WALLS, FIELD NAILING 12" O.C
 - SIDEWALL VENT: 3" HIGH BY 4'-0" LONG. INSTALL UNDER SKIRTING. SKIRTING ATTACH WITH 10d NAILS, EDGE NAILING 8" O.C.
 - ENDWALL VENT: 3" HIGH BY 2'-0" LONG. INSTALL UNDER SKIRTING. SKIRTING ATTACH WITH 10d NAILS, EDGE NAILING 4" O.C.
 - SHIM: 5/8" X 2 1/2" WHEN REQUIRED
- FOUNDATION AT MOD LINE / END WALL**
- TOP PLATE: 2x8 CONTINUOUS W/ (1) 16d NAIL AT 4" O.C. TO BLOCKING PLATE BELOW
 - BLOCKING: 2x10 CONTINUOUS W/ (1) 16d NAIL AT 4" O.C. TO BLOCKING OR SILL PLATE BELOW
 - SILL PLATE: (7) 2x12x30' (PT)
- FOUNDATION AT MOD LINE / INTERIOR WALL**
- TOP PLATE: 2x8 CONTINUOUS W/ (1) 16d NAIL AT 4" O.C. TO BLOCKING PLATE BELOW
 - BLOCKING: 2x10 CONTINUOUS W/ (1) 16d NAIL AT 4" O.C. TO BLOCKING OR SILL PLATE BELOW
 - SILL PLATE: (5) 2x12x30' (PT)
 - FLOOR BEAM: C7x 9.8 TYPICAL
 - FLOOR HEADER: C7x 9.8 TYPICAL
 - FINISH GRADE
 - FLOOR JOIST
 - EXTERIOR FINISH
 - PLYWOOD SUB-FLOOR
 - TOP PLATE: CONTINUOUS
 - BLOCKING
 - SILL PLATE
 - MODLINE-
 - TIE PLATE: 12" x 8" x 10 GA
 - PLATE ANCHOR: 4-1/4" Ø S.M.S. (1 1/2" MIN. EMBEDMENT)
 - PLATE ANCHOR: 4-1/4" x 2" LONG LAG SCREWS (1 1/2" MIN. EMBEDMENT)
 - TIE PLATE: 12" x 4" x 10 GA
 - BUILDING ANCHORAGE: 6- 5/8"x4" LAGS SCREWS AT EACH BUILDING (FOR LOCATION SEE PLAN AT ADJACENT BUILDINGS)
 - LOCATION OF SHIM PLATES WHERE REQUIRED FOR LEVELING USE 1/4", 1/2" OR 3/4" PLYWOOD AT SAME WIDTH AS PLATE. NAIL SHIM TO PLATE WITH (6)-10d BOX.
 - 2" CUTOUT OF SILL PLATE FOR DRAINAGE. FIELD TO LOCATE AT LOWEST CORNER OF FOUNDATION.
 - 1" PIPE EACH END OF PAD AT ADJACENT BUILDING LINE.
 - THIS VENT TO BE LOCATED UNDER LANDING. PROVIDE EQUAL AREA SCREENED VENTILATION IN LANDING SKIRT.
- FOUNDATION AT BUILDING SEPARATION / END WALL**
- TOP PLATE: 2x8 CONTINUOUS W/ (1) 16d NAIL AT 4" O.C. TO BLOCKING PLATE BELOW
 - BLOCKING: 2x10 CONTINUOUS W/ (1) 16d NAIL AT 4" O.C. TO BLOCKING OR SILL PLATE BELOW
 - SILL PLATE: (6) 2x12x30' (PT) WITH SILL RESTRAINT PER PLAN AND NOTE 24.
- FOUNDATION AT BUILDING SEPARATION / INTERIOR WALL**
- TOP PLATE: 2x8 CONTINUOUS W/ (1) 16d NAIL AT 4" O.C. TO BLOCKING PLATE BELOW
 - BLOCKING: 2x10 CONTINUOUS W/ (1) 16d NAIL AT 4" O.C. TO BLOCKING OR SILL PLATE BELOW
 - SILL PLATE: (6) 2x12x30' (PT) WITH SILL RESTRAINT PER PLAN AND NOTE 24.

- GENERAL NOTES**
- SILL RESTRAINT:** THE FOUNDATION SHALL BE DESIGNED TO PREVENT SLIDING ON THE SUPPORTING SURFACE (ASPHALT CONCRETE PAVING OR ON SOIL OR ON PRE-DRILLED CONCRETE SLAB ON GRADE) BY ATTACHING THE WOOD FOUNDATION PLATES FOR THE BUILDING, RAMPS AND STAIRS TO THE GROUND WITH RESTRAINING DEVICES.
 USE A ONE-INCH DIAMETER STANDARD WEIGHT (1.315" ACTUAL O.D.) HOT DIPPED GALVANIZED PIPE OR ONE-INCH DIAMETER STEEL ROD SPACED AT NOT MORE THAN 10'-0". ONE PIPE/ROD SHALL BE LOCATED A MAXIMUM OF TWO FEET FROM EACH CORNER IN BOTH DIRECTIONS AND A MINIMUM OF TWO PIPES/RODS PER DISCONTINUOUS FOUNDATION STRIP.
 PIPES TO PENETRATE INTO SOIL AND/OR PAVING A MINIMUM OF 12" MEASURED VERTICALLY. 18-1/2" LONG PIPE REQUIRED FOR PENETRATION AT A 45 DEGREE ANGLE.
 - TO PREVENT WATER FROM PONDING BENEATH THE STRUCTURE VERIFY DRAINAGE WITH DISTRICT ARCHITECT SITE PLANS.
 - A WOOD SILL (FOOTING) PLATE SHALL BE PRESSURE TREATED HEM FIR OR DOUG FIR AND MAY BEAR DIRECTLY ON SOIL OR PAVED SURFACE. GRASS OR TURF SHALL BE CLEARED TO BARE SOIL UNDER THE ENTIRE AREA OF THE BUILDING (BY DISTRICT). THE WOOD SILL (FOOTING) PLATE MAY SUPPORT WOOD CRIPPLE STUDS, POSTS OR CONTINUOUS BLOCKING AND SHEATHING (SKIRT) WHICH NEED NOT BE TREATED. FOUNDATION LUMBER TO BE PRECUT AT FACTORY. LUMBER AND PRESSURE TREATING TO BE VERIFIED BY THE INSPECTOR.
 - FOUNDATION DESIGNED FOR 1000 PSF SOIL BEARING PRESSURE
 - THIS FOUNDATION PLAN HAS 1/4" ADDED AT EACH MODLINE AND 1/8" AT EACH SIDE WALL AND DOES NOT MATCH THE FLOOR PLAN DIMENSIONS. THIS IS REQUIRED FOR GROWTH THAT IS EXPERIENCED WHEN SETTING MULTIPLE MODULE BUILDINGS.
 - MACHINE APPLIED 16d FASTENERS SHALL HAVE AN EMBEDMENT OF NOT LESS THAN 1 1/2" INTO SECOND MEMBER, AND SHALL BE NOT LESS THAN 3 1/2" IN OVERALL LENGTH
 - THE ABOVE NAILS SHALL ALSO BE ACCEPTABLE FOR HAND NAILING PROVIDED THE REQUIRED EMBEDMENT IS MAINTAINED.


DATE SIGNED: SEP 30 2014

PRE-CHECK (PC) DOCUMENT CODE: 2013 CBC
 A SEPARATE PROJECT APPLICATION FOR CONSTRUCTION IS REQUIRED


IDENTIFICATION STAMP
 DIV. OF THE STATE ARCHITECT
 OFFICE OF REGISTRATION SERVICES
 No. 3802
 DATE: OCT 8 2014
 LICENSE EXPIRES 6/30/2016

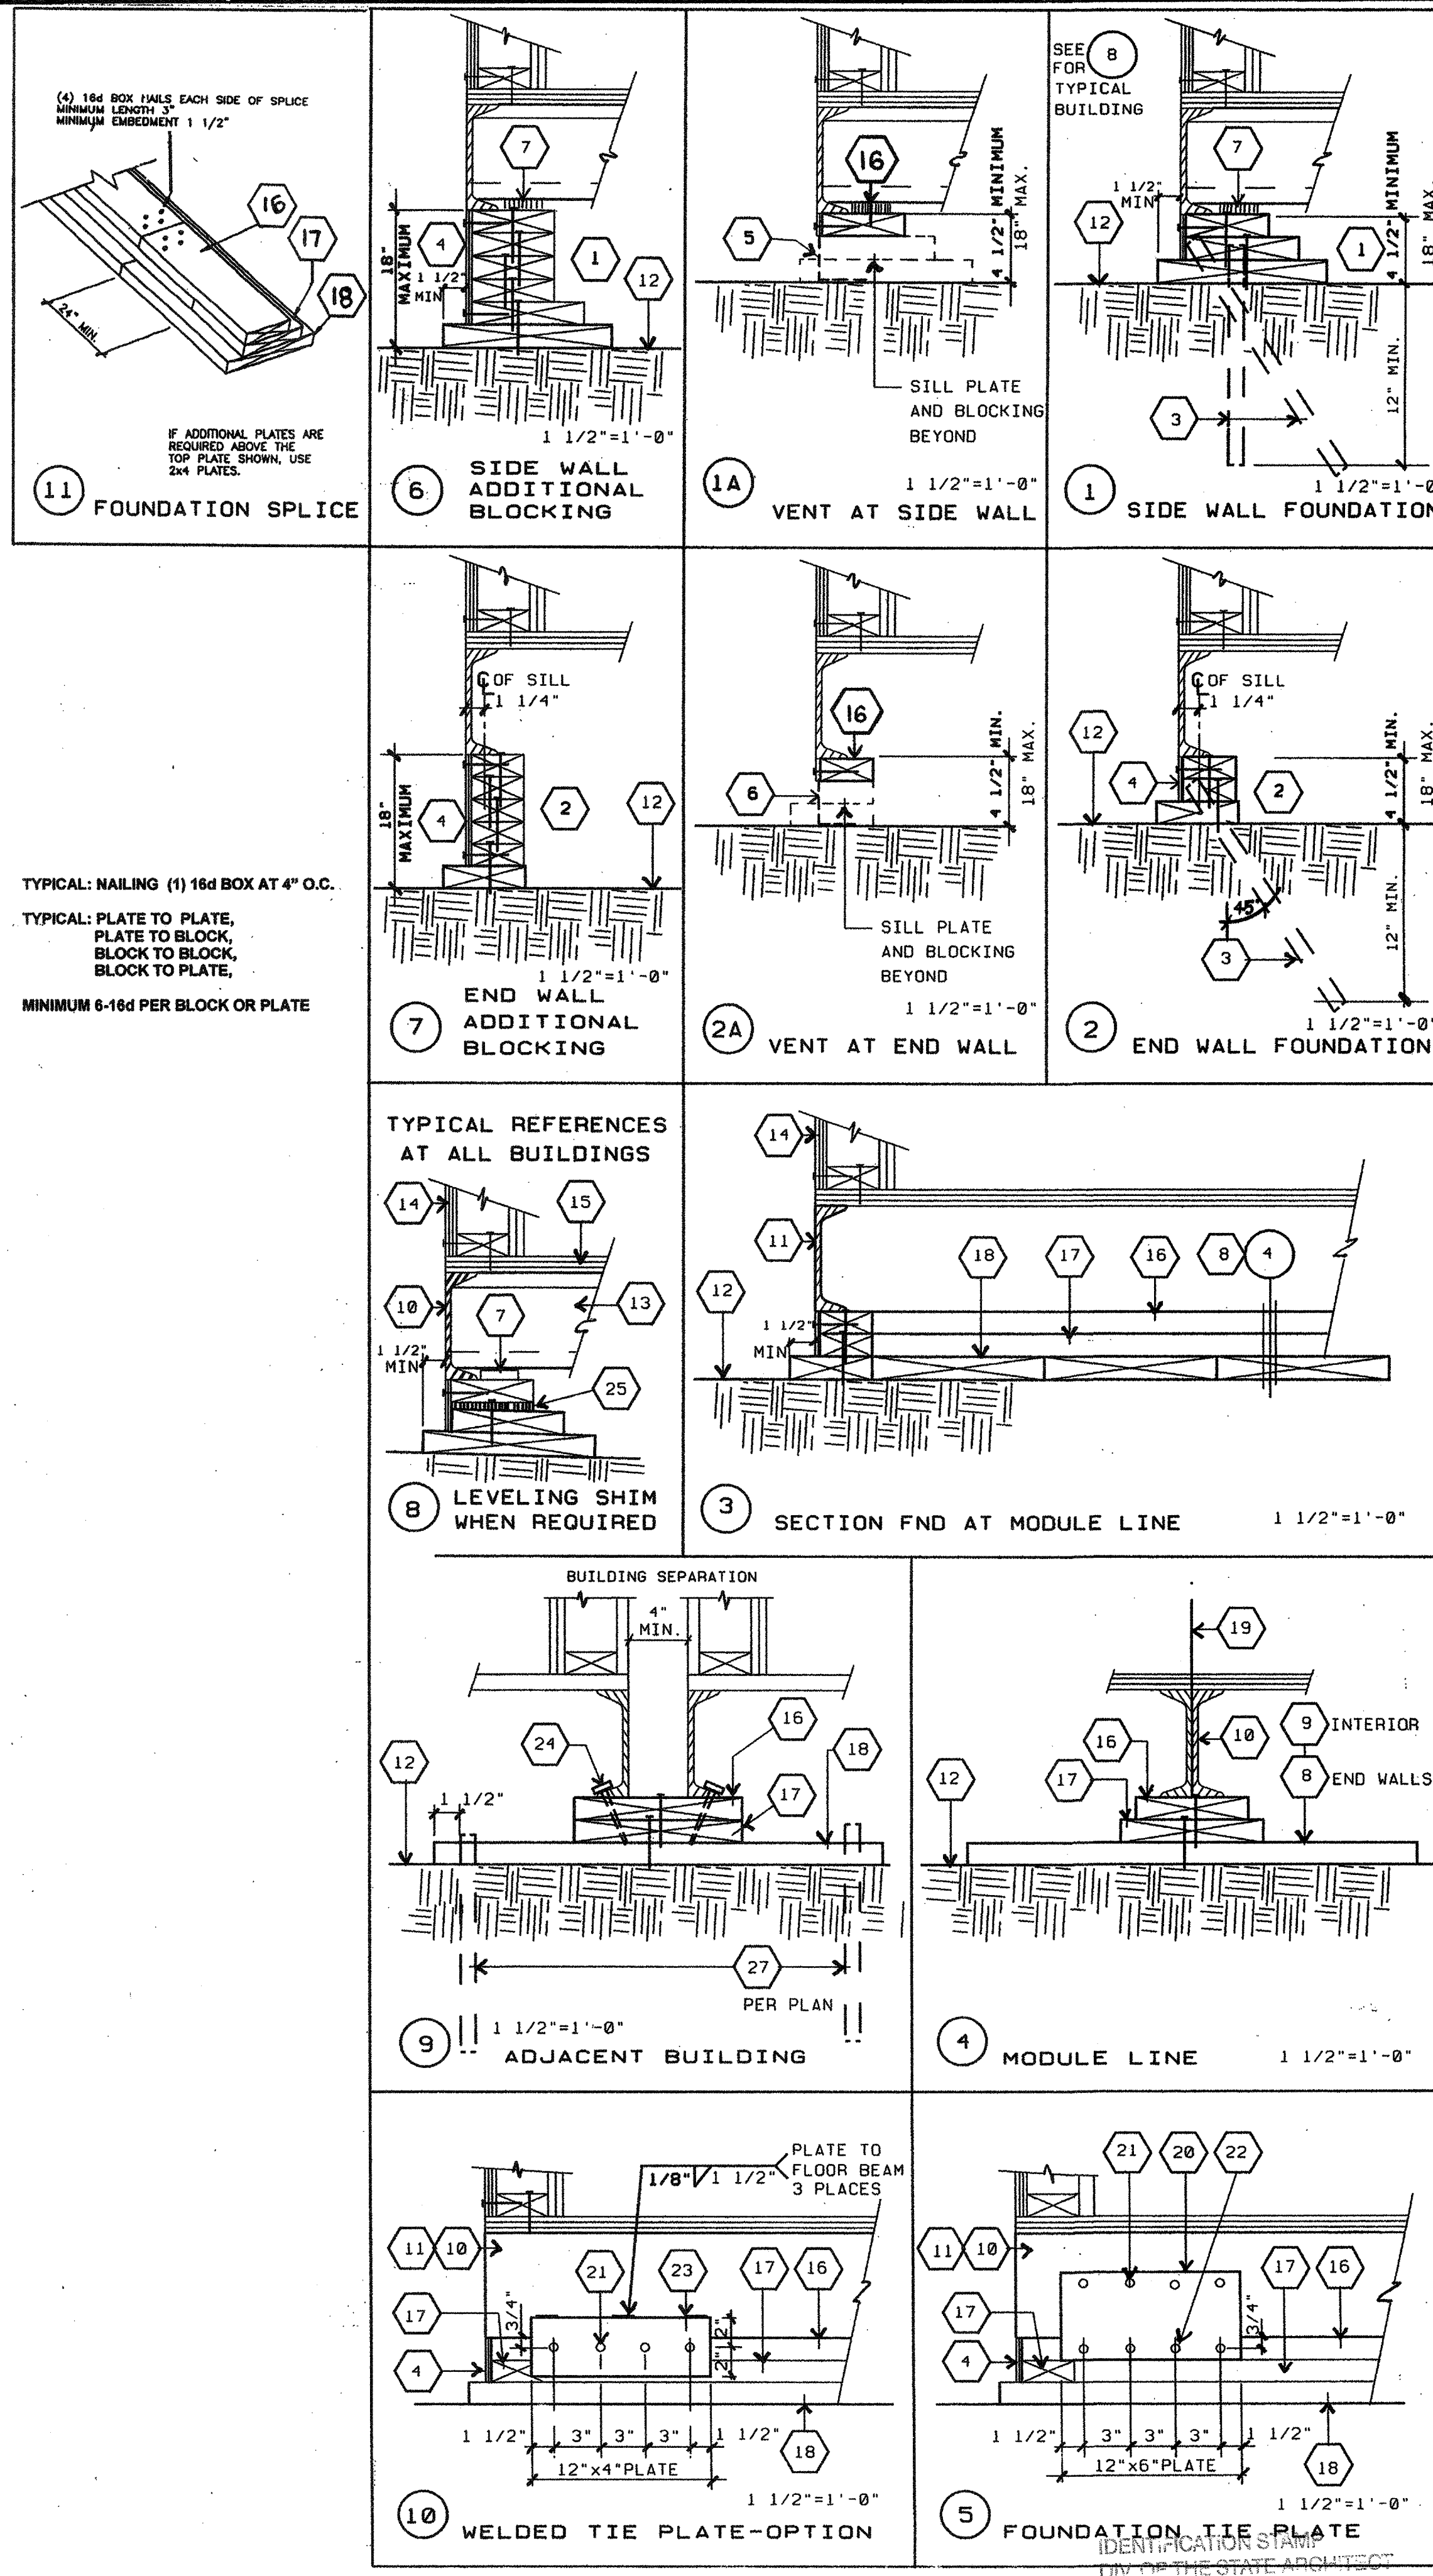

TYPICAL: NAILING (1) 16d BOX AT 4" O.C.
 TYPICAL: PLATE TO PLATE, BLOCK TO BLOCK, BLOCK TO PLATE, MINIMUM 6-16d PER BLOCK OR PLATE

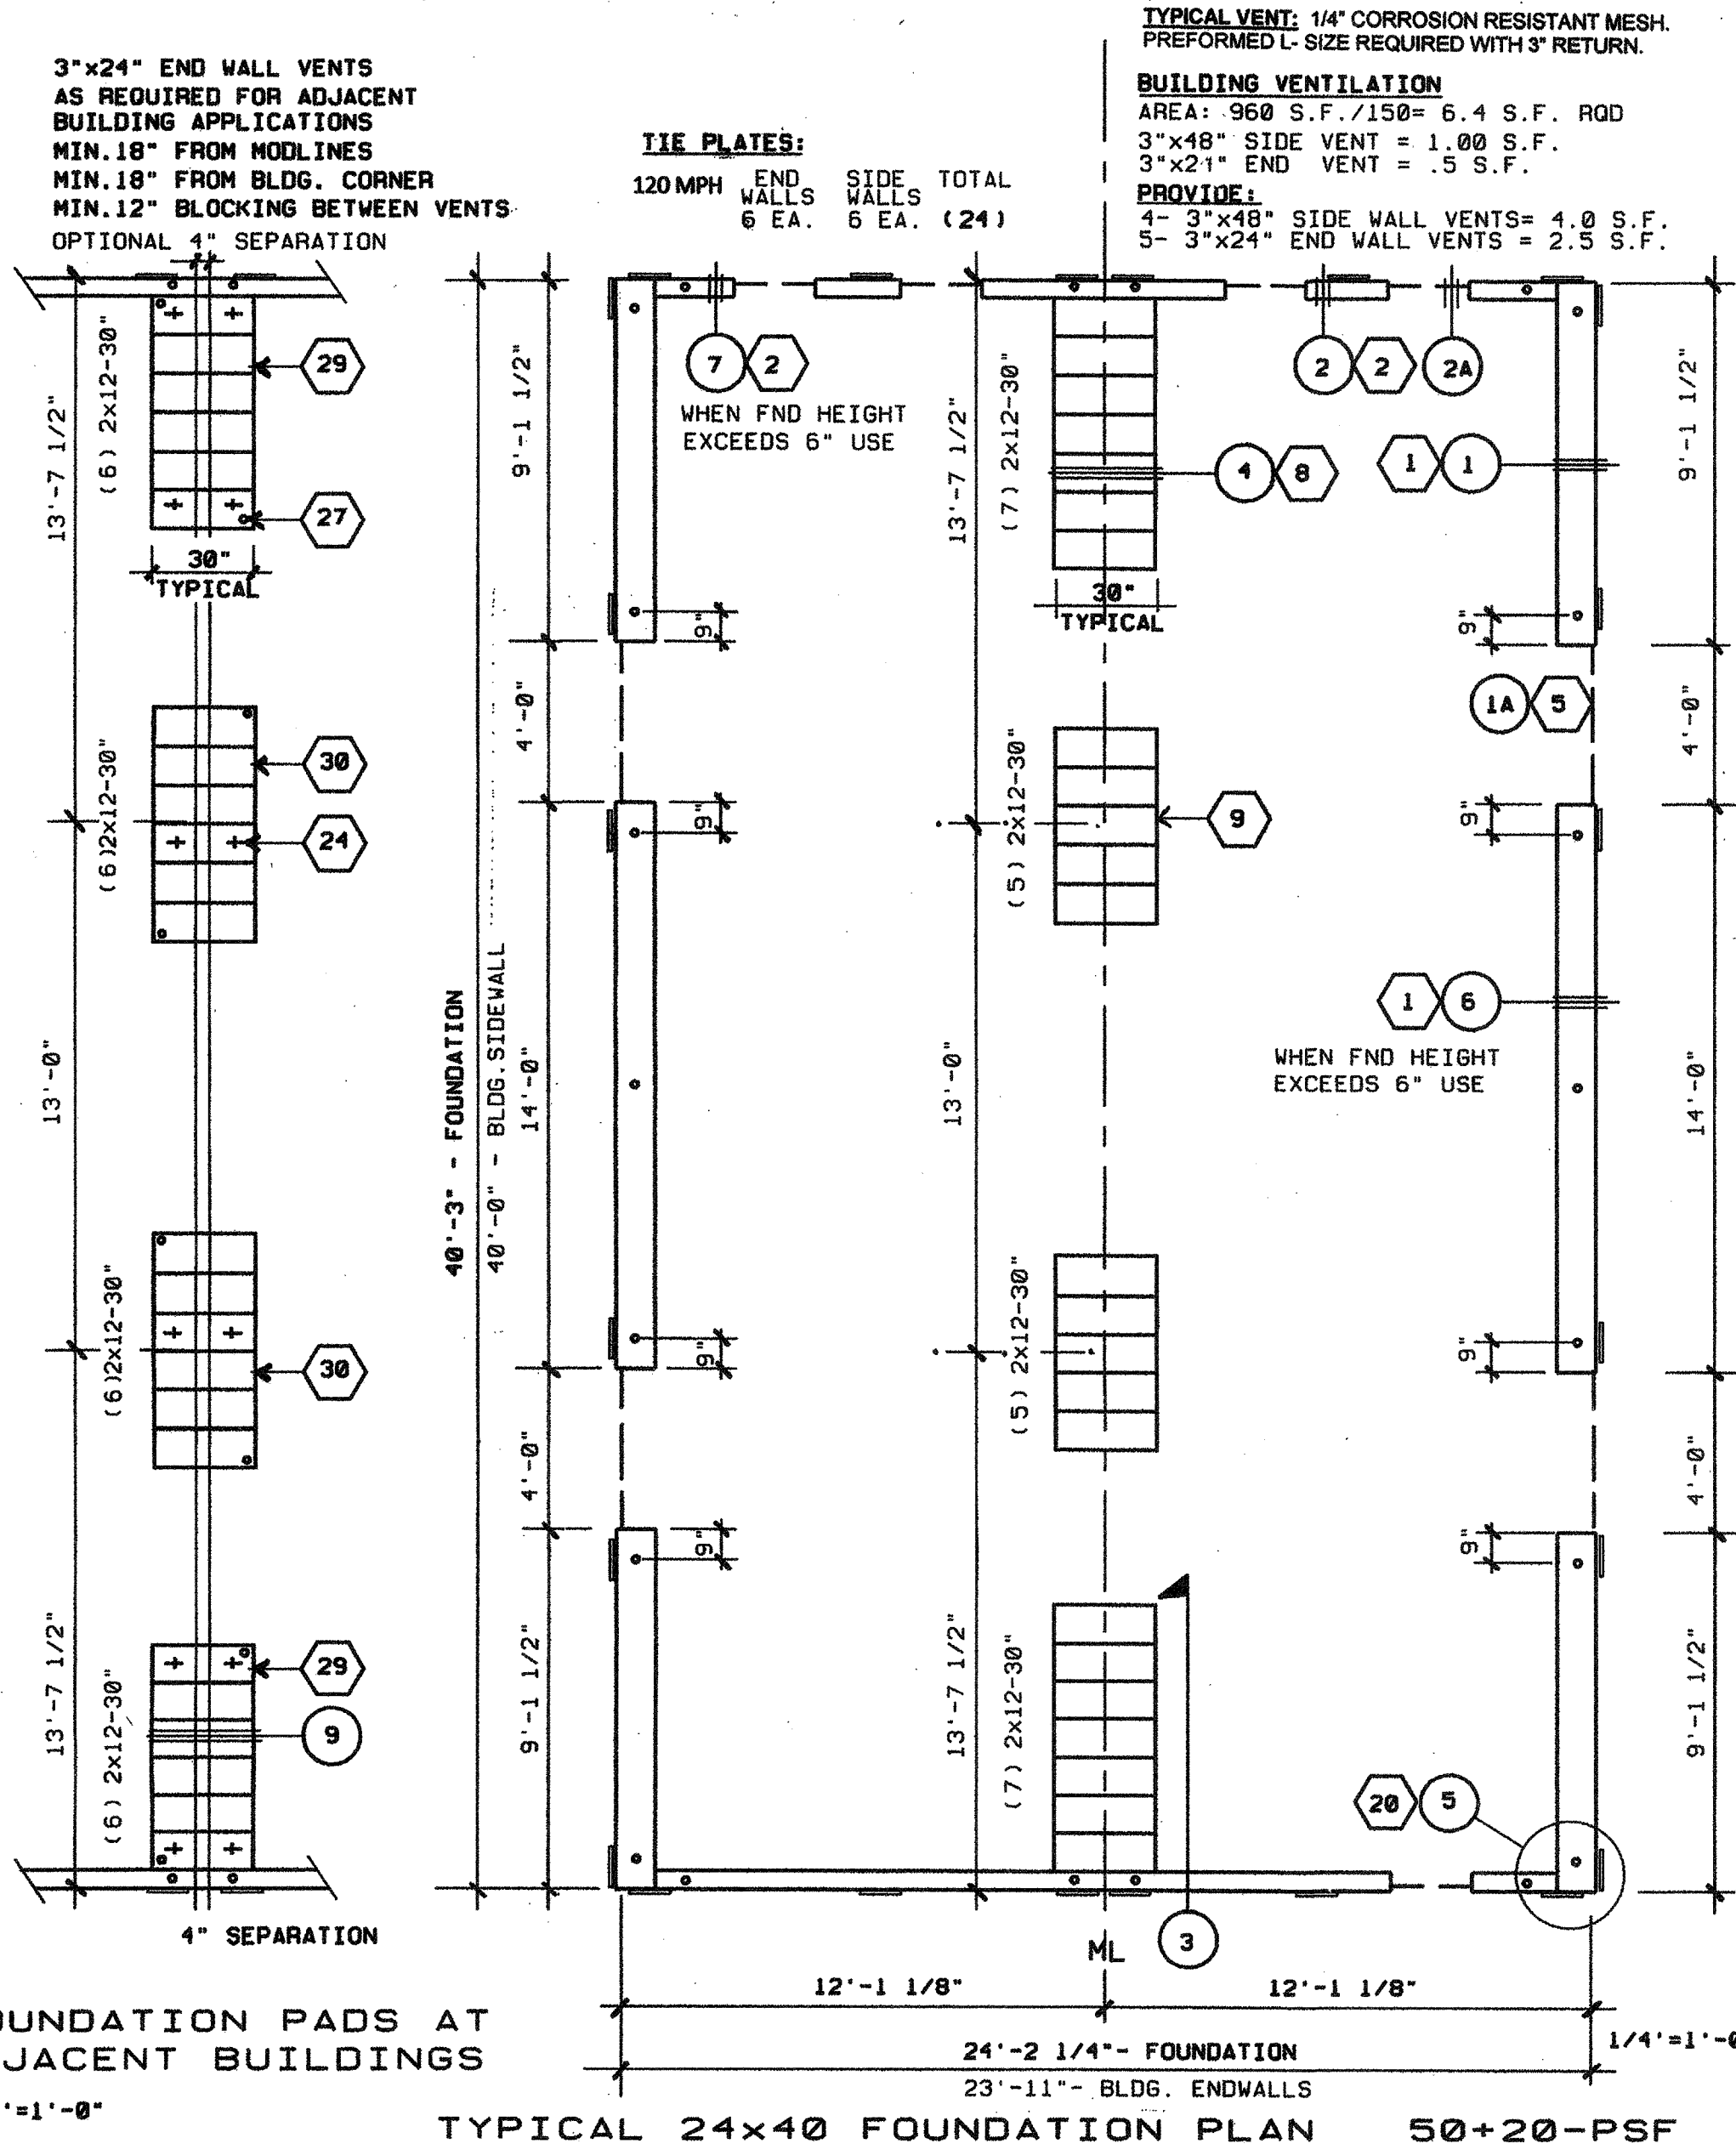

24x40 - 50+20 PSF STOCKPILE CLASSROOM RELOCATION FOUNDATION PLAN & DETAILS

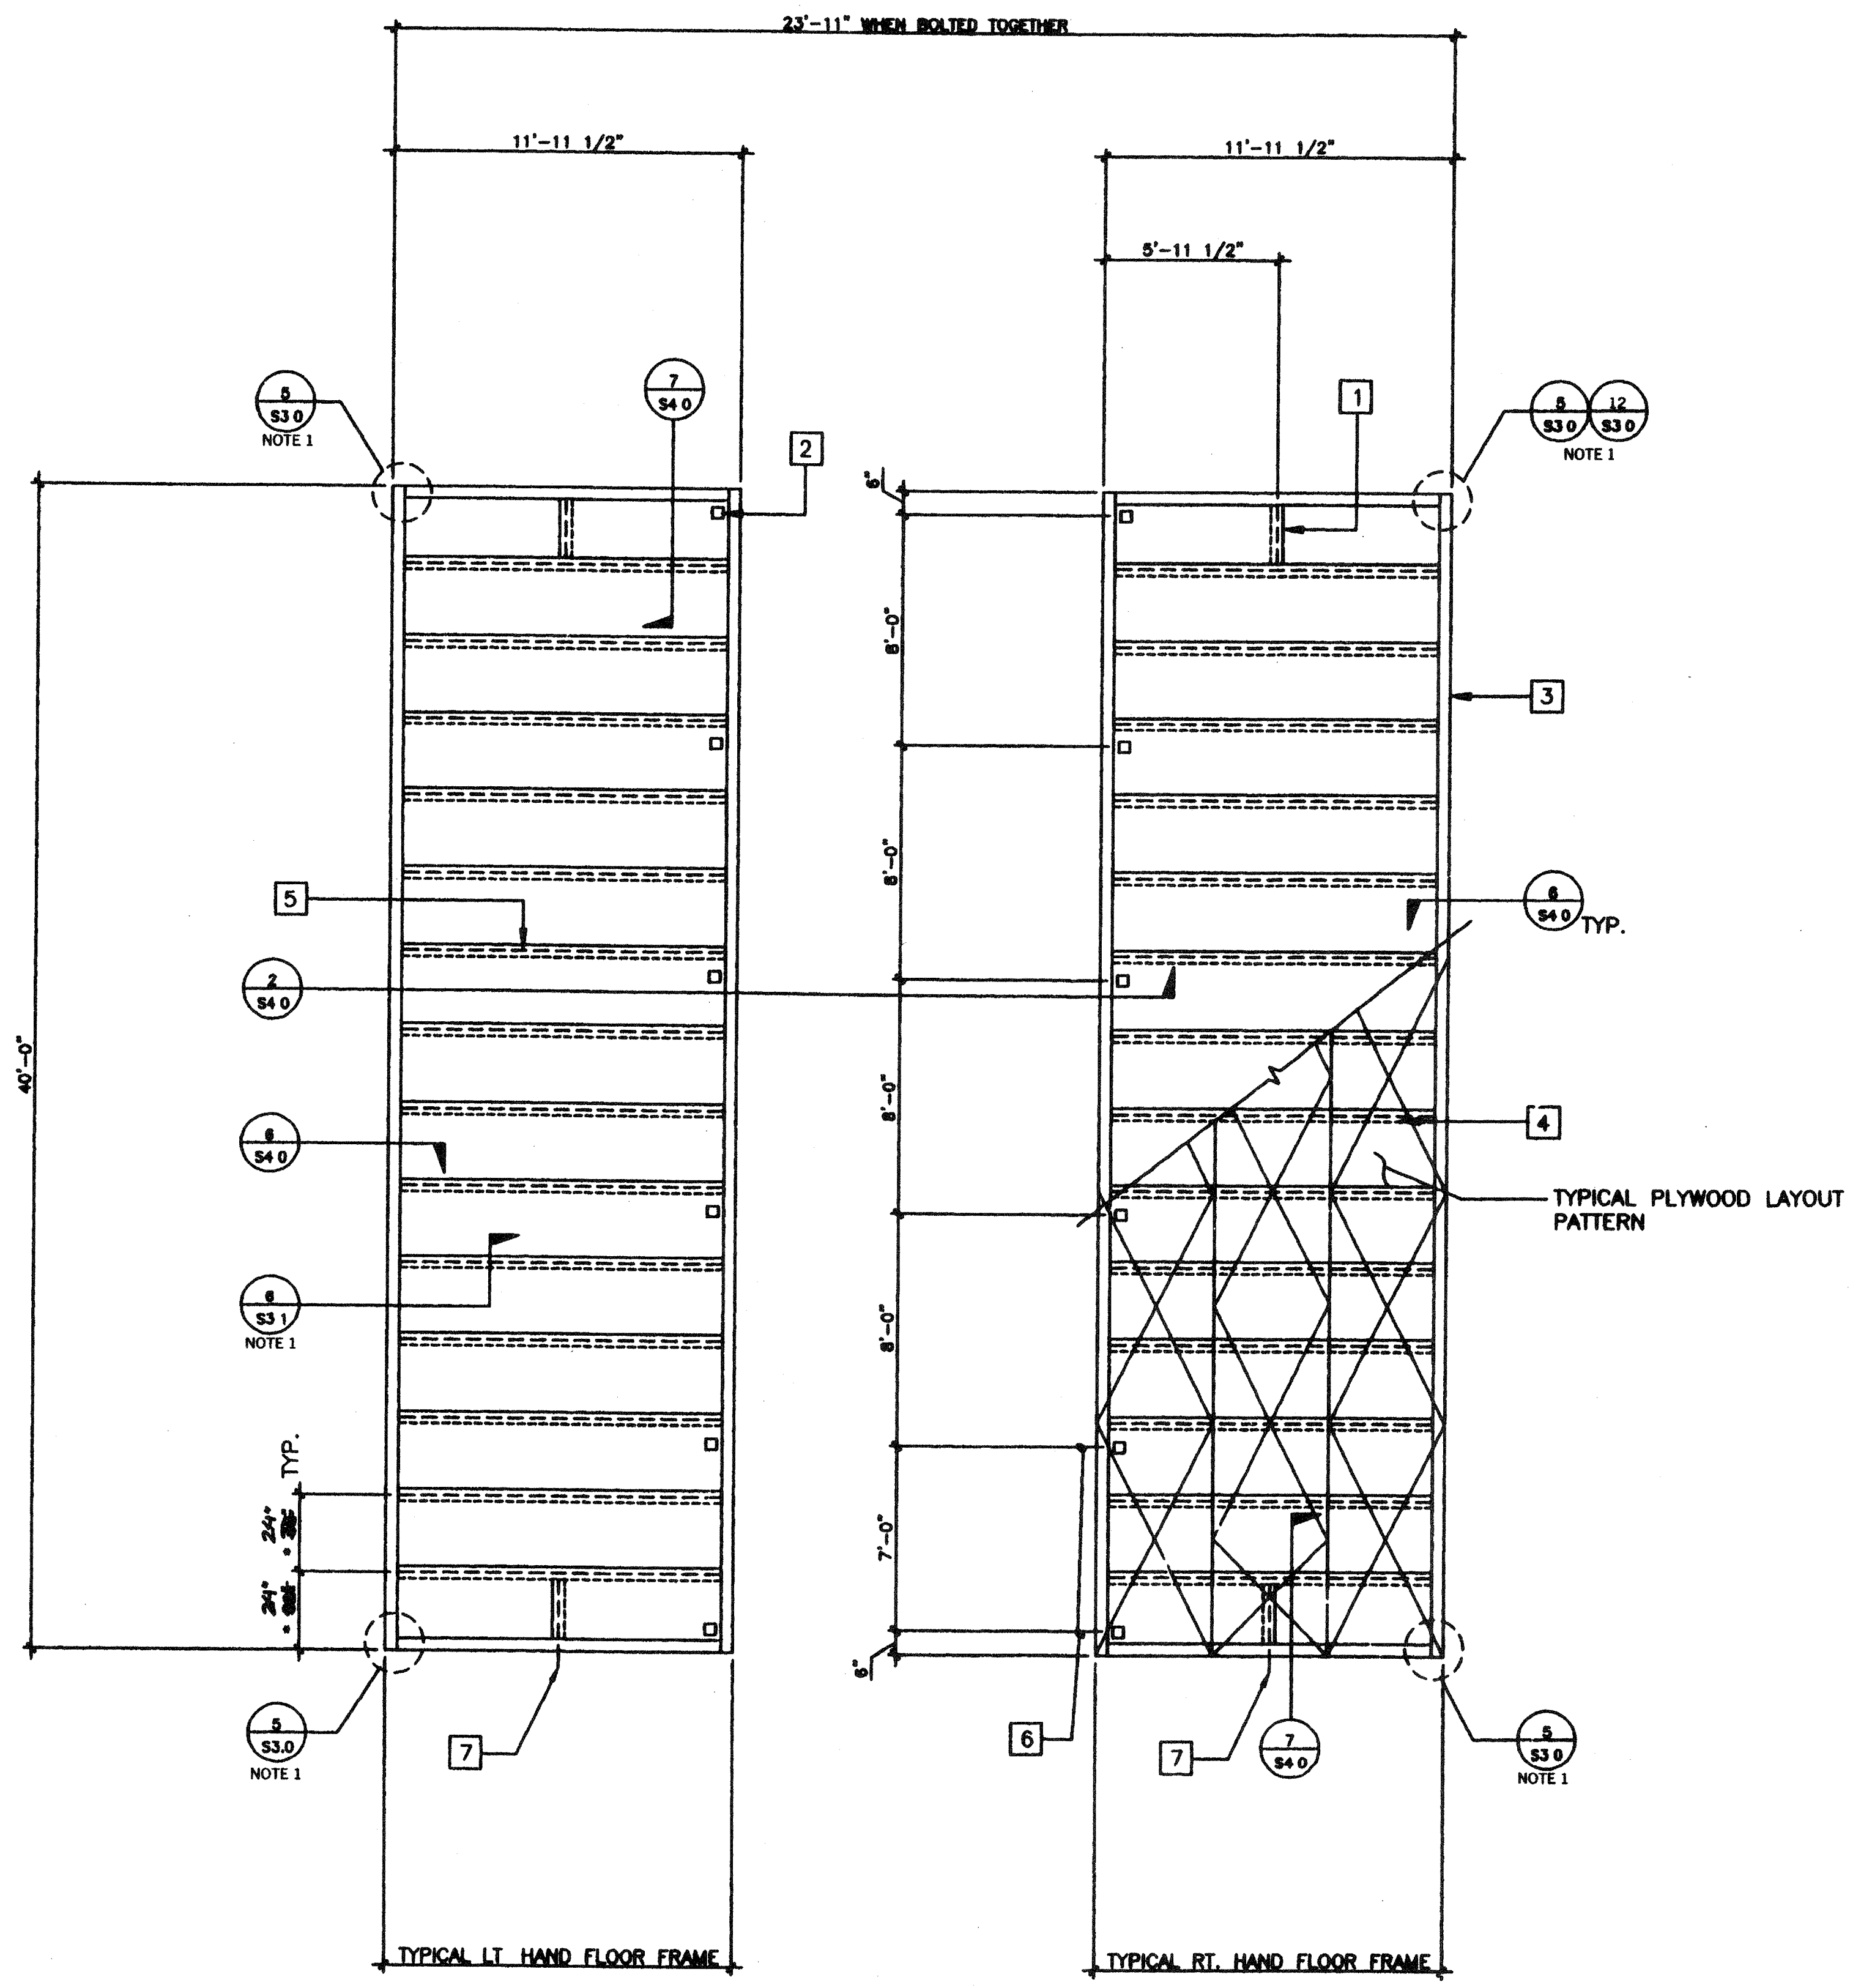

FLOOR JOIST TABLE	
LIVE LOAD	6 3/8" X 2 1/2" 12GA
50 P.S.F. W/ 20 P.S.F. PARTITIONS	21" O.C.
CONDITION	

- KEY NOTES**
- 6 3/8 X 2 1/2 X 12GA. BLOCKING AT MIDSPAN OF FLOOR HDR. TYPICAL
 - 5" Ø HAND HOLES AT BOLT BM TO BM (12 PLACES)
 - C 7X9.8 PERIMETER CHANNEL (TYPICAL)
 - PLYWOOD FLOOR SHEATHING: APA PS 1-83 1 1/8" THICK, STURD-I-FLOOR W/48" O.C SPAN RATING. ATTACHED W/#10 X 1 3/4" SELF-TAPPING FLAT HEAD SCREWS AT 6" O.C. TO PERIMETER FRAME, AEROSMITH AKN 144.0175 DRIVE PINS AT 6" O.C SUPPORTED EDGES AND 6" O.C. FIELD TO JOIST. (TYPICAL)
 - 6 3/8 X 2 1/2 X 12GA. FLOOR PURLIN ● 32" O.C.
 - TYPICAL BOLT HOLE LOCATION (SEE FOUNDATION DETAILS)
 - 11/16" Ø HOLE ● MID-DEPTH FOR HANDLING

NOTES


1. FOR MONO PITCH ROOF BLDG'S SEE SA3.0, SA3.1

• SEE FLOOR JOIST TABLE FOR APPROPRIATE SPACING PER JOIST.

END MODULES FRAMING PLAN

SCALE 1/4"=1'-0"

FLOOR LIVE LOAD - 50 PSF + 20 PSF PARTITION

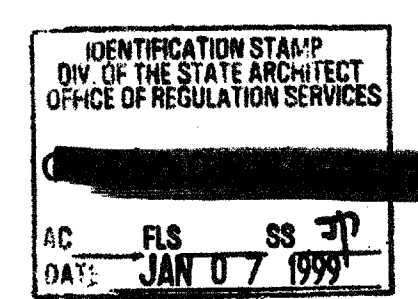

IDENTIFICATION STAMP
DIV. OF THE STATE ARCHITECT
OFFICE OF REGULATION SERVICES

APP#3 117168

AC/FLS/SS/JH
DATE AUG 04 2016

4012-088

© MODTECH, INC. 1997

PROJECT NUMBER: 2986

drawn by: 05 JAN 99
checked by: STK
date: 1/21/99
project no: 2986

REVISIONS	Electrical Engineer's Seal	Mechanical Engineer's Seal	Structural Engineer's Seal	Architect's Seal	Division of the State Architect
△					
△					

Electrical Engineer's Seal

Mechanical Engineer's Seal

Structural Engineer's Seal

Architect's Seal
EXERCISED ARCHITECT
GEO. GEORGE S. EDWARDS
JUL 9 30 99
STATE OF CALIFORNIA

Division of the State Architect
IDENTIFICATION STAMP
DIV. OF THE STATE ARCHITECT
OFFICE OF REGULATION SERVICES
PC-266
AC/FLS/SS/JH
DATE JUL 25 1997

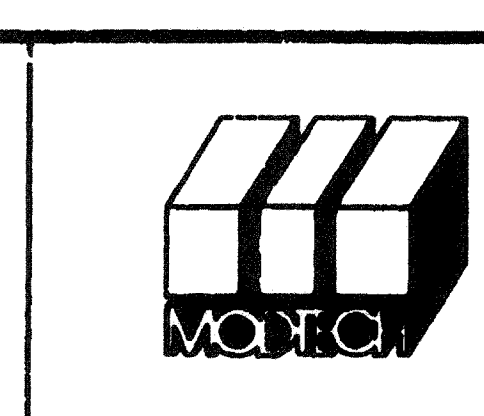


MODTECH INC.
2830 BARRETT AVENUE
PERRIS, CALIF. 92572
PH (909) 943-4014
FAX (909) 940-0427

FLOOR FRAMING PLAN

SA1.0



FILE # P266 SA1.0.DWG PROJECT NO. 2986 PC-266

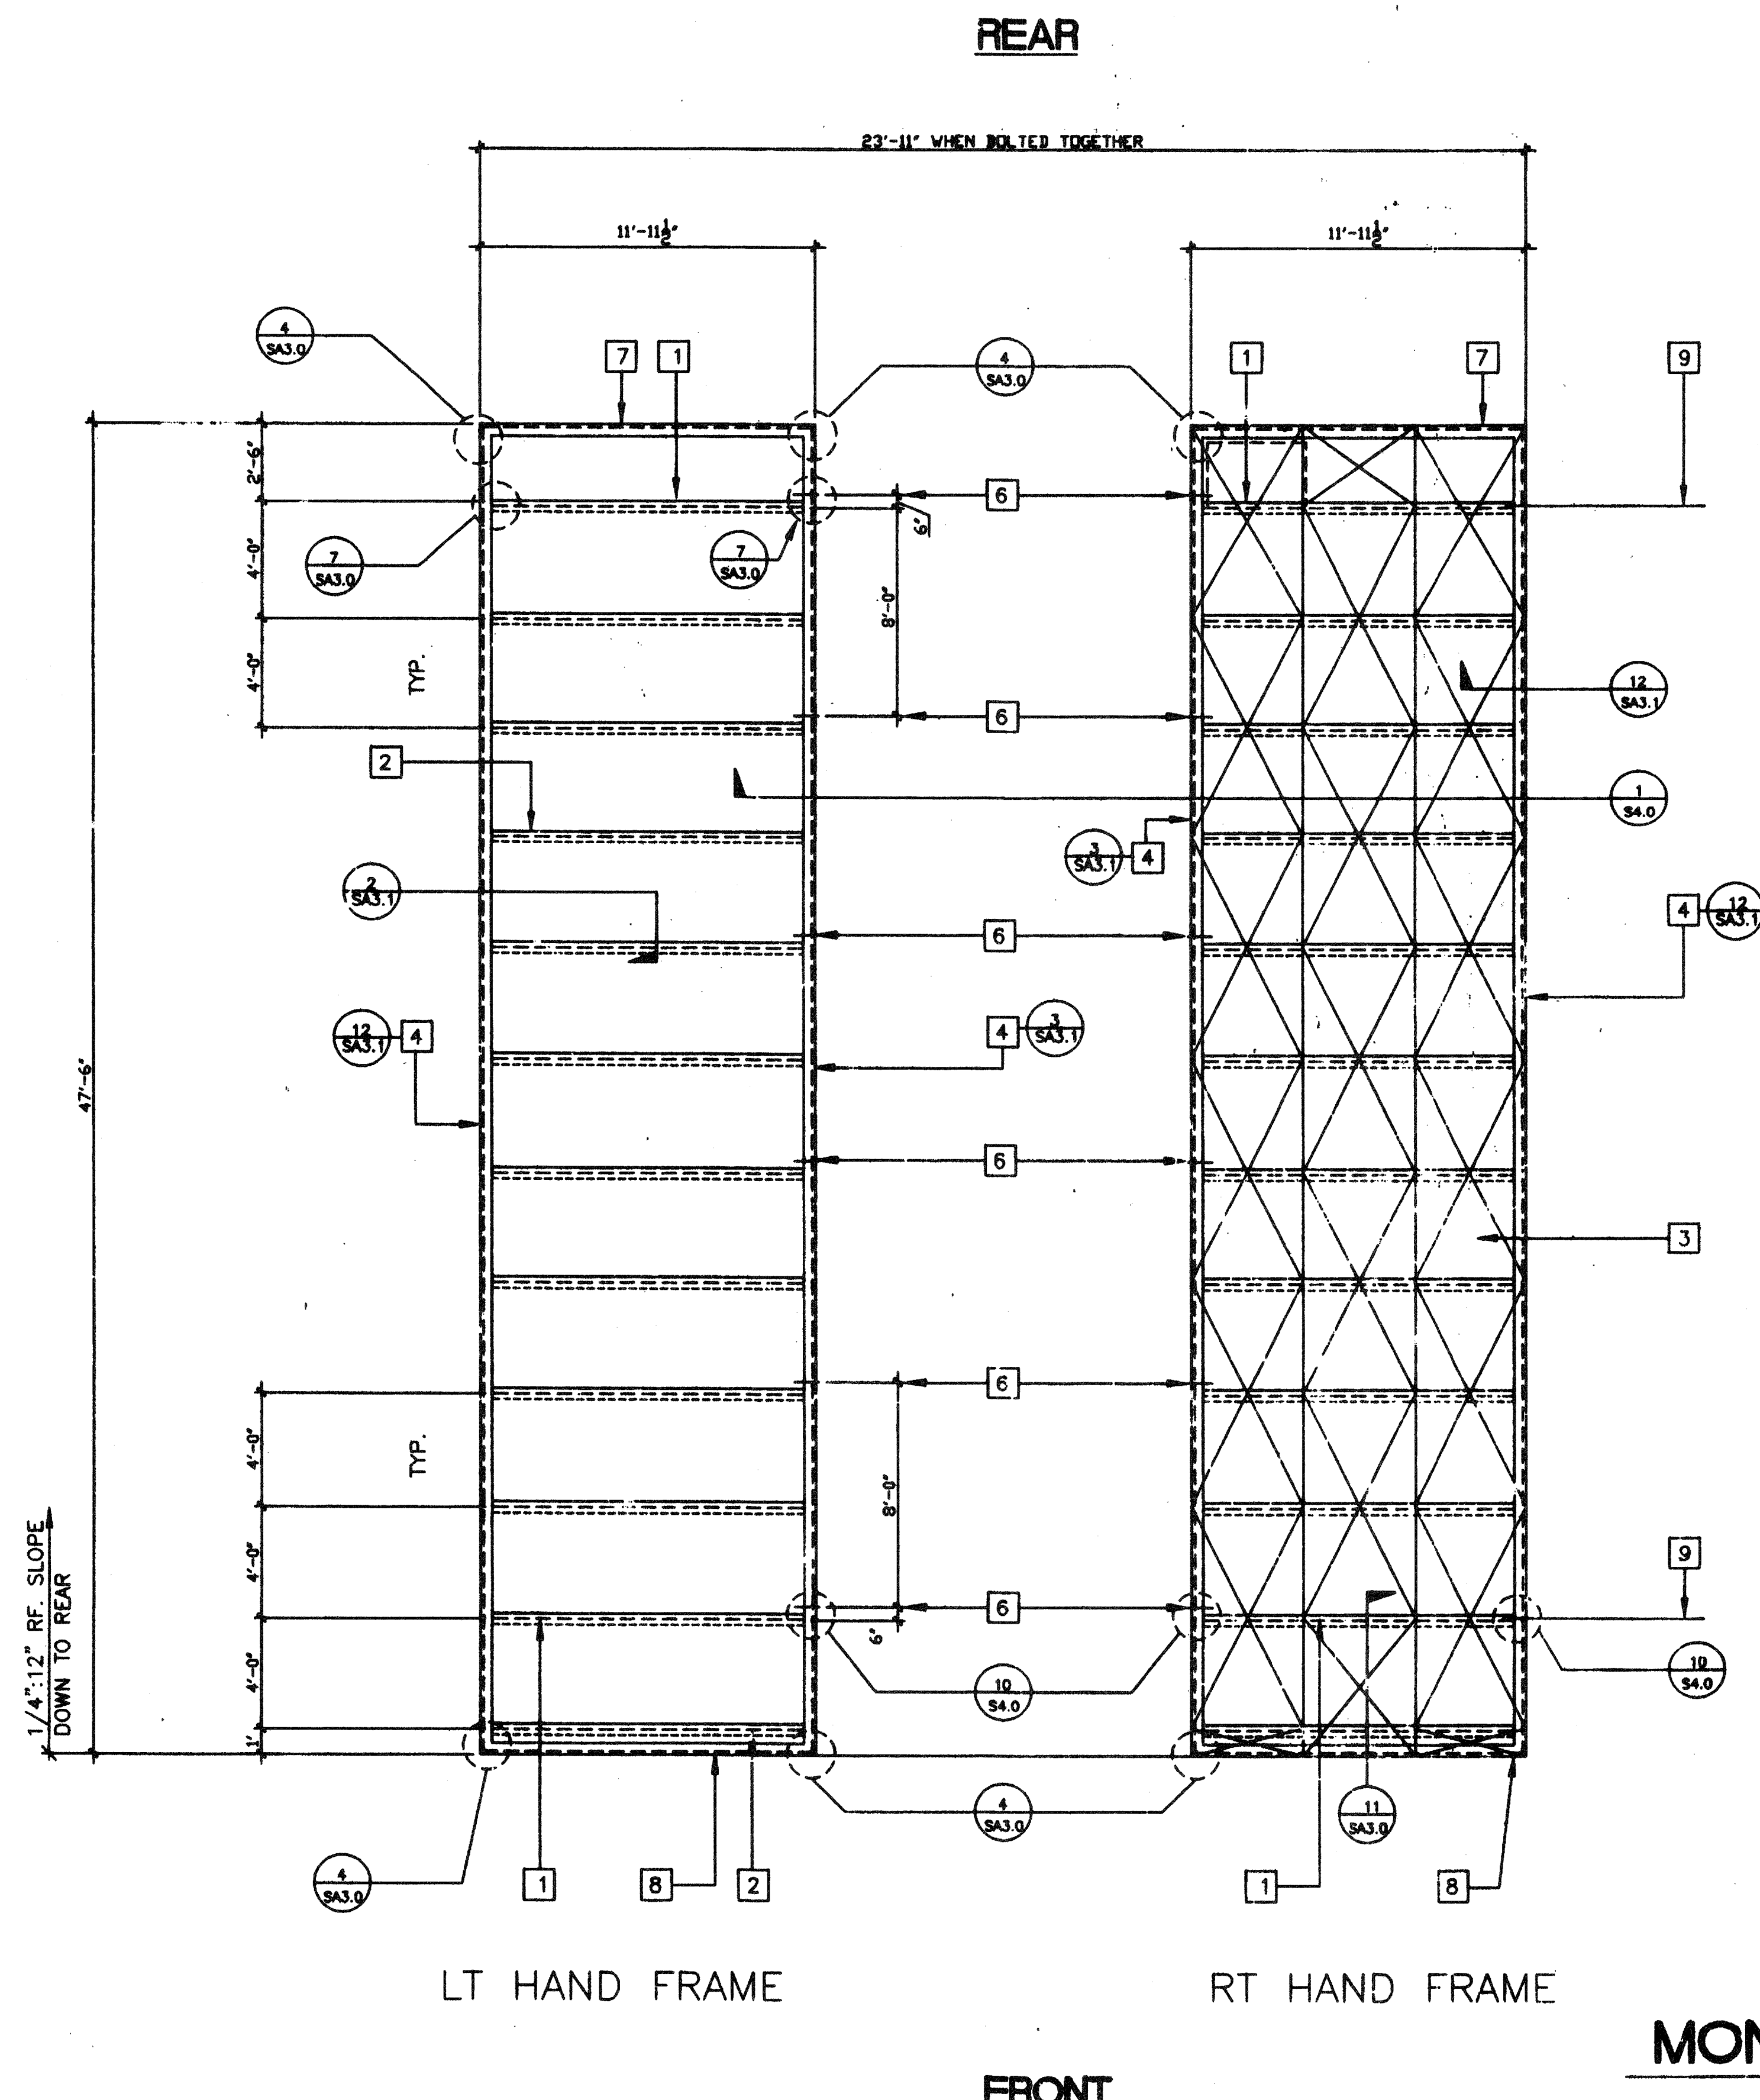

- ### KEY NOTES
- 1 C 14 X 12GA. □ HEADER
 - 2 □ 4 X 3 X 12 GA.
 - 3 PLYWOOD ROOF SHEETING 3/4" CD EXPOSURE 1 P.I.I 48/24 PSI-83 PLYCLIPS AT 16" O.C. LONG EDGES. #10-1-1/4" SELF TAPPING FLAT HEAD SCREWS AT 6" O.C. TO PERIMETER FRAME. AEROSMITH AKN 144.0175 DRIVE PINS AT 6" O.C. AT SUPPORTED EDGES AND 6" O.C. FIELD TO PURLINS. PLYWOOD PATTERN SHOWN IS TYPICAL THRU OUT. *(ALTERNATE: USE AEROSMITH AKN 144.0175 DRIVE PINS AT 6" O.C. PERIMETER)
 - 4 TAPERED ROOF BEAM 10GA. □ SEE 7/S3.1
 - 5 NOT USED
 - 6 11/16# DRILL SEE DETAIL 1/S4.0
 - 7 □ 13 3/8"X14GA. FACIA @ 2' OVERHANG
 - 8 □ 10" X 12 GA. ROOF FASCIA @ 5' OVERHANG
 - 9 E.N. THIS LINE
 - 10 8"x3 1/2" x 14 GA. ROOF OVERHANG BEAM

MONO ROOF FRAMING PLAN

SCALE 1/4"=1'-0"

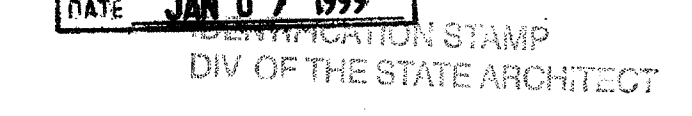
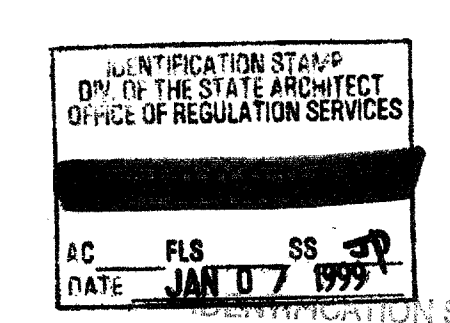


APP#3 117168
 AC / FLS / SS / TN
 Date / AUG 04 2018
STKP-42M 1/24/98


REVISIONS	Electrical Engineer's Seal	Mechanical Engineer's Seal	Structural Engineer's Seal	Architect's Seal	Division of the State Architect	MODTECH INC.	PROJECT NUMBER: 2986	© MODTECH, INC. 1997	drawn by: 4012-088
▲									date: 05 JAN 99
▲									checked by:
▲									date:
▲									Modtech project no:
▲									MODTECH Index No:

Electrical Engineer's Seal

Mechanical Engineer's Seal

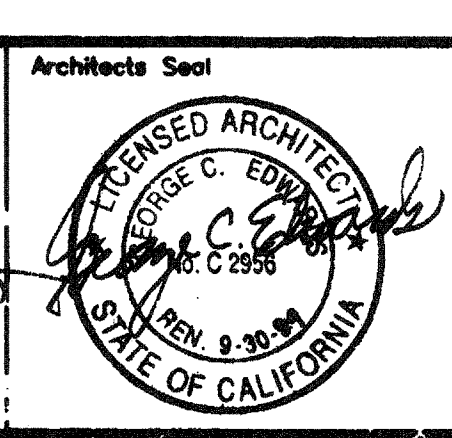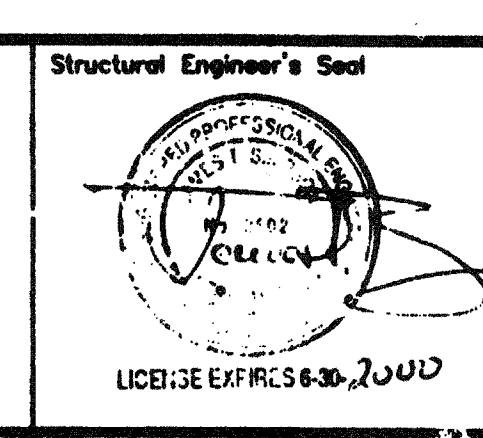

Division of the State Architect
 IDENTIFICATION STAMP
 DIV. OF THE STATE ARCHITECT
 OFFICE OF REGULATION SERVICES
PC-266
 AC / FLS / SS / TN
 DATE / JUL 25 1999

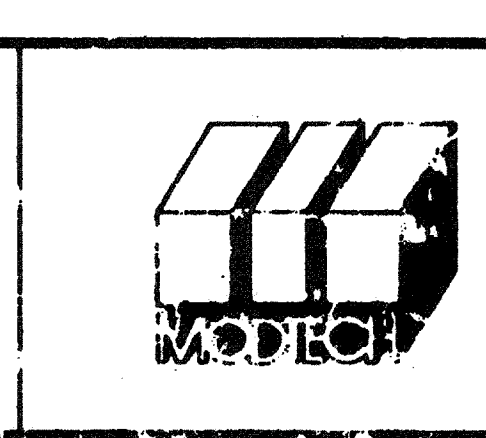

MODTECH INC.
 2830 BARRETT AVENUE
 PERRIS, CALIF. 92572
 PH (909) 943-4014
 FA (909) 940-0427

PROJECT NUMBER: 2986












© MODTECH, INC. 1997

drawn by: 4012-088
 date: 05 JAN 99
 checked by:
 date:
 Modtech project no:
 MODTECH Index No:
SA2.0

ROOF FRAMING PLAN

FILE # P-255 SA2.0.BWG

PROJECT NO. 2986

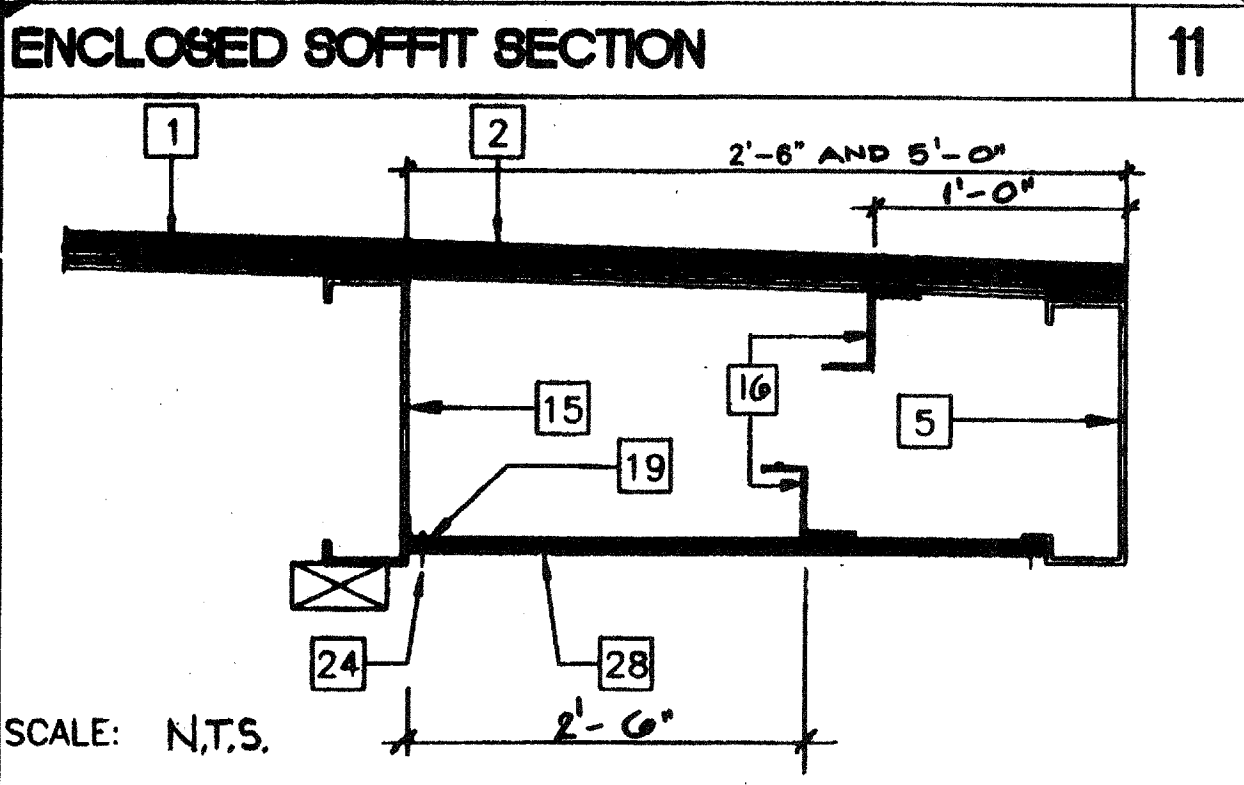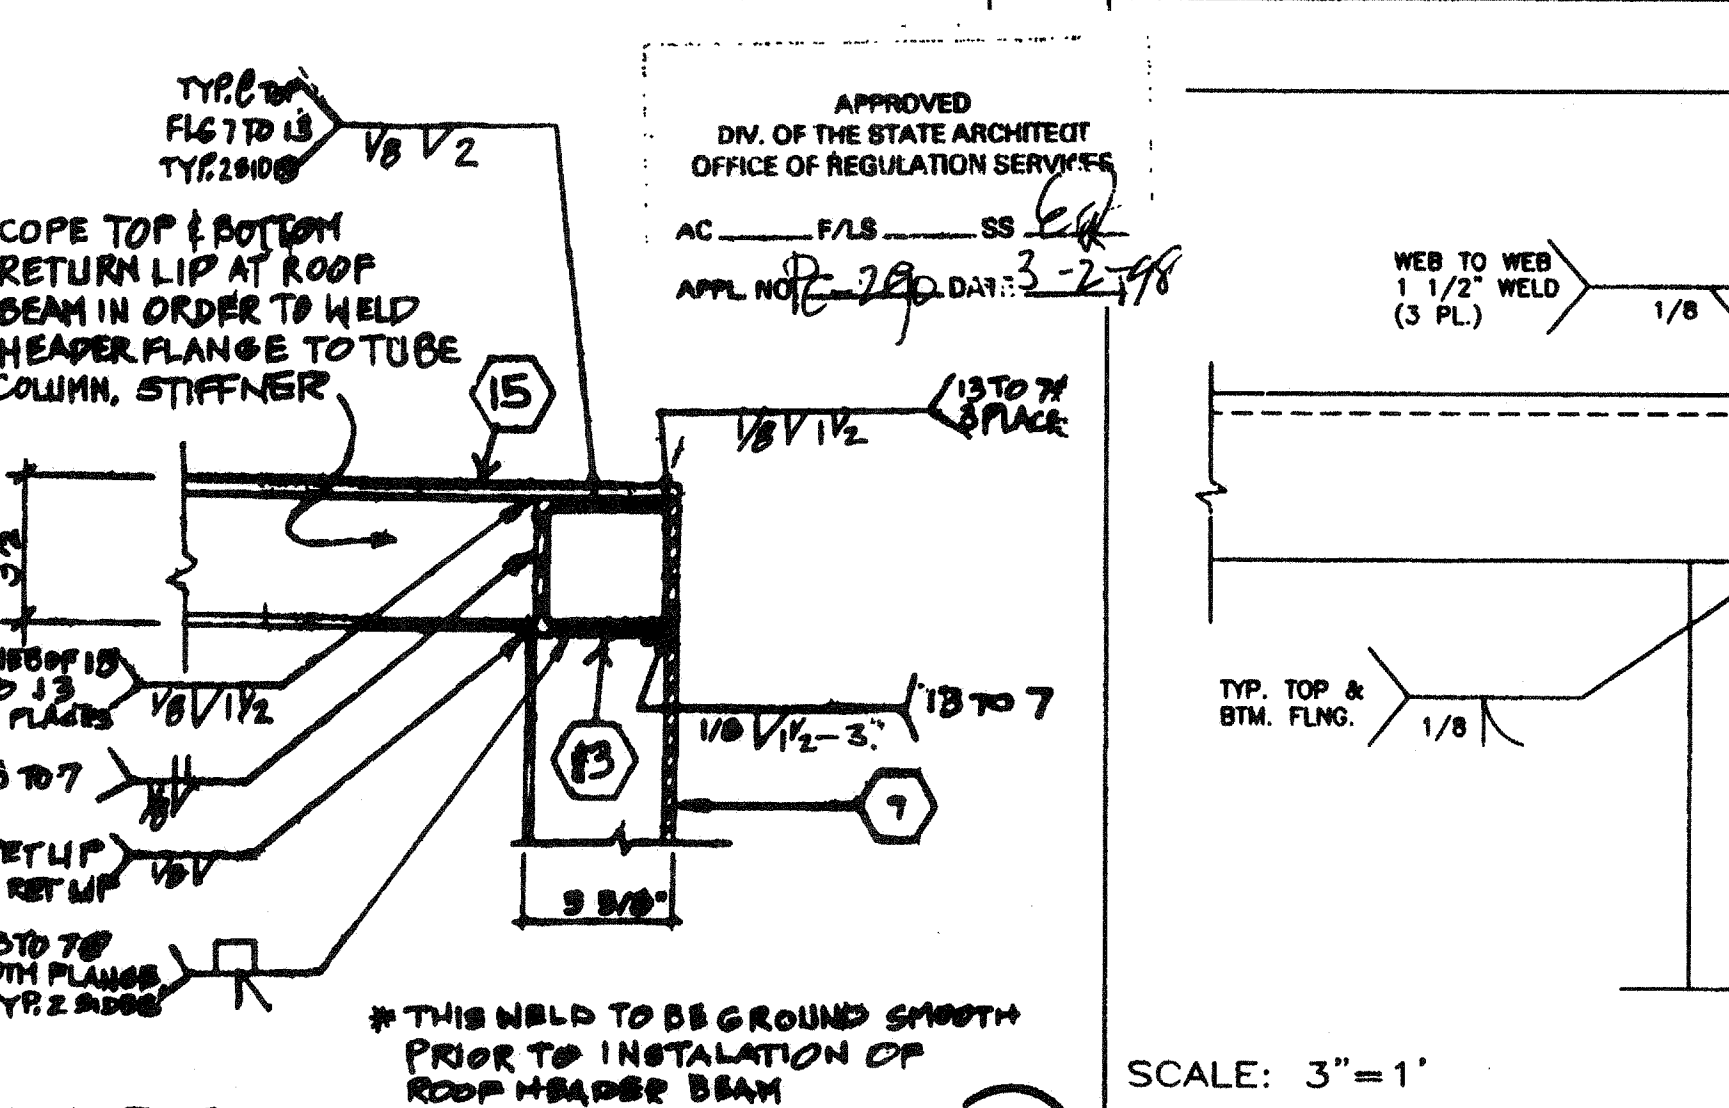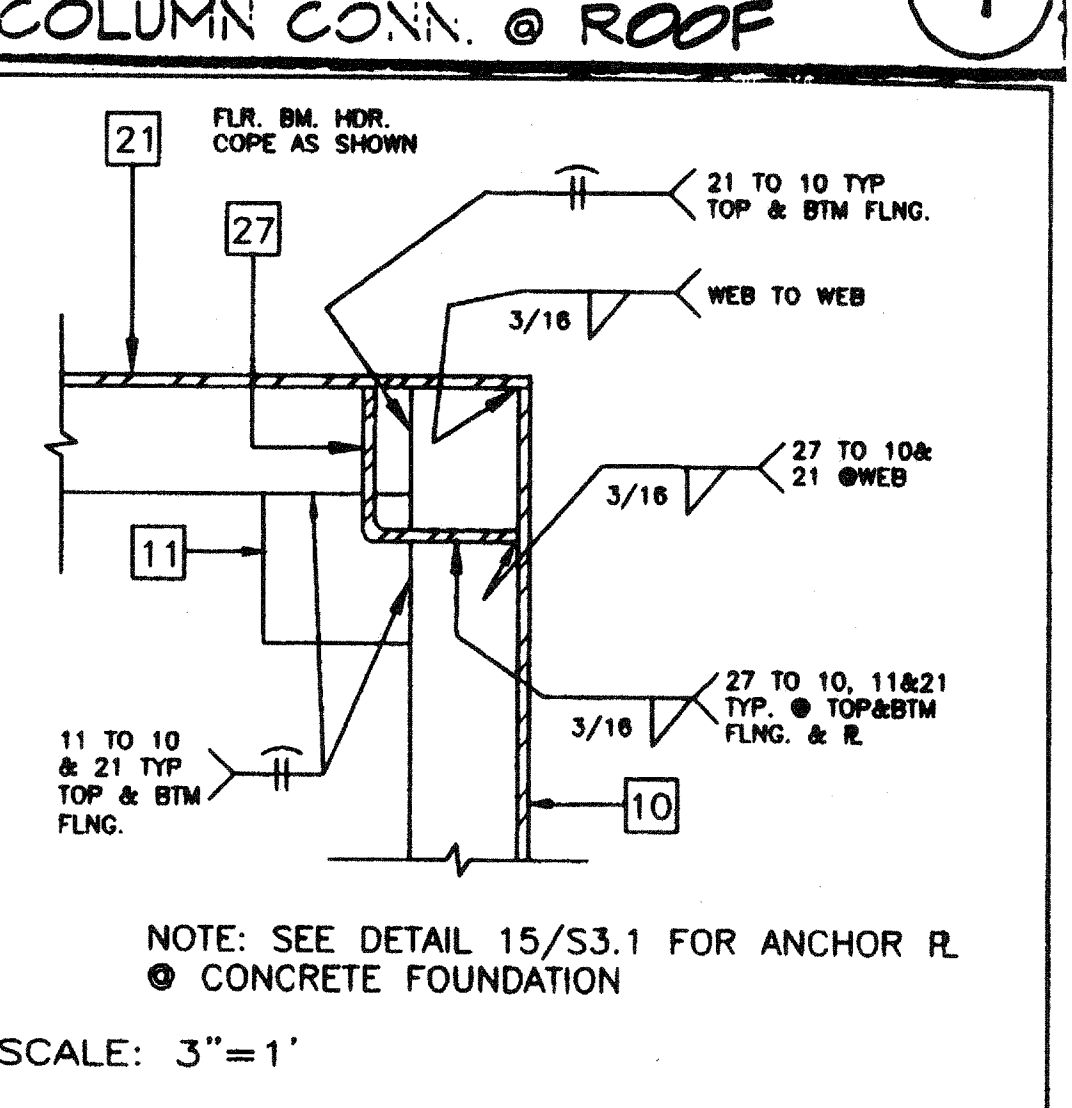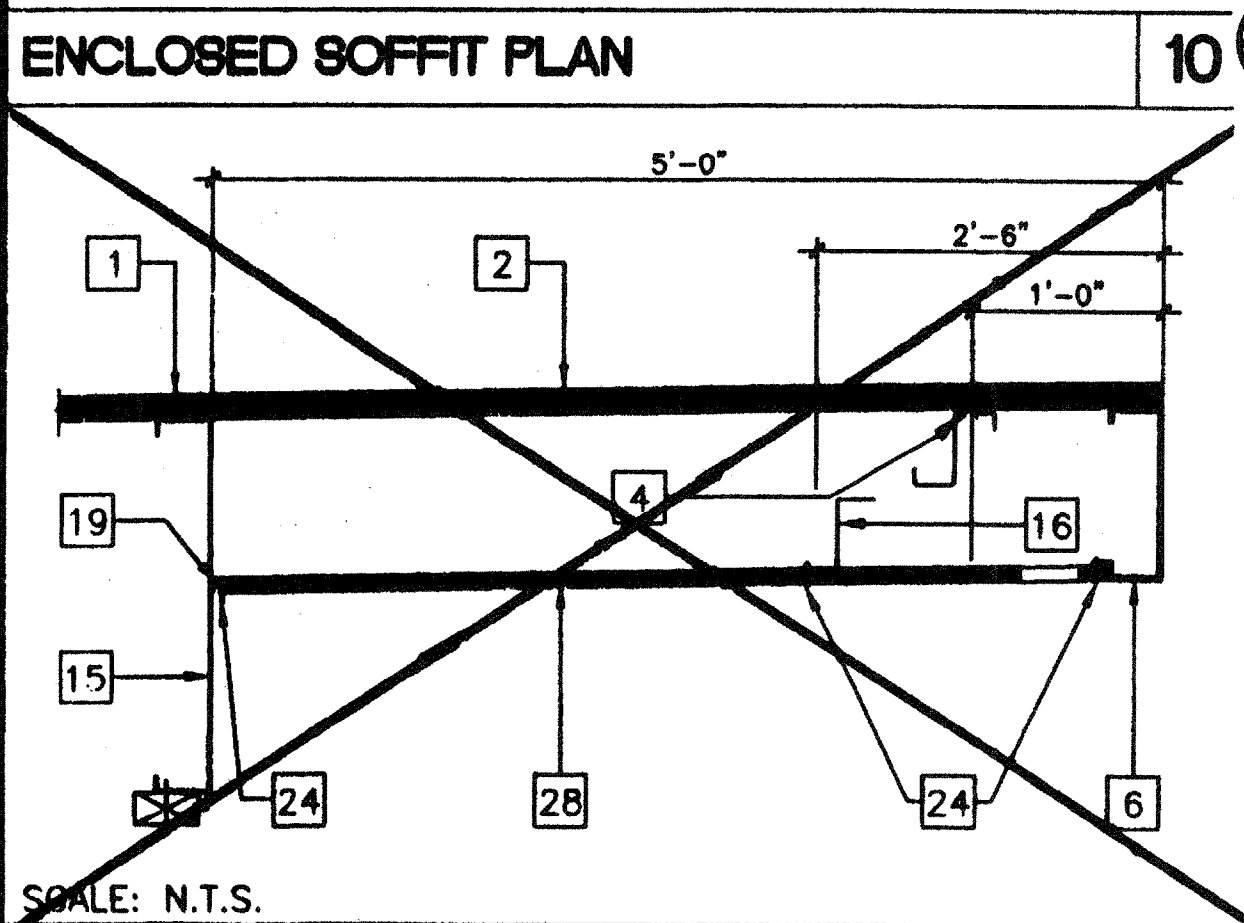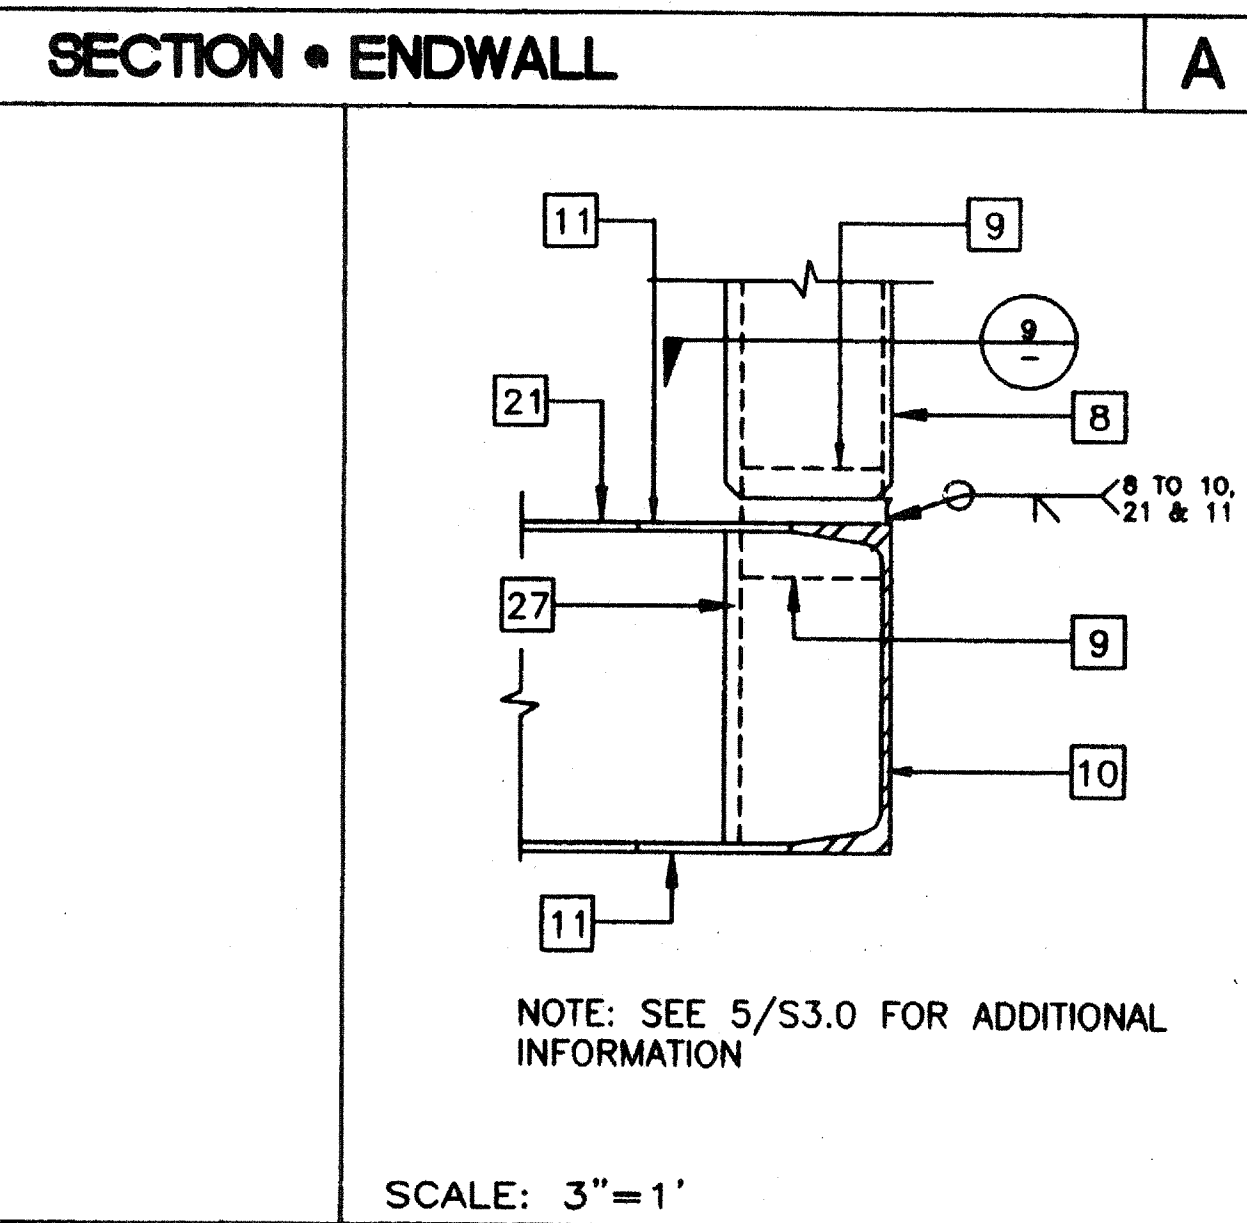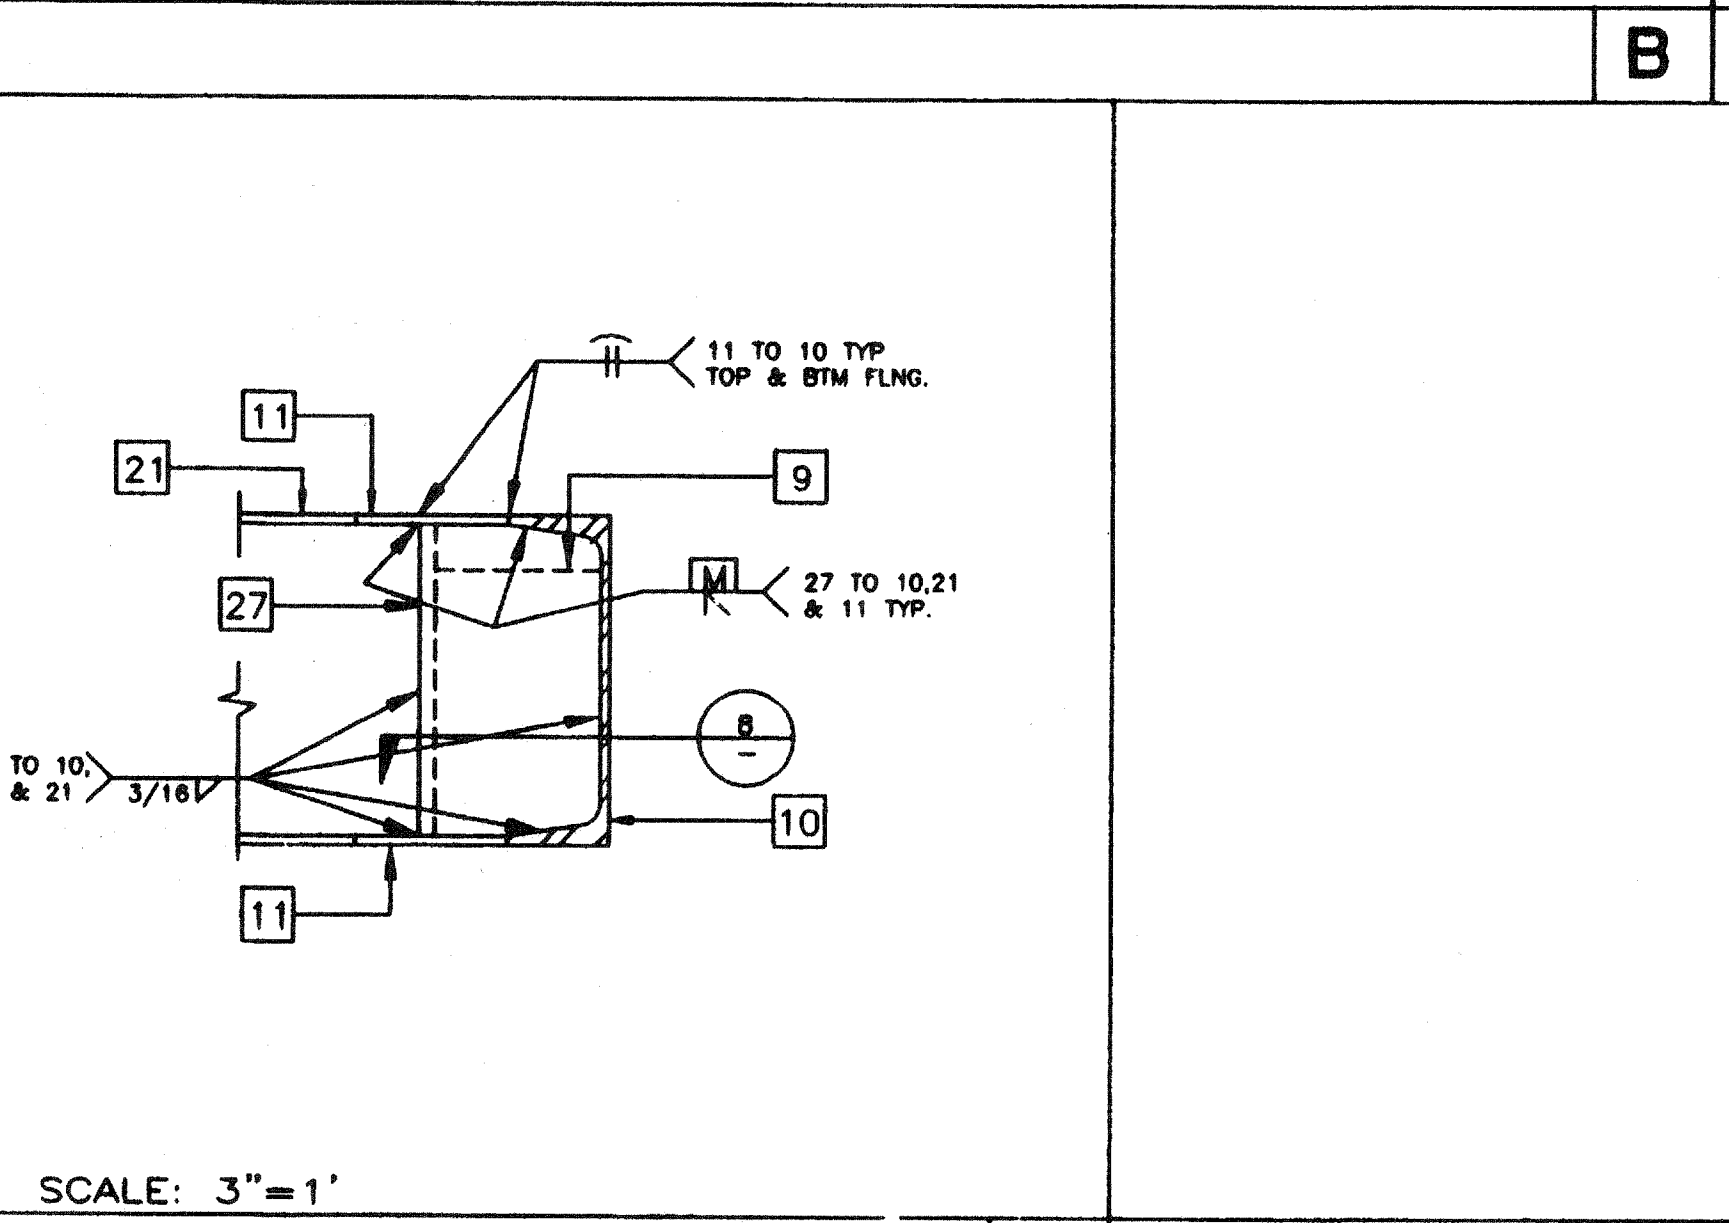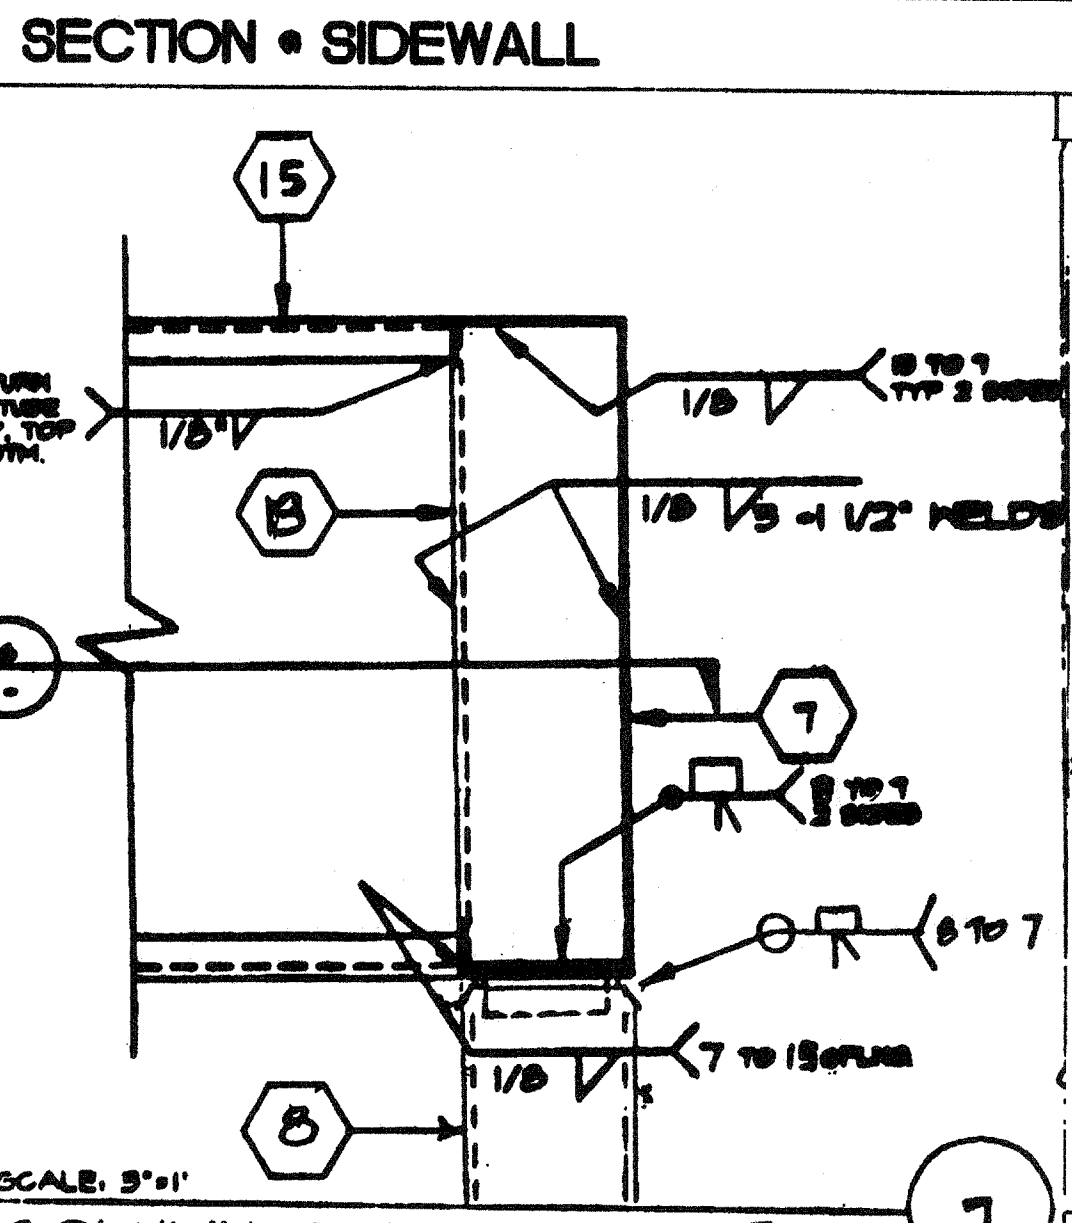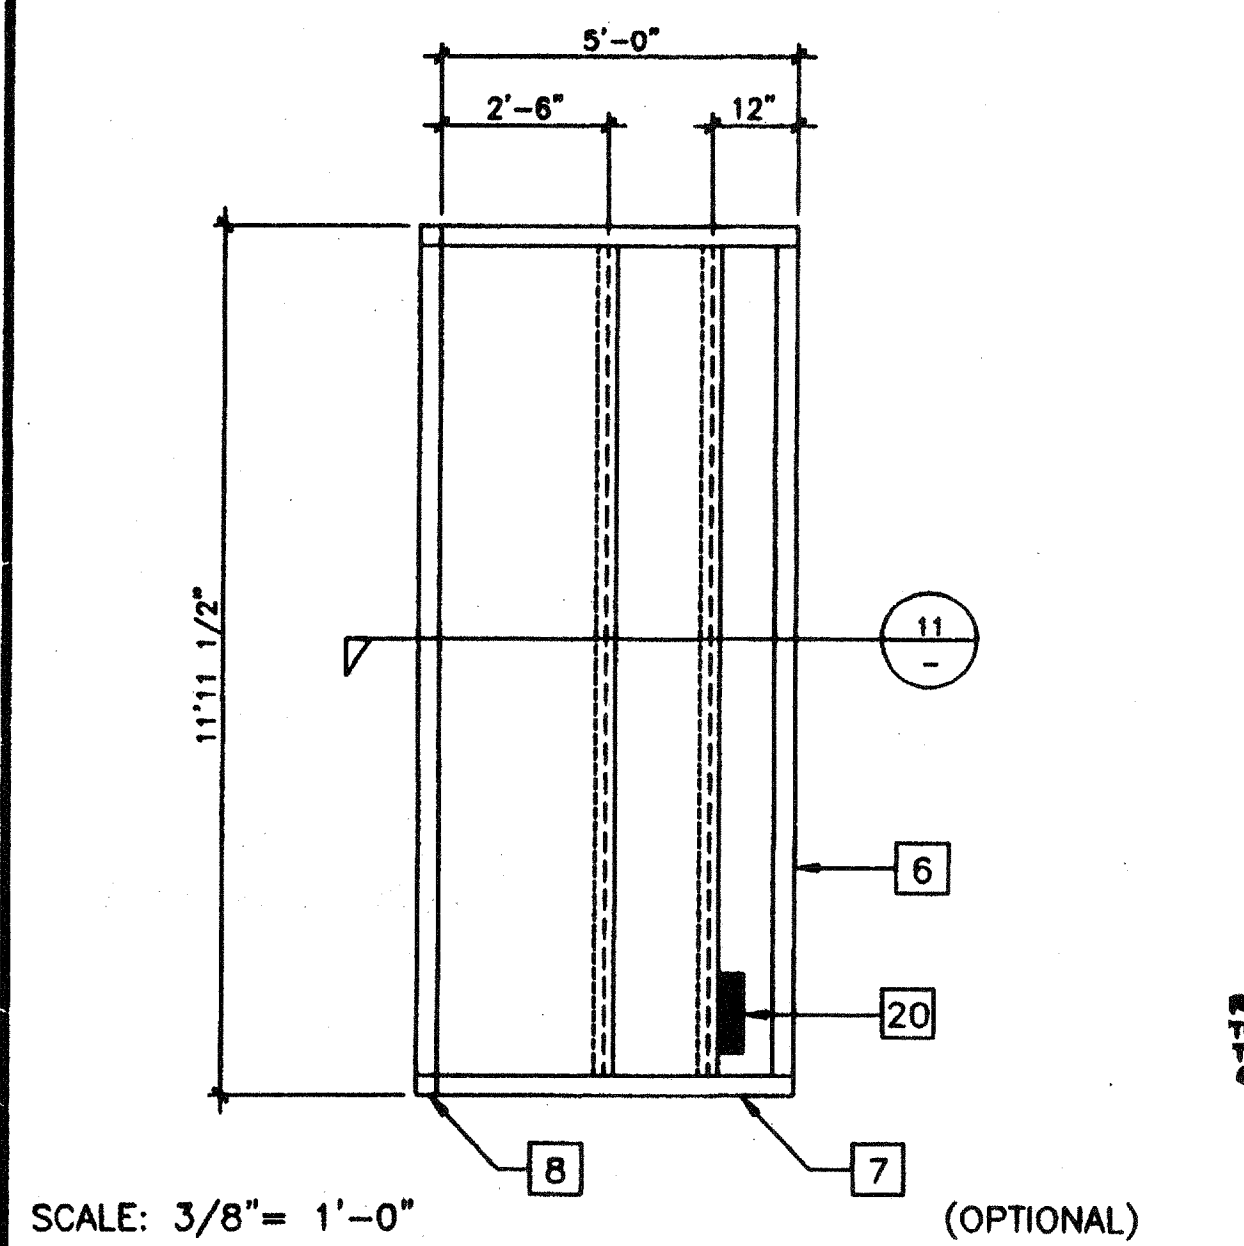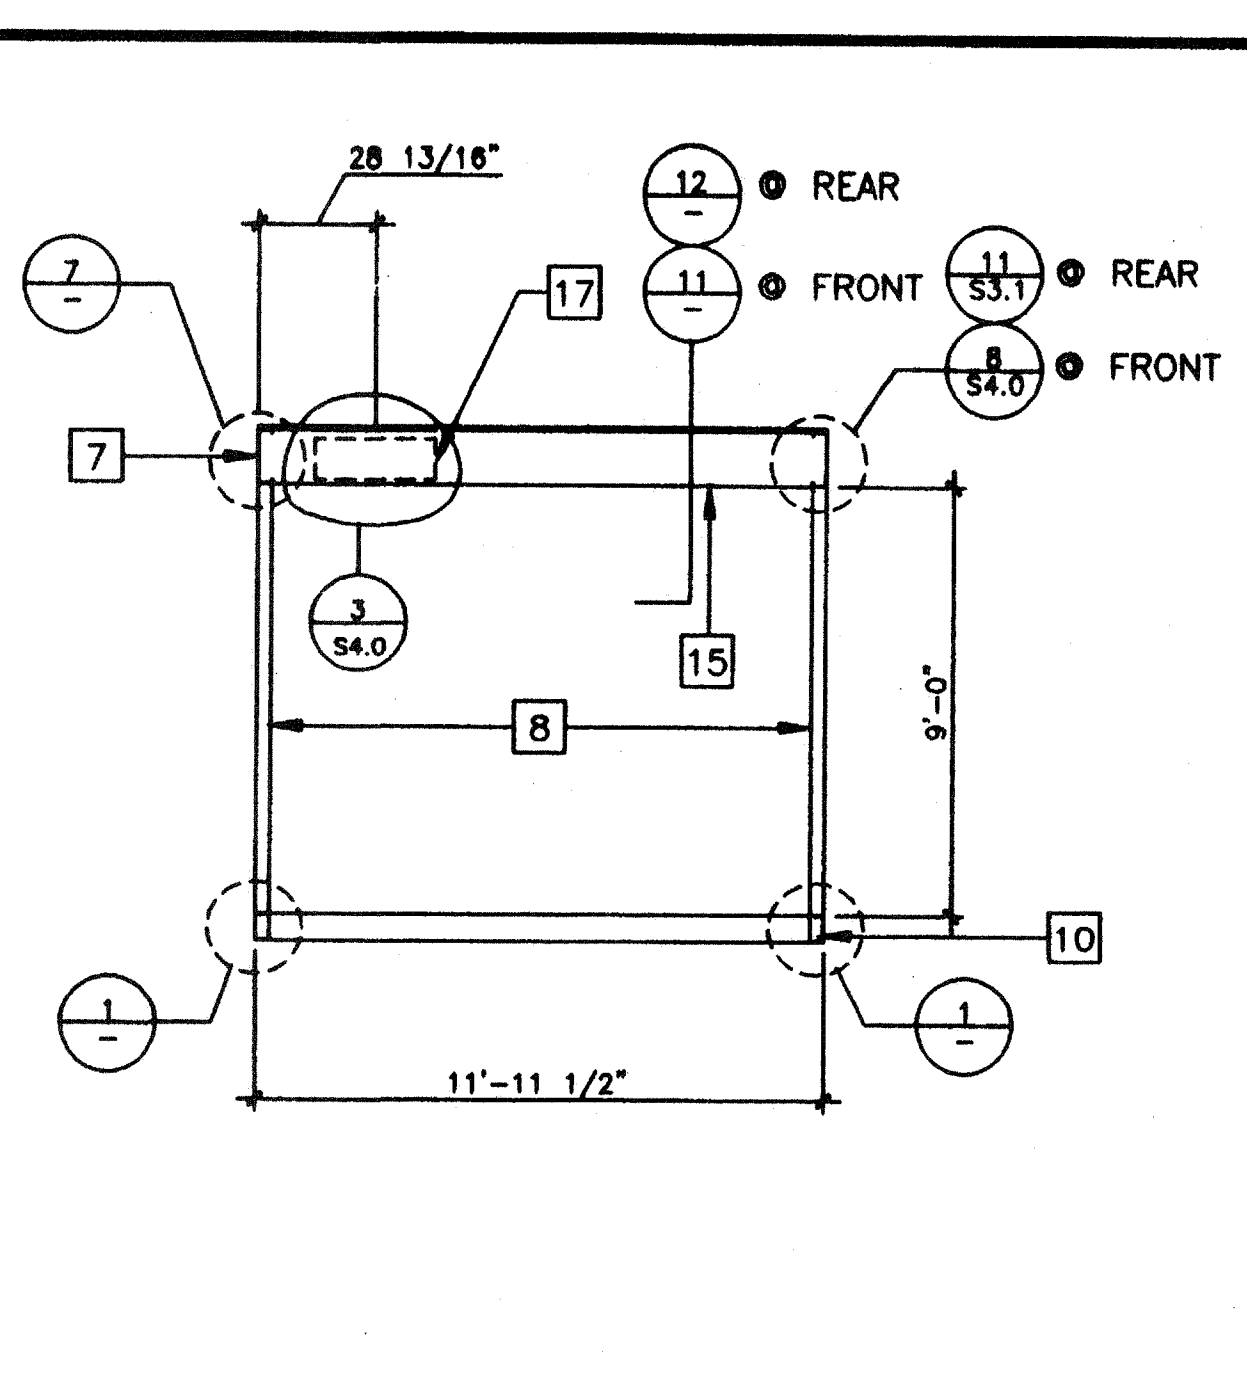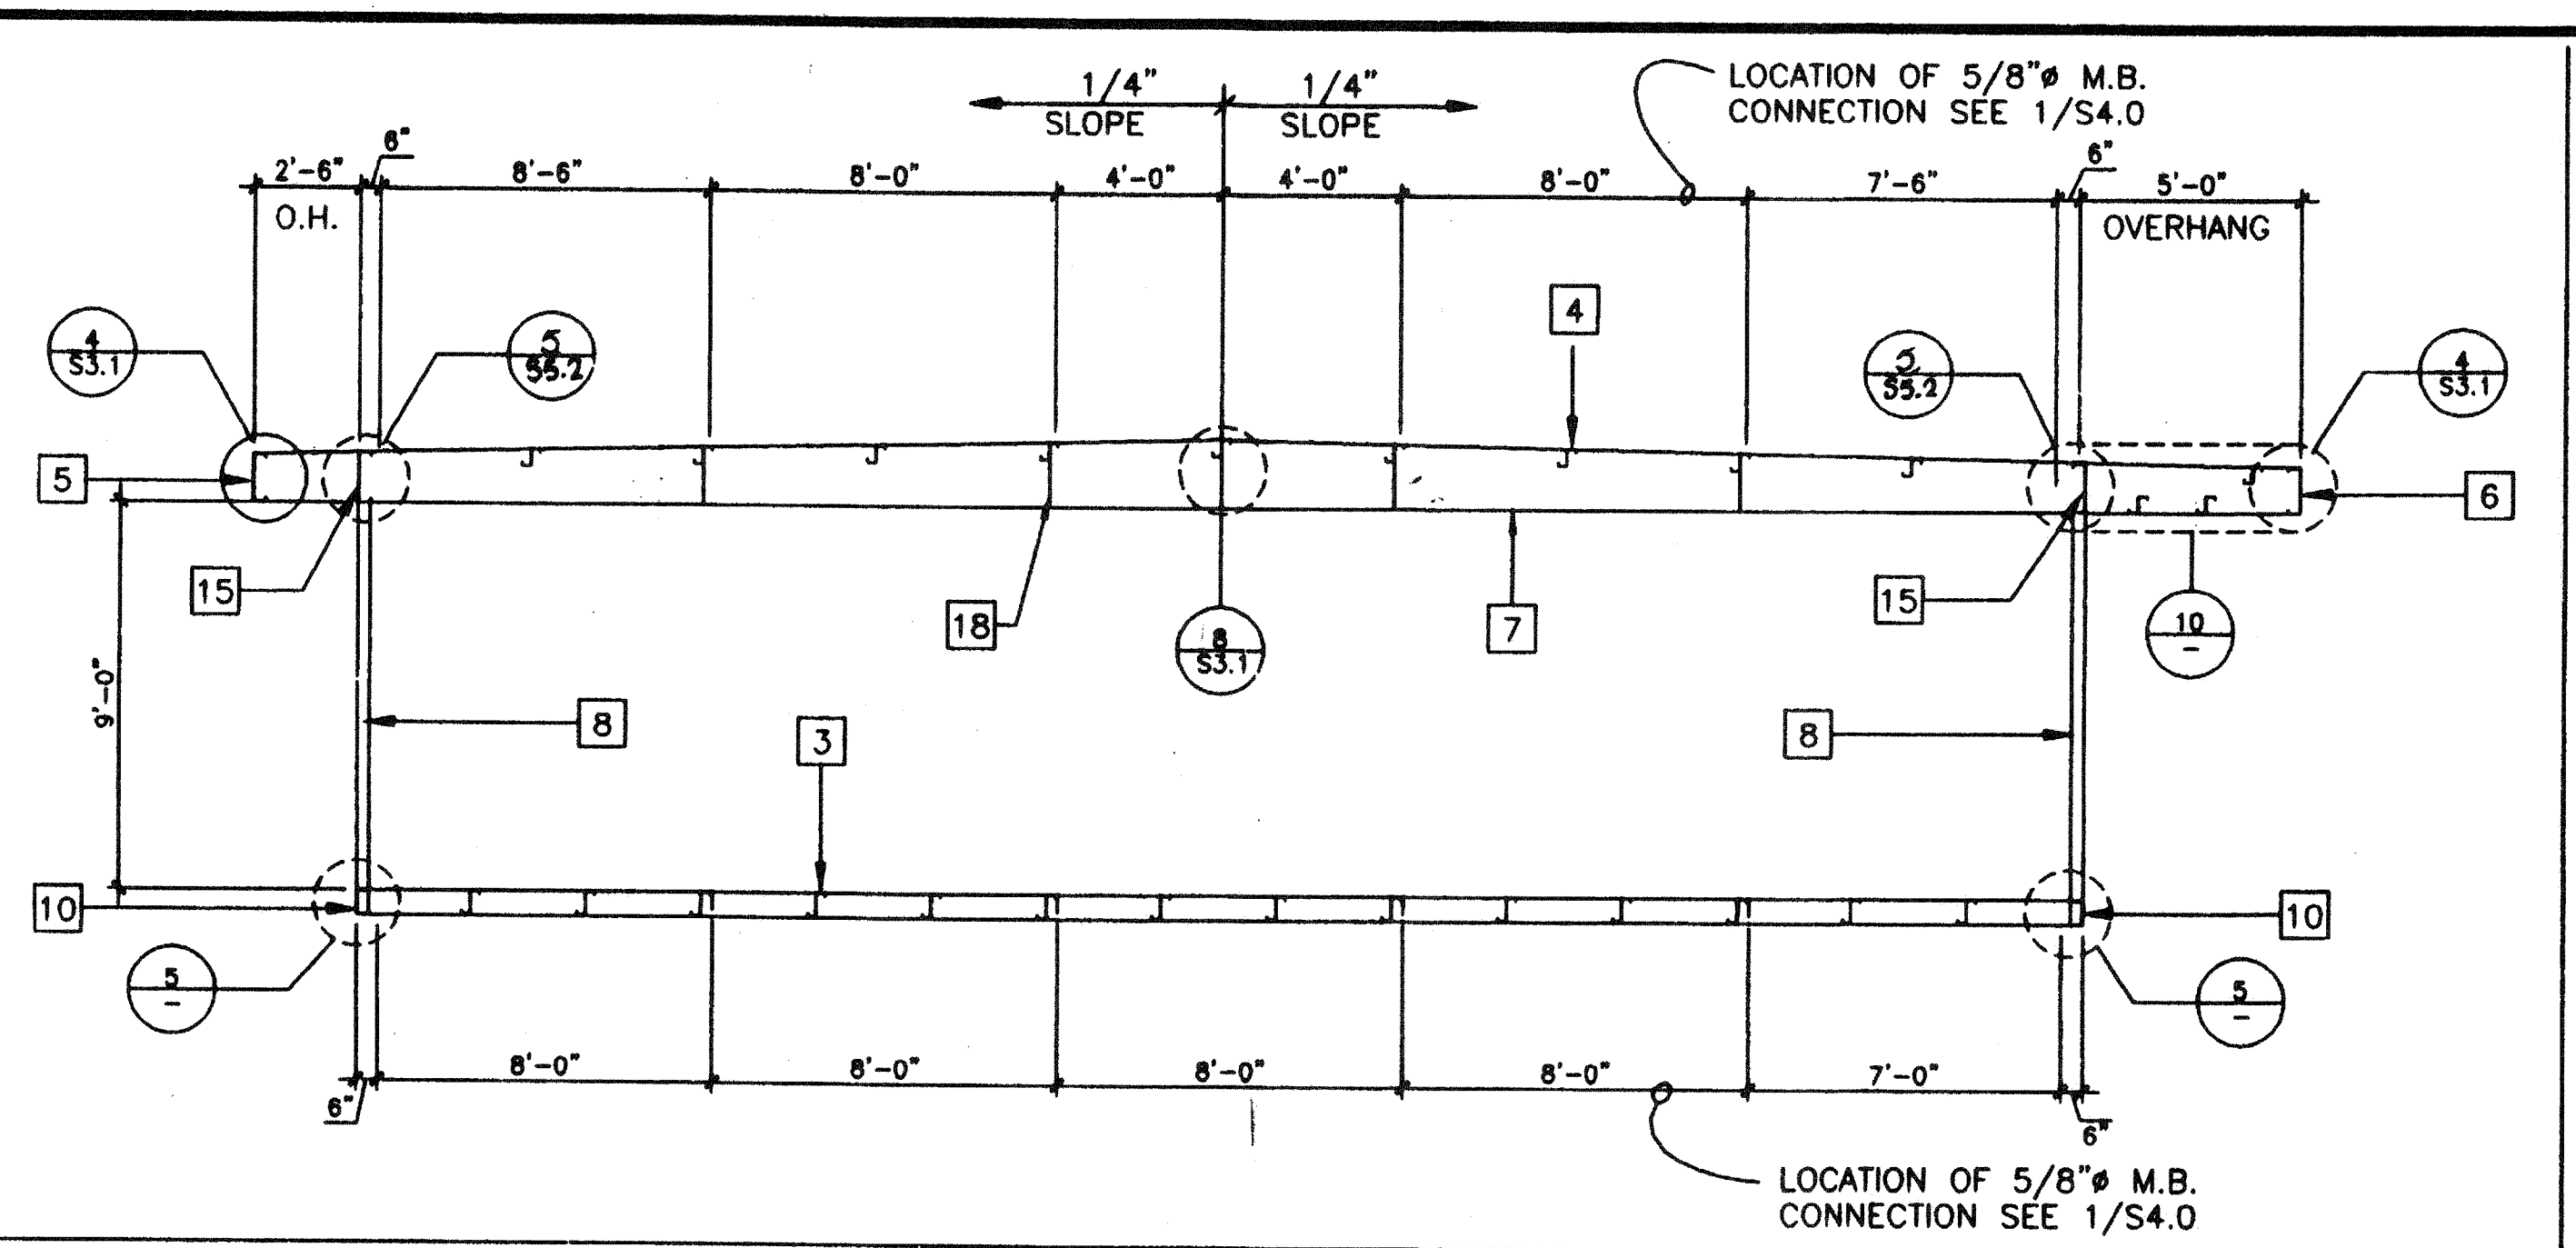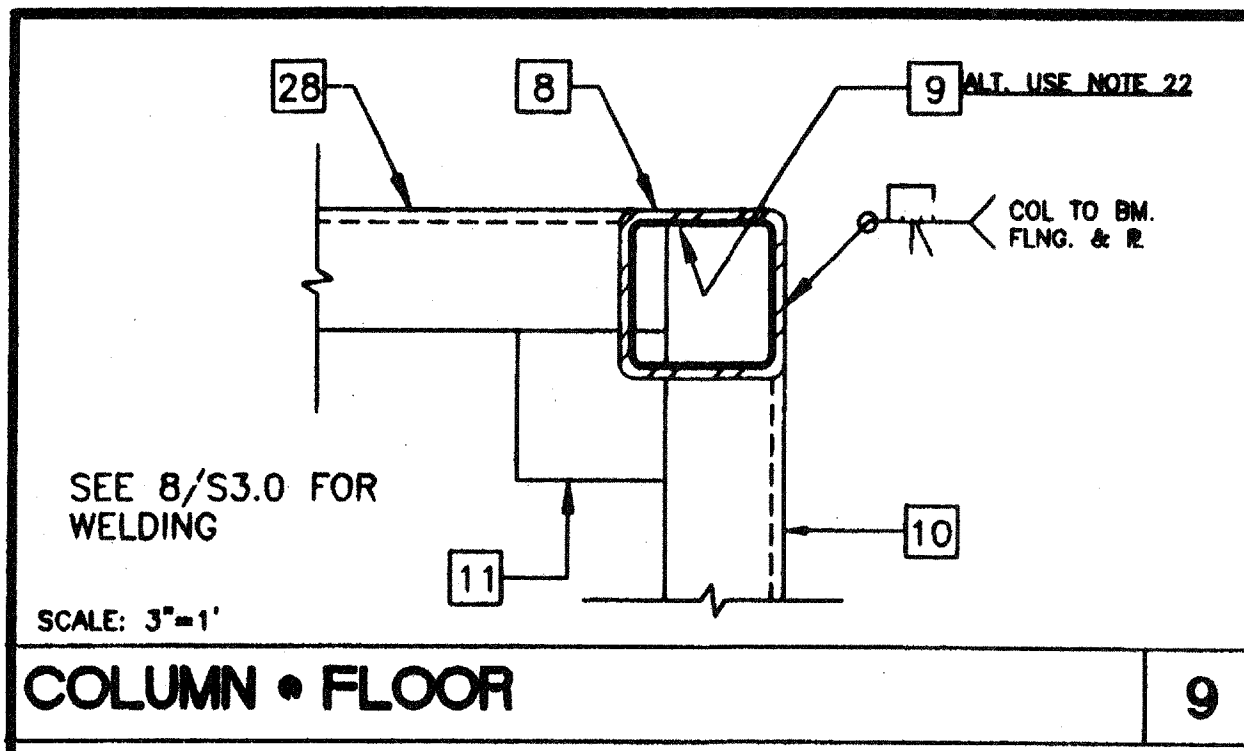

- ### KEY NOTES
- 1 EN • PLYWOOD EDGES
 - 2 PLYWOOD ROOF SHEATHING
 - 3 6 3/8"X2 1/2"X12GA. FLR. JOIST 6/S3.1
 - 4 6X2 1/2"X14GA. ROOF PURLIN 2/S3.1
 - 5 [13 3/8"X3 1/2"X14GA. FACIA 4/S3.1
• 2' OVERHANG
 - 6 [10"X3 1/2"X14GA. FACIA 4/S3.1
• 5' OVERHANG
 - 7 [10 GA. TAPERED ROOF BEAM (SEE 3/S3.1)
OR 12/S3.1 REFER TO RF. FRAMING PLAN
 - 8 3 1/2"X3 1/2"X1/4" COLUMN
 - 9 BACK-UP PLATE MIN. 10 GA.
 - 10 [7X9.8 FLOOR CHANNEL
 - 11 3 1/2"X3 1/2"X1/4" STEEL PLATE WELDED FLUSH TO TOP AND BOTTOM OF CHANNEL FLANGES
 - 12 NOT USED
 - 13 SECTION OF 3 1/2"X3 1/2"X1/4" TUBE STEEL COPE TO FIT ROOF BEAM
 - 14 NOT USED
 - 15 [14"X3 1/2"X12GA. HEADER (SEE 1/S3.1)
 - 16 "Z" STIFFENER • SOFFIT CLOSURE
 - 17 LOCATION OF HVAC
 - 18 1/4" FULL DEPTH STIFFNER PLATE AT 8'-0" O.C. U.N.O. ALIGN WITH PURLIN
 - 19 1/2"X 1 1/2"X16 GA. < TACK WELD IN PLANT
 - 20 SCREENED VENT OPENING (4"X14")
 - 21 [7X9.8 FLOOR HEADER
 - 22 NOT USED
 - 23 NOT USED
 - 24 #10 STSMS • 6" O.C. TYP. • EN & 12" OC. FM (ALT. AEROSMITH AKN 144.0175 DRIVE PIN)
 - 25 NOT USED
 - 26 NOT USED
 - 27 3 1/2"X3 1/2"X1/4" TUBE STEEL CUT TO FIT FLOOR BEAM
 - 28 SOFFIT PLYWOOD

NO.	REVISIONS
1	
2	
3	
4	
5	

Electrical Engineer's Seal

Mechanical Engineer's Seal

Structural Engineer's Seal

Architect's Seal

APPROVED ARCHITECT

GEORGE C. EDWARDS

NO. 2192

EXPIRES 9-30-99

STATE OF CALIFORNIA

LICENSE # 1566-2000

APPROVED

DIV. OF THE STATE ARCHITECT

OFFICE OF REGULATION SERVICES

AC FLS SS

APPL. NO. 269

DATE: 3-2-98

WEB TO WEB 1 1/2" WELD (3 FL)

1/8"

TYP. TOP & BTM. FLNG. 1/8"

SCALE: 3"=1"

PROJECT NUMBER: 266

© MODTECH, INC. 1997

drawn by: CM 4012-088

checked by: 05 JAN 99

date:

Modtech project no:

MODTECH Index No.

2986

IDENTIFICATION STAMP

DIV. OF THE STATE ARCHITECT

OFFICE OF REGULATION SERVICES

100325

AC FLS SS

DATE: JAN 07 1999

IDENTIFICATION STAMP

DIV. OF THE STATE ARCHITECT

OFFICE OF REGULATION SERVICES

APP#3 117168

AC FLS SS

DATE: AUG 04 2016

STKP-42D

MODTECH INC.

2830 BARRETT AVENUE

PERRIS, CALIF. 92572

PH (909) 943-4014

FAX (909) 940-0427




















PROJECT NUMBER: 266

MONTEREY PENINSULA U.S.D.

FRAMING ELEVATIONS / DETAILS

S3.0

PROJECT NO. 266

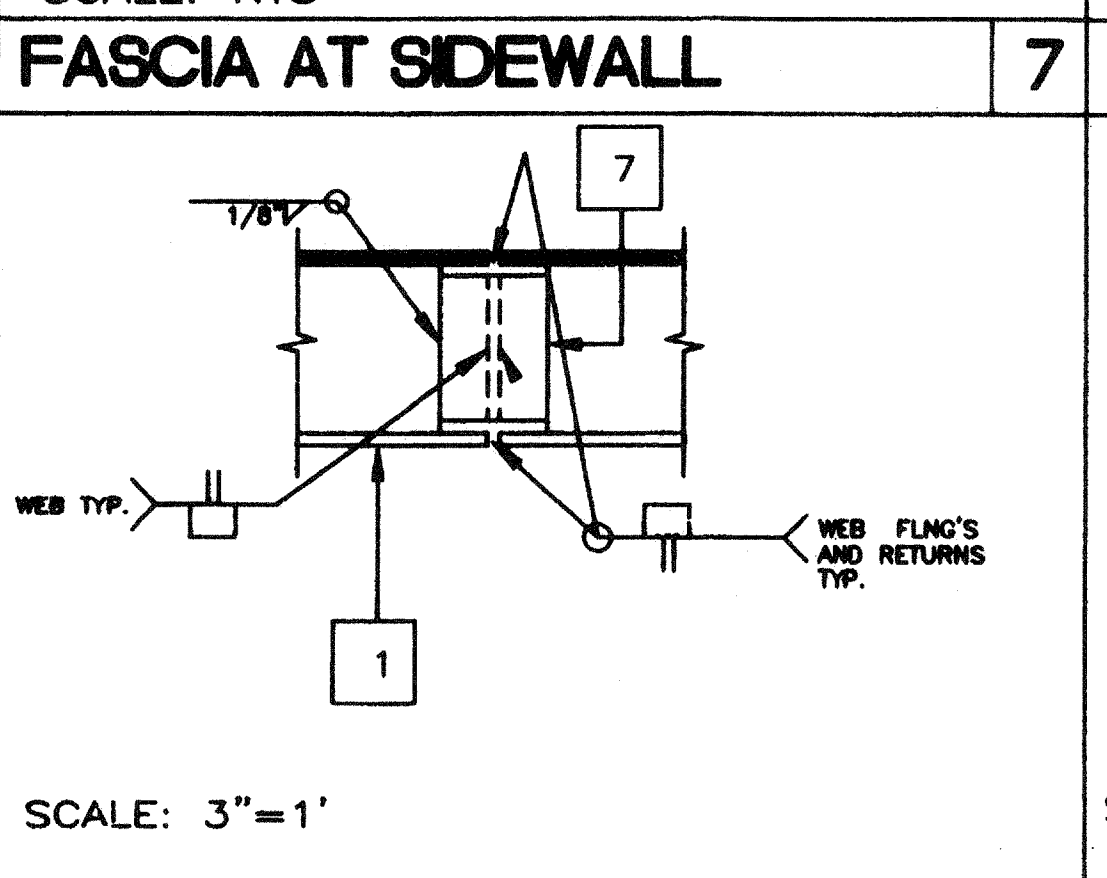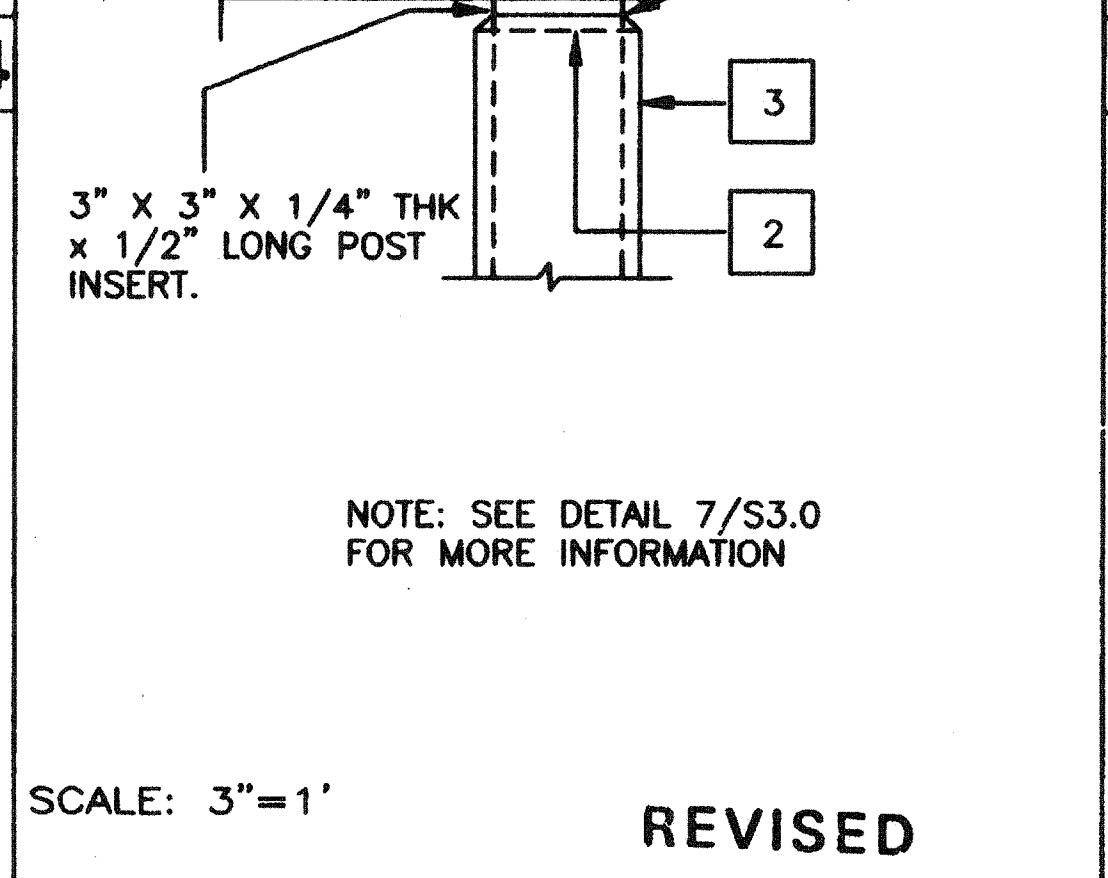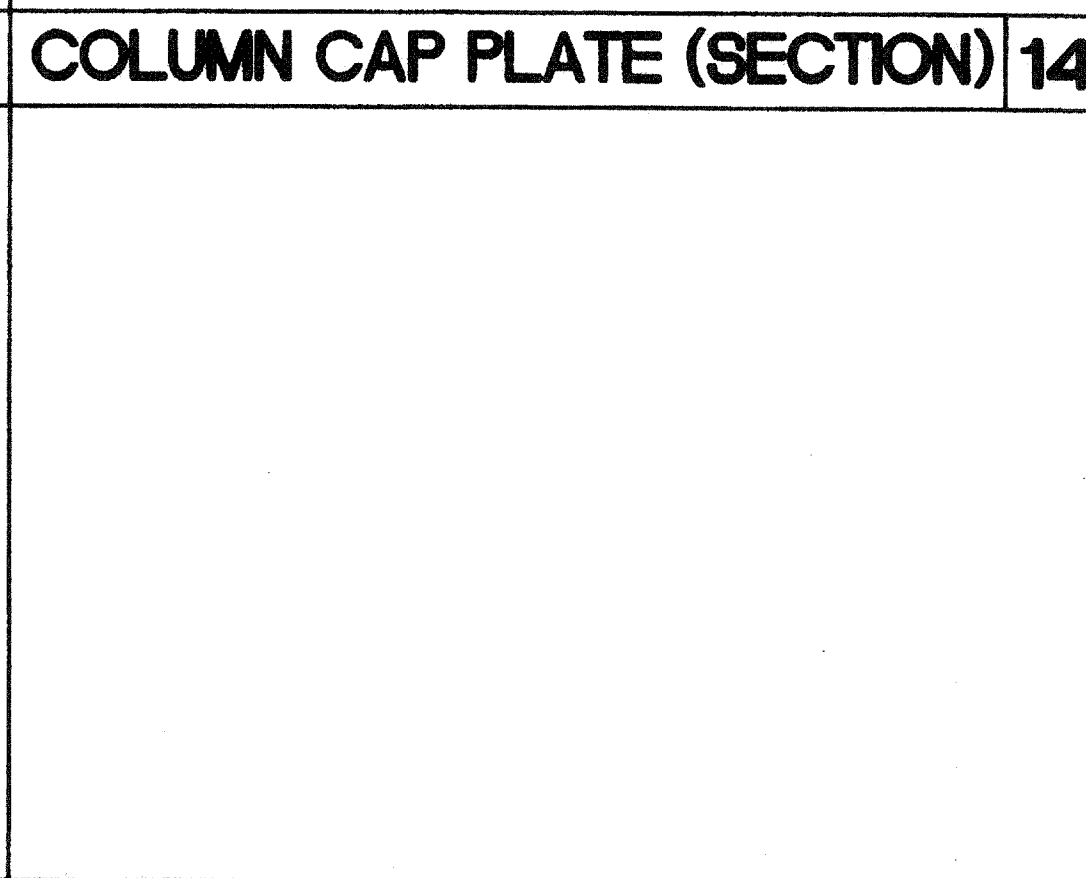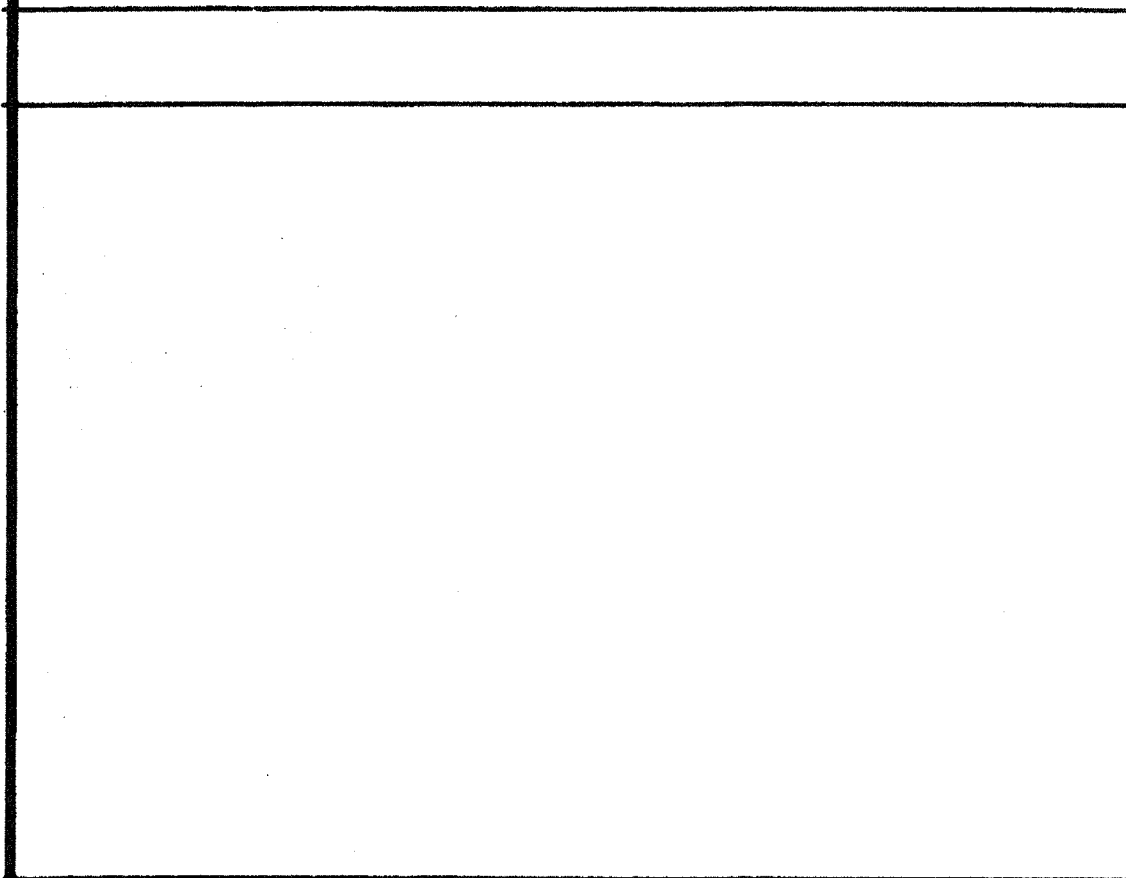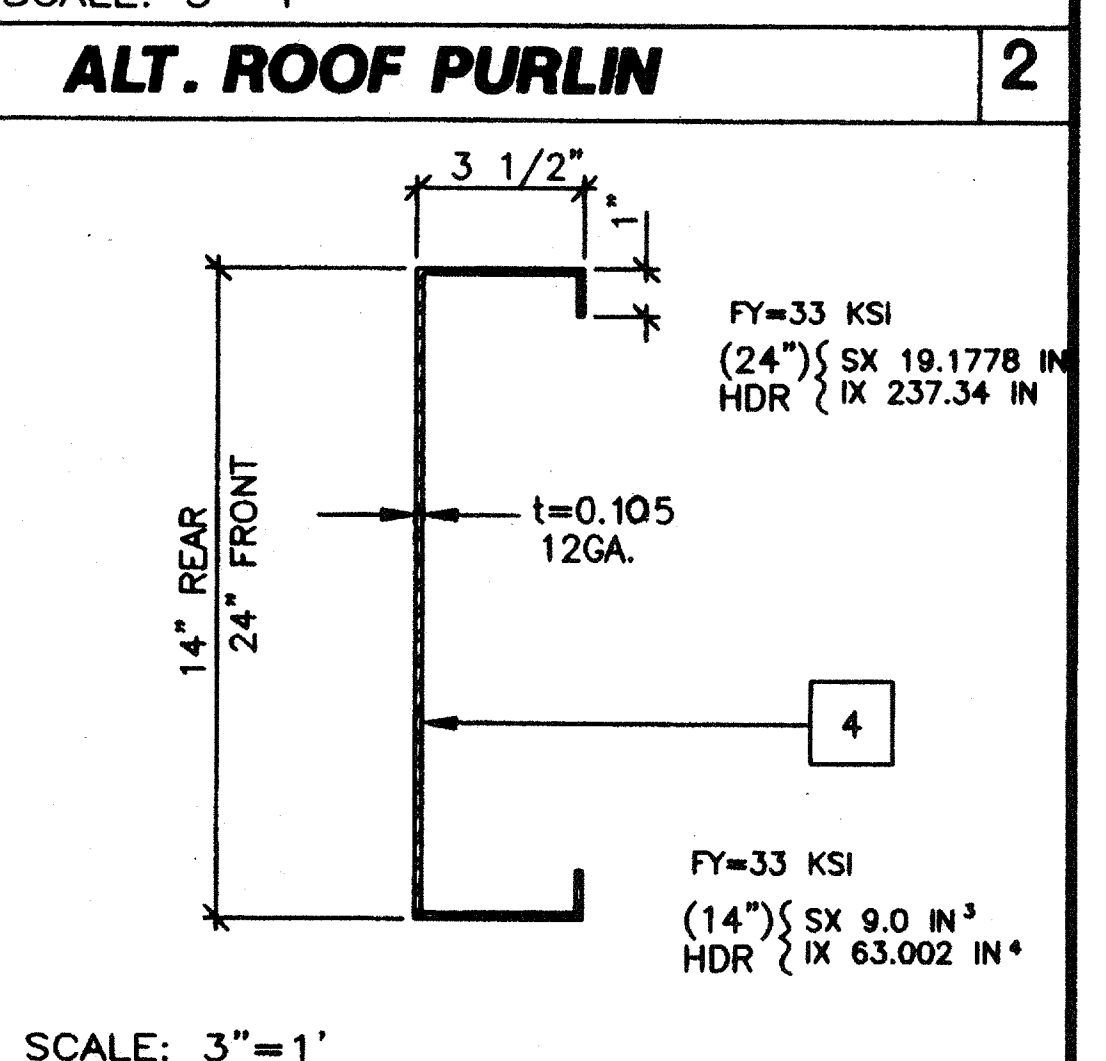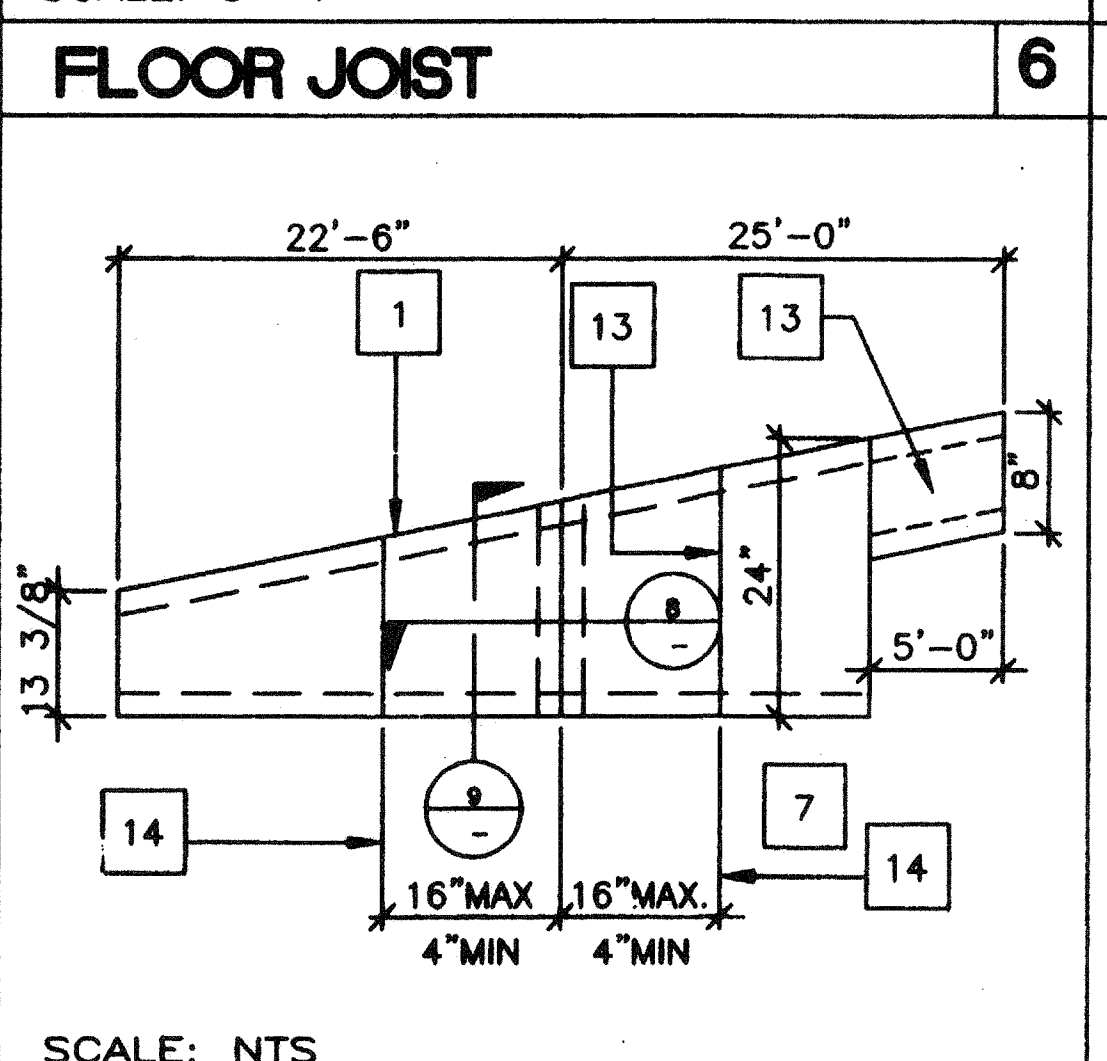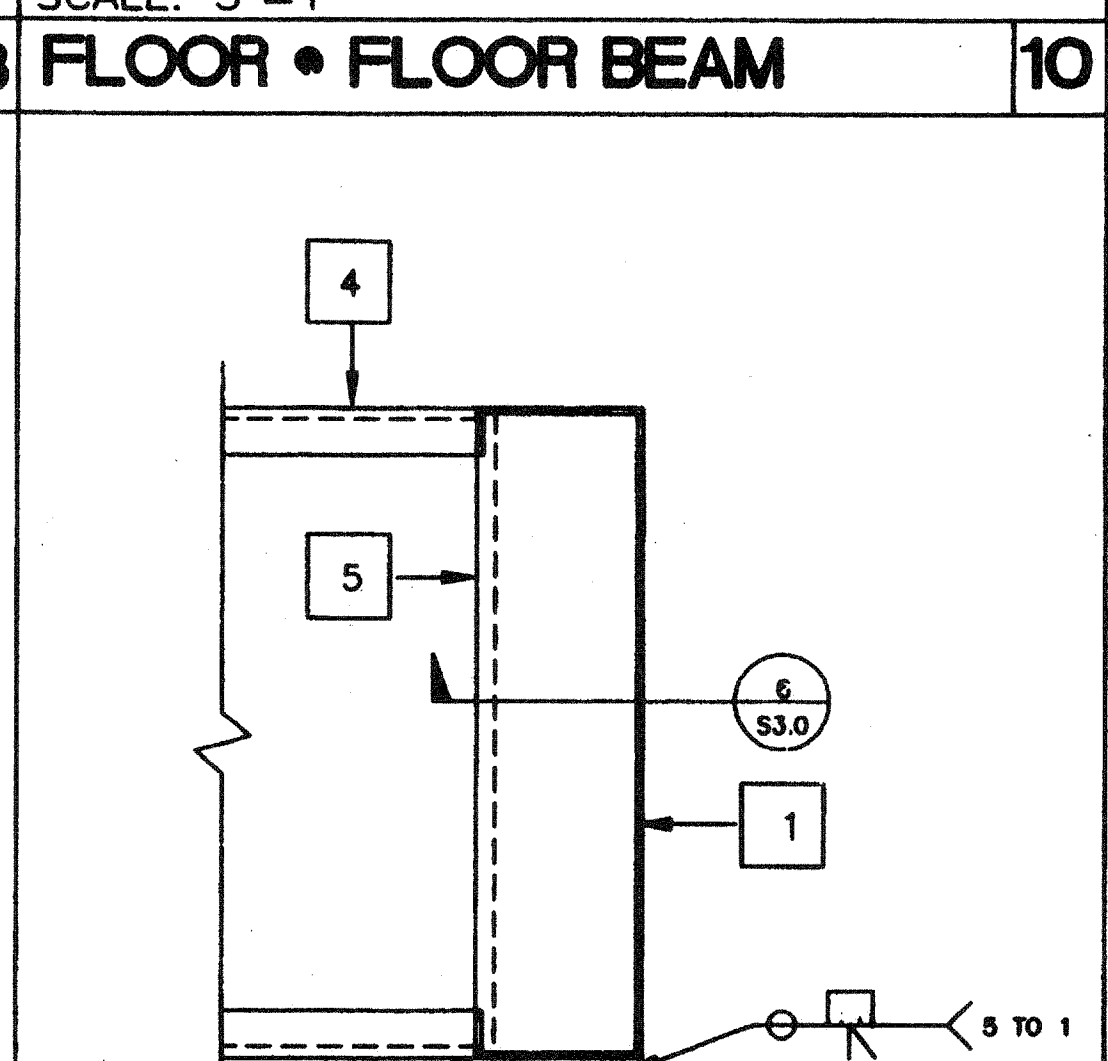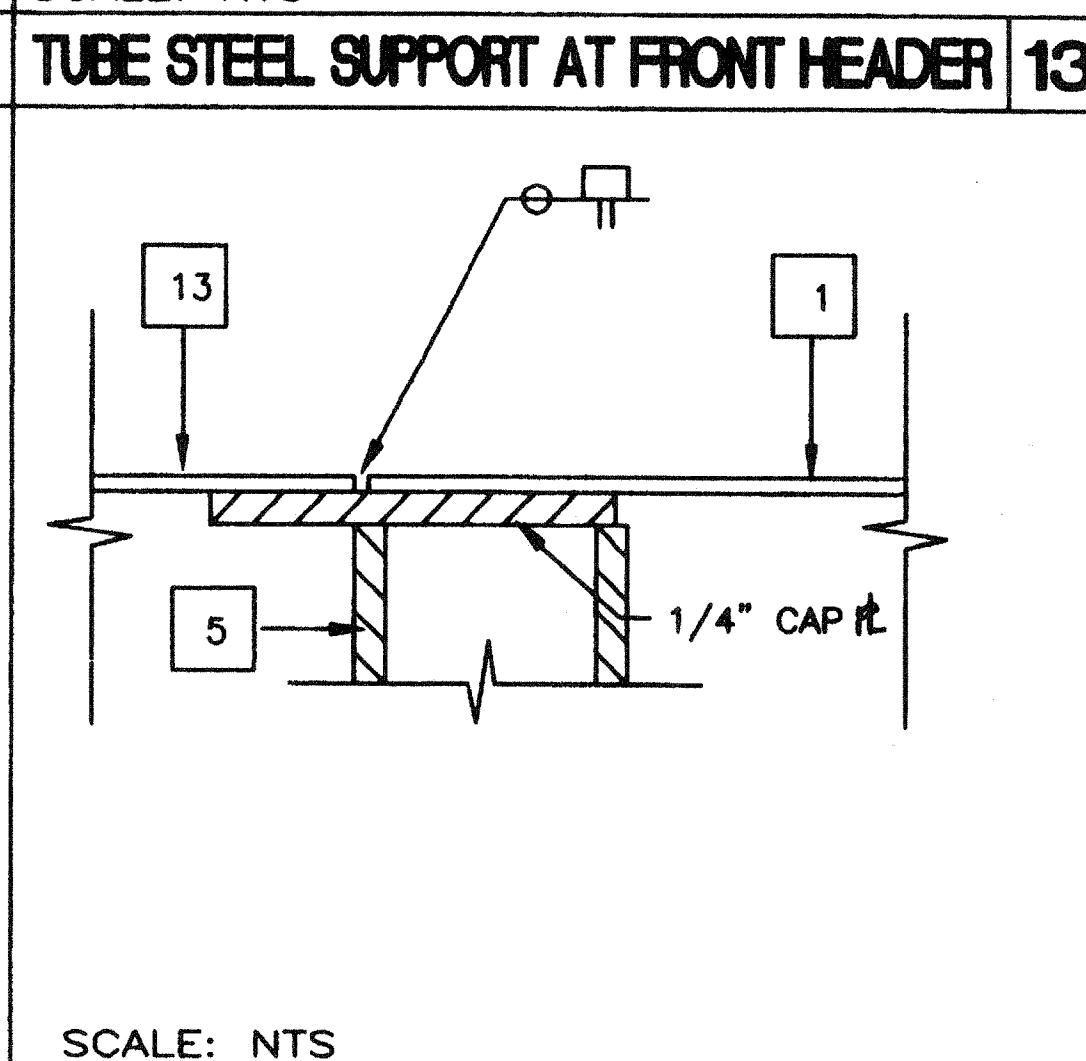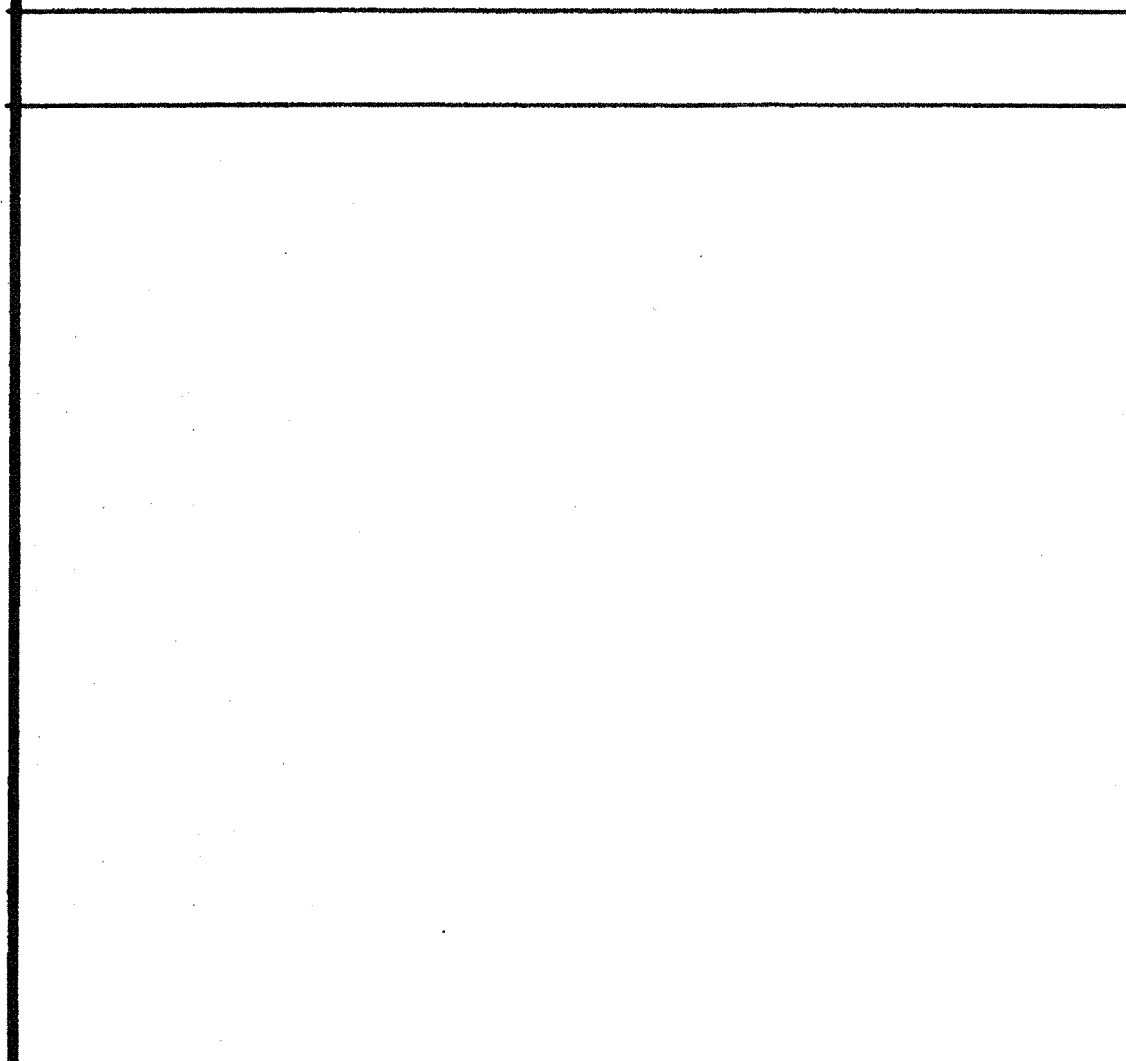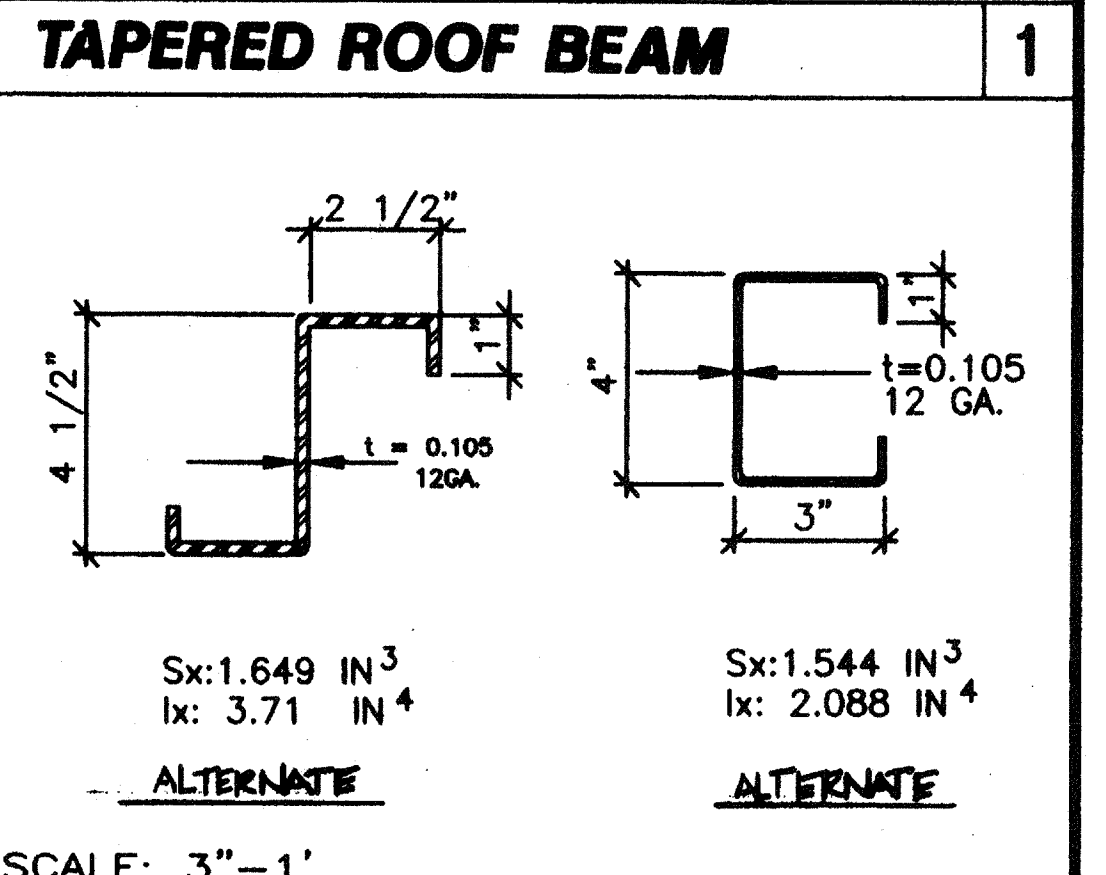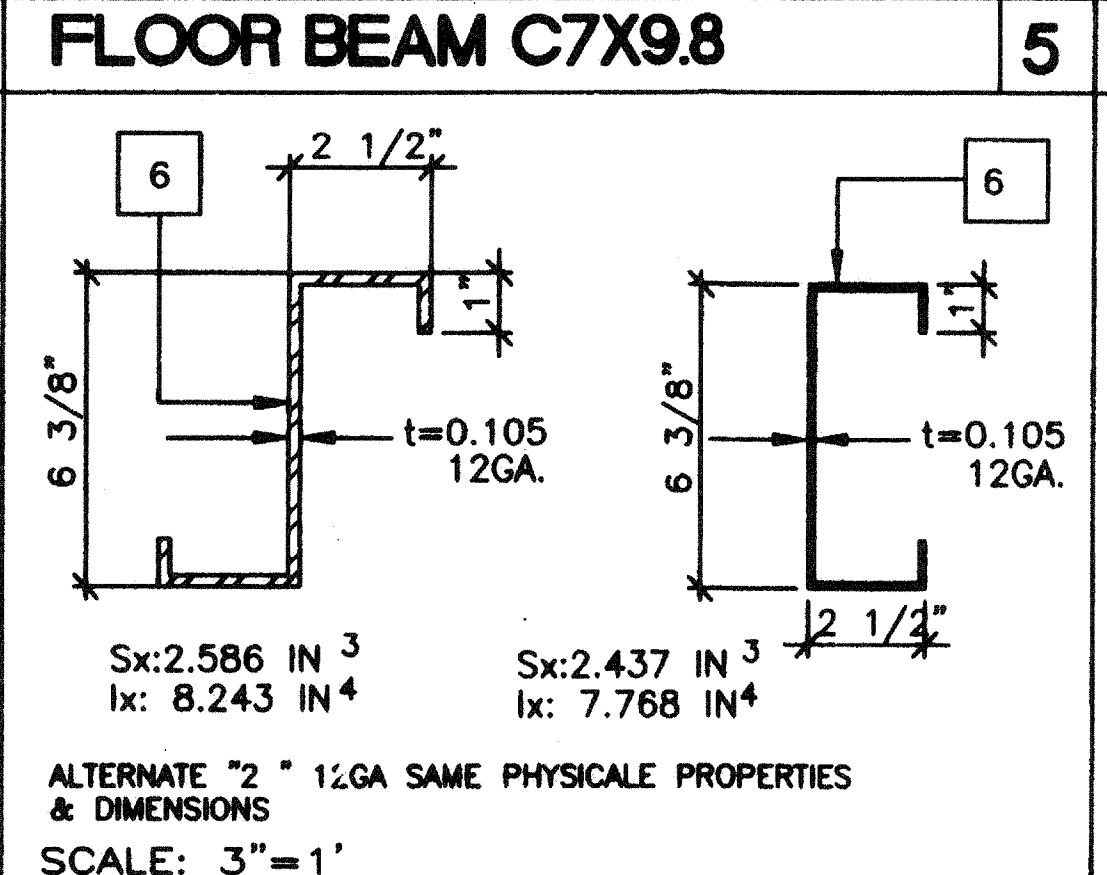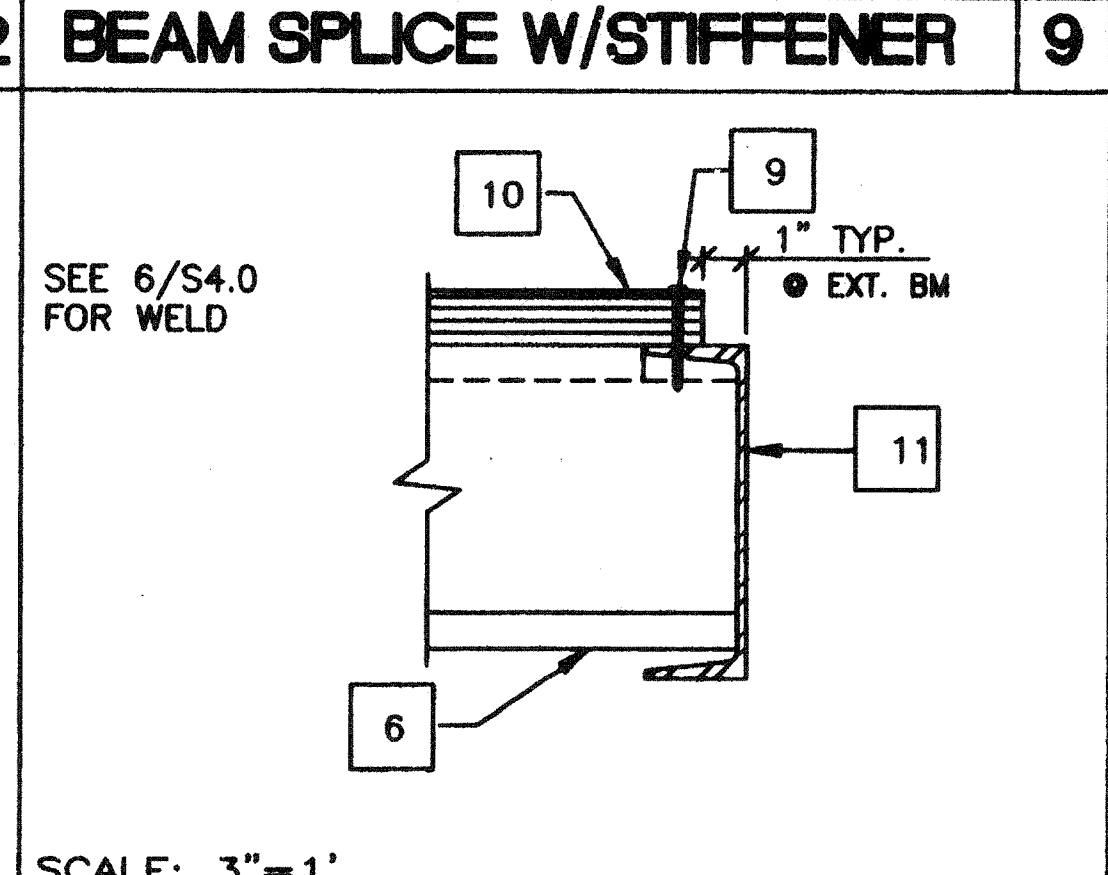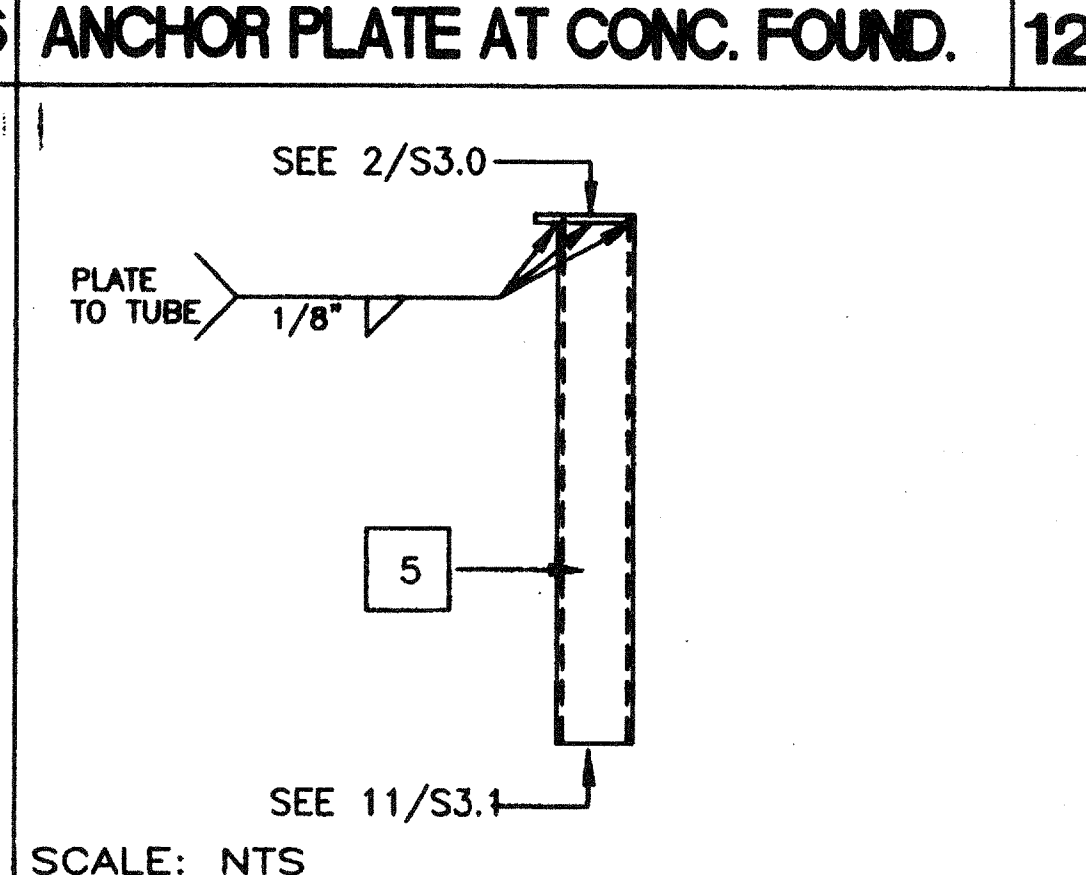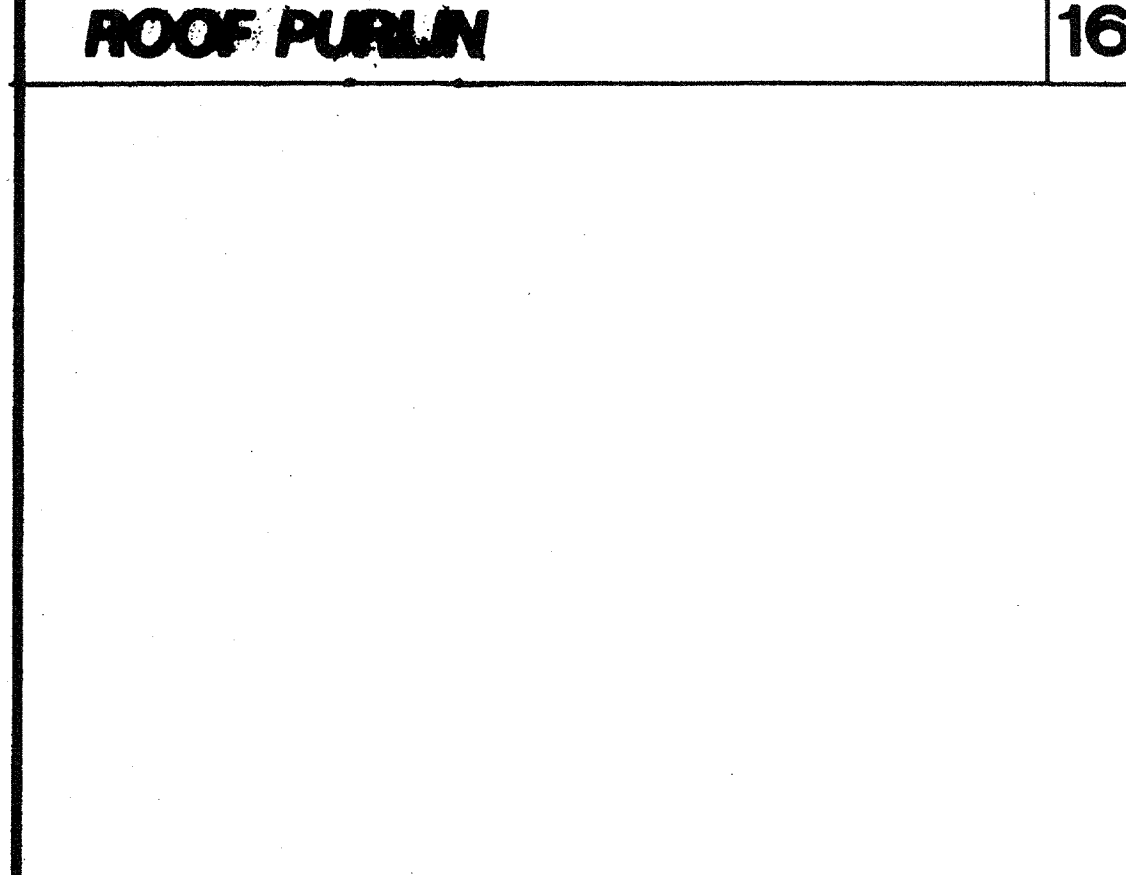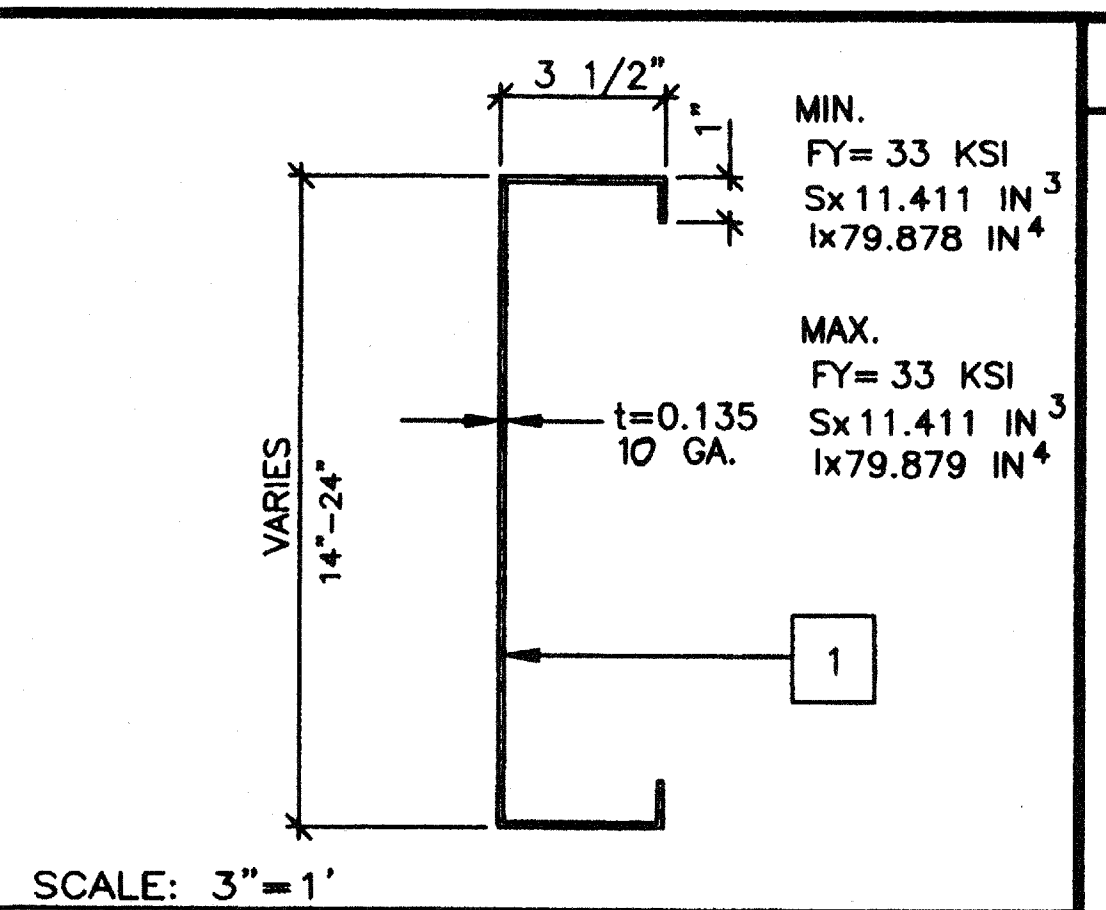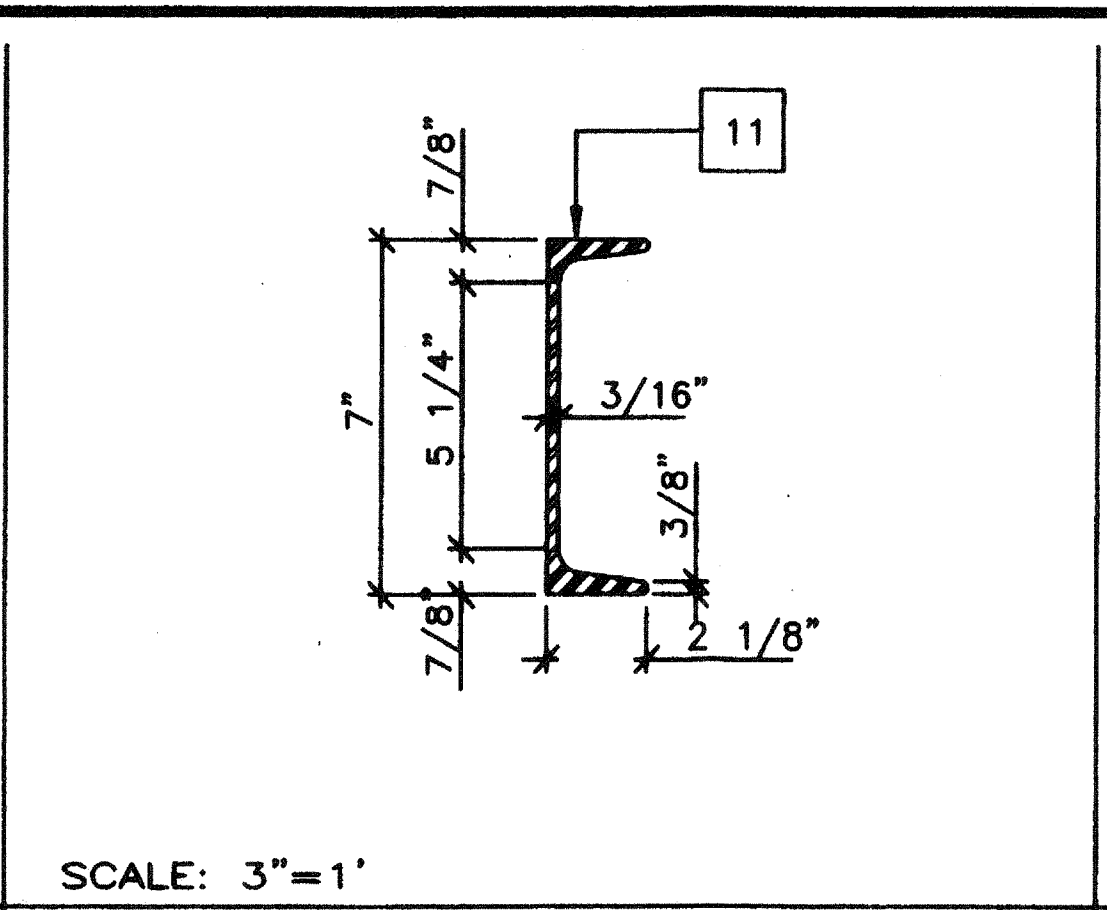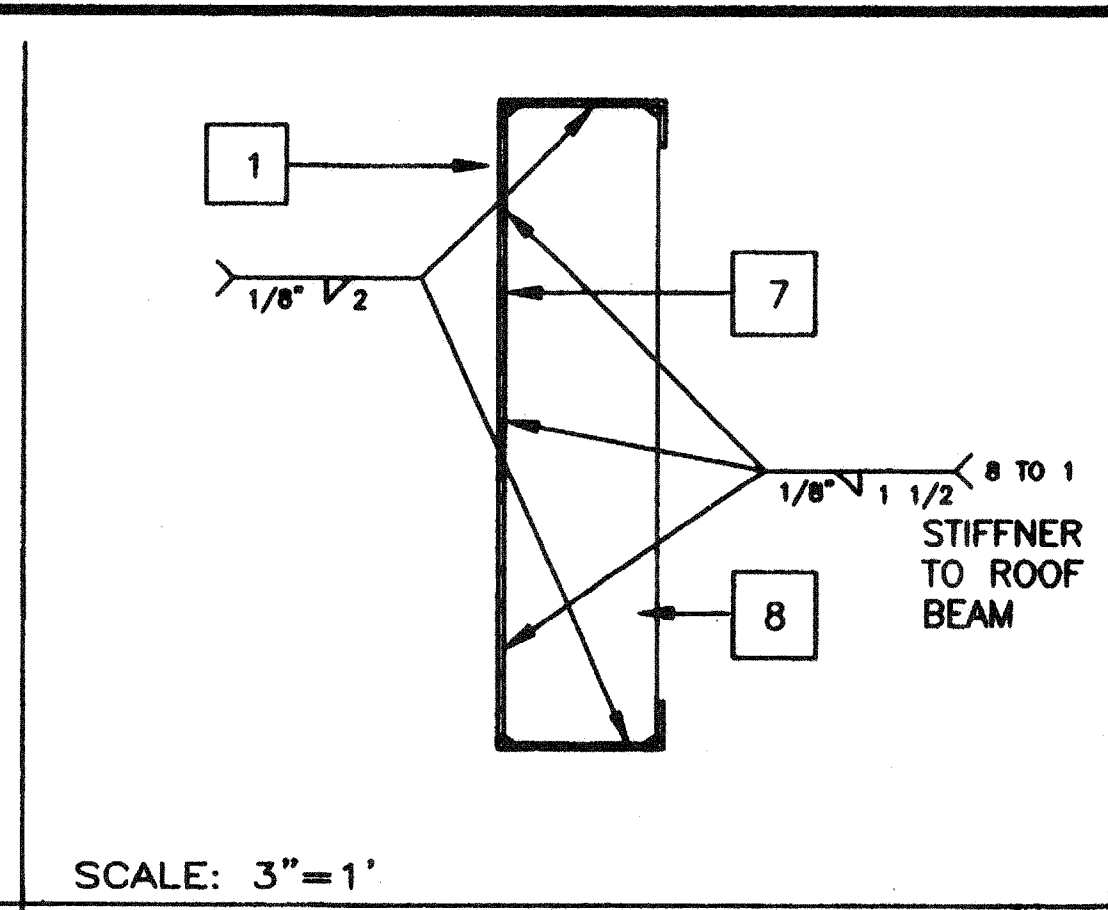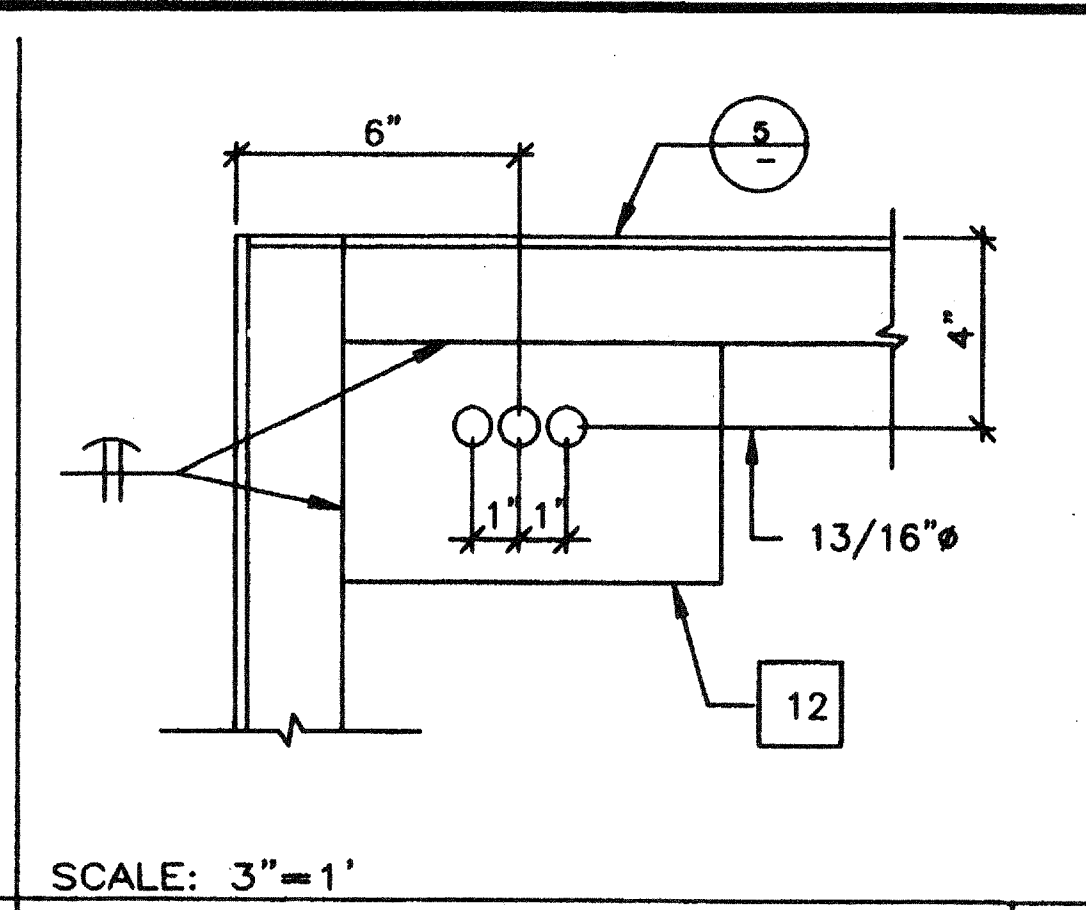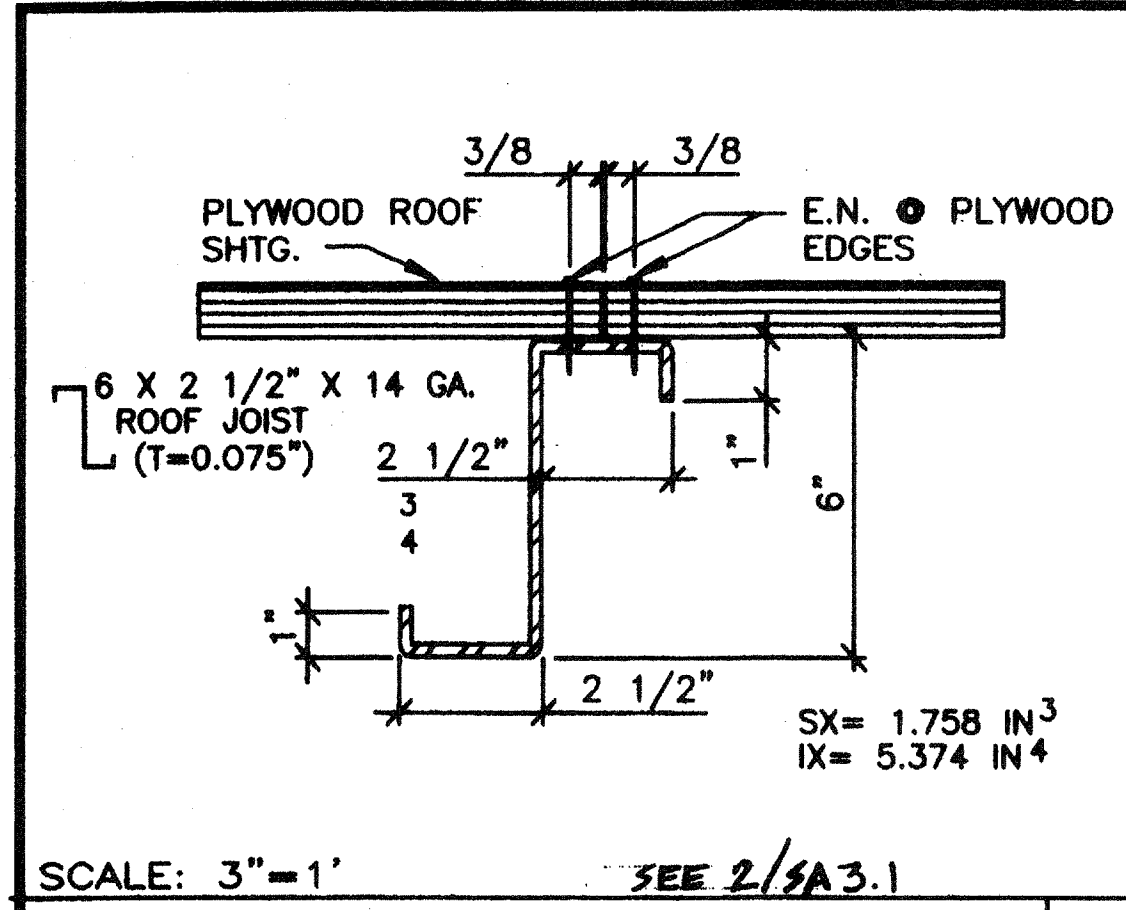

REVISIONS

1		
2		
3		
4		
5		

Electrical Engineer's Seal
 Mechanical Engineer's Seal
 Structural Engineer's Seal
 ARCHITECT'S SEAL
 LICENSED ARCHITECT
 GEORGE C. EDWARDS
 No. 02855
 STATE OF CALIFORNIA
 LICENSE EXPIRES 6-30-2029

Division of the State Architect
 IDENTIFICATION STAMP
 DIV. OF THE STATE ARCHITECT
 OFFICE OF REGULATION SERVICES
 PC-266
 AC. [Signature]
 DATE: JAN 25 1999

MODTECH INC.
 2830 BARRETT AVENUE
 PERRIS, CALIF. 92572
 PH (909) 943-4014
 FAX (909) 940-0427

PROJECT NUMBER: 2986
 © MODTECH, INC. 1997
 STRUCTURAL DETAILS


- KEY NOTES
- [10 GA. TAPERED ROOF BEAM (SEE STRUC.) 33 KSI MATERIAL
 - BACK-UP PLATE MIN. 10 GA.
 - 3 1/2"X3 1/2"X1/4" COLUMN
 - [10GA.X 24" HEADER SEE 1/S3.1
 - SECTION OF 3 1/2"X3 1/2"X1/4" TUBE STEEL COPE TO FIT ROOF BEAM
 - 6 3/8"X2 1/2"X12GA. FLOOR JOIST
 - 10GA. BENT PLATE BACK-UP
 - 1/4" STIFFENER
 - #10 S.T.S.M.S 6" O.C. (SEE S1.0)
 - PLYWOOD FLOOR SHEATHING
 - FLOOR BEAM (SEE STRUCTURAL) SEE 5/S3.1
 - 5"X8"X1/4" IP
 - ROOF OVERHANG BEAM 8"x3 1/2" x4 GA.
 - ADDITIONAL SPLICE LOCATION (OPTIONAL)

IDENTIFICATION STAMP
 DIV. OF THE STATE ARCHITECT
 OFFICE OF REGULATION SERVICES
 AC. [Signature]
 DATE: JAN 07 1999


IDENTIFICATION STAMP
 DIV. OF THE STATE ARCHITECT
 APP#3 117168
 AC. FLS ✓ SS ✓ TV ✓
 Date: JAN 04 2019

(MONO SLOPE)
 STKP-42 M 4/24/99


drawn by: 4012-088
 checked by: 05 JAN 99
 Modtech project no:
 MODTECH Index No.
 2986
 SA3.1

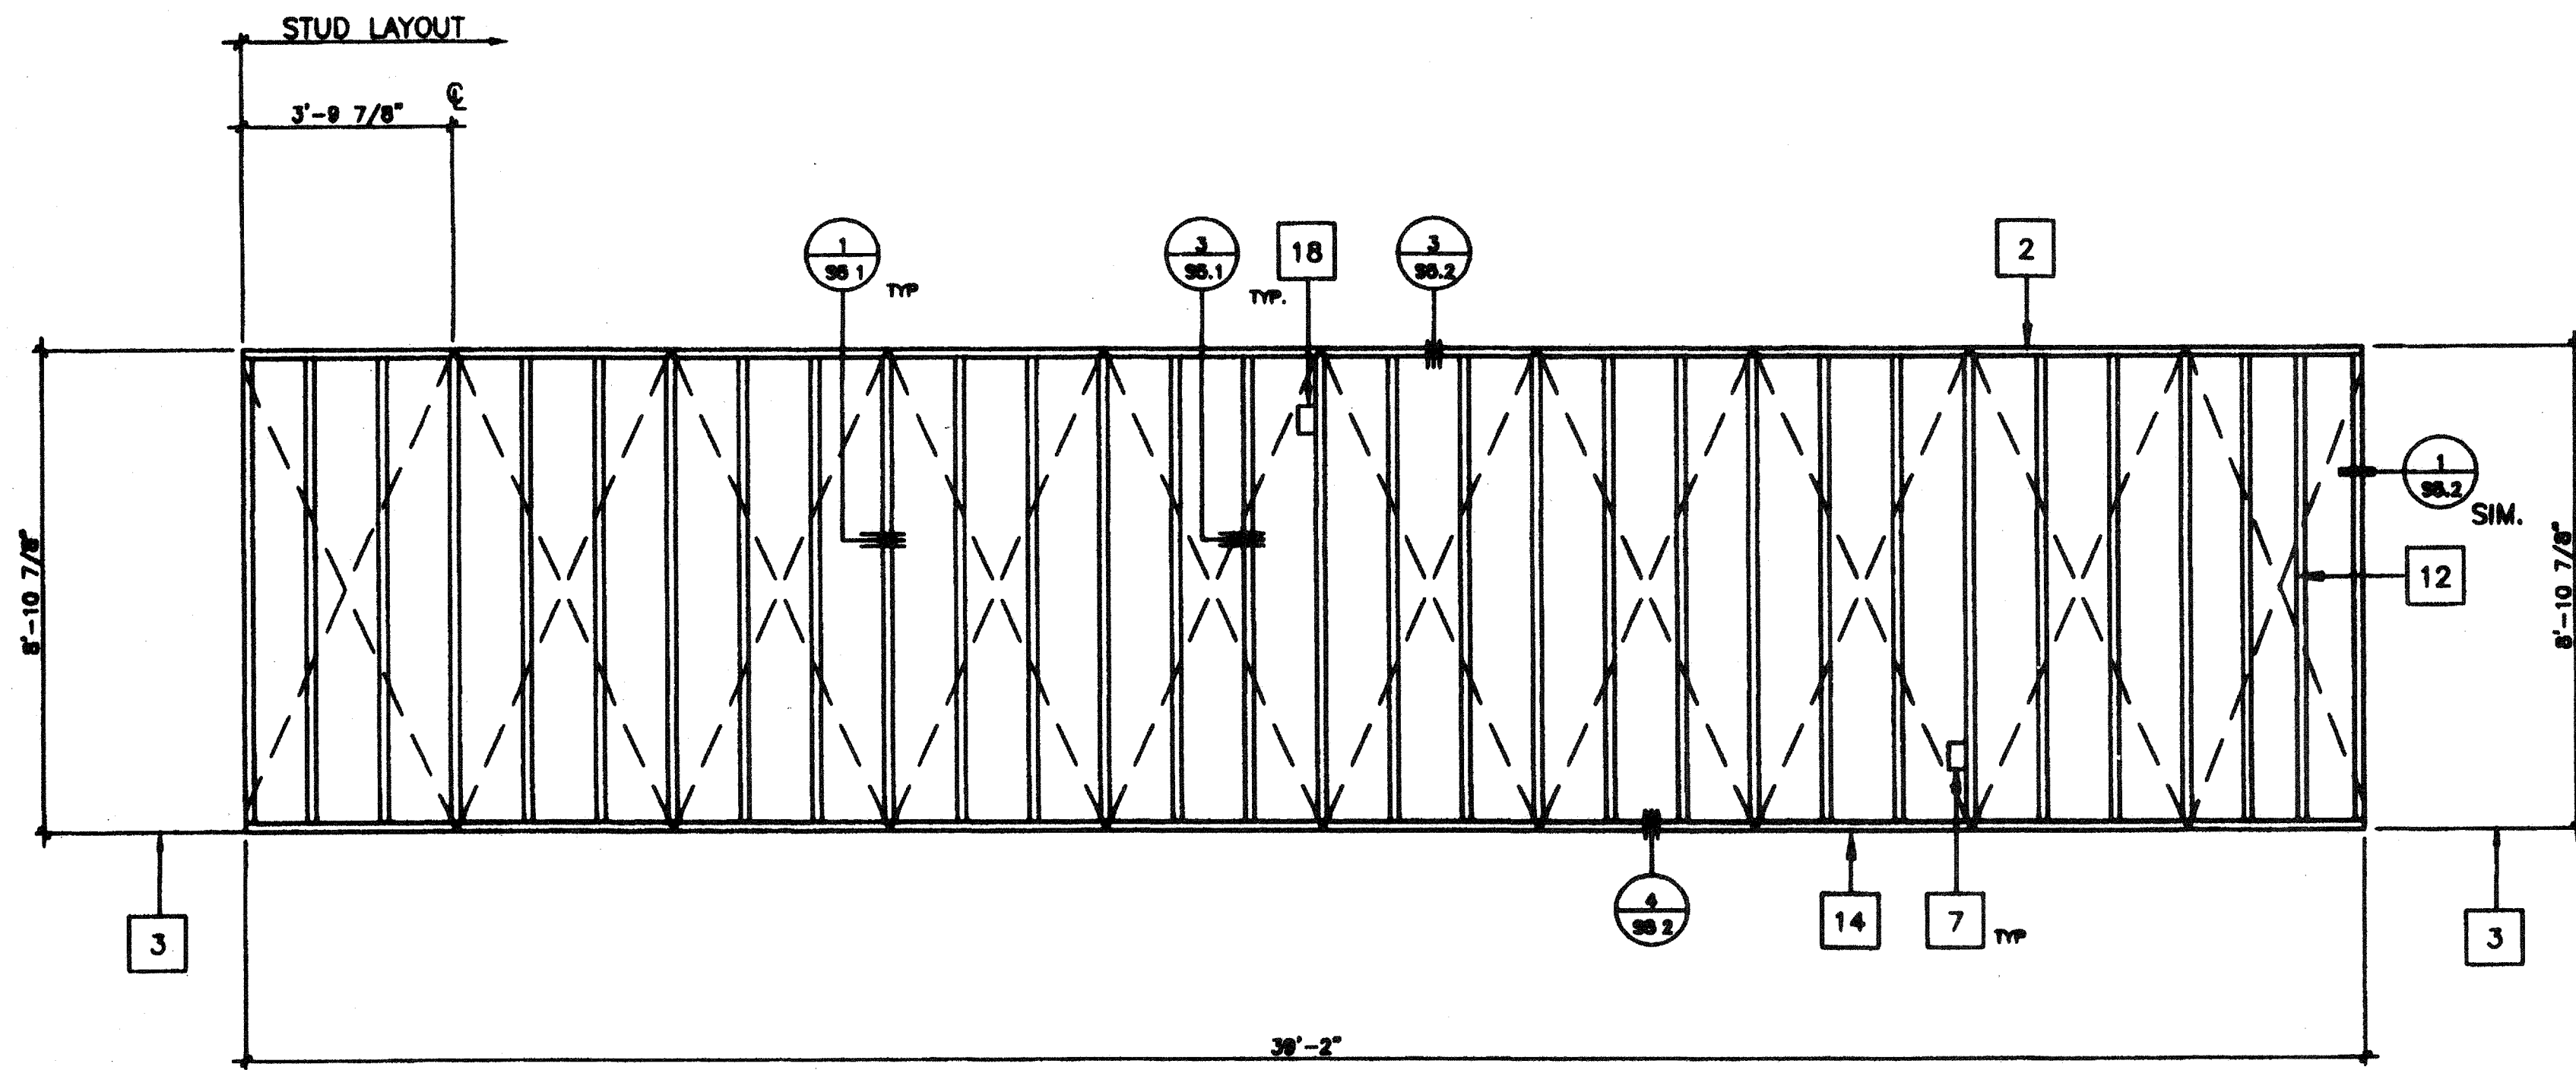


A
A₁ OPPOSITE HAND

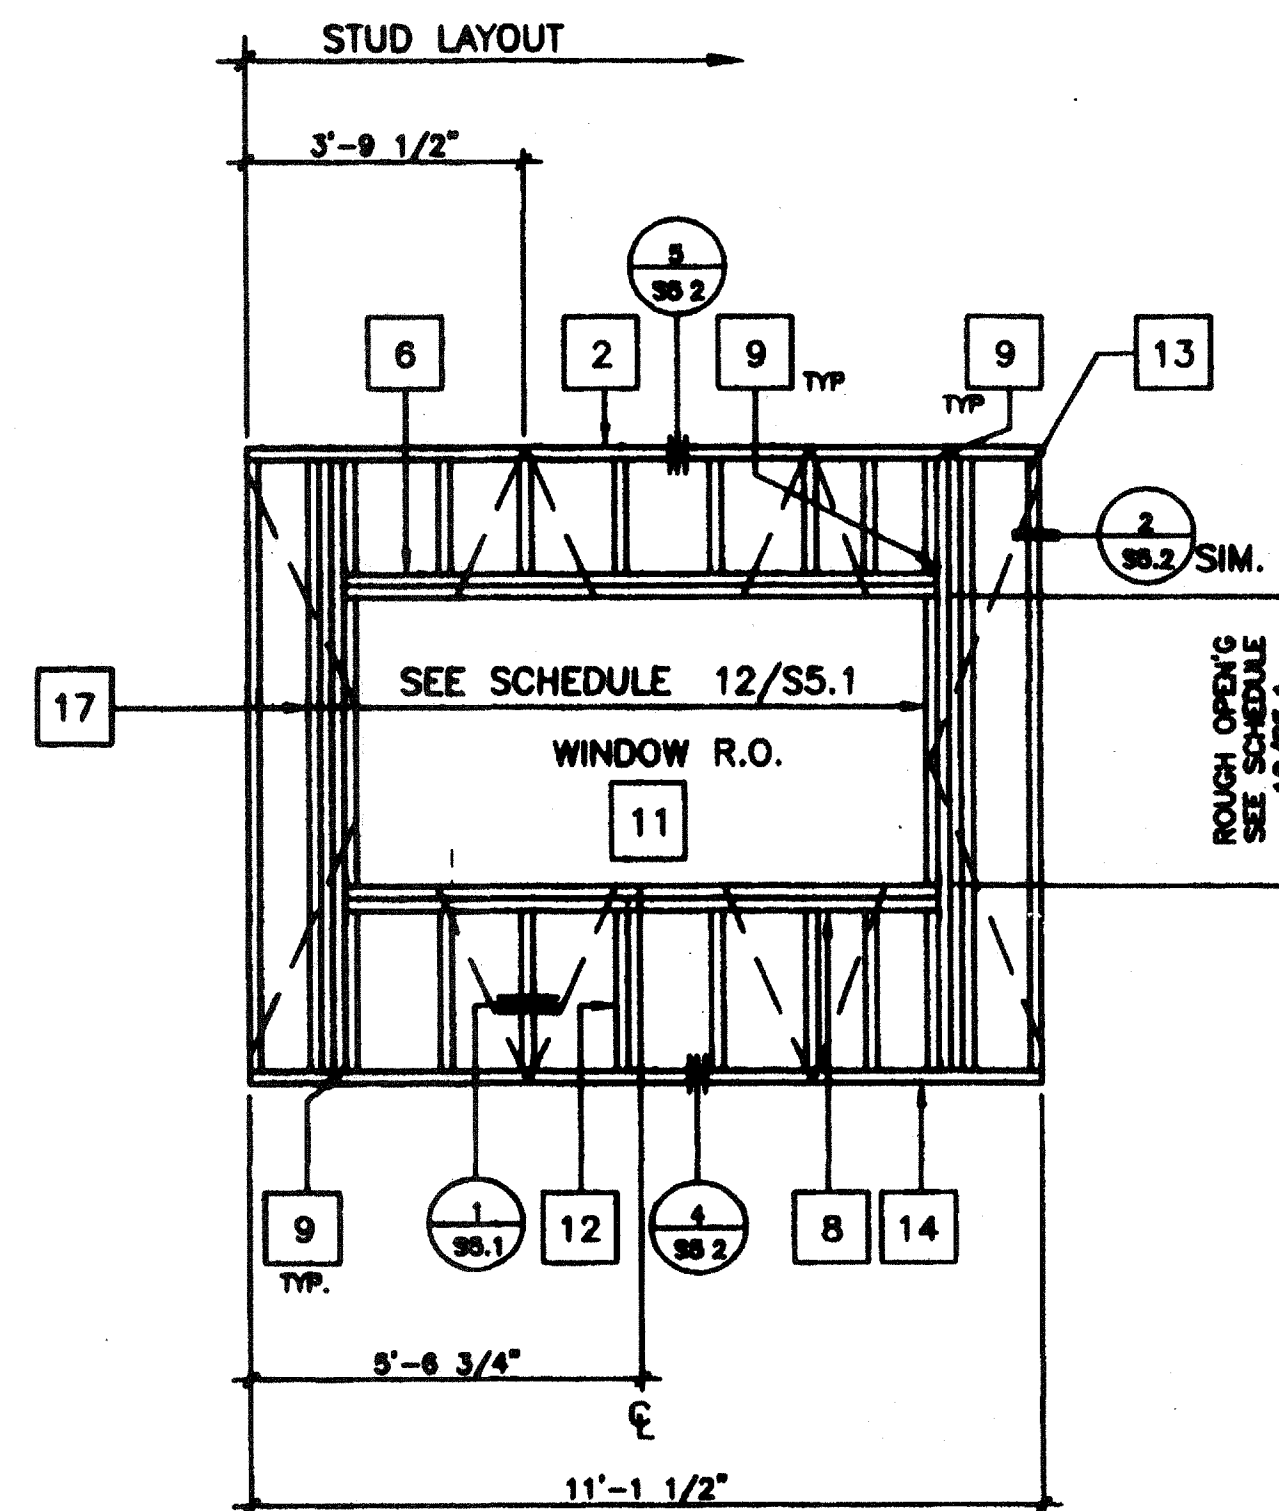


B
B₁ OPPOSITE HAND

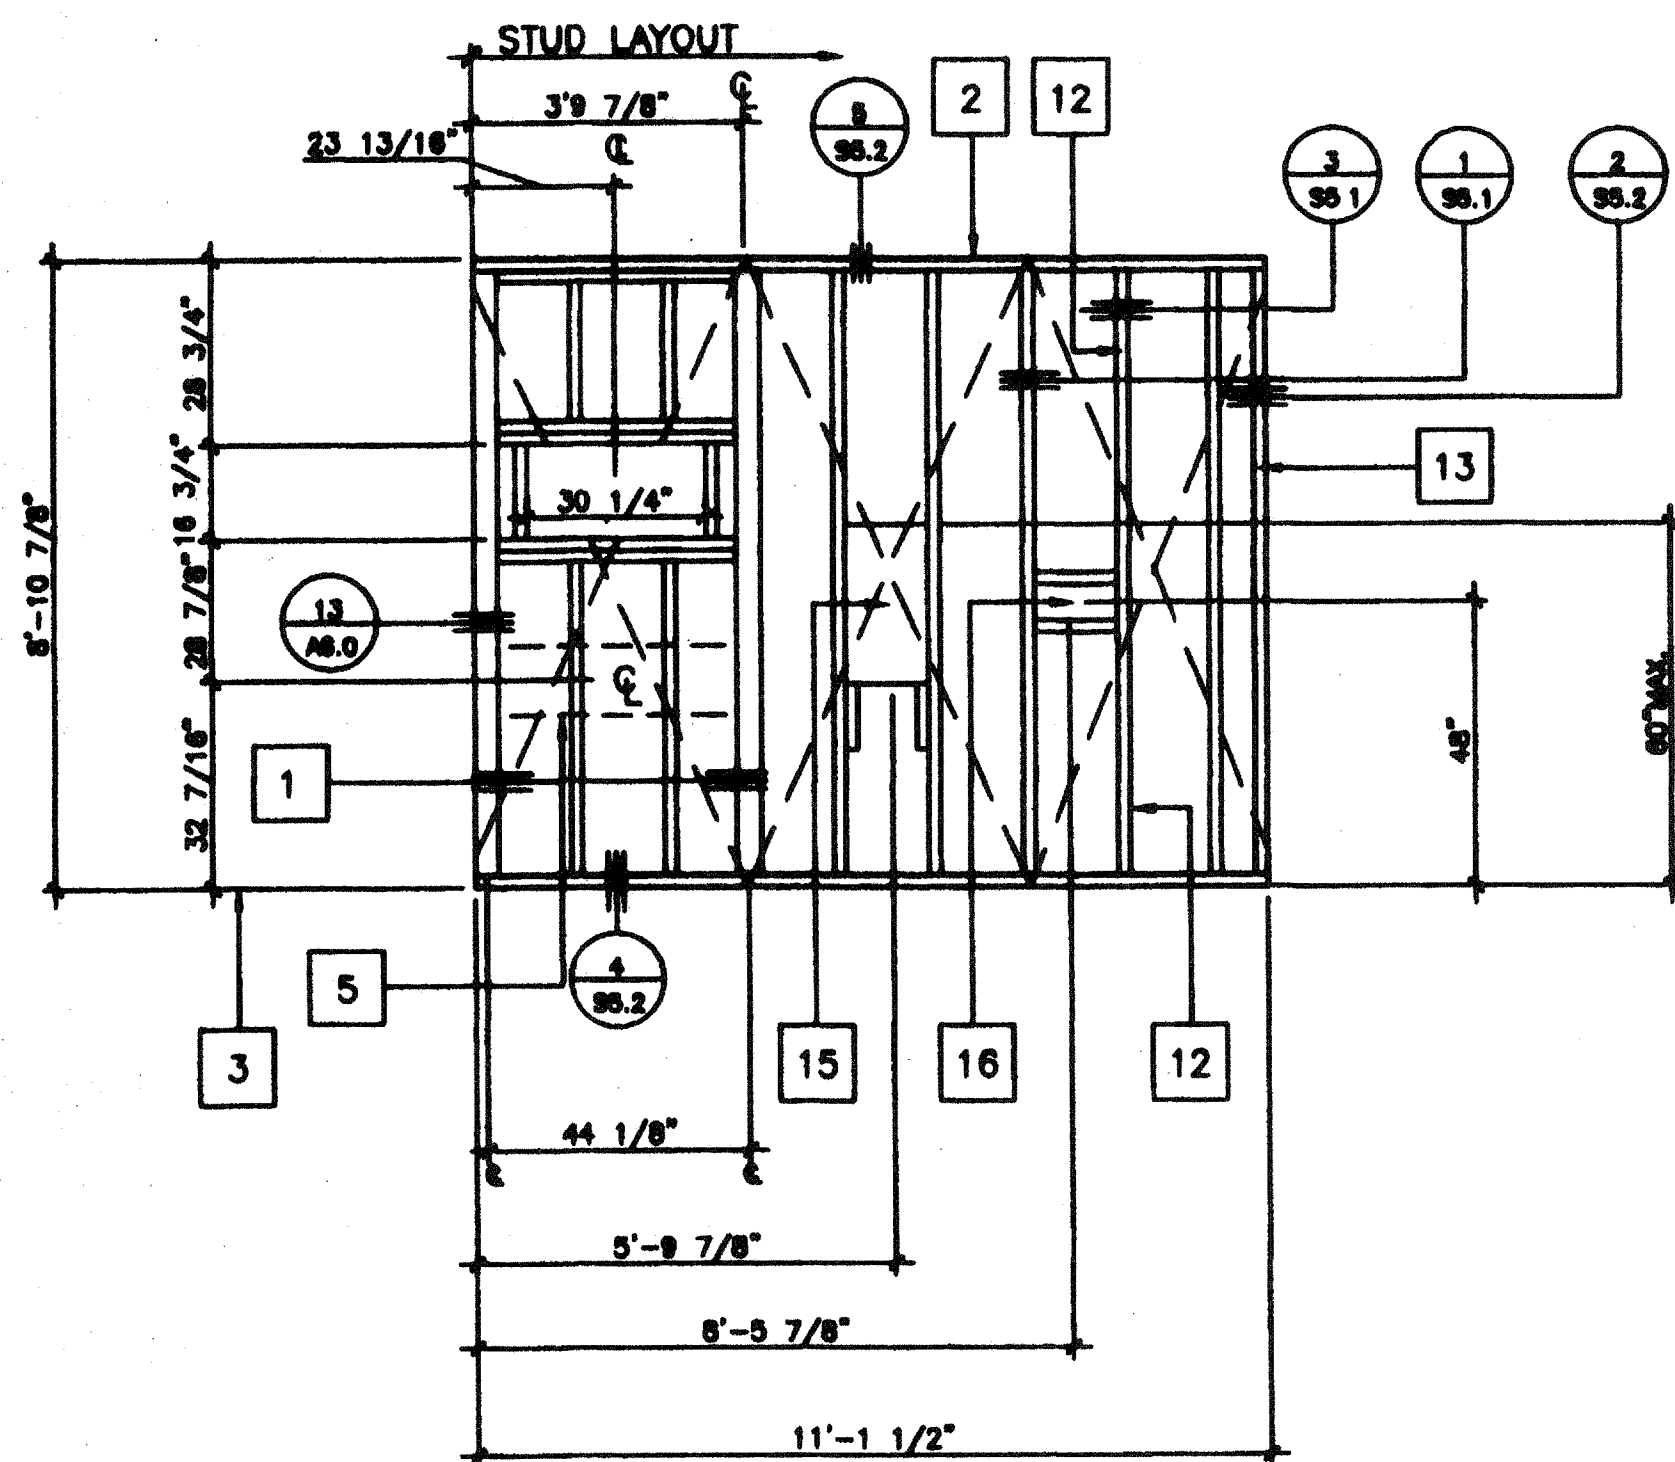

C
C₁ OPPOSITE HAND

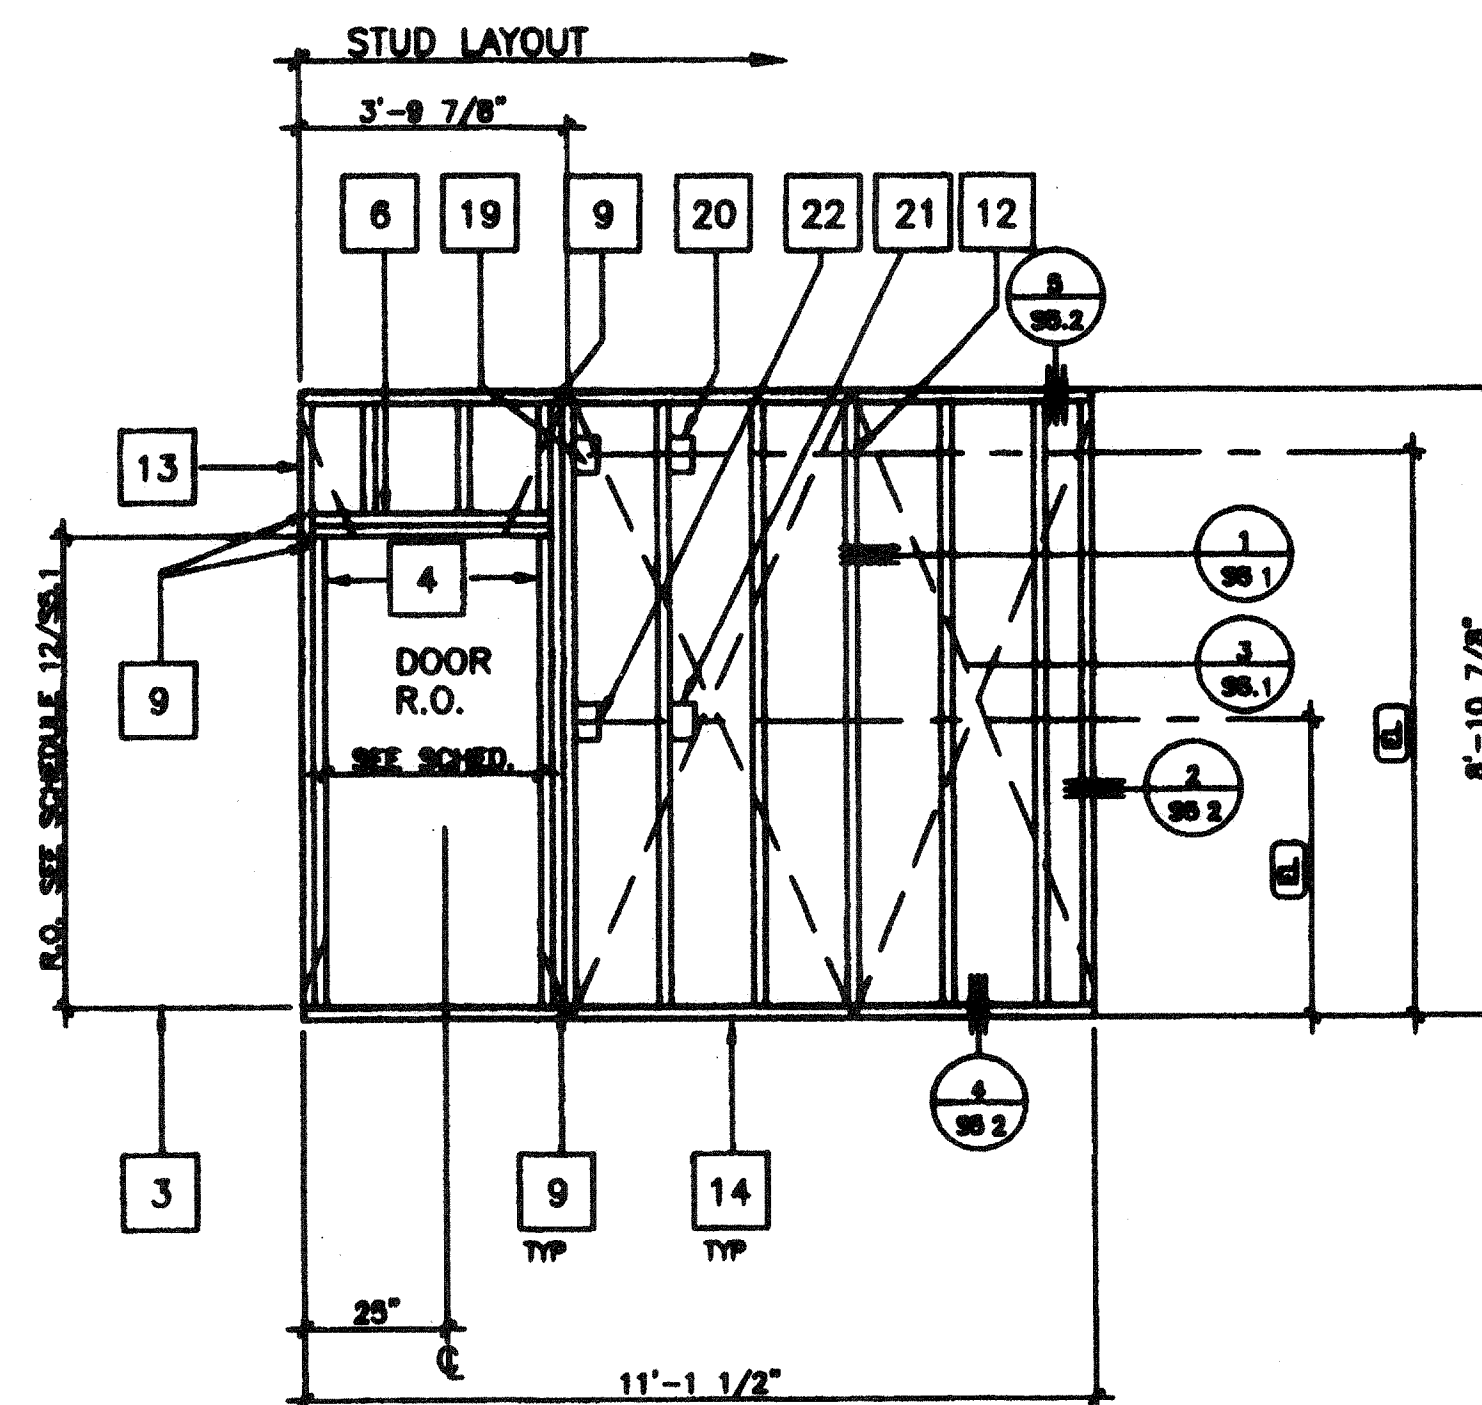

D
D₁ OPPOSITE HAND

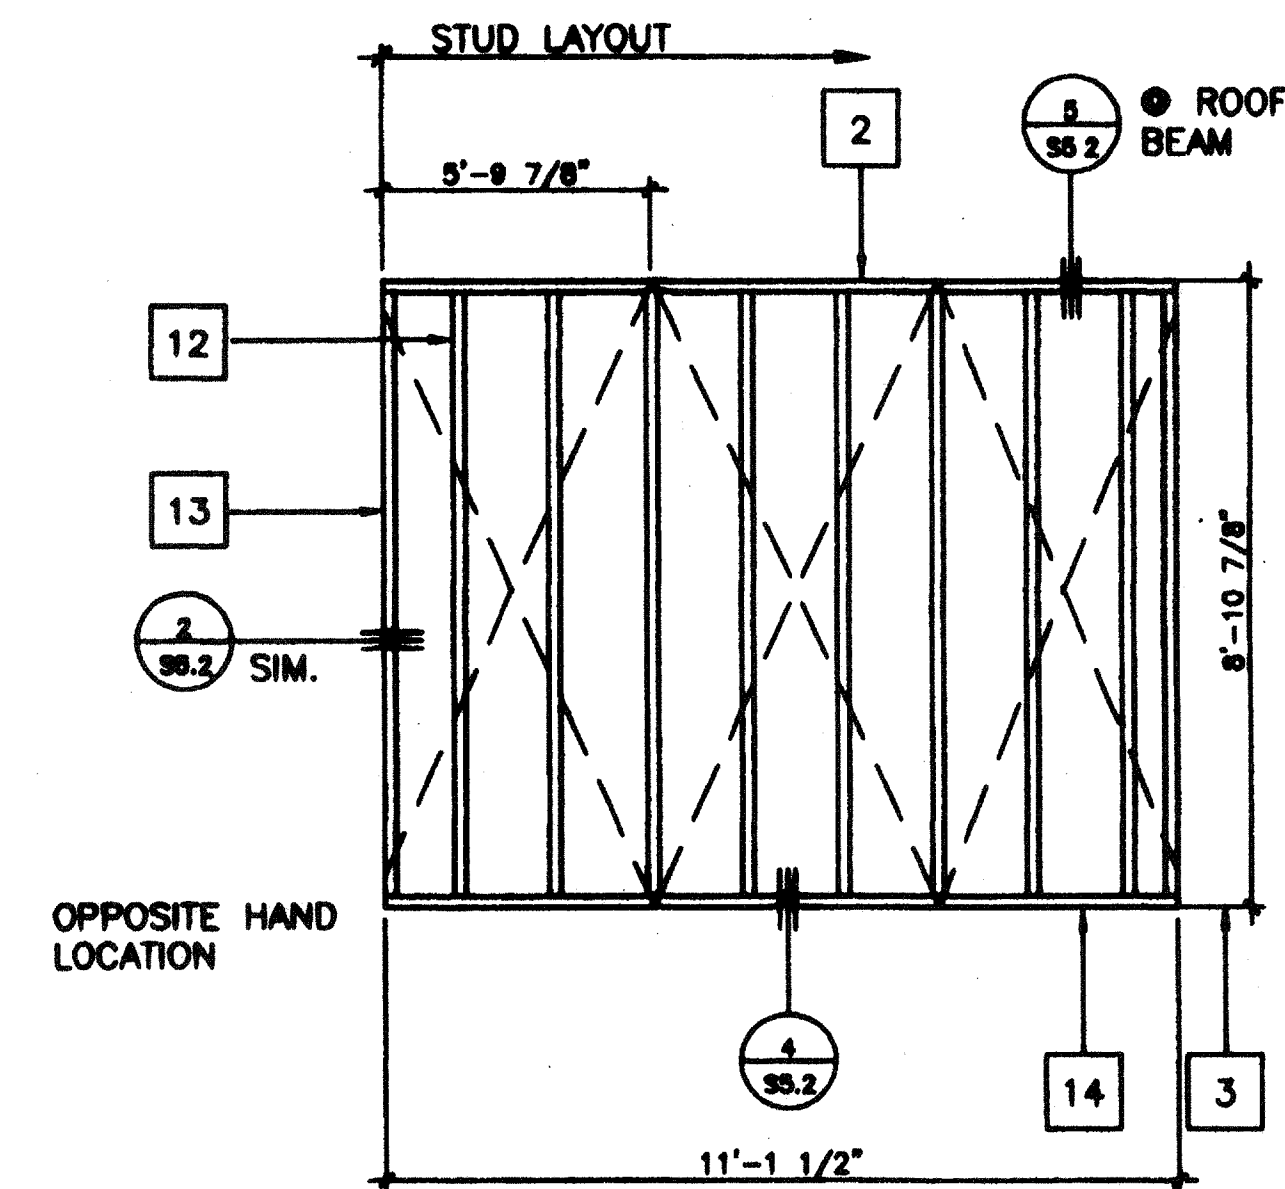


E
SCALE 3/8"=1'

KEY NOTES

- 1 4 X 4 POST
- 2 2X4 TOP PLATE
- 3 FINISH FLOOR
- 4 2X4 FULL HGT KING STUDS AND 2X4 TRIMMER (SEE SCHEDULE FOR QUANTITY SHT S5 1)
- 5 2x6 LET IN FOR AC SUPPORT SEE 15/A6 0
- 6 HEADER (SEE SCHEDULE)
- 7 TYPICAL DUPLEX WALL RECEPTICAL FOR SPECIFIC LOCATION SEE (EL)
- 8 WINDOW SILL PLATE (SEE SCHEDULE)
- 9 A 34 CLIPS @ HEADER & SILL TO FULL HGT STUDS AND FULL HGT. STUDS TO TOP AND BOTTOM PLATES
- 10 REQUIRED OPENING FOR A 3068 DOOR (SEE DETAIL 7/S5 1)
- 11 REQUIRED OPENING FOR A 8040 WINDOW (SEE DETAIL 6/S5 1)
- 12 2X4 STUD @ 16" O.C TYPICAL
- 13 2X4 NAILER TYPICAL @ EACH END
- 14 2X4 SILL PLATE
- 15 FRAME FOR ELECTRICAL PANEL
- 16 THERMOSTAT LOCATION 4S BOX
- 17 FULL HGT. STUDS AND 1-2X4 TRIMMER (SEE WINDOW SCHEDULE FOR JAMB STUDS REQUIRED SHT. S5 1)
- 18 CLOCK OUTLET (EL)
- 19 "J" BOX FOR EXTERIOR LIGHT FIXTURE (TO EXTERIOR) (EL)
- 20 "J" BOX FOR FIRE HORN (TO EXTERIOR) (EL)
- 21 "J" BOX FOR FIRE PULL STATION (TO INTERIOR) (EL)
- 22 LIGHT SWITCH BOX (EL)

NOTES

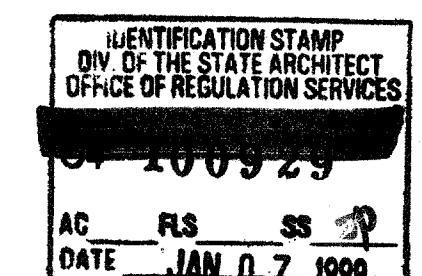

IDENTIFICATION STAMP
DIV. OF THE STATE ARCHITECT
OFFICE OF REGULATION SERVICES
APP#3 117168
AC FLS SS TN
Date JAN 04 2018

STKP-42 1/26/98

REVISIONS	Electrical Engineer's Seal	Mechanical Engineer's Seal	Structural Engineer's Seal	Architect's Seal	Division of the State Architect

REVISIONS

REVISOR

DATE

MODTECH INC.
2830 BARRETT AVENUE
PERRIS, CALIF. 92572
PH (909) 943-4014
FAX (909) 940-0427


PROJECT NUMBER 2986
© MODTECH, INC 1997

drawn by 4012-088
checked by 05 JAN 99
project no.
WALL FRAMING


S5.0

NAILING SCHEDULE	
CONNECTION	NAILING
1. JOIST TO SILL OR ORDER, TOENAIL	3-8d
2. BRIDGING TO JOIST, TOENAIL, END END	2-8d
3. 1" X 6" (25 mm X 152mm) SUBFLOOR OR LESS TO EACH JOIST, FACE NAIL	2-78d
4. WIDER THAN 1" X 6" (25 mm X 152 mm) SUBFLOOR TO EACH JOIST, FACE NAIL	3-8d
5. 2" (51mm) SUBFLOOR TO JOIST OR ORDER, BLIND AND FACE NAIL	2-18d
6. SOLE PLATE TO JOIST OR BLOCKING, TYPICAL FACE NAIL	16d at 16" (406mm) o.c.
7. SOLE PLATE TO JOIST OR BLOCKING, AT BRICKED WALL PANELS	3-16d per 16" (406mm)
8. TOP PLATE TO STUD, END NAIL	2-18d
9. STUD TO SOLE PLATE	4-8d, toenail or 2-18d, end nail
10. DOUBLE STUDS, FACE NAIL	16d at 24" (610mm) o.c.
11. DOUBLE TOP PLATES, TYPICAL FACE NAIL	16d at 16" (406mm) o.c.
12. DOUBLE TOP PLATES, LAP SPICE	8-18d
13. BLOCKING BETWEEN JOISTS OR RAFTERS TO TOP PLATE, TOENAIL	3-8d
14. RIM JOIST TO TOP PLATE, TOENAIL	8d at 6" (152mm) o.c.
15. TOP PLATES, LAP AND INTERSECTIONS, FACE NAIL	2-18d
16. CONTINUOUS HEADER TWO PIECES	16d at 16" (406mm) o.c. along each edge
17. CEILING JOIST TO PLATE, TOENAIL	3-8d
18. CONTINUOUS HEADER TO STUD, TOENAIL	4-8d
19. CEILING JOISTS, LAP OVER PARTITIONS, FACE NAIL	3-18d
20. CEILING JOIST TO PARALLEL RAFTERS, FACE NAIL	3-18d
21. RAFTER TO PLATE, TOENAIL	3-8d
22. 1" (25 mm) BRACE TO EACH STUD AND PLATE, FACE NAIL	2-8d
23. 1" X 8" (25 mm X 203 mm) SHEATHING OR LESS TO EACH BEARING, FACE NAIL	2-8d
24. WIDER THAN 1" X 8" (25 mm X 203mm) SHEATHING TO EACH BEARING, FACE NAIL	3-8d
25. BUILT-UP CORNER STUDS	16d at 24" (610mm) o.c.
26. BUILT-UP ORDER AND BEAMS	20d at 32" (813 mm) O.C. AT TOP AND BOTTOM AND STAGGERED 2-20d AT ENDS AND AT EACH SPICE.
27. 2" (51mm) PLANKS	
28. WOOD STRUCTURAL PANELS AND PARTICLEBOARD: SUBFLOOR, ROOF AND WALL SHEATHING (TO FRAMING) (1 INCH=25.4mm)	
1/2" AND LESS	8d ³
19/32" - 3/4"	8d ⁴ OR 8d ⁵
7/8" - 1"	8d ³
1 1/8" - 1 1/4"	10d ⁴ OR 8d ⁵
COMBINATION SUBFLOOR-UNDERLAYMENT (TO FRAMING) (1 INCH=25.4mm)	
3/4" AND LESS	8d ⁵
7/8" - 1"	8d ⁵
1 1/8" - 1 1/4"	10d ⁴ OR 8d ⁵
29. PANEL SIDING (TO FRAMING): 1/2" (13 mm) OR LESS	8d ⁶
5/8" (16 mm)	8d ⁶
30. FIBERBOARD SHEATHING 1/2" (13 mm)	NO 11 GA 8 ⁹
	8d ⁴
25/32" (20 mm)	NO 16 GA 8 ⁹
	NO 11 GA 8 ⁹
	8d ⁴
	NO.18 GA 9
31. INTER PANELING 1/4" (6.4 mm)	4d 10
3/8" (9.5 mm)	8d 11


NOTE: All nail shall be box nails unless otherwise noted.

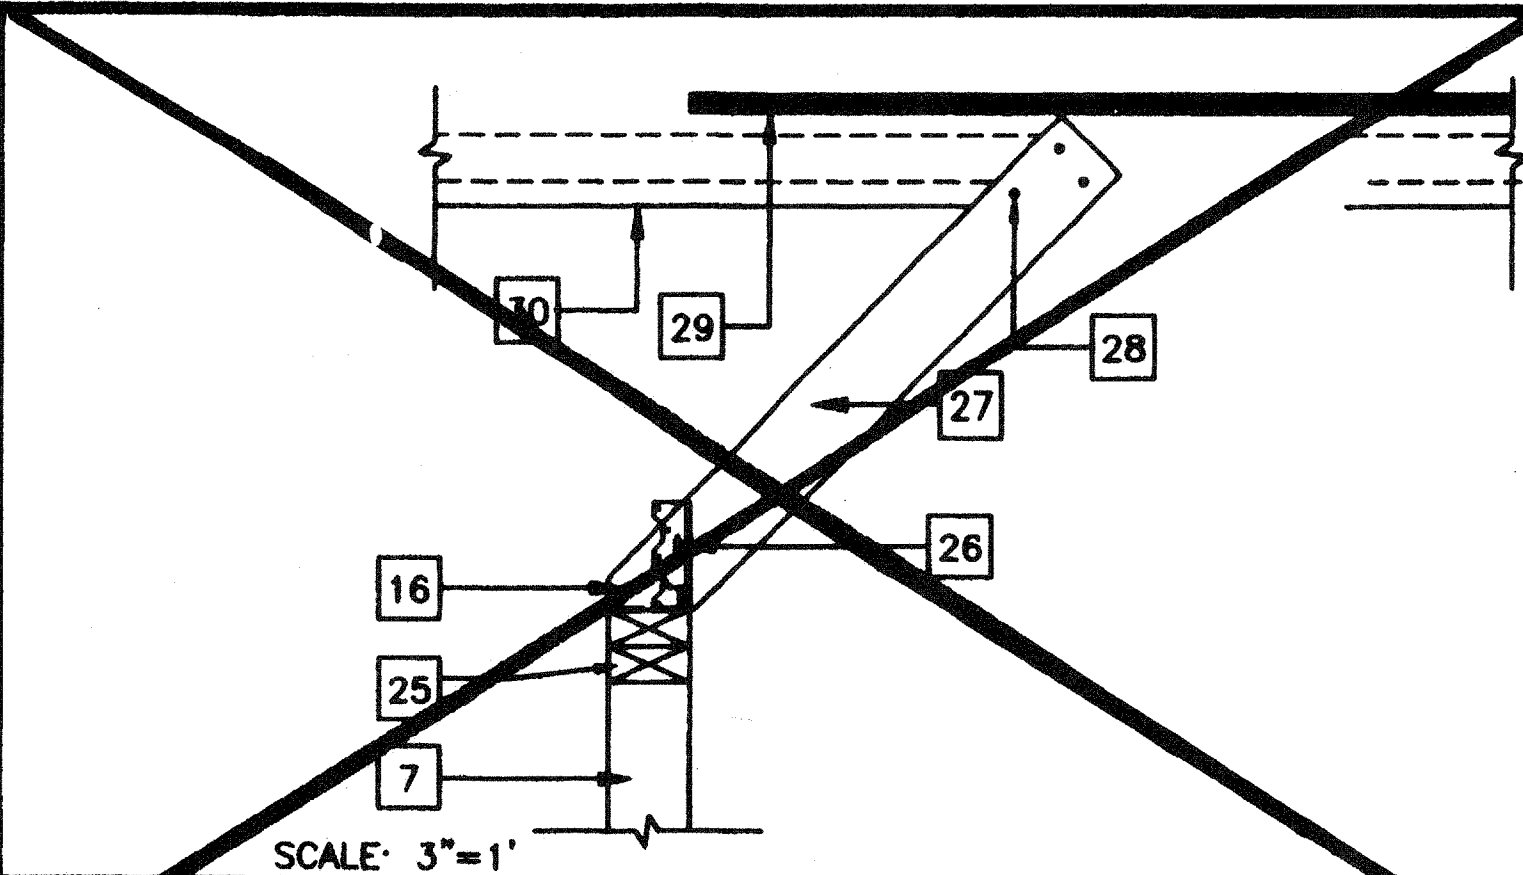

PERPENDICULAR PARTITION CONNECTION 8

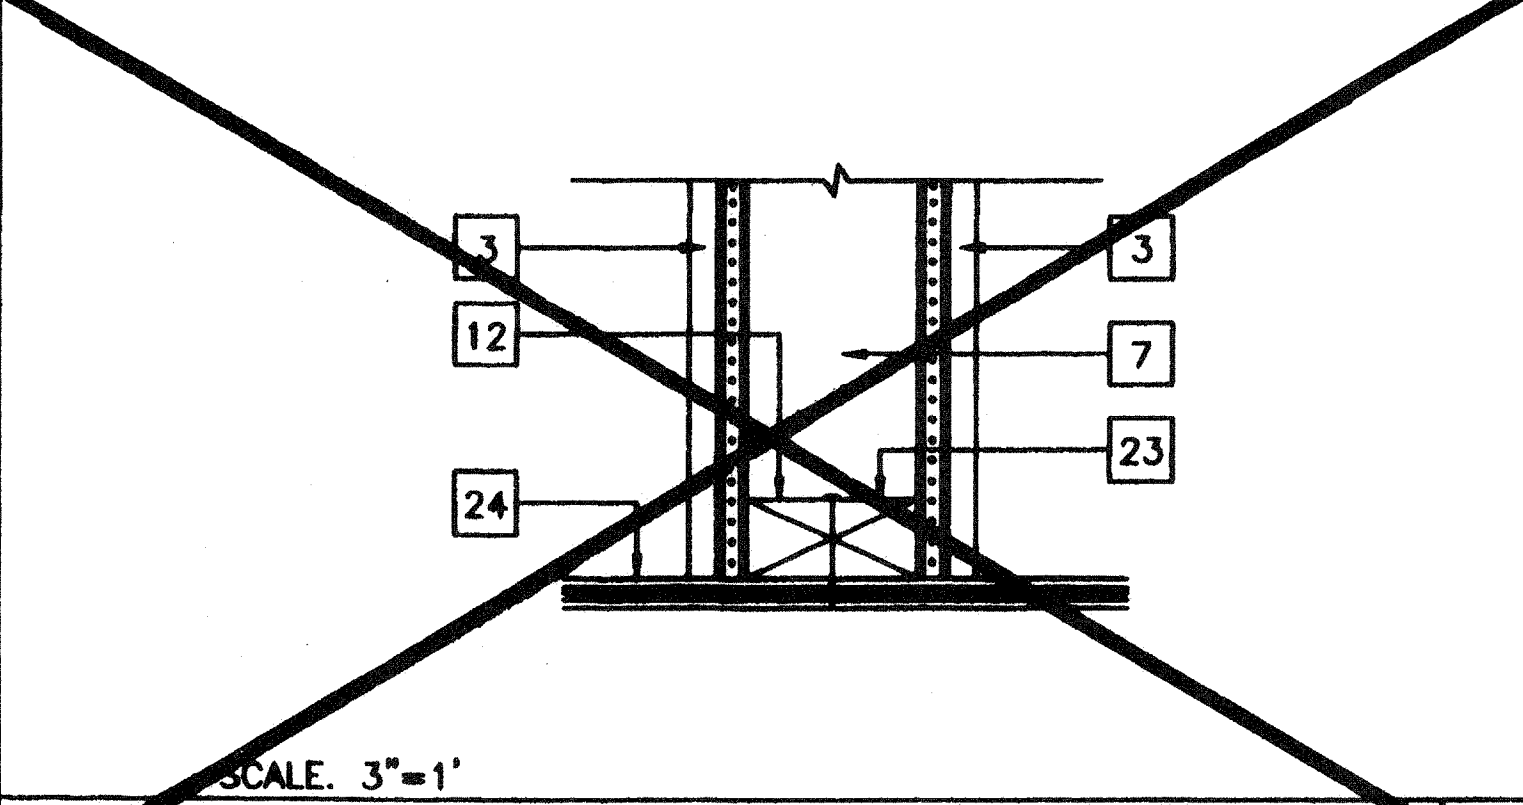

INT. PARTITION CONN AT FLOOR 10

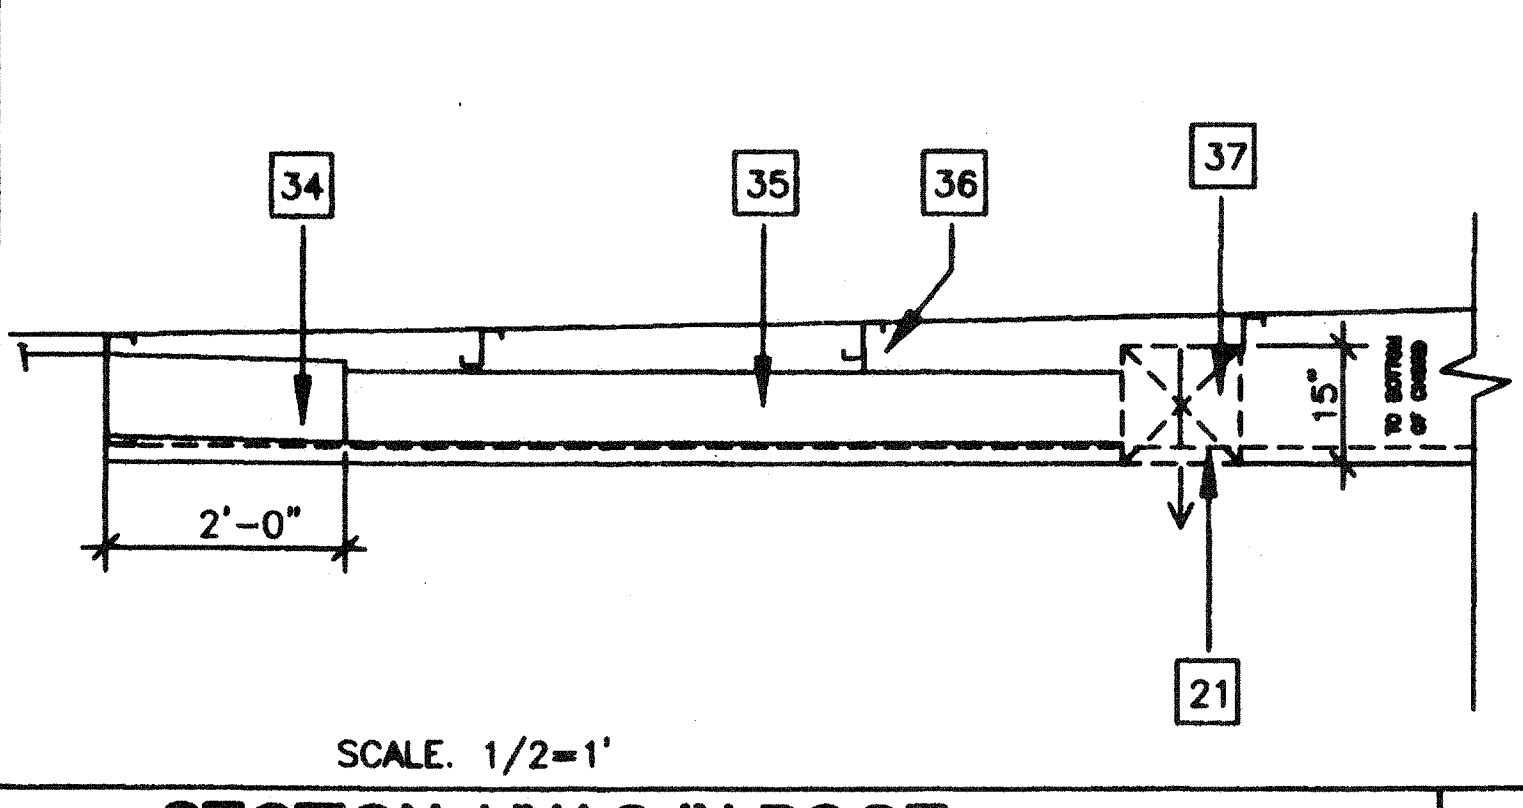


SECTION: HVAC IN ROOF 11


OPENING	ROUGH OPENING			
	HDR.	SILL	JAMB	HEIGHT WIDTH
3068	(2) 2X4	(2) 2X4	(2) 2X4	81 1/4" 38"
8040	(3) 2X4	(2) 2X4	(4) 2X4	48 1/8" 96 1/8"

ALTERNATE: METAL STUD 24 HDS350 IN LIEU OF 2X4 WD STUDS


ROUGH OPENING SCHEDULE REVISED 12

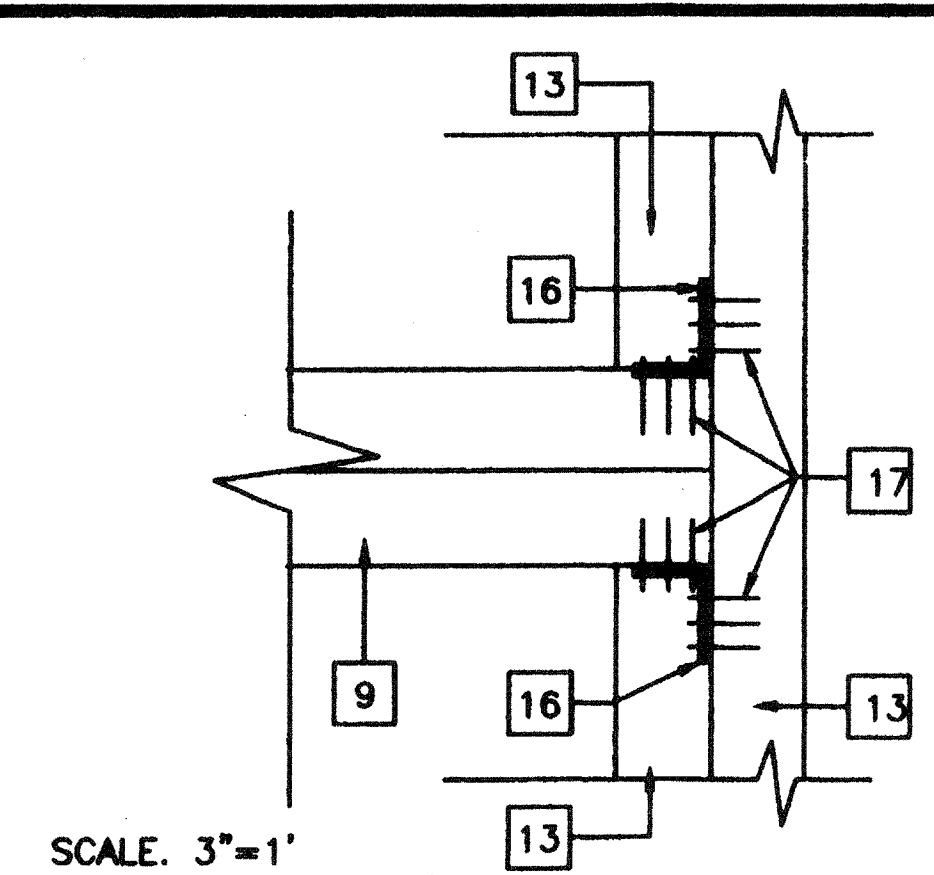


WINDOW SILL AT JAMB 5

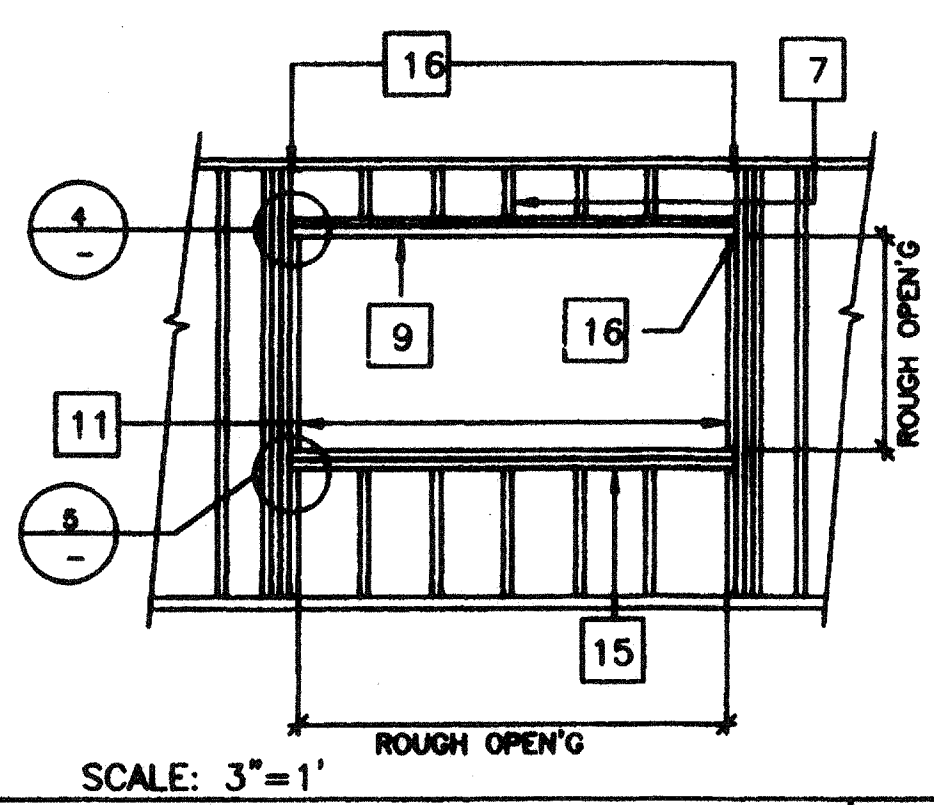


TYP. WINDOW FRAMING 6

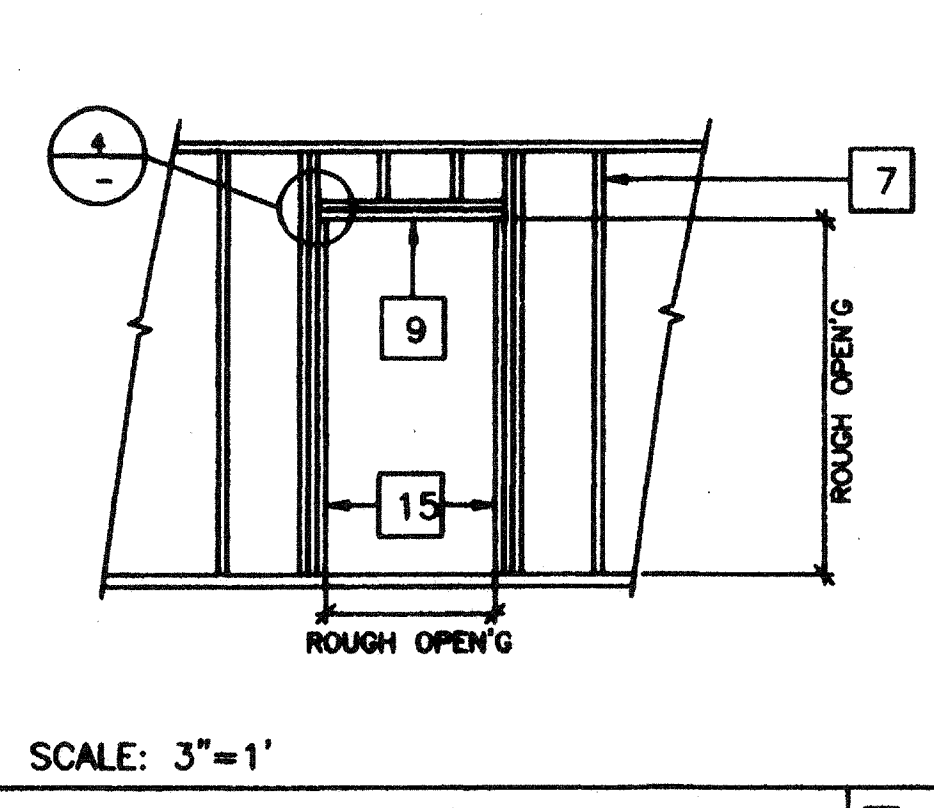


TYP. DOOR FRAMING 7

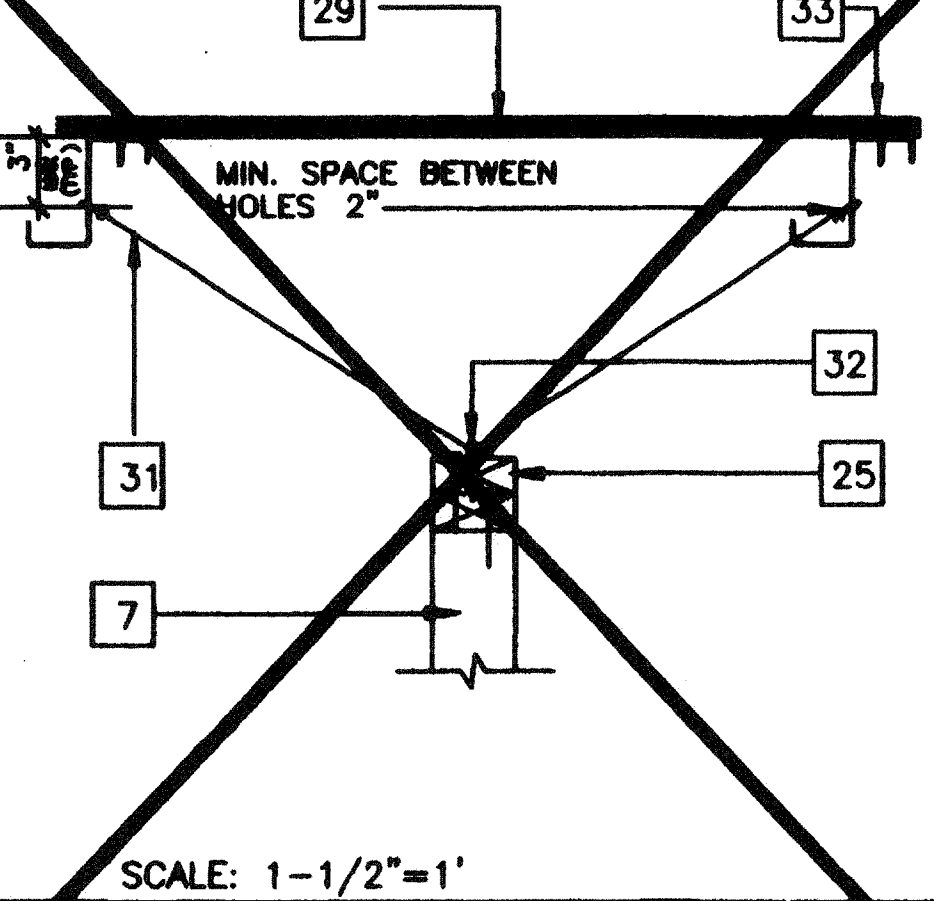


DETAIL PARALLEL PARTITION CONN. 8

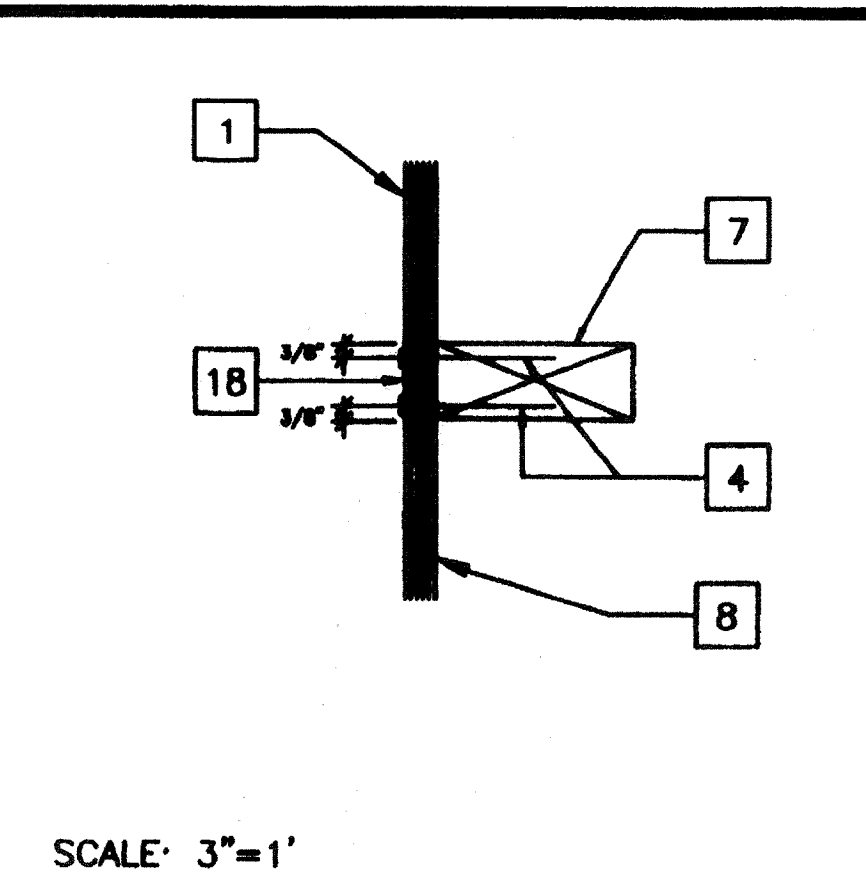


DETAIL AT VERT. PLYWOOD EDGES 1

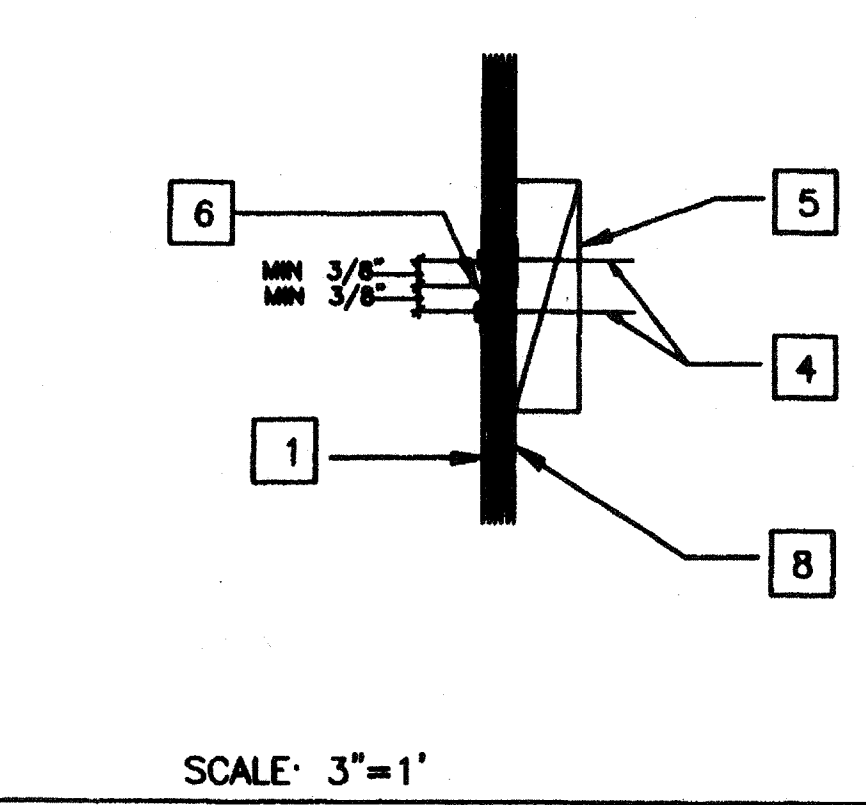

DETAIL AT HORIZ PLYWOOD JOISTS 2

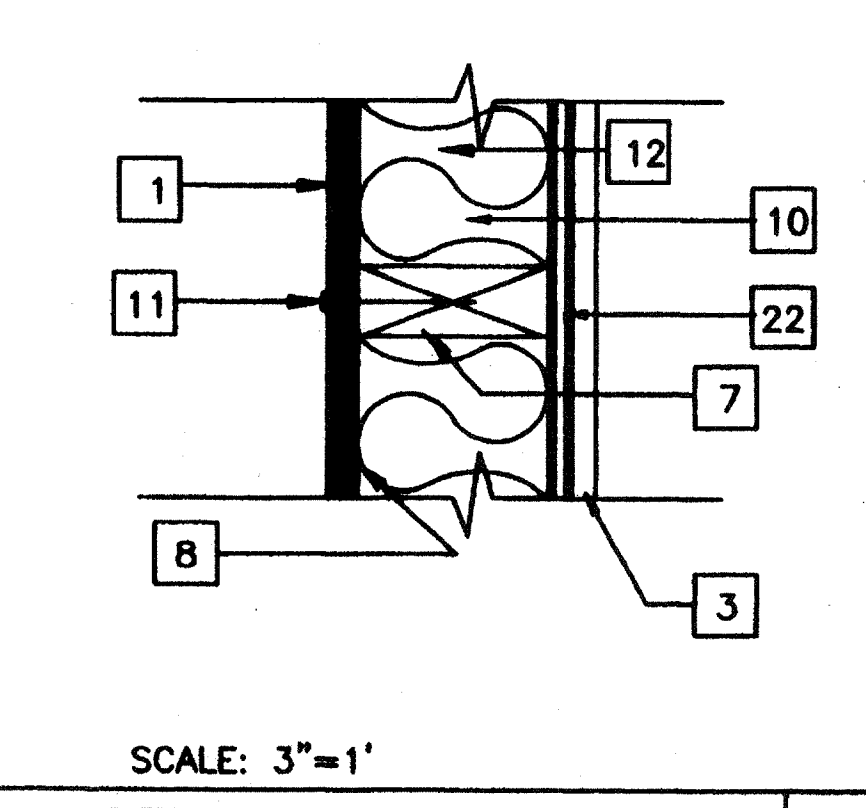

SECTION AT STUD 3

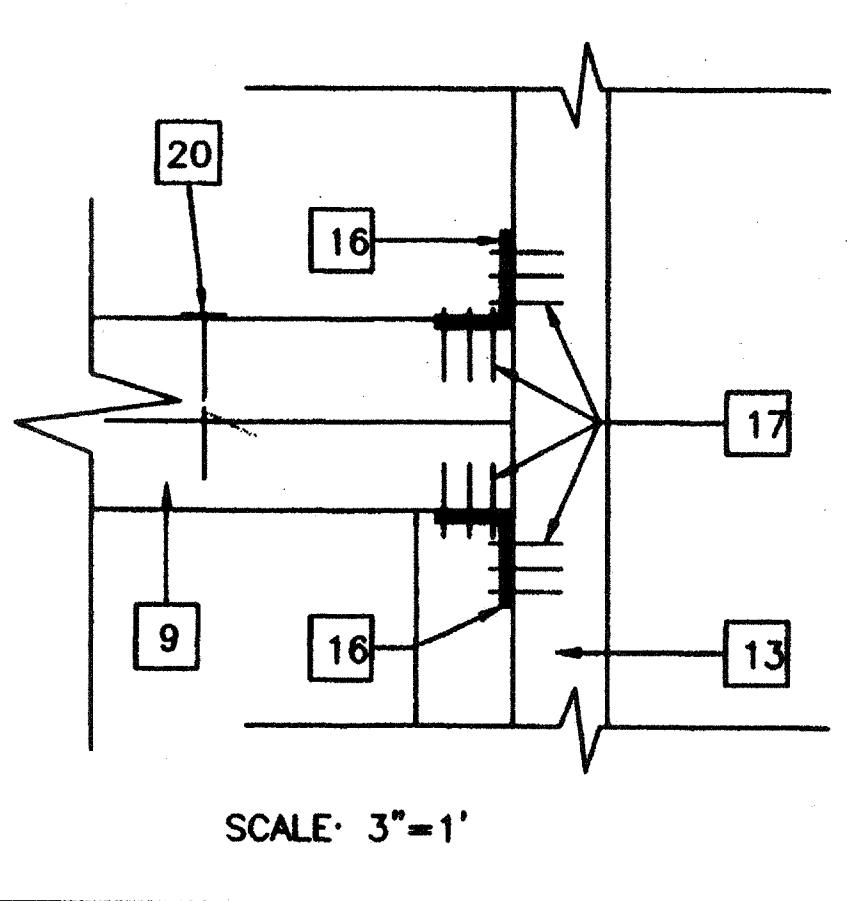

HEADER DETAIL 4

- ### KEY NOTES
- EXTERIOR PLYWOOD SIDING - SHEATHING NAIL W/GALV. BOX NAILS - 8d @ 6" O.C EDGES, 8d @ 12" O.C. IN FIELD
 - GYP. BOARD
 - TYP. INTERIOR FINISH-SEE FINISH SCHEDULE
 - E.N.
 - 2X4 BLK'G
 - "Z" FLASHING
 - 2X4 @ 16" O.C.
 - WATERPROOF MEMBRANE
 - HEADER SEE SCHEDULE 12/SS.1
 - INSULATION SEE SPECIFICATIONS
 - 8d ELECTRO GALV. 12" O.C.FN.
 - 2X4 SILL PLATE (BELOW)
 - FULL HEIGHT STUDS AND 1-2X4 TRIMMER (SEE WINDOW SCHEDULE FOR JAMB STUDS REQ'D)
 - NOT USED
 - SILL PLATE (SEE SCHEDULE)
 - A 34 CLIPS @ HEADER AND SILL TO FULL HEIGHT STUDS AND FULL HEIGHT STUDS TO TOP AND BOTTOM PLATES
 - 9GA. 8d 1 1/2" NAILS
 - LAP JOINT
 - NOT USED
 - 16D @ 16" O.C.
 - ROOF CHANNEL
 - ATTACH GYP. BD. TO STUDS W/6d COOLERS @ 6" O.C.
 - 2X4 BOTTOM PLATE W/16d @ 16" O.C
 - PLYWOOD FLOOR
 - 2X4 DBL TOP PLATE
 - SIMPSON A35 W/8d X 2 1/2"
 - 2X4 BRACE @ 8'-0" O.C. MAX. @ MAX 45'
 - #12 X 2 TYPE A HEX HEAD SCREWS W/WASHERS (TYP. FOR 3)
 - PLYWOOD SHEATHING
 - ROOF PURLIN
 - ATTACH 12GA. BRACE WIRES TO EYE LAG SCREWS AND TO ROOF PURLINS @ 8'-0" O.C. ENDS TO HAVE 4 TIGHT WRAPS IN 1-1/2"
 - 1/4" 2-1/2" EYE LAG SCREW @ 8'-0" O.C. (Z " EMBEDMENT)
 - ATTACH PER ROOF FRAMING PLAN (TYP.)
 - PLENUM
 - DUCTWORK
 - ROOF PURLIN
 - TRANSFER BOX

IDENTIFICATION STAMP
DIV. OF THE STATE ARCHITECT
OFFICE OF REGULATION SERVICES
DATE: JAN 07 1999

APP#3 117¹⁶⁸
AC / FLS / SS / IV
Date: AUG 04 2008

STKP-42 4/24/98

REVISIONS	Electrical Engineer's Seal	Mechanical Engineer's Seal	Structural Engineer's Seal	Architect's Seal	Division of the State Architect
1					
2					
3					
4					

Electrical Engineer's Seal

Mechanical Engineer's Seal

Structural Engineer's Seal

Architect's Seal

Division of the State Architect
IDENTIFICATION STAMP
DIV. OF THE STATE ARCHITECT
OFFICE OF REGULATION SERVICES
PS-266
DATE: JUN 2 1997

MODTECH INC.
2930 BARRETT AVENUE
PERRIS, CALIF. 92572
PH (909) 943-4014
FAX (909) 940-0427

PROJECT NUMBER: 2986
© MODTECH, INC. 1997
FRAMING DETAILS


drawn by: 4012-088
checked by: 05 JAN 99
date:
Modtech project no:
MODTECH Index No:
S5.1

FILE # P266S1.DWG PROJECT NO. 2986 PC-266

FILE # P266 S52 DWG PROJECT NO. 2986 PC-266


KEY NOTES

- 1 PLYWOOD ROOF SHEATING
- 2 [10GA.X HEADER TYPICAL.
- 3 1 1/2 X 1 1/2 X 16GA.
- 4 #10 S.T.S.M.S @24" O.C. OR 0.145# SHOT PIN AT 24" O.C.
- 5 E.N. PLYWOOD TO ROOF BEAM. (SEE STRUCTURAL)
- 6 FLOOR BEAM (SEE STRUCTURAL)
- 7 TUBE STEEL COLUMN.
- 8 2X4 STUD @ 16" O.C. TYP.
- 9 16d BOX NAILS @ 8" O.C.
- 10 2X4 SILL PLATE.
- 11 2X TRIMMER @ CORNER.
- 12 16d @ 24" O.C.
- 13 #10 S.T.S.M.S @ 16" O.C. OR AEROSMITH AKN 144.0175 DRIVE PIN.

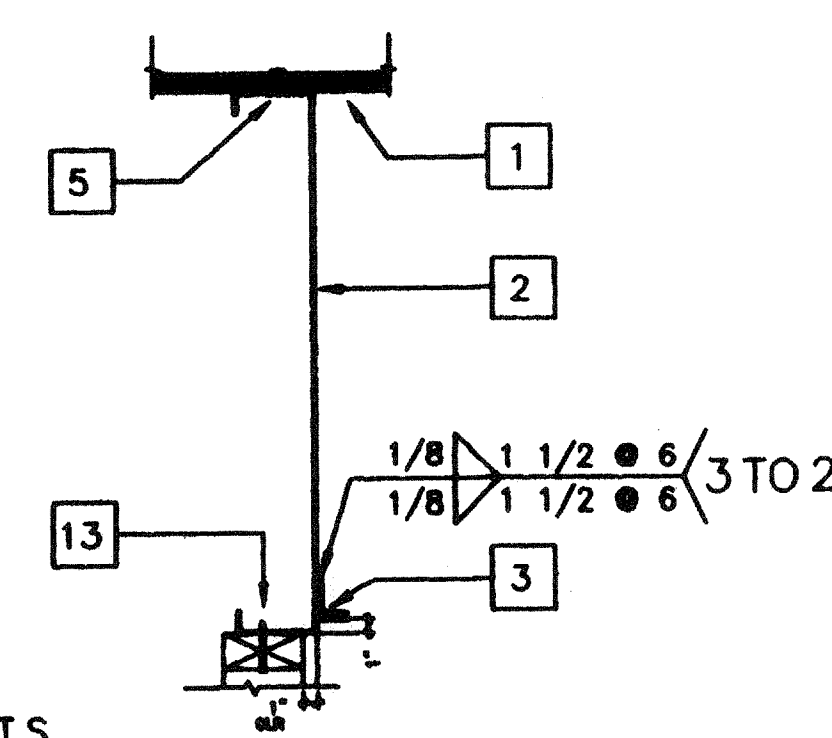


SCALE: N.T.S.

END WALL AT ROOF

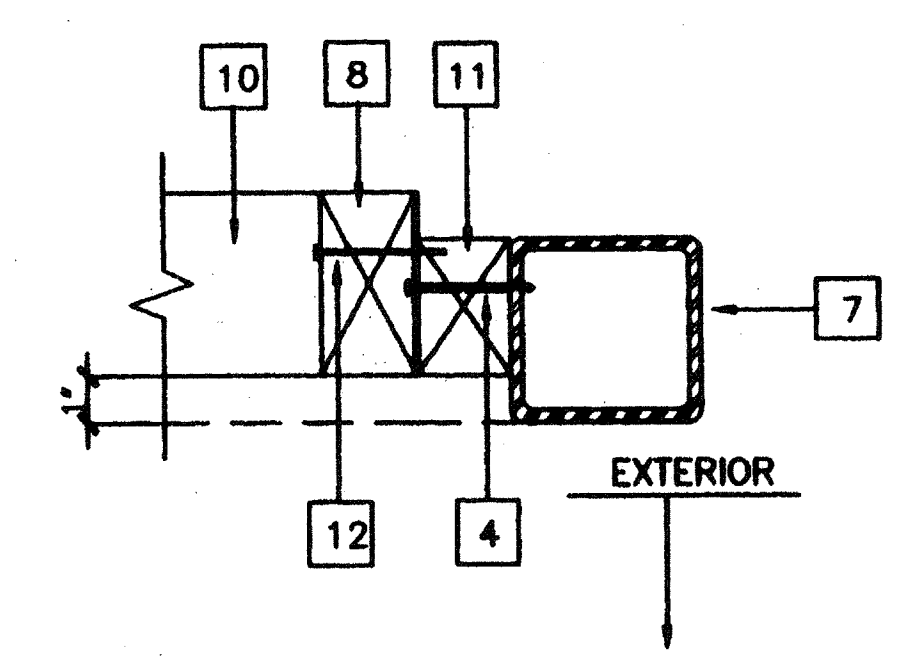


SCALE: 3"=1'

COLUMN AT END WALL

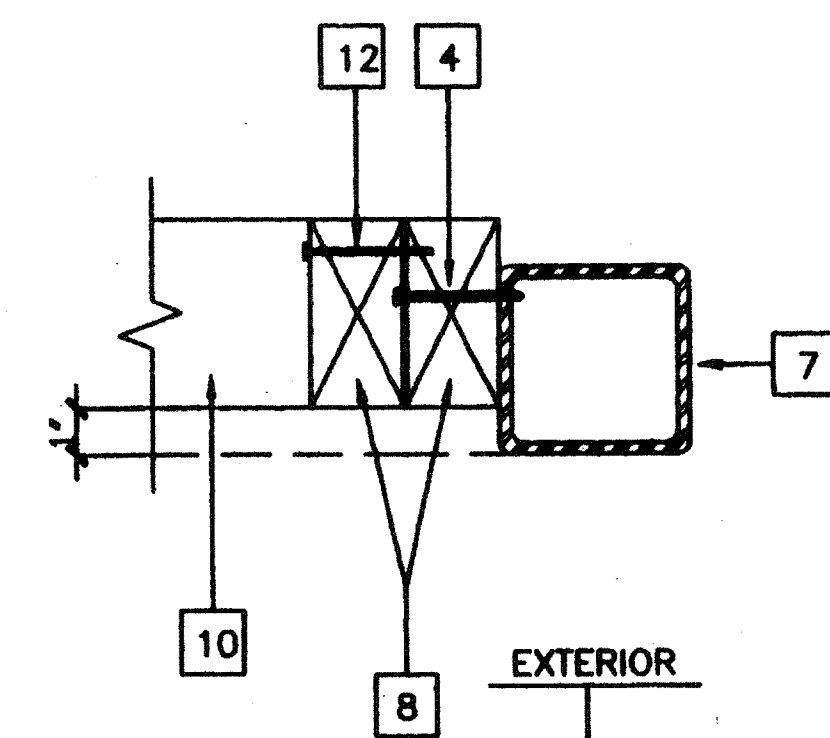


SCALE: 4"=1'

COLUMN AT SIDE WALL

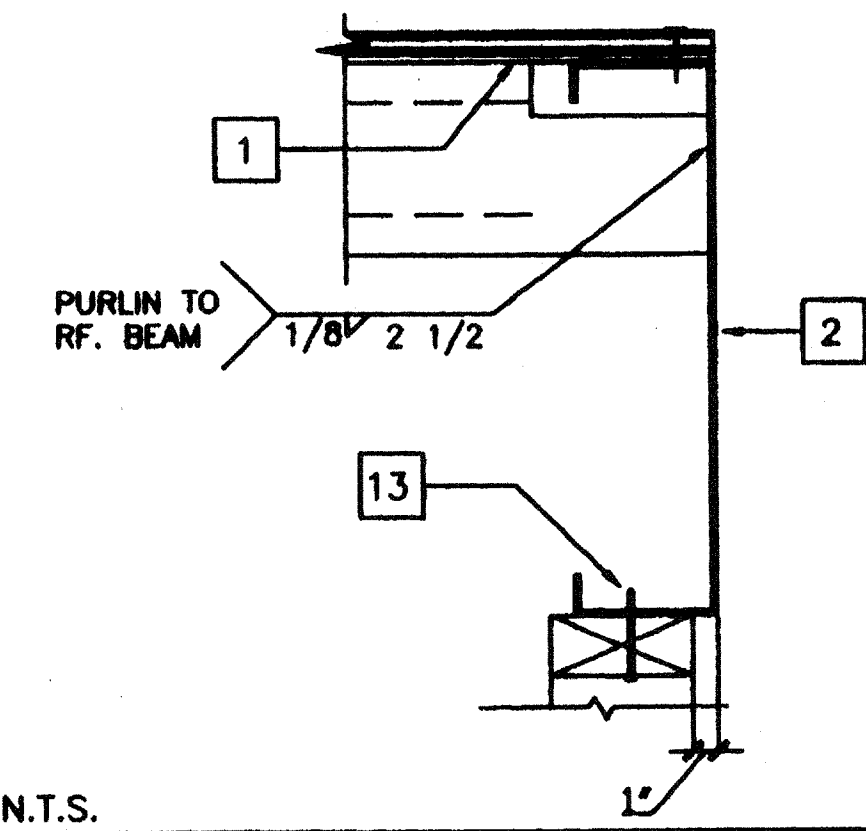


SCALE: N.T.S.

ROOF PURLIN AT ROOF BEAM

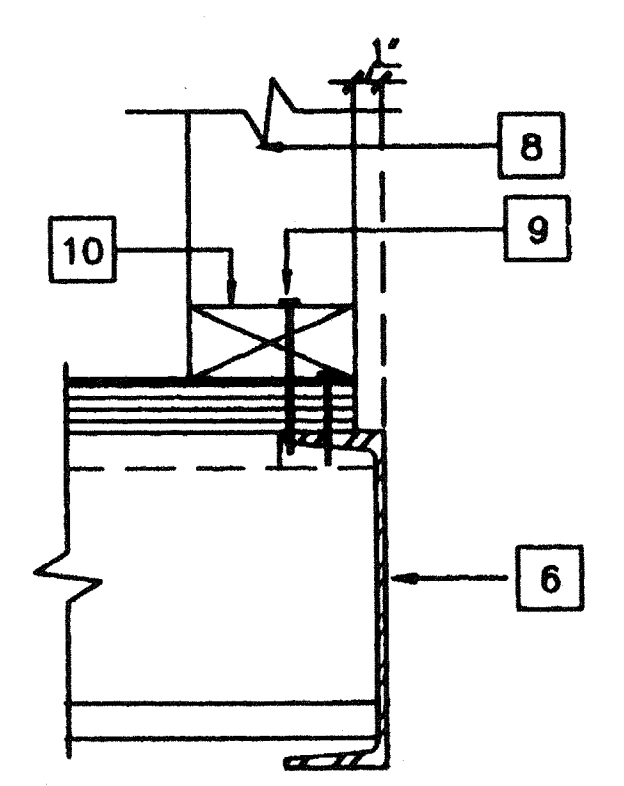

SCALE: 3"=1'

WALL SILL AT FLOOR

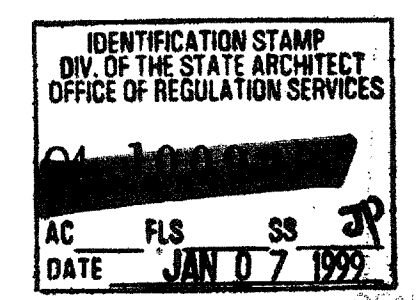

IDENTIFICATION STAMP
DIV. OF THE STATE ARCHITECT
OFFICE OF REGULATION SERVICES
APP#3 117168
AC/FLS/SS/TH
Date: JAN 04 2018

STKP-42 11/24/98

17	13	9	5	1			
18	14	10	6	2			
19	15	11	7	3			
20	16	REVIS	12	8	4		

REVISIONS			
1			
2			
3			
4			
5			

Electrical Engineer's Seal


Mechanical Engineer's Seal

Structural Engineer's Seal

Architect's Seal

Division of the State Architect
 IDENTIFICATION STAMP
 DIV. OF THE STATE ARCHITECT
 OFFICE OF REGULATION SERVICES

 AC/FLS/SS/TH
 DATE: JUN 25 1997

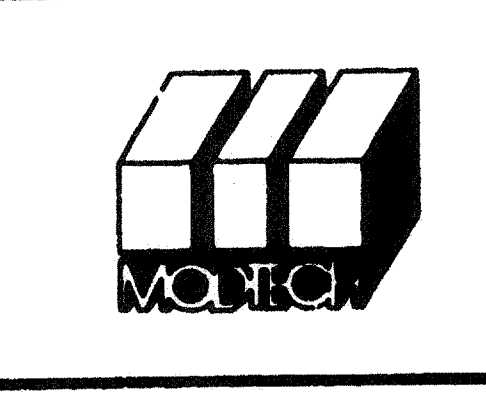


MODTECH INC.
 2830 BARRETT AVENUE
 PERRIS, CALIF. 92572
 PH (909) 943-4014
 FAX (909) 940-0427

PROJECT NUMBER: 2986 © MODTECH, INC. 1997

drawn by 4012-088
 checked by 05 JAN 99
 date
 Modtech project no.
 Modtech Index No.
S5.2

WALL FRAMING DETAILS

FILE # P266 MTO DWG

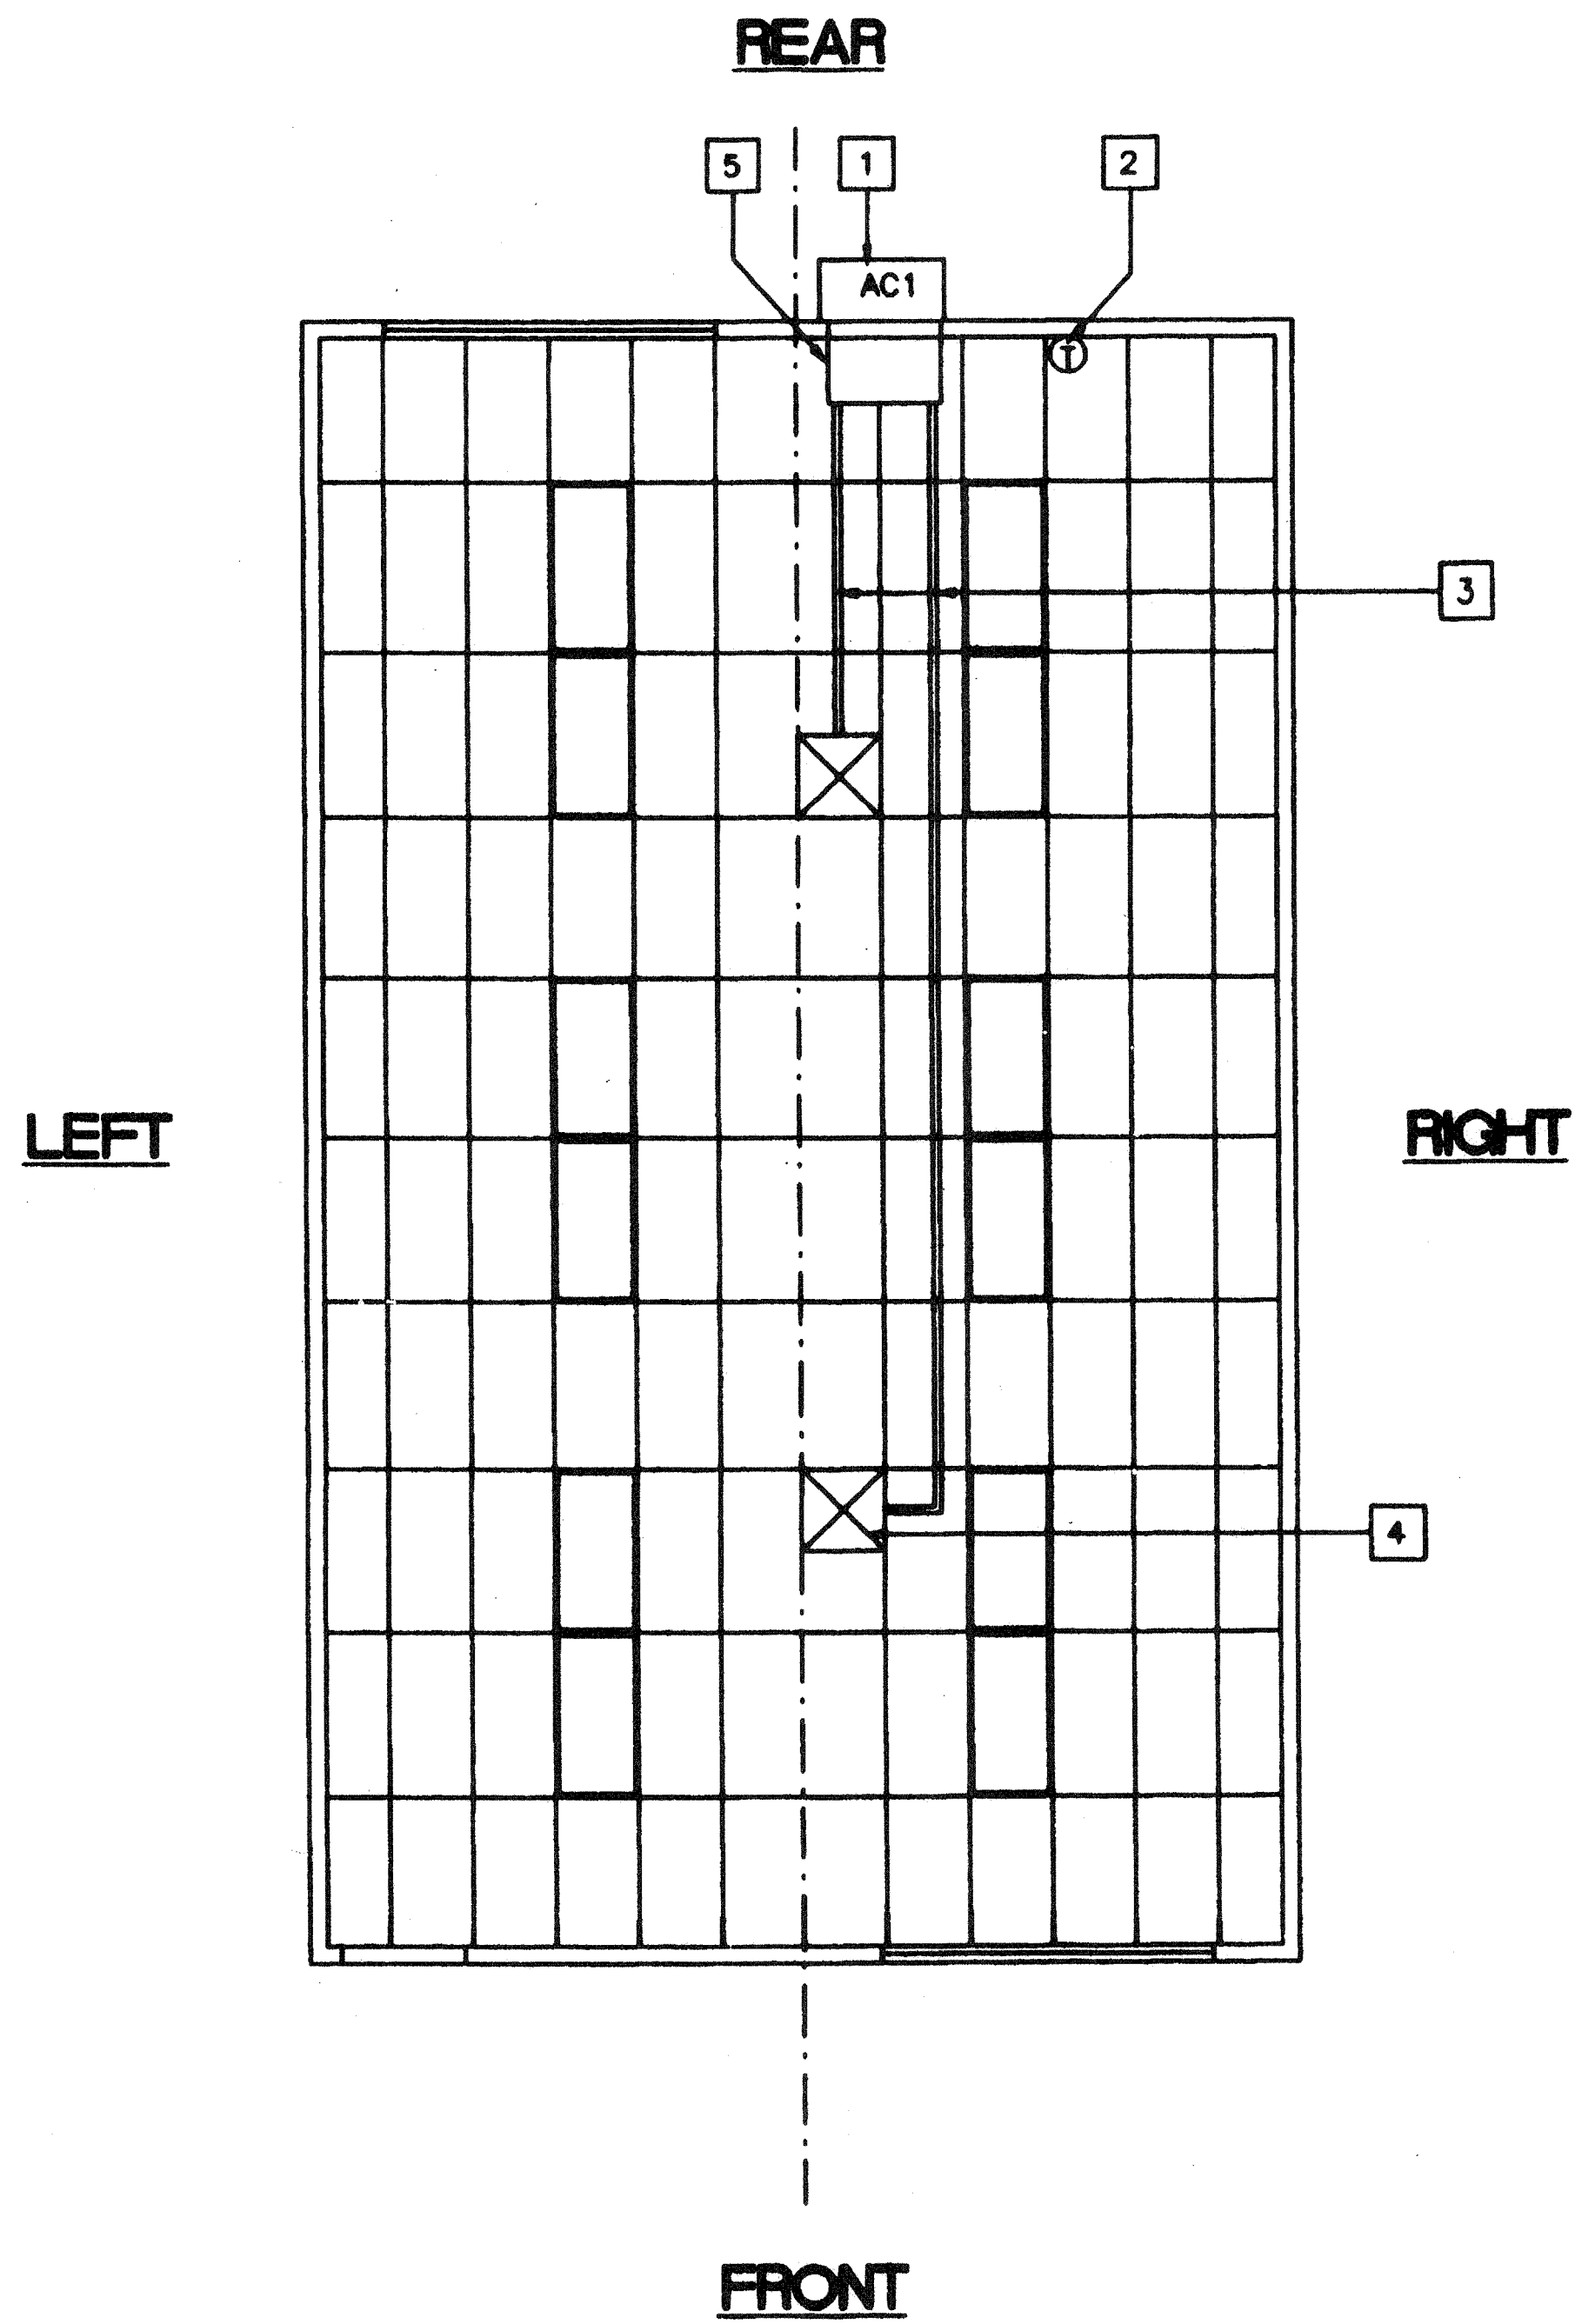

- ### KEY NOTES
- 1 AC1: WALL MOUNT 3.5 TON HEAT PUMP NOMINAL 47,000 BTUH COOL / 46,000 BTUH HEAT W/5kw HEATER OLA AND CALIFORNIA STATE ENERGY APPROVED 208 / 230V, 1 PHASE, MAX FLA 28 AMPS WEIGHT 510 LBS.
 - 2 ① THERMOSTAT - WHITE ROGERS IF92 + 48" A.F.F.
 - 3 12" FLEX DUCT
 - 4 15 x 15 4W SUPPLY AIR GRILLE
 - 5 10" x 30" x 2' PLENUM (SEE SPECS)

NOTES

1 INSULATION APPLIED TO EXTERIOR SURFACE OF DUCTS LOCATED IN BLDGS SHALL HAVE A FLAME SPREAD OF NOT MORE THAN 25 & A SMOKE-DENSITY NOT EXCEEDING 50 WHEN TESTED AS A COMPOSITE INSTALLATION INCLUDING INSULATION, FACING MATERIALS, TAPES & ADHESIVES AS NORMALLY APPLIED EXCEPT FOR INSULATION HAVING A FLAME SPREAD INDEX NOT EXCEEDING 50 & A SMOKE-DENSITY NOT GREATER THAN 100 MAY BE INSTALLED IN DWELLINGS OR APARTMENT HOUSES WHERE THE DUCT SYSTEM SERVES NOT MORE THAN ONE DWELLING UNIT.

2 **SCHOOL EQUIPMENT ANCHORAGE**
 THE FOLLOWING IS FOR THE MECHANICAL ENGINEER'S INFORMATION ONLY
 THE SEISMIC ANCHORAGE OF MECHANICAL EQUIPMENT SHALL CONFORM TO C.C.R. TITLE 24, SECTION 14534.2 AND TABLE 14-4 AND ANCHORAGE DETAILS FOR ROOF/FLOOR MOUNTED EQUIPMENT WEIGHING LESS THAN 400 LBS AND HUNG EQUIPMENT WEIGHING LESS THAN 20 LBS MAY BE OMITTED FROM THE PLANS

FOR MECHANICAL DRAWINGS:
 ALL MECHANICAL EQUIPMENT SHALL BE BRACED OR ANCHORED TO RESIST A HORIZONTAL FORCE ACTING IN ANY DIRECTION USING THE FOLLOWING CRITERIA


EQUIPMENT ON GRADE	30% OF OPERATING WEIGHT
EQUIPMENT ON STRUCTURE	30% OF OPERATING WEIGHT

FOR FLEXIBLY MOUNTED EQUIPMENT USE 4 X THE ABOVE VALUES, AND FOR SIMULTANEOUS VERTICAL FORCE USE 1/3 X THE HORIZONTAL FORCE

THE ABOVE VALUES ARE FOR AN IMPORTANCE FACTOR, I = 1.0 AND SEISMIC ZONE, Z = 0.4

WHERE ANCHORAGE DETAILS ARE NOT SHOWN ON THE DRAWINGS THE FIELD INSTALLATION SHALL BE SUBJECT TO THE APPROVAL OF THE MECHANICAL ENG AND THE FIELD ENGINEER OF THE OFFICE OF THE STATE ARCHITECT

IDENTIFICATION STAMP
 DIV. OF THE STATE ARCHITECT
 OFFICE OF REGULATION SERVICES
 AC / FLS / SS / W
 DATE JAN 07 1999

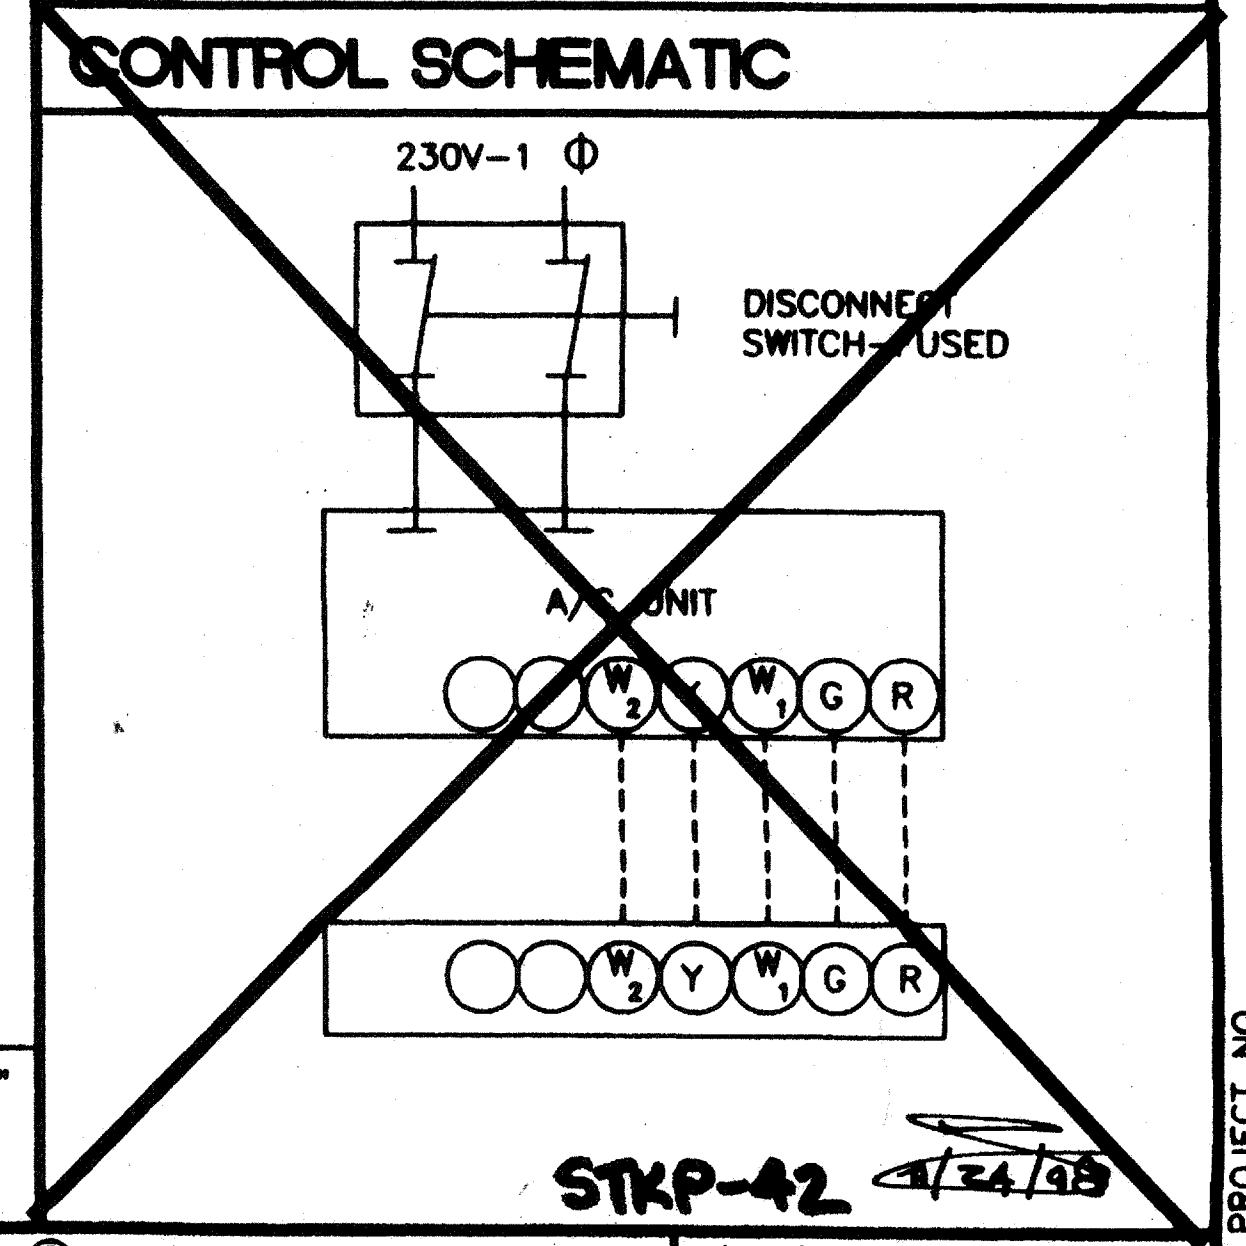

MECHANICAL PLAN (24' X 40')
 SCALE 1/4" = 1'-0"

REVISIONS	Electrical Engineer's Seal	Mechanical Engineer's Seal	Structural Engineer's Seal	Architect's Seal	Division of the State Architect	MODTECH INC.	PROJECT NUMBER: 29 86	© MODTECH, INC. 1997	drawn by 4012-088
1									date 05 JAN 99
2									date
3									date
4									date

Electrical Engineer's Seal

Mechanical Engineer's Seal

Structural Engineer's Seal

Architect's Seal
 LICENSED ARCHITECT
 GEORGE C. EDWARDS
 No. 1012-254
 EXPIRES 9-30-99
 STATE OF CALIFORNIA

Division of the State Architect
 IDENTIFICATION STAMP
 DIV. OF THE STATE ARCHITECT
 OFFICE OF REGULATION SERVICES
 PC-266
 AC / FLS / SS / W
 DATE JAN 07 1999

MODTECH INC.
 2830 BARRETT AVENUE
 PERRIS, CALIF. 92572
 PH (909) 943-4014
 FAX (909) 940-0427

PROJECT NUMBER: 29 86

© MODTECH, INC. 1997

drawn by 4012-088
 date 05 JAN 99
 checked by
 date
 Modtech project no.
 MODTECH logo No.

MECHANICAL (HVAC) PLAN
M1.0

PROJECT NO. 2986
 PC-266

ELECTRICAL PANEL SCHEDULE


LOAD	WATTS		BREAKER	PANEL A						FEED		LOAD
	AV	BV		LOCATION: REAR			LOCATION: FRONT			TYPE	WATTS	
RECEPTACLE (4)	720		20	1	1				2	60	840	HVAC (S)
RECEPTACLE / CLOCK (5)	900		20	1	3				4	—	360	HVAC (S)
INT. / EXT. LIGHTS (25)	900		20	1	5				6	30	2500	HVAC (HS)
INTERIOR LIGHTS (24)	840		20	1	7				8	—	2500	HVAC (HS)
FA (DEDICATED)	40				9				10			
					11				11			
					12				12			
WATTS/PHASE		A = 7,520	1600		1740		5060		5060		B = 7,600	WATTS/PHASE
TOTAL		18,500	WATTS	68	AMPS	120/240 VOLTS		SINGLE PH		THREE WIRE		
NCL =		13300 W										

GENERAL GROUNDING NOTES


- EACH BUILDING SHALL BE SEPARATELY GROUNDING WITH A 3/4" RD. X 8' COPPER/CLAD STEEL GROUND ROD. WHERE ROCK BOTTOM IS ENCOUNTERED, ROD SHALL BE DRIVEN AT AN ANGLE NOT TO EXCEED 45 DEGREE'S FROM THE VERTICAL OR SHALL BE BURIED IN A TRENCH THAT IS AT LEAST 30" DEEP. (BY SITE ELECTRICAL)
- TESTING: TEST FOR RESISTANCE TO GROUND. IF RESISTANCE EXCEEDS 25 OHMS, INSTALL ADDITIONAL GROUND RODS SEPARATED AT LEAST 6'-0" UNTIL RESISTANCE IS REDUCED TO 25 OHMS OR LESS. (BY SITE ELECTRICAL)
- PROVIDE EQUIPMENT ANCHORAGE PER TITLE 24, TABLE 16 J, PART B.
- APPROVAL OF THIS PLAN DOES NOT CONSTITUTE APPROVAL OF THIS FIRE ALARM FOR ALL SITES. THE FIRE ALARM SYSTEM AND/OR COMPONENTS MAYBE REQUIRED TO BE CHANGED DUE TO SITE LOCATION, EXISTING CONDITIONS OR INCOMPATIBLE COMPONENTS.
- GROUNDING TEST SHALL BE DONE IN THE PRESENCE OF THE PROJECT INSPECTOR. ALL GROUNDING SHALL BE IN ACCORDANCE WITH C.E.C. ARTICLE 250.

ELECTRICAL LEGEND

- 2'x4' 4 TUBE FLUORESCENT LIGHT FIXTURE
- ⊙ EXTERIOR LIGHT FIXTURE AT +96" AFF
- ⊕ DUPLEX WALL RECEPTACLE 15-A 125-V 3-WIRE AT +18" AFF L.N.O.
- ⊖ HVAC UNIT (HV)
- ⊗ 4s 'J' BOX FOR INT. FA PULL BOX. +48" AFF 3/4" CO TO ⊕ PULLSTRING.
- ⊘ 4s 'J' BOX FOR EXT. HORN/BELL. +96" AFF 3/4" CO TO ⊕ PULLSTRING.
- ⊙ (6x4x4) WEATHER PROOF GUTTER BOX + 18" AFF 3/4" CO TO ⊕ PULLSTRING.
- ⊖ ELECTRICAL PANEL. + 60" AFF (C). 1/2" POWER NIPPLE F22. GROUND JUMPER BY SITE ELEC.
- ⊕ SWITCH +48" A.F.F.
- ⊙ CLOCK. + 96" AFF
- ⊙ 4s 'J' BOX FOR INT. FA STROBE AT + 80" AFF. 3/4" CO TO ⊕ PULLSTRING.

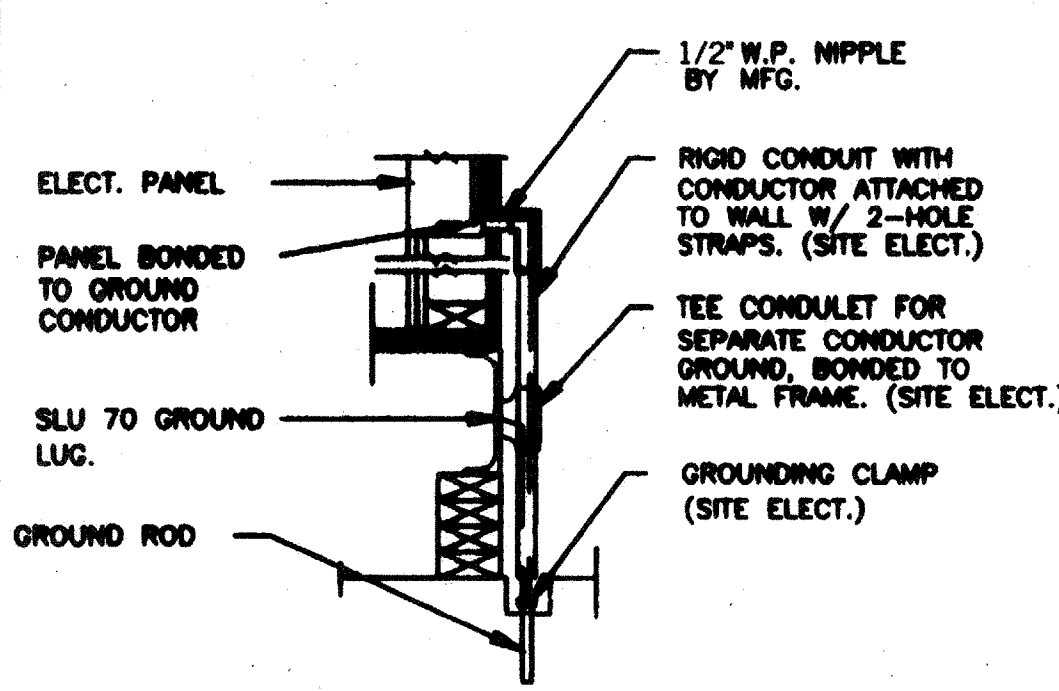

TYP GROUNDING DETAIL 1

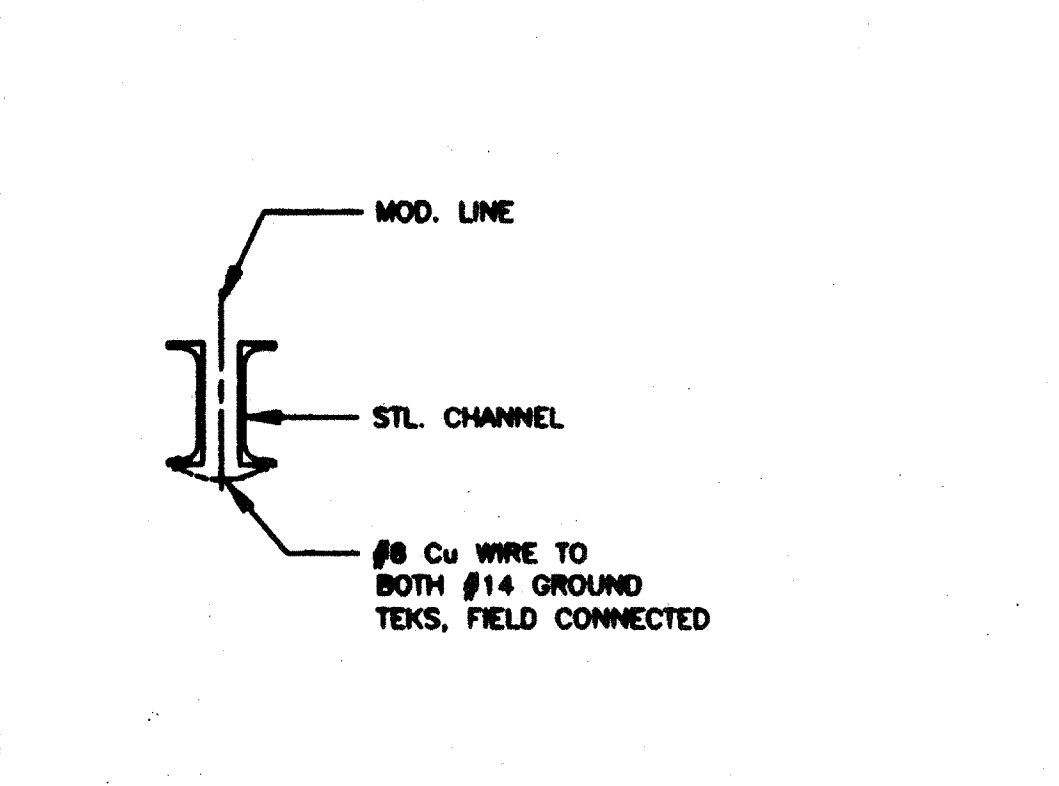


GROUND JUMPER • MOD LINE 2

NOTES

- SCHOOL EQUIPMENT ANCHORAGE
THE FOLLOWING IS FOR THE ARCHITECTS INFORMATION ONLY:
THE SEISMIC ANCHORAGE OF ELECTRICAL EQUIPMENT SHALL CONFORM TO C.C.R. TITLE 24, SECTION 16004.2 AND TABLE 16040. ANCHORAGE DETAILS FOR ROOF/FLOOR MOUNTED EQUIP. WEIGHING LESS THAN 400 LBS. & HUNG EQUIPMENT WEIGHING LESS THAN 20 LBS. MAY BE OMITTED FROM THE PLANS.
FOR ELECTRICAL DRAWINGS:
ALL ELECTRICAL EQUIPMENT SHALL BE BRACED OR ANCHORED TO RESIST A HORIZONTAL FORCE ACTING IN ANY DIRECTION USING THE FOLLOWING CRITERIA:

EQUIPMENT ON GRADE	30% OF OPERATING WEIGHT
EQUIPMENT ON STRUCTURE	30% OF OPERATING WEIGHT

FOR FLEXIBLY MOUNTED EQUIPMENT USE 4 X THE ABOVE VALUES, AND FOR SIMULTANEOUS VERTICAL FORCE USE 1/3 X THE HORIZONTAL FORCE.
THE ABOVE VALUES ARE FOR AN IMPORTANCE FACTOR, I = 1.0 AND SEISMIC ZONE, Z = 0.4.
WHERE ANCHORAGE DETAILS ARE NOT SHOWN ON THE DRAWINGS THE FIELD INSTALLATION SHALL BE SUBJECT TO THE APPROVAL OF THE ARCHITECT AND THE FIELD ENGINEER OF THE OFFICE OF THE STATE ARCHITECT.

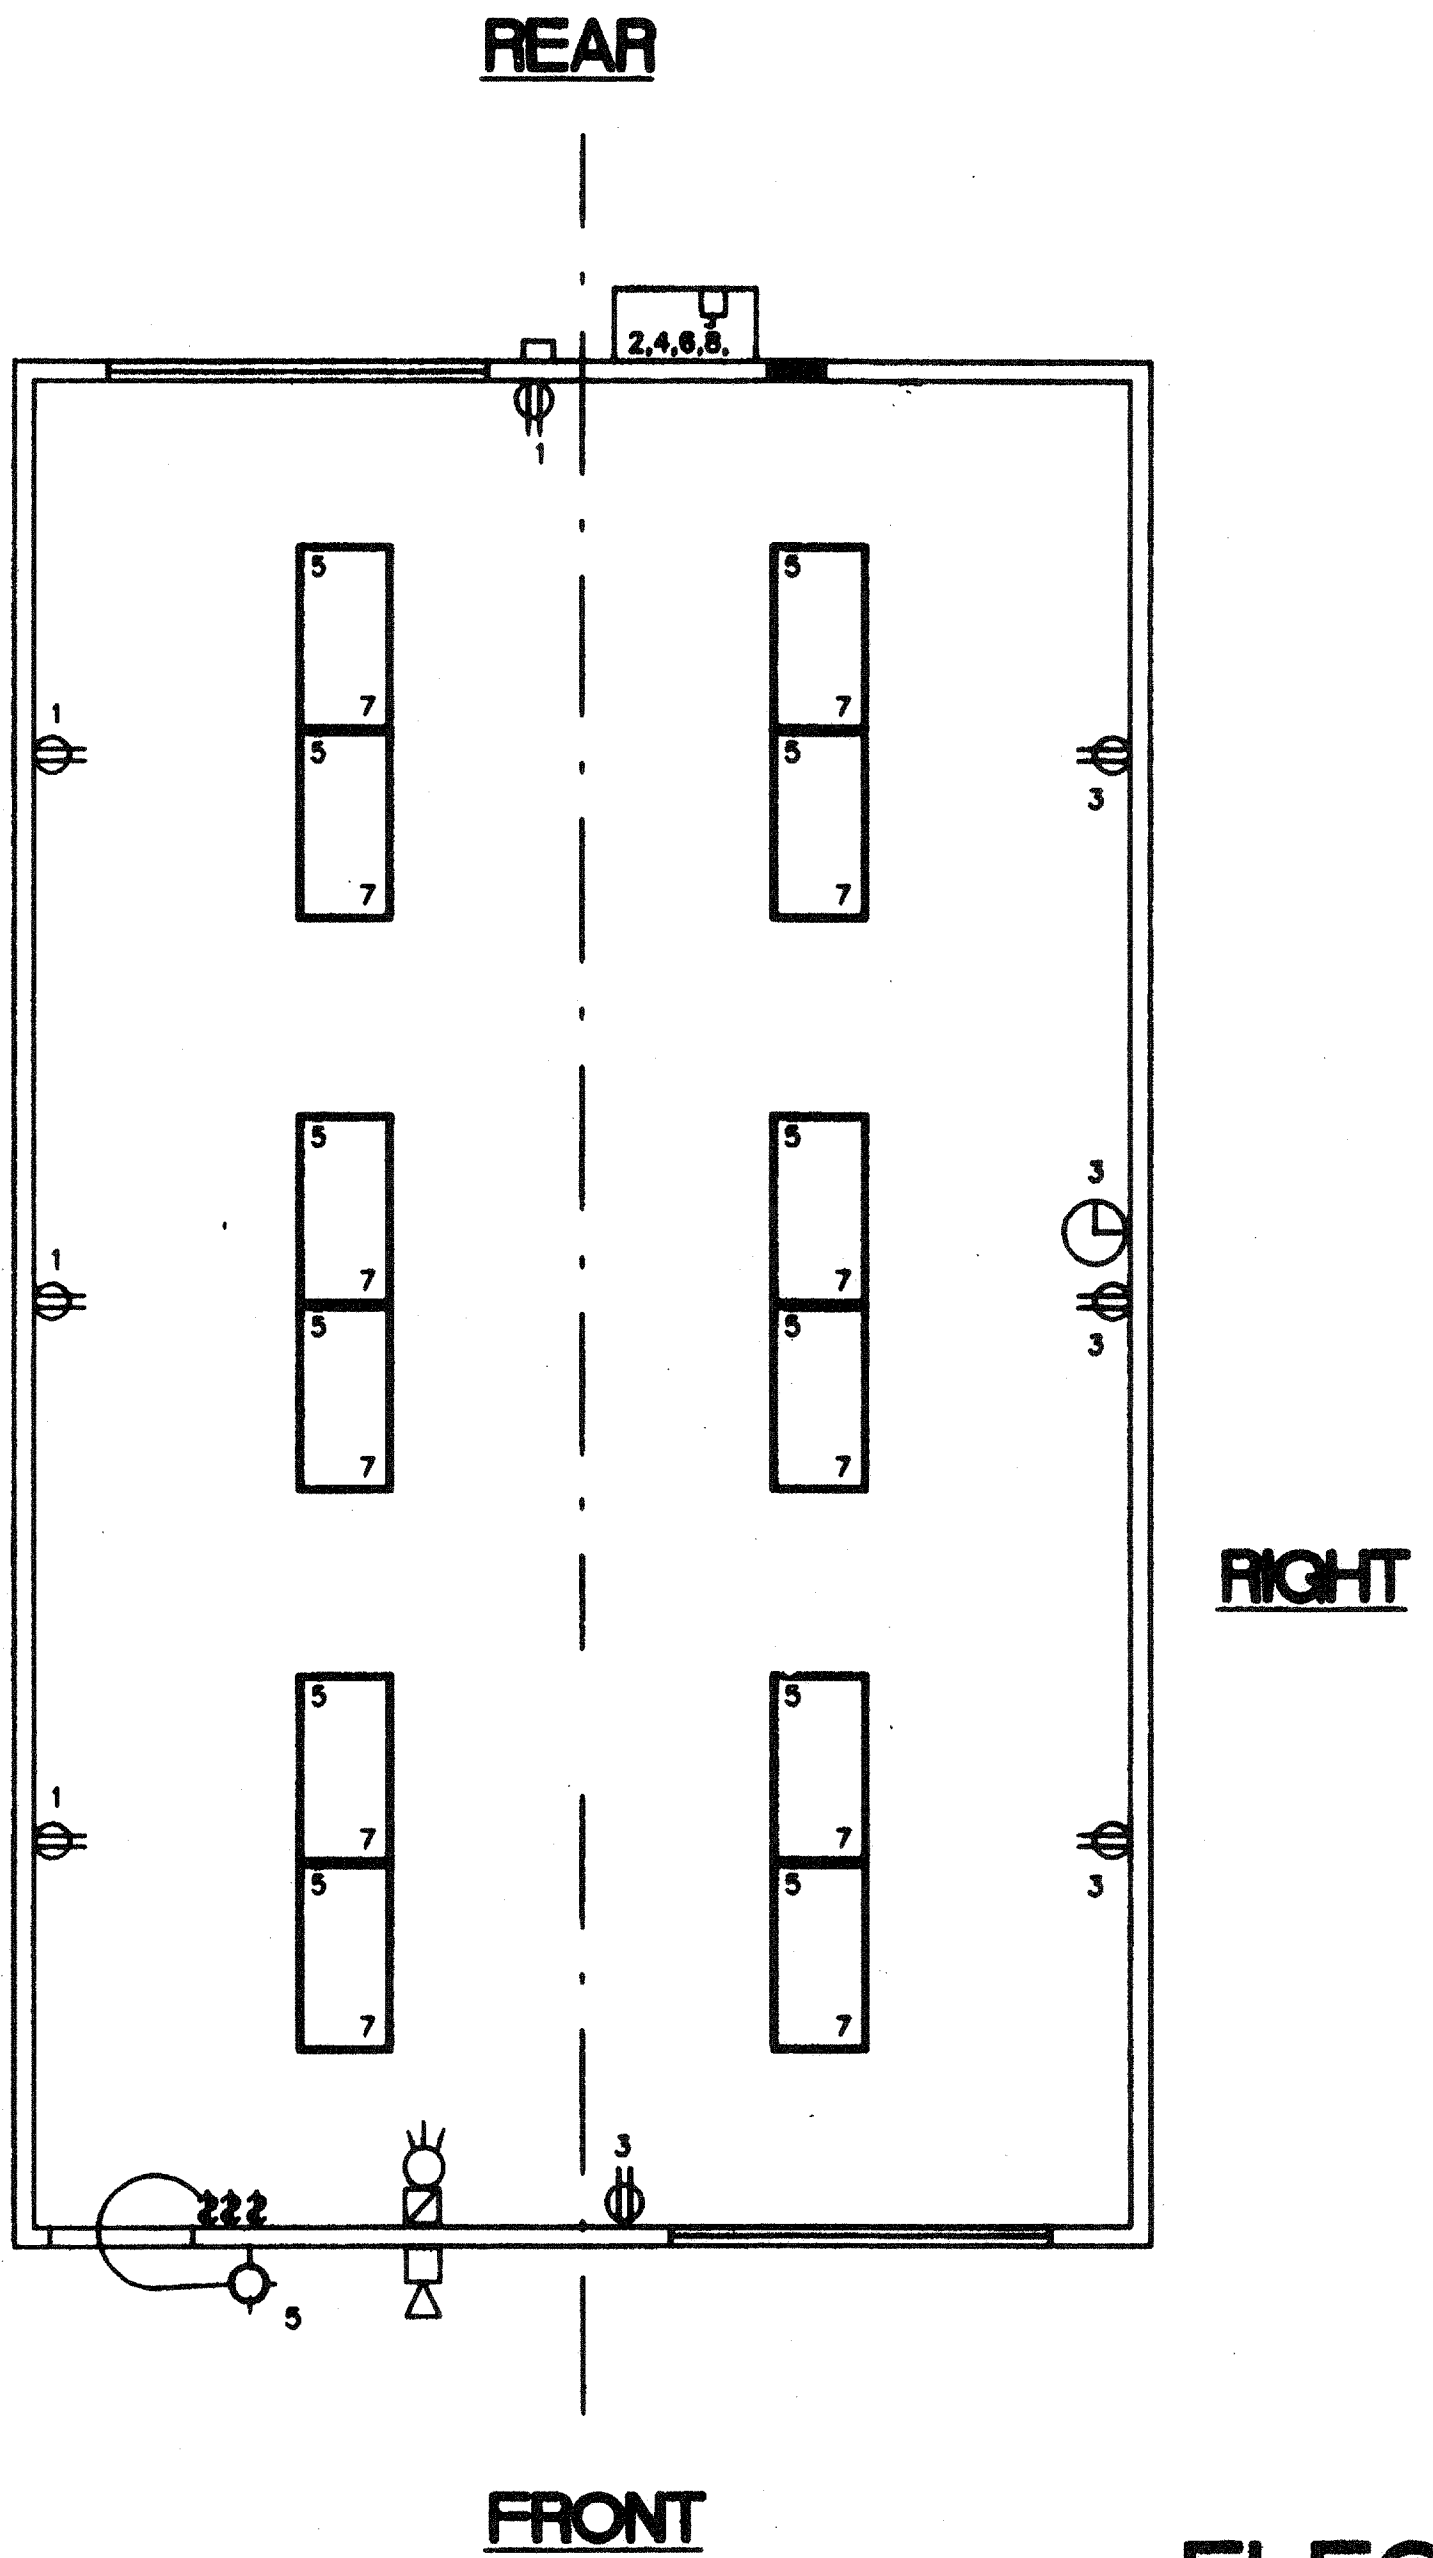

ELECTRICAL PLAN (24' X 40')

1/4" = 1'-0"

REVISIONS

△	
△	
△	
△	

REVISIED

Electrical Engineer's Seal
Mechanical Engineer's Seal
Structural Engineer's Seal
Architect's Seal
Division of the State Architect
PC-266
DATE: JAN 25 1999


MODTECH INC.
2830 BARRETT AVENUE
PERRIS, CALIF. 92572
PH (909) 943-4014
FAX (909) 940-0427

PROJECT NUMBER: 2986 © MODTECH, INC. 1997


drawn by: FWH
date: 11/98
checked by: 05 JAN 99
project no:
DATE: JAN 07 1999
STKP-42 1/24/98
E1.0

ELECTRICAL PLAN


FILE # P266E10.DWG PROJECT NO. 2377, 3022, 3183 PC-266 2506

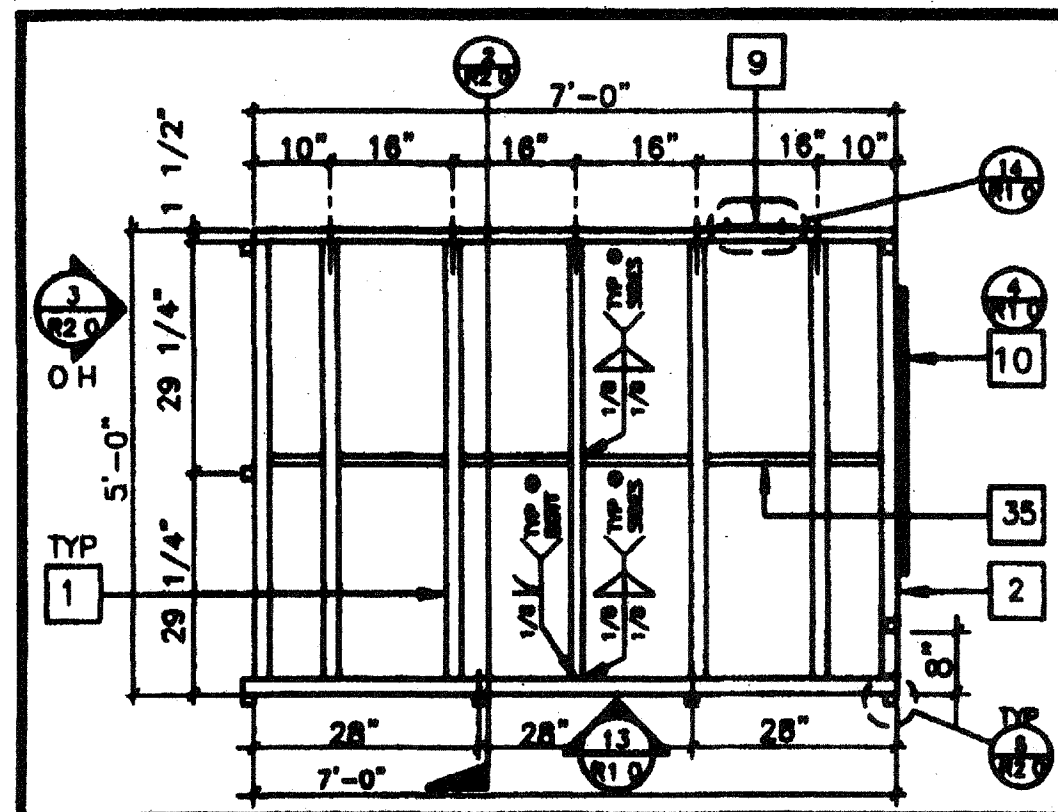


LANDING FRAME 12

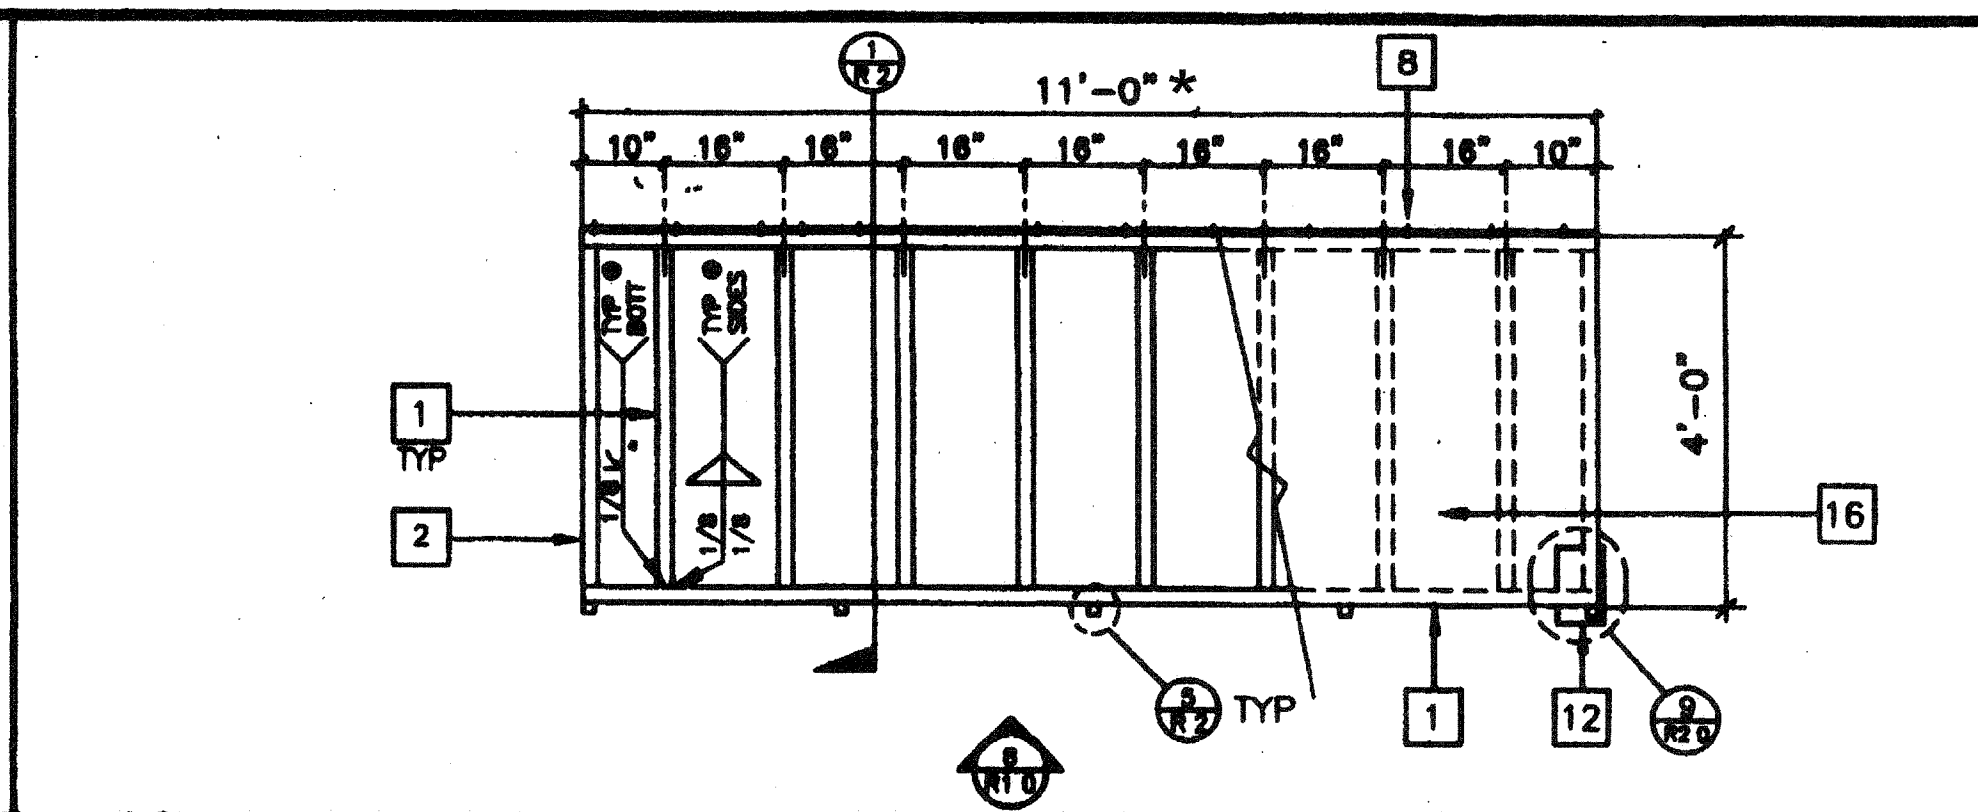


RAMP FRAME 7

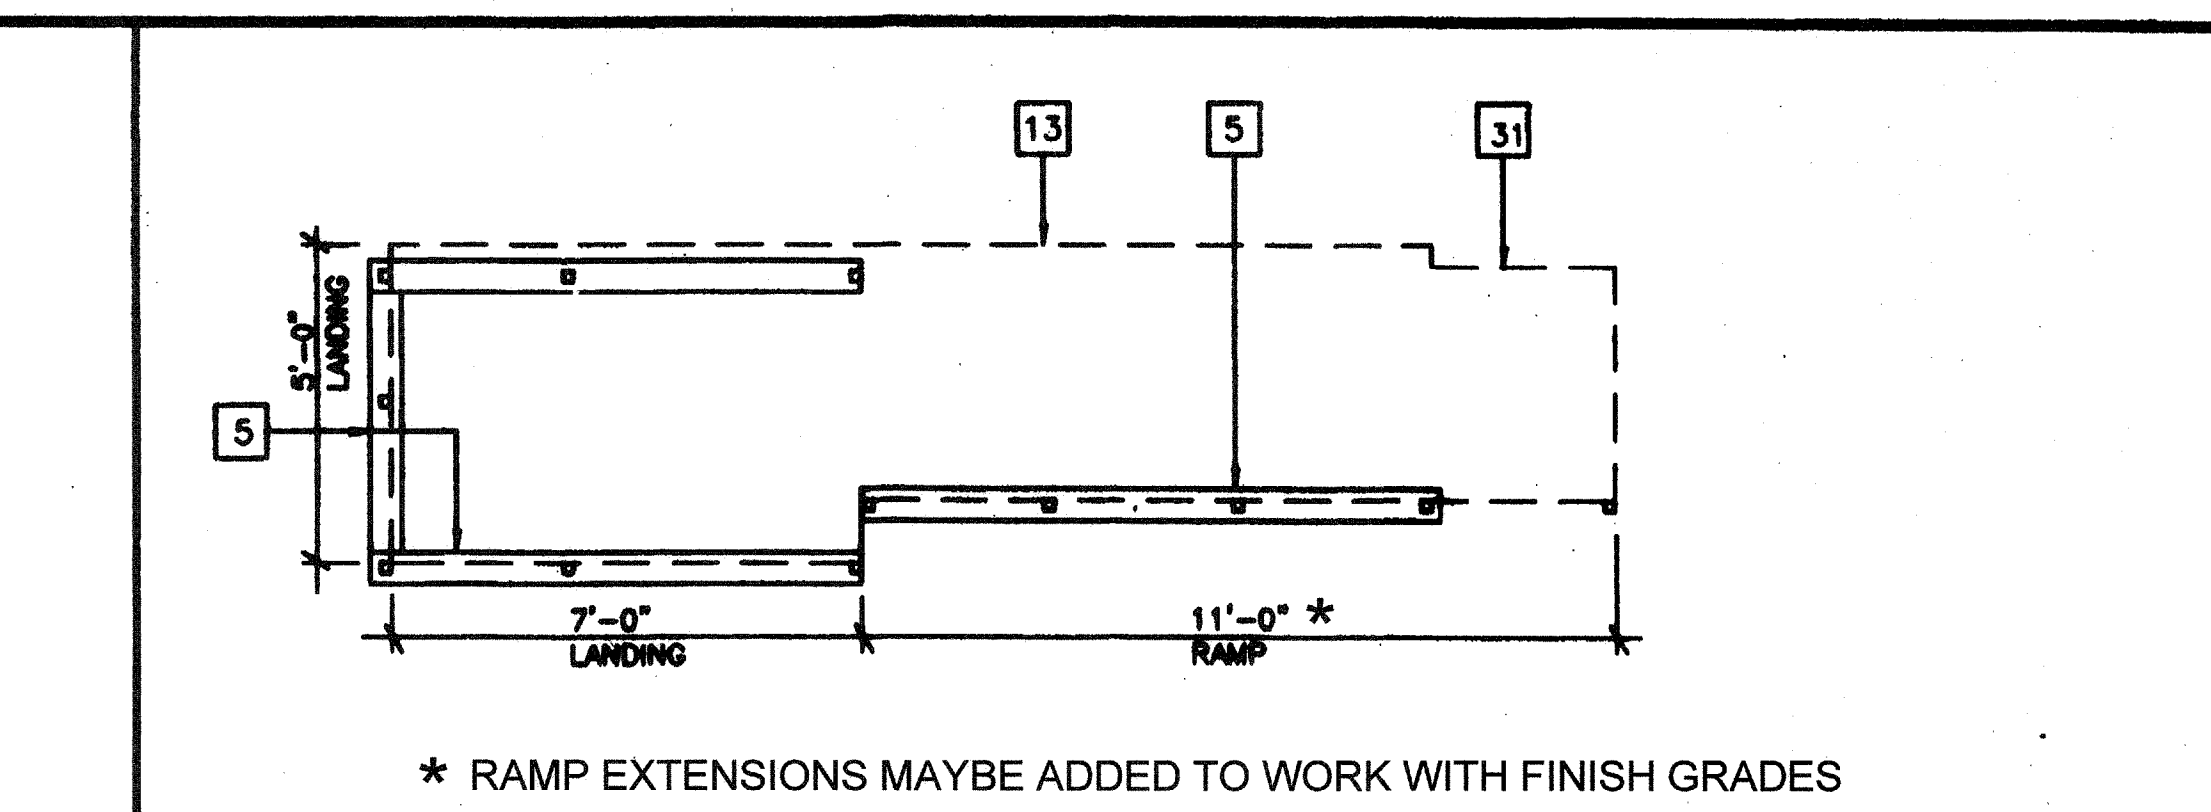


SILL PLAN FOR RAMP AND LANDING 3/8" 1

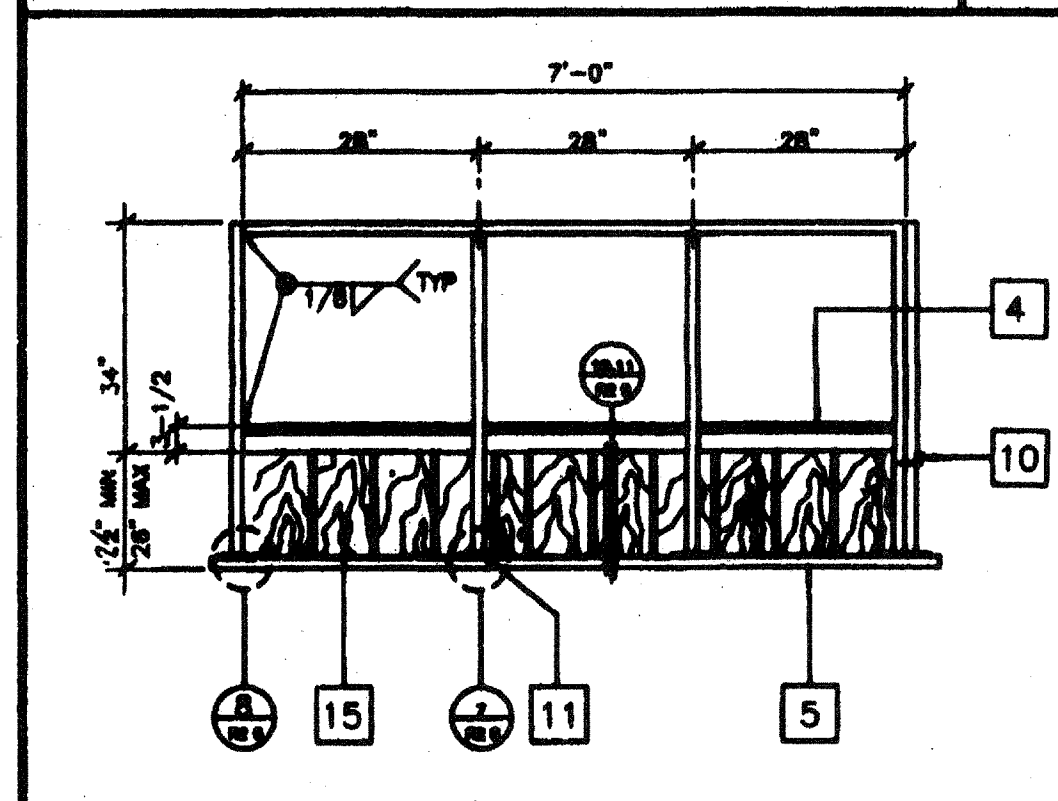


LANDING ELEVATION 13

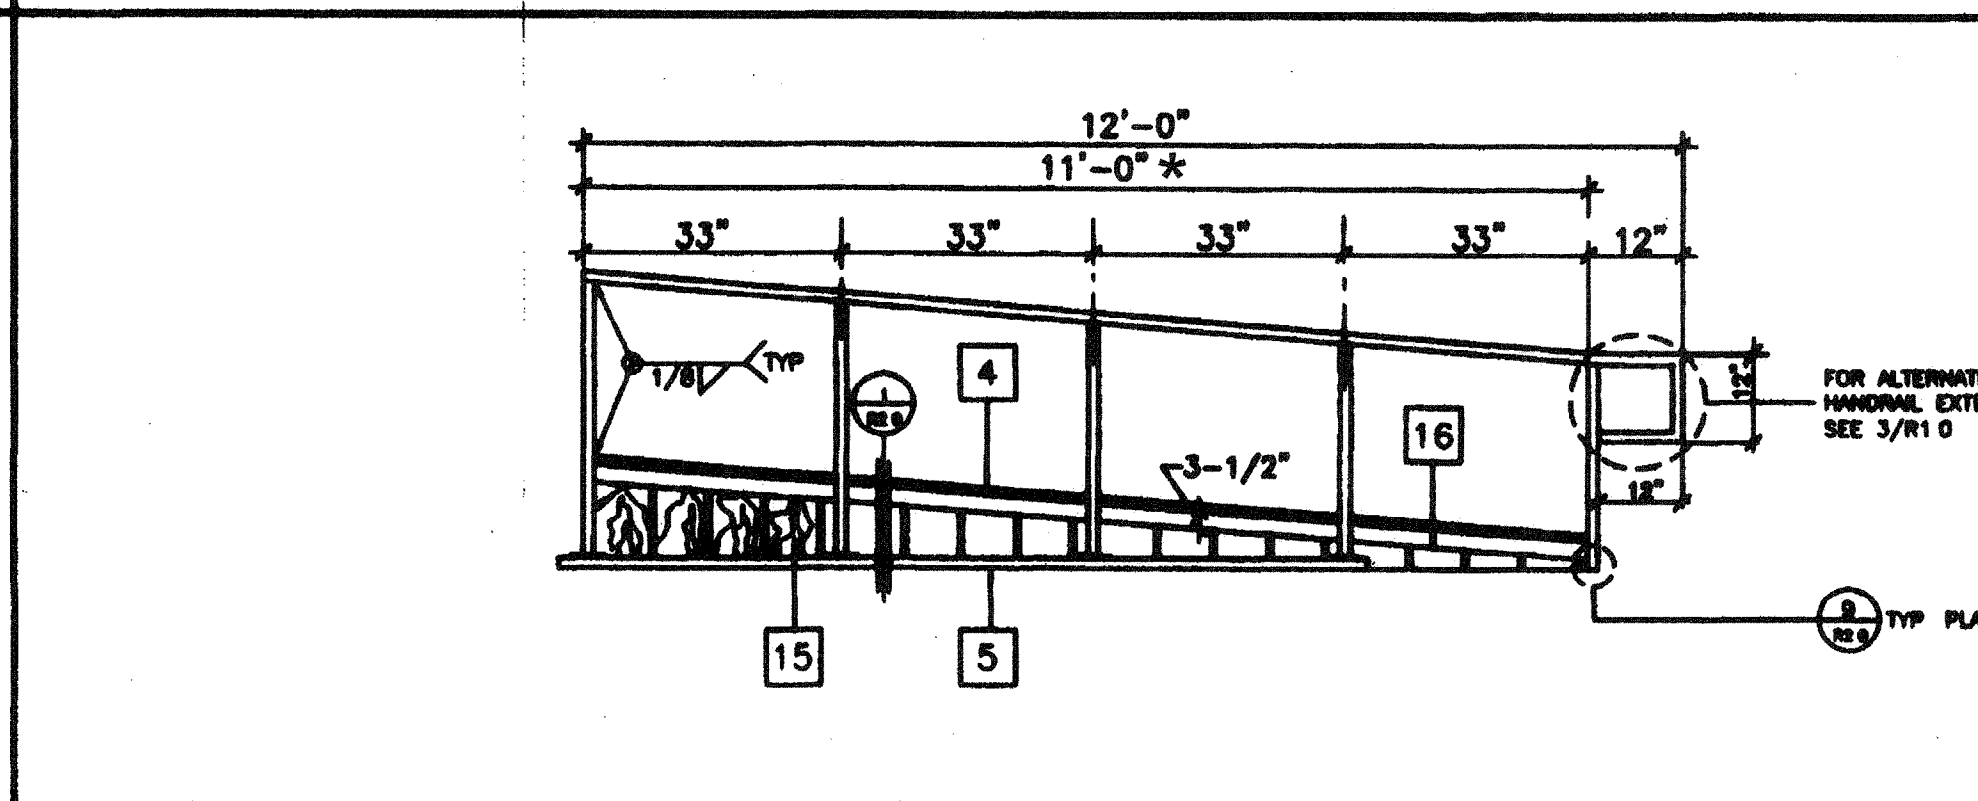


RAMP ELEVATION 8

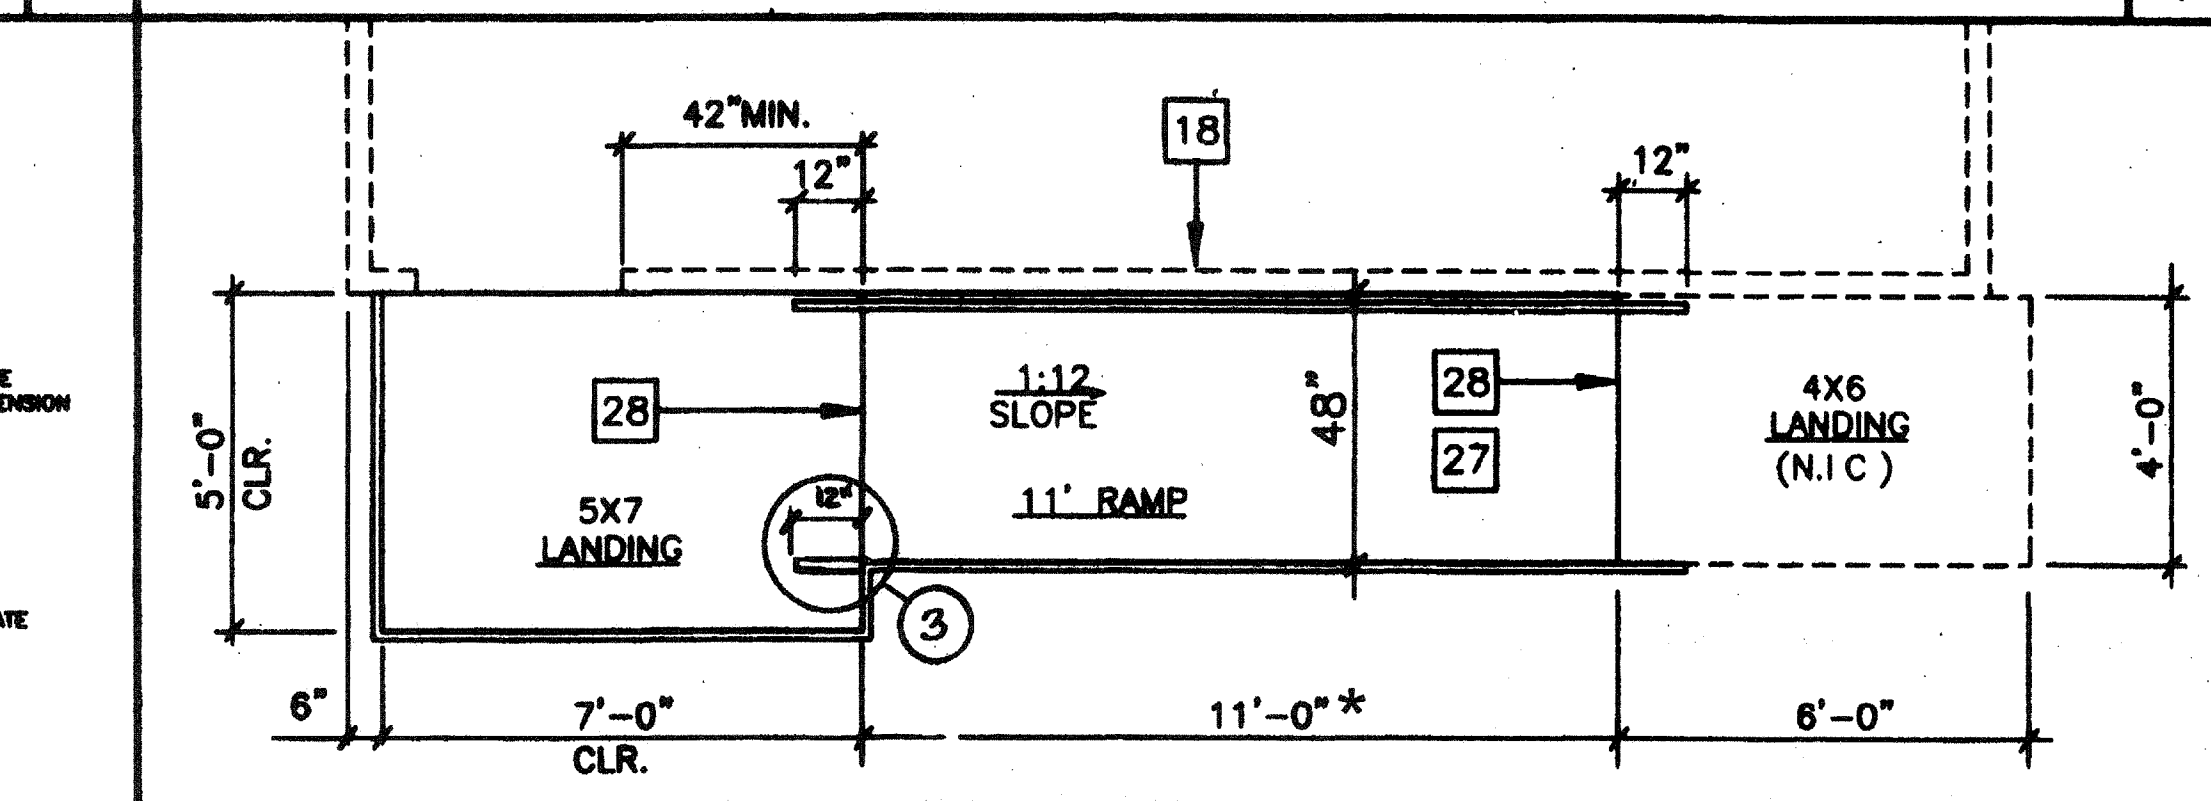


RAMP AND LANDING AT BUILDING 3/8" 2

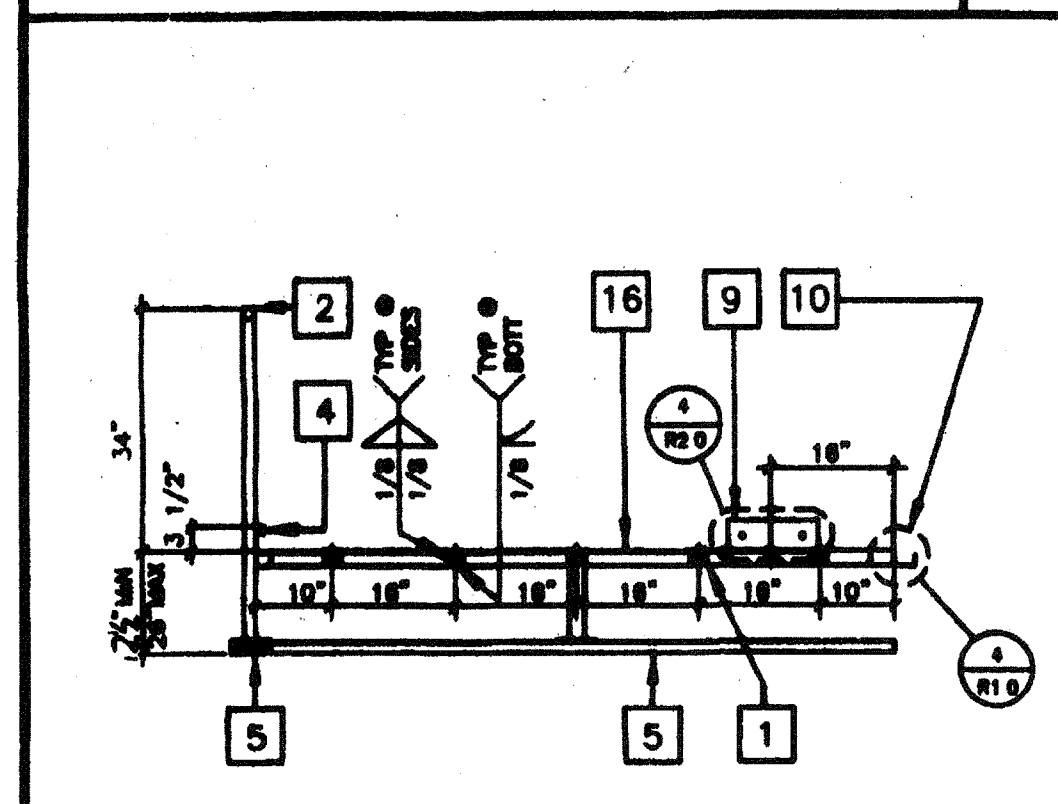


LONG. SECTION • LANDING 14

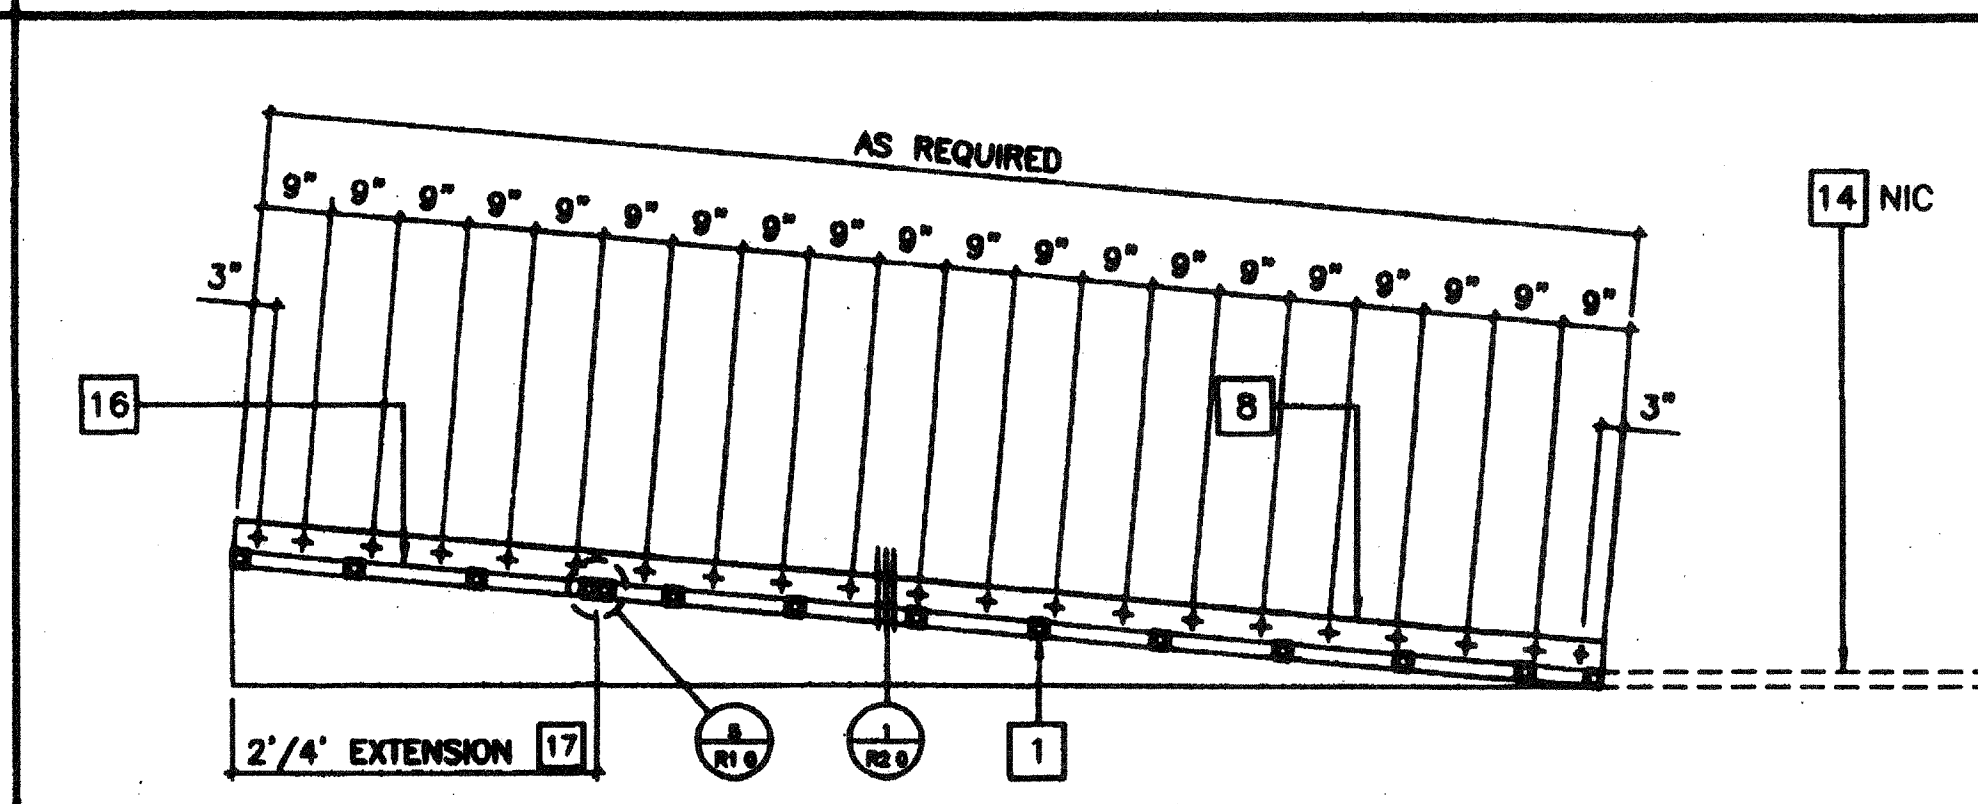


LONGITUDINAL SECTION • RAMP 9

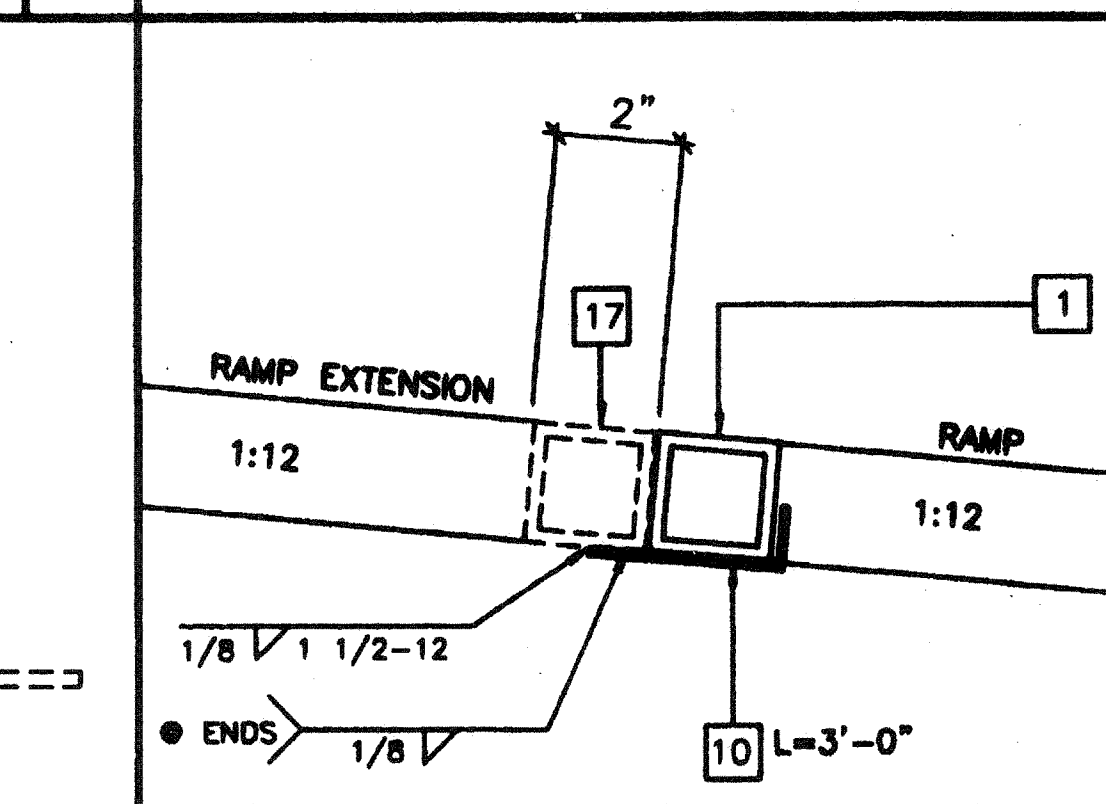

RAMP EXTENSION TO RAMP 5

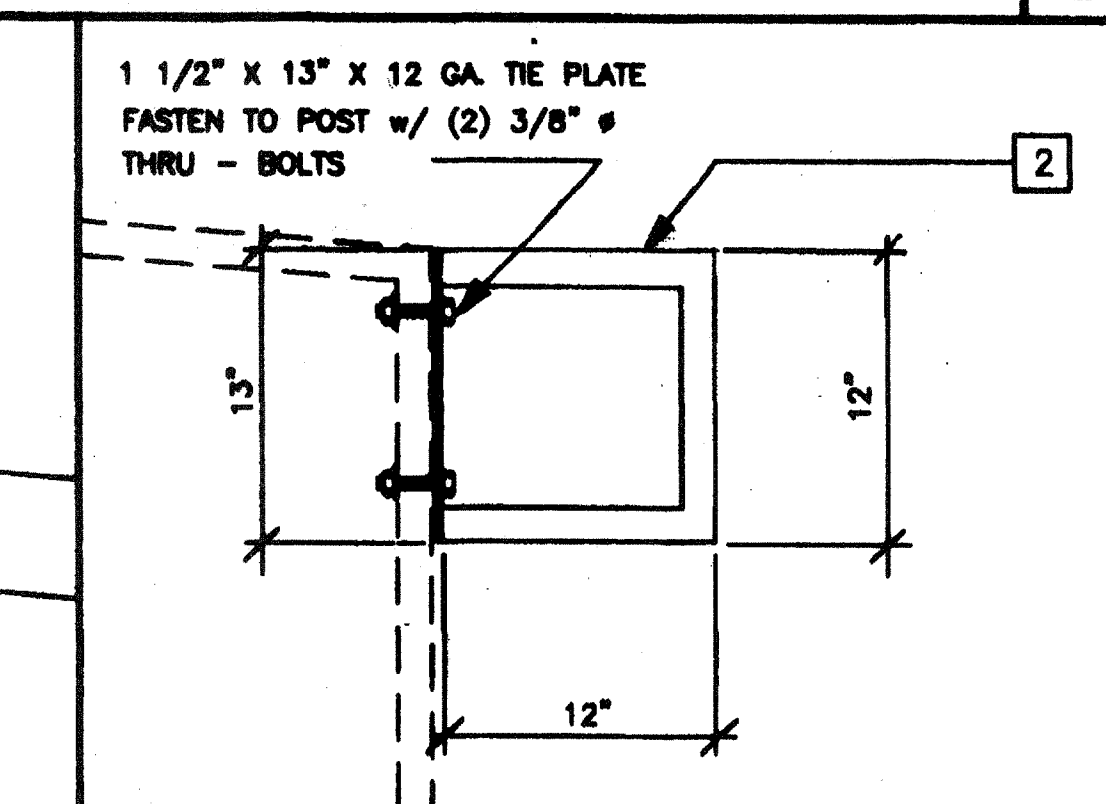


GUARD RAIL EXTENSION 3

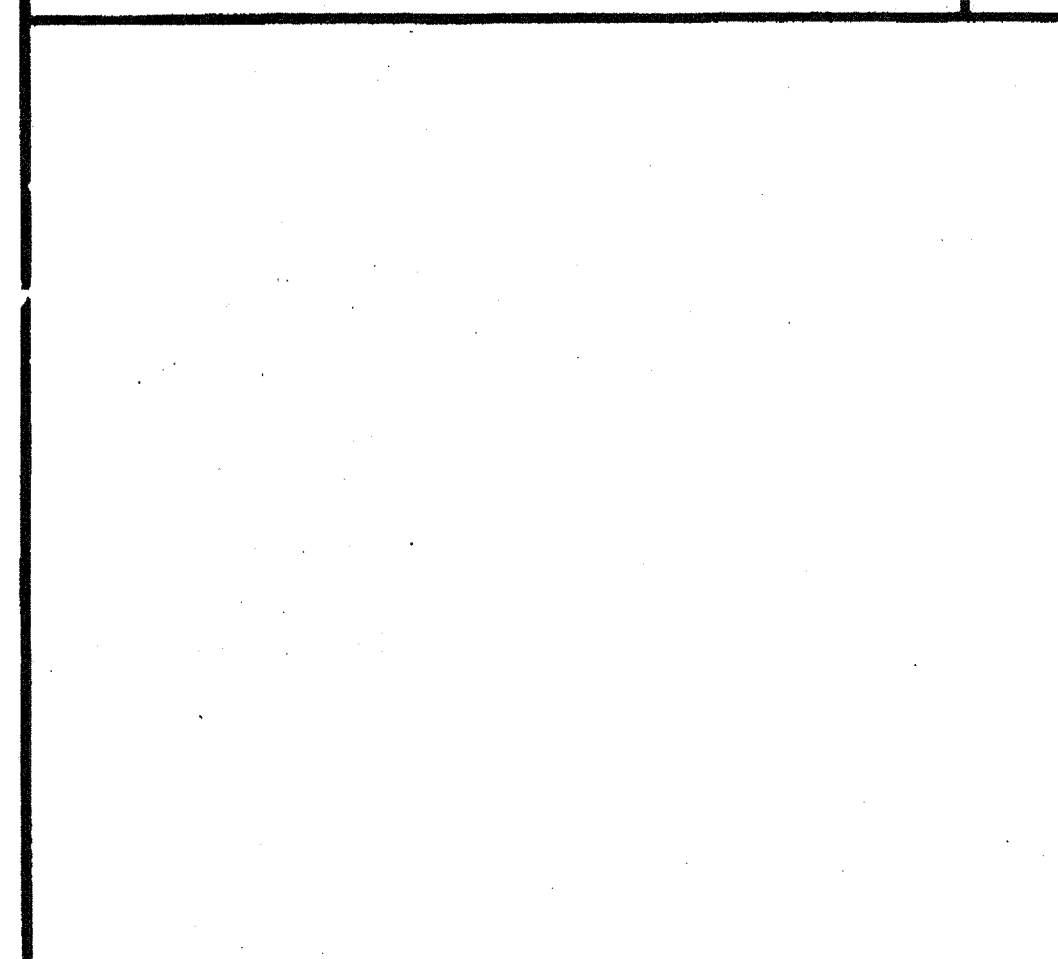

LANDING TO RAMP 4

KEY NOTES

- 1 TS 2" x 2" x 14ga
- 2 TS 1 1/2" x 1 1/2" x 14ga (Fy = 39KSI)
- 4 TS 1" x 1" x 16ga WHEELCHAIR GUIDE
- 5 2 x 6 PT SILL PLATE
- 8 6" x 10ga CONT. PLATE W/ 1/4" x 2" TEK SCREWS @ 9" OC INTO WOOD OR FOUND. BLOCKS OR #14 x 2" TEK SCREWS INTO STEEL @ 9" OC
- 9 6" x 12" x 10ga PLATE W/ 2-1/4" x 3" LAGS TO STRUCTURAL FRAME OF BUILDING
- 10 3" x 1" x 3'-0" x 10ga BENT PLATE
- 11 2" x 4" x 12ga BASE PLATE W/ 2-1/4" x 1" LAGS
- 12 6" x 10" x 12ga BASE PLATE @ RAMP TOE
- 13 LINE OF RAMP/LANDING ABOVE
- 14 LOWER LANDING BY DISTRICT
- 15 SKIRTING: PLYWOOD TO MATCH BUILDING SIDING. BLOCK ALL EDGES. ATTACH W/ 8d @ 8" OC EDGES AND 12 OC FIELD. AT EDGE CONNECTION TO T.S. USE #14 x 2" TEK SCREWS @ 6" OC
- 16 12ga METAL DECK: NON-SLIP SURFACE. DESIGN COEFFICIENT OF FRICTION GREATER THAN 0.6. MAINTAINABLE FOR 1 YR.
- 17 RAMP EXTENSION FRAME.
- 18 EXISTING BUILDING.
- 27 RAMP BY MODTECH.
- 28 FLUSH TRANSITION
- 31 NOTCH BOTTOM PLATE (MUD SILL) AS REQUIRED TO CLEAR RAMP TOE. MAX NOTCH 1 1/2" x 4'-0" LONG.
- 35 TS 1" x 1" x 16ga

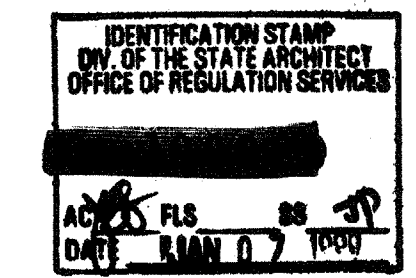


IDENTIFICATION STAMP
DIV. OF THE STATE ARCHITECT
OFFICE OF REGULATION SERVICES
APP#3 117168
AC/FLS/SS/TV
Date: APR 04 2009

NOTES

- 1 RAMP: RAMP SHALL NOT SLOPE MORE THAN 1" IN 12"
- 2 HANDRAILS: HANDRAILS AT BOTH SIDES OF RAMP AT 34" HT.
- 3 SURFACE: LANDING & RAMP TO HAVE NON SLIP SURFACE ANCOR GRIP II AS MANUFACTURED BY AMERICAN CHEMICAL COMPANY (OR EQUAL)
- 4 GROUNDING: PROVIDE GROUNDING OF RAMP TO BLDG FRAME W/ #8 CU TO BOTH GROUND LUGS.
- 5 ARCHITECT SITE / RAMP / LANDING PLANNING: DUE TO VARYING SITE CONDITIONS THE MAXIMUM HEIGHT OF FINISH FLOOR FROM GRADE IS 28" THEREFORE IT IS POSSIBLE THAT THE ACCESS RAMP ATTACHED TO THE BUILDING COULD BE 28'-0" AT A SLOPE OF 1:12 ARCHITECT MUST TAKE INTO ACCOUNT THAT THE RAMP SUPPLIED BY MODTECH INC. IS 11'-0" AT A SLOPE OF 1:12 THEREFORE THE ARCHITECT WILL HAVE TO DESIGN AND PROVIDE SUFFICIENT DETAILS OF RAMP EXTENSIONS AND BOTTOM LANDING DEPENDING ON PARTICULAR SITE CONDITIONS. IN NO WAY IS MODTECH INC. RESPONSIBLE FOR ANY RAMP EXTENSION EXCEEDING THE ORIGINAL PLAN AS SHOWN ON SHEET R-1.
- 6 ALL 1 1/4" AND 1 1/2" TUBE STEEL TO BE OF ASTM A500 GRADE A STEEL (Fy = 36 KSI)

REVISIONS	Electrical Engineer's Seal	Mechanical Engineer's Seal	Structural Engineer's Seal	Architect's Seal
1				
2				
3				
4				
5				

Electrical Engineer's Seal
Mechanical Engineer's Seal
Structural Engineer's Seal
Architect's Seal

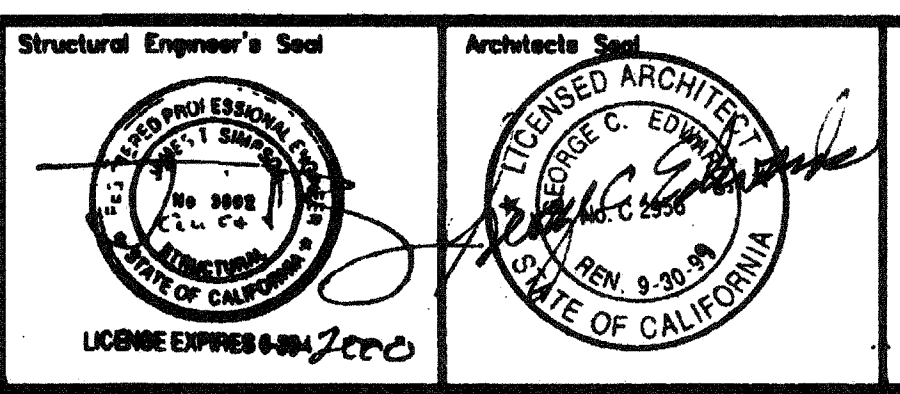


IDENTIFICATION STAMP
DIV. OF THE STATE ARCHITECT
OFFICE OF REGULATION SERVICES
PC 266
AC/FLS/SS/TV
DATE: JAN 21 2009
REVISED

MODTECH INC.
2830 BARRETT AVENUE
PERRIS, CALIF. 92572
PH (909) 943-4014
FAX (909) 940-0427

Job Number: PC 266 2986 © MODTECH, INC. 1997
drawn by FVH
date 11/98
checked by 4012-088
date 05 JAN 99
PROJECT no. 2986
MODTECH index No.

STKP-42
RAMP / LANDING
R1.0

2506, 2577, 3022, 3153

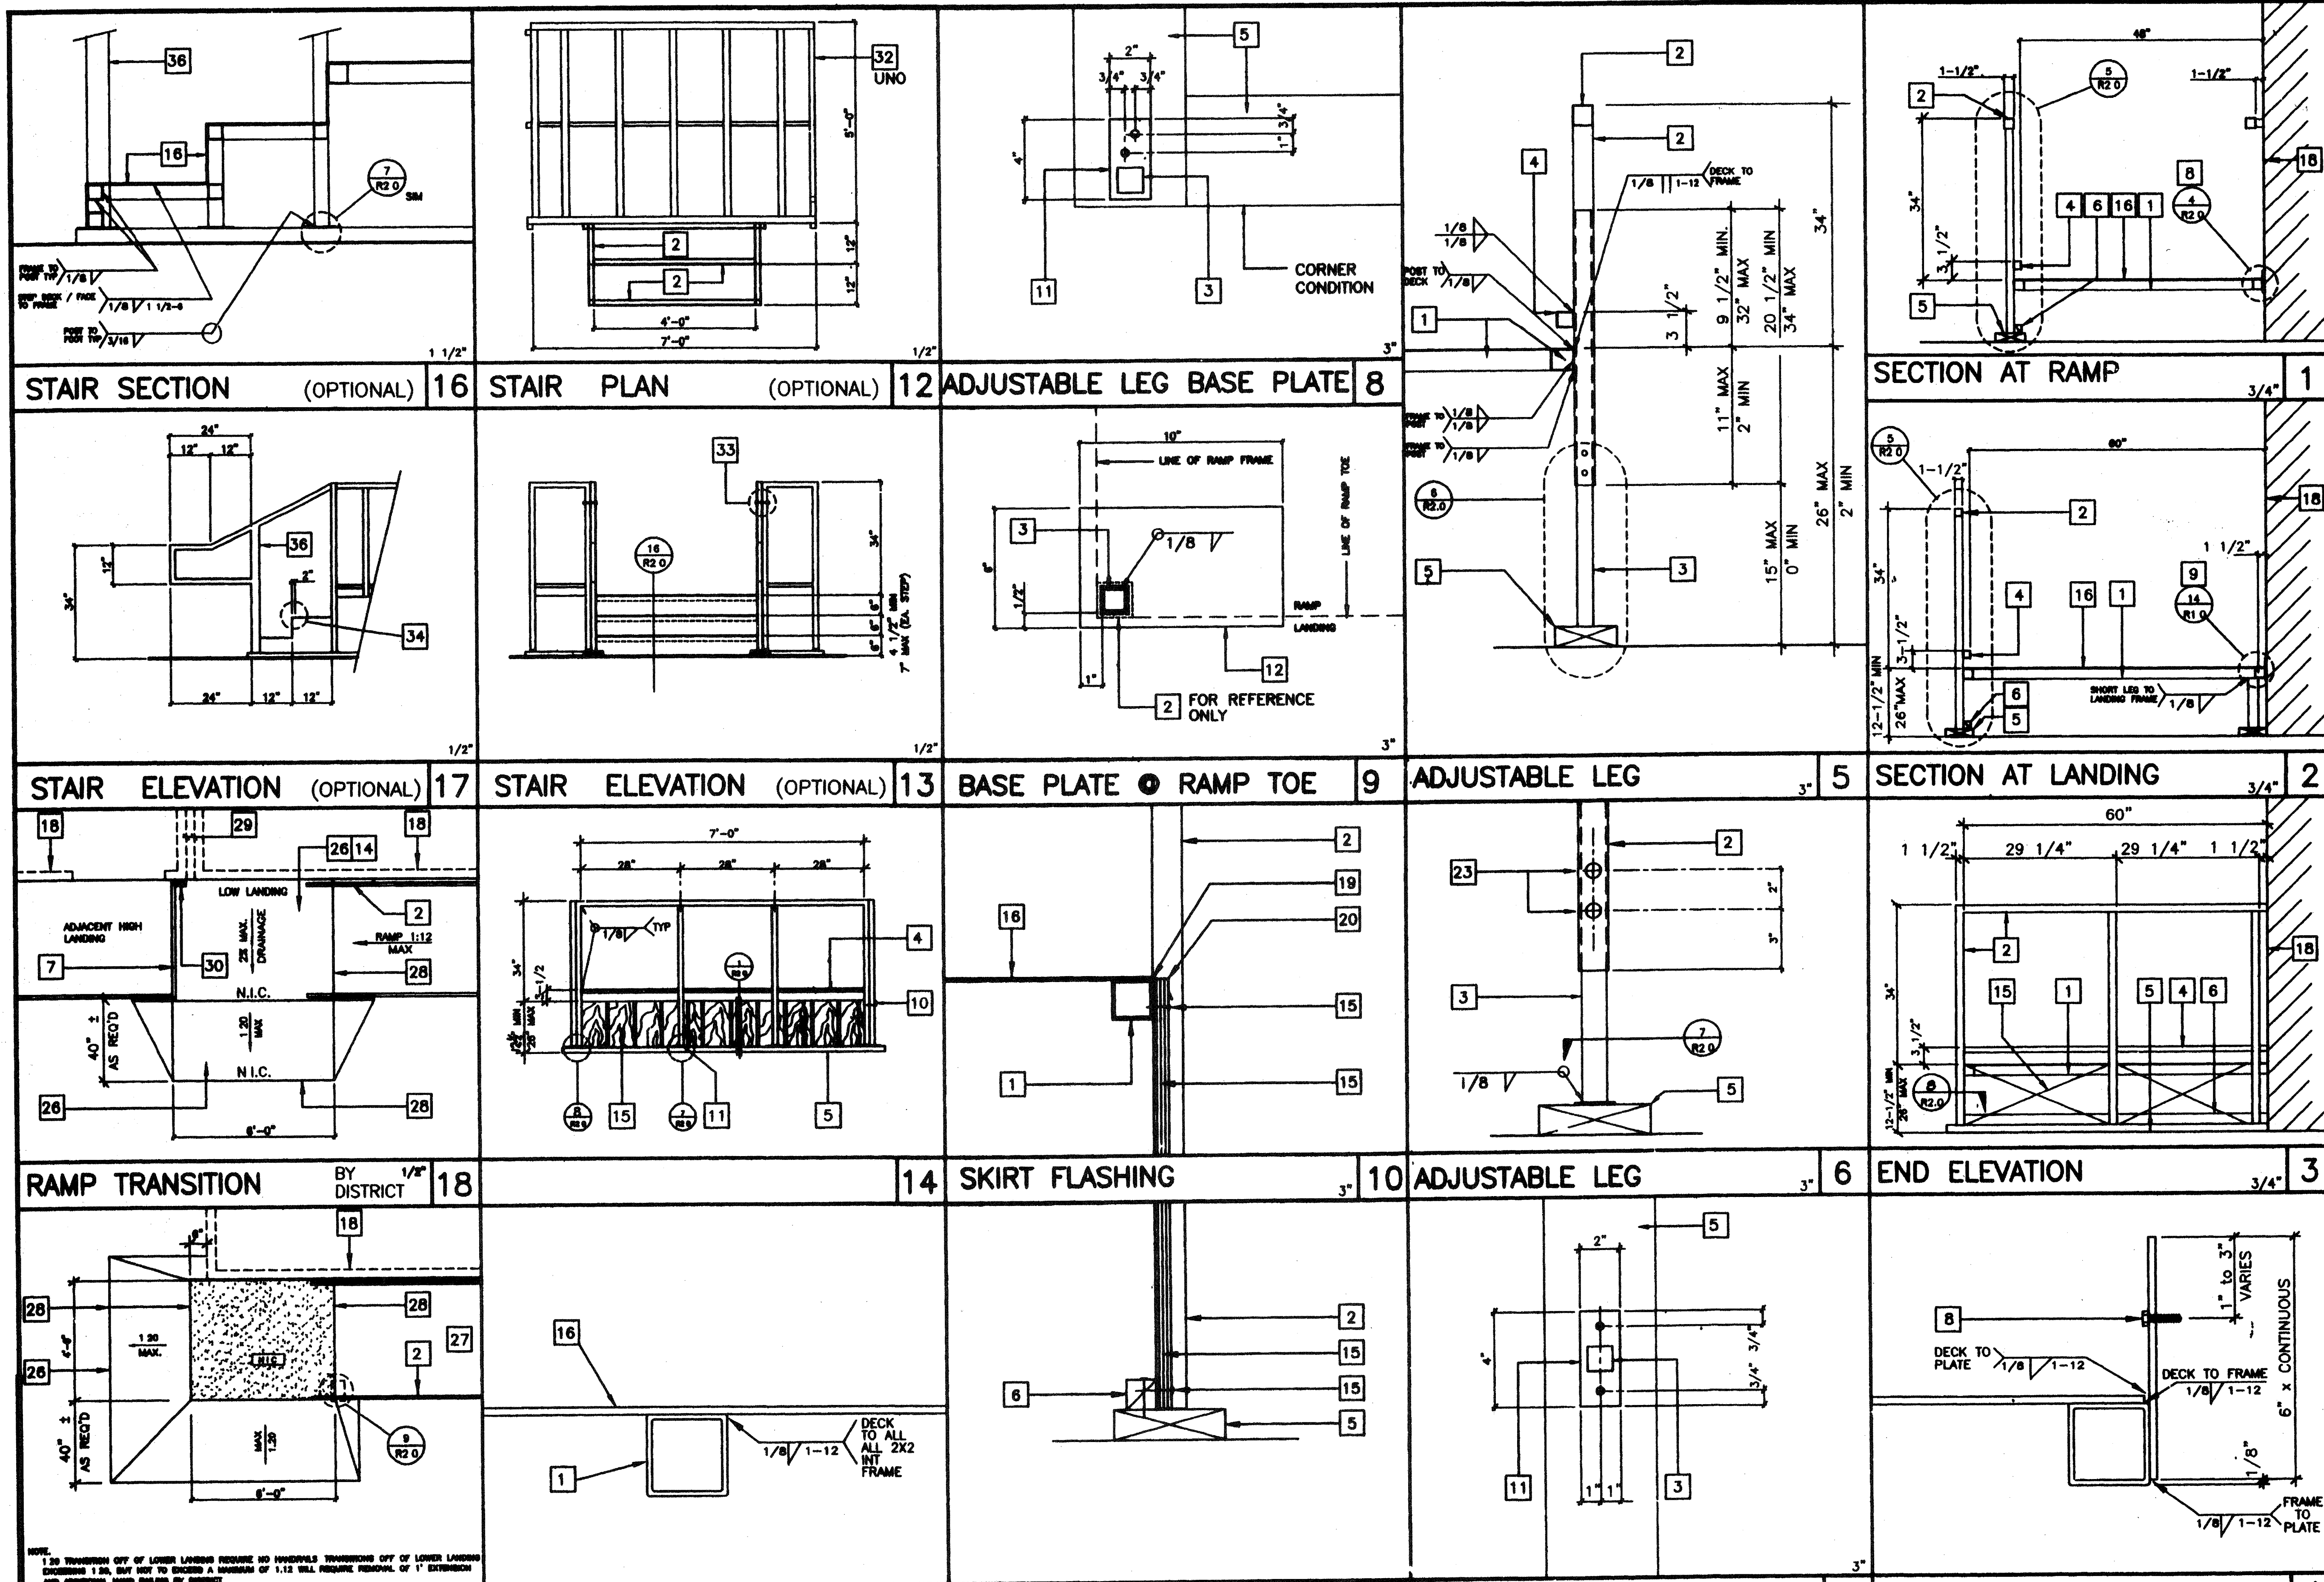

- ### KEY NOTES
- TS 2" x 2" x 14ga
 - TS 1 1/2" x 1 1/2" x 14ga (Fy = 36 KSI)
 - TS 1 1/4" x 1 1/4" x 14ga (Fy = 36 KSI)
 - TS 1" x 1" x 16ga WHEELCHAIR GUIDE
 - 2 x 6 FT SILL PLATE
 - 2 x 2 NAILER W/16d @ 12" OC
 - 2 x RW HEADER BY DISTRICT.
 - 6" x 10ga CONTINUOUS PLATE W/ #14 x 2" TEK SCREWS @ 9" OC INTO WOOD OR FOUNDATION BLOCKS OR #14 x 2" TEK SCREWS INTO METAL @ 9" OC
 - 2" x 4" x 12ga BASE PLATE W/2-1/4" x 1" LAGS
 - 6" x 10" x 12ga BASE PLATE @ RAMP TOE.
 - LOWER LANDING BY DISTRICT
 - SKIRTING: PLYWOOD TO MATCH BUILDING SIDING. BLOCK ALL EDGES. ATTACH W/6d @ 6" OC EDGES AND 12" OC FIELD. AT EDGE CONNECTION TO F.S. USE #14 x 2" TEK SCREWS @ 6" OC
 - 12ga METAL DECK: NON-SLIP SURFACE. DESIGN COEFFICIENT OF FRICTION GREATER THAN EX. MAINTAINABLE FOR 1 YR.
 - EXISTING BUILDING.
 - CAULKING
 - 26 ga FLASHING
 - 3/8" dia x 2" LONG MB W/NUT & WASHERS
 - PAVE BY DISTRICT.
 - RAMP BY MODTECH
 - FLUSH TRANSITION
 - 3" MINIMUM BUILDING SEPARATION
 - PROVIDE DRAINAGE FOR WATER FROM DOWNSPOUT FOR THIS CONDITION. BY DISTRICT
 - FOR LANDING DETAILS AND RAMP ATTACHMENT SEE 12/R1.0
 - FASTEN POSTS W/ 3/8" THRU BOLT. TYPICAL
 - 2" WARNING STRIPES MAX 1" FROM EVERY STAR NOSING. USE CONTRASTING COLOR.
 - TS 2 1/2" x 1 1/2" x 8ga ASTM A800 GRADE A

REVISIONS

1		
2		
3		
Professional seals and stamps:

- Electrical Engineer's Seal
- Mechanical Engineer's Seal
- Structural Engineer's Seal
- Architect's Seal
- IDENTIFICATION STAMP: DIV. OF THE STATE ARCHITECT OFFICE OF REGULATION SERVICES, PC 266, DATE JAN 31 1997, REVISED

MODTECH INC.
 2830 BARRETT AVENUE
 PERRIS, CALIF. 92572
 PH (909) 345-4014
 FAX (909) 940-0427

Job Number: PC 266 2986 © MODTECH, INC. 1997

drawn by: FM 11/96
 checked by: 4012-088
 date: 05 JAN 97
 Modtech Project no. 2986
 MODTECH Inset No. **R2.0**

RAMP/STAIR DETAILS

IDENTIFICATION STAMP
 DIV. OF THE STATE ARCHITECT
 APP#3 117168
 AC PLS / SS TH
 Date 10/5 0 4 2016

IDENTIFICATION STAMP
 DIV. OF THE STATE ARCHITECT
 OFFICE OF REGULATION SERVICES
 AC PLS / SS TH
 Date JAN 07 1997

2506, 2377, 3023, 3183