

JOB #3278

RELOCATABLE BUILDING(S)

FOR
CLASS LEASING
STOCKPILE #43

22- 24x40 CLASSROOMS

02- SERIAL # 41422-41425 DUAL SLOPE JOB # 3253
W/ SINK CABINET OPTION

10- SERIAL # 41892-41911 JOB # 3278

10- SERIAL # 41912-41931 JOB # 3278

22 BLDGS ASSIGNED

PC-275
24' x 40'
~~36' x 40'~~
~~48' x 40'~~

REVISED

BUILDING DATA			
BUILDING SIZE	24' X 40'	36' X 40'	48' X 40'
OCCUPANCY	E - 2	E - 1	E - 1
TYPE OF CONSTRUCTION	V - N	V -	V -
WIND LOAD	70 MPH EXP. "C"	70 MPH EXP. "C"	70 MPH EXP. "C"
FLOOR LIVE LOAD	50/50 PSF	50/50 PSF	50/50 PSF
ROOF LIVE LOAD	20 PSF	20 PSF	20 PSF
BUILDING AREA	960 SF	1440 SF	1920 SF
STRUCTURAL DESIGN	RIGID FRAME	RIGID FRAME	RIGID FRAME

APPLICABLE CODES	
TITLE 24	CCR PART 2 1995 CBC (94 UBC W/95 CA AMENDMENTS)
1994 UBC & 1995 CA AMENDMENTS	(95 CBC - PART 2, TITLE 24, CCR)
1993 NEC & 1995 CA AMENDMENTS	(95 NEC - PART 3, TITLE 24, CCR)
1994 UMC & 1995 CA AMENDMENTS	(95 UMC - PART 4, TITLE 24, CCR)
1994 UPC & 1995 CA AMENDMENTS	(95 UPC - PART 5 TITLE 24, CCR)
1994 UNIFORM FIRE CODE W/ STATE AMENDMENTS	(CALIFORNIA FIRE CODE - PART 9, TITLE 24, CCR)
1994 BUILDING STANDARDS CODE	(95 STATE REFERENCED STANDARDS CODE - PART 12, TITLE 24, CCR)
TITLE 19, CCR, PUBLIC SAFETY, STATE FIRE MARSHAL REGULATIONS	

SYMBOLS	
SYMBOL	DESCRIPTION
	DETAIL ON SAME SHEET AS SYMBOL
	DETAIL NUMBER (1) ON SHEET NUMBER (2)
	KEY NOTE (1) ON SAME SHEET AS SYMBOL
	KEY NOTE NUMBER (4) ON SHEET NUMBER (5)
	WALL PANEL TYPE "A" ON SHEET (1)
	SECTION "A" ON SHEET (2)
	REVISION / CHANGE IN DRAWING NO (1) IS FIRST REVISION
	HIGHLIGHTS CHANGED AREA
	DOOR REFERENCE
	WINDOW REFERENCE
	ELECTRICAL ITEM(S) SEE ELECT DRAWINGS
	HEATING/VENTILATING & AIR CONDITIONING ITEM(S) SEE MECHANICAL DRAWINGS
	PLUMBING ITEM(S) SEE MECHANICAL DRAWINGS
	STRUCTURAL ITEM(S) SEE STRUCTURAL DRAWINGS

AGENCY TRACKING NO. 63321-201
FILE NO. 15-6

IDENTIFICATION STAMP
DIV. OF THE STATE ARCHITECT
OFFICE OF REGULATION SERVICES
03-117283
AC/11-FLS 087 SS PCL
DATE SEP 13 2016

WITH THE SIGNING OF THESE DRAWINGS, WE ACKNOWLEDGE THAT WE HAVE REVIEWED THESE PLANS AND SPECIFICATIONS AND HAVE FOUND THEM TO BE IN GENERAL COMPLIANCE WITH THE BID DRAWINGS, SPECIFICATIONS AND ASSOCIATED ADDENDA. WHEN THESE PLANS AND SPECIFICATIONS HAVE BEEN APPROVED BY THE DIVISION OF THE STATE ARCHITECT THEY SHALL PRESIDE OVER CONFLICTING AREAS IN THE BID DRAWINGS AND SPECIFICATIONS, AND ANY ADDENDA THERETO.

CONFIDENTIAL - This document and the information contained herein are the property of MODTECH, INC. unauthorized copying, disclosure or other unauthorized uses are prohibited.

SHEET INDEX	
ARCHITECTURAL	
A0	COVER SHEET
A1.0	FLOOR PLAN (24'X40')
A2.0	ROOF PLAN (24'X40') MONO PITCH
A2.0A	ROOF PLAN (24'X40') DUAL PITCH
A3.0	EXTERIOR ELEVATIONS (24'X40') MONO PITCH
A3.0A	EXTERIOR ELEVATIONS (24'X40') DUAL PITCH
A4.0	INTERIOR ELEVATIONS (24'X40')
A5.0	DOOR, WINDOW, FINISH, HARDWARE SCHEDULES
A6.0	ARCHITECTURAL DETAILS (WOOD STUDS)
A6.1	ARCHITECTURAL DETAILS (WOOD STUDS)
A7.0	REFLECTED CEILING PLAN (24'X40')
A7.2	REFLECTED CEILING PLAN DETAILS

STRUCTURAL	
F0.1	FOUNDATION PLAN (24' x 40') 50 PSF LL (WOOD)
F3.0	FOUNDATION DETAILS (WOOD)
S1.0	FLOOR FRAMING PLAN 50 PSF LL
S1.2	FLOOR FRAMING DETAILS
S2.0	ROOF FRAMING PLAN (MONO PITCH)
S2.0A	ROOF FRAMING PLAN (DUAL PITCH)
S2.1	ROOF FRAMING DETAILS
S3.0	STRUCTURAL ELEVATIONS & DETAILS (MONO PITCH)
S3.0A	STRUCTURAL ELEVATIONS & DETAILS (DUAL PITCH)
S4.0	WALL FRAMING (WOOD)
S5.0	FRAMING DETAILS (WOOD)
S5.1	FRAMING DETAILS (WOOD)

MECHANICAL	
M1.0	HVAC PLAN (24'X40')

ELECTRICAL	
E1.0	ELECTRICAL PLAN (24'X40')

RAMP	
R1.0	RAMP / LANDING PLAN
R2.0	RAMP / STAIRS DETAILS

REVISIONS	Electrical Engineer's Seal	Mechanical Engineer's Seal	Structural Engineer's Seal	Architect's Seal	Division of the State Architect	MODTECH INC.	PROJECT NUMBER: 3278	MODTECH, INC. 1998	DRAWN BY: DD DATE: 09-21-98


Electrical Engineer's Seal

Mechanical Engineer's Seal

Structural Engineer's Seal

Architect's Seal

Division of the State Architect
IDENTIFICATION STAMP
DIV. OF THE STATE ARCHITECT
OFFICE OF REGULATION SERVICES
APPL PC-275
DATE 9/13/16

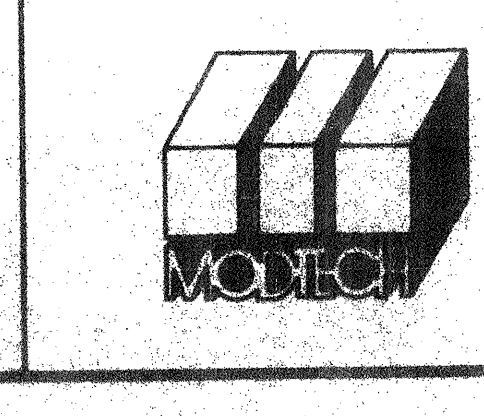

MODTECH INC.
2830 BARRETT AVENUE
PERRIS, CALIF. 92572
PH (909) 943-4014
FAX (909) 940-0427

PROJECT NUMBER: 3278

MODTECH, INC. 1998

CHECKED BY: STKP 43
DATE: 09-21-98
MODTECH PROJECT NO: 3253, 3278
MODTECH Logo No. A0.0
09/09/99

FILE PATH: 275-AC-0.DWG PROJECT NO. 3253, 3278 PC-275