

Transmittal Letter

Project: Roosevelt ES Modernization

Contractor: Fonder- Salari Inc.

We are sending you

x	Attached	☐ Under Separate Cover via: [Type text here] the following:		
☐	Shop Drawings	☐ Prints	☐ Plans	☐ Submittal
☐	Copy of Letter	☐ Change Order	☐ Samples	☐ Closeout
☐	Total Quantity	☐ Reproducible	☐ Specification	☒ As Built

Submittal	Date	Description
Section 09	12/02/2025	As Built Drawing

These are transmitted as checked below


For Approval	Approved as Submitted	Resubmit copies for approval
For Your Use	Approved as Noted	Submit [#] copies for distribution
As Requested	Returned for Corrections	Return [#] corrected prints
For Review and Comment	Revise and Resubmit/Work May Not Proceed	
FOR BIDS DUE: [Type text here]	PRINTS RETURNED AFTER LOAN	

Comments:

Please confirm received to: rhithika@michaelsurfacesolutions.com

Note:

	Rhithika Sreenivas, Bid Coordination Engineer
--	--

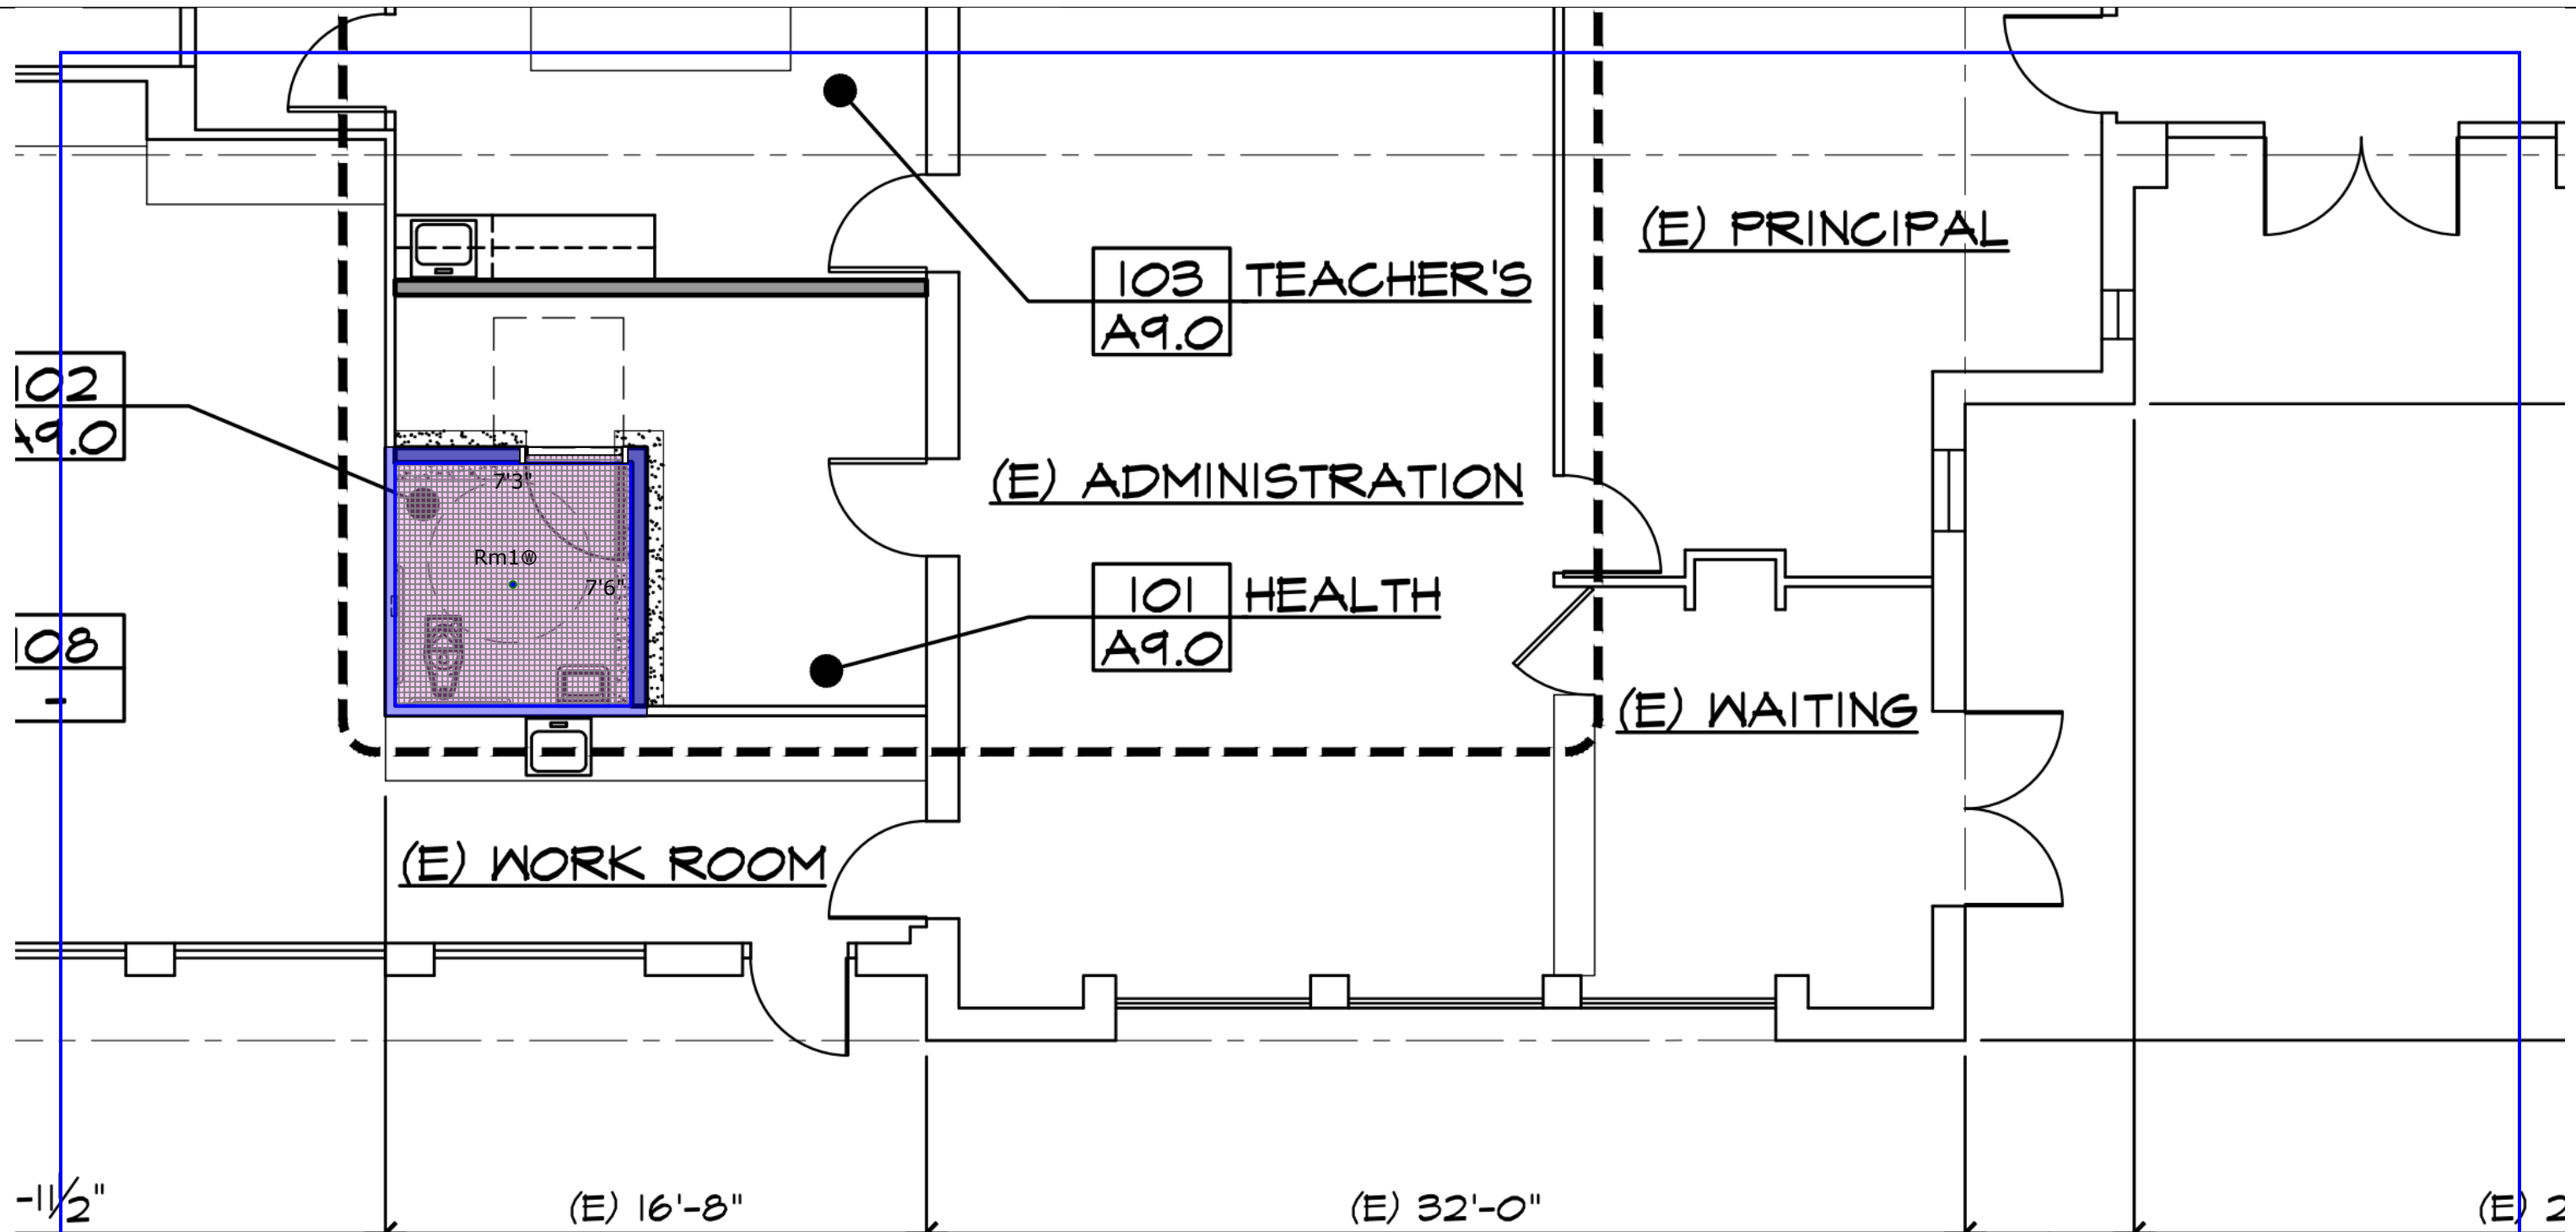

- FLOOR TILE - KEYSTONE 2"X2" - COLOR: URBAN PUTTY SPECKLE, GROUT - NEW TAUPE 185
- TILE BASE - COLOR WHEEL CLASSIC 4.25"X4.25', COLOR: ALMOND 0135, GROUT - SNOW WHITE 11
- WALL TILE - COLOR WHEEL CLASSIC 4.25"X4.25", COLOR : ALMOND 0135, GROUT - SNOW WHITE 11






BUILDING 'A'


Rm1

FLOOR TILE - KEYSTONE 2"X2" - COLOR: URBAN PUTTY SPECKLE, GROUT - NEW TAUPE 185


TILE BASE - COLOR WHEEL CLASSIC 4.25"X4.25', COLOR: ALMOND 0135, GROUT - SNOW WHITE 11

WALL TILE - COLOR WHEEL CLASSIC 4.25"X4.25", COLOR : ALMOND 0135, GROUT - SNOW WHITE 11

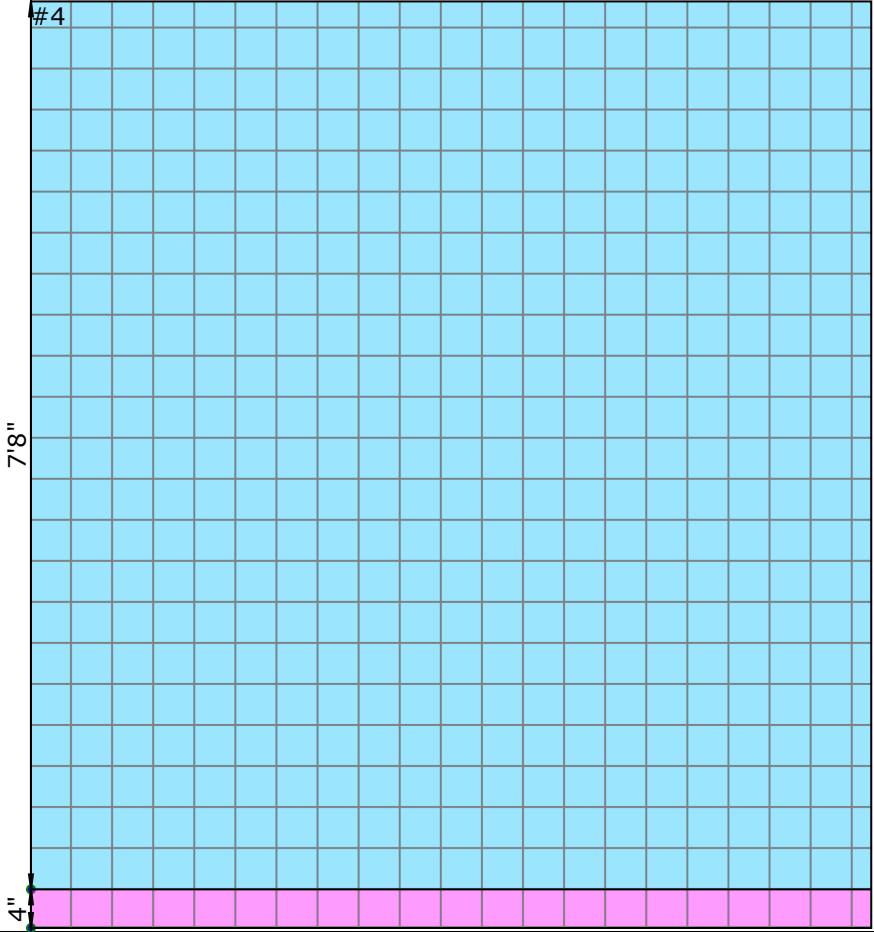
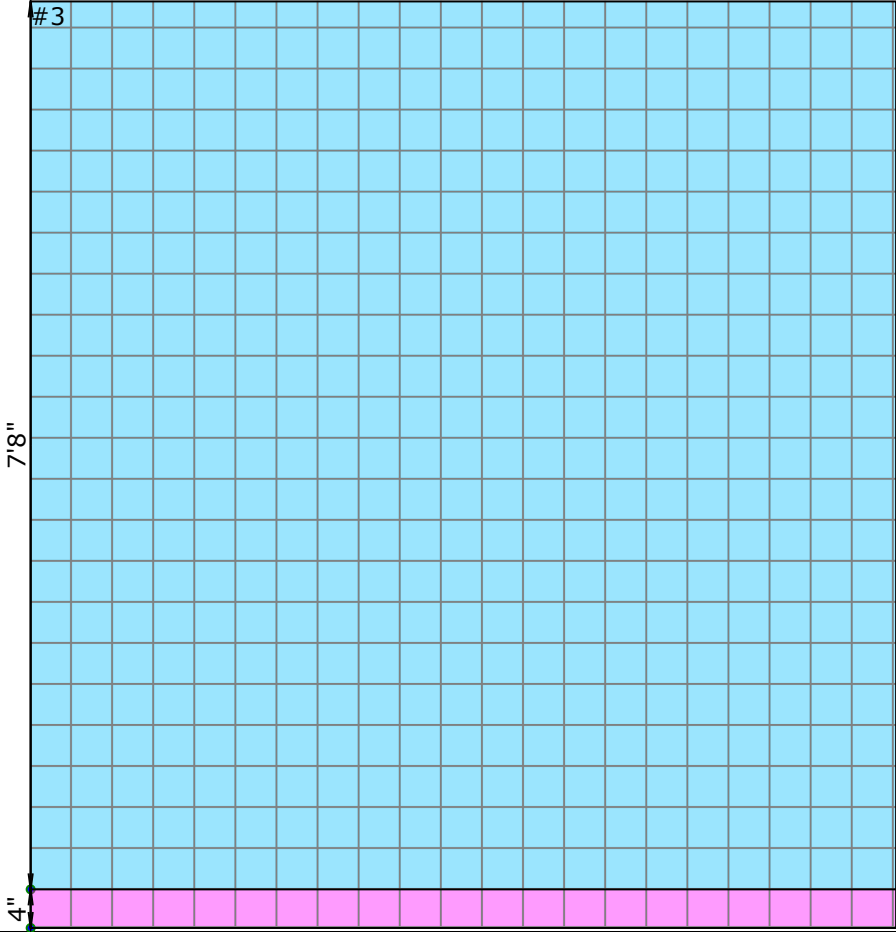
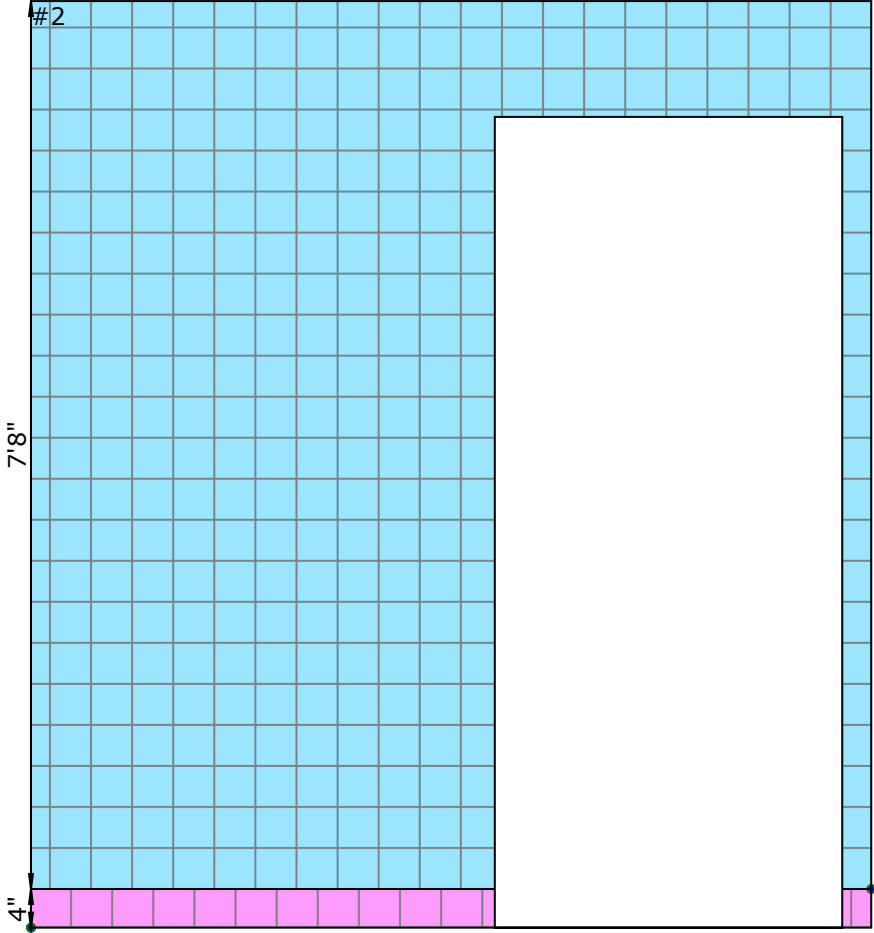
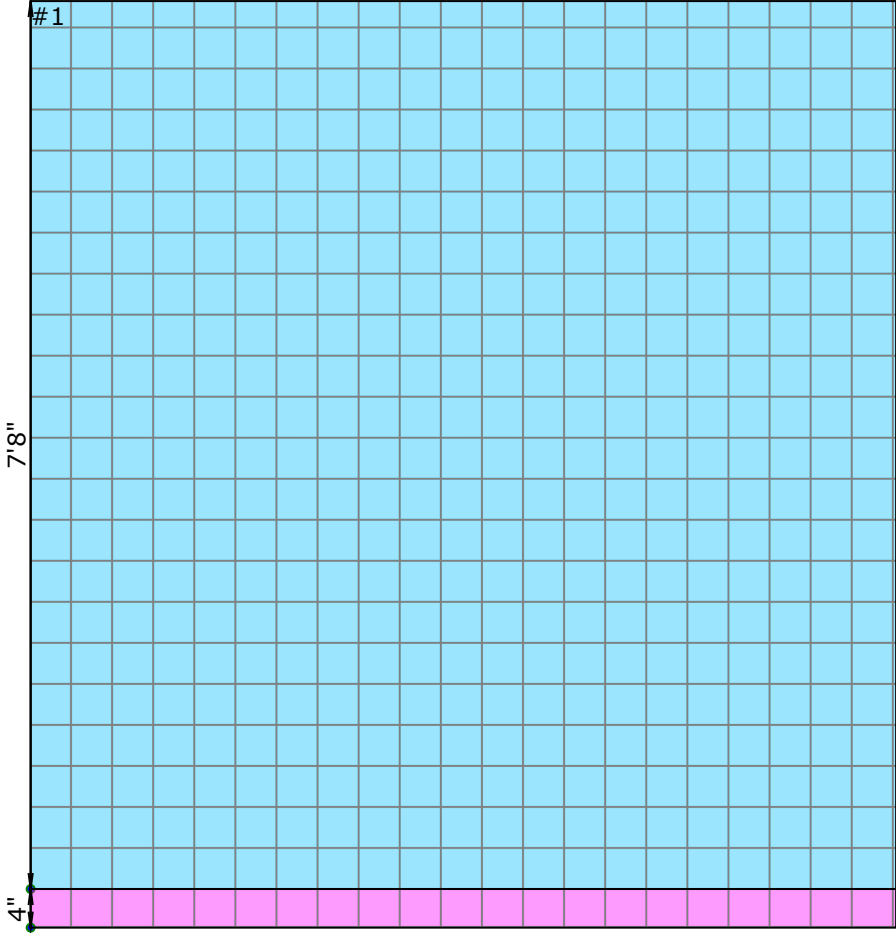
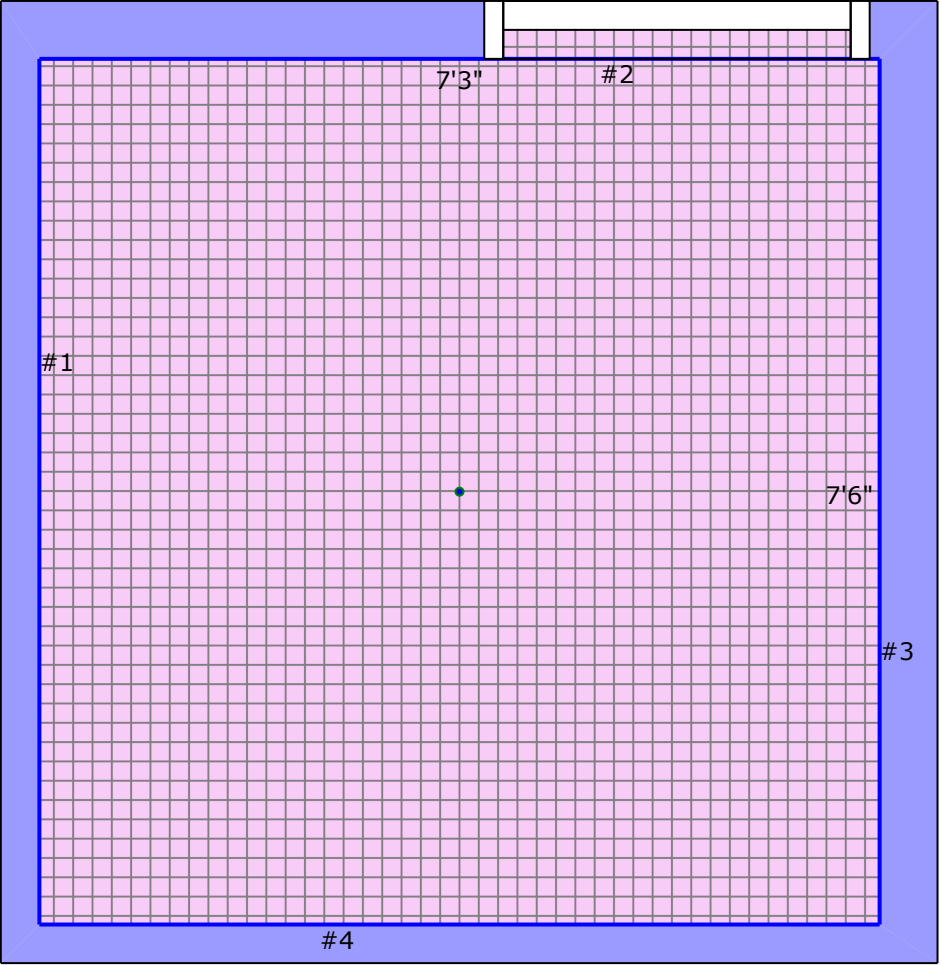


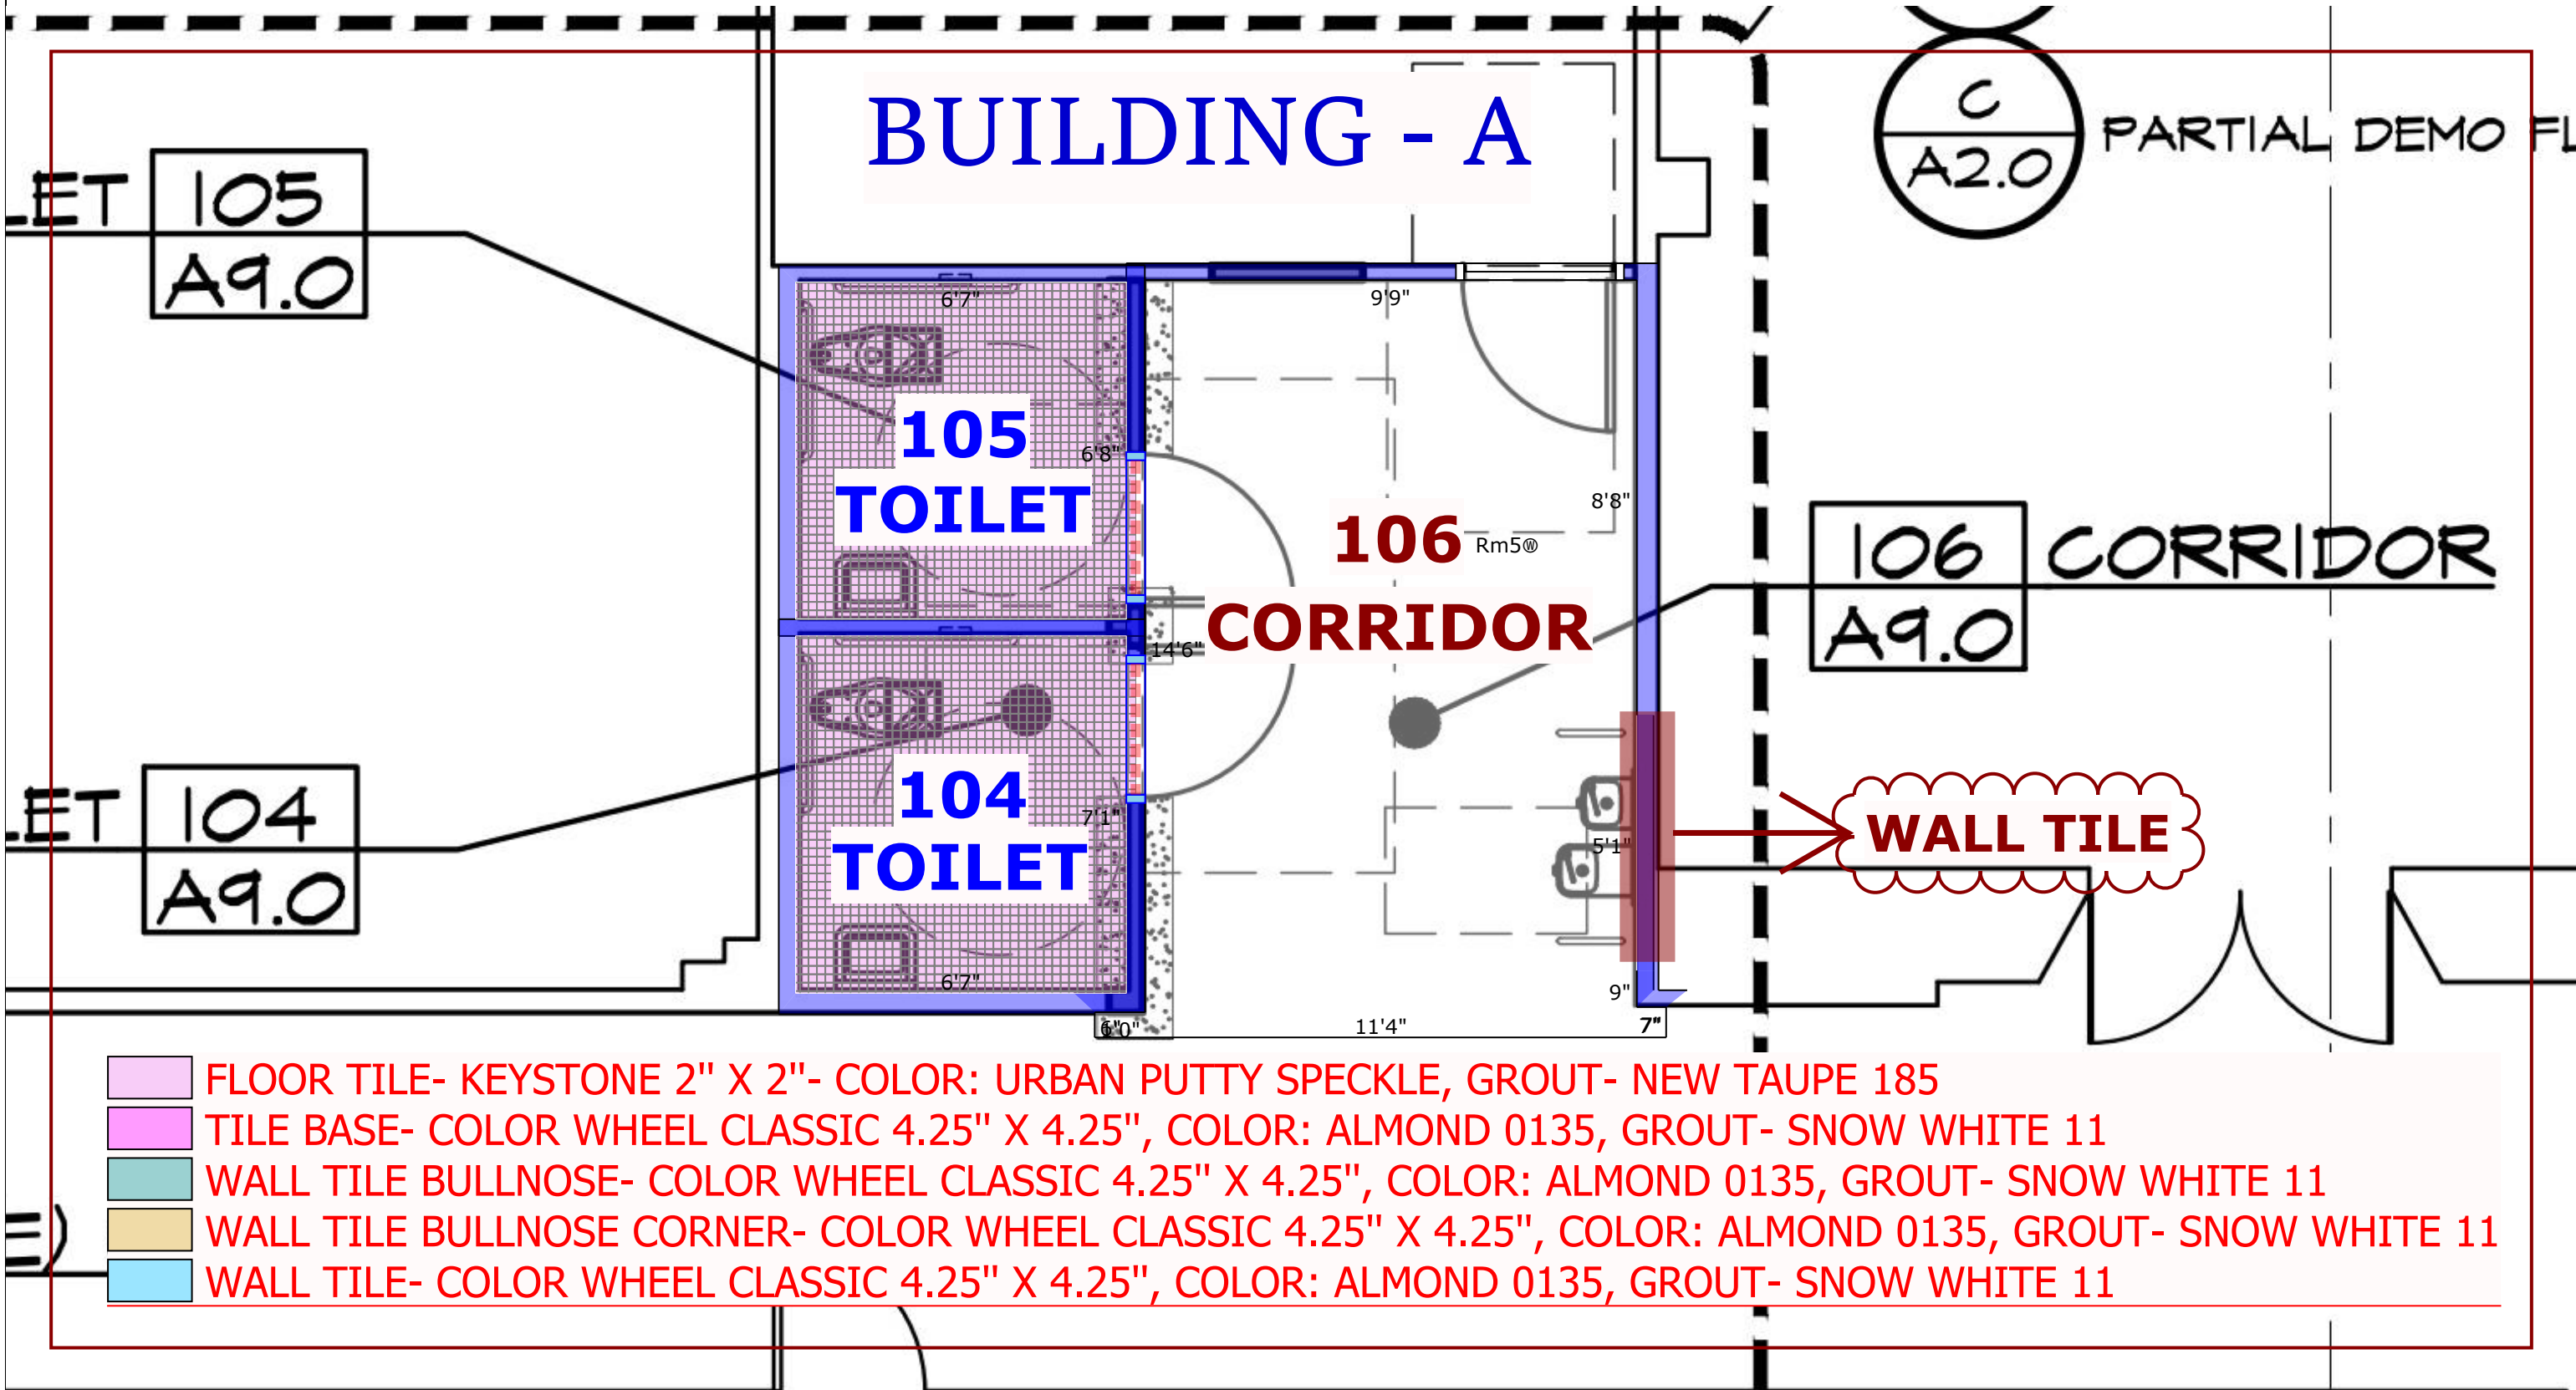






- WALL TILE BULLNOSE- COLOR WHEEL CLASSIC 4.25" X 4.25", COLOR: ALMOND 0135, GROUT- SNOW WHITE 11
- WALL TILE BULLNOSE CORNER- COLOR WHEEL CLASSIC 4.25" X 4.25", COLOR: ALMOND 0135, GROUT- SNOW WHITE 11
- WALL TILE- COLOR WHEEL CLASSIC 4.25" X 4.25", COLOR: ALMOND 0135, GROUT- SNOW WHITE 11

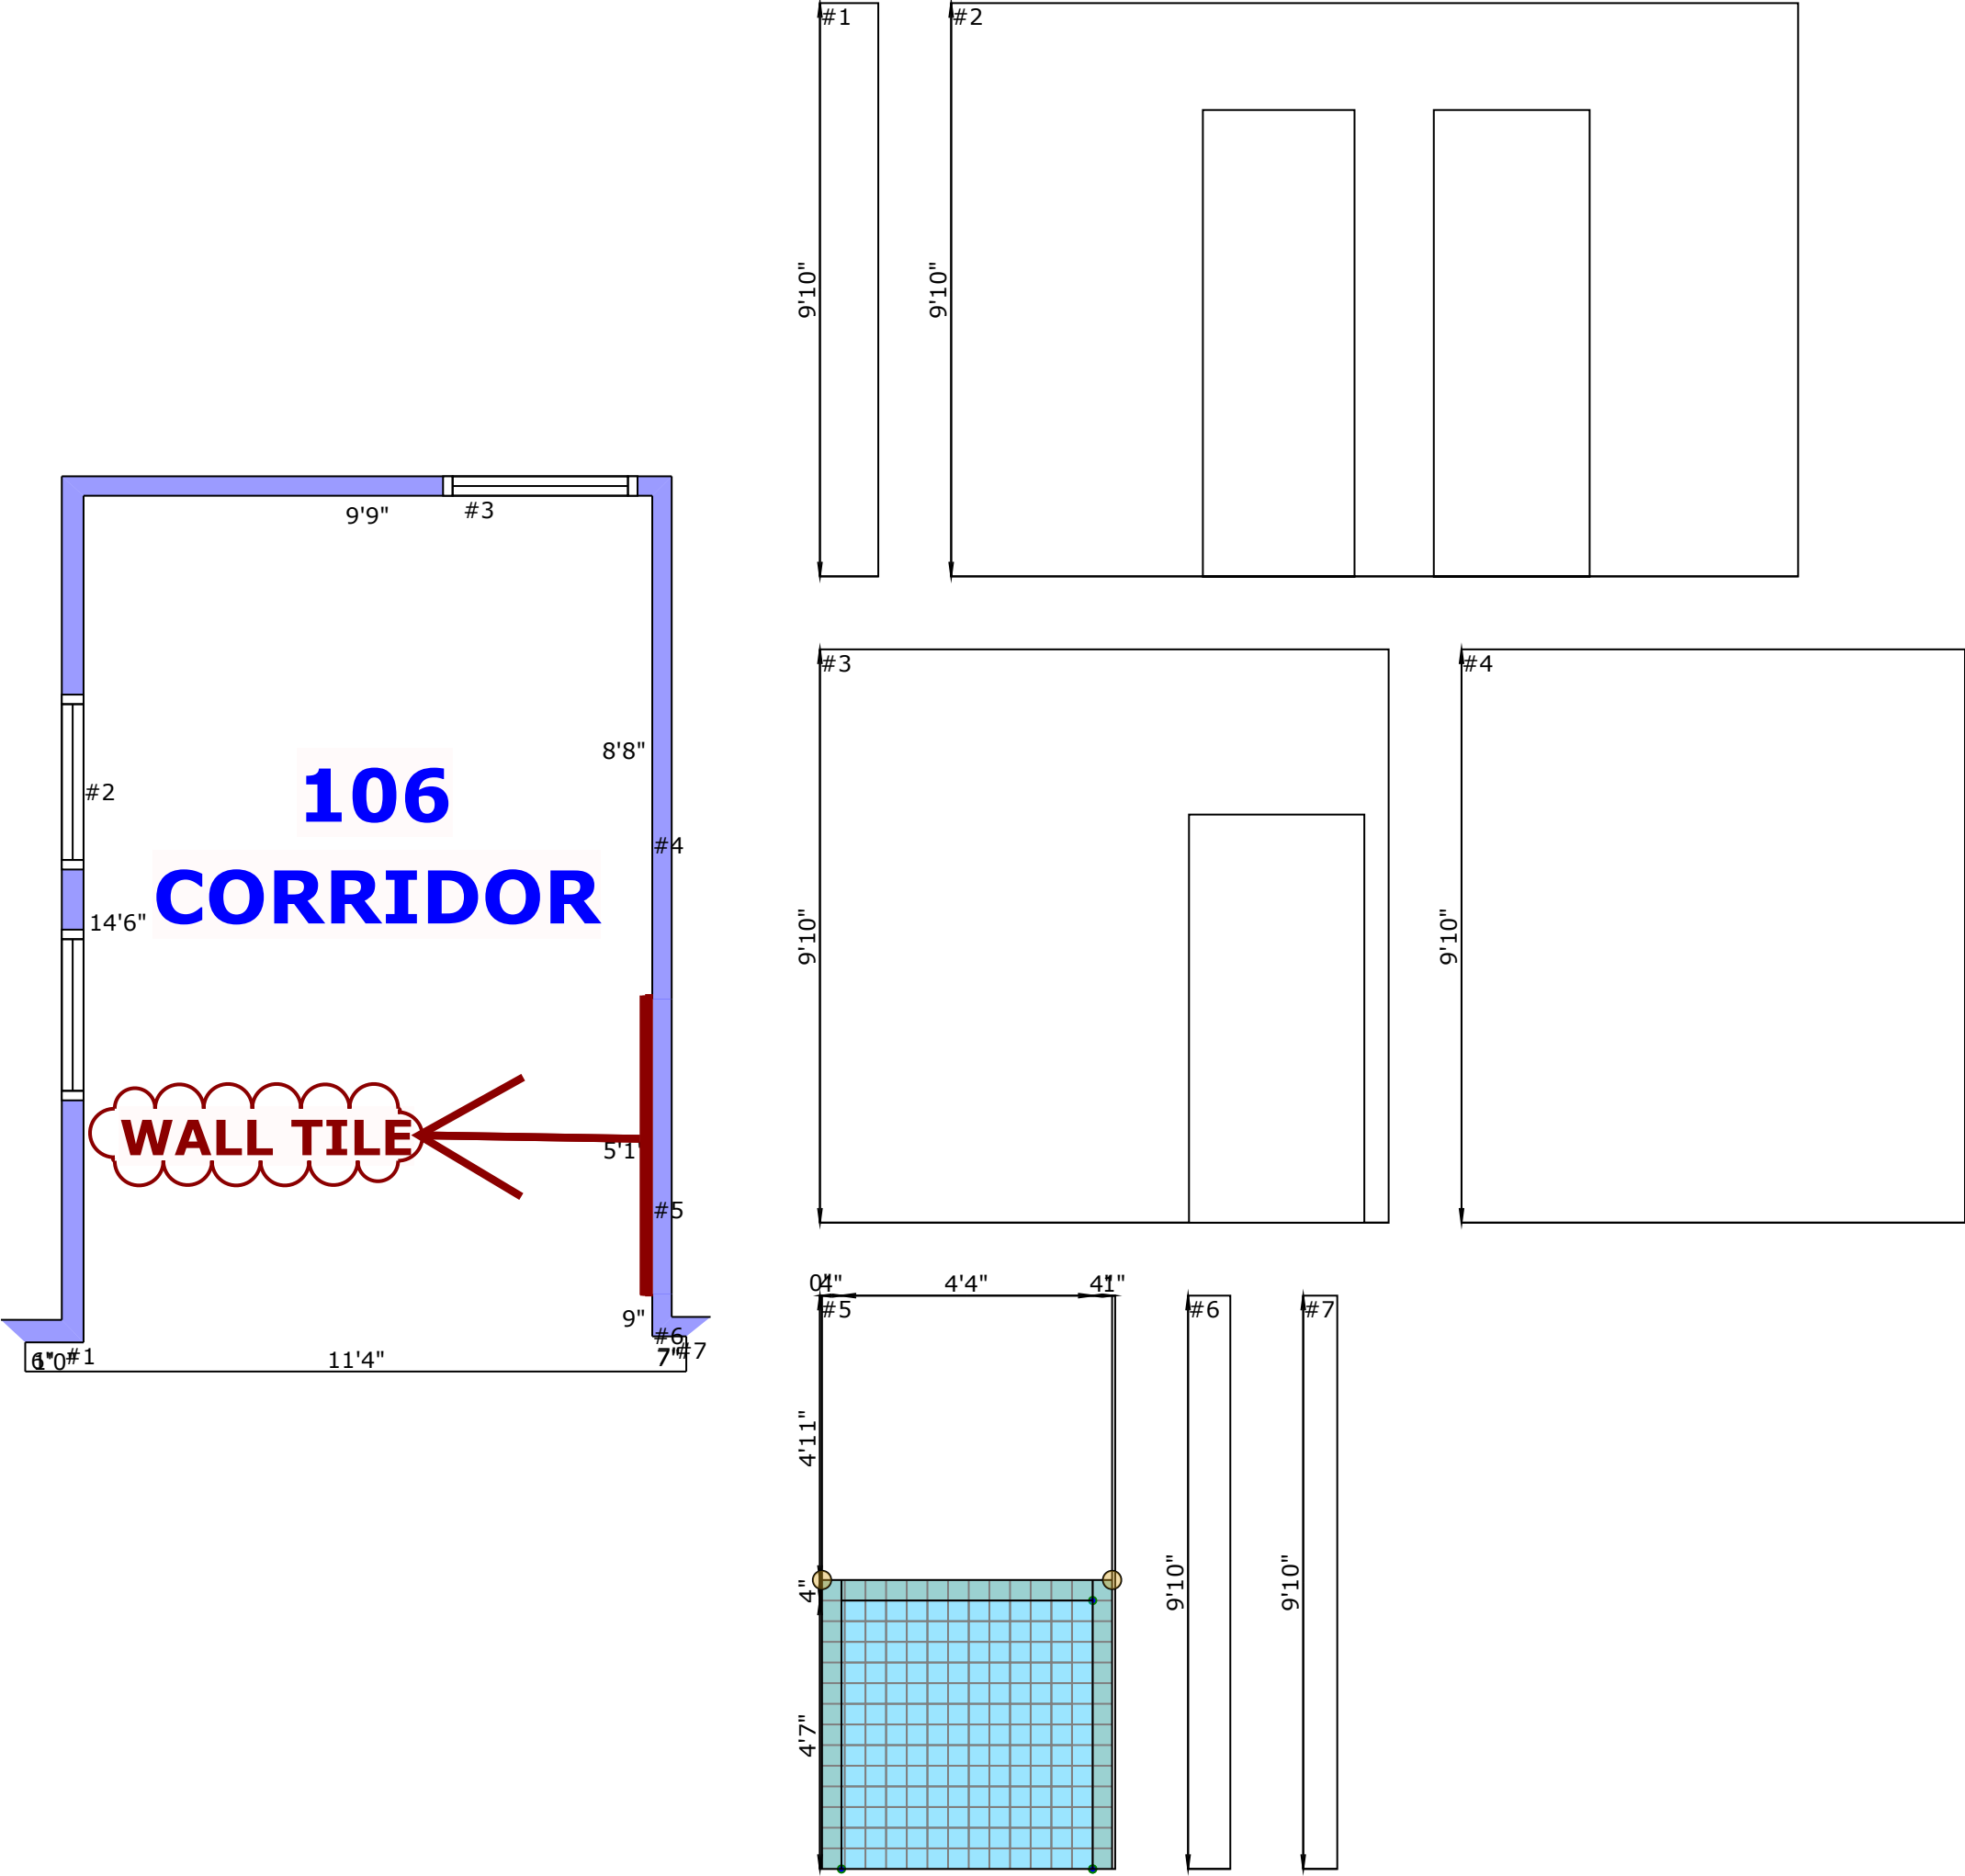


- Rm3
- FLOOR TILE- KEYSTONE 2" X 2"- COLOR: URBAN PUTTY SPECKLE, GROUT- NEW TAUPE 185
- TILE BASE- COLOR WHEEL CLASSIC 4.25" X 4.25", COLOR: ALMOND 0135, GROUT- SNOW WHITE 11
- TRANSITION: CERAMIC TILE TO SHEET VINYL
- WALL TILE- COLOR WHEEL CLASSIC 4.25" X 4.25", COLOR: ALMOND 0135, GROUT- SNOW WHITE 11

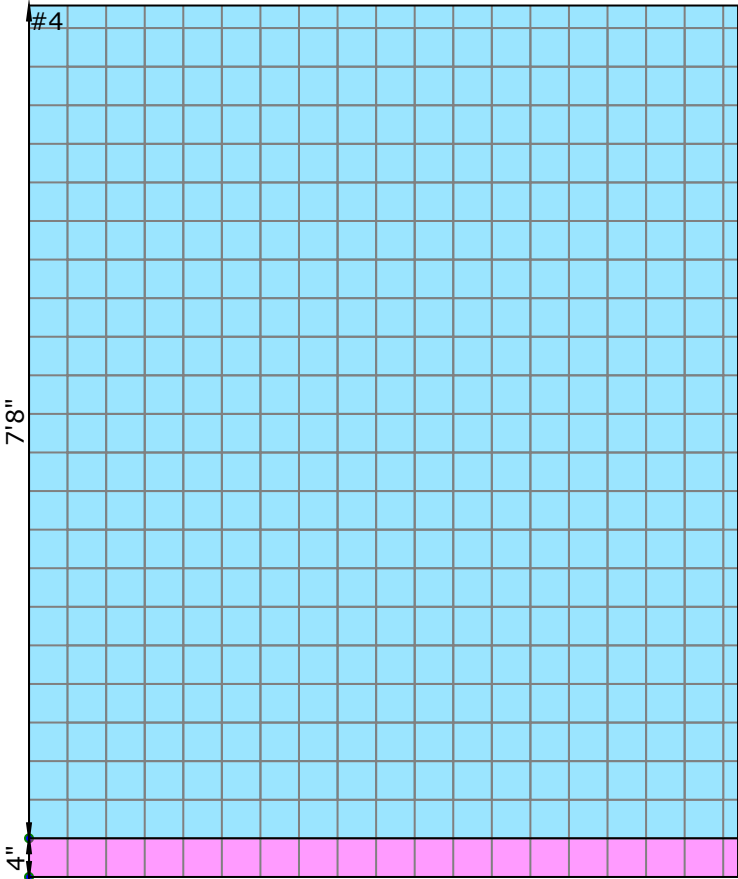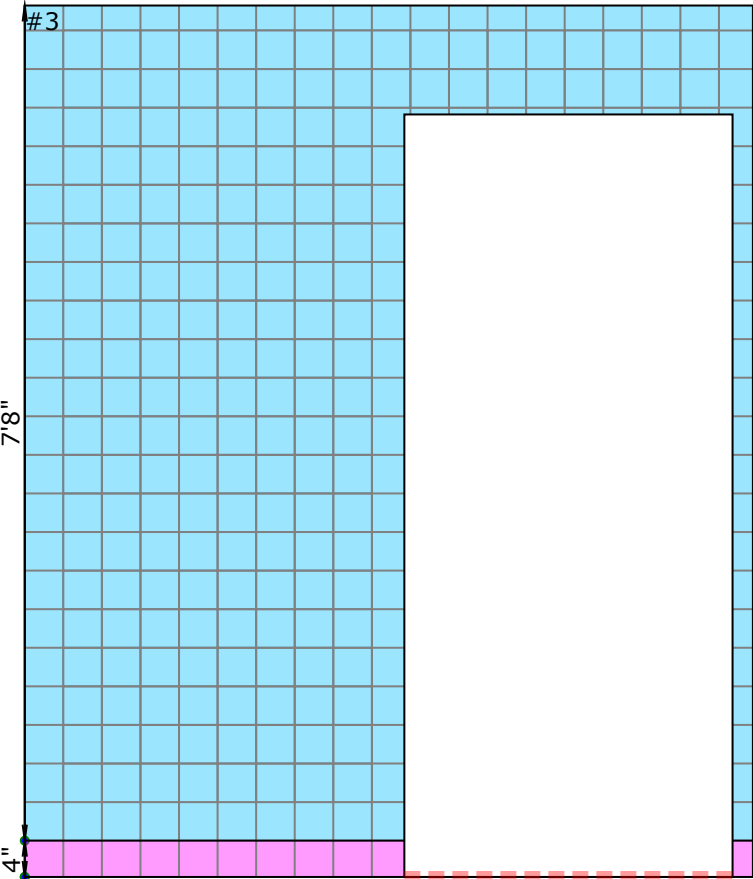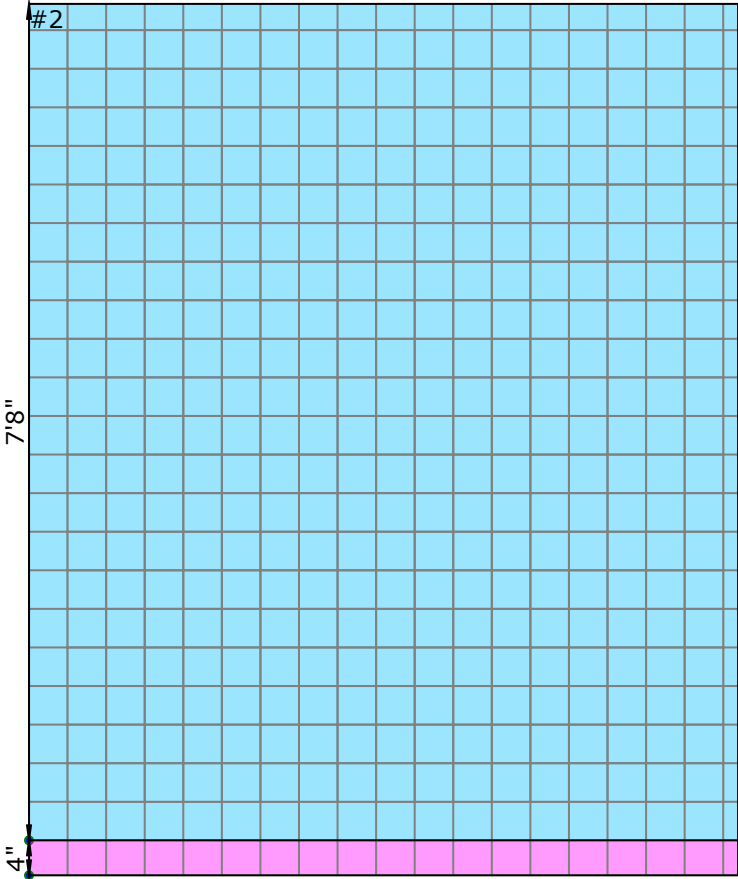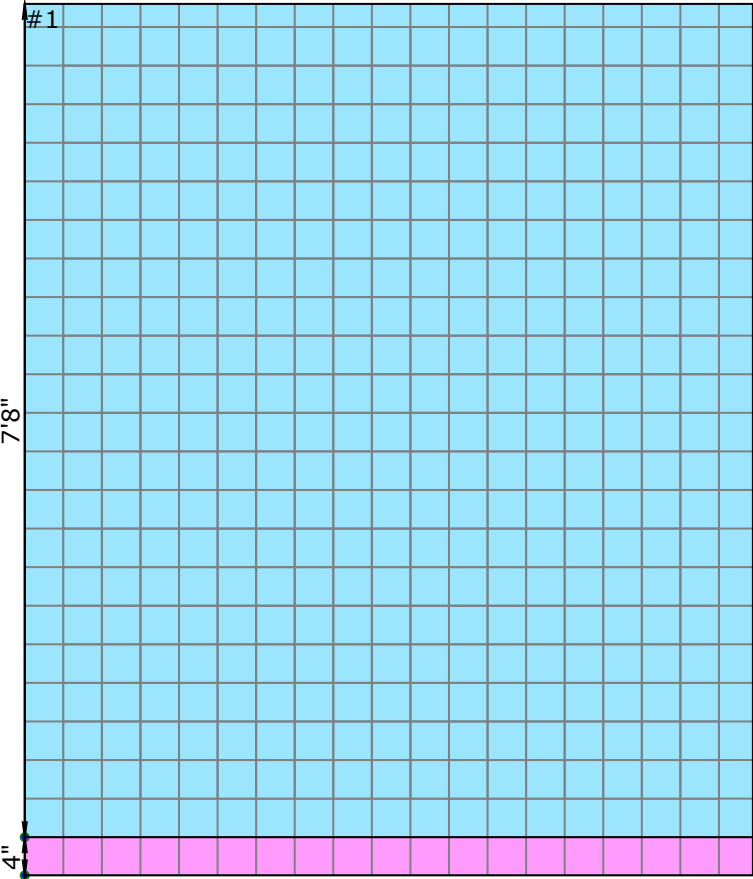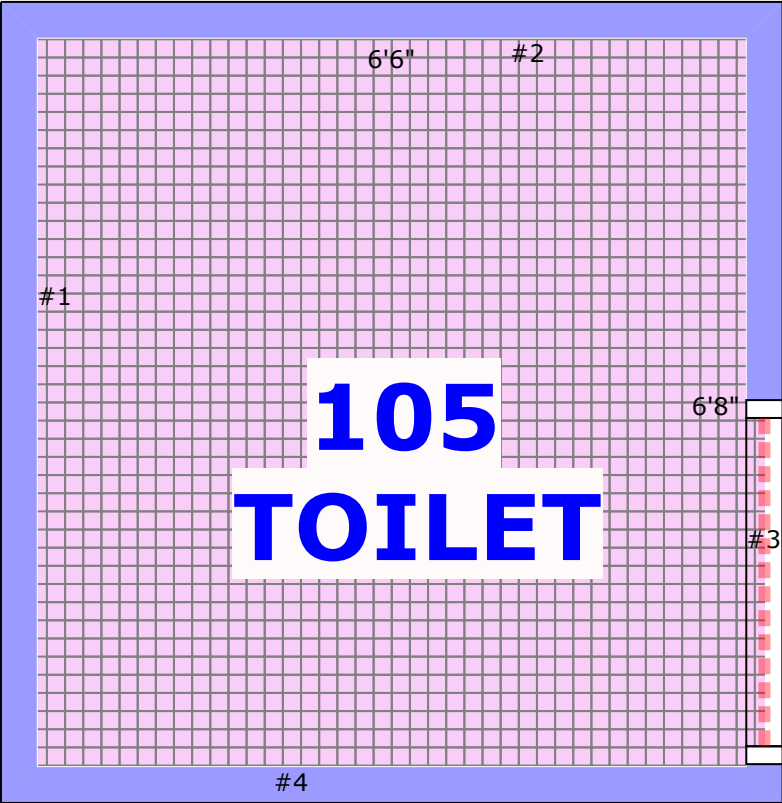


- Rm4
- FLOOR TILE- KEYSTONE 2" X 2"- COLOR: URBAN PUTTY SPECKLE, GROUT- NEW TAUPE 185
- TILE BASE- COLOR WHEEL CLASSIC 4.25" X 4.25", COLOR: ALMOND 0135, GROUT- SNOW WHITE 11
- TRANSITION: CERAMIC TILE TO SHEET VINYL
- WALL TILE- COLOR WHEEL CLASSIC 4.25" X 4.25", COLOR: ALMOND 0135, GROUT- SNOW WHITE 11

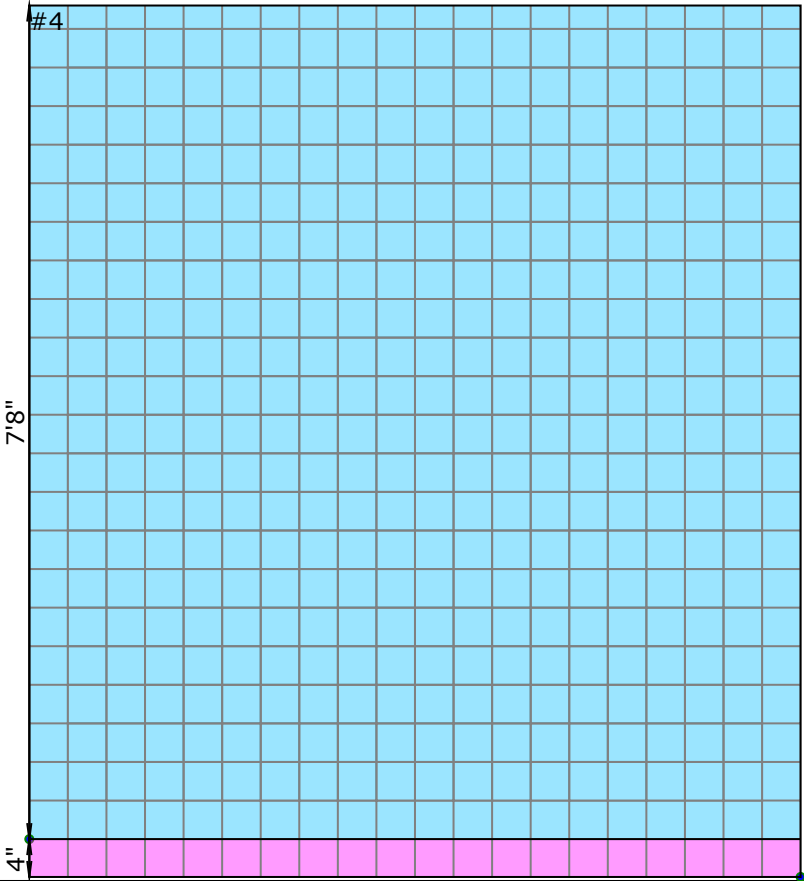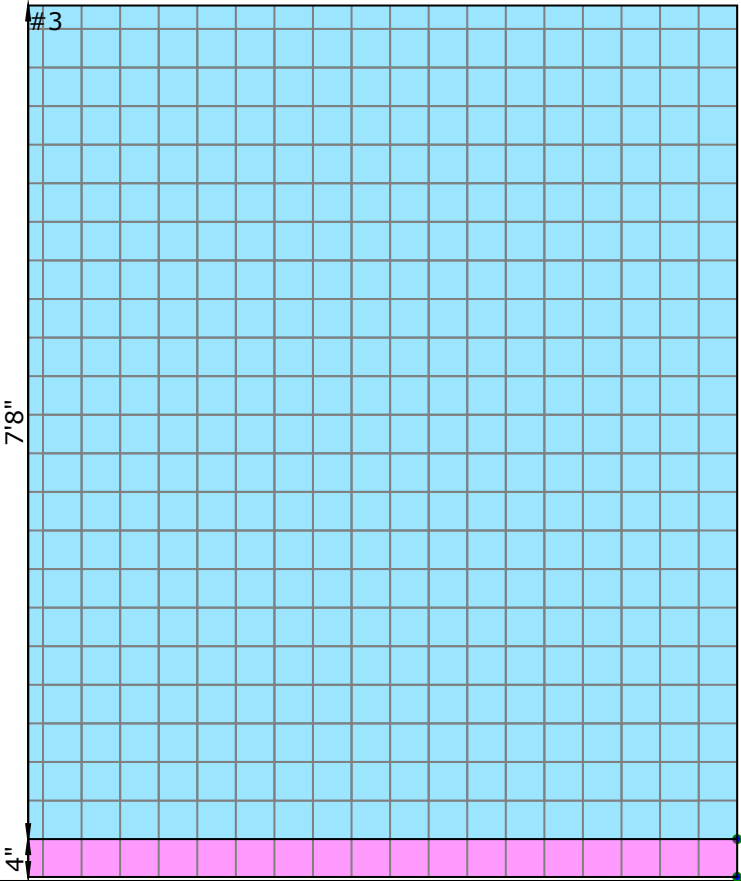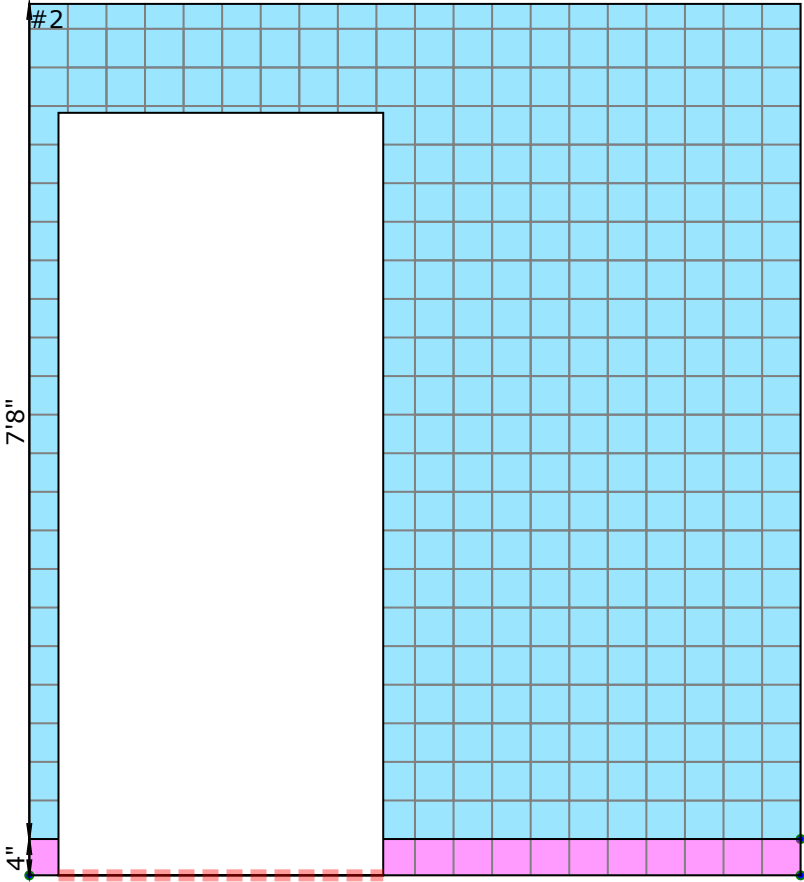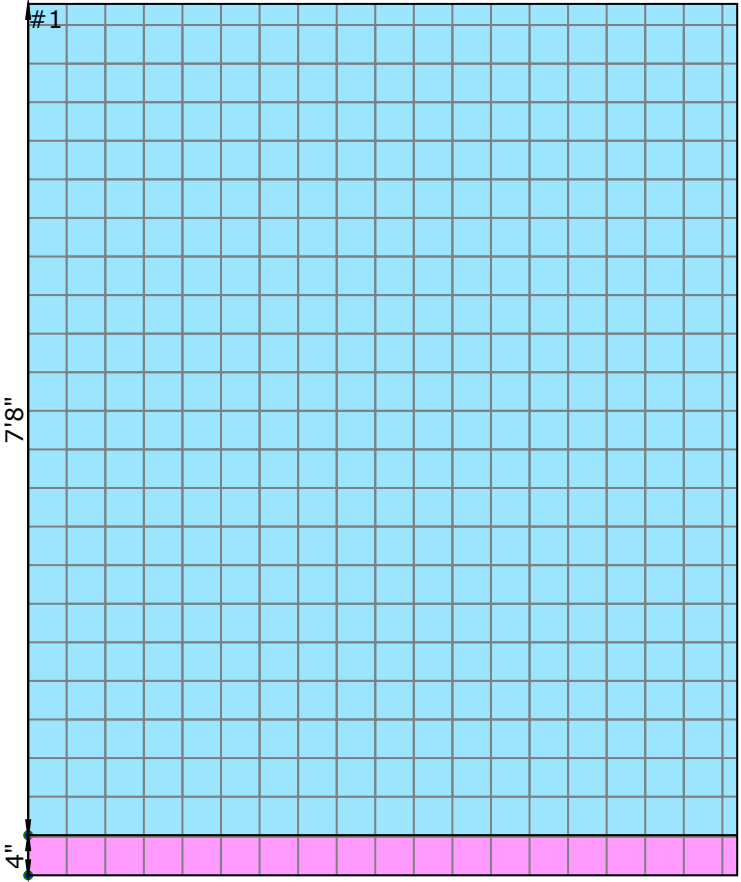
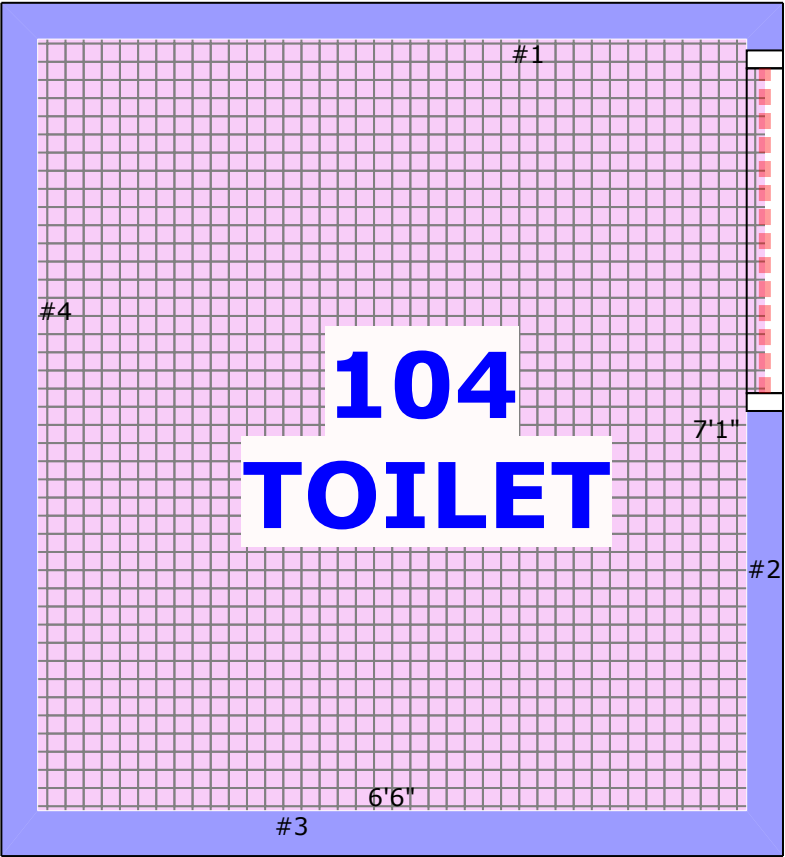


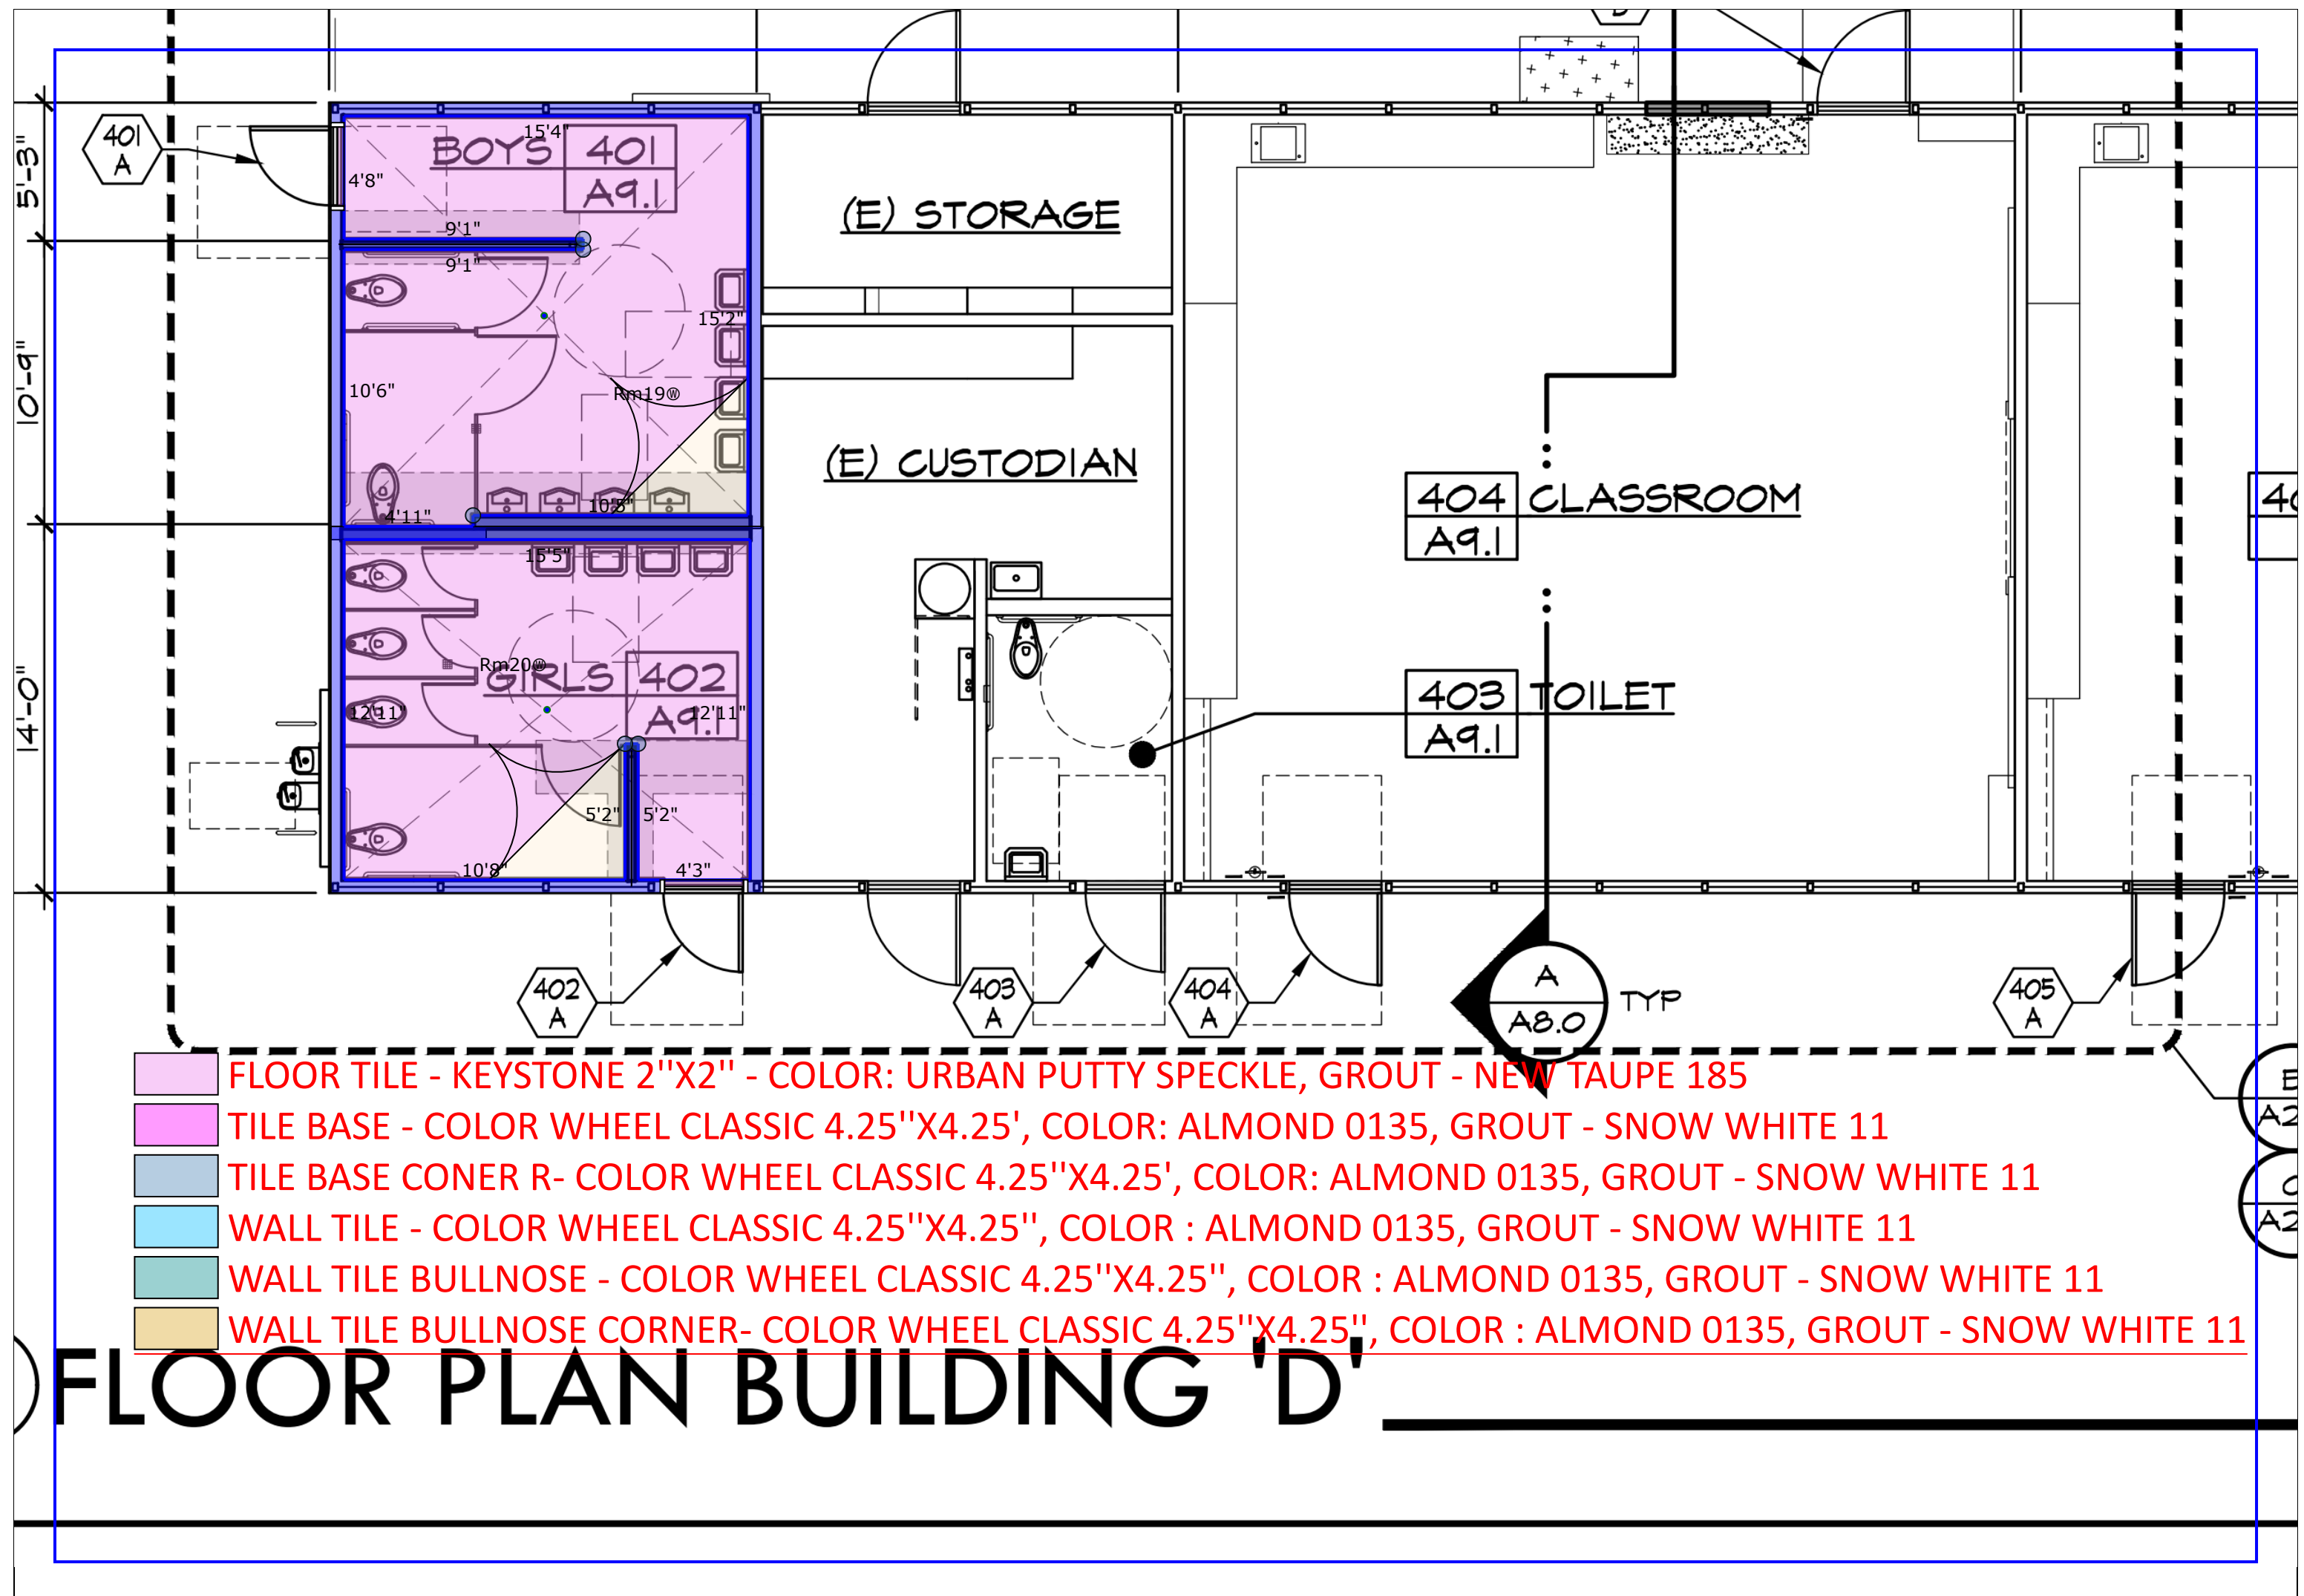






- Rm19
- FLOOR TILE - KEYSTONE 2"X2" - COLOR: URBAN PUTTY SPECKLE, GROUT - NEW TAUPE 185
 - Mortarbed
 - TILE BASE - COLOR WHEEL CLASSIC 4.25"X4.25", COLOR: ALMOND 0135, GROUT - SNOW WHITE 11
 - TILE BASE CONER R- COLOR WHEEL CLASSIC 4.25"X4.25', COLOR: ALMOND 0135, GROUT - SNOW WHITE 11
 - WALL TILE - COLOR WHEEL CLASSIC 4.25"X4.25", COLOR : ALMOND 0135, GROUT - SNOW WHITE 11
 - WALL TILE BULLNOSE - COLOR WHEEL CLASSIC 4.25"X4.25", COLOR : ALMOND 0135, GROUT - SNOW WHITE 11
 - WALL TILE BULLNOSE CORNER- COLOR WHEEL CLASSIC 4.25"X4.25", COLOR : ALMOND 0135, GROUT - SNOW WHITE 11

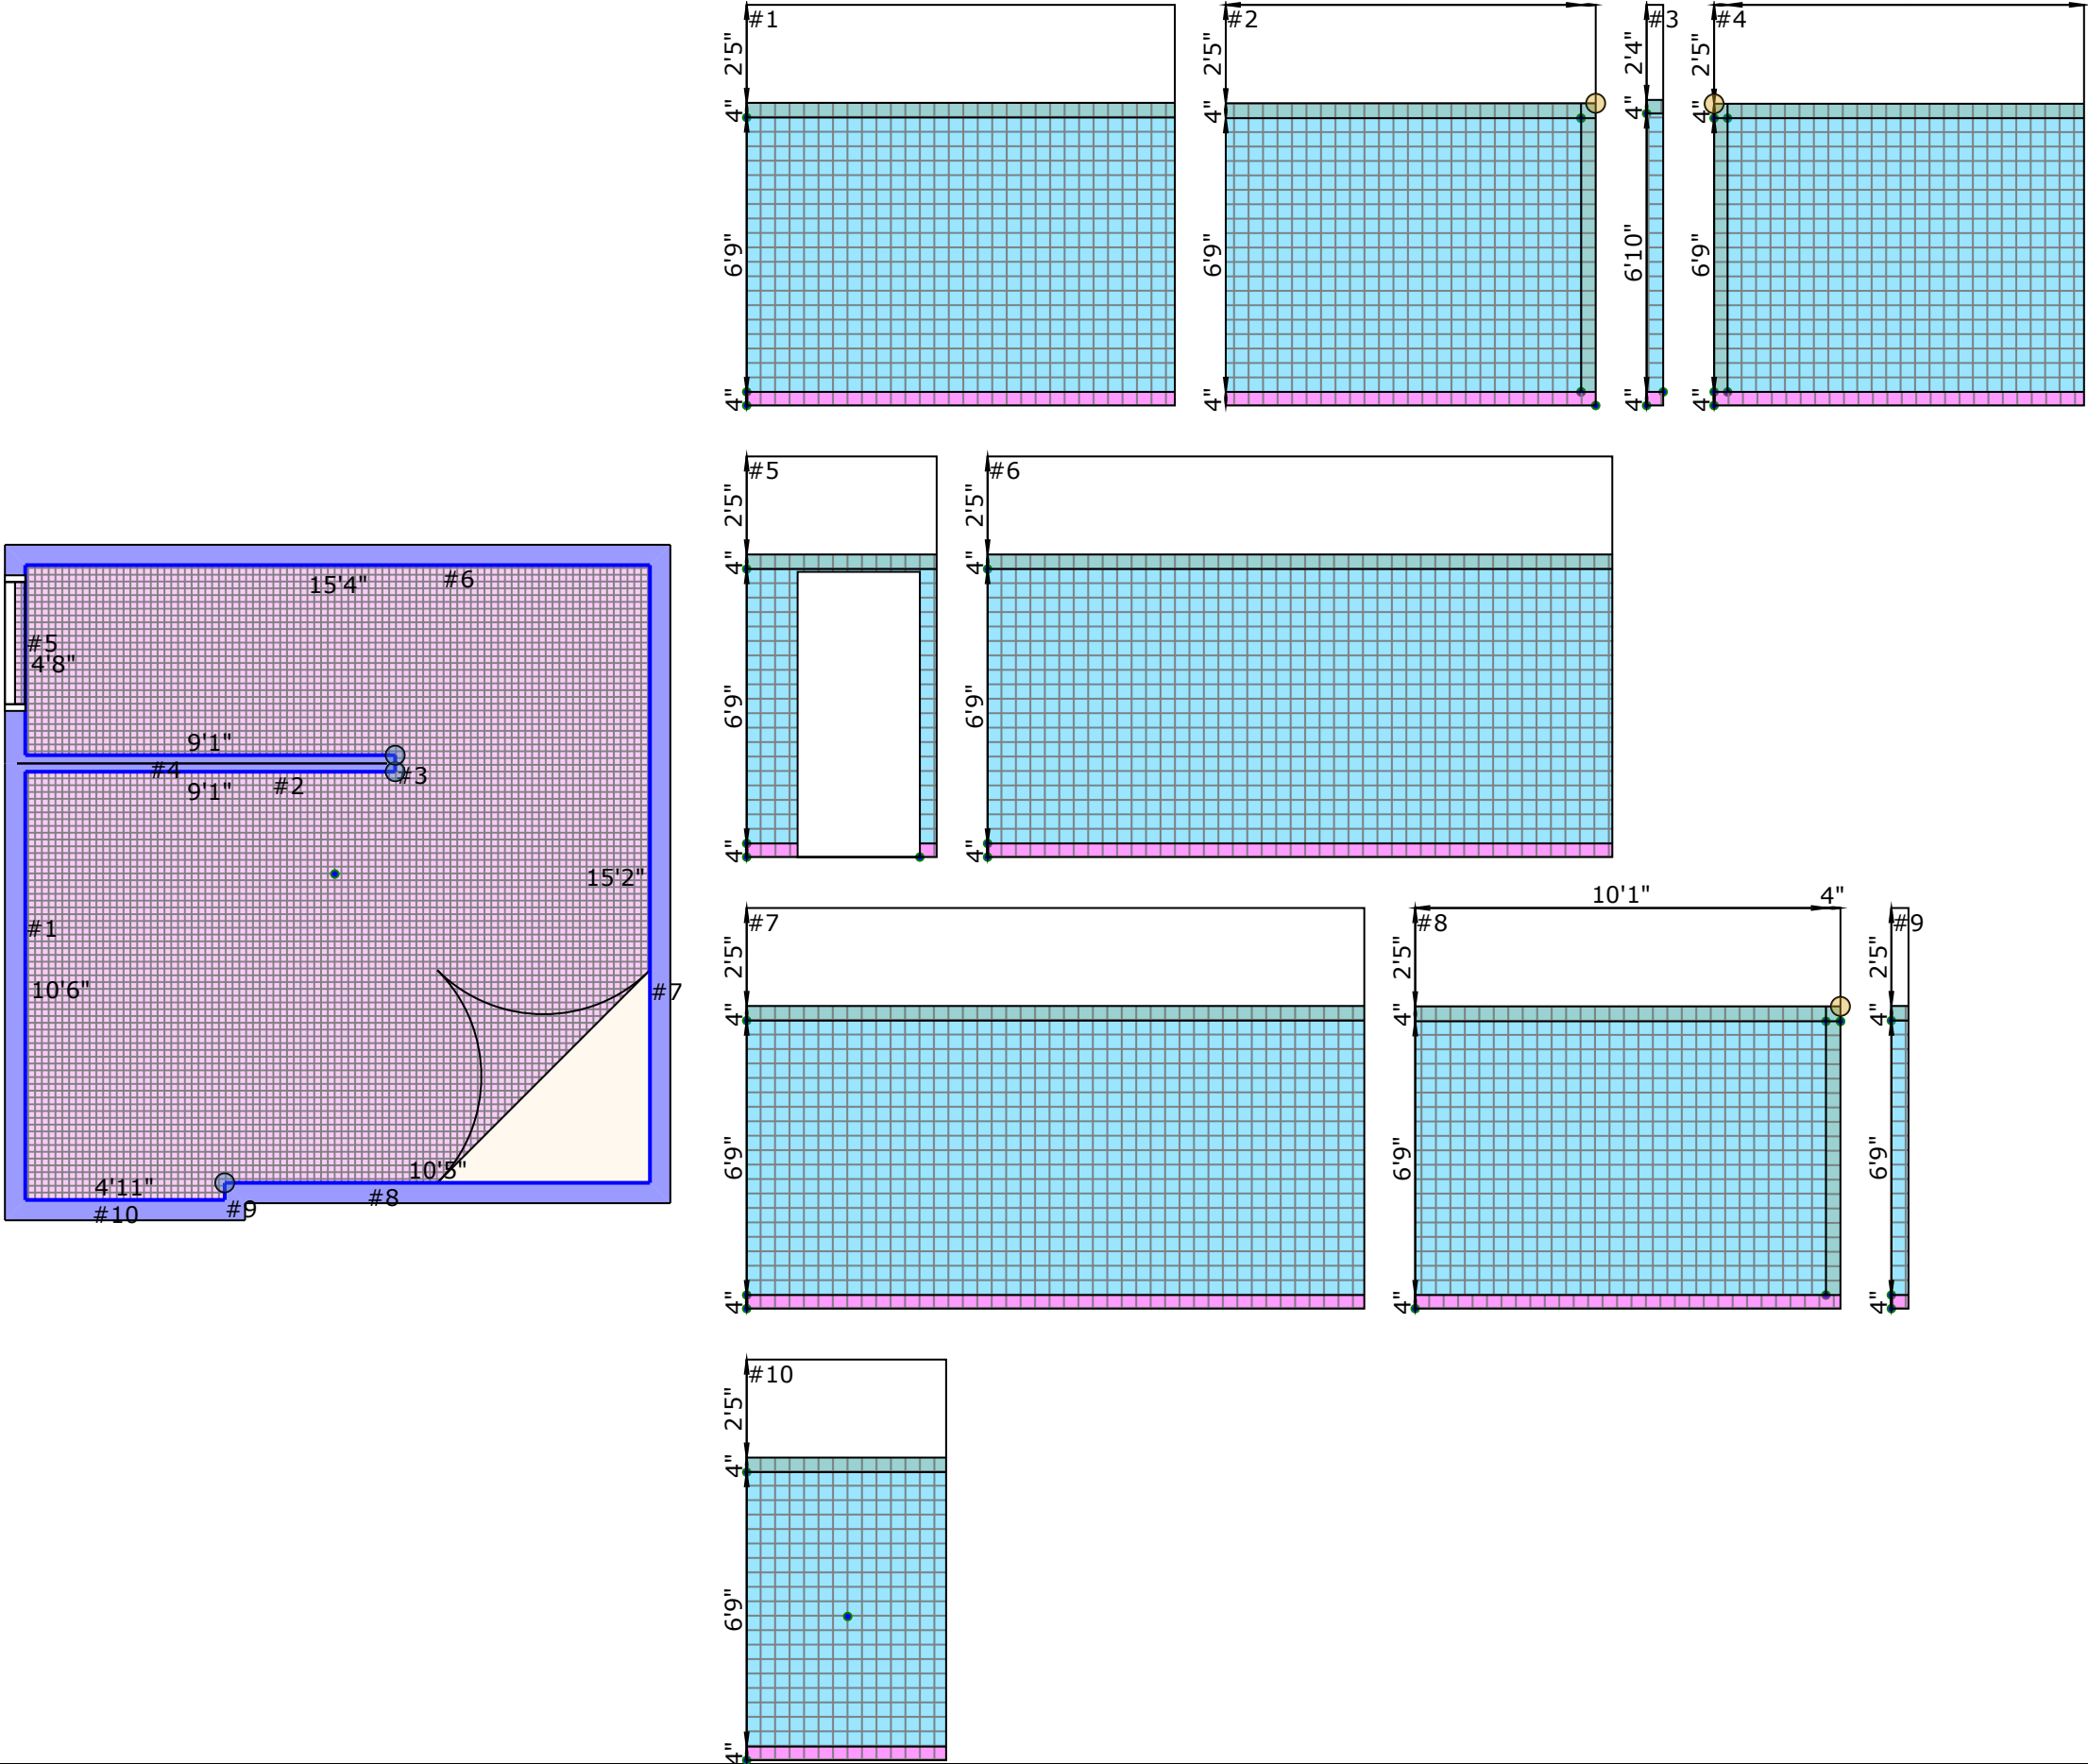






- Rm20
- FLOOR TILE - KEYSTONE 2"X2" - COLOR: URBAN PUTTY SPECKLE, GROUT - NEW TAUPE 185
- Mortarbed
- TILE BASE - COLOR WHEEL CLASSIC 4.25"X4.25', COLOR: ALMOND 0135, GROUT - SNOW WHITE 11
- TILE BASE CONER R- COLOR WHEEL CLASSIC 4.25"X4.25', COLOR: ALMOND 0135, GROUT - SNOW WHITE 11
- WALL TILE - COLOR WHEEL CLASSIC 4.25"X4.25", COLOR : ALMOND 0135, GROUT - SNOW WHITE 11
- WALL TILE BULLNOSE - COLOR WHEEL CLASSIC 4.25"X4.25", COLOR : ALMOND 0135, GROUT - SNOW WHITE 11
- WALL TILE BULLNOSE CORNER- COLOR WHEEL CLASSIC 4.25"X4.25", COLOR : ALMOND 0135, GROUT - SNOW WHITE 11

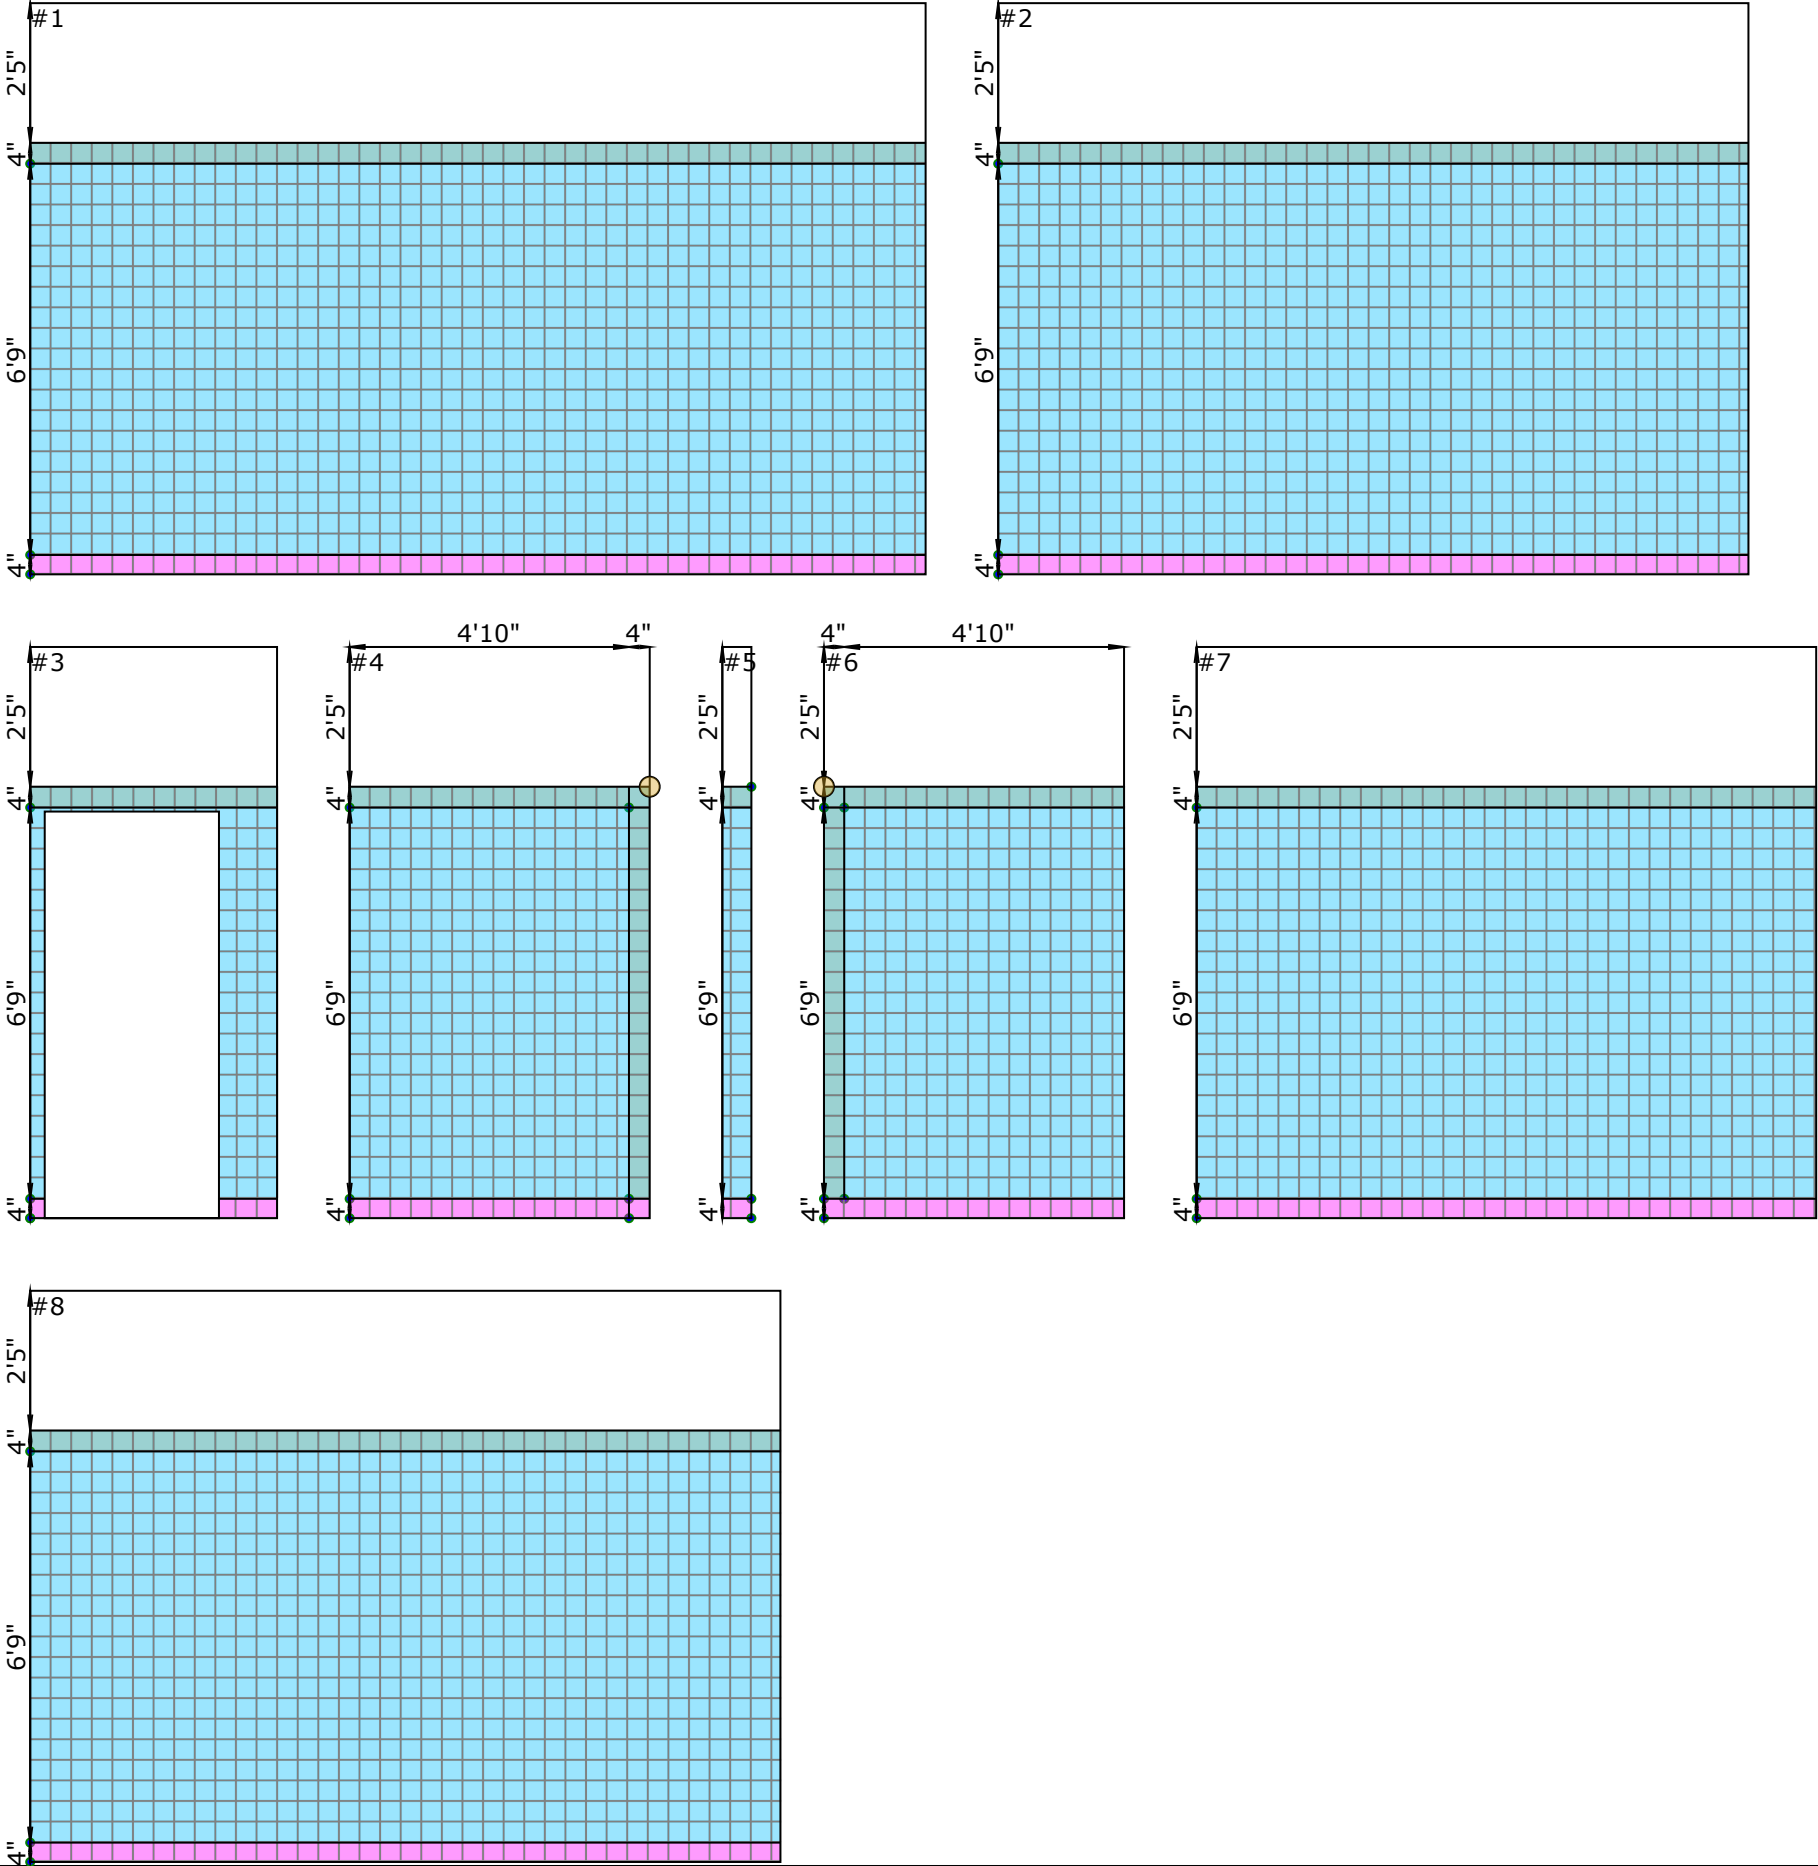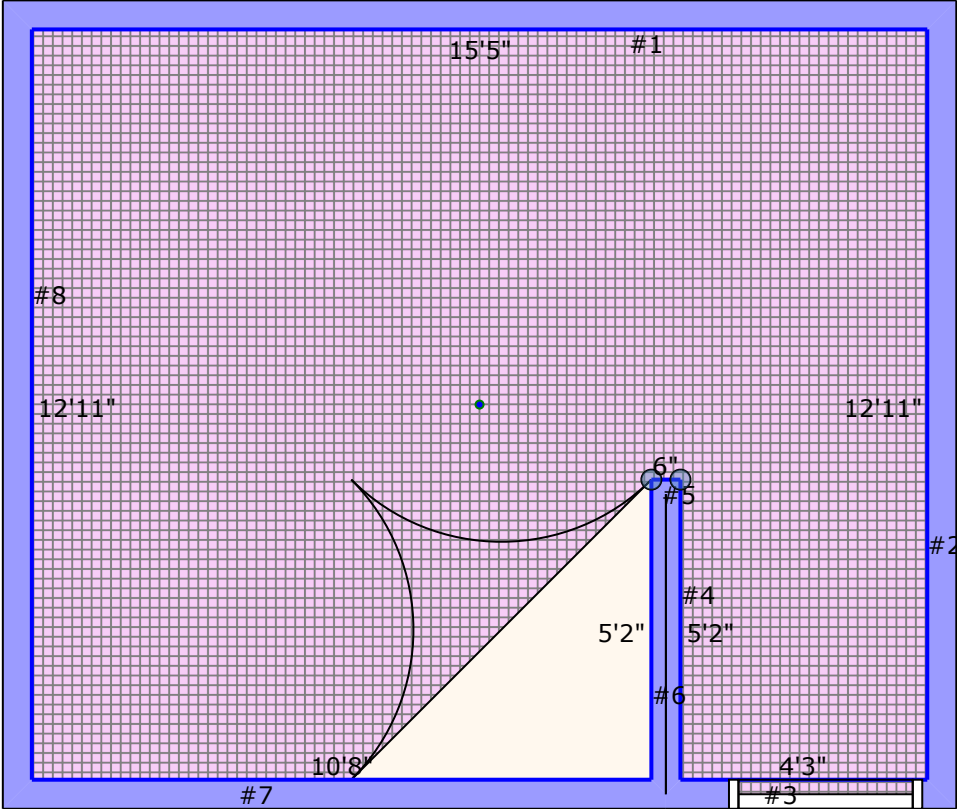





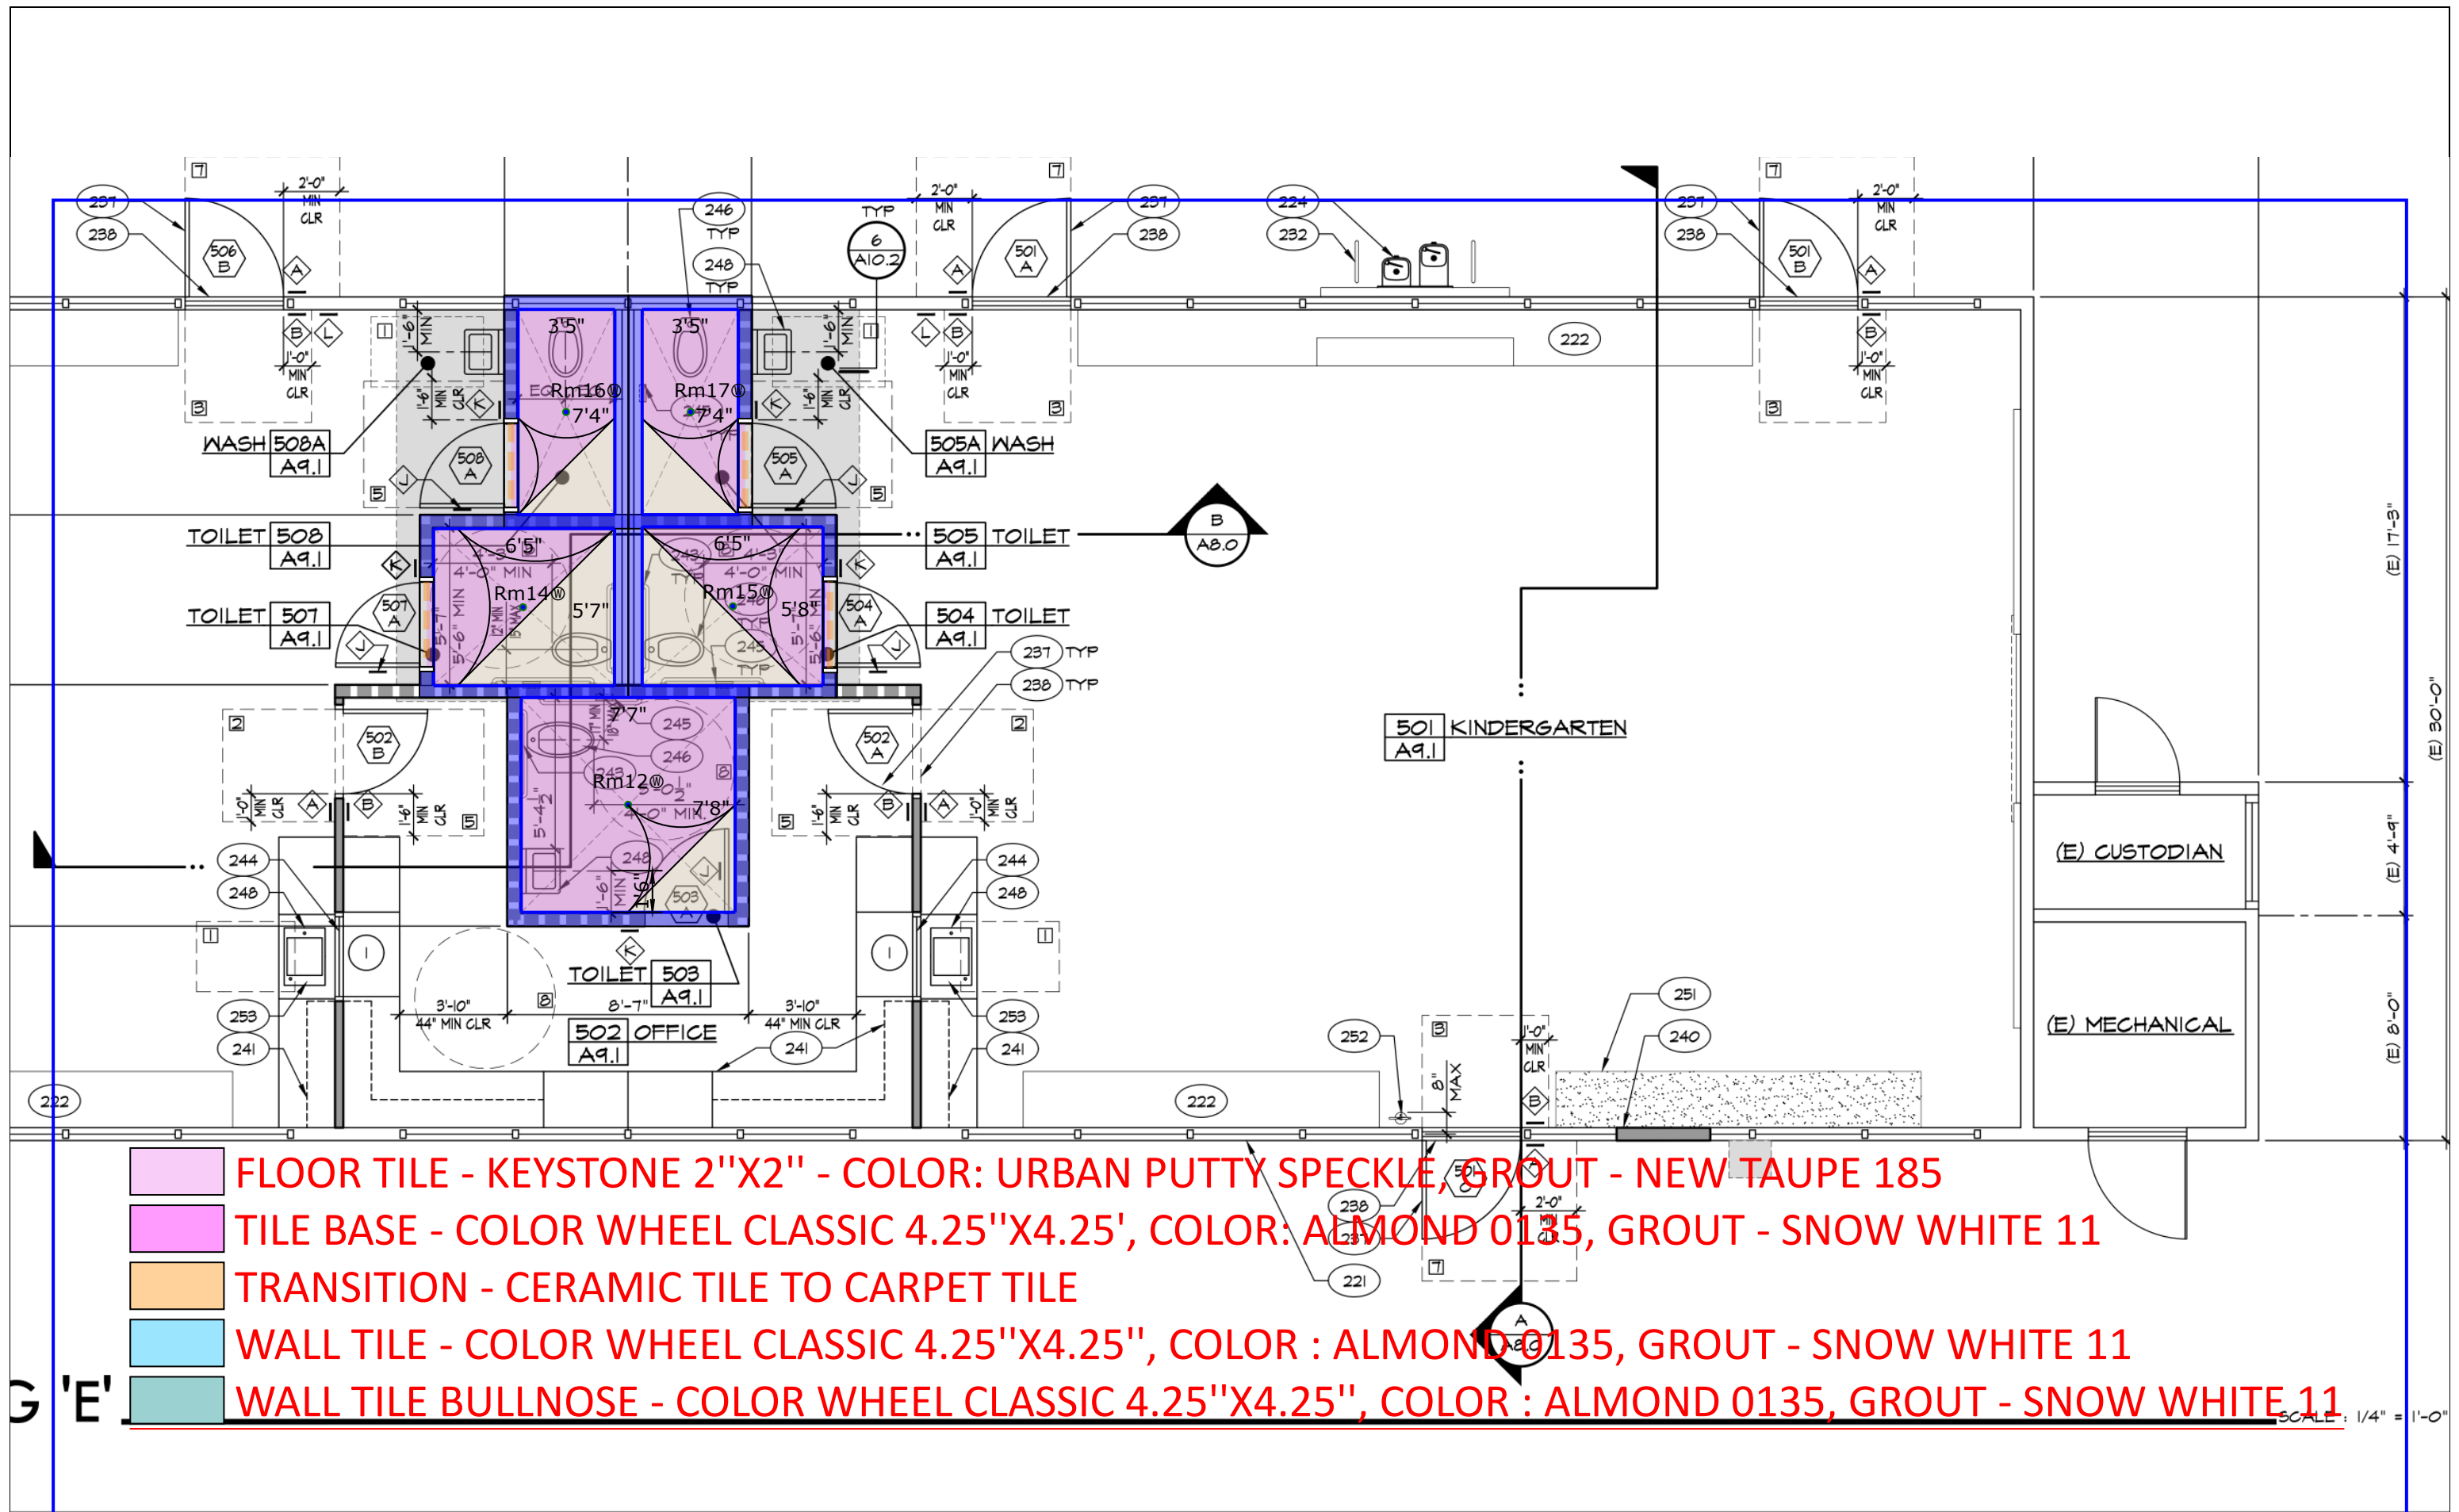


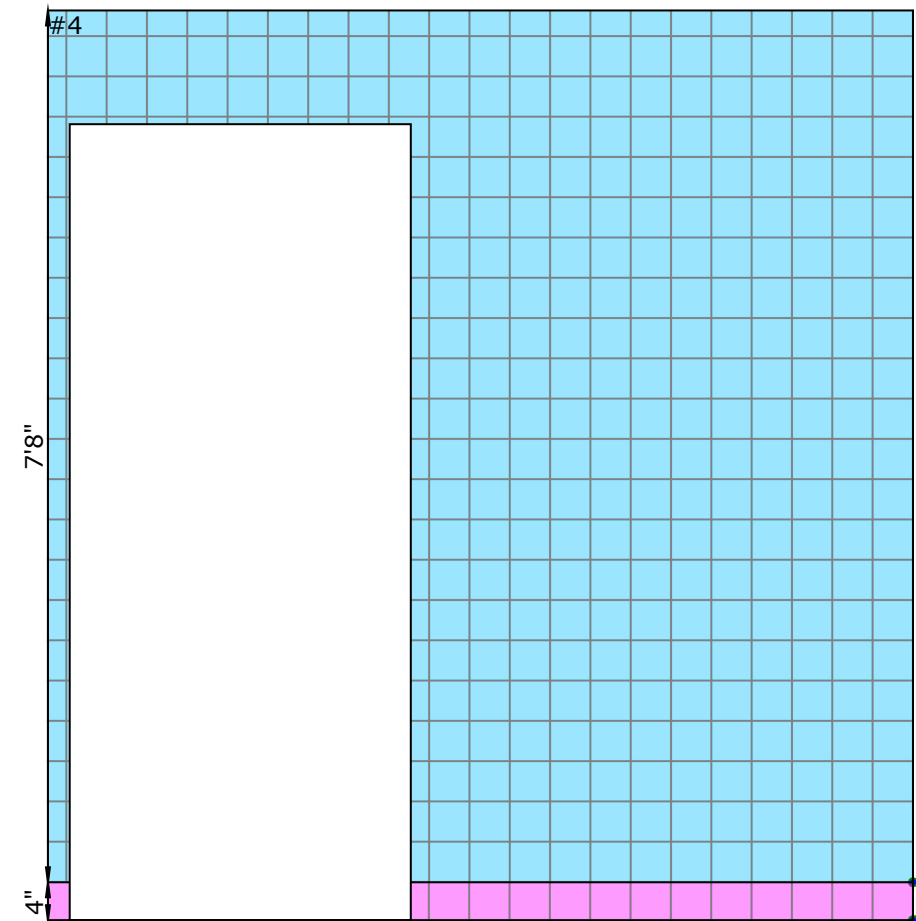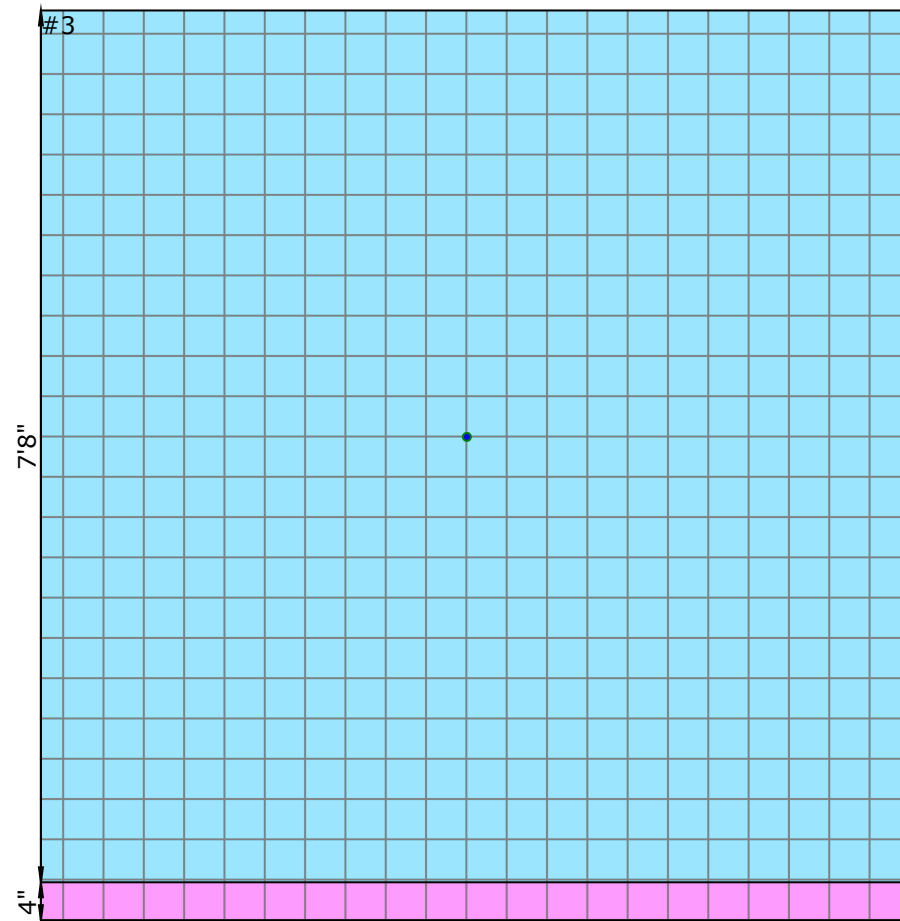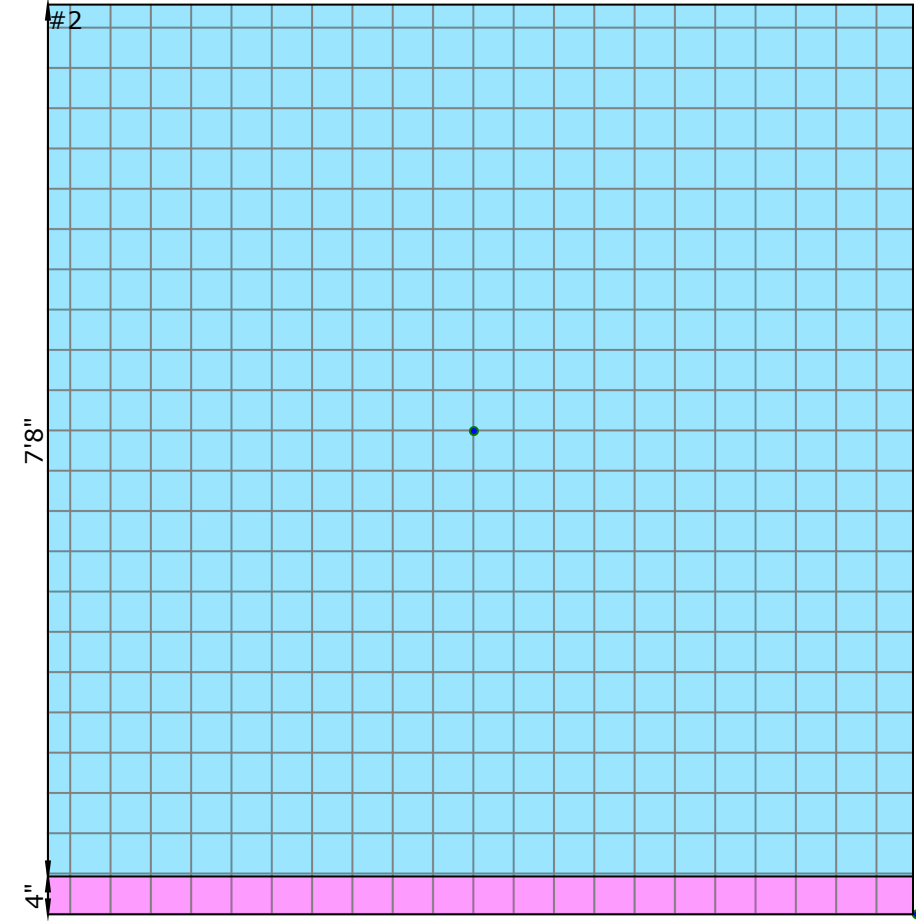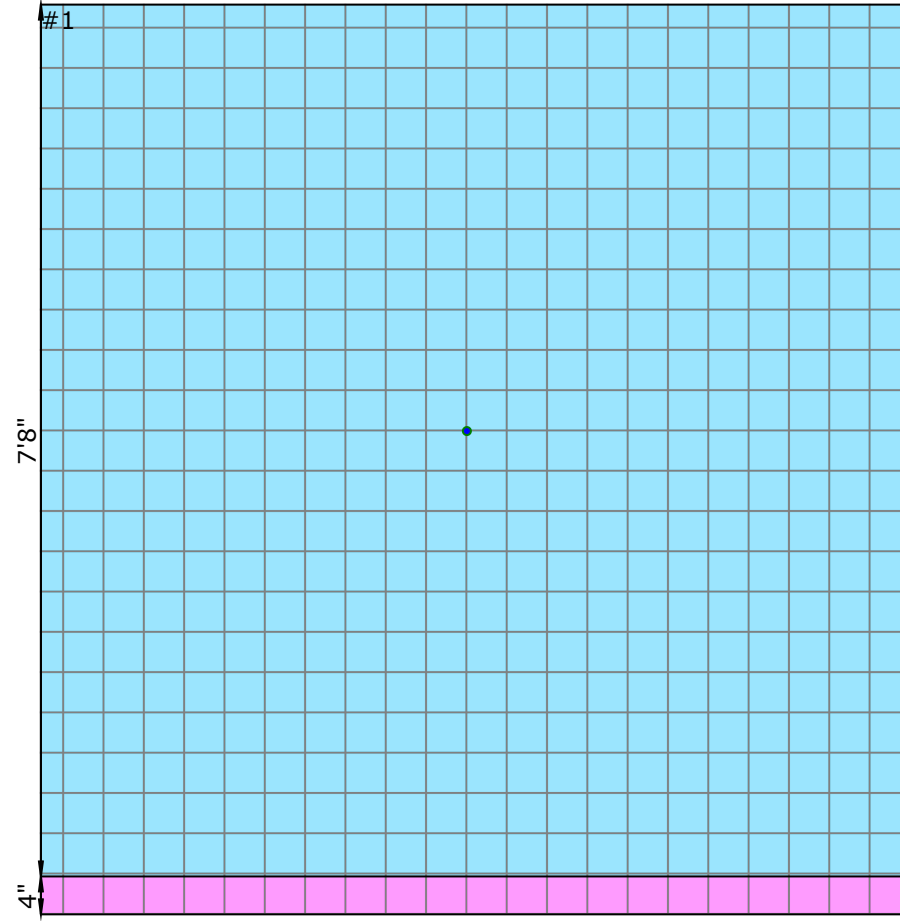






- Rm14
- FLOOR TILE - KEYSTONE 2"X2" - COLOR: URBAN PUTTY SPECKLE, GROUT - NEW TAUPE 185
 - Mortarbed
 - TILE BASE - COLOR WHEEL CLASSIC 4.25"X4.25', COLOR: ALMOND 0135, GROUT - SNOW WHITE 11
 - TRANSITION - CERAMIC TILE TO CARPET TILE
 - WALL TILE - COLOR WHEEL CLASSIC 4.25"X4.25", COLOR : ALMOND 0135, GROUT - SNOW WHITE 11

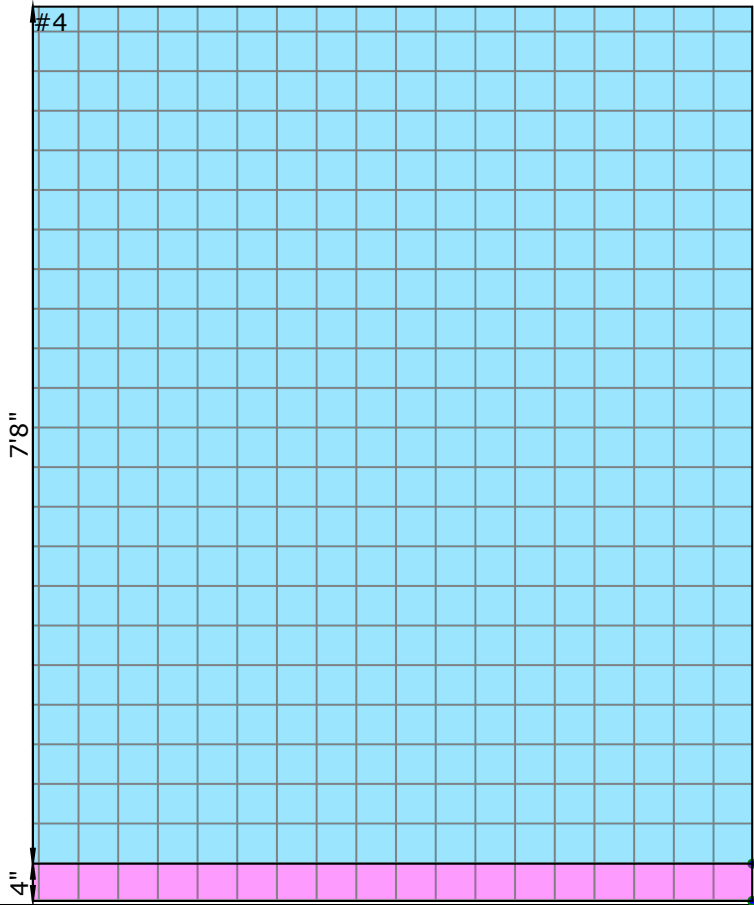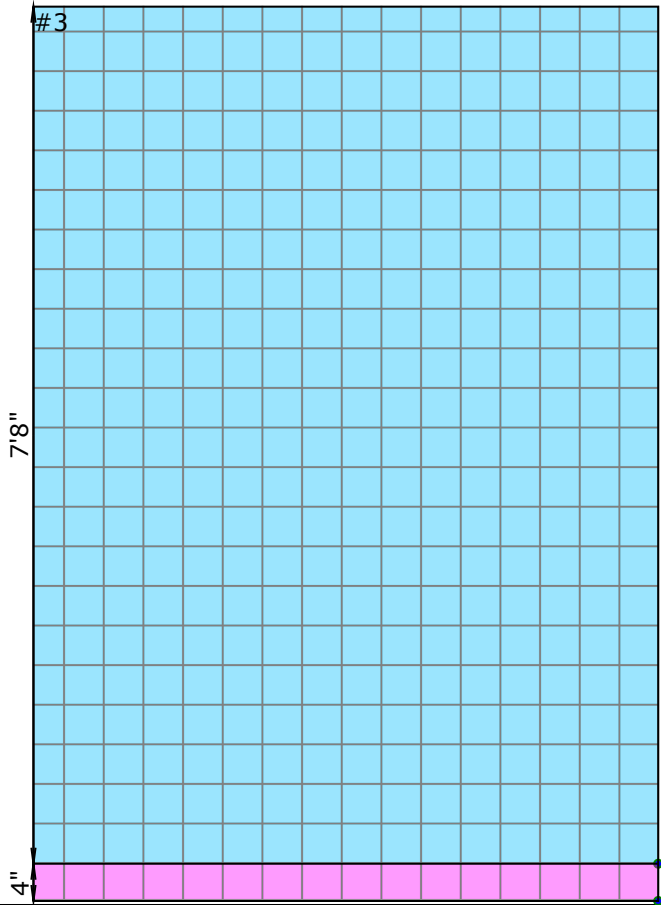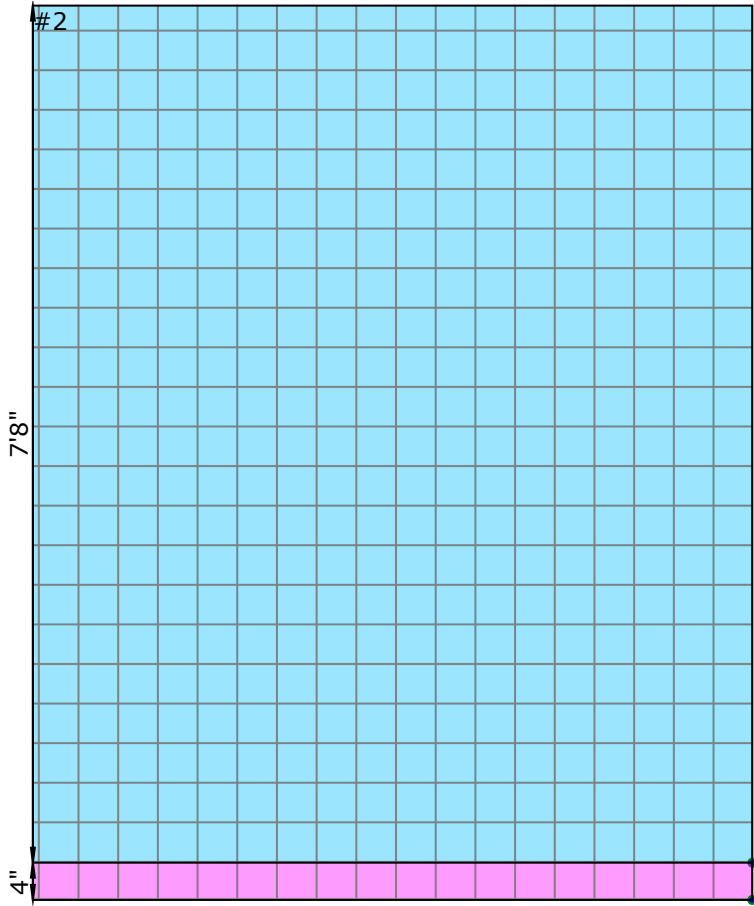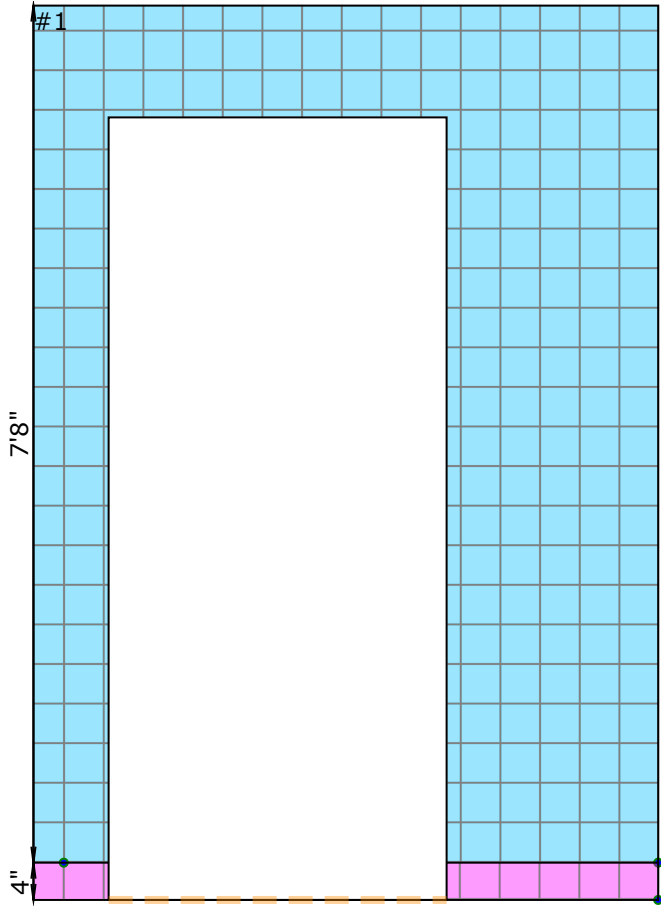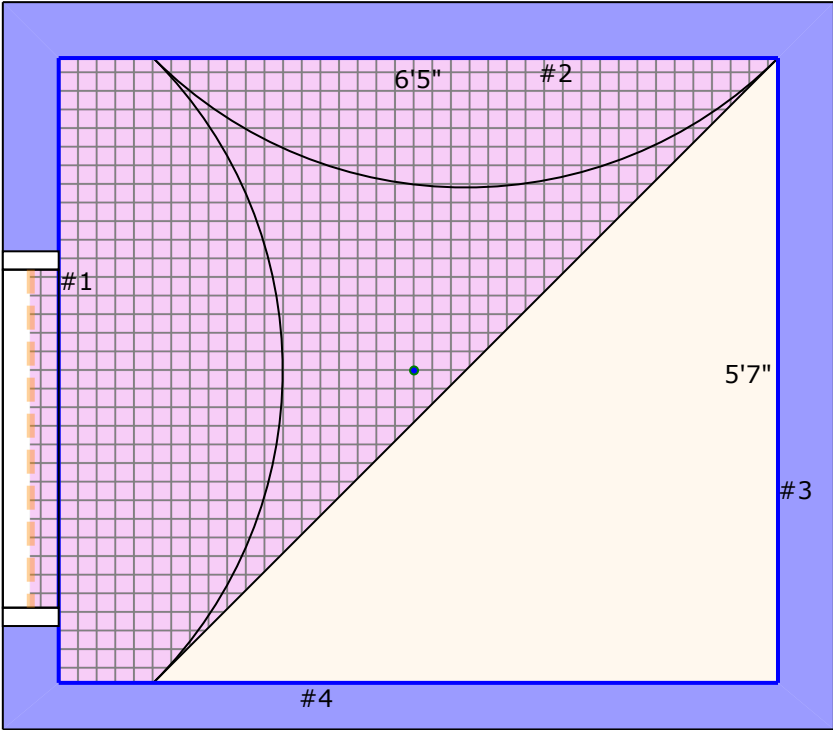

- Rm15
- FLOOR TILE - KEYSTONE 2"X2" - COLOR: URBAN PUTTY SPECKLE, GROUT - NEW TAUPE 185
 - Mortarbed
 - TILE BASE - COLOR WHEEL CLASSIC 4.25"X4.25', COLOR: ALMOND 0135, GROUT - SNOW WHITE 11
 - TRANSITION - CERAMIC TILE TO CARPET TILE
 - WALL TILE - COLOR WHEEL CLASSIC 4.25"X4.25", COLOR : ALMOND 0135, GROUT - SNOW WHITE 11

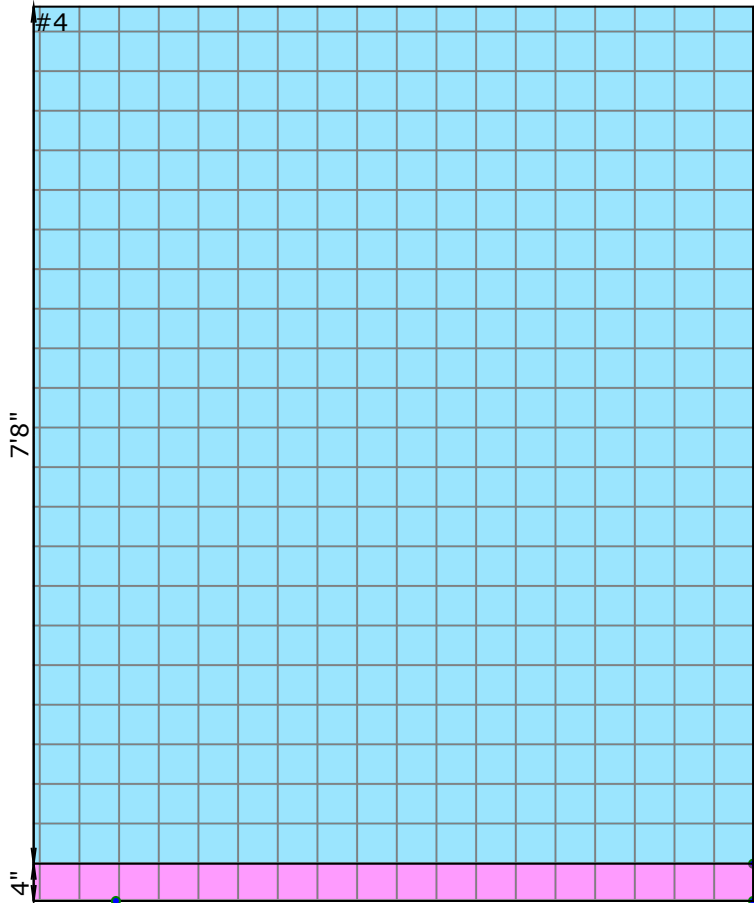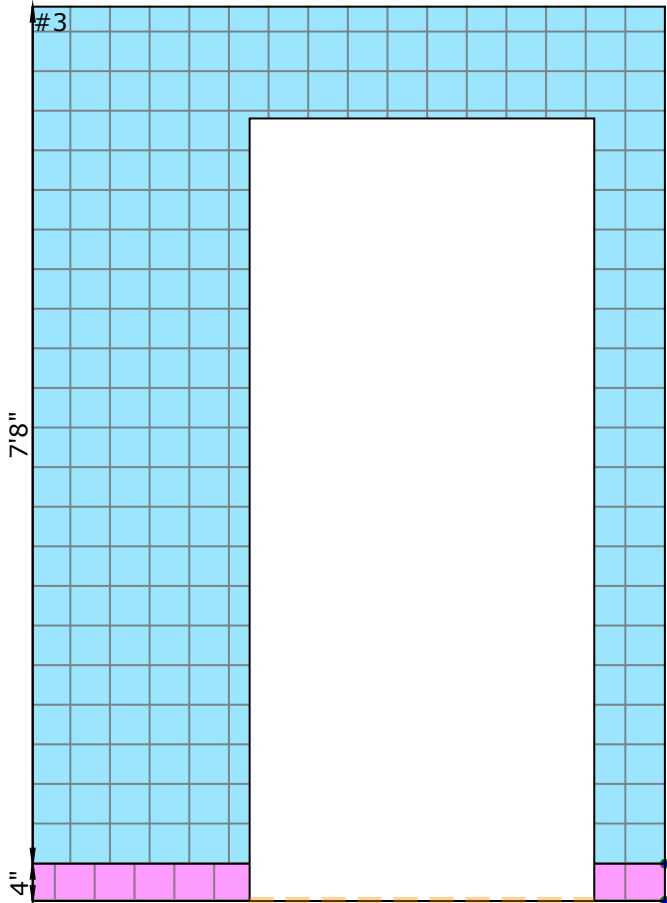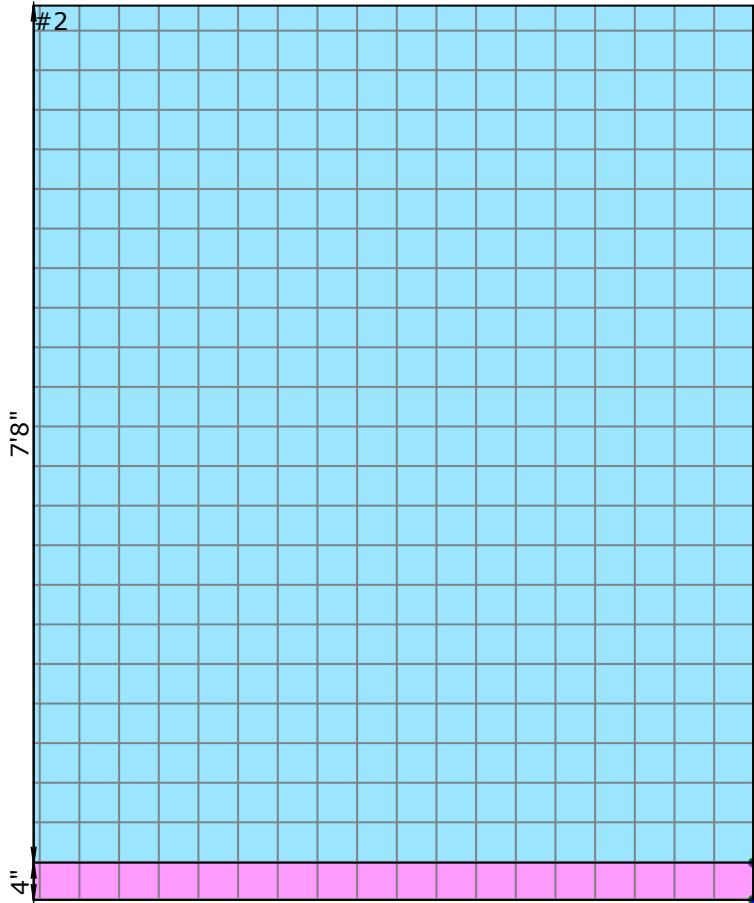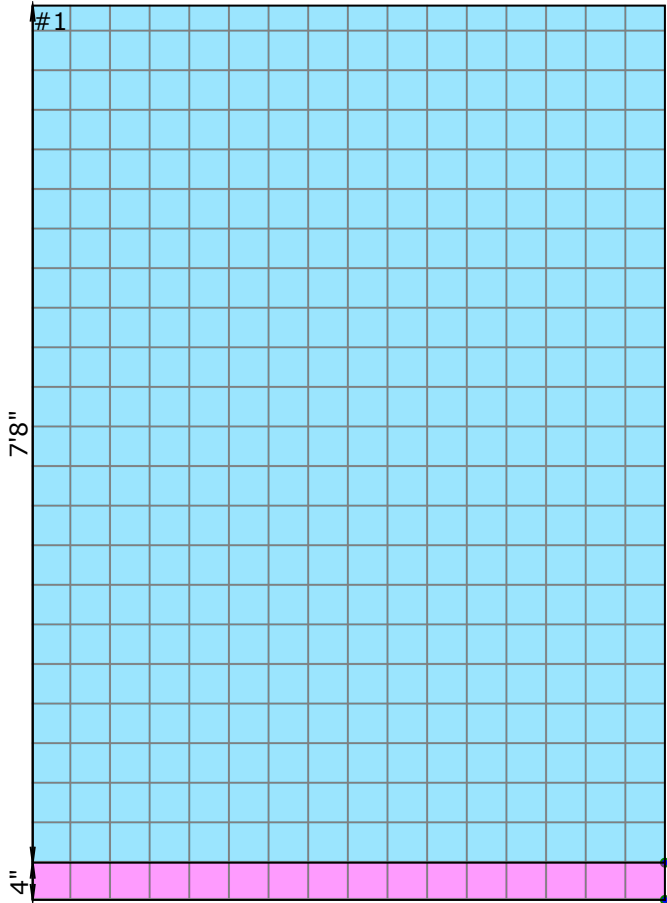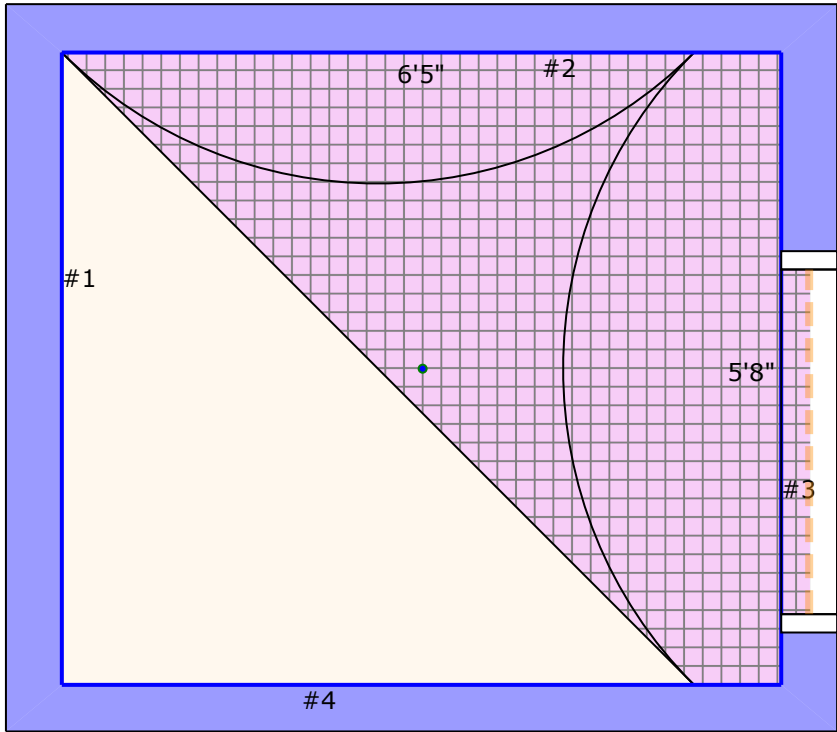

- Rm16
- FLOOR TILE - KEYSTONE 2"X2" - COLOR: URBAN PUTTY SPECKLE, GROUT - NEW TAUPE 185
- Mortarbed
- TILE BASE - COLOR WHEEL CLASSIC 4.25"X4.25', COLOR: ALMOND 0135, GROUT - SNOW WHITE 11
- TRANSITION - CERAMIC TILE TO CARPET TILE
- WALL TILE - COLOR WHEEL CLASSIC 4.25"X4.25", COLOR : ALMOND 0135, GROUT - SNOW WHITE 11
- WALL TILE BULLNOSE - COLOR WHEEL CLASSIC 4.25"X4.25", COLOR : ALMOND 0135, GROUT - SNOW WHITE 11

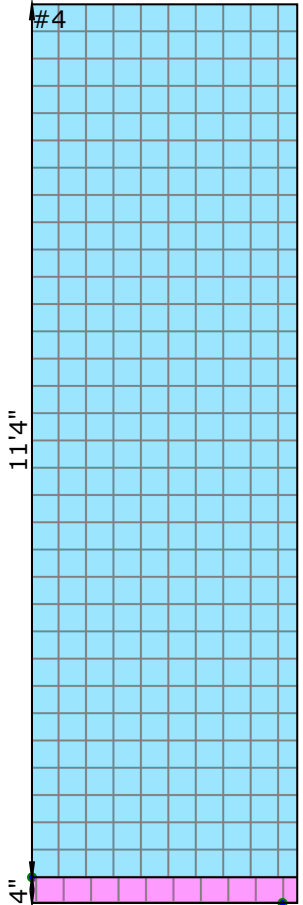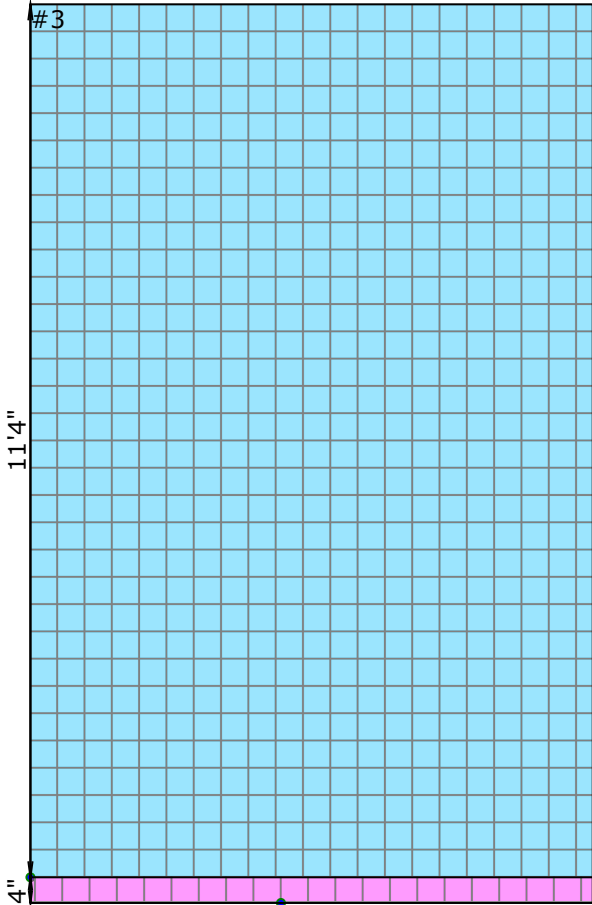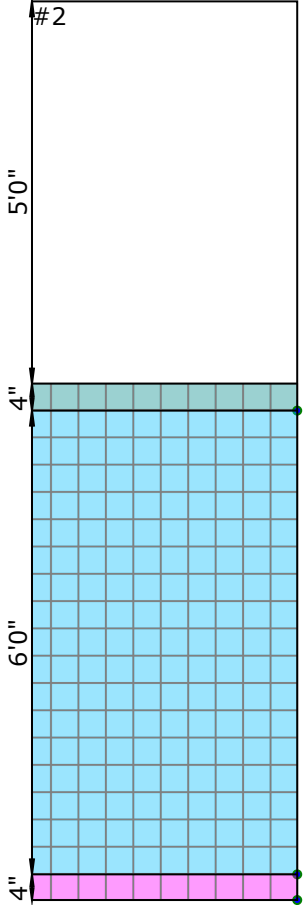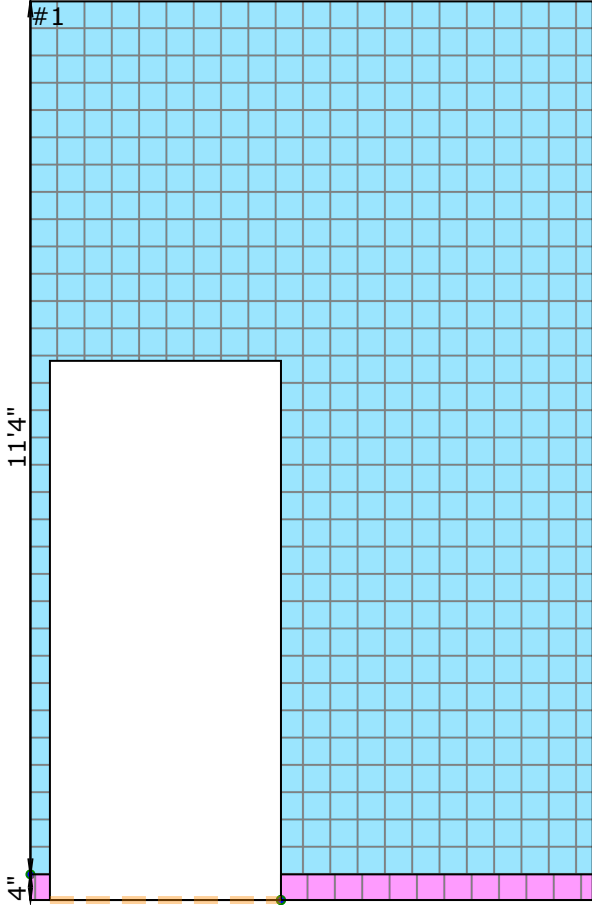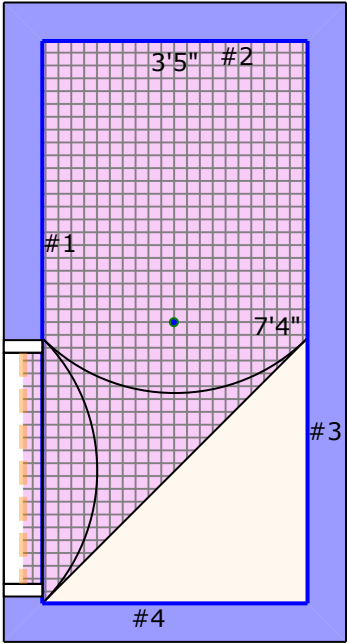

- Rm17
- FLOOR TILE - KEYSTONE 2"X2" - COLOR: URBAN PUTTY SPECKLE, GROUT - NEW TAUPE 185
 - Mortarbed
 - TILE BASE - COLOR WHEEL CLASSIC 4.25"X4.25', COLOR: ALMOND 0135, GROUT - SNOW WHITE 11
 - TRANSITION - CERAMIC TILE TO CARPET TILE
 - WALL TILE - COLOR WHEEL CLASSIC 4.25"X4.25", COLOR : ALMOND 0135, GROUT - SNOW WHITE 11
 - WALL TILE BULLNOSE - COLOR WHEEL CLASSIC 4.25"X4.25", COLOR : ALMOND 0135, GROUT - SNOW WHITE 11

