


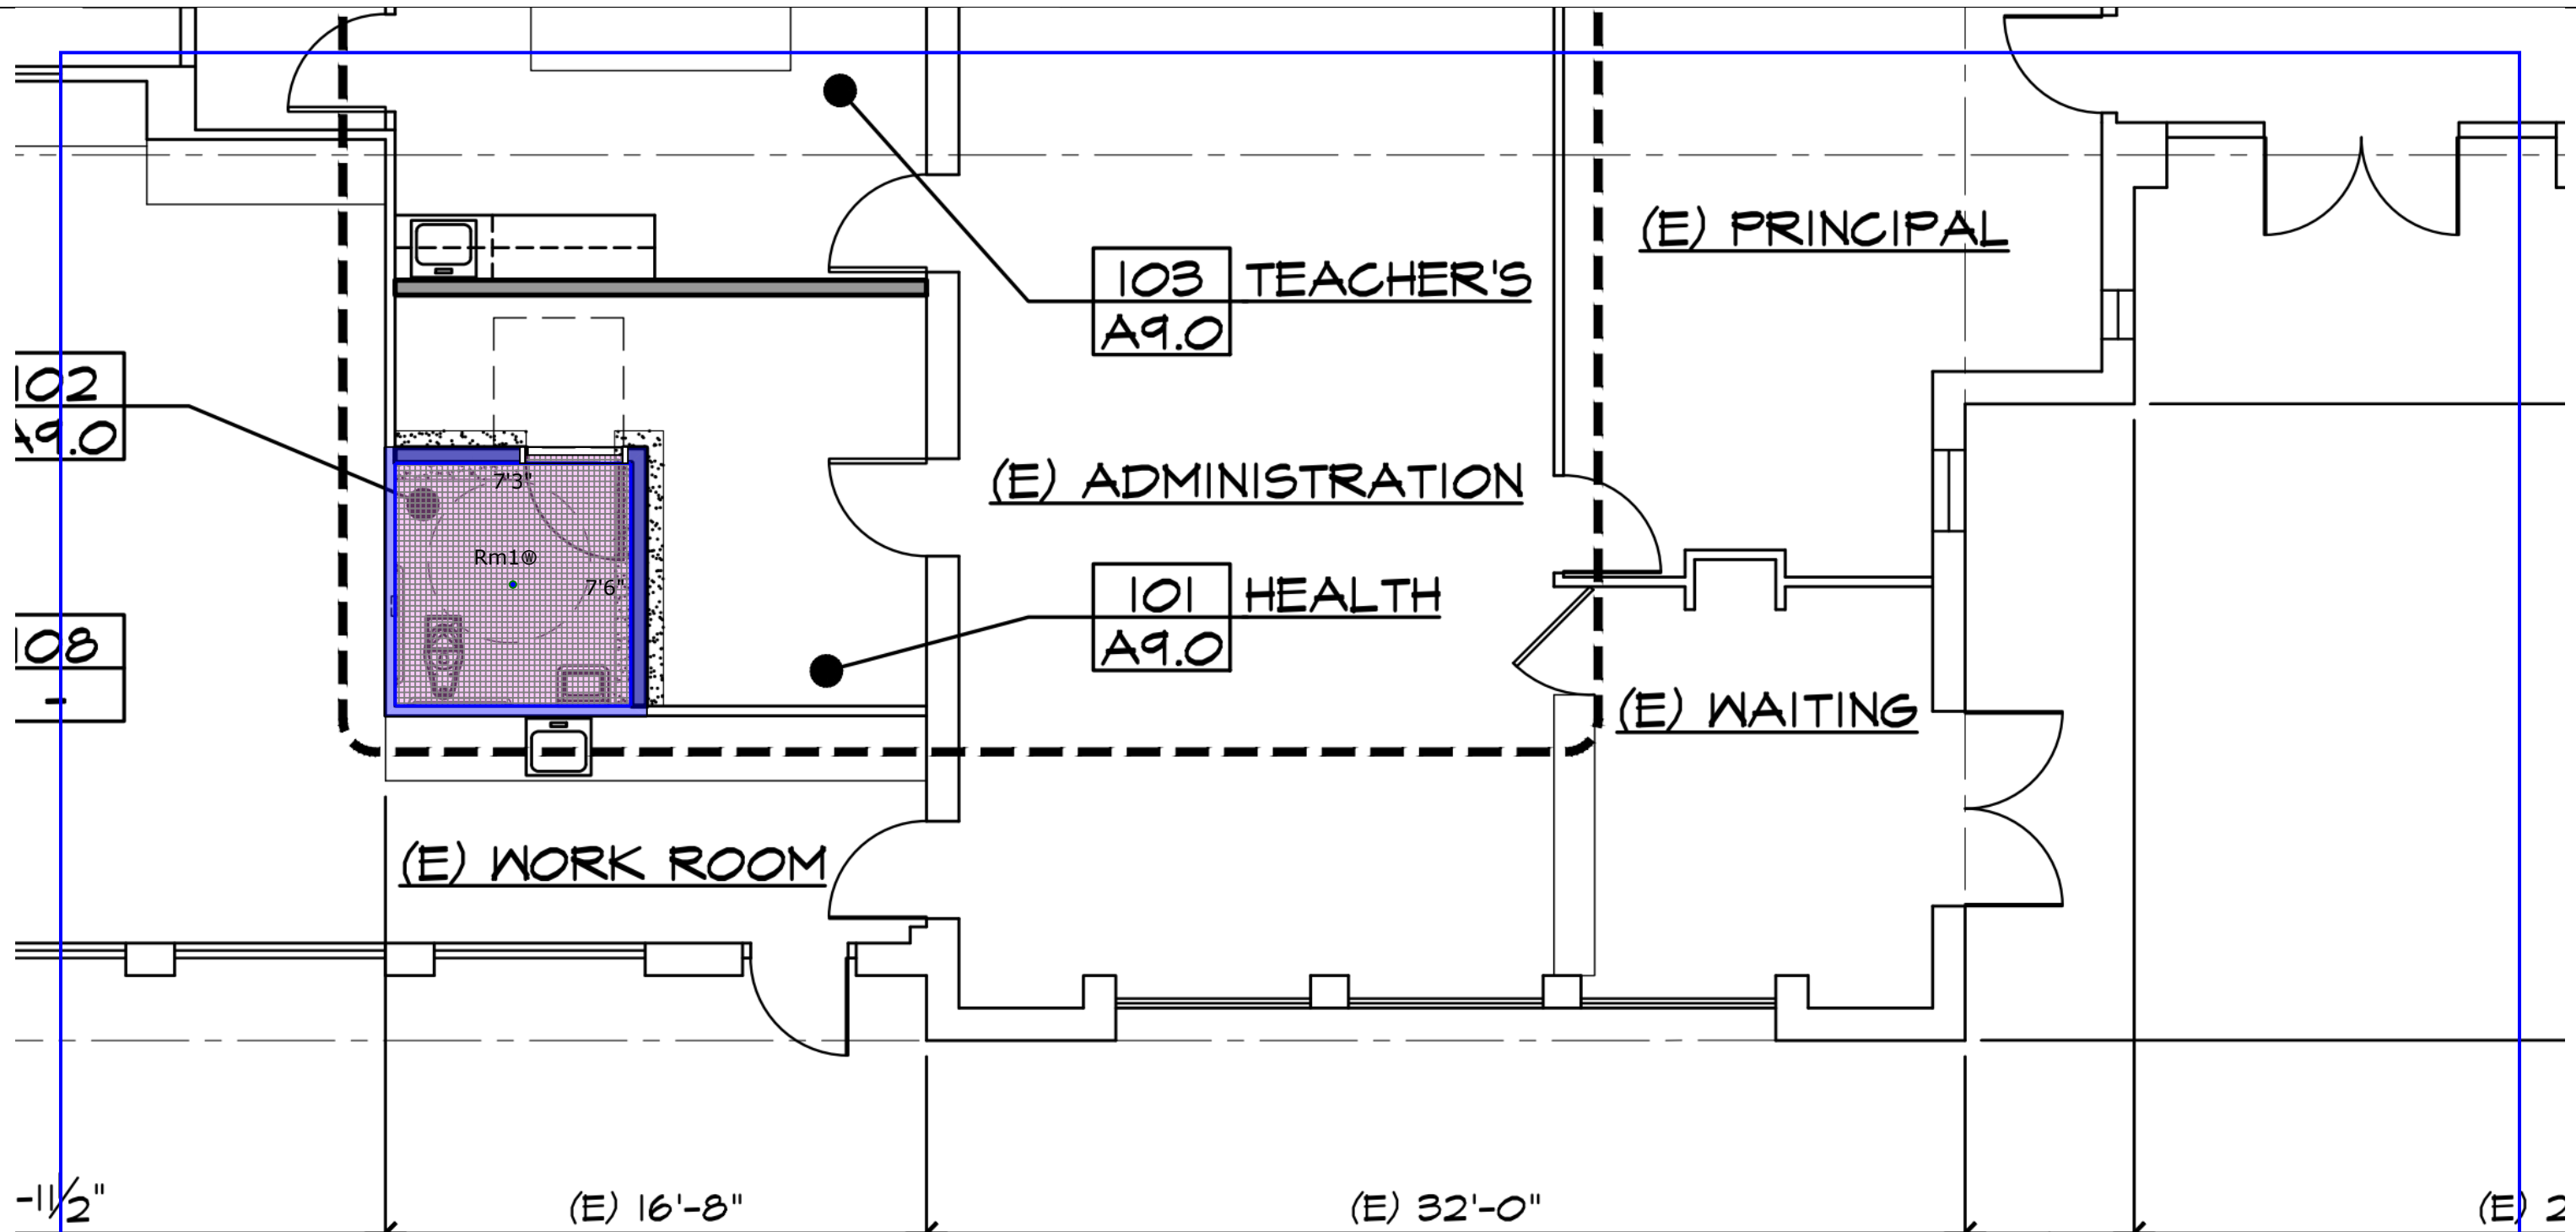

- FLOOR TILE - KEYSTONE 2"X2" - COLOR: URBAN PUTTY SPECKLE, GROUT - NEW TAUPE 185
- TILE BASE - COLOR WHEEL CLASSIC 4.25"X4.25', COLOR: ALMOND 0135, GROUT - SNOW WHITE 11
- WALL TILE - COLOR WHEEL CLASSIC 4.25"X4.25", COLOR : ALMOND 0135, GROUT - SNOW WHITE 11

BUILDING 'A'