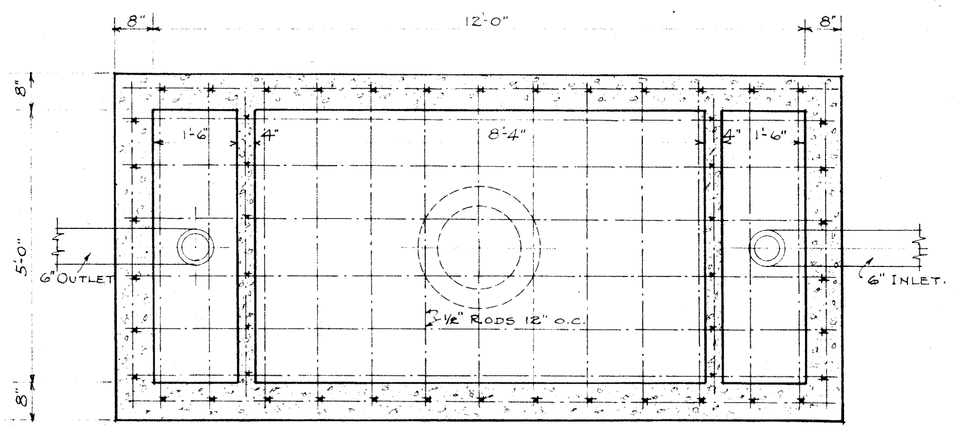

· PLAN ·

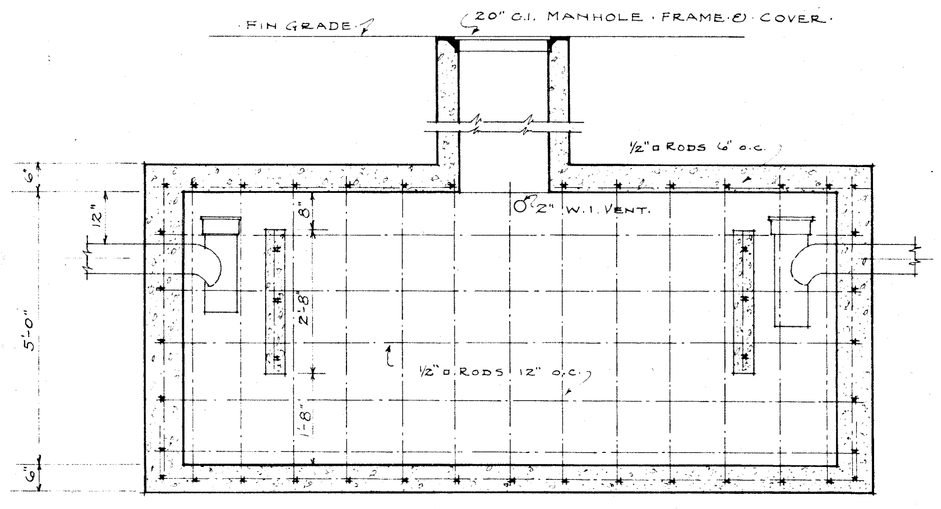

· LONGITUDINAL SECTION ·

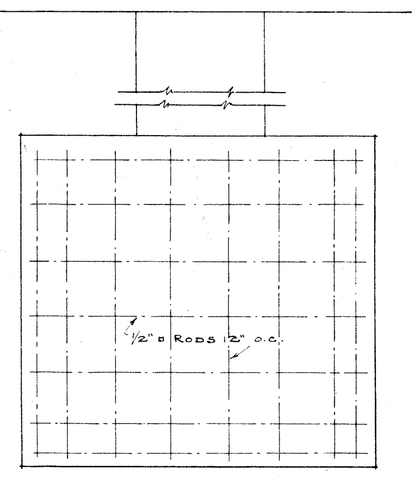

· END ·

· DETAILS OF SEPTIC TANK ·
1/2"=1'-0"

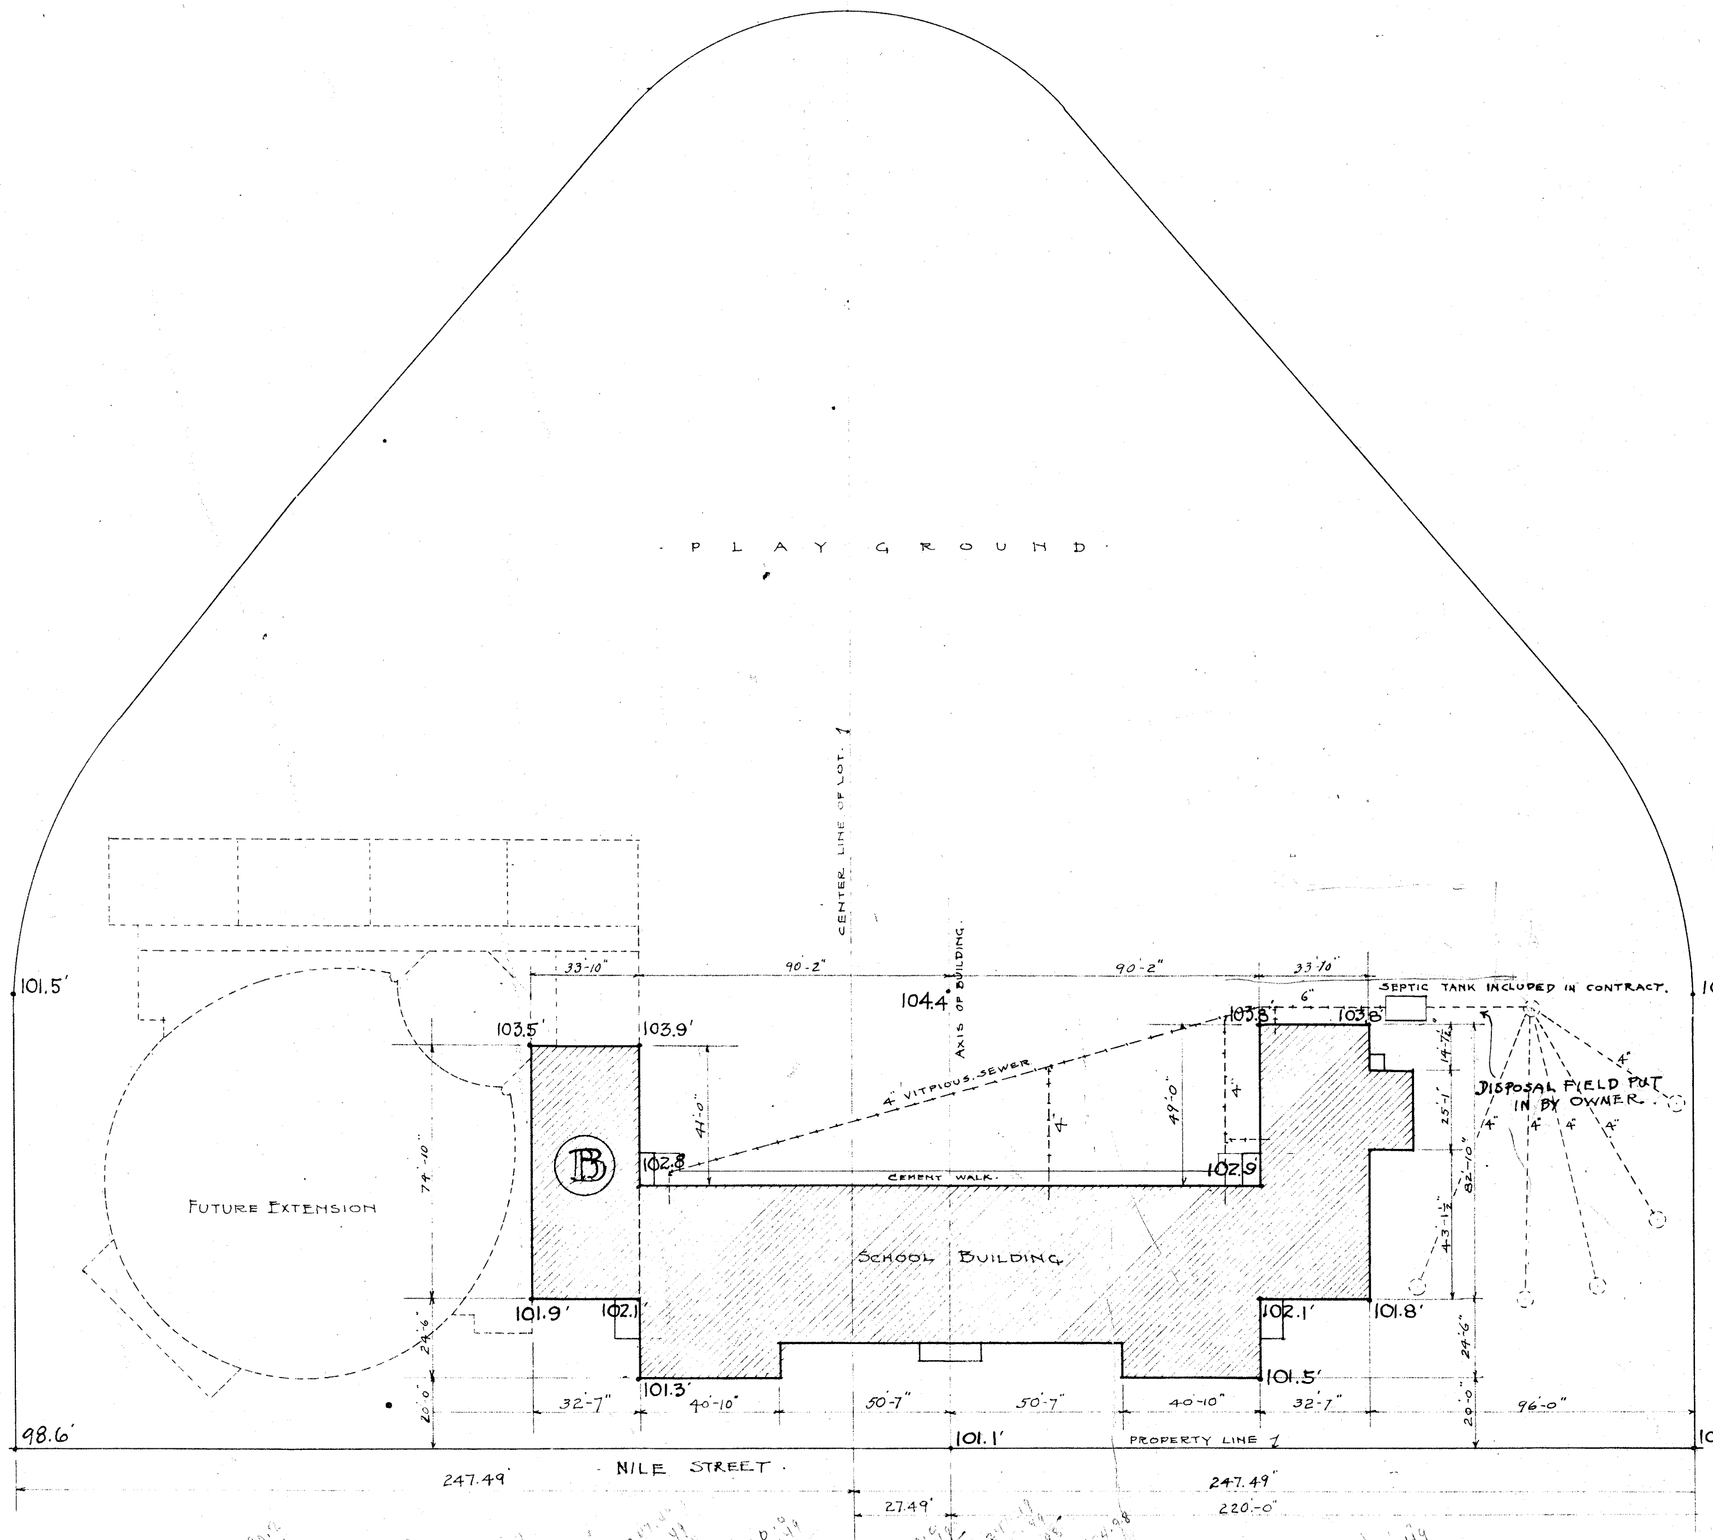

⊥ · BENCH MARK · 100.0'
CURB · SOUTH SIDE · NILE ST.

· HORACE · MANN · SCHOOL ·
· BAKERSFIELD · SCHOOL DISTRICT ·
· NILE ST. · BAKERSFIELD ·

4-12-30

C. H. RUSH. BIGGAR
ARCHITECT
405-406 BANK OF ITALY BLDG.
BAKERSFIELD, CALIFORNIA