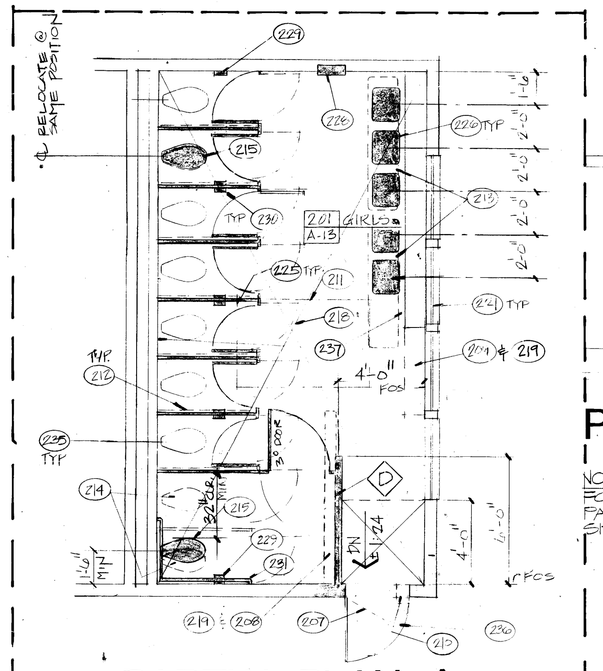

PARTIAL PLAN A 1/4"=1'-0"

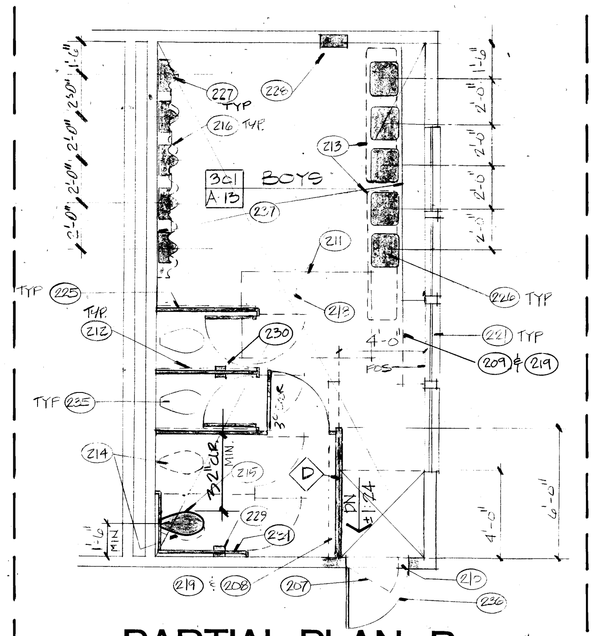

PARTIAL PLAN B 1/4"=1'-0"

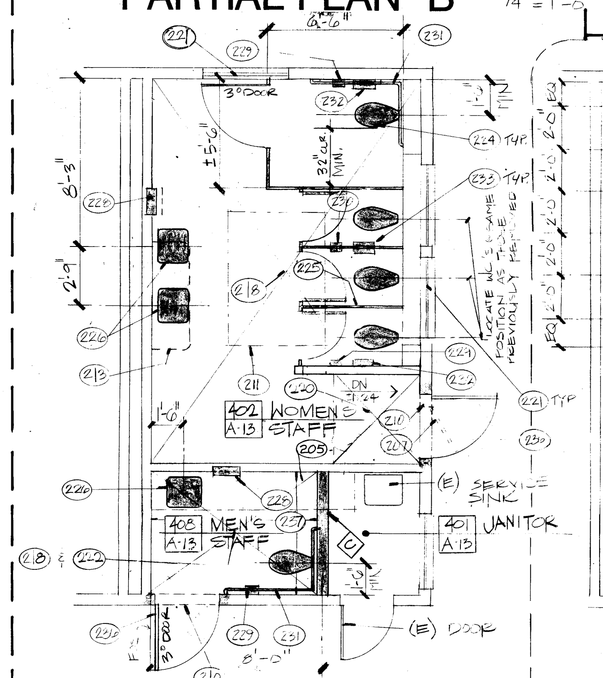

PARTIAL PLAN C 1/4"=1'-0"

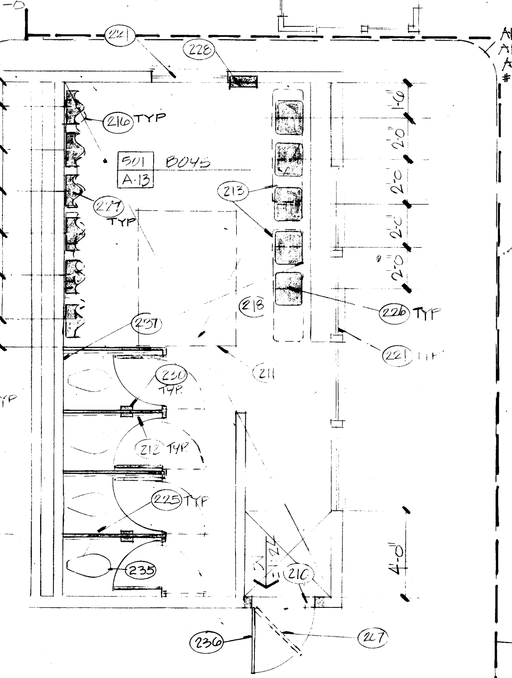

PARTIAL PLAN D 1/4"=1'-0"

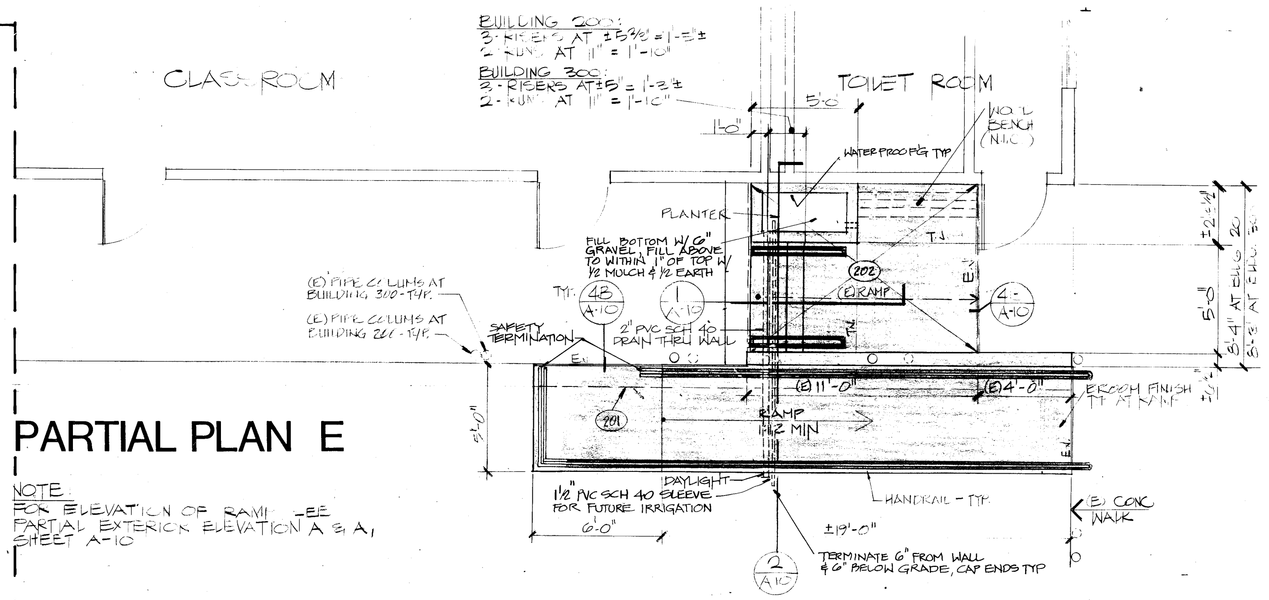

PARTIAL PLAN E

NOTE:
FOR ELEVATION OF RAMP SEE PARTIAL EXTERIOR ELEVATION A & A1 SHEET A-10

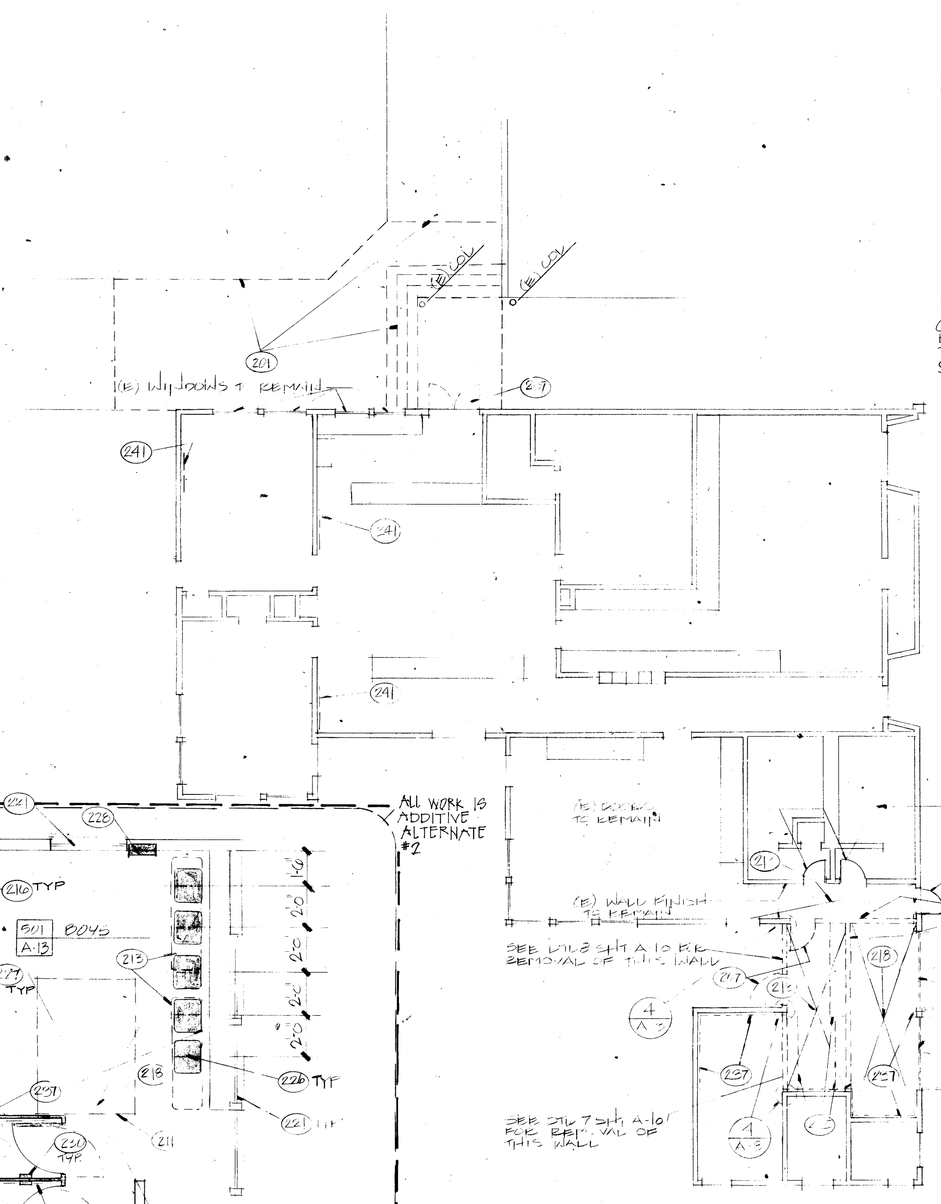

BUILDING 100
DEMOLITION PLAN

CERAMIC TILE FLOOR AND ASSOCIATED SAWCUTTING AND DEMOLITION WORK, RELATED TO TILE WORK, IN TOILET 201, 301, 402, AND 408 (AND 501, IF ALTERNATE 2 IS SELECTED) IS ALTERNATE 3 (ADDITIVE) BASE BID IS RESINOUS FLOORING

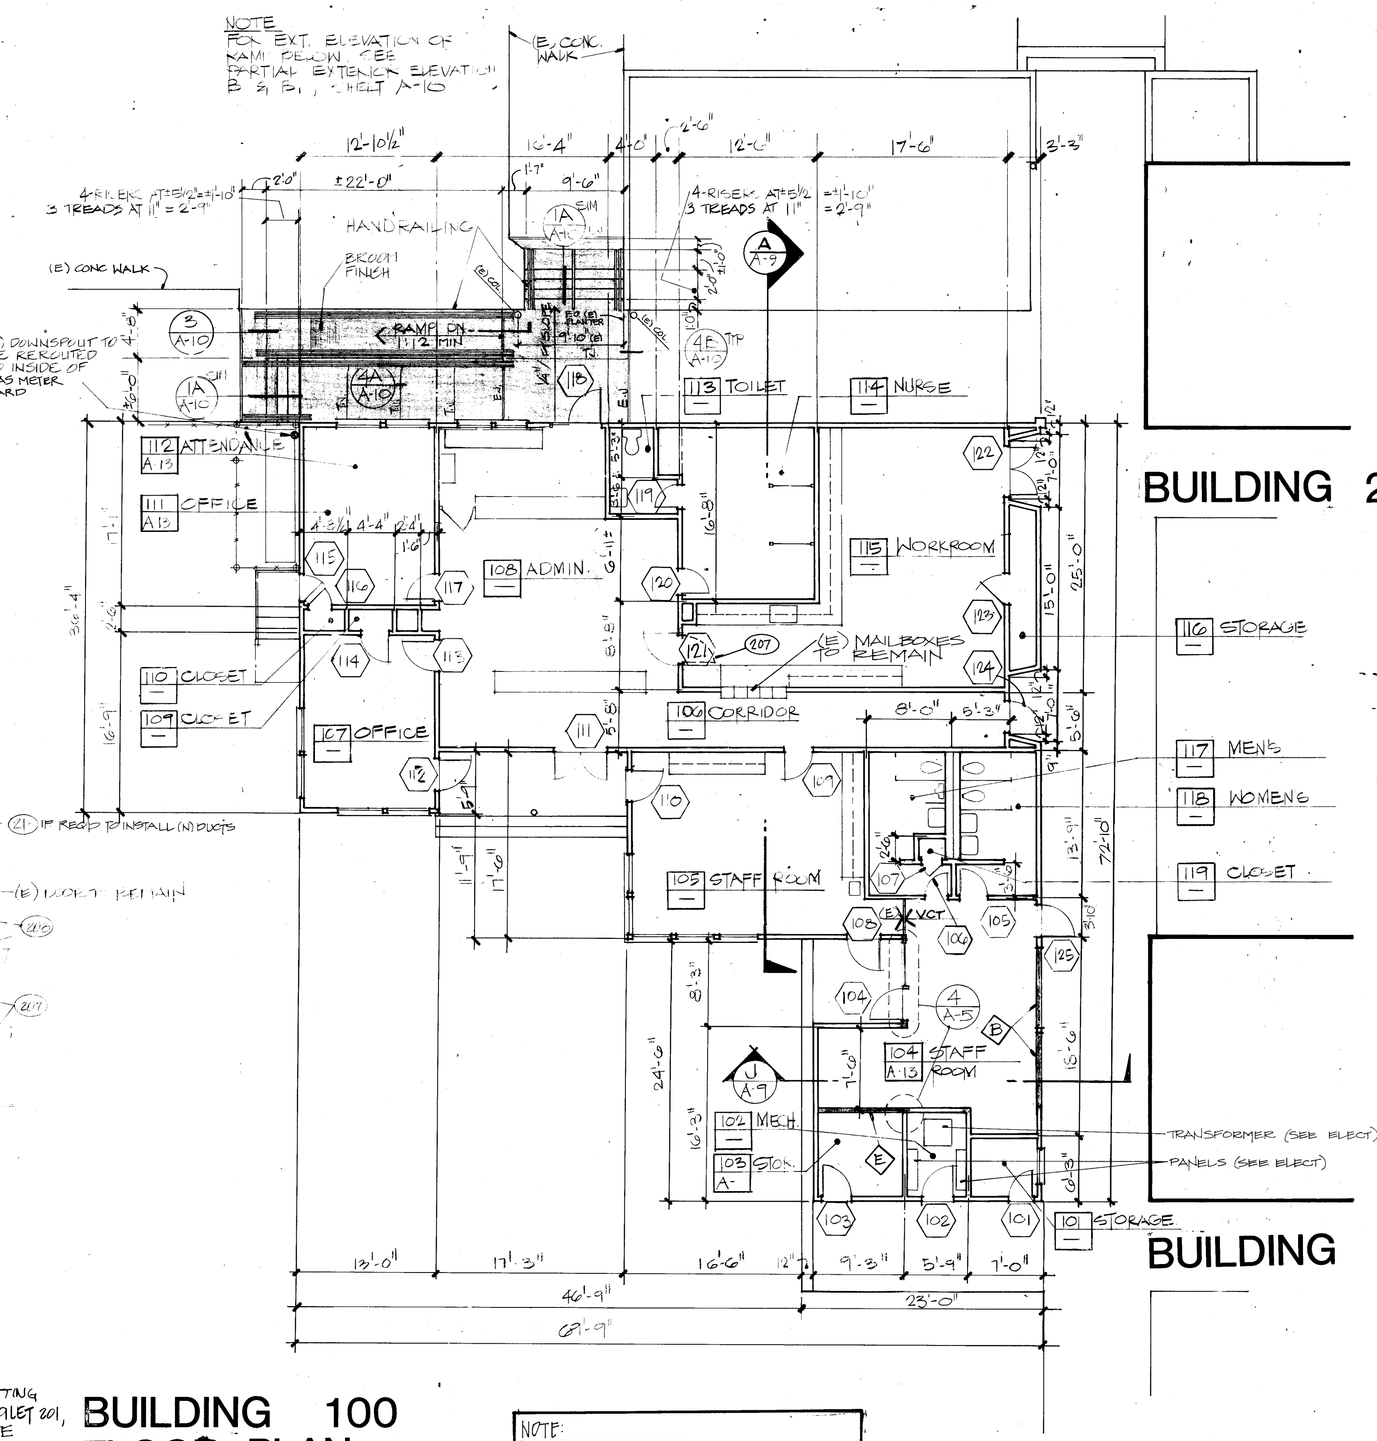

BUILDING 100
FLOOR PLAN

BUILDING 200

BUILDING 300

NOTE:
ALL DEMOLITION & CONSTRUCTION WORK SHOWN FOR BUILDING 100 EXCEPT NEW HANDICAP RAMP, NEW DOOR HARDWARE AND FIRE ALARM SYSTEM ARE ALTERNATE # 1

201	SAWCUT AND REMOVE (E) CONCRETE STEPS AND WALK WHERE SHOWN
202	SAWCUT AND REMOVE (E) CONC. RAMP AS SHOWN
203	REMOVE (E) WALL FOR NEW OPENING
204	NOT USED
205	REMOVE (E) CABINETS OR SHELVES, TURN OVER TO OWNER
206	
207	REMOVE (E) DOOR, FRAME AND HARDWARE
208	REMOVE (E) WALL SHOWN DASHED
209	REMOVE PORTION OF (E) FURRING, SEE PLUMBING FOR CAPPING OF ANY (E) PLUMBING IN IT.
210	REMOVE WALL AS REQUIRED FOR NEW DOOR FRAME
211	REMOVE (E) SKYLIGHT. SEE DETAIL 2, SHEET A-12
212	REMOVE (E) TOILET PARTITIONS AND ALL ACCESSORIES IN ROOM
213	SEE PLUMBING FOR REMOVAL OF (E) TROUGH LAVATORIES
214	SEE PLUMBING FOR REMOVAL OF (E) WATER CLOSET
215	SEE PLUMBING FOR RELOCATED (E) WATER CLOSET
216	SEE PLUMBING FOR REMOVAL OF (E) FLOOR MOUNTED URINALS
217	NOT USED
218	REMOVE (E) CEILING FINISH. JOISTS TO REMAIN
219	SAWCUT AND REMOVE (E) 6" HIGH CONC. CURB. PATCH FLOOR WITH CONCRETE TO MATCH (E)
220	SAWCUT AND REMOVE (E) CONCRETE FLOOR WHERE SHOWN. PROVIDE (N) 4" THICK CONCRETE FLOOR TO SLOPE TO ENTRY DOOR TO ALLOW NEW TILE FLOOR ON MORTAR BED TO BE FLUSH WITH ENTRY.
221	REMOVE AND REPLACE (E) GLASS OR PLYWOOD IN (E) WINDOWS WITH PATTERNED GL.
222	SAWCUT & REMOVE (E) CONCRETE FLOOR WHERE SHOWN. PROVIDE (N) 4" THICK CONCRETE FLOOR, DEPRESSED 2" FOR (N) TILE ON MORTAR BED
223	NOT USED
224	NEW WATER CLOSET SHOWN SHADED. SEE PLUMBING
225	4'-9" DEEP TOILET PARTITION. LOCATE SAME POSITION AS THOSE PREVIOUSLY REMOVED
226	NEW LAVATORIES SHOWN SHADED, SEE PLUMBING
227	NEW URINALS. SEE PLUMBING
228	RECESSED PAPER TOWEL DISPENSER AND WASTE RECEPTACLE
229	SURFACE MOUNTED MULTI-ROLL TOILET TISSUE DISPENSER
230	PARTITION MOUNTED MULTI-ROLL TOILET TISSUE DISPENSER (SERVES TWO COMPARTMENTS
231	36 X 48 GRAB BAR
232	SURFACE MOUNTED SANITARY NAPKINS DISPOSAL
233	PARTITION MOUNTED SANITARY NAPKINS DISPOSAL FOR TWO TOILET COMPARTMENTS
234	NOT USED
235	(E) WATER CLOSETS TO BE REMOVED FOR NEW TILE FLOOR. RELOCATE AT SAME LOCATION. SEE PLUMBING.
236	NEW DOOR AND FRAME. SEE 1/8" SCALE BUILDING PLANS FOR DOOR NUMBER
237	REMOVE (E) WALL FINISH ON ALL WALLS IN ROOM OR WHERE SHOWN DASHED
238	NOT USED
239	NOT USED
240	NOT USED
241	REMOVE (E) TACK BD ON WALL AND TURN OVER TO OWNER

Application No. 77/50602

approved

C.B.J./L.H.

C • 3269
C • 3132
S • 6564

D.R. CARTNAL

© copyrighted 1989

bfgc inc.
architects planners
31 south real road box 9698
bakersfield california 93309
805 832 8122

FLOOR PLAN - BUILDING 100 / DEMOLITION PLAN - BUILDING 100 / TOILET ROOM PLANS, H.C. RAMP 1/8"=1'-0" 1/4"=1'-0"

M.T. VERNON MODERNIZATION
BAKERSFIELD CITY SCHOOL DISTRICT
2161 POTOMAC AVENUE
BAKERSFIELD, CALIFORNIA 93307

job 87-127

date 1 FEB. 89

sheet A2

bfgc architects planned - sketches