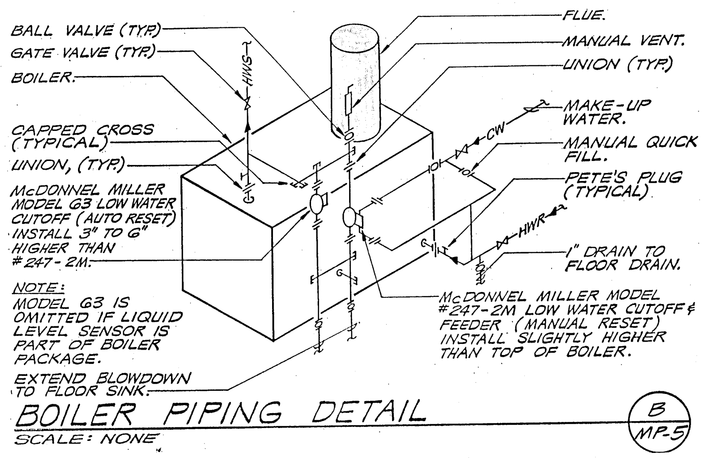

BOILER PIPING DETAIL

SCALE: NONE

B / MP-5

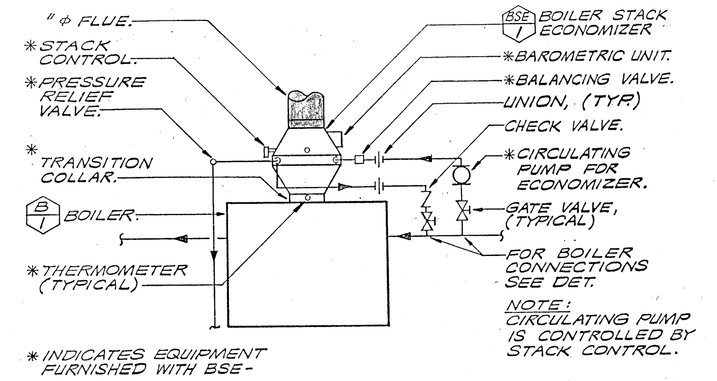

* INDICATES EQUIPMENT FURNISHED WITH BSE -

BOILER STACK ECONOMIZER

SCALE: NONE

A / MP-5

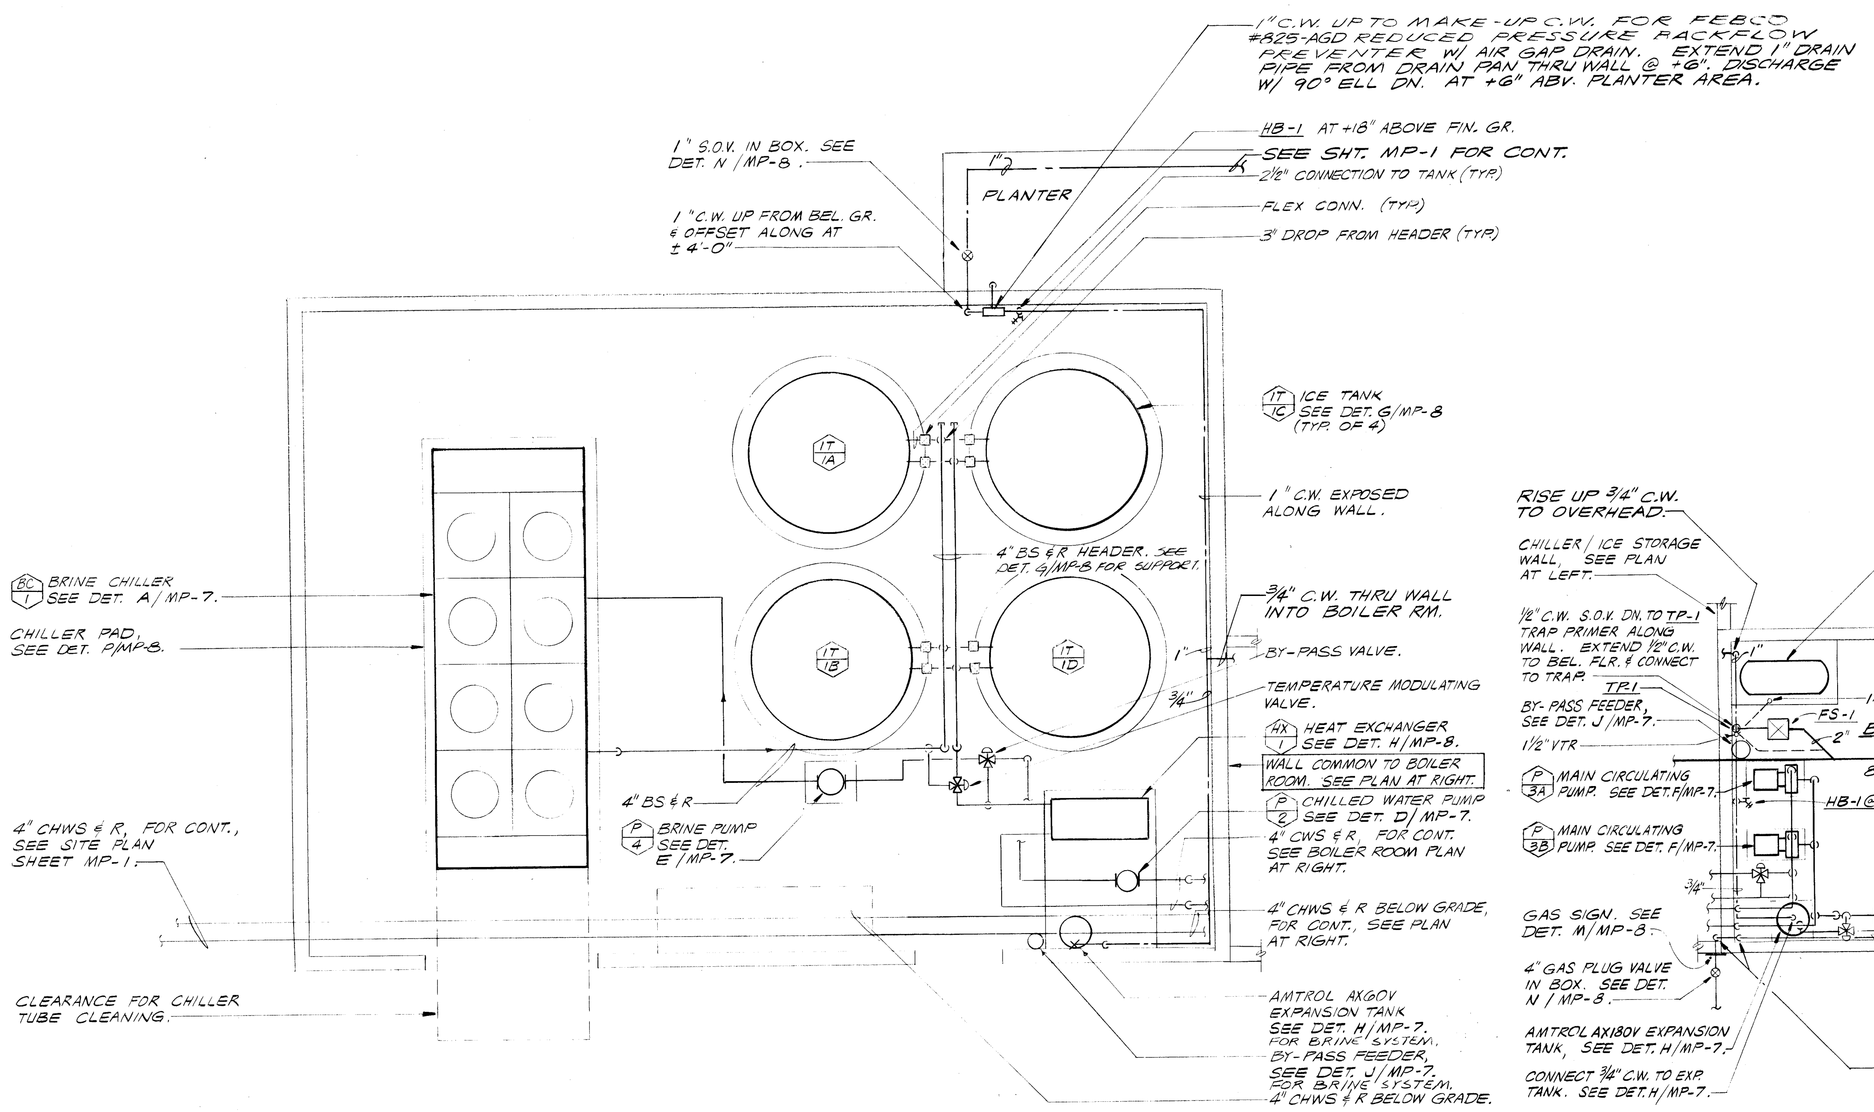

CHILLER / ICE STORAGE YARD PLAN

SCALE: 1/4" = 1'-0"

N

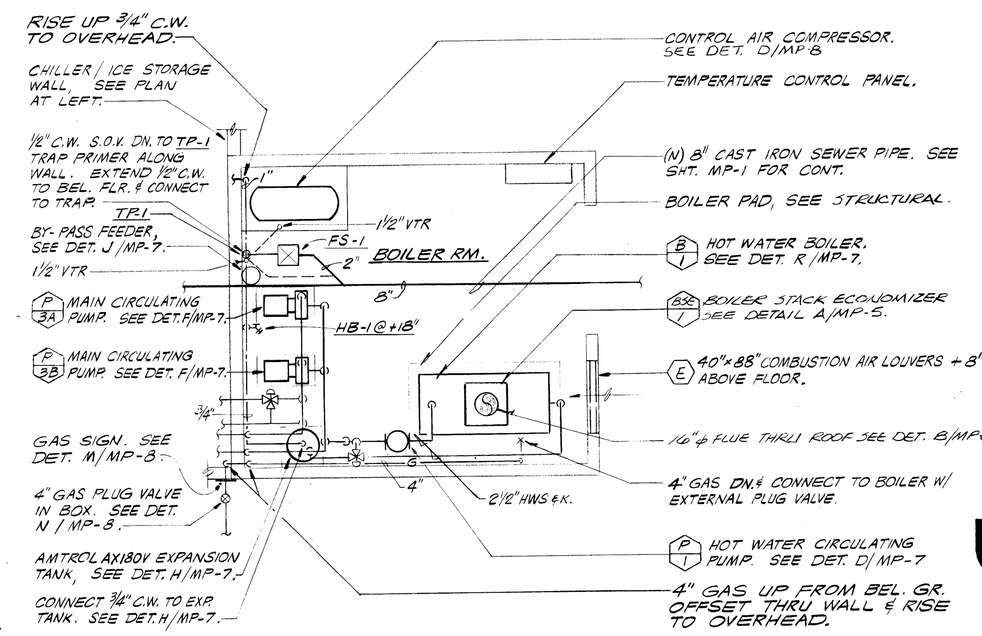

BOILER ROOM PLAN

SCALE: 1/4" = 1'-0"

N

approved

Donald R. Lawrence & Associates
CONSULTING MECHANICAL ENGINEERS, INCORPORATED
1300 N. Shaw Avenue, Suite 2B — Fresno, CA 93711
(209) 226-0101 — ME11064 — FAX-209-224-6327

C • 3269
C • 3132
MC • 6564

© copyrighted 1989

bfgc inc.
architects planners
31 south real road box 9698
bakersfield california 93309
805 832 8122

CHILLER/ICE STORAGE YARD PLAN & BOILER ROOM PLAN SCALE: 1/4" = 1'-0"

MT. VERNON MODERNIZATION
BAKERSFIELD CITY SCHOOL DISTRICT
2161 POTOMAC AVENUE
BAKERSFIELD, CALIFORNIA 93307

job 87-126

date FEB 89

sheet MP-5

planned - architects
bfgc