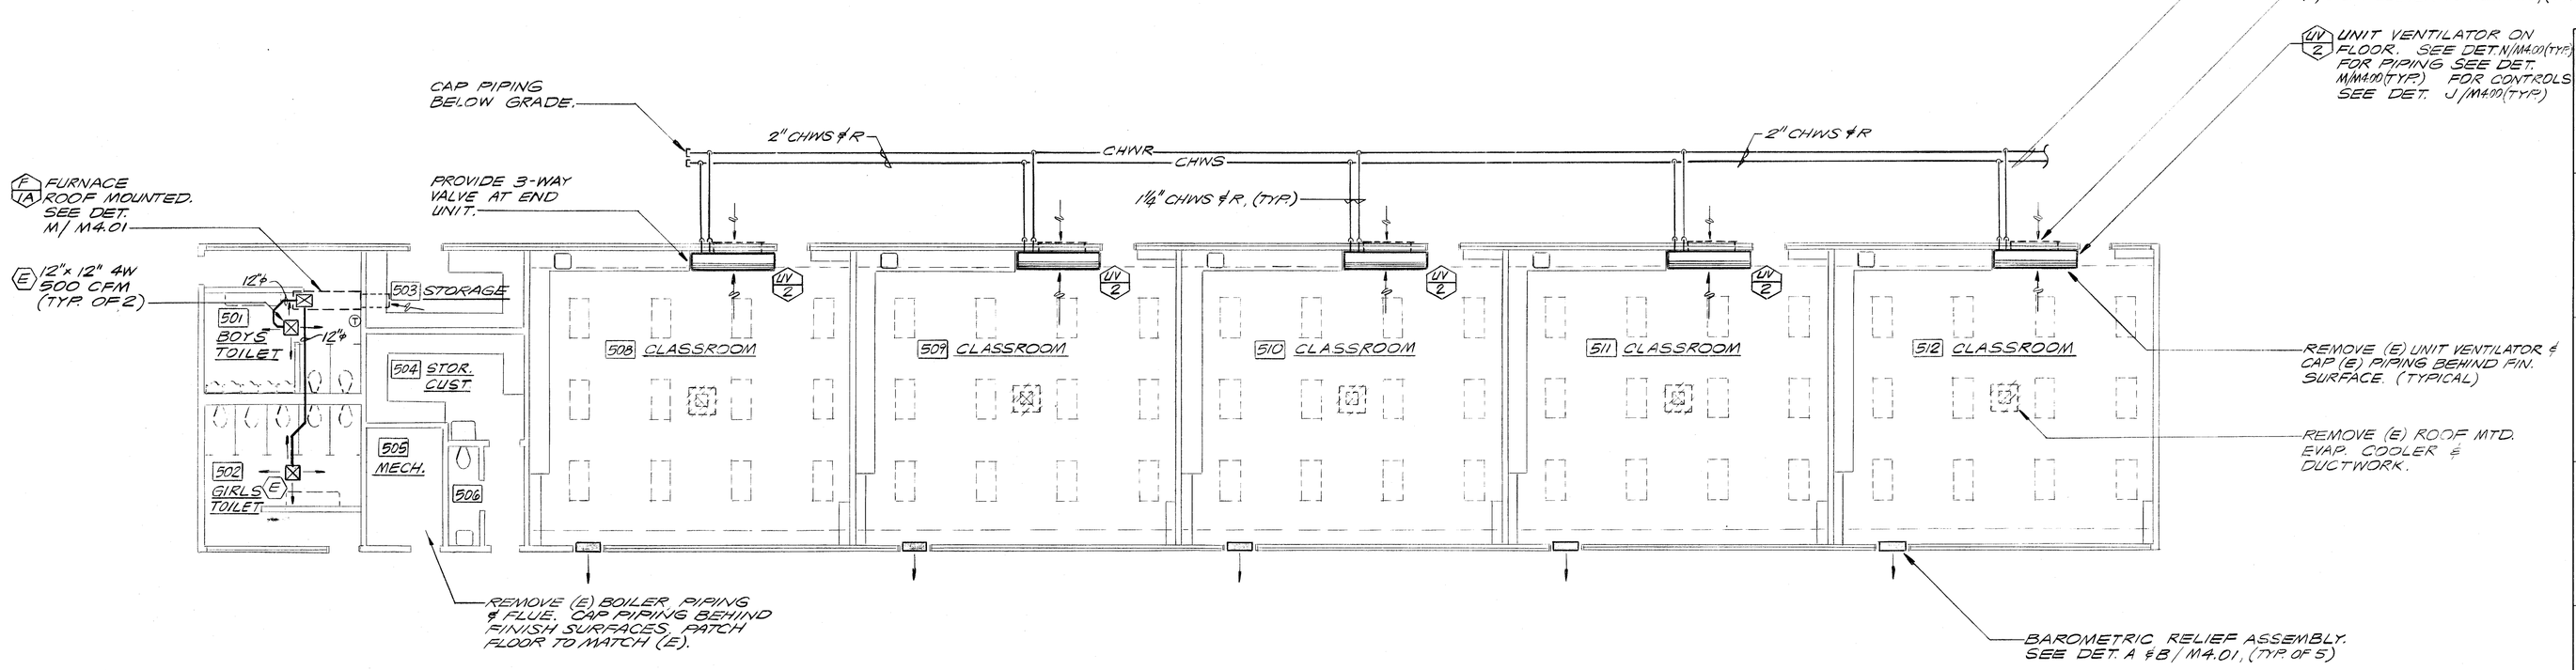

BUILDING 500

AIR CONDITIONING PLAN

SCALE: 1/8"=1'-0"

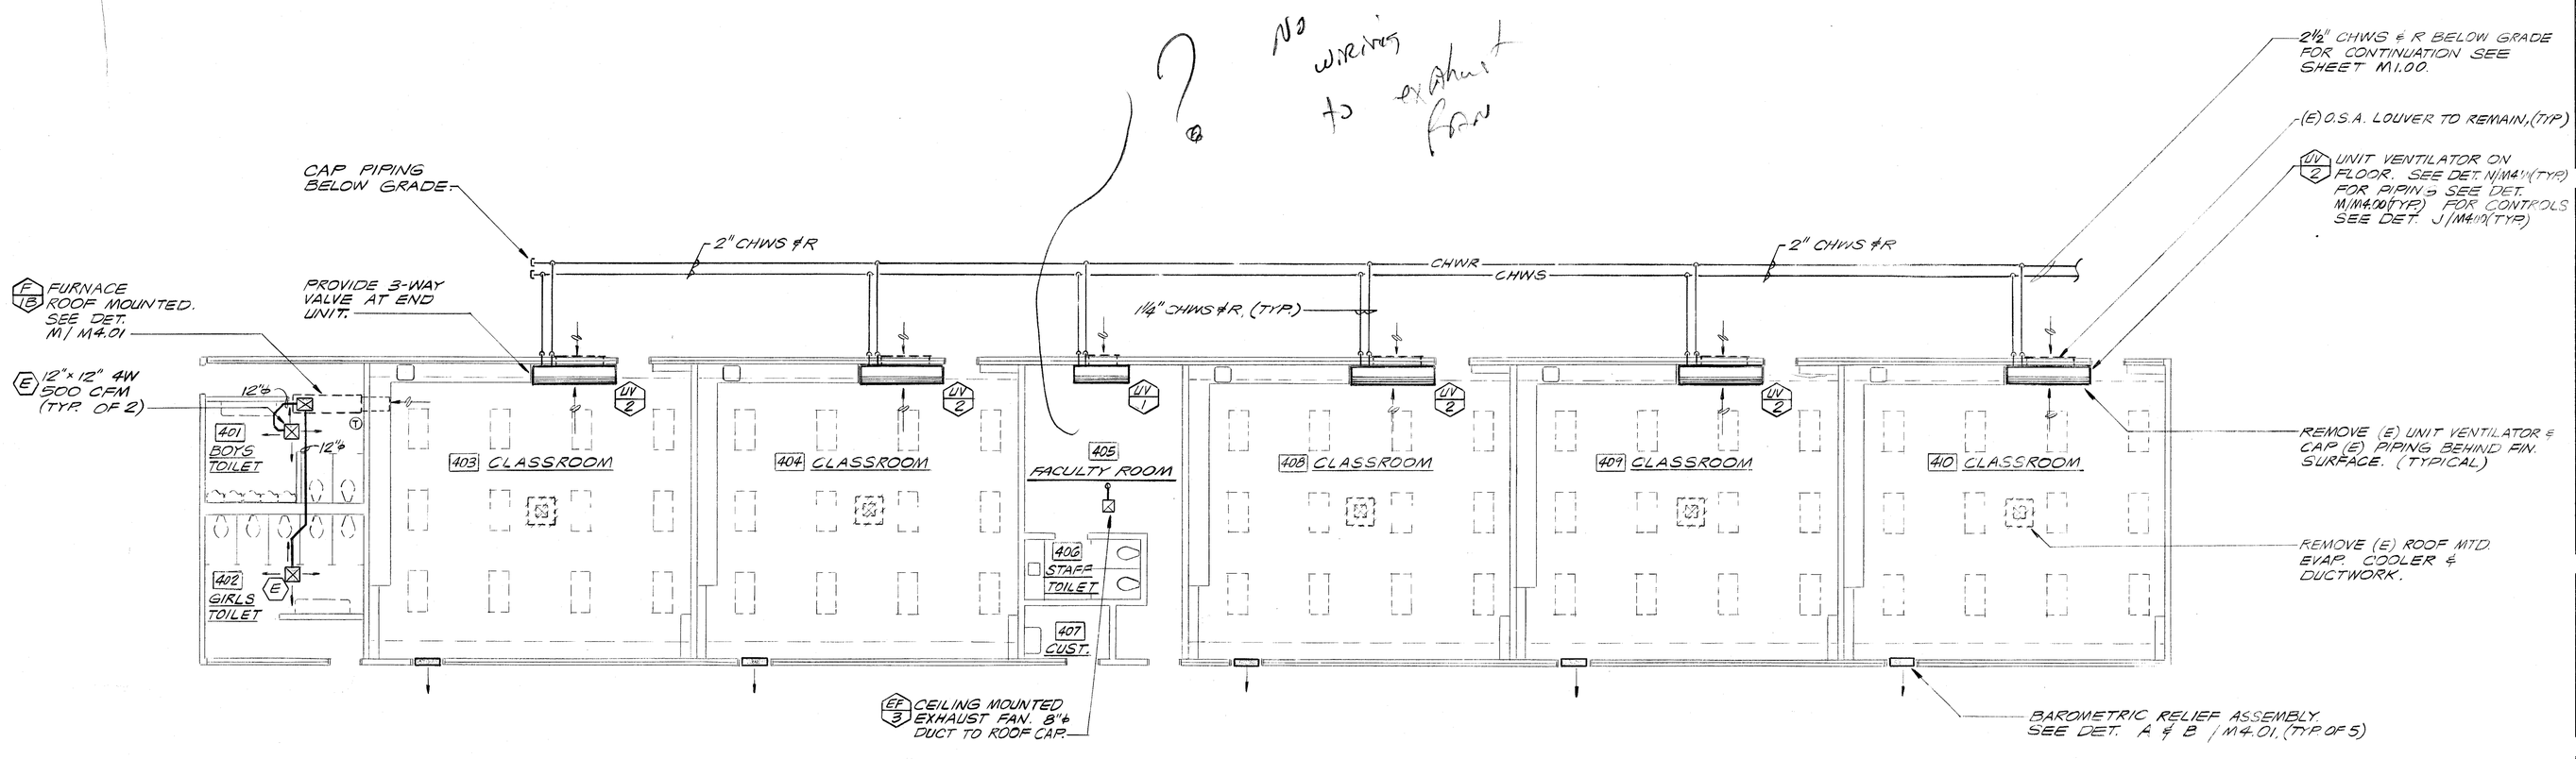

BUILDING 400

AIR CONDITIONING PLAN

SCALE: 1/8"=1'-0"

bfgc

u/c

Donald R. Lawrence & Associates
CONSULTING MECHANICAL ENGINEERS, INCORPORATED
1300 W. Shaw Avenue, Suite 2B Fresno, CA 93711
(209) 226-0101 ME11064 FAX-209-224-6327

ROOSEVELT SCHOOL MODERNIZATION

FOR

BAKERSFIELD CITY SCHOOL DISTRICT

BUILDINGS 400 & 500 AIR CONDITIONING PLAN

bfgc architects planners inc.
p.o. box 9698 bakersfield california 93389–9698
31 south real road 93309 (805) 832 8122
C–3132 C–6564 C–8021 C–8702

job no.	
date	
drawn by	D. ENNS
chk'd by	G. NYE
copyright	

M 2.03