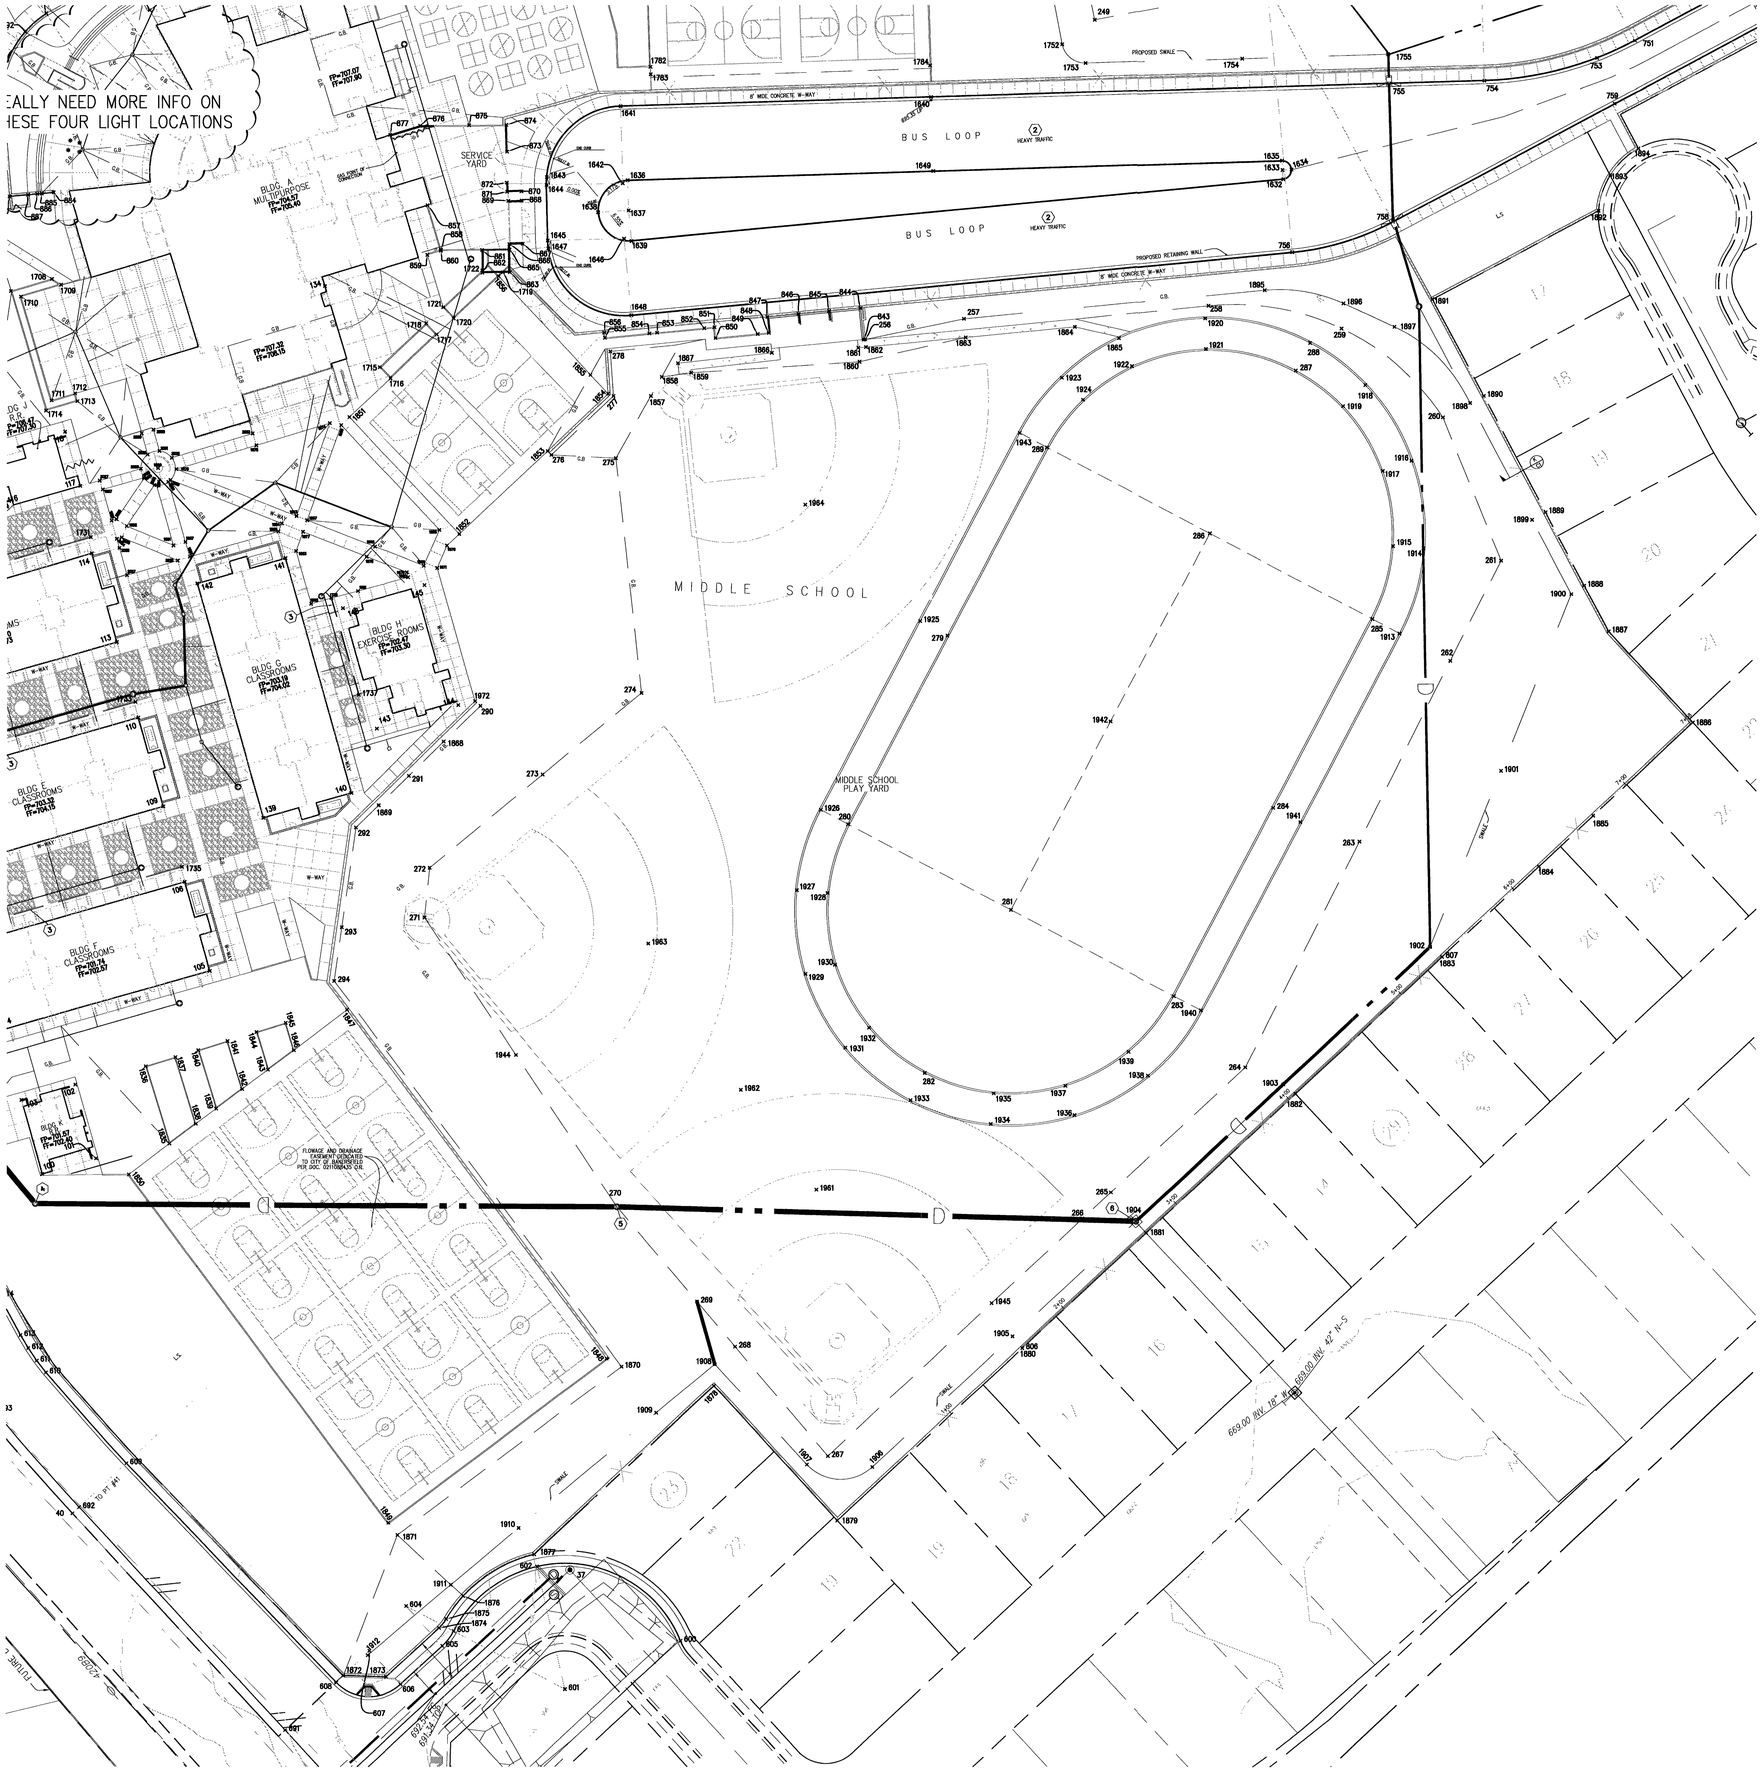

P:\PROJECTS\12007-BCSD\X-proj\dwg\12007PN01.dwg, 10/1/2013 6:58:22 AM, swalker, 1:40