



*D. Ordiz*  
DANNY E. ORDIZ, AIA  
ARCHITECT C-14,728  
WILLIAM J. MELBY, AIA  
ARCHITECT C-16,835  
CONSULTANT



**RFI 139**  
Request:  
RDM Electric - 9/18/12  
Reference Sheets E-122C, E-122D, E-122E, E-122F, E-122G, E-122H & E-122P  
in the classroom buildings (C.D., E., G., N. & P), the electrical plans show fused  
disconnects to be installed for the fan coils. Due to the fan coil and ductwork,  
there is not enough room to install the disconnects inside the mechanical  
closets. Please advise on an alternate location for the fused disconnects for  
the fan coils located in the classrooms of Buildings C, D, E, F, G, N & P.  
Answer:  
John Maloney - JMPE - 10/2/12  
It is acceptable to mount the specified fused disconnects above the ceiling.

IDENTIFICATION STAMP  
DIVISION OF STATE ARCHITECT  
OFFICE OF REGULATION SERVICES  
APPL. # : 02-112027  
FILE # : 15-6  
AC: *[Signature]* SS: *[Signature]*  
DATE: 1/18/12


NEW ELEMENTARY SCHOOL  
9801 HIGHLAND KNOLLS DR  
BAKERSFIELD  
CALIFORNIA  
93306

NEW MIDDLE SCHOOL  
4115 VINELAND ROAD  
BAKERSFIELD  
CALIFORNIA  
93306

FOR:  
BAKERSFIELD CITY SCHOOL  
DISTRICT  
1300 BAKER STREET  
BAKERSFIELD  
CALIFORNIA  
93305

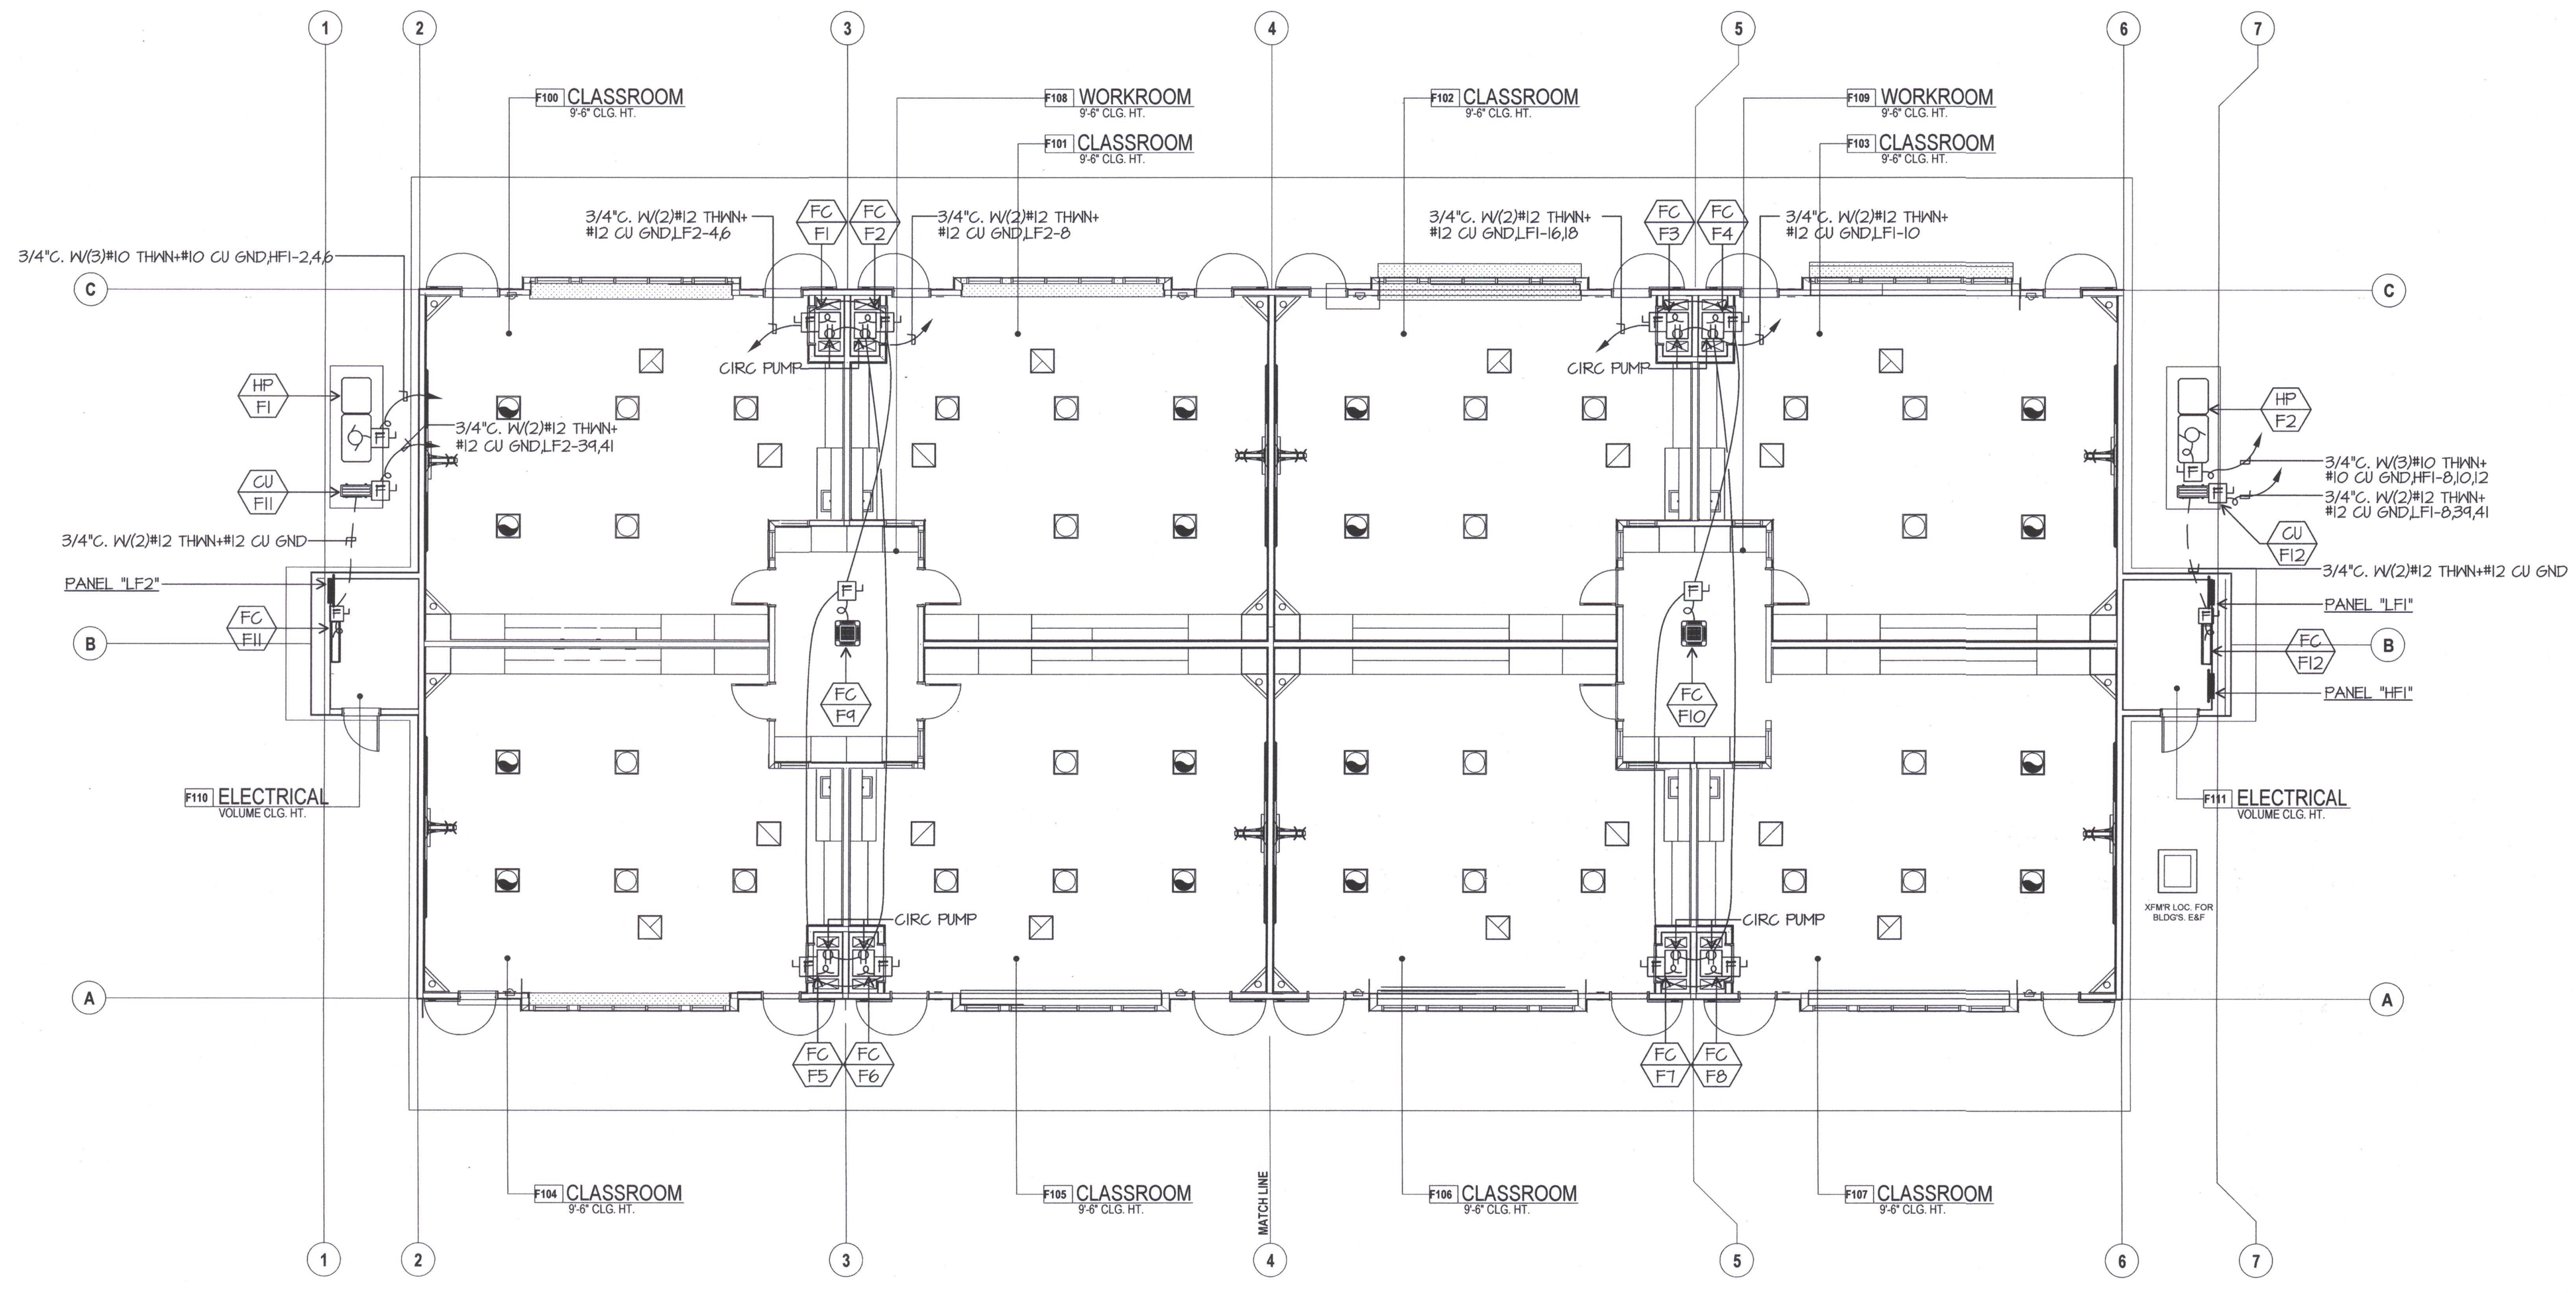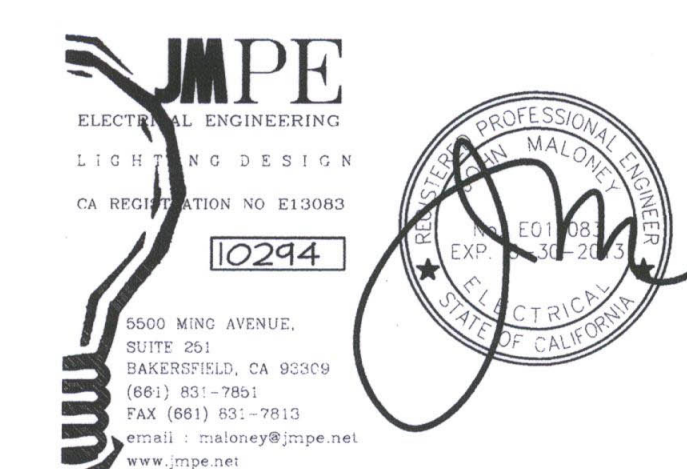

ELECTRICAL MECHANICAL PLAN BUILDING F

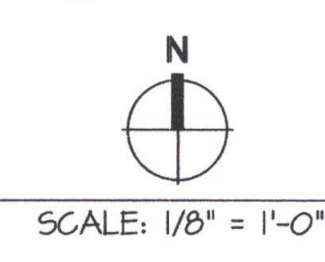

| MARK | DATE | DESCRIPTION |
|------|------|-------------|
| △    |      |             |
| △    |      |             |
| △    |      |             |
| △    |      |             |

JOB NUMBER:  
20101244  
CAD DRAWING FILE:  
DRAWN BY:  
AC  
CHECKED BY:  
PH

CHECK AND VERIFY ALL DIMENSIONS BEFORE  
PROCEEDING WITH THE WORK.  
REPORT DISCREPANCIES TO THE ARCHITECT.  
THE DRAWINGS, IDEAS, AND DESIGNS  
REPRESENTED ON THIS SHEET ARE THE  
PROPERTY OF THE ARCHITECT.

COPYRIGHT  
ORDIZ MELBY ARCHITECTS, INC. 2010  
SHEET TITLE  
ELECTRICAL MECHANICAL  
PLAN BUILDING F

SHEET IDENTIFICATION NUMBER  
E-122F  
SHEET OF

M:\E\122F\1024\DATE\12-20-11 AC