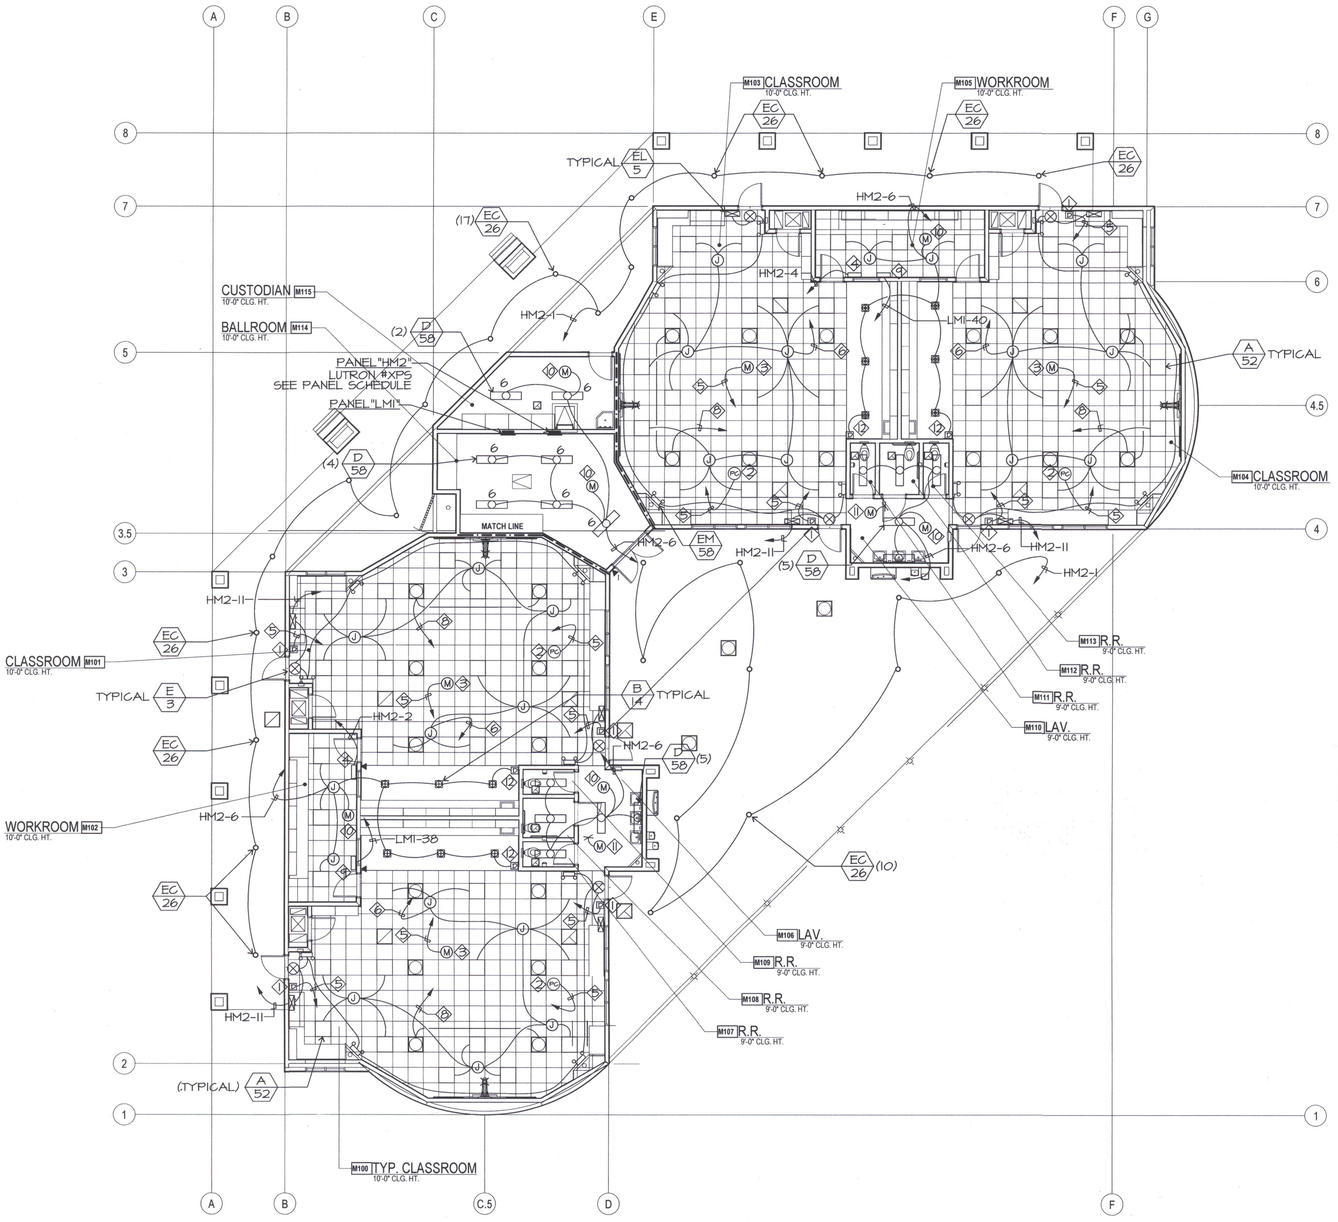

LIGHTING PLAN NOTES

1. LUTRON WALL CONTROL STATION #DN-X-WH
2. LUTRON PHOTO SENSOR #DN-PS-WH
3. LUTRON MOTION SENSOR #DN-MS-WH
4. LUTRON ENERGI SAVR NODE #DN-277V-0/10V-WH
5. LV CABLE TO ENERGI SAVR NODE
6. HOMERUN VIA ENERGI SAVR NODE
7. CONNECT SKYLIGHT MOTORIZED SHUTTER
8. HOMERUN VIA ENERGY SAVR SWITCH
9. LUTRON ENERGI SAVR NODE SWITCH #DN-120V-SW-WH
10. SENSOR SWITCH #CMR-PDT-277-WH
11. SENSOR SWITCH #CMR-PDT-WH CONNECT EF
12. 0-10V DIMMER. LUTRON #DVSCTV-WH
13. AT WALLS ABLE TO RESIST THE PASSAGE OF SMOKE, CAULK ALL PENETRATIONS.

LINE TYPE	WALL TYPE
13	SMOKE SEPARATION

PRFI O-M LM M0014 Room M103 Symbol at Door CLO 2/14/2012 2/14/2012 2/21/2012

A-C Electric - 2/14/12 — John Maloney - JMPE Electrical Engineering & Lighting Design - 2/14/12

Sheet E-132M, Room M103, should there be a (D) <1> next to this door? Yes.

REQUEST:
RDM Electric - 10/9/12

Reference Sheets A131M & E-132M

RFI 167

The Electrical Lighting Plan layouts shown for Rooms M108, M109, M110, M111, M112 and M113 differ from those locations shown on the Architectural Reflected Ceiling Plan. Please advise on which lighting layouts are correct for these (6) rooms.

ANSWER:
Joseph W. Covington - Ordiz-Melby (10/11/12)

E-132M

FI O-M LM 00378 DC Switching for Classroom Solatube CLO 9/18/2013 9/20/2013 9/25/2013

RDM Electric - 9/18/13 — John Maloney - JMPE - 9/18/13

RFI 378

Reference RFI #292 & Sheets E132C, E132D, E132E, E132F, E132G, E132M, E132N & E132P
Per the response to RFI #292, the solatubes in the classrooms are to be controlled via an Energi Savr Node. However, per the attached cut sheets, the solatubes appear to need separate DC switching to be controlled, which is not shown on the drawings. The plans only show to supply 120V to the solatubes via the Energi Savr Nodes. Do the classrooms need DC switching to be added as a means of controlling the solatubes? If so, please advise on the requirements.

Contact closure on Energi Savr Node will operate solatube shutter. Wire verified this with Solatube and Lutron.

LIGHTING PLAN BUILDING M

SCALE: 1/8" = 1'-0"

ORDIZ MELBY
ARCHITECTS, INC.

5500 MING AVENUE SUITE 280
BAKERSFIELD, CALIFORNIA 93309
TELEPHONE (661) 832-5258
FACSIMILE (661) 832-4291

LICENSED ARCHITECT DANNY ESPINEDA ORDIZ No. C- 14728 MAY 31, 2013 RENEWAL DATE STATE OF CALIFORNIA

DANNYE ORDIZ, AIA
ARCHITECT C-14,728

WILLIAM J. MELBY, AIA
ARCHITECT C-16,835

CONSULTANT

IDENTIFICATION STAMP
DIVISION OF STATE ARCHITECT
OFFICE OF REGULATION SERVICES
APPL. # : 02-112027
FILE # : 15-6
AC. ____ FLS ____ SS ____
DATE JAN 2 0 2012

NEW ELEMENTARY SCHOOL
9801 HIGHLAND KNOLLS DR
BAKERSFIELD
CALIFORNIA
93306

NEW MIDDLE SCHOOL
4115 VINELAND ROAD
BAKERSFIELD
CALIFORNIA
93306

FOR:

DISTRICT
1300 BAKER STREET
BAKERSFIELD
CALIFORNIA
93305

JMPE
ELECTRICAL ENGINEERING
LIGHTING DESIGN
CA REGISTRATION NO E13083
10294
5500 MING AVENUE,
SUITE 251
BAKERSFIELD, CA 93309
(661) 831-7851
FAX (661) 831-7813
email : maloney@jmpe.net
www.jmpe.net

LICENSED ELECTRICAL ENGINEER JOHN MALONEY No. E13083 CERTIFICATE EXPIRES 08/31/2013 STATE OF CALIFORNIA

MARK	DATE	DESCRIPTION

JOB NUMBER:
20101244
CAD DRAWING FILE:

DRAWN BY:
AC
CHECKED BY:
PH

CHECK AND VERIFY ALL DIMENSIONS BEFORE PROCEEDING WITH THE WORK. REPORT DESCREPANCIES TO THE ARCHITECT.

THE DRAWINGS, IDEAS, AND DESIGNS REPRESENTED ON THIS SHEET ARE THE PROPERTY OF THE ARCHITECT.

COPYRIGHT
ORDIZ-MELBY ARCHITECTS, INC. 2010

SHEET TITLE
LIGHTING PLAN
BUILDING M

SHEET IDENTIFICATION NUMBER
E-132M
SHEET OF

M:\PE\JOB#\10294\DATE\12-27-11 AC