


MATCHLINE, SEE SHEET E

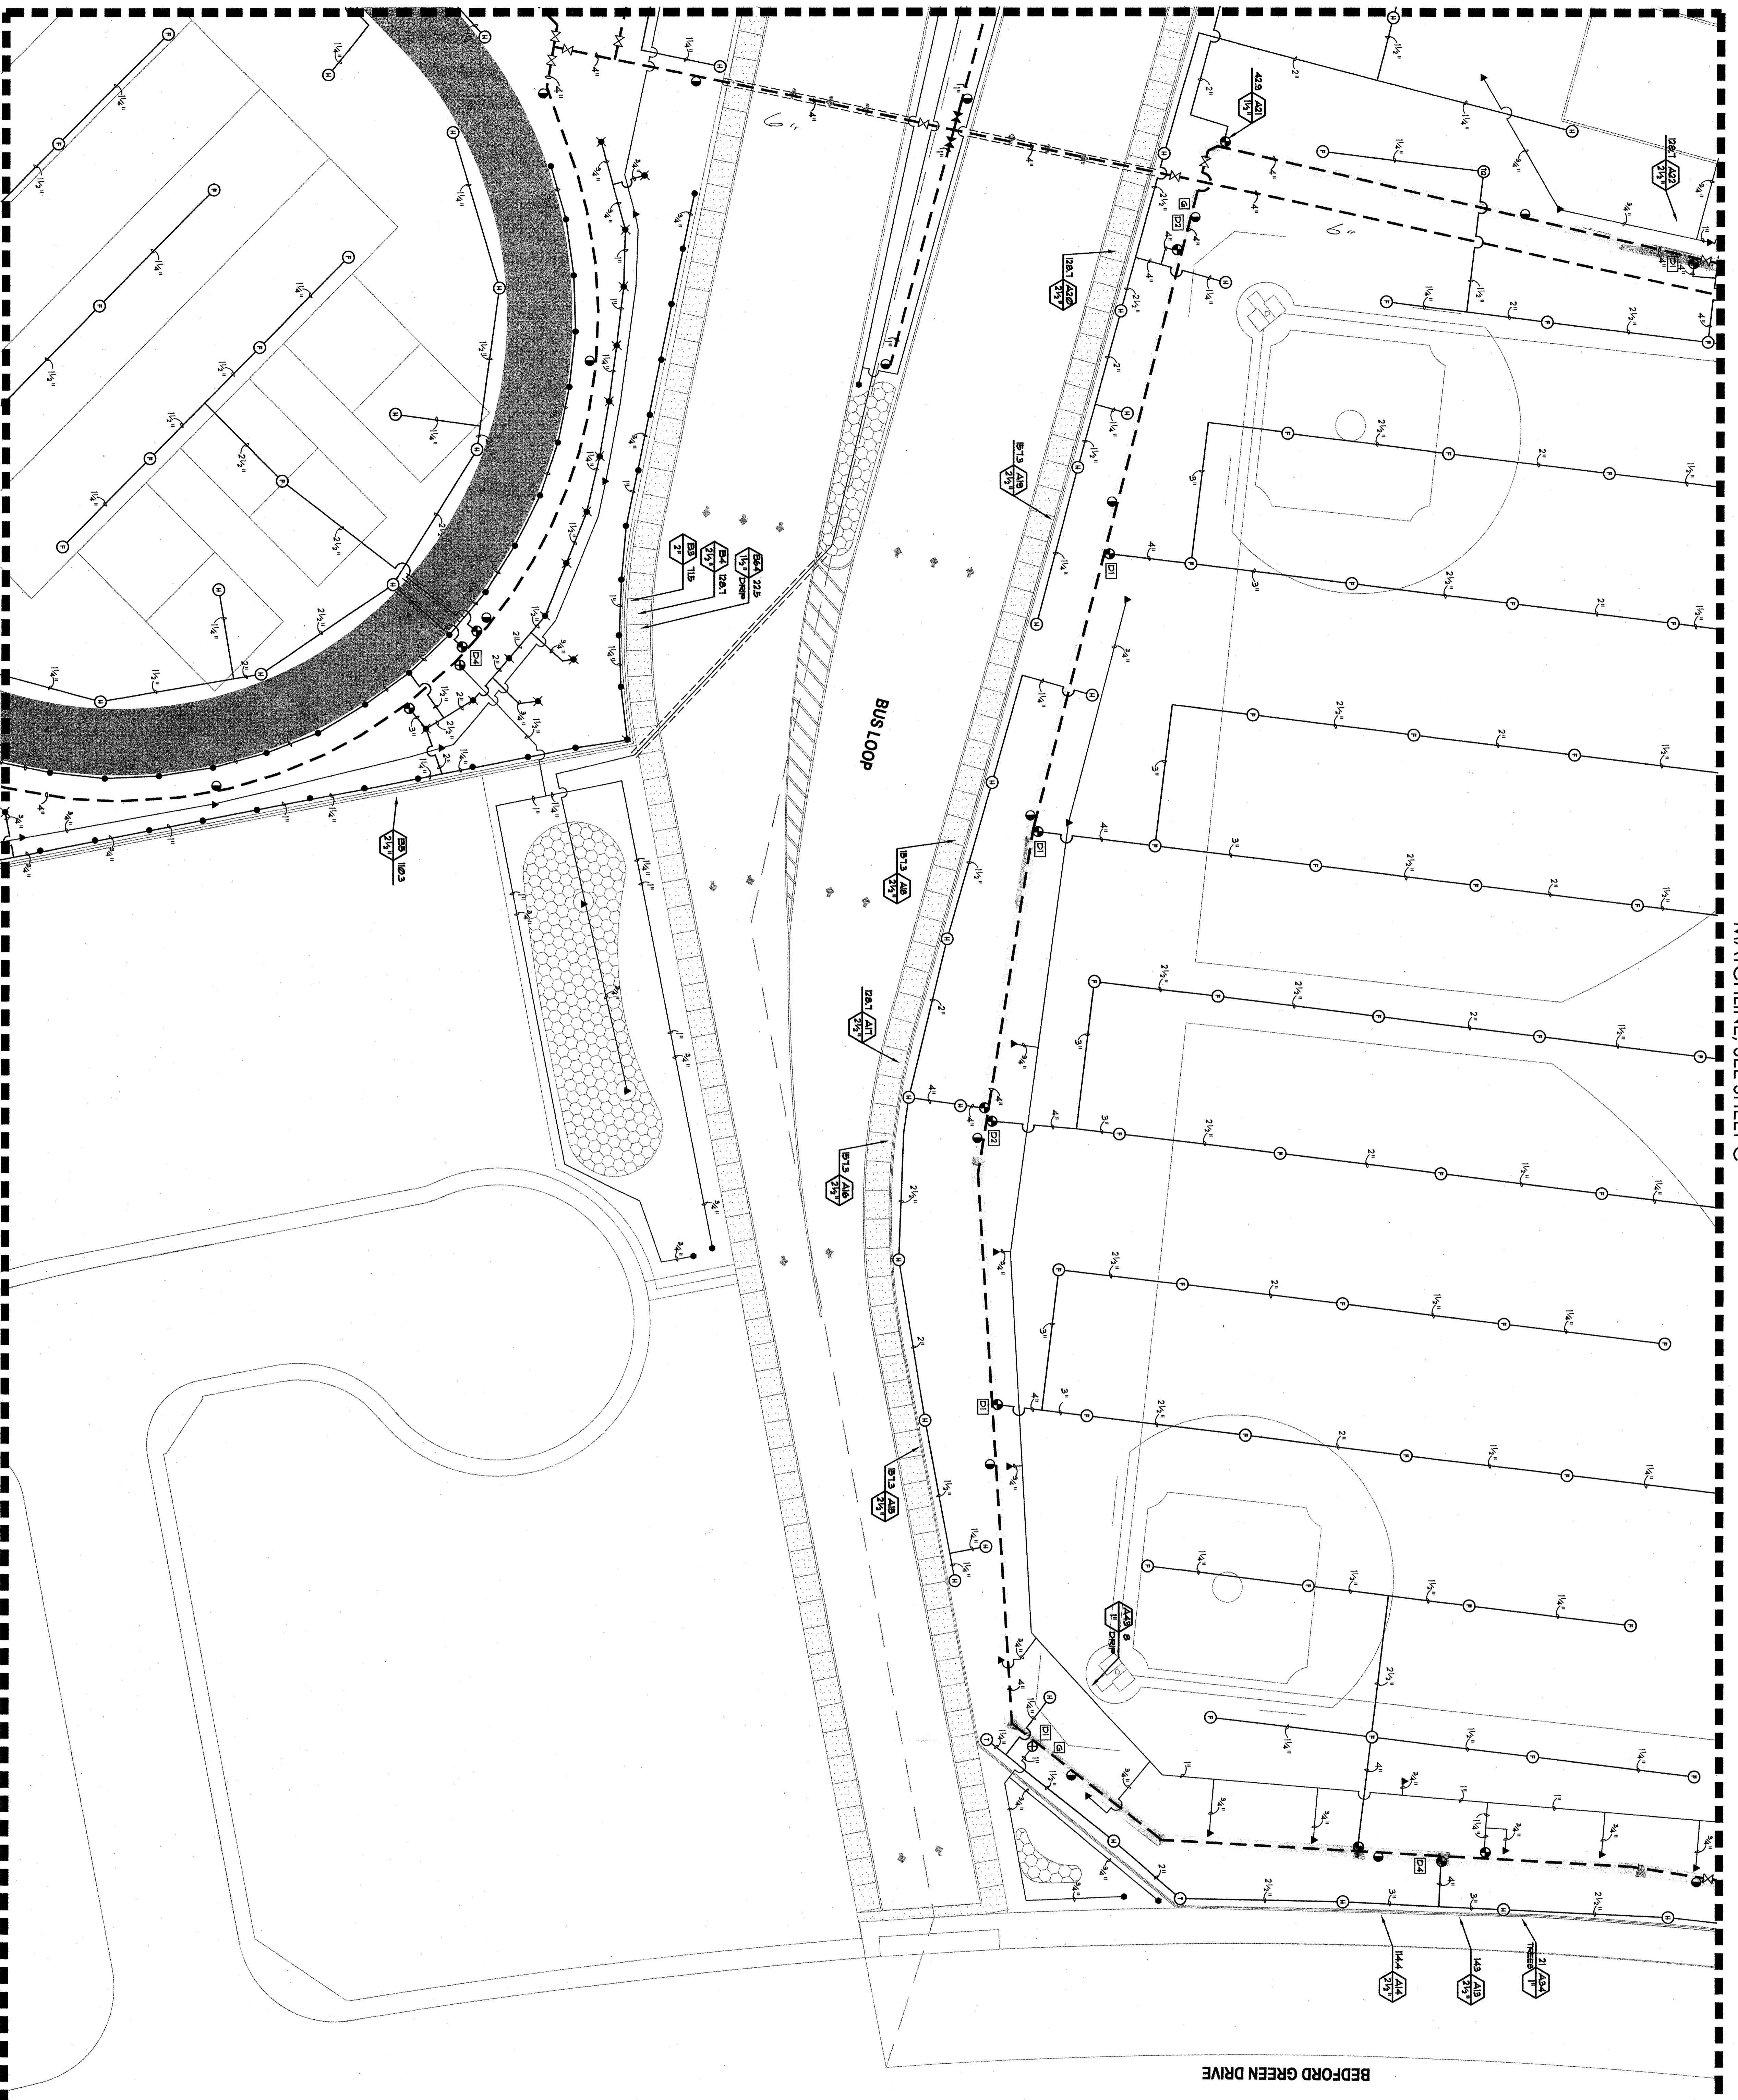


MATCHLINE, SEE SHEET C

MATCHLINE, SEE SHEET I

**VALVE IDENTIFICATION KEY**

|                        |              |
|------------------------|--------------|
| VALVE STATION NUMBER   | VALVE G.P.M. |
| CONTROLLER DESIGNATION |              |
| VALVE SIZE             |              |

**NOTES**  
 REFER TO SHEET L10 FOR IRRIGATION LEGEND AND NOTES  
 REFER TO SHEET L11, L12 & L13 FOR IRRIGATION DETAILS

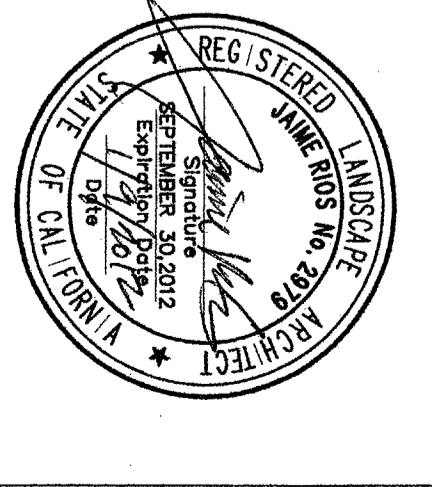

**ROS DESIGN STUDIO**  
 LANDSCAPE ARCHITECTURE & DESIGN  
 3801 ORA VISTA AVENUE  
 BAKERSFIELD, CALIFORNIA 93309  
 P: 661.833.9239  
 F: 661.837.5284

**ORDIZ MELBY ARCHITECTS, INC.**  
 5500 KING AVENUE SUITE 280  
 BAKERSFIELD, CALIFORNIA 93306  
 TELEPHONE (801) 852-5558  
 FACSIMILE (801) 852-4281

**IDENTIFICATION STAMP**  
 DIVISION OF STATE ARCHITECTS  
 OFFICE OF REGULATION SERVICES  
 APPL. #02-112027  
 FILE # 15-9  
 DATE JUN 2 0 2012  
 PTH # 8325-112

**FOR:**  
 NEW ELEMENTARY SCHOOL ROLLS DR  
 9801 HIGHWAY BAKERSFIELD CALIFORNIA 93306  
 NEW MIDDLE SCHOOL  
 4115 VINELAND ROAD CALIFORNIA 93306

**BAKERSFIELD CITY SCHOOL DISTRICT**  
 1300 BAKER STREET BAKERSFIELD CALIFORNIA 93305

| MARK | DATE | DESCRIPTION |
|------|------|-------------|
|      |      |             |
|      |      |             |
|      |      |             |
|      |      |             |
|      |      |             |

**JOB NUMBER:** 200701244  
**DATE:** 2007/01/24  
**DRAWN BY:** 1444ALDO A (MULTIPURPOSE)-DJA  
**CHECKED BY:**    
**DATE:**    
**SCALE:** 1"=20'

**ORIGIN AND REVISIONS:**  
 CHECK AND REVISION ALL DIMENSIONS BEFORE REPORT SUBMITTAL TO THE ARCHITECT.  
 THE DRAWINGS, DATA AND DESIGNING REPORT DOCUMENTATION IS THE PROPERTY OF THE ARCHITECT.  
 COPYRIGHT ARCHITECTS, INC. 2010  
 SHEET TITLE: IRRIGATION PLAN  
 SHEET IDENTIFICATION NUMBER: L7