
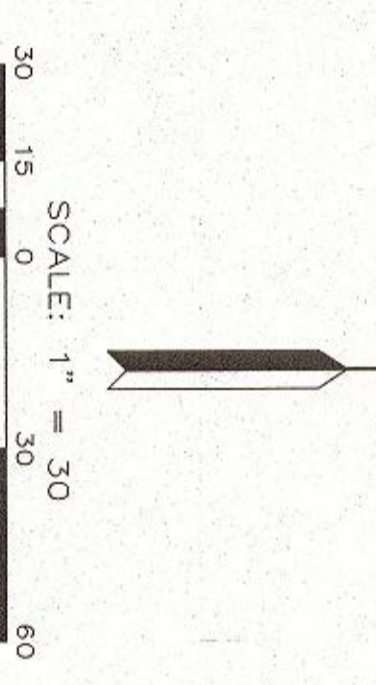


MATCH LINE - SEE SHEET C8

MATCH LINE - SEE SHEET C8

MATCH LINE - SEE SHEET C7

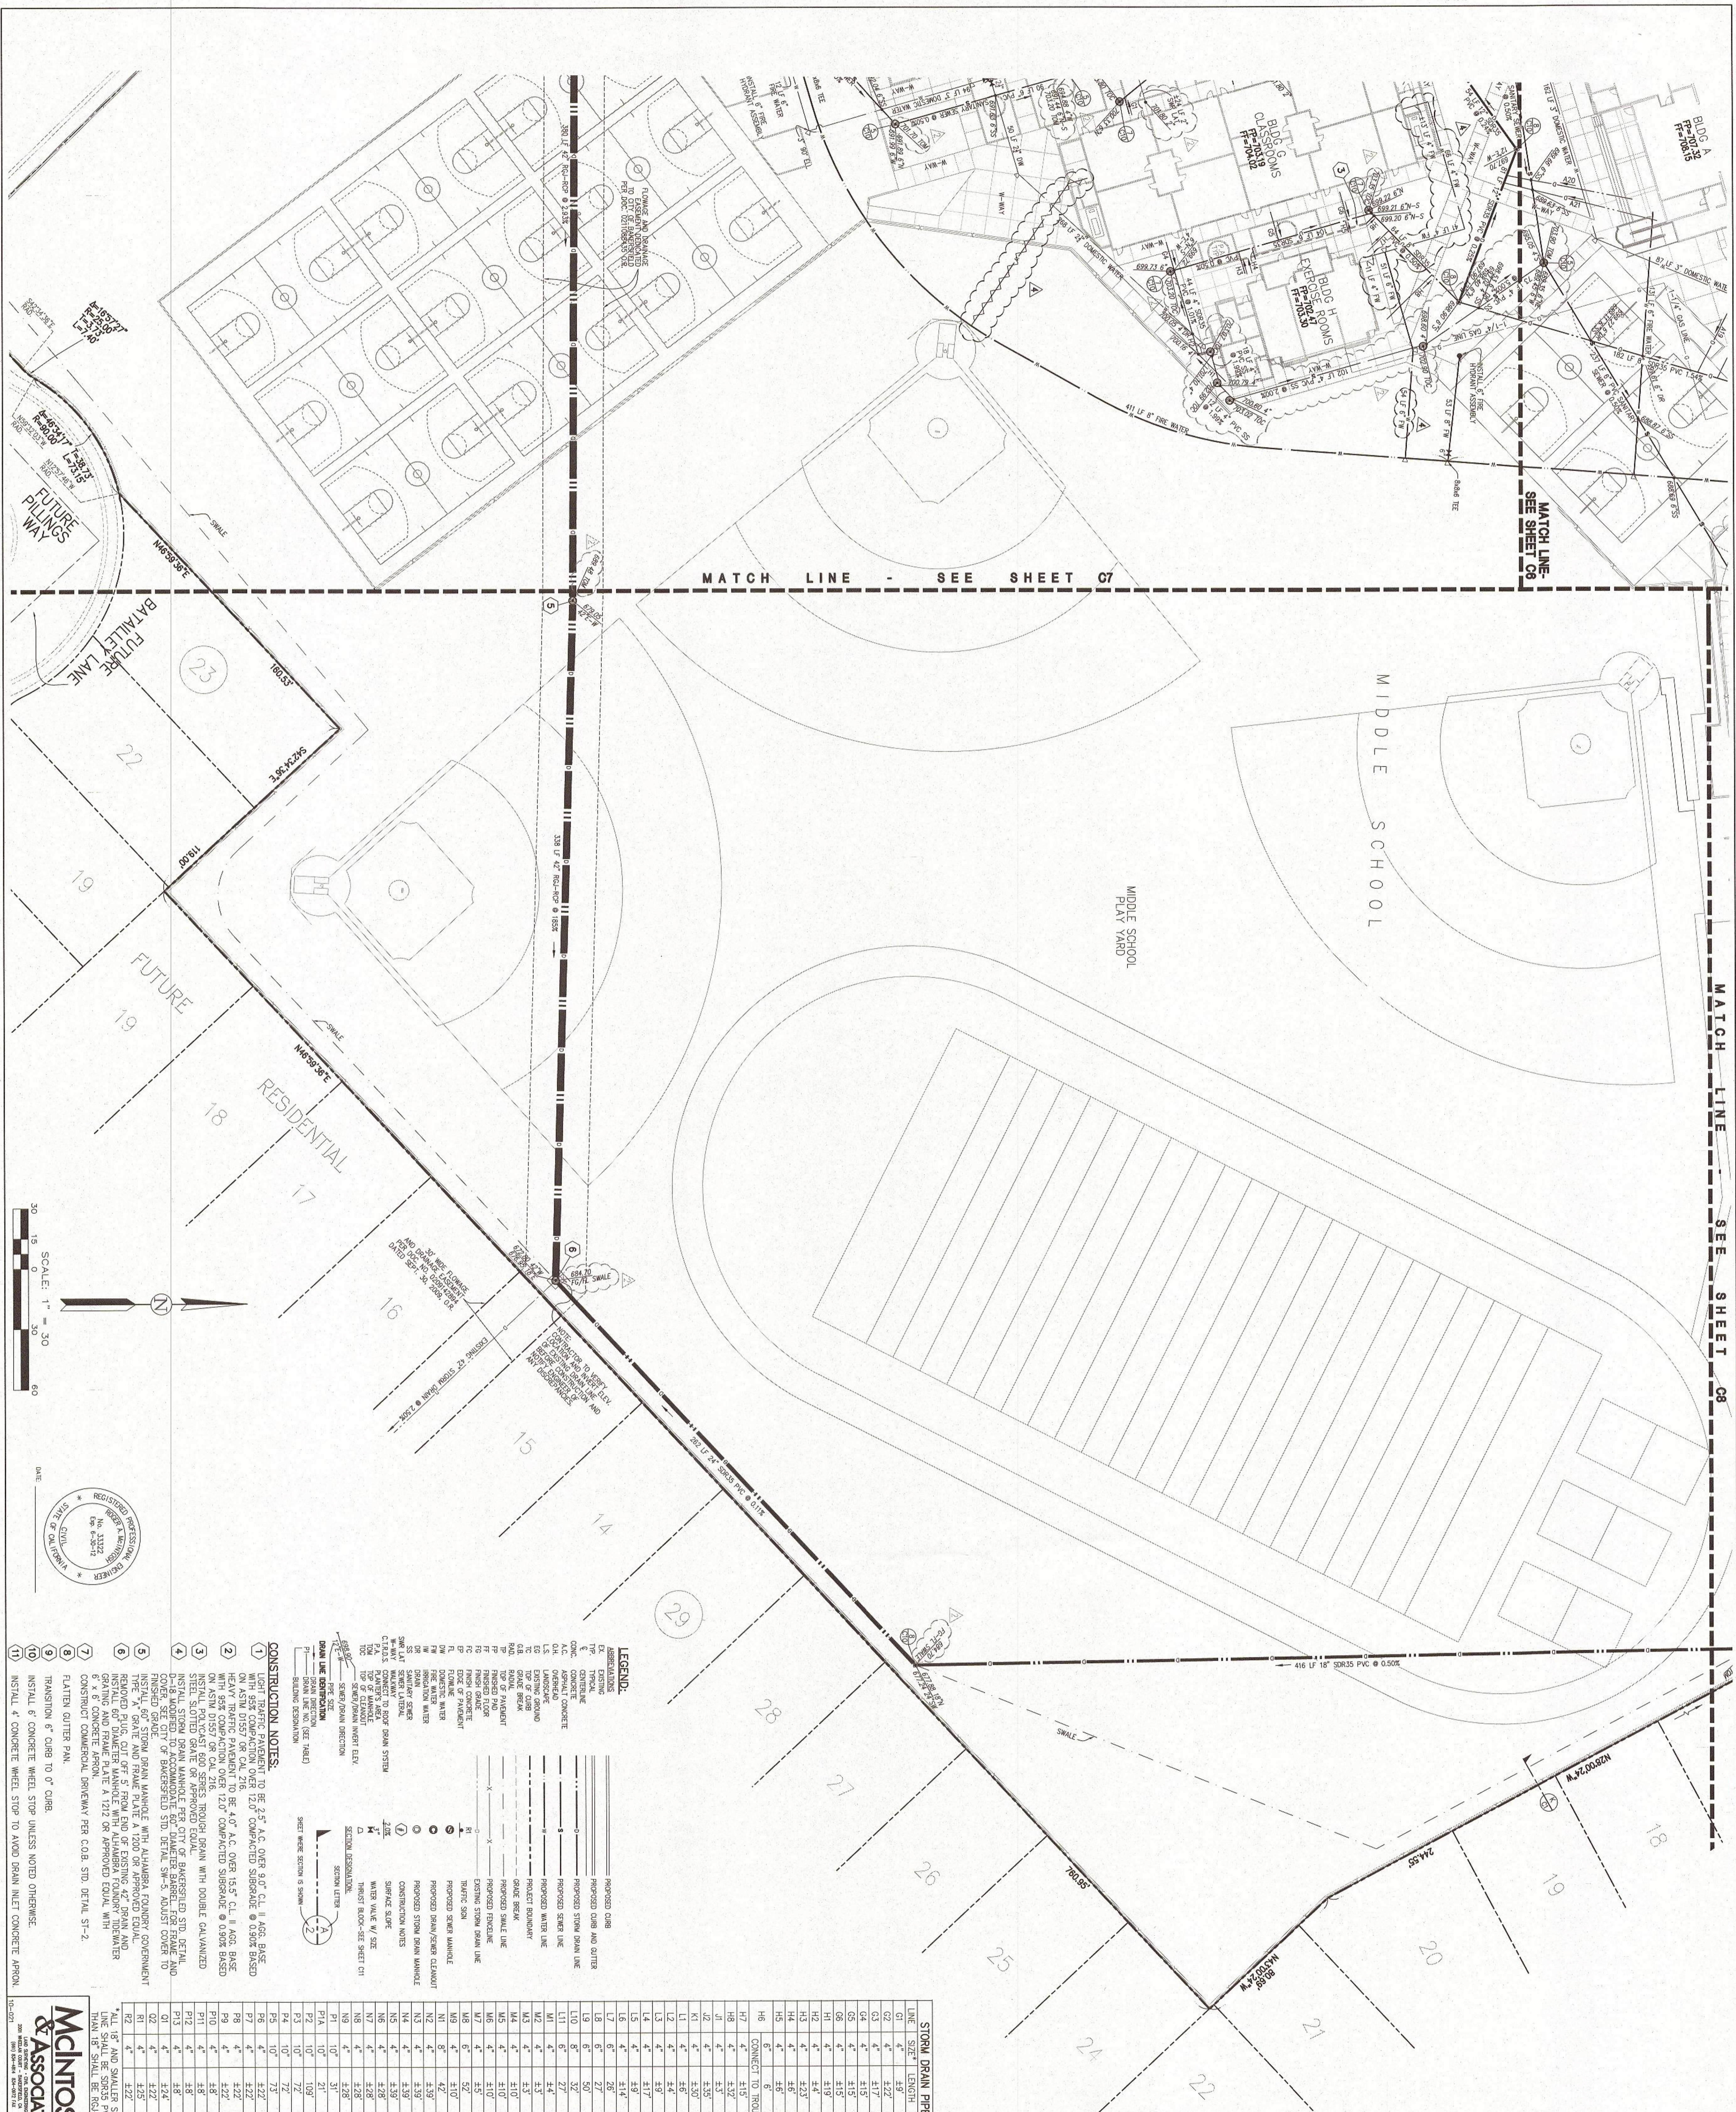

30' 15' SCALE: 1" = 30'

DATE: _____

REGISTERED PROFESSIONAL ENGINEER

- CONSTRUCTION NOTES:**
- LIGHT TRAFFIC PAVEMENT TO BE 2.5" A.C. OVER 3.0" C.L. II AGG. BASE ON ASH 10577 OR CAL. 716 12.0" COMPACTED SUBGRADE @ 0.5% BASED HEAVY TRAFFIC PAVEMENT TO BE 4.0" A.C. OVER 15.5" C.L. II AGG. BASE ON ASH 10577 OR CAL. 716 12.0" COMPACTED SUBGRADE @ 0.5% BASED.
 - HEAVY TRAFFIC PAVEMENT TO BE 4.0" A.C. OVER 15.5" C.L. II AGG. BASE ON ASH 10577 OR CAL. 716 12.0" COMPACTED SUBGRADE @ 0.5% BASED.
 - INSTALL POLYCAST 600 SERIES THROUGH DRAIN WITH DOUBLE GALVANIZED STEEL SLOTTED GRATE OR APPROVED EQUAL.
 - CONSTRUCT COMMERCIAL DRAINWAY PER COB. STD. DETAIL ST-2 FLATTEN CUTTER PAN.
 - TRANSITION 6" CHIBB TO 0" CHIBB.
 - INSTALL 6" CONCRETE WHEEL STOP UNLESS NOTED OTHERWISE.
 - INSTALL 4" CONCRETE WHEEL STOP TO AVOID DRAIN INLET CONCRETE APRON.

LEGEND:

EX	EXISTING
PRO	PROPOSED
CONC.	CONCRETE
AP	ASPHALT
APP	APPROVED EQUAL

STOP DRAIN PIPE TABLE

LINE	SIZE	LENGTH	SLOPE
McINTOSH & ASSOCIATES

REGISTERED PROFESSIONAL ENGINEERS

APR #003

SHEET #

C9

SHEET IDENTIFICATION NUMBER

FOR:

BAKERSFIELD CITY SCHOOL DISTRICT
1300 BAKER STREET
BAKERSFIELD CALIFORNIA 93305

NEW ELEMENTARY SCHOOL
8801 HIGHLAND KNOLLS DR
BAKERSFIELD, CALIFORNIA 93306

NEW MIDDLE SCHOOL
4115 VINELAND ROAD
BAKERSFIELD CALIFORNIA 93306

REVISIONS:

MARK	DATE	DESCRIPTION
05-16-12	Revision 2	
05-29-12	Revision 4	

ORDIZ MELBY
ARCHITECTS, INC.

5950 MING AVENUE
BAKERSFIELD, CALIFORNIA 93309
TELEPHONE (801) 832-2828
FACSIMILE (801) 832-2931

SITE 290

DANIEL E. GRITZ, P.E.
ARCHITECT C-14,728
WILLIAM J. MELBY, AIA
ARCHITECT C-16,885


IDENTIFICATION STAMP
OFFICE OF STATE SERVICES
APPL. #: 04-120271
FILE #: 150

AC: _____ PLS: _____ SS: _____
DATE: _____ P/N # 8331-112