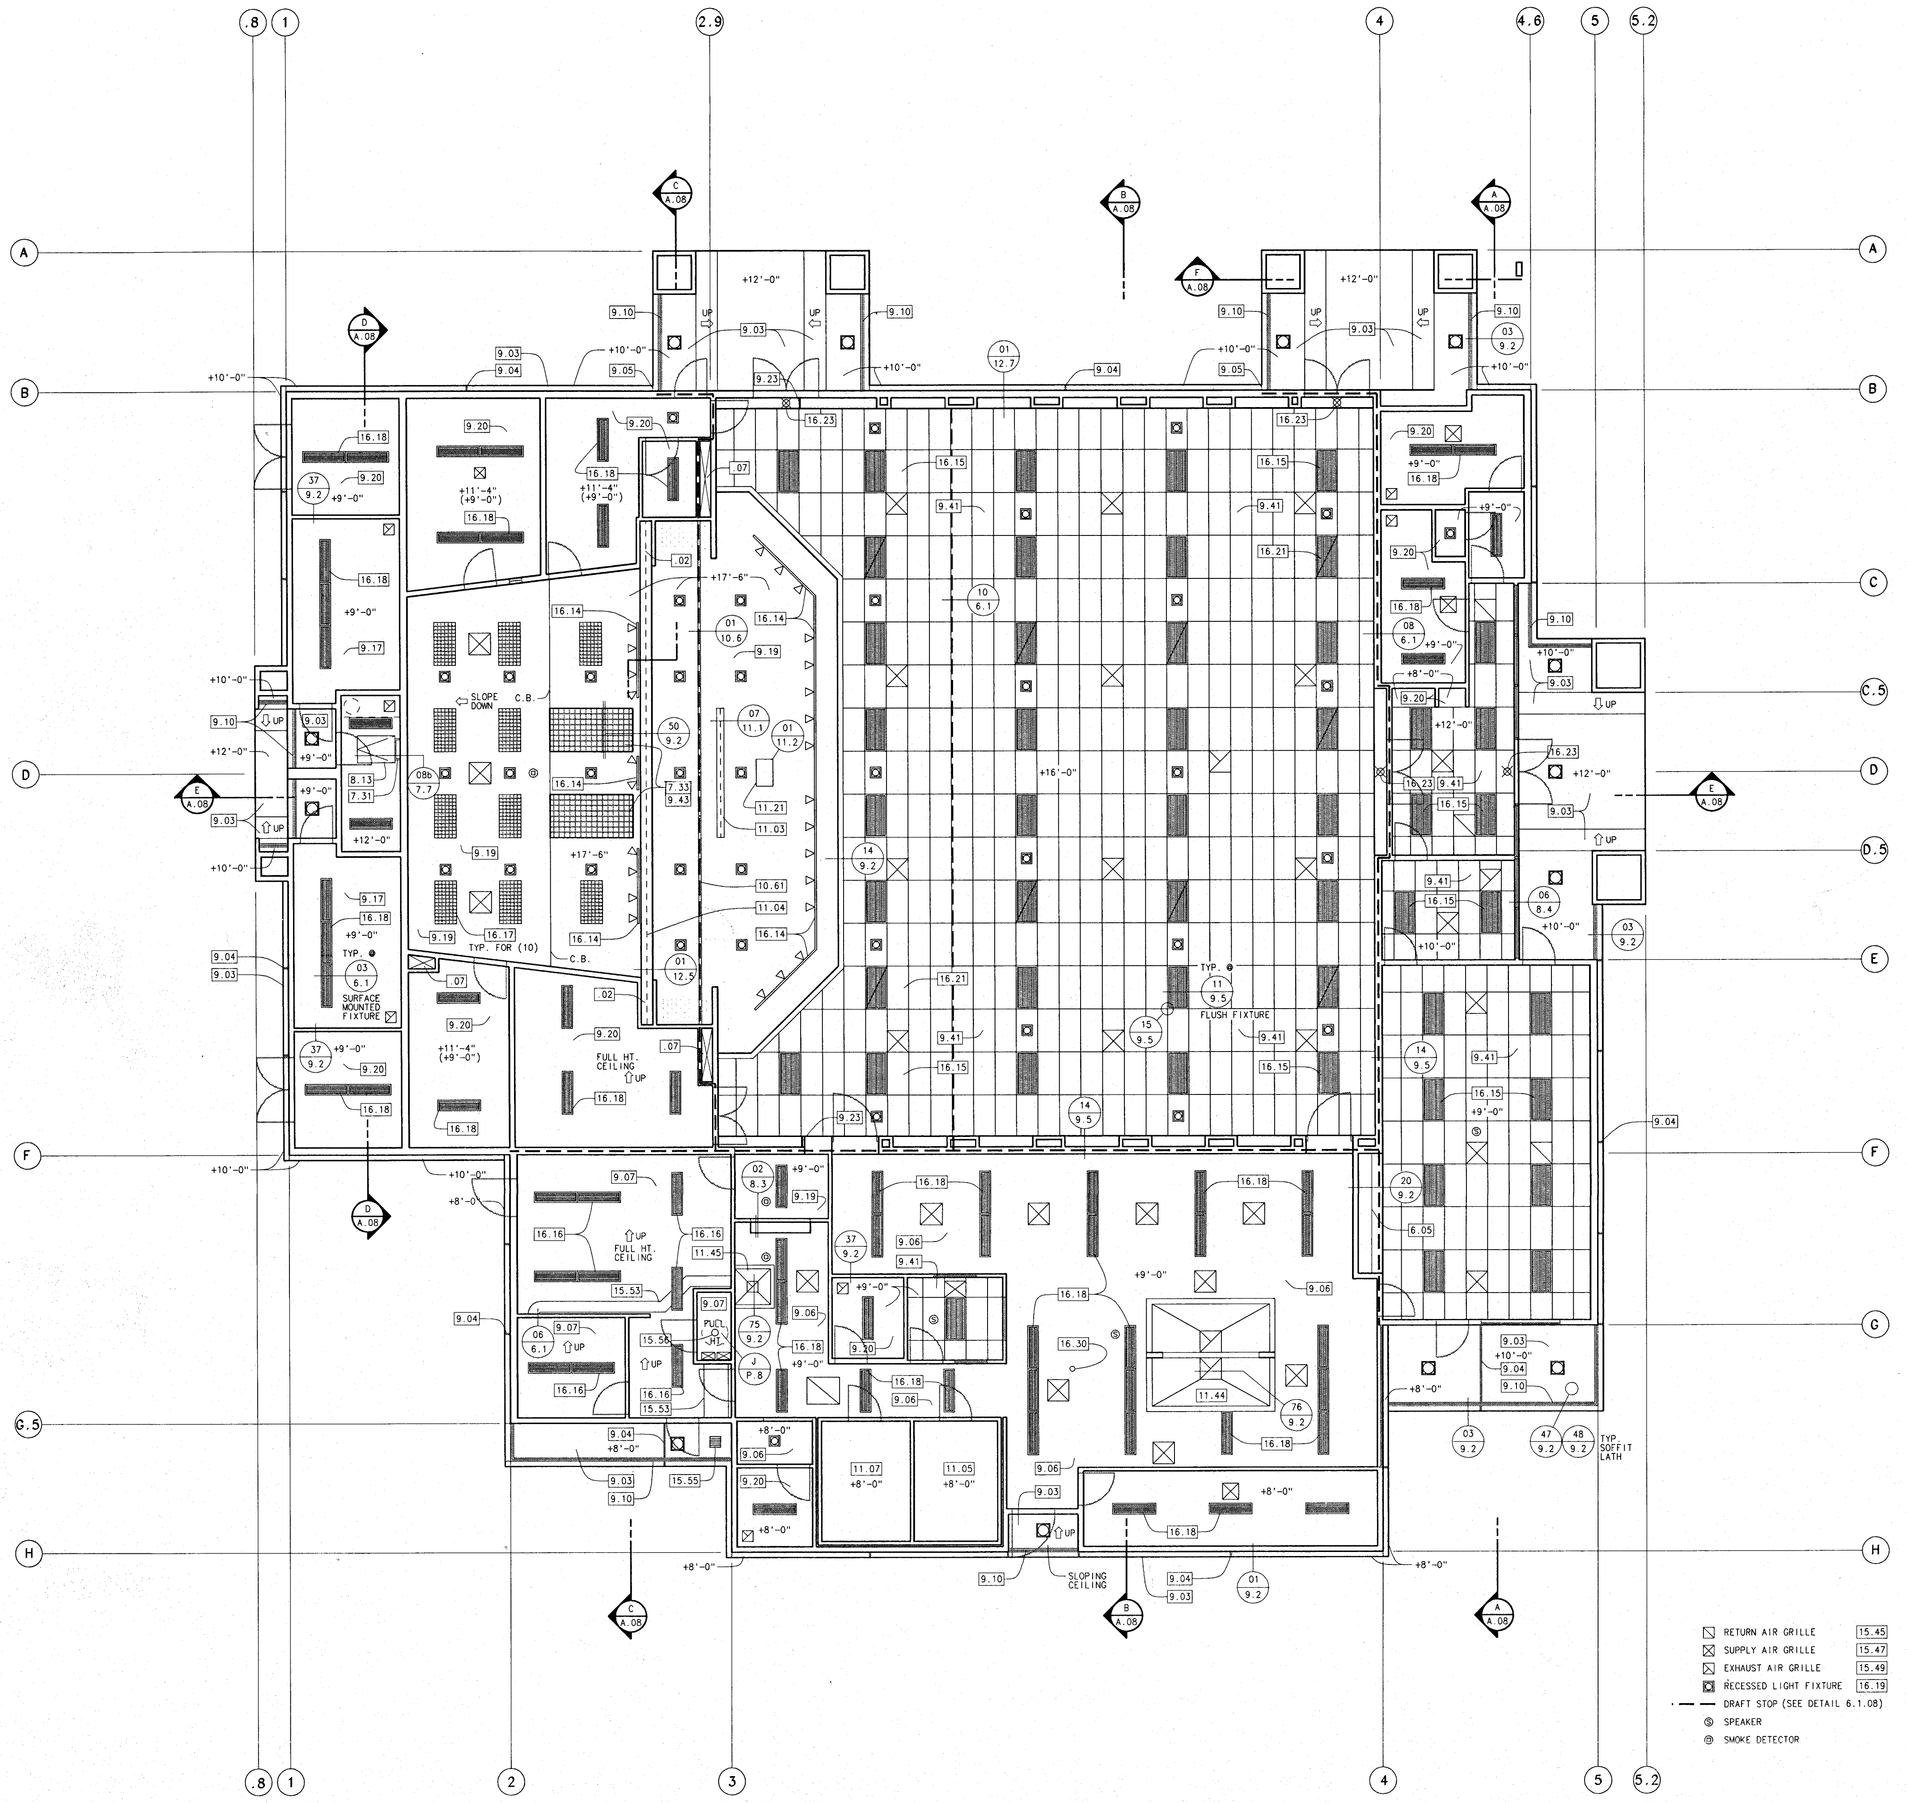

CAFETERIA REFLECTED CEILING PLAN 'C'

1/8" = 1'-0"

KEYNOTES:

	.02	CURTAIN STACK SPACE	00000
	.07	MECHANICAL SPACE	00000
	6.05	WALL CABINET BELOW SOFFIT	06400
	7.31	ROOF ACCESS ALUMINUM LADDER (CEILING TO ROOF CURB)	07700
	7.33	SMOKE HATCH ABOVE @ ROOF (PROVIDE MANUAL RELEASE PER U.B.C. 3503(c).	07700
	8.13	CEILING ACCESS PANEL 30" X 36" PAINTED	08305
	9.03	CEMENT PLASTER SOFFIT WITH SAND FLOAT FINISH	09200
	9.04	PLASTER EXPANSION SCREED w/ CONT. BLOCKING (SUPERIOR #15)	09200
	9.05	PLASTER EXPANSION SCREED (WESTERN #XJ-15) TYP. @ CORNERS ONLY	09200
	9.06	1/2" TYPE 'X' IMPERIAL BD. OVER 2 - COAT VENEER PLASTER	09215
RC 2601	9.07	2 - LAYERS 1/2" TYPE 'X' GYP. BD. BELOW ROOF JOISTS	09215
	9.10	CONTINUOUS VENT SCREED (SUPERIOR #115 - 3.5")	09250
	9.17	CEMENT PLASTER CEILING	09250
	9.19	5/8" GYPSUM BOARD DRYWALL TYPE 'X'(Fire Rated)	09250
WP 3605	9.20	5/8" GYPSUM BOARD DRYWALL w/ (1) LAYER 5/8" TYPE 'X' @ TOP SIDE ATTIC OF 2x CEILING JOISTS	09250
	9.23	DRAFT STOPS	09250
	9.41	2' X 4' SUSPENDED T-BAR CEILING WITH FLUSH LAY-IN PANEL	09510
	9.43	PARABOLIC GRILLE @ SMOKE SHAFT	09510
	10.61	MANUAL PULL SINGLE PANEL MOVEABLE PARTITION (ALTERNATE BID ITEM #2)	10650
	11.03	RECESSED ELEC. PROJECTION SCREEN	11132
	11.04	MANUAL PULL BI-PARTING STAGE CURTAIN	11800
	11.05	WALK-IN COLD BOX	11400
	11.07	WALK-IN FREEZER	11400
	11.21	SUSPENDED SPEAKER (PAINTED)	11510
	11.44	KITCHEN HOOD	11400
	11.45	DISHWASHER HOOD	11400
	12.03	RECESSED DOUBLE FOLDING TABLE & BENCH UNIT	12720
	15.45	RETURN AIR GRILLE	15800
	15.47	SUPPLY AIR GRILLE	15800
	15.49	EXHAUST AIR GRILLE	15800
	15.53	EXPOSED MECHANICAL (PAINTED)	15800
	15.55	MECHANICAL GRILLE	15800
	15.56	WATER HEATER FLUE	15650
	16.14	STAGE TRACK LIGHTING FIXTURES	16100
	16.15	RECESSED FLUORESCENT FIXTURE	16100
	16.16	SURFACE MOUNTED FLUORESCENT FIXTURE	16100
	16.17	RECESSED FLUORESCENT FIXTURE WITH PARABOLIC LIGHT LENSE	16100
	16.18	FLUORESCENT FIXTURE	16100
	16.19	RECESSED LIGHT FIXTURE	16100
	16.21	EMERGENCY LIGHT FIXTURE	16100
	16.23	EXIT LIGHT FIXTURE	16100
	16.30	CEILING MOUNTED RETRACTABLE OUTLET REEL	16100

GENERAL NOTES:

1. FOR TYPICAL SUSPENDED CEILING NOTES SEE 9.5.06a & 9.5.06b.
2. TYPICAL @ T-BAR CEILING: PROVIDE STRUT TO ROOF STRUCTURE TO RESIST VERTICAL FORCE INDUCED BY WIRES PER 1988 UBC STD. 47181c. SEE 9.5.15.
3. SEE DETAILS 9.2.47 & 9.2.48 FOR ATTACHMENT OF METAL LATH OR PAPER BACKED WIRE FABRIC TO WOOD FRAMED HORIZONTAL SURFACES.
4. T-BAR SYSTEM SERIES NUMBERS:
   MAIN RUNNERS: CHICAGO METALLIC CO. - #1811 & 1819
   CROSS RUNNERS: CHICAGO METALLIC CO. - #1814 (OR 1804, 1824)
   SEE SPEC. SECTION 09510 FOR ADDITIONAL INFO.
5. PROVIDE SANTILE PAINT AT THE INTERIOR FINISH, TYP @ ROOMS 120, 125, 126, 128, 129, 132, 133, 134 & 135.

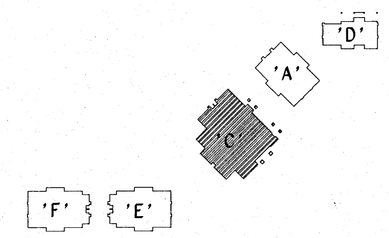

KEY PLAN

KLASSEN CORPORATION

Architecture
Planning
Construction
2021 Westwind Drive
Bakersfield, CA 93301
(805) 327-0875
(805) 327-5933 Fax

LICENSED ARCHITECT — PAUL KLASSEN — C10401 — EXP 1-31-95 — STATE OF CALIFORNIA

The above drawings and specifications and ideas, designs and arrangements represented thereby are and shall remain the property of the architect; and no part thereof shall be copied, disclosed to others or used in connection with any work or project other than the specific project for which they have been prepared and developed without the written consent of the architect. Visual contact with these drawings or specifications shall constitute conclusive evidence of acceptance of these restrictions.

Written dimensions on these drawings shall have precedence over scaled dimension; contractors shall verify and be responsible for all dimensions and conditions on the job and this office must be notified of any variations from the dimensions and conditions shown by these drawings. Shop details must be submitted to this office for approval before proceeding with fabrication.

BAKERSFIELD CITY SCHOOL DISTRICT

MESA MARIN ELEMENTARY SCHOOL

BAKERSFIELD, CA.

Sheet title: REFLECTED CEILING PLAN - 'C'

Date:	Issued for:

Date:	Revisions:	
10-94	A	AS BUILTS

Drawn by: done

Job no: 1223

Dgn. file: mma04.2d

Sheet: A.04

Sheet of: 30
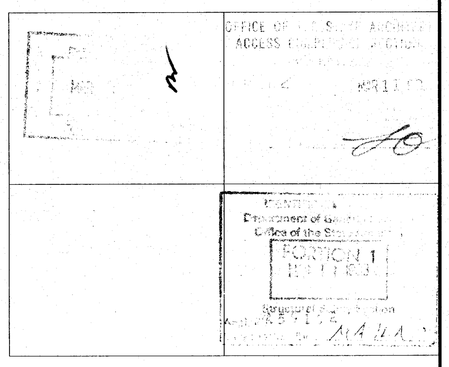
Date: March 8, 1993