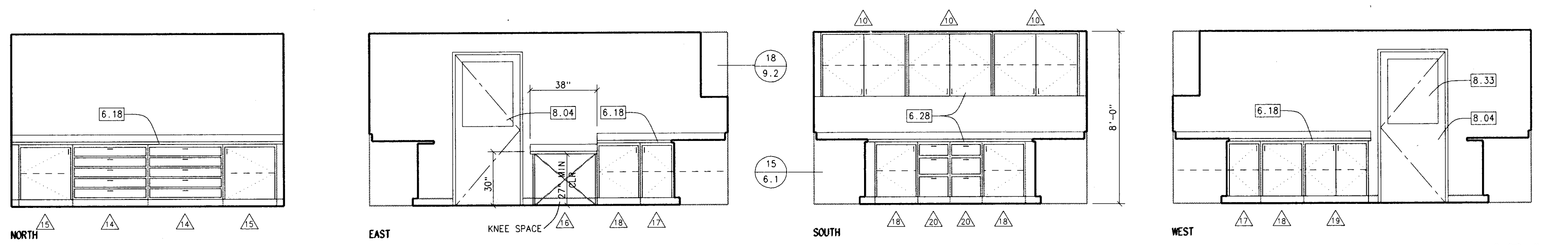

109 TEACHER WORKROOM

'D'

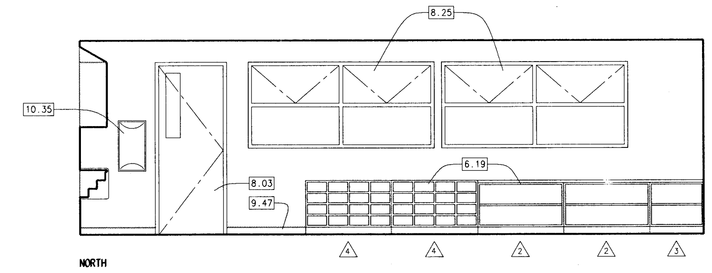

110 PRIMARY CLASSROOM

'D'

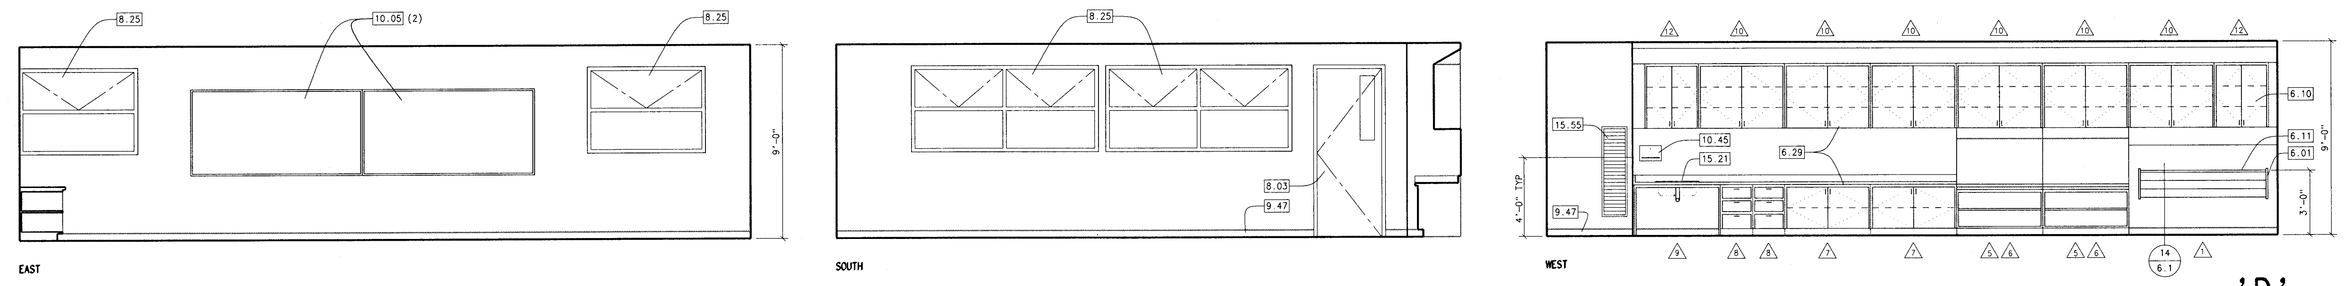

110 PRIMARY CLASSROOM

'D'

KEYNOTES:

6.01	PROVIDE SOLID BACKING IN WALL FOR WALL MOUNTED ACCESSORIES	06100
6.10	LAM. PLASTIC UPPER CAB w/ SLOPING TOP	06400
6.11	LAM. PLASTIC WALL MT'D. COAT RACK	06400
6.29	LAM. PLASTIC BASE & UPPER CABINET w/ SLOPING TOP	06400
8.03	HOLLOW METAL DOOR AND FRAME	08110
8.04	SOLID MASONITE DOOR w/ H.M. FRAME	08110
8.25	BRONZE ANODIZED ALUMINUM FRAMED WINDOW w/ PROJECTED TOP & FIXED BOTTOM SECTION. GLAZED w/ BRONZE TINT (NAIL IN)	08520
8.33	TEMPERED GLASS	08800
8.34	WIRE GLASS	08800
9.17	5/8" GYPSUM BOARD DRYWALL	09250
9.47	RUBBER TOPSET BASE (4" HIGH)	09650
9.57	VINYL WALLCOVERING	09950
9.59	PAINT	09900
10.03	TACK WALL (1/2" THICK w/ VINYL COVERING) OVER 1/2" GYPSUM BOARD	10100
10.05	PORCELAIN ENAMEL CHALKBOARD (4'x8') (NO LINES)	10100
10.14	WALL MOUNTED SIGN (FRAMED)	10425
10.35	SEMI-RECESSED CABINET w/ FIRE EXT.	10522
10.45	SURFACE MOUNTED PAPER TOWEL DISPENSER (Bobrick B-262)	10800
15.21	SINK	15400
15.55	MECHANICAL GRILLE	15800

CABINET SCHEDULE

EQUIPMENT NO.	W.I.C. NO.	CABINET SIZE L H D	DESCRIPTION	EQUIPMENT NO.	W.I.C. NO.	CABINET SIZE L H D	DESCRIPTION
1	–	72" x 15" x 15"	COAT RACK & SHELF – (32) COAT HOOKS (IVES 581) STAGGERED	27	745	48" x 33" x 15"	WALL EASEL – VINYL TACK STRIP AT TOP EXPOSED TO VIEW SURFACES LAMINATED PLASTIC, PLASTIC TRAY
2	100	48" x 30" x 24"	OPEN BASE CABINET – (1) ADJUSTABLE SHELF	28	100	48" x 24" x 15"	OPEN BASE CABINET – (1) SHELF
3	100	30" x 30" x 24"	OPEN BASE CABINET – (1) ADJUSTABLE SHELF	29	100	48" x 27" x 15"	OPEN BASE CABINET – (1) ADJUSTABLE SHELF
4	170	48" x 30" x 15"	BASE CABINET – CUBICLE STORAGE (16) CUBICLES	30	102	36" x 27" x 24"	BASE CABINET – (1) ADJUSTABLE SHELF
5	745	48" x 30" x 15"	WALL EASEL – VINYL TACK STRIP AT TOP EXPOSED TO VIEW SURFACES LAMINATED PLASTIC, PLASTIC TRAY	31	176	48" x 27" x 24"	BASE CABINET – (1) ADJUSTABLE SHELF
6	100	48" x 27" x 15"	OPEN BASE CABINET – (1) ADJUSTABLE SHELF	32	100	48" x 27" x 24"	OPEN BASE CABINET – (1) ADJUSTABLE SHELF
7	102	48" x 30" x 24"	BASE CABINET – (1) ADJUSTABLE SHELF	33	100	42" x 27" x 24"	OPEN BASE CABINET – (1) ADJUSTABLE SHELF
8	230	18" x 30" x 24"	BASE CABINET – (3) DRAWERS	34	302	18" x 36" x 15"	UPPER CABINET – (2) ADJUSTABLE SHELVES
9	156	48" x 30" x 24"	SINK BASE UNIT –	35	400	36" x 96" x 24"	OPEN TALL CABINET – (5) ADJUSTABLE SHELVES
10	302	48" x 36" x 15"	UPPER CABINET – (2) ADJUSTABLE SHELVES	36	300	48" x 42" x 15"	OPEN UPPER CABINET – (2) ADJUSTABLE SHELVES – RECESS FOR LIGHT VALANCE
10A	302	48" x 36" x 15"	UPPER CABINET – (2) ADJUSTABLE SHELVES, RECESS FOR LIGHT VALANCE	37	100	24" x 30" x 24"	OPEN BASE CABINET – (1) ADJUSTABLE SHELF
11	302	24" x 36" x 15"	UPPER CABINET – (2) ADJUSTABLE SHELVES	38	291	36" x 1" x 24"	MODIFIED TO BE PENCIL DRAWERS – (2) 1" H.
12	302	30" x 36" x 15"	UPPER CABINET – (2) ADJUSTABLE SHELVES	39	291	60" x 1" x 24"	MODIFIED TO BE PENCIL DRAWERS – (3) 1" H.
13	501	24" x 96" x 24"	TEACHER WARDROBE – (2) LOCKABLE DOORS, MIRROR, COAT HOOK, POLE, & SHELF	40	170	48" x 36" x 15"	BASE CABINET – CUBICLE STORAGE (16) CUBICLES
14	250	42" x 36" x 27"	(5) EQUAL DRAWERS – CLEAR INSIDE DRAWER DIMENSIONS 37" W x 25" D, DRAWER TO HAVE SIDES & BACK	41	100	48" x 36" x 24"	OPEN BASE CABINET – (1) ADJUSTABLE SHELF
15	102	30" x 36" x 27"	BASE CABINET – (1) ADJUSTABLE SHELF	42	100	30" x 36" x 24"	OPEN BASE CABINET – (1) ADJUSTABLE SHELF
16	160	36" x 30" x 30"	BASE CABINET – KNEE SPACE	43	102	48" x 36" x 24"	BASE CABINET – (1) ADJUSTABLE SHELF
17	176	48" x 36" x 30"	CORNER UNIT – (1) ADJUSTABLE SHELF	44	156	48" x 34" x 24"	SINK BASE UNIT –
18	102	24" x 36" x 30"	BASE CABINET – (1) ADJUSTABLE SHELF	45	230	18" x 36" x 24"	BASE CABINET – (3) DRAWERS
19	102	36" x 36" x 30"	BASE CABINET – (1) ADJUSTABLE SHELF	46	102	36" x 36" x 24"	BASE CABINET – (1) ADJUSTABLE SHELF
20	230	18" x 36" x 24"	BASE CABINET – (3) DRAWERS	47	302	48" x 30" x 15"	UPPER CABINET – (2) ADJUSTABLE SHELVES
21	704	42" x 42" x 30"	MOBILE BASE CABINET – CUBICLE STORAGE (32) CUBICLES – (16) EACH SIDE	48	–	48" x 15" x 15"	COAT RACK & SHELF – (24) COAT HOOKS (IVES 581) STAGGERED
22	–	60" x 15" x 15"	COAT RACK & SHELF – (32) COAT HOOKS (IVES 581) STAGGERED	49	762	112" x 54" x 30"	STUDY CARRELS – COUNTER (+30") & UPPER SHELVES
23	402	48" x 96" x 24"	TALL CABINET – MODIFIED LOCKABLE FOR (4) DOORS – (5) ADJUSTABLE SHELVES	50	240	42" x 24" x 30"	(4) EQUAL DRAWERS – DRAWERS TO HAVE A BACK & SIDES
24	402	24" x 96" x 24"	TALL CABINET – MODIFIED FOR (2) DOORS – (5) ADJUSTABLE SHELVES	51	100	12" x 24" x 30"	OPEN BASE CAB. – (1) ADJUSTABLE SHELF
25	230	18" x 27" x 24"	BASE CABINET – (3) DRAWERS	52	441	48" x 24" x 66"	STORAGE CAB. – (4) ADJUSTABLE SHELVES
26	156	36" x 27" x 24"	SINK BASE UNIT	53			

CABINET ANCHORAGE

VERTICAL LOAD REQUIREMENT REF.: TABLE NO. 23-B
LATERL FORCE REQUIREMENT REF.: TABLE NO. 23-P

PROVIDE BRACING AND ANCHORAGE DETAILS FOR WALL HUNG CABINETS AND FLOOR SUPPORTED STORAGE RACKS, CABINETS AND BOOK STACKS OVER FIVE FEET IN HEIGHT. DESIGN SUPPORTING PARTITIONS AND WALLS TO RESIST FORCES APPLIED BY CABINET ANCHORAGES.

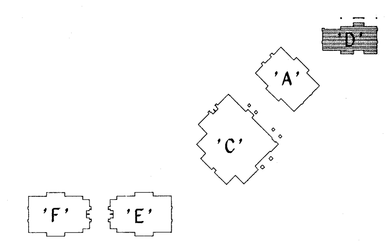

KEY PLAN

KLASSEN CORPORATION
Architecture
Planning
Construction
2021 Westwind Drive
Bakersfield, CA 93301
(805) 327-0875
(805) 327-5933 Fax

LICENSED ARCHITECT – PHIL KLASSEN – C10401 – REN. 1-31-95 – STATE OF CALIFORNIA

The above drawings and specifications and ideas, designs and arrangements represented thereby are and shall remain the property of the architect and no part thereof shall be copied, disclosed to others or used in connection with any work, project or other than the specific project for which they have been prepared and developed without the written consent of the architect. Visual contact with these drawings or specifications shall constitute conclusive evidence of acceptance of these restrictions.

Written dimensions on these drawings shall have precedence over scaled dimension; contractors shall verify and be responsible for, all dimensions and conditions on the job and this office must be notified of any variations from the dimensions and conditions shown by these drawings. Shop details must be submitted to this office for approval before proceeding with fabrication.

BAKERSFIELD CITY SCHOOL DISTRICT

MESA MARIN ELEMENTARY SCHOOL

BAKERSFIELD, CA.

Sheet title: KINDERGARTEN CLASSROOMS INTERIOR ELEVATIONS & CABINET SCHEDULES – 'D'

Date:	Issued for:

Date:		Revisions:
10-94	A	AS BUILTS

Drawn by: done

Job no: 1223

Dgn. file: mma28.2d

Sheet: A.28

Sheet of: 30

Date: March 8, 1993

OFFICE OF THE STATE ARCHITECT
ACCESS COMPLIANCE SECTION
MAR 11 93

CERTIFICATION
Department of General Services
Office of the State Architect
MAR 11 1993
Structural Safety Section
Appl. #
Submitted By