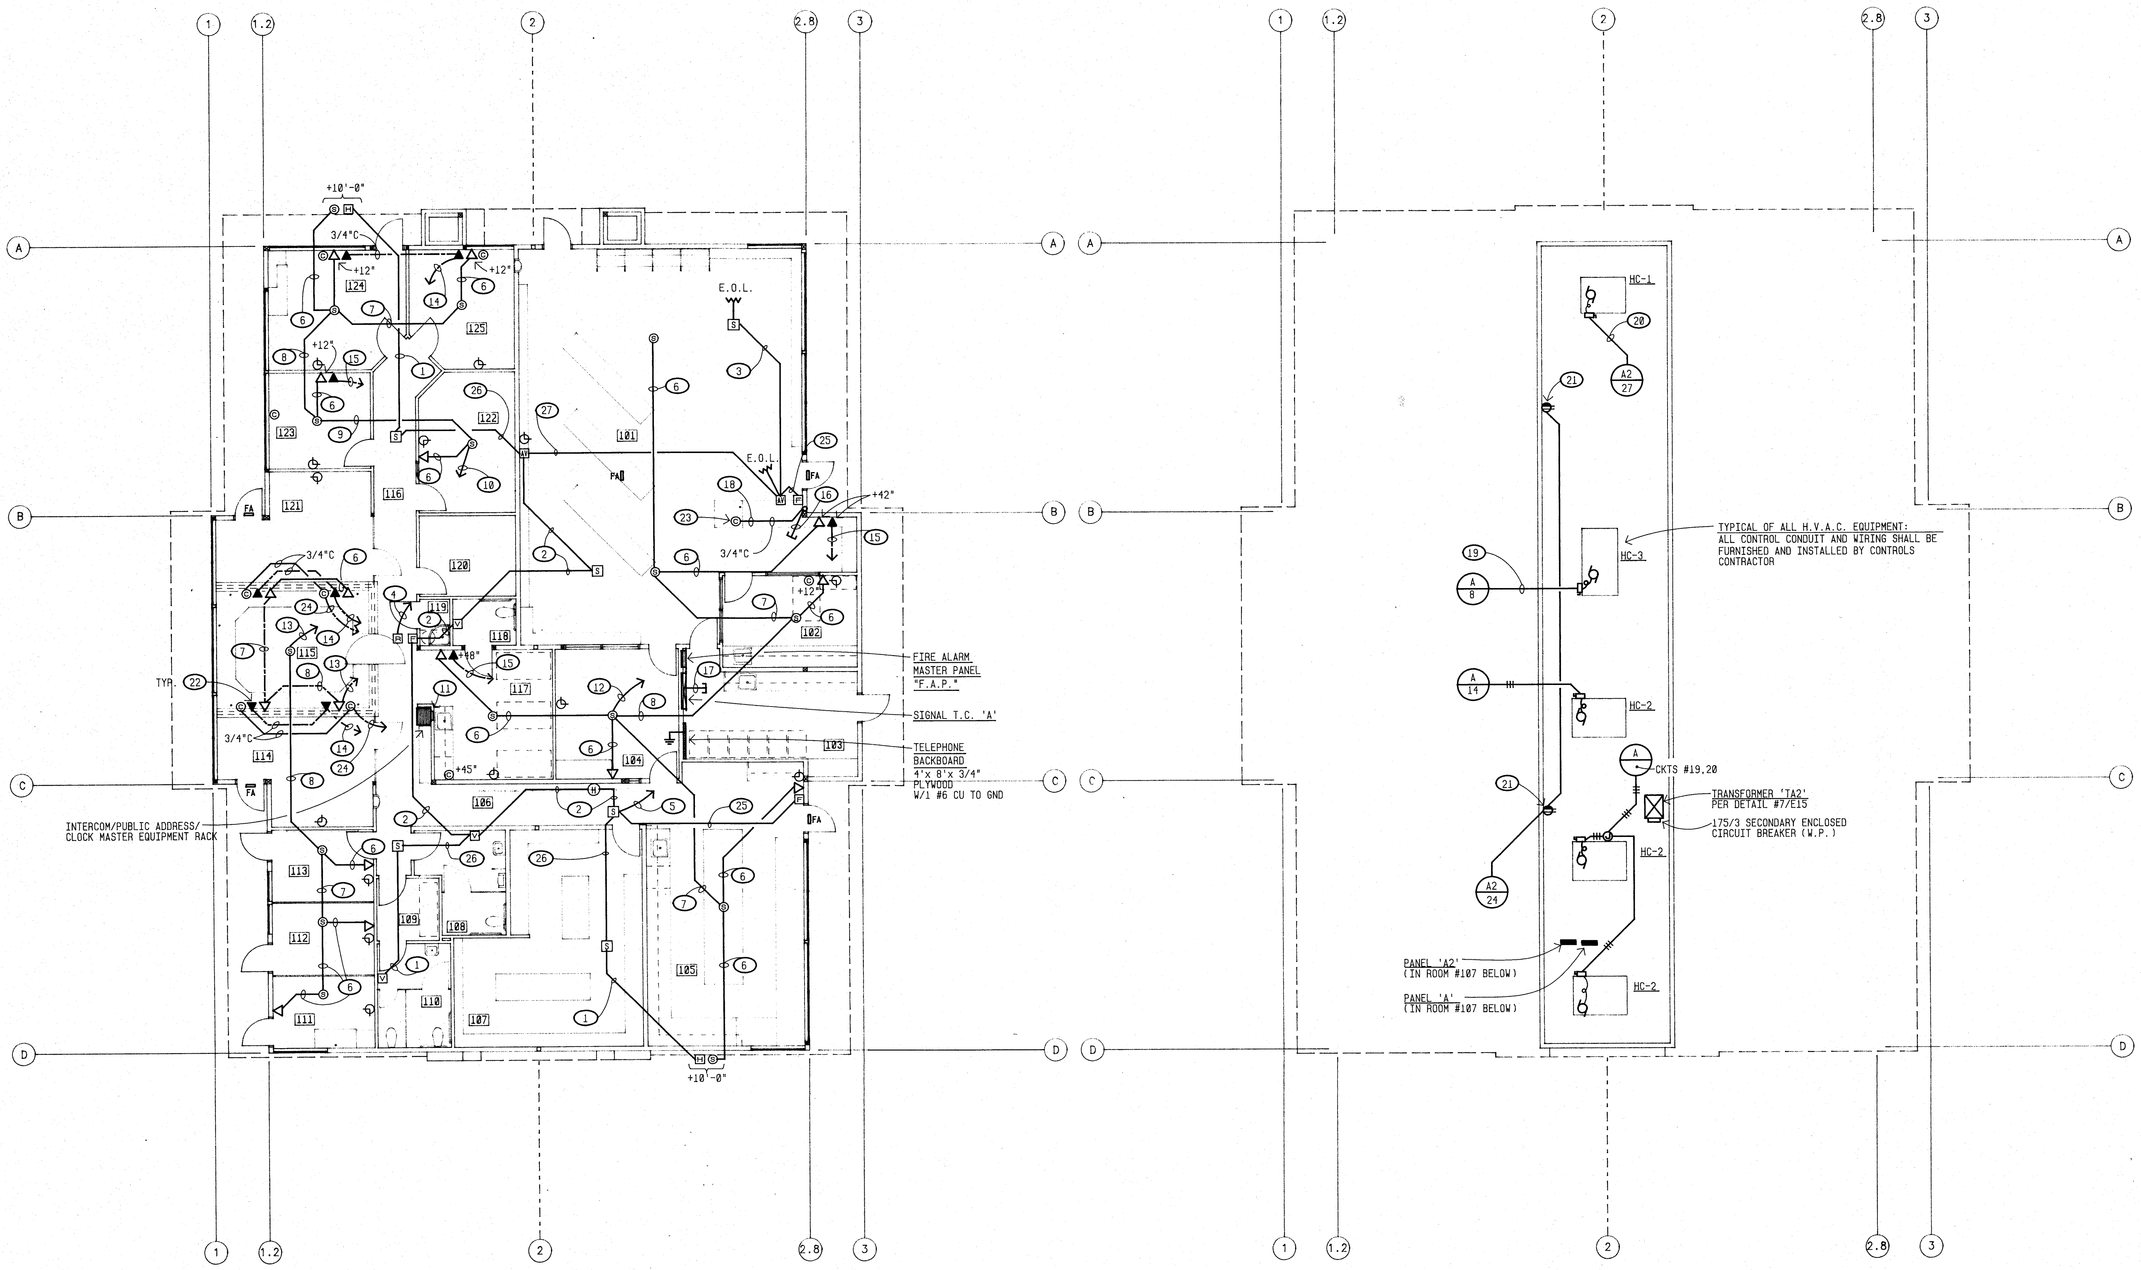

ADMINISTRATION/LIBRARY SIGNALS PLAN 'A'

1/8" = 1'-0"

ADMINISTRATION/LIBRARY ROOF ELECTRICAL PLAN 'A'

1/8" = 1'-0"

NOTES (THIS SHEET ONLY):

1. 1/2"C - 4 #12
2. 3/4"C - 6 #12, 2 #14
3. 1/2"C - 2 #14
4. 3/4"C - 8 #14 TO FIRE ALARM MASTER PANEL 'F.A.P.'
5. 3/4"C - 6 #12, 2 #14 TO FIRE ALARM MASTER PANEL 'F.A.P.'
6. 1/2"C - ONE I.C.CABLE
7. 1/2"C - TWO I.C.CABLES
8. 3/4"C - THREE I.C.CABLES
9. 3/4"C - FOUR I.C.CABLES
10. 1"C - FIVE I.C.CABLES TO INTERCOM SECTION OF SIGNAL T.C. 'A'
11. PROVIDE PULL BOX BEHIND EQUIPMENT RACK PER SIGNALS LINE DIAGRAM. DETAIL #2/E16.
12. 1"C - SIX I.C.CABLES TO INTERCOM SECTION OF SIGNAL T.C. 'A'
13. 3/4"C - FOUR I.C.CABLES TO INTERCOM SECTION OF SIGNAL T.C. 'A'
14. 1"C TO TELEPHONE BACKBOARD
15. 3/4"C TO TELEPHONE BACKBOARD
16. 1"C STUB TO ACCESSIBLE ATTIC SPACE ABOVE T-BAR CEILING
17. 2"C STUB (COMPUTER) AND 1"C (BURGLAR ALARM) INTO ACCESSIBLE ATTIC SPACE ABOVE T-BAR CEILING.
18. RUN CONDUIT IN CABINETRY AS DIRECTED BY ARCHITECT.
19. 3/4"C - 3 #10 + 1 #10 GND (THWN-CU)
20. 3/4"C - 2 #10 + 1 #10 GND (THWN-CU)
21. WEATHERPROOF G.F.C.I. DUPLEX RECEPTACLE ON ROOF. MOUNT TO SIDEWALL OF MECHANICAL WELL AT +24" ABOVE ROOF.
22. MOUNT IN KNEE SPACE BELOW.
23. MOUNT IN CABINETRY AS DIRECTED BY ARCHITECT.
24. 1"C TO COMPUTER SECTION OF SIGNAL T.C.'A'.
25. 1/2"C - 4 #14.
26. 3/4"C - 4 #12, 4 #14.
27. 3/4"C - 6 #12, 2 #14.

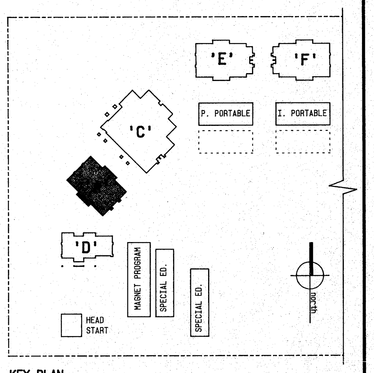

KEY PLAN

APPROVALS

MAR 8 1993

OFFICE OF THE STATE ARCHITECT
ACCESS COMPLIANCE SECTION
APPLICATION PER W. DIR. RULES
#91152 MAR 11 93
APPROVAL of this plan does not authorize or approve any deviation or deviation from applicable regulations.
Reviewed by

IDENTIFICATION STAMP
Department of General Services
Office of the State Architect
PORTION 1
MAR 11 1993
Structural Safety Section
Acct. #A59162
Backchecked By 4/4/94

KLASSEN CORPORATION

Architecture
Planning
Construction

2021 Westwind Drive
Bakersfield, CA 93301
(805) 327-0875
(805) 327-5933 Fax

REGISTERED ARCHITECT
L. PHIL KLASSEN
#C10401
Exp. 1-31-95
STATE OF CALIFORNIA

The above drawings and specifications and ideas, designs and arrangements represented thereby are and shall remain the property of the architect; and no part thereof shall be copied, disclosed to others or used in connection with any work or project other than the specific project for which they have been prepared and developed without the written consent of the architect. Visual contact with these drawings or specifications shall constitute conclusive evidence of acceptance of these restrictions.
Written dimensions on these drawings shall have precedence over scaled dimensions; contractors shall verify and be responsible for, all dimensions and conditions on the job and this office must be notified of any variations from the dimensions and conditions shown by these drawings. Shop details must be submitted to this office for approval before proceeding with fabrication.

BAKERSFIELD CITY SCHOOL DISTRICT

MESA MARIN ELEMENTARY SCHOOL

BAKERSFIELD, CA.

Sheet title: ADMIN./LIBRARY SIGNALS AND ROOF ELECT. PLANS, BUILDING 'A'

REGISTERED PROFESSIONAL ENGINEER
Donald Carmichael
Lic. 7198
Exp. 9/30/93
Electrical
STATE OF CALIFORNIA

Date:	Issued for:

Date:	Revisions:
10-94	A AS BUILTS

Drawn by: R.T.S.

Job no: 1223

Dgn. file:

Sheet: E.6

Sheet of: 17

Date: