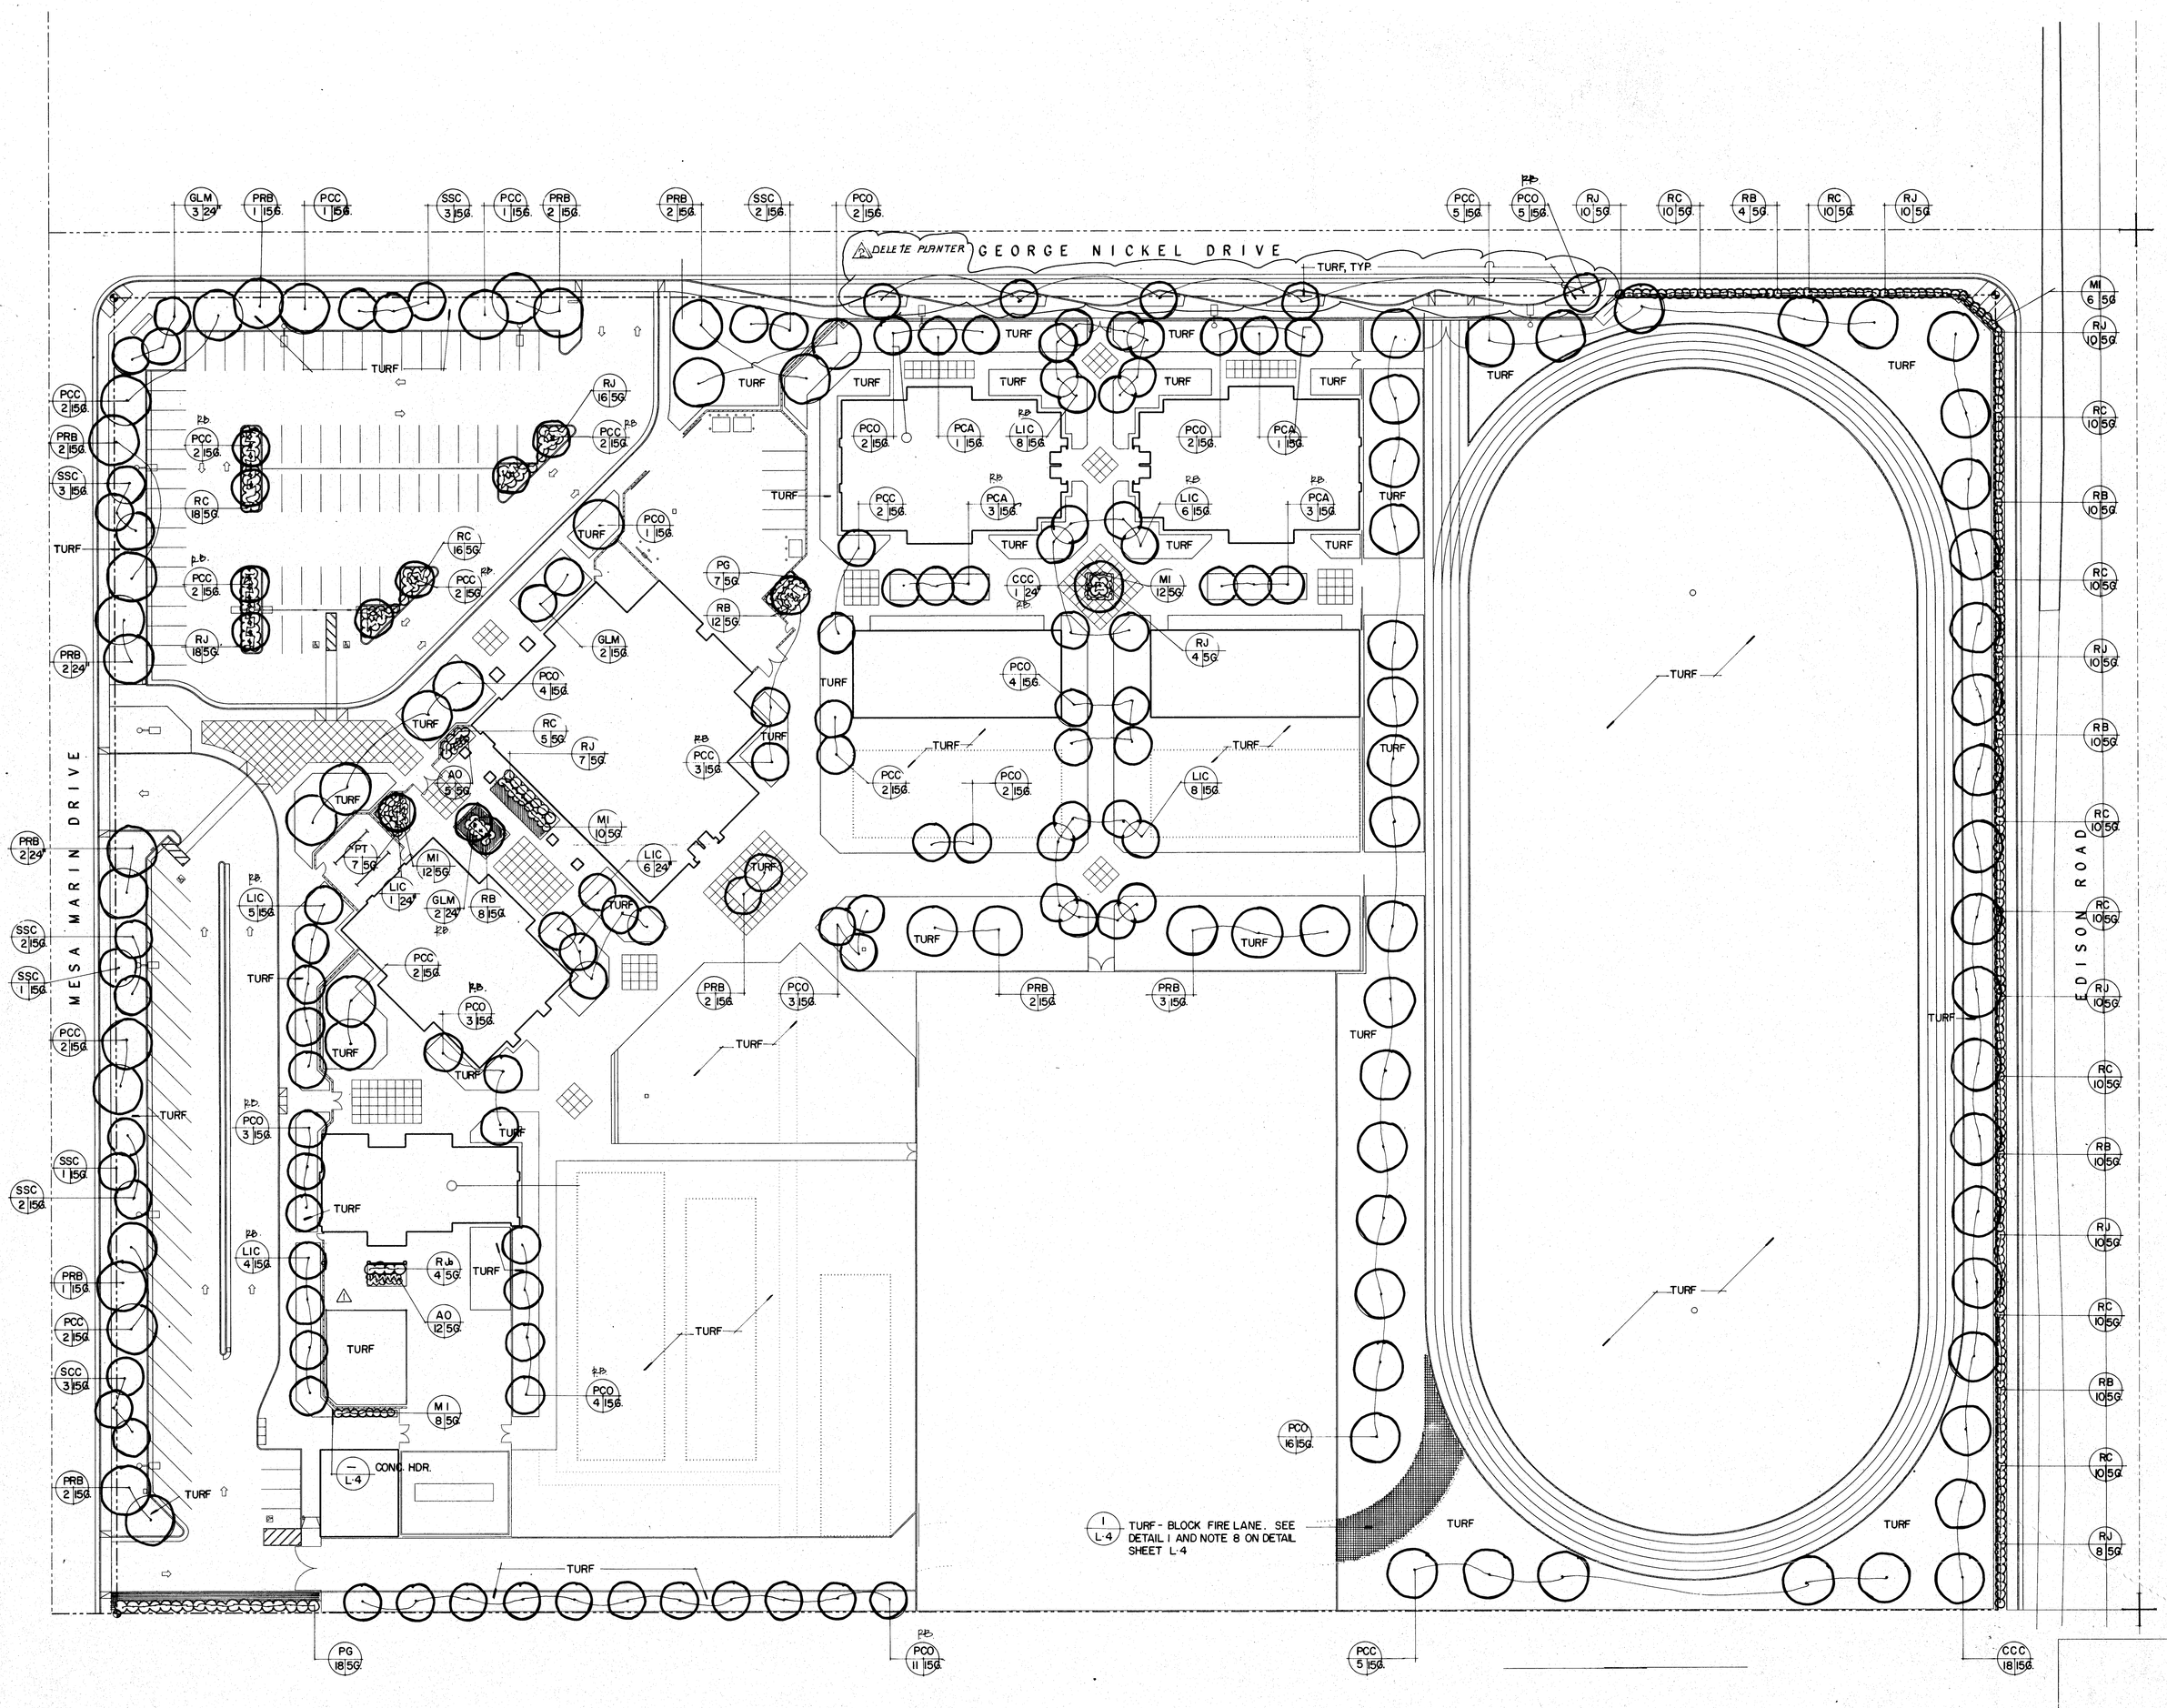

LANDSCAPE PLAN

1"=30'-0"

north

KLASSEN CORPORATION

Architecture
Planning
Construction

2021 Westwind Drive
Bakersfield, CA 93301
(805) 327-0875
(805) 327-5933 Fax

LICENSED ARCHITECT
T. PHIL KLASSEN
C10401
REV 1-31-95
STATE OF CALIFORNIA

The above drawings and specifications and ideas, designs and arrangements represented thereby are and shall remain the property of the architect, and no part thereof shall be copied, disclosed to others or used in connection with any work or project other than the specific project for which they have been prepared and developed without the written consent of the architect. In the event of conflict with these drawings or specifications shall constitute conclusive evidence of acceptance of these restrictions.
Written dimensions on these drawings shall have precedence over scaled dimensions; contractors shall verify and be responsible for all dimensions and conditions on the job and this office must be notified of any variations from the dimensions and conditions shown by these drawings. Shop details must be submitted to this office for approval before proceeding with fabrication.

BAKERSFIELD CITY SCHOOL DISTRICT

MESA MARIN ELEMENTARY SCHOOL

BAKERSFIELD, CA.

Sheet title: **LANDSCAPE PLAN**

REGISTERED LANDSCAPE ARCHITECT
RALPH ADAME
No. 2600
Expiration Date
STATE OF CALIFORNIA

LANDSCAPE ARCHITECTURE

RALPH ADAME A.S.L.A.
LANDSCAPE ARCHITECT #2600
5405 STOCKDALE HWY. #207
BAKERSFIELD, CALIF. 93309
(805) 397-0061

Date:	Issued for:

Date:	Revisions:
4-20-93	1 KINDER BLDG
5-16-94	2 INST. BLDG. ADD
10-94	A AS BUILTS

Drawn by: R.A.

Job no: 1223 9211.003

Dgn. file:

Sheet: **L-1**

Sheet of: 28

Date: 12-22-92

PORTION 1

CERTIFICATION STAMP
Department of General Services
Office of the State Architect
NOV 11 1993
Structural Safety Section
Checked By