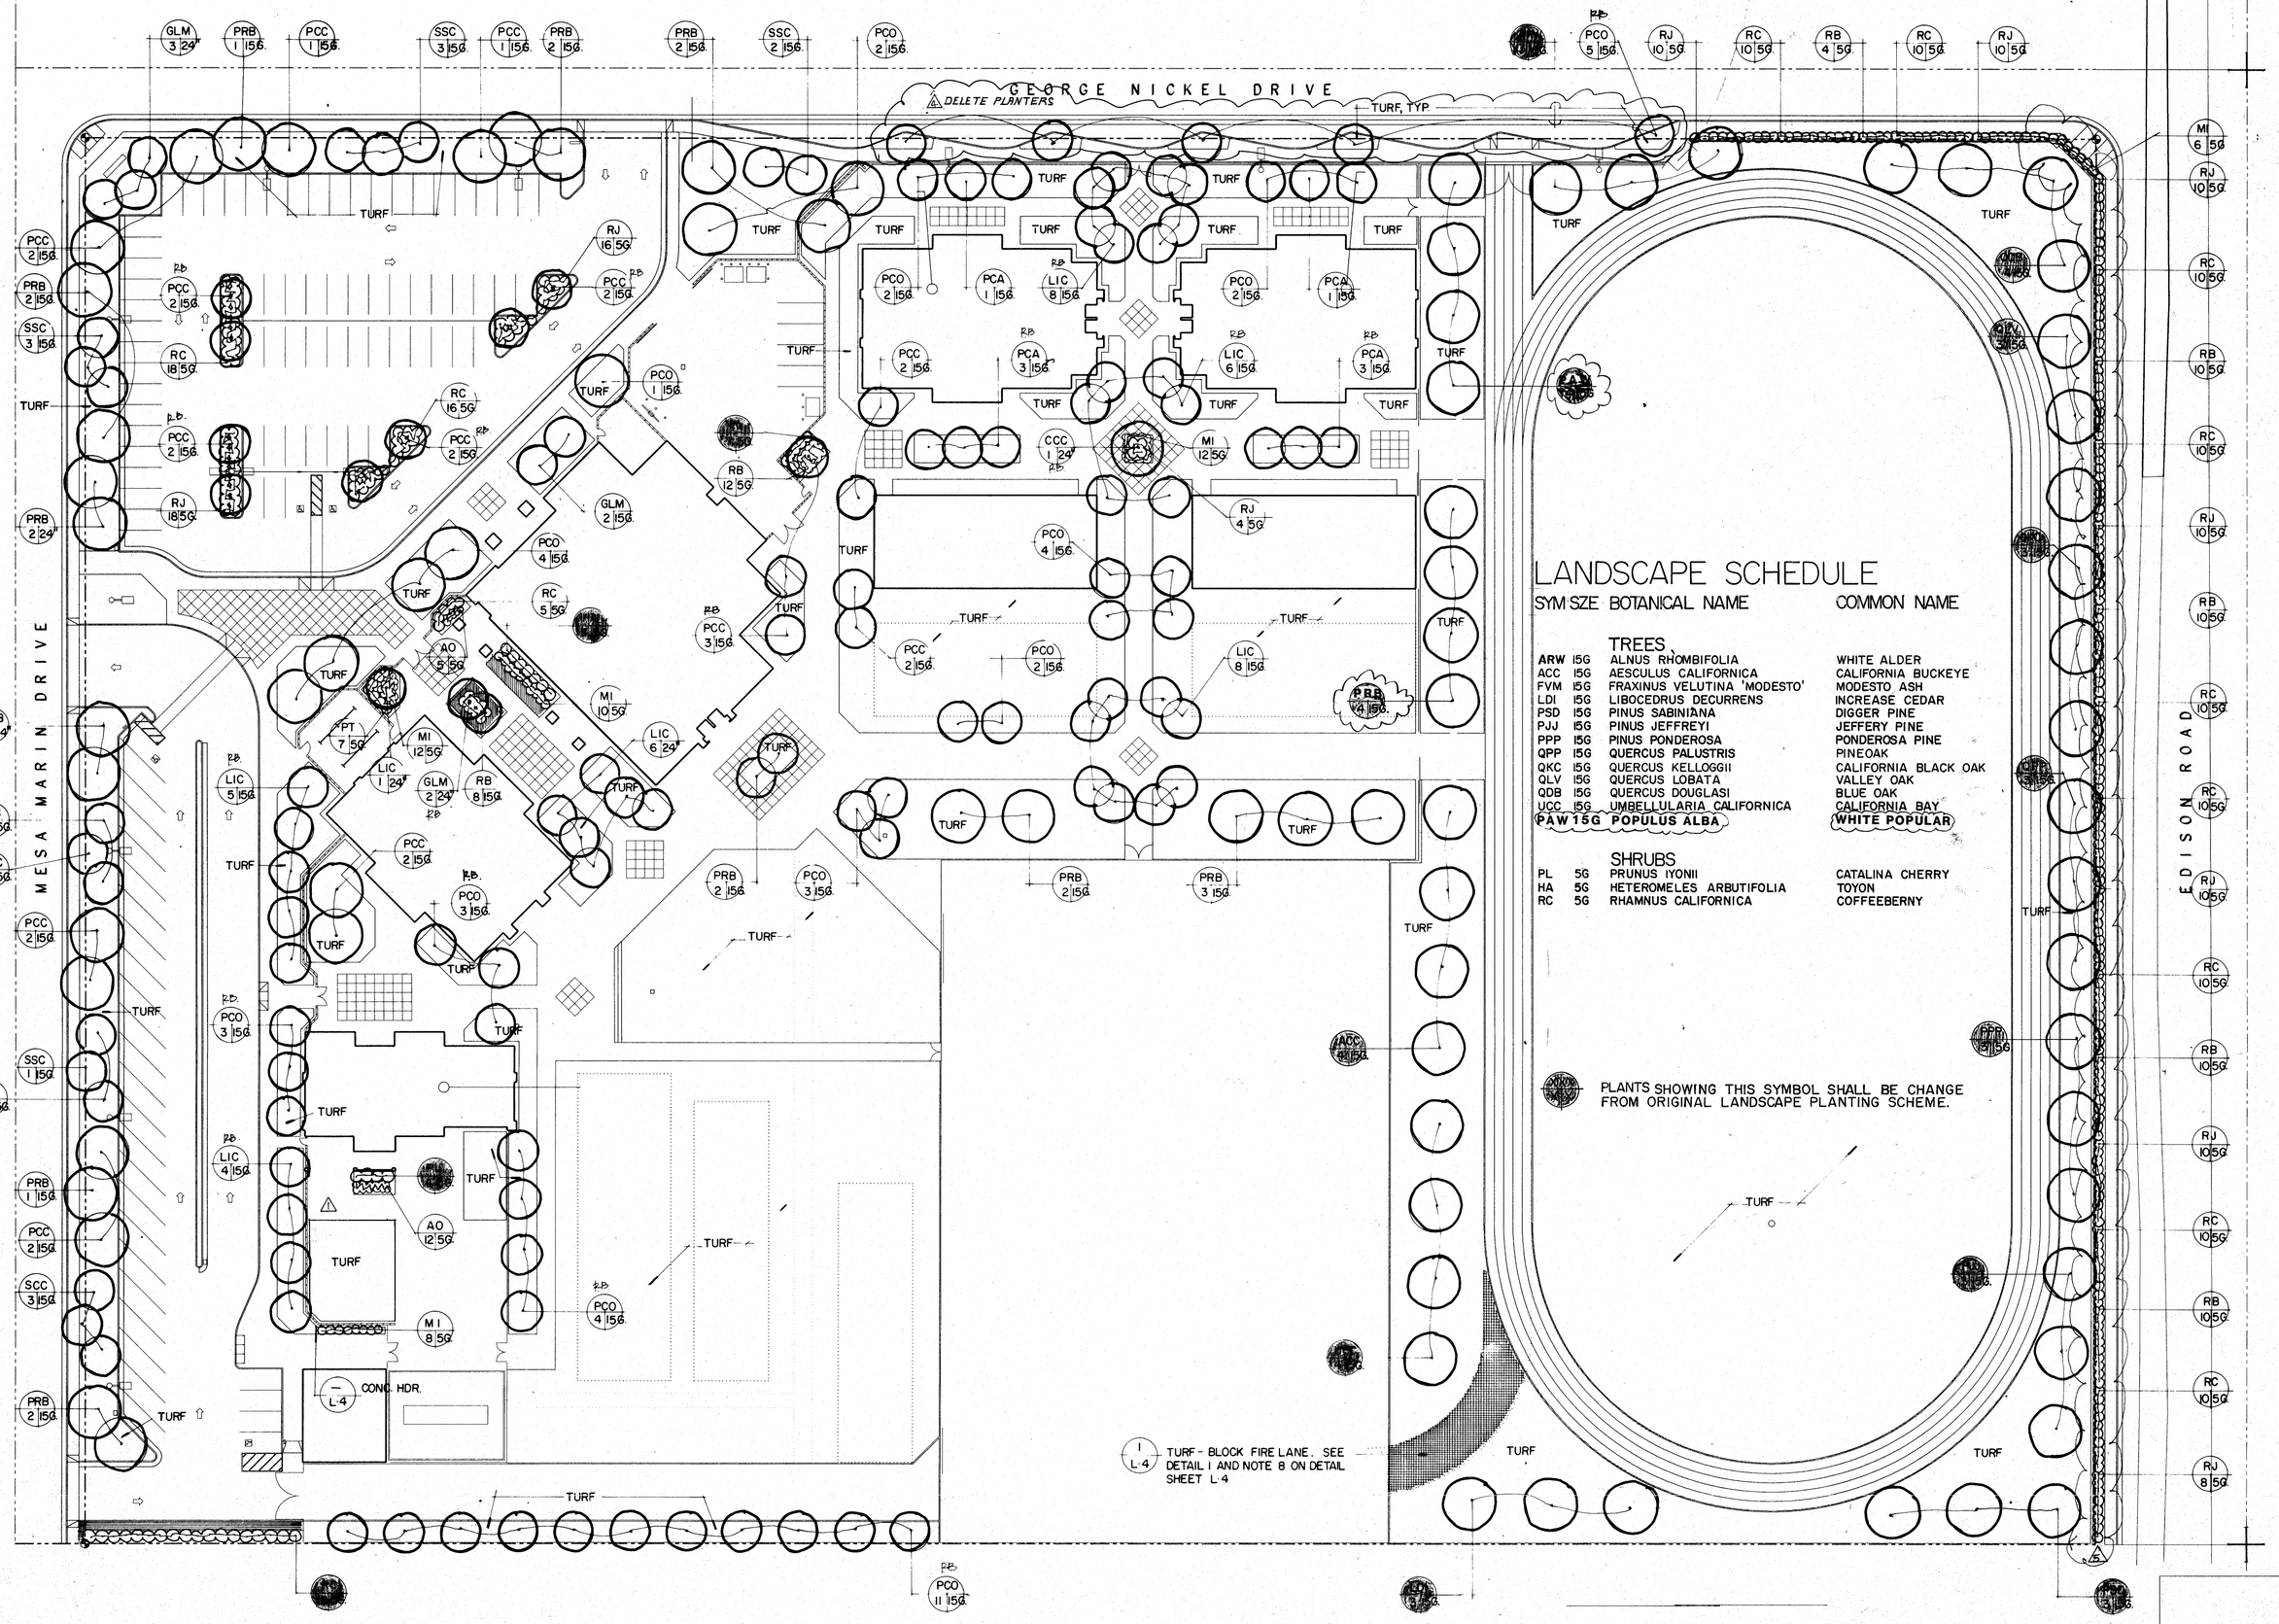

LANDSCAPE SCHEDULE

SYM	SIZE	BOTANICAL NAME	COMMON NAME
TREES			
ARW	15G	ALNUS RHOMBIFOLIA	WHITE ALDER
ACC	15G	AESCULUS CALIFORNICA	CALIFORNIA BUCKEYE
FVM	15G	FRAXINUS VELUTINA 'MODESTO'	MODESTO ASH
LDI	15G	LIBOCEDRUS DECURRENS	INCREASE CEDAR
PSD	15G	PINUS SABINIANA	DIGGER PINE
PJJ	15G	PINUS JEFFREYI	JEFFERY PINE
PPP	15G	PINUS PONDEROSA	PONDEROSA PINE
QPP	15G	QUERCUS PALUSTRIS	PINEOAK
QKC	15G	QUERCUS KELLOGGII	CALIFORNIA BLACK OAK
QLV	15G	QUERCUS LOBATA	VALLEY OAK
QDB	15G	QUERCUS DOUGLASI	BLUE OAK
UCC	15G	UMBELLULARIA CALIFORNICA	CALIFORNIA BAY
PAW	15G	POPULUS ALBA	WHITE POPULAR
SHRUBS			
PL	5G	PRUNUS IYONII	CATALINA CHERRY
HA	5G	HETEROMELES ARBUTIFOLIA	TOYON
RC	5G	RHAMNUS CALIFORNICA	COFFEEBERNY

LANDSCAPE PLAN · 'NATURE TRAIL' LAYOUT

1"=30'-0"

north

KLASSEN CORPORATION
Architecture
Planning
Construction
2021 Westwind Drive
Bakersfield, CA 93301
(805) 327-0875
(805) 327-5933 Fax

LICENSED ARCHITECT L. PHIL KLASSEN C10401 EXP. 1-31-95 STATE OF CALIFORNIA

The above drawings and specifications and ideas, designs and arrangements represented thereby are and shall remain the property of the architect, and no part thereof shall be copied, disclosed to others or used in connection with any work or project other than the specific project for which they have been prepared and developed without the written consent of the architect. When coupled with other drawings, specifications shall constitute conclusive evidence of acceptance of these restrictions.

Written dimensions on these drawings shall have precedence over scaled dimension. contractors shall verify and be responsible for, all dimensions and conditions on the job and this office must be notified of any variations from the dimensions and conditions shown by these drawings. Shop details must be submitted to this office for approval before proceeding with fabrication.

BAKERSFIELD CITY SCHOOL DISTRICT
MESA MARIN ELEMENTARY SCHOOL
BAKERSFIELD, CA.

Sheet title: **LANDSCAPE PLAN**

LANDSCAPE ARCHITECTURE
RALPH ADAME A.S.L.A.
LANDSCAPE ARCHITECT #2000
5405 STOCKDALE HWY. #207
BAKERSFIELD, CALIF. 93309
(805) 397-6681

REGISTERED LANDSCAPE ARCHITECT RALPH ADAME No. 2000 STATE OF CALIFORNIA

Date:	Issued for:

Date:		Revisions:
4-20-93	1	KINDER BLDG
4-7-94	2	NATURE TRAIL
4-14-94	3	TREE REV'S I.B. 23
6-6-94	4	INST BULL. 0235
10-94	5	AS BUILTS
3-18-94	6	INST. BULL 17

Drawn by: R.A.
Job no: 1223 9211.003
Dgn. file:
Sheet: **L-1NT**
Sheet of: 28
Date: 12-22-92
I.B. 22

Office of Regional Safety Section of the State Architect
Date: 4/6/94