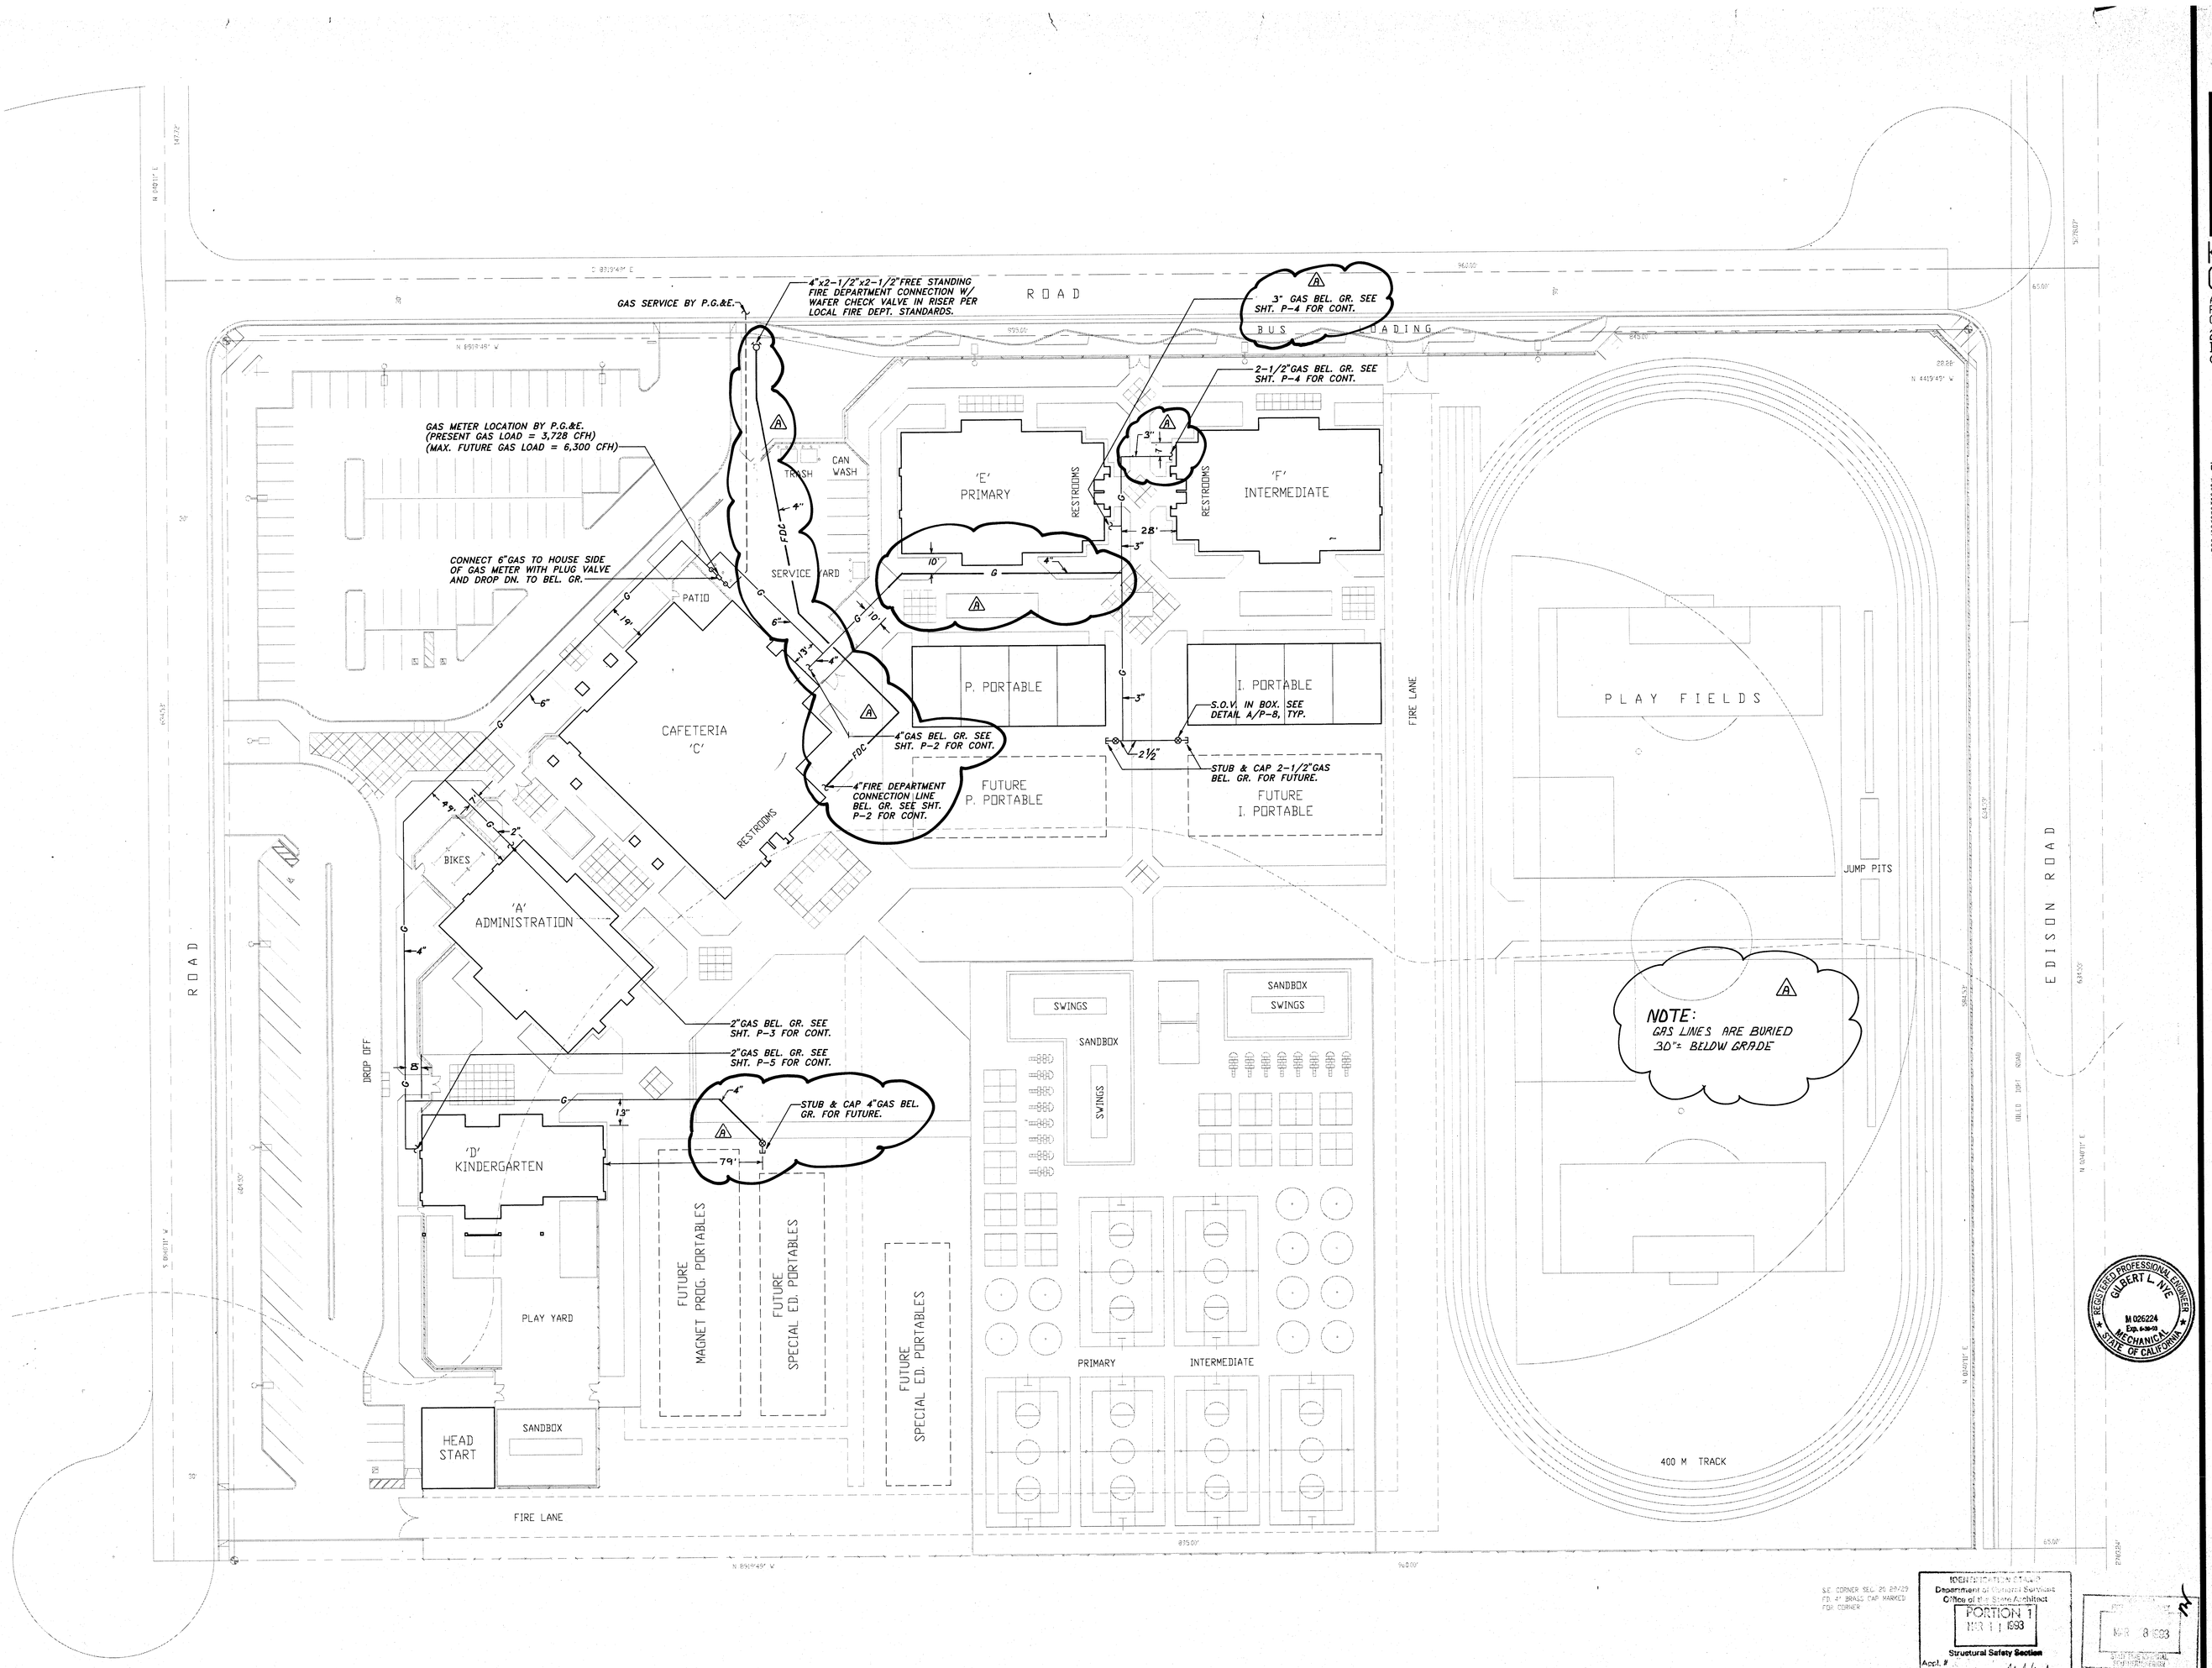

PLUMBING SITE PLAN

1"=30'-0"

north

1200 ACRES NET
1324 ACRES GROSS

SE CORNER SEC. 20 29/29 FD. 4" BRASS CAP MARKED FOR CORNER

IDENTIFICATION STAMP
Department of General Services
Office of the State Architect
PORTION 1
MAR 11 1993
Structural Safety Section
Appl. #
Quickchecked By

MAR 8 1993

OFFICE OF THE STATE ARCHITECT
ACCESS COMPLIANCE SECTION
APPLICATION PER W. KID. ENG.
9112 MAR 11 93
Reviewed by

REGISTERED PROFESSIONAL ENGINEER
GILBERT L. NYE
M 026224
Exp. 6-30-93
MECHANICAL
STATE OF CALIFORNIA

KLASSEN CORPORATION
Architecture
Planning
Construction
2021 Westwind Drive
Bakersfield, CA 93301
(805) 327-0875

LICENSED ARCHITECT
LYLE RAINS
C-8,610 C-10,401

The above drawings and specifications and ideas, designs and arrangements represented thereby are and shall remain the property of the undersigned and no part thereof shall be used for any purpose except as to the construction of the work or project other than for specific project for which they have been prepared and developed without the written consent of the undersigned. Visual contact with these drawings or specifications shall constitute conclusive evidence of acceptance of these restrictions.
Before proceeding with any work, contractors shall hold preconstruction meeting with all subcontractors and shall verify and be responsible for all dimensions and conditions on the job. Any discrepancy in the drawings or specifications or from the dimensions and conditions shown by these drawings shall be details must be submitted to the office for approval before processing and fabrication.

BAKERSFIELD CITY SCHOOL DISTRICT
MESA MARIN ELEMENTARY SCHOOL
BAKERSFIELD, CALIFORNIA

Sheet title: PLUMBING SITE PLAN

Lawrence • Nye • Decker Associates
CONSULTING MECHANICAL ENGINEERS, INCORPORATED
1300 N. Real Avenue, Suite 18 Fresno, Ca 93727
(209) 255-0136 FAX-209-255-4837

Date:	Issued for:

Date:	Revisions:
5-24-93	ADD #2
10-94	AS BUILTS

Drawn by: DLB
Checked by: DAD
Job no: 1223
Sheet: P.1
Sheet of: 8
Date: