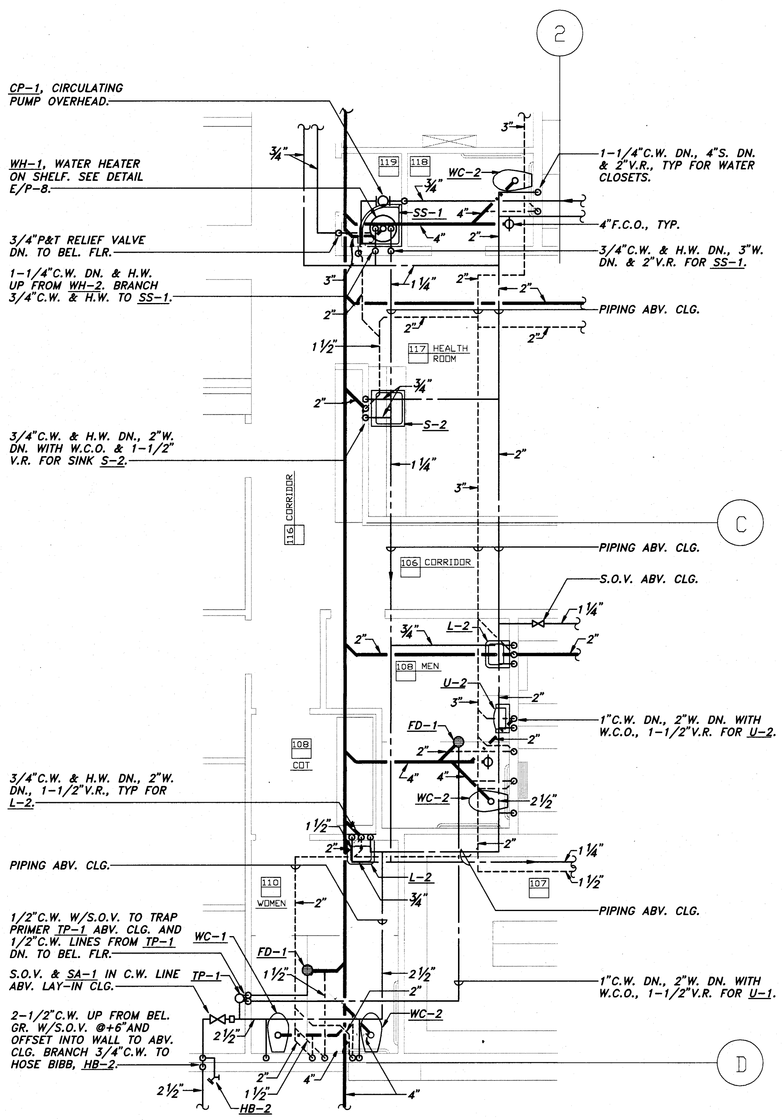

DETAILED PLUMBING PLAN

SCALE: 1/4"=1'-0"

A
P-3

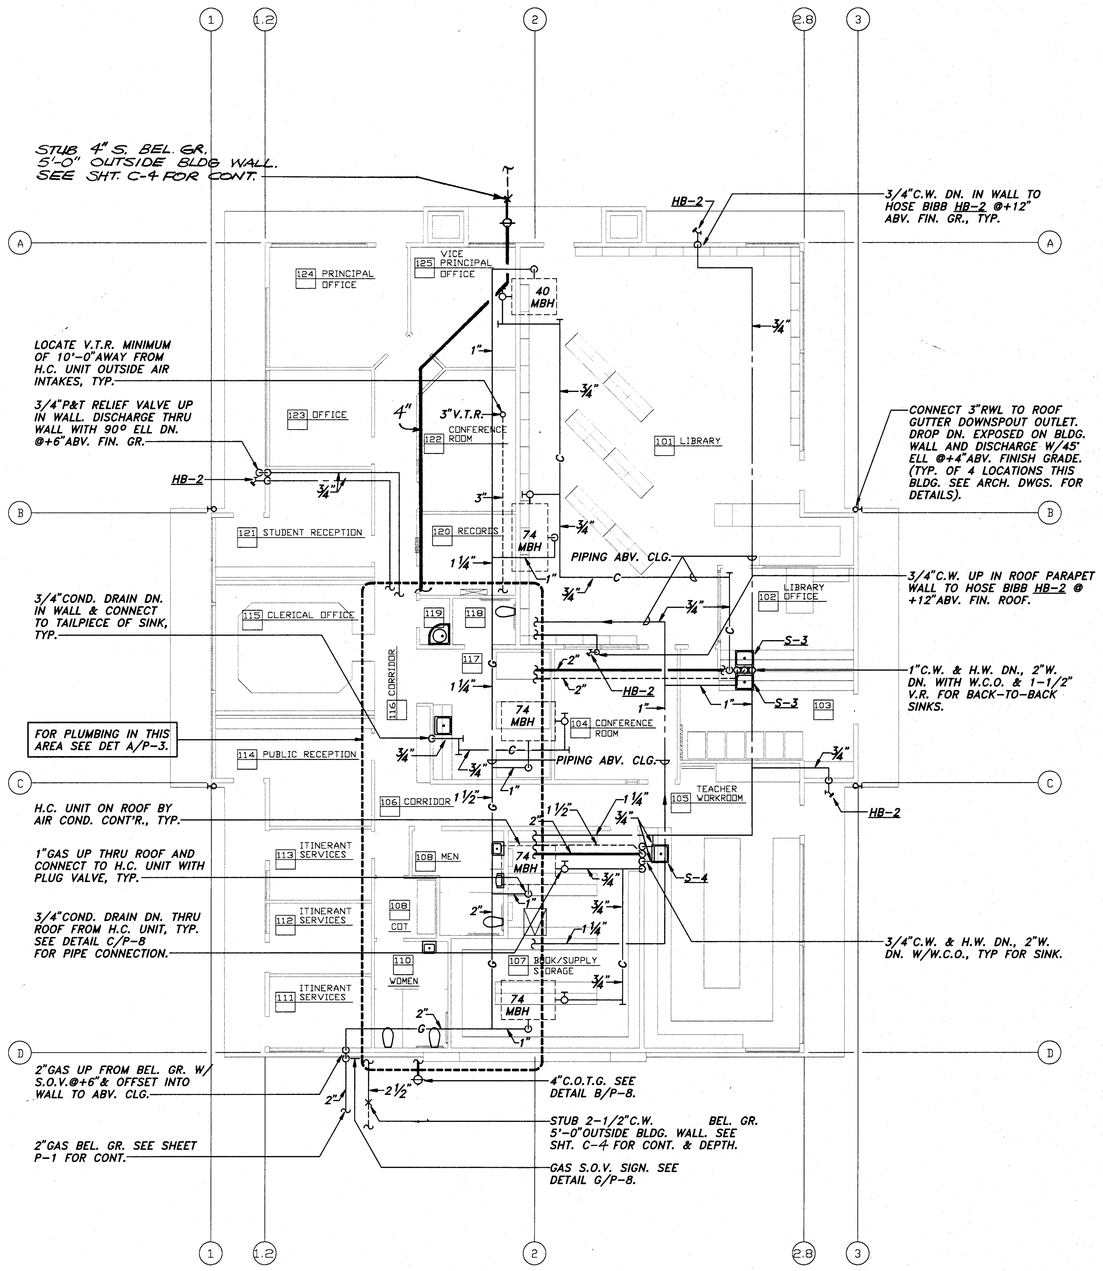

ADMINISTRATION / LIBRARY PLUMBING PLAN 'A'

1/8" = 1'-0"

OFFICE OF THE STATE ARCHITECT
ACCESS COMPLIANCE SECTION
APPLICATION PER W. JOD REQ.
59152 MAR 11 93
APPROVAL of this plan does not authorize or approve any omission or deviation from applicable regulations.
Reviewed by

APPROVED
FIRE PROTECTION ENGINEER
MAR 8 1993
STATE FIRE MARSHAL
SOUTHERN DIVISION

IDENTIFICATION STAMP
Department of General Services
Office of the State Architect
PORTION 1
MAR 11 1993
Structural Safety Section
Appl. # 59152
Is checked by

KLASSEN CORPORATION
Architecture
Planning
Construction
2021 Westwind Drive
Bakersfield, CA 93301
(805) 327-0875

LICENSED ARCHITECT
STATE OF CALIFORNIA
C-8,610 C-10,495

The above drawings and specifications are the property of the architect and no part thereof shall be used, reused or copied in whole or in part without the express written consent of the architect. Written dimensions have been generated and developed without any variance or omission. Contractor shall verify and be responsible for all dimensions. Contractor shall notify the architect of any discrepancies before proceeding with work. Acceptance of these restrictions constitutes evidence of intent and agreement to comply with the provisions.
Shop drawings or other submittals must accompanied by a letter from the contractor stating that he has checked and approved the submittal and that it is in conformance with the plans and specifications. Shop drawings or other submittals not accompanied by a letter from the contractor will be returned without review. The office must be notified of any variance from the contract documents. Shop drawings or other submittals must be submitted to the office for approval before processing and fabrication.

BAKERSFIELD CITY SCHOOL DISTRICT
MESA MARIN ELEMENTARY SCHOOL
BAKERSFIELD, CALIFORNIA

Sheet title: ADMINISTRATION/LIBRARY PLUMBING PLAN - BUILDING "A"

REGISTERED PROFESSIONAL ENGINEER
GILBERT L. NYE
M 026224
Exp. 6-30-93
MECHANICAL
STATE OF CALIFORNIA

Lawrence • Nye • Becker Associates
CONSULTING MECHANICAL ENGINEERS, INCORPORATED
1300 T. Street Avenue, Suite 29 Fresno, Ca. 93721
(209) 233-6161 FAX-233-3241-6207

Date:	Issued For:

Date:		Revisions:
5-24-93	1	ADD #2
10-94	2	AS BUILTS

Drawn by: DLB
Checked by: DAG
Job no: 1223
Sheet: P.3
Sheet of: 8
Date: