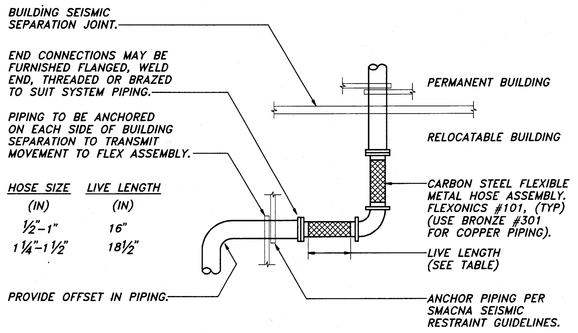

SEISMIC JOINT FOR PIPE DETAIL

A / P-5

SCALE: NONE

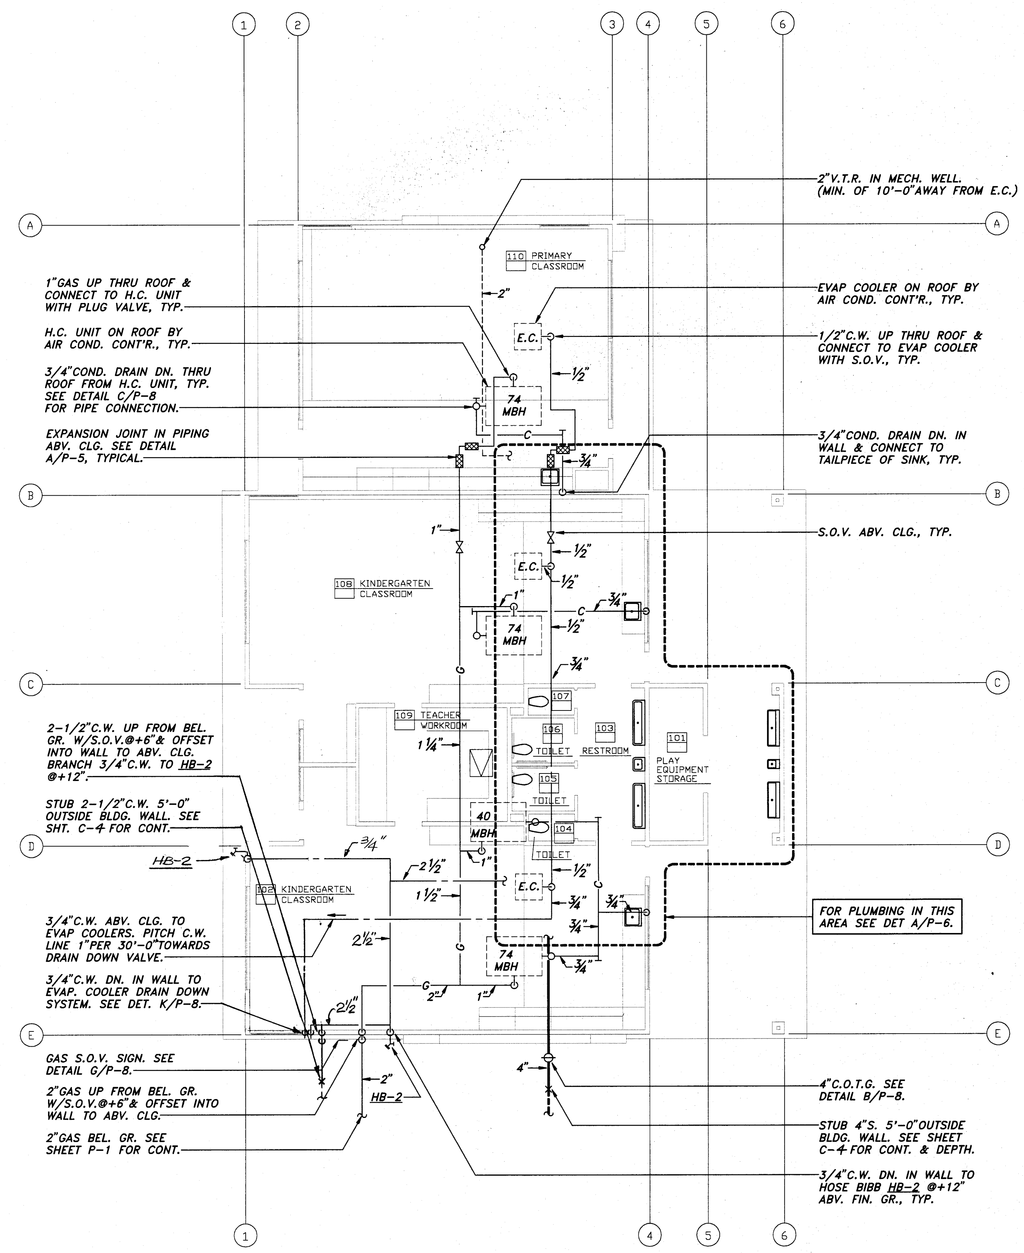

north

KINDERGARTEN CLASSROOM PLUMBING PLAN

'D'

1/8" = 1'-0"

IDENTIFICATION STAMP
Department of General Services
Office of the State Architect
PORTION 1
MAR 11 1993
Structural Safety Section
Appl. # 93
Bookmarked By

OFFICE OF THE STATE ARCHITECT
ACCESS COMPLIANCE SECTION
APPLICATION PER W. 3020 (B)(C)
91 v 2 MAR 11 93
Approval of this plan does not authorize an inspector deviations of or waiver from applicable requirements.
Reviewed by

RECEIVED
MAR 8 1993

KLASSEN CORPORATION
Architecture
Planning
Construction
2021 Westwind Drive
Bakersfield, CA 93301
(805) 327-0875

LICENSED ARCHITECT L. NYE BECKER C10401 REN. 1-31-95 STATE OF CALIFORNIA

C-8,610 C-10,401

The above drawings and specifications and ideas, designs and arrangements represented thereby are and shall remain the property of the undersigned and no part thereof shall be used for any other work and project than the specific project for which they have been prepared and developed and that these drawings and specifications are not to be loaned, copied or reproduced. Visual contact with these drawings and specifications shall constitute conclusive evidence of acceptance of these restrictions.
Contractors shall verify and be responsible for all dimensions and conditions. Do not scale drawings. Contractors shall verify and be responsible for all dimensions and conditions on the job. The office must be notified of any variations from the dimensions and conditions shown by these drawings. Shop details must be submitted to this office for approval before proceeding with fabrication.

BAKERSFIELD CITY SCHOOL DISTRICT
MESA MARIN ELEMENTARY SCHOOL
BAKERSFIELD, CALIFORNIA

Sheet title: KINDERGARTEN PLUMBING PLAN BUILDING "D"

REGISTERED PROFESSIONAL ENGINEER GILBERT L. NYE M 026224 Exp. 6-30-93 MECHANICAL STATE OF CALIFORNIA

Lawrence • Nye • Becker Associates
CONSULTING MECHANICAL ENGINEERS, INCORPORATED
1300 E. Shaw Avenue, Suite 19 Fresno, Ca 93710
(209) 226-6181 FAX-209-224-0287

Date:	Issued For:

Date:		Revisions:
6-24-93	1	ADD #2
10-94	A	AS BUILTS

Drawn by: DLB
Checked by: DAO
Job no: 1223
Sheet: P.5
Sheet of: 8
Date: