


N ROOF FRAMING PLAN 1/8"= 1'-0"

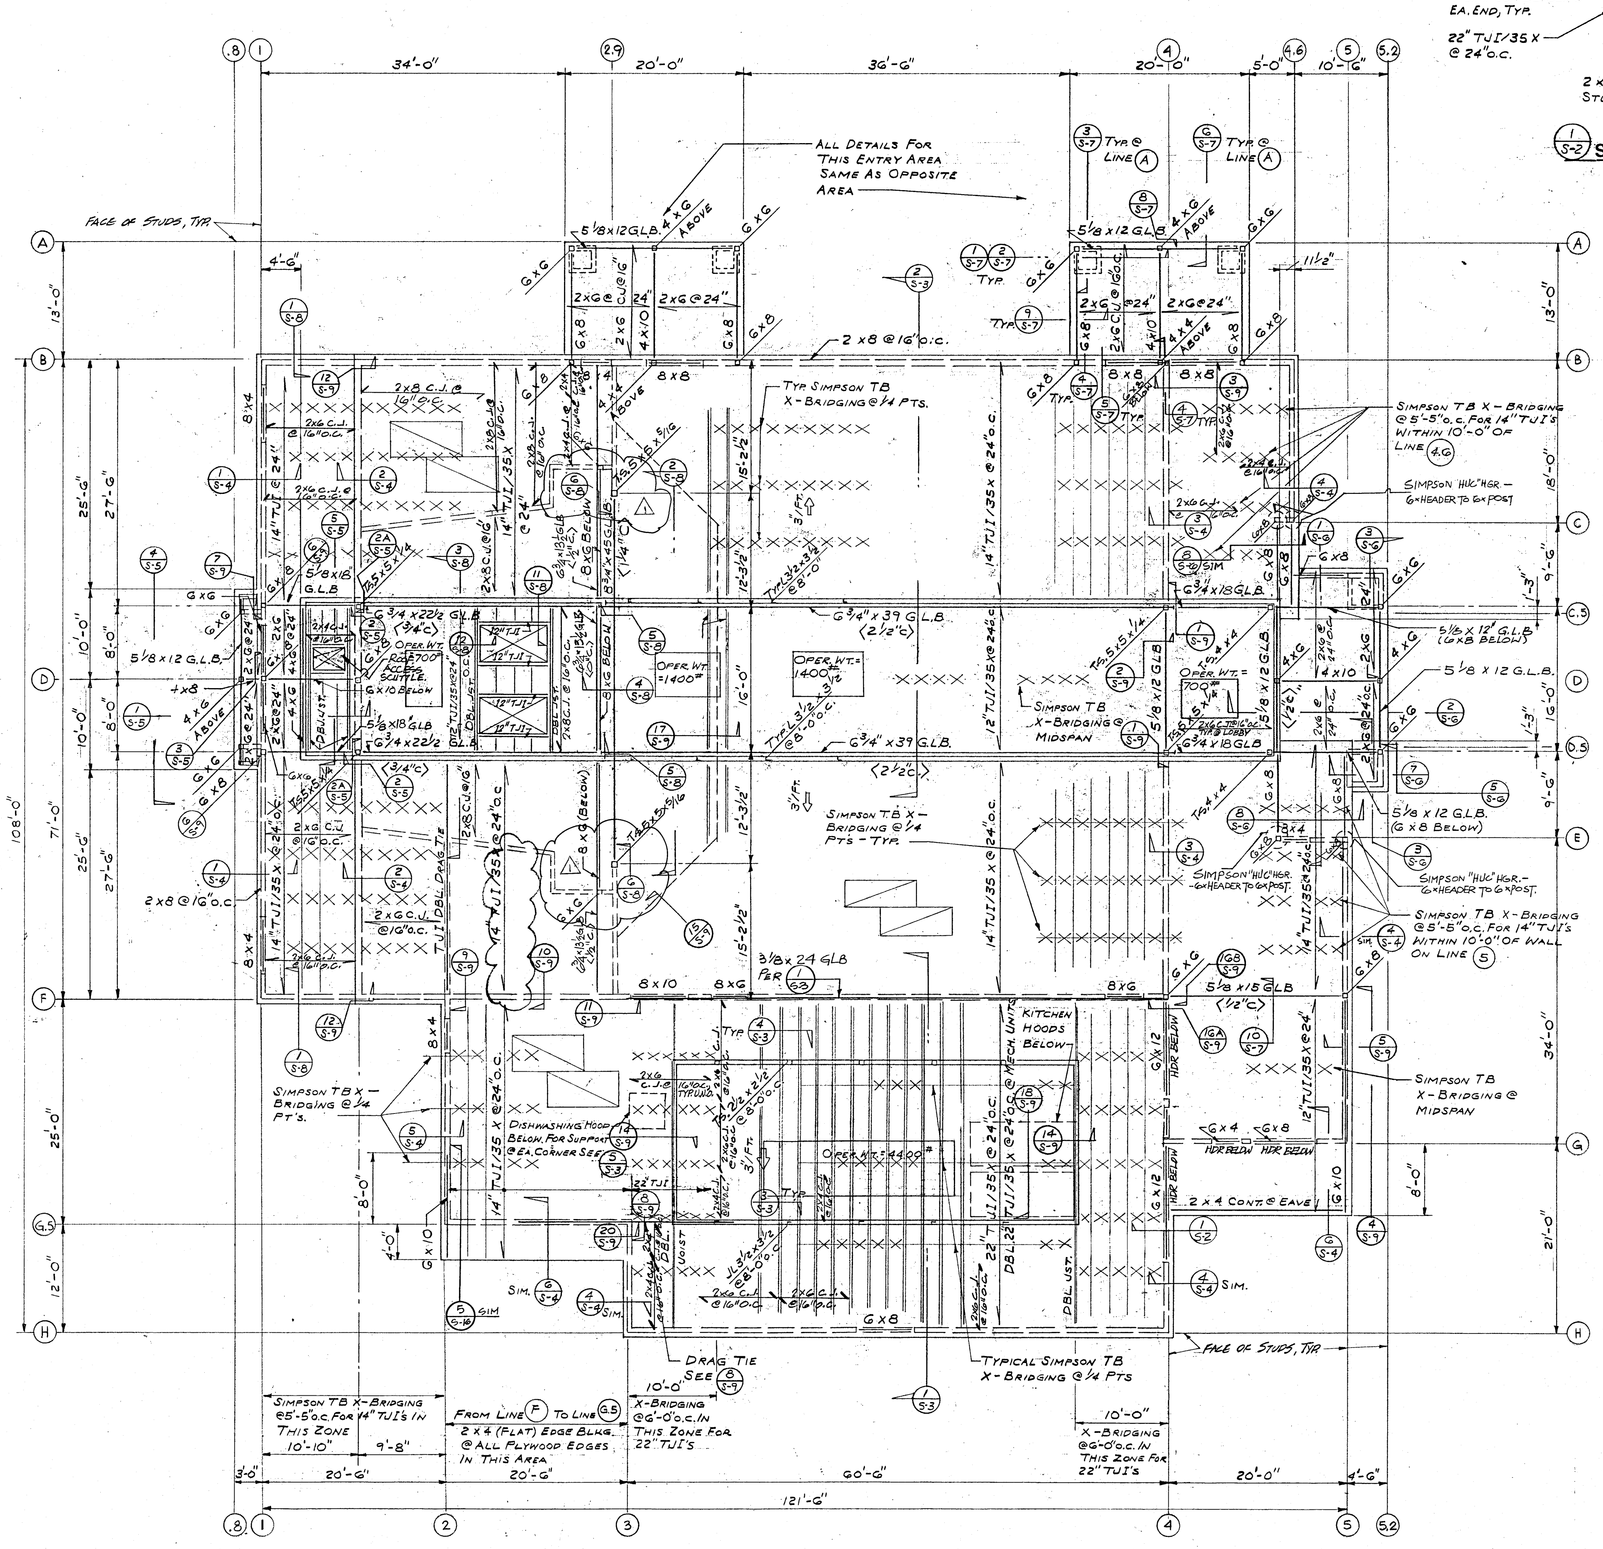


1/S-2 SECTION @ DRAG TIE 1/2" = 1'-0"

| MINIMUM BOLTED DOUBLE PLATE SPLICES | | |
|---|---|---|
| Along Line | # 3/4" ∅ Bolts Each Side of Splice | Reference Detail |
| B | 3 | 1/ST-3 |
| F | 3 | 1/ST-3 |
| H | 2 | 2/ST-3 |
| 1 | 2 | 2/ST-3 |
| 1.5 | 2 | 2/ST-3 |
| 2 | 2 | 2/ST-3 |
| 4 | 3 | 1/ST-3 |
| 4.5 | 2 | 2/ST-3 |
| 5 | 2 | 2/ST-3 |

**TYPICAL ROOF SHEATHING**

5/8" T. & G. Plywood **(Stagger As Shown)**
"Structural 1" CD w/Ext. Glue
10d @6" o.c. - boundaries of diaphragms & edges of sheets
10d @10" o.c. - Intermediate supports
No edge blocking required, except where noted.

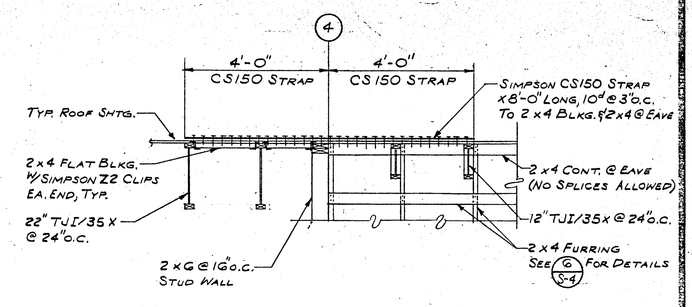
**KLASSEN CORPORATION**
Architecture
Planning
Construction
2021 Westwind Drive
Bakersfield, CA 93301
(805) 327-0875
(805) 327-5933 Fax


REGISTERED ARCHITECT K. DALE KLASSEN Exp. 1-31-95 STATE OF CALIFORNIA


The above designs, drawings, specifications and ideas, designs and arrangements represented thereby are and shall remain the property of the architect and no part thereof shall be copied, disclosed to others or used in connection with any work or project other than the specific project for which they have been prepared and developed without the written consent of the architect. Visual contact with these drawings or specifications shall constitute conclusive evidence of acceptance of these restrictions.
Written dimensions on these drawings shall have precedence over scaled dimension. Contractors shall verify and be responsible for all dimensions and conditions on the job and this office must be notified of any variance from the dimensions and conditions shown by these drawings. Shop drawings must be submitted to this office for approval before proceeding with fabrication.


BAKERSFIELD CITY SCHOOL DISTRICT
**MESA MARIN** ELEMENTARY SCHOOL
JEWETT STREET
BAKERSFIELD, CALIFORNIA

Sheet title: **CAFETERIA ROOF FRAMING PLAN**


**WARREN A. MINNER**
STRUCTURAL ENGINEER
1716 OAK STREET
BAKERSFIELD, CALIFORNIA 93301
PHONE (805) 324-9724
FAX (805) 324-3416


| Date: | Issued for: |
|---|---|
| | |

| Date: | Revisions: |
|---|---|
| 7-2-93 | ADD #4, Item 2 |
| 4-10-94 | 1 INST. BULL. DIV. |
| 9-94 | A AS BUILTS |

Drawn by: J.V.
Checked by: G.D.
Job no:
Sheet: **S-2**
Date: 3-8-93

REGISTERED PROFESSIONAL ENGINEER WARREN A. MINNER No. 863 STRUCTURAL STATE OF CALIFORNIA
Exp. Date 12-31-95