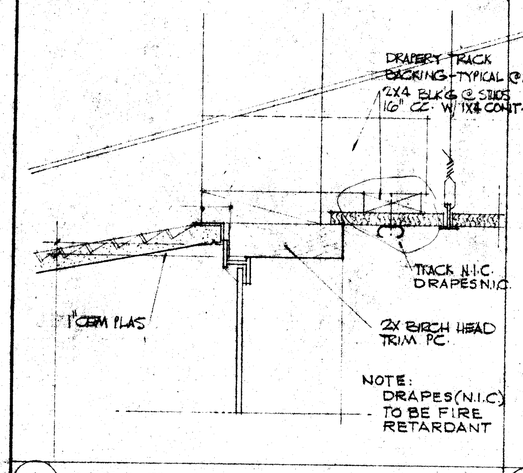

1 HEAD 3" = 1'-0"

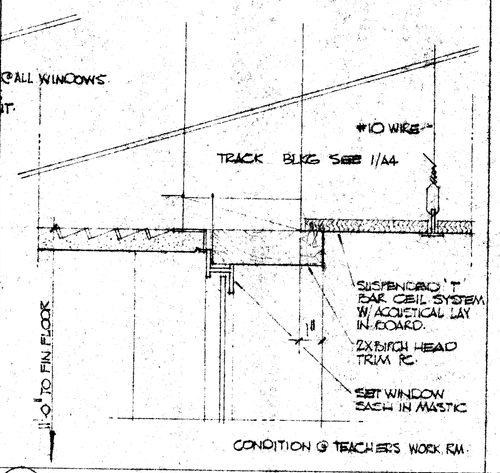

5 HEAD 3" = 1'-0"

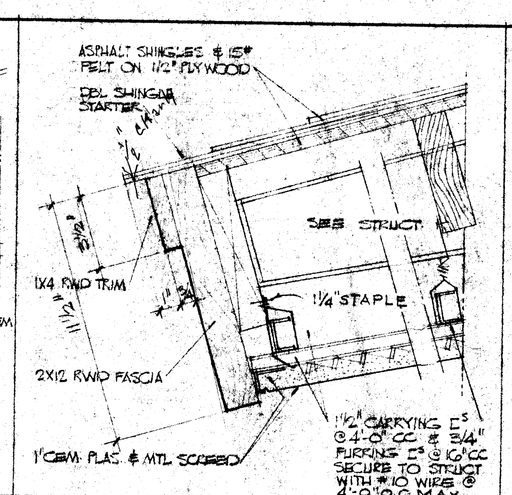

9 EAVE DETAIL 3" = 1'-0"

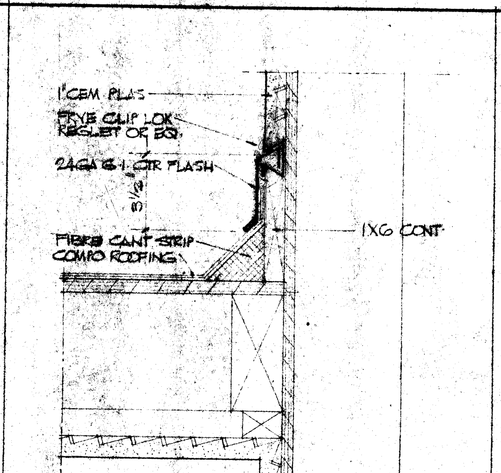

13 CANOPY ROOF @ VERT. WALL 3" = 1'-0"

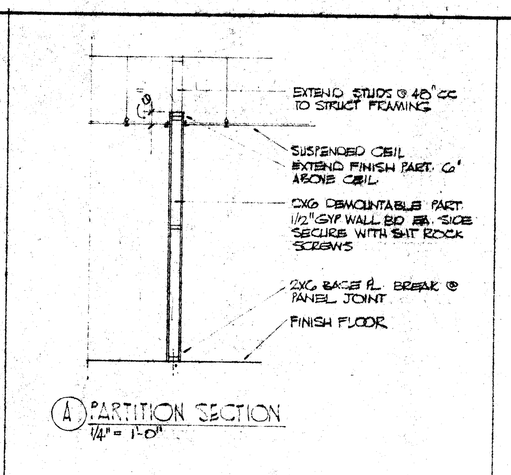

A PARTITION SECTION 1/4" = 1'-0"

17 DEMOUNTABLE PARTITION DETAILS

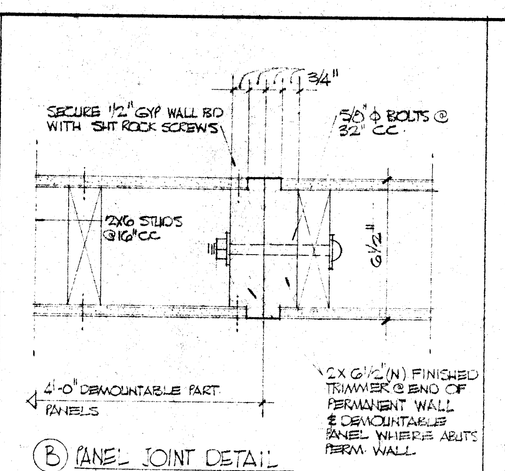

B PANEL JOINT DETAIL 3" = 1'-0"

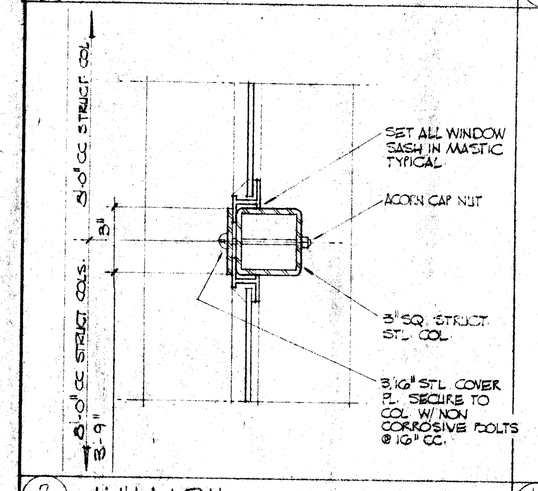

2 MULLION 3" = 1'-0"

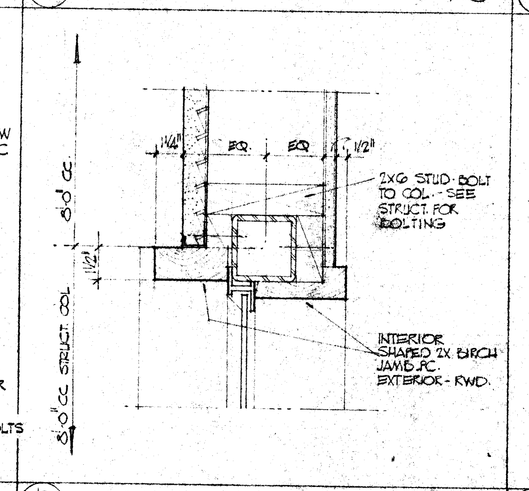

6 JAMB 3" = 1'-0"

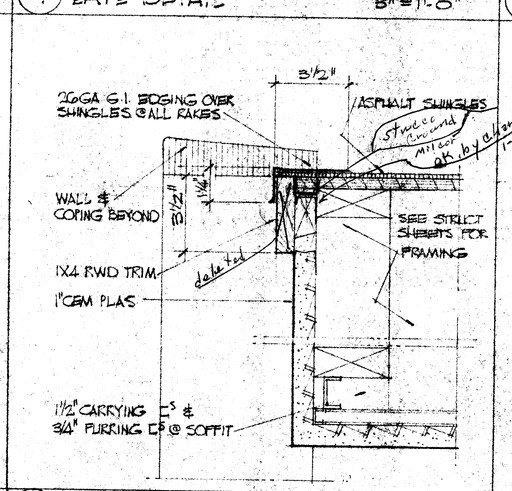

10 OVERHANG & SOFFIT @ RAKE 3" = 1'-0"

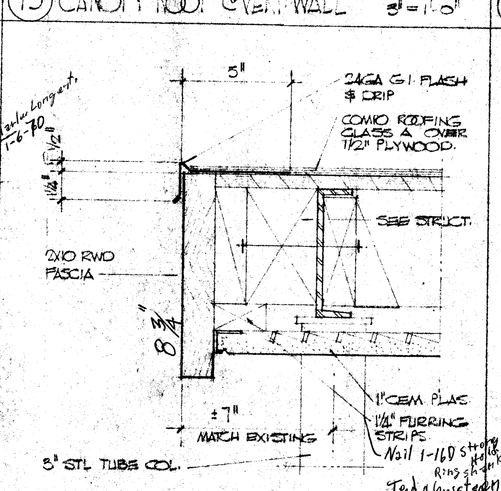

14 CANOPY EAVE - TYP. 3" = 1'-0"

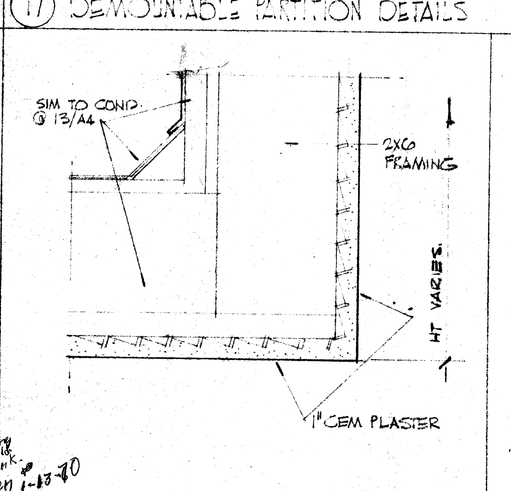

18 CANOPY TRANSITION @ SLOPED ROOF

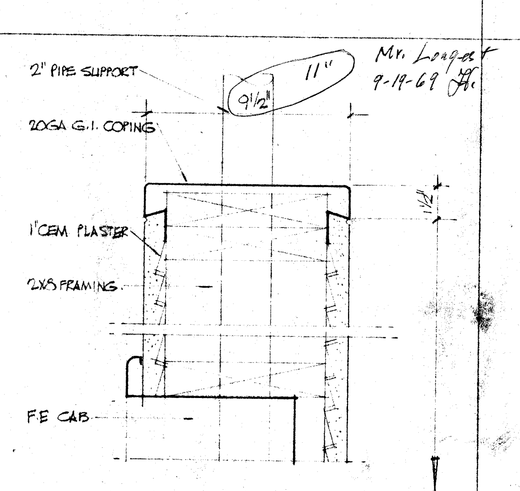

21 COPING @ D.F. WALL 3" = 1'-0"

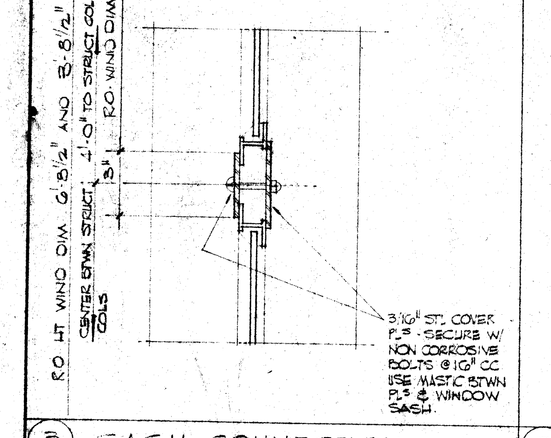

3 SASH CONNECTION 3" = 1'-0"

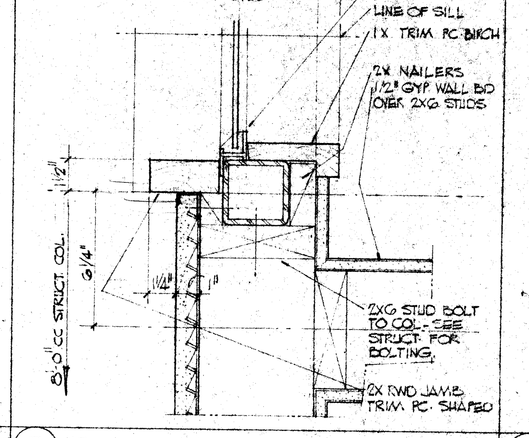

7 JAMB 3" = 1'-0"

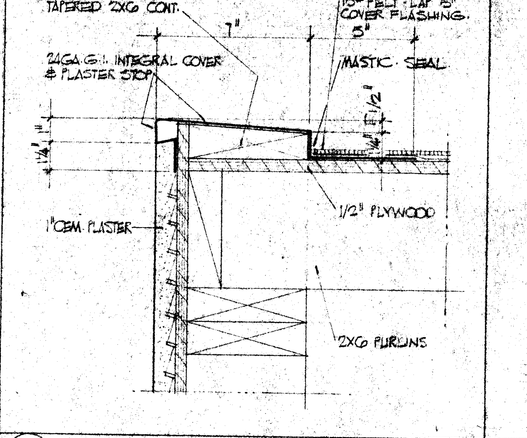

11 COPING @ RAKE 3" = 1'-0"

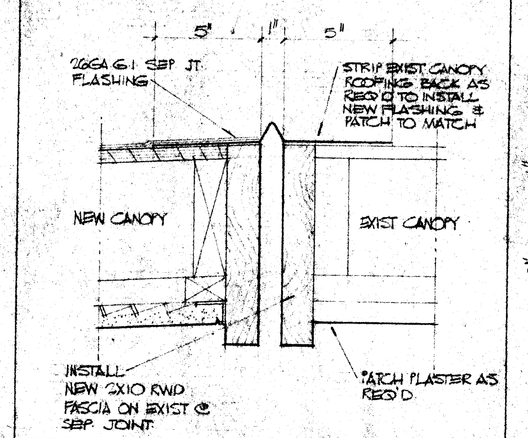

15 FLASHING @ CANOPY SEPARATION

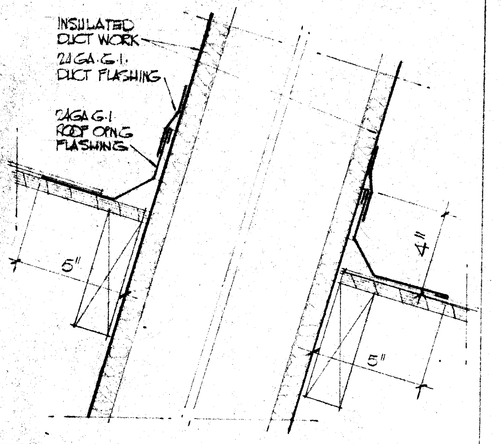

19 DUCT FLASHING 3" = 1'-0"

 

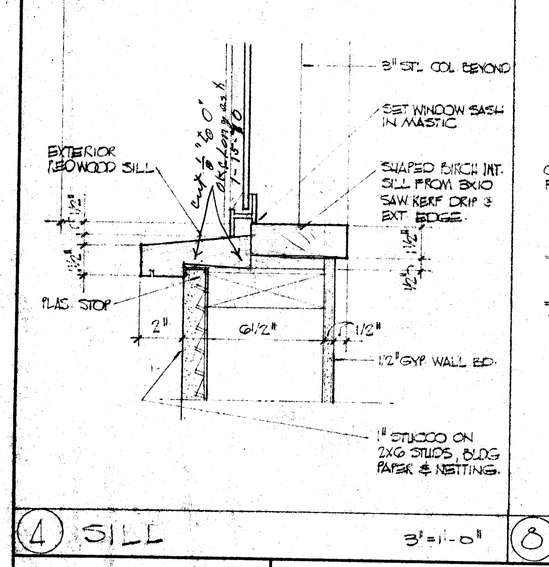

4 SILL 3" = 1'-0"

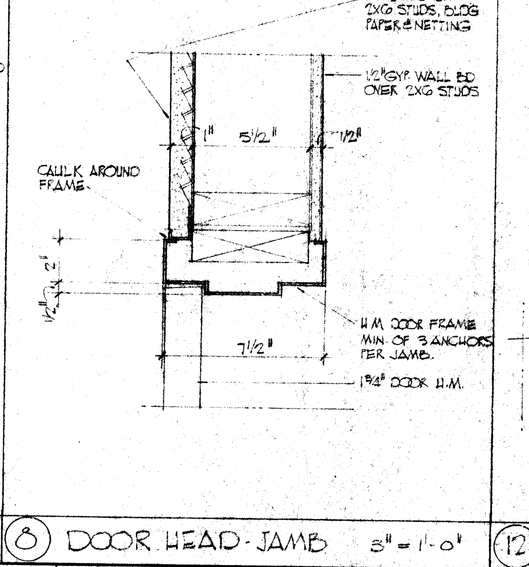

8 DOOR HEAD - JAMB 3" = 1'-0"

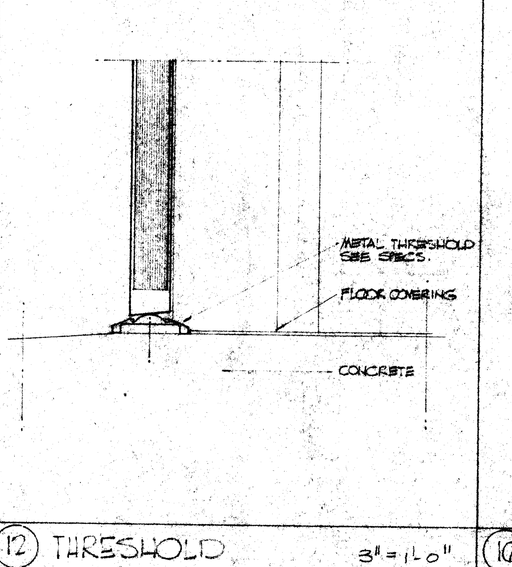

12 THRESHOLD 3" = 1'-0"

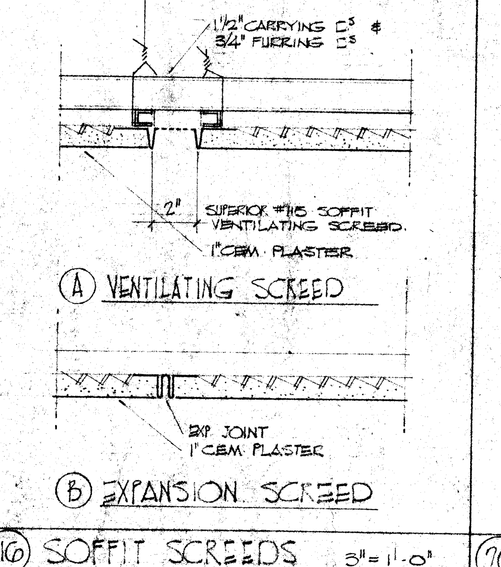

16 SOFFIT SCREEDS 3" = 1'-0"

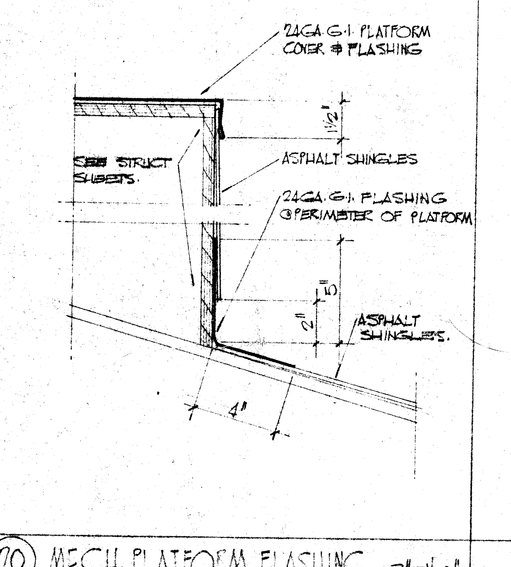

20 MECH. PLATFORM FLASHING 3" = 1'-0"

 

CHECK AND VERIFY ALL DIMENSIONS AND CONDITIONS AT JOB SITE BEFORE PROCEEDING WITH THE WORK REPORT ANY DISCREPANCIES TO THE ARCHITECT

7/68 DIETERICH-POST CLEARPRINT 1000H

323 B/S APPROVED JUN 11 1969 Office of the State Architect By [illegible]

BAKERSFIELD CITY SCHOOL DISTRICT BOARD OF EDUCATION APPROVED: [signature] MAY 19, 1969 DATE

APPROVED STATE FIRE MARSHAL STATE OF CALIFORNIA DATE [illegible] BY [signature]

MARK	DATE	REVISION	DRAWN DWE
			DATE 6-10-69
			JOB NO. 6991-17
			CHECK'D P.

EDDY & PAYNTER ASSOCIATES
ARCHITECTS C-895 C-1654
2901 H ST. • 325-9048 BAKERSFIELD • CALIF.

E/P A.I.A. W. Paynter

DOOR & WINDOW DETAILS - MISC. DETAILS.
LINCOLN JUNIOR HIGH SCHOOL ADDITION
BAKERSFIELD CITY SCHOOL DISTRICT
BAKERSFIELD, KERN COUNTY, CALIFORNIA.

A4 OF SHEETS