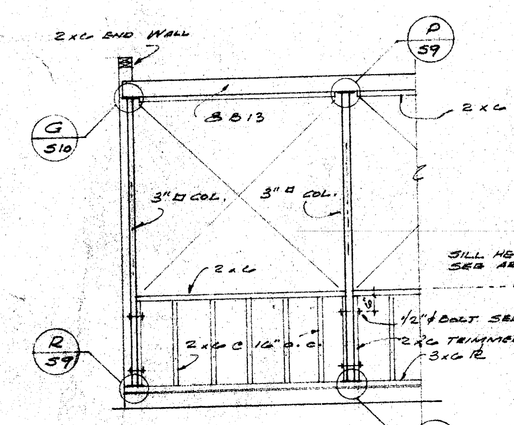

AT END WALL

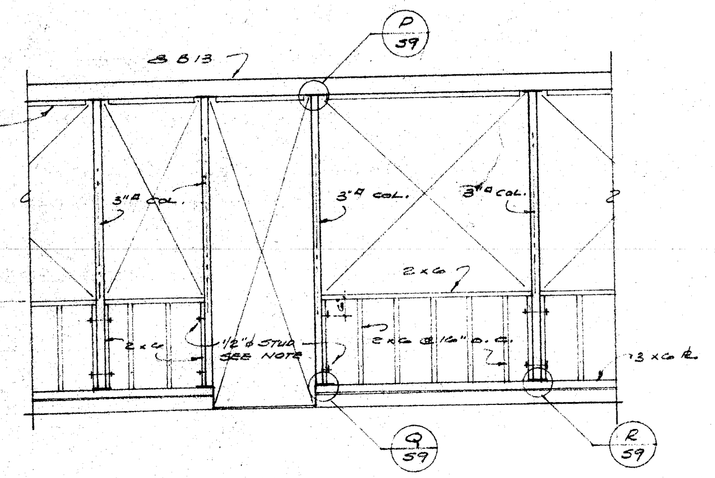

AT DOOR AND WINDOW

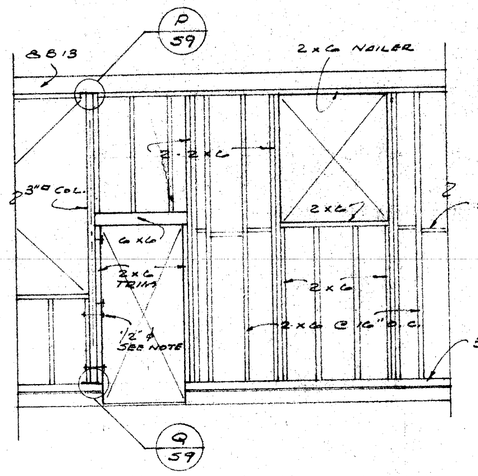

AT FRAMED WALL

TYPICAL SIDE WALL FRAMING (A S11)

NOTE: ATTACH TRIMMERS TO 3"ø COLUMNS AS SHOWN WITH 1/2"ø BOLTS - 6" MIN. END DISTANCE AND 4'-0" MAX. O.C. WITH 2-BOLTS MIN. PER PIECE. WHERE TRIMMER OCCURS ON ONE SIDE ONLY USE 7/8"ø WELDED STUDS IN LIEU OF 1/2"ø BOLTS.

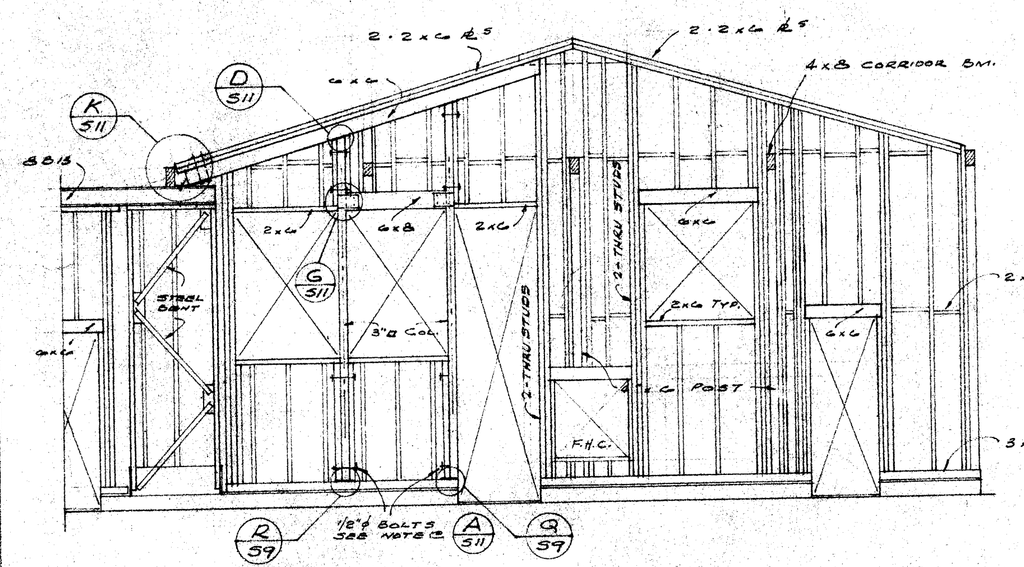

WEST WALL ELEVATION (B S11) UNIT "C"

ALL STUDS 2x6 @ 16" O.C.

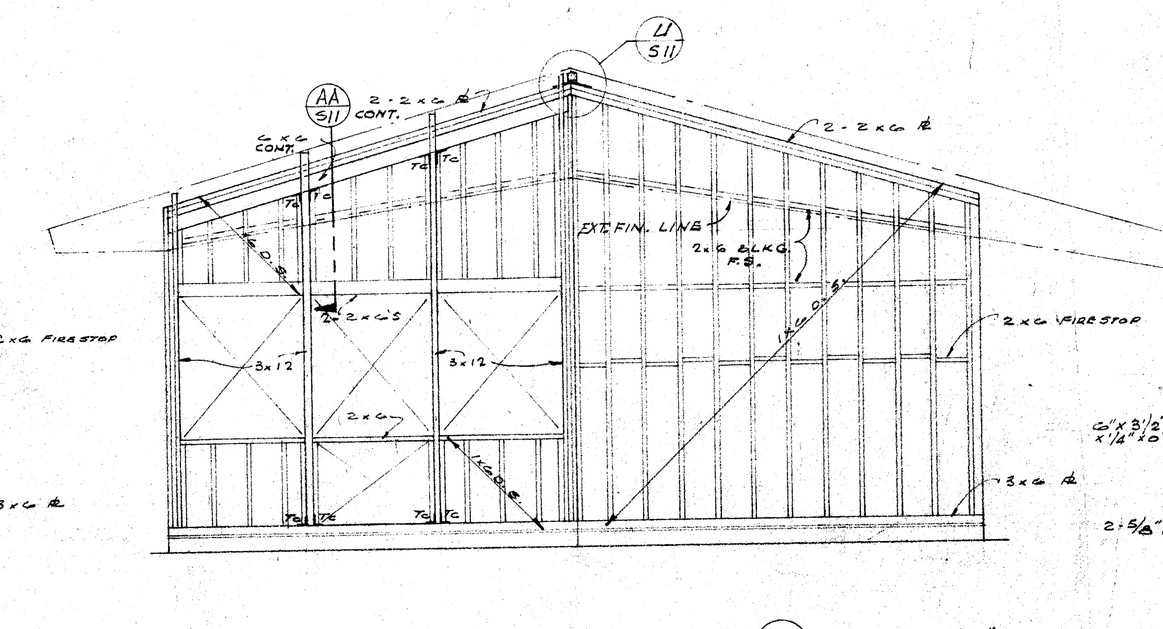

NORTH WALL ELEVATION (C S11) UNIT "C"

ALL STUDS 2x6 @ 16" O.C.

PLAN

DETAIL (U S11)

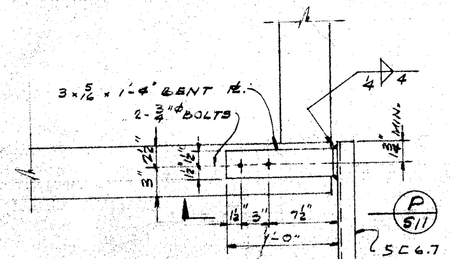

PLAN DETAIL (O S11)

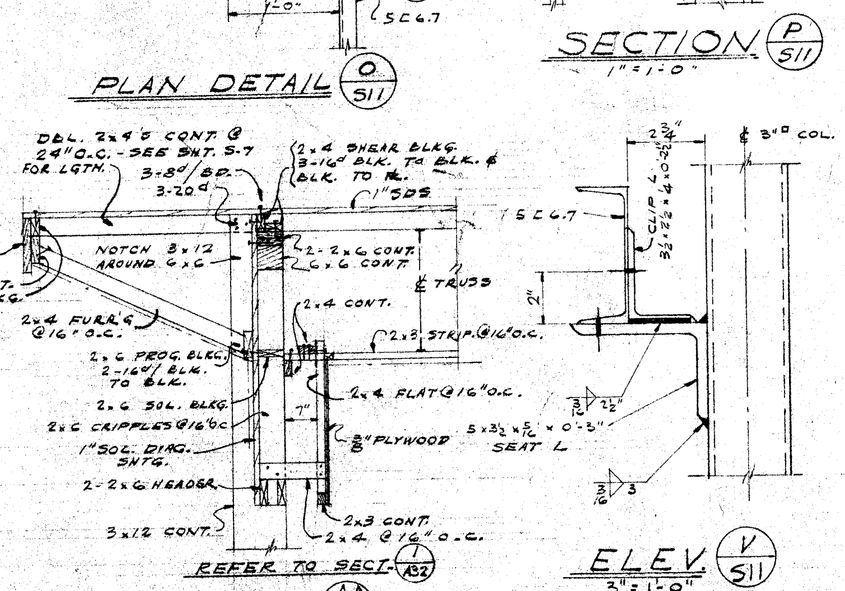

SECTION (AA S11)

ELEV (V S11)

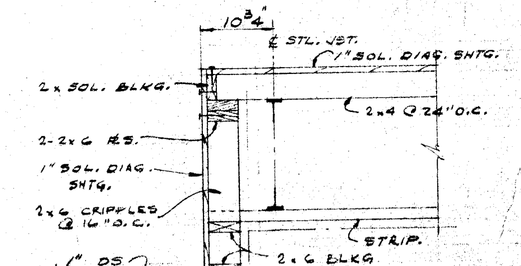

SECTION (P S11)

SECTION (Q S11)

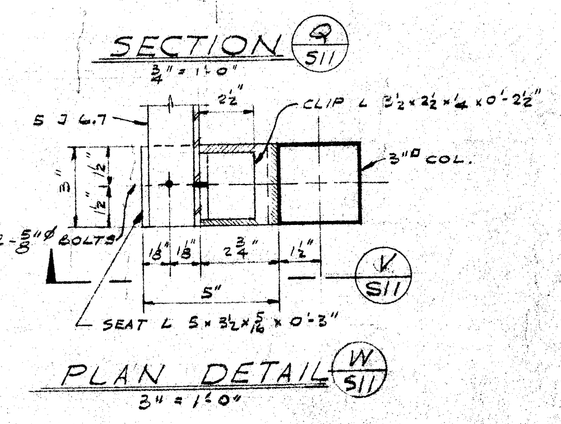

PLAN DETAIL (W S11)

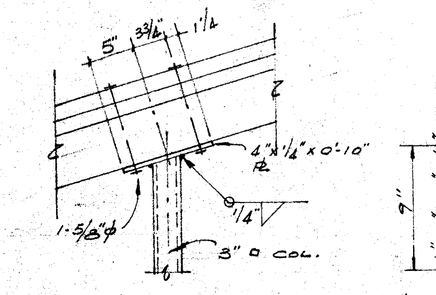

DETAIL (D S11)

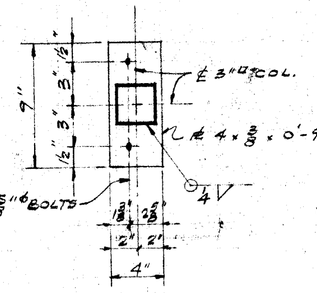

INTERMEDIATE R. DETAIL (E S11)

1/2" = 1'-0"

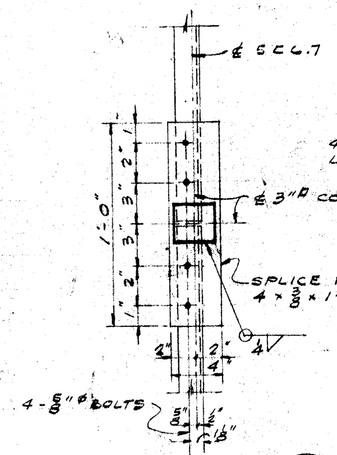

SPLICE DETAIL (F S11)

1/2" = 1'-0"

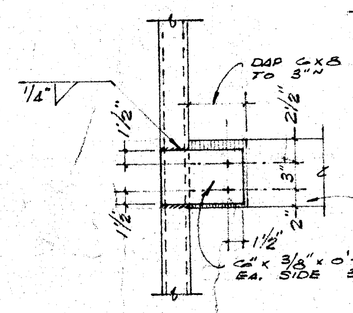

DETAIL (G S11)

1" = 1'-0"

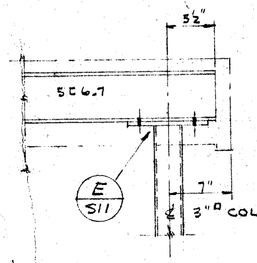

DETAIL AT END OF PASSAGE (H S11)

1" = 1'-0"

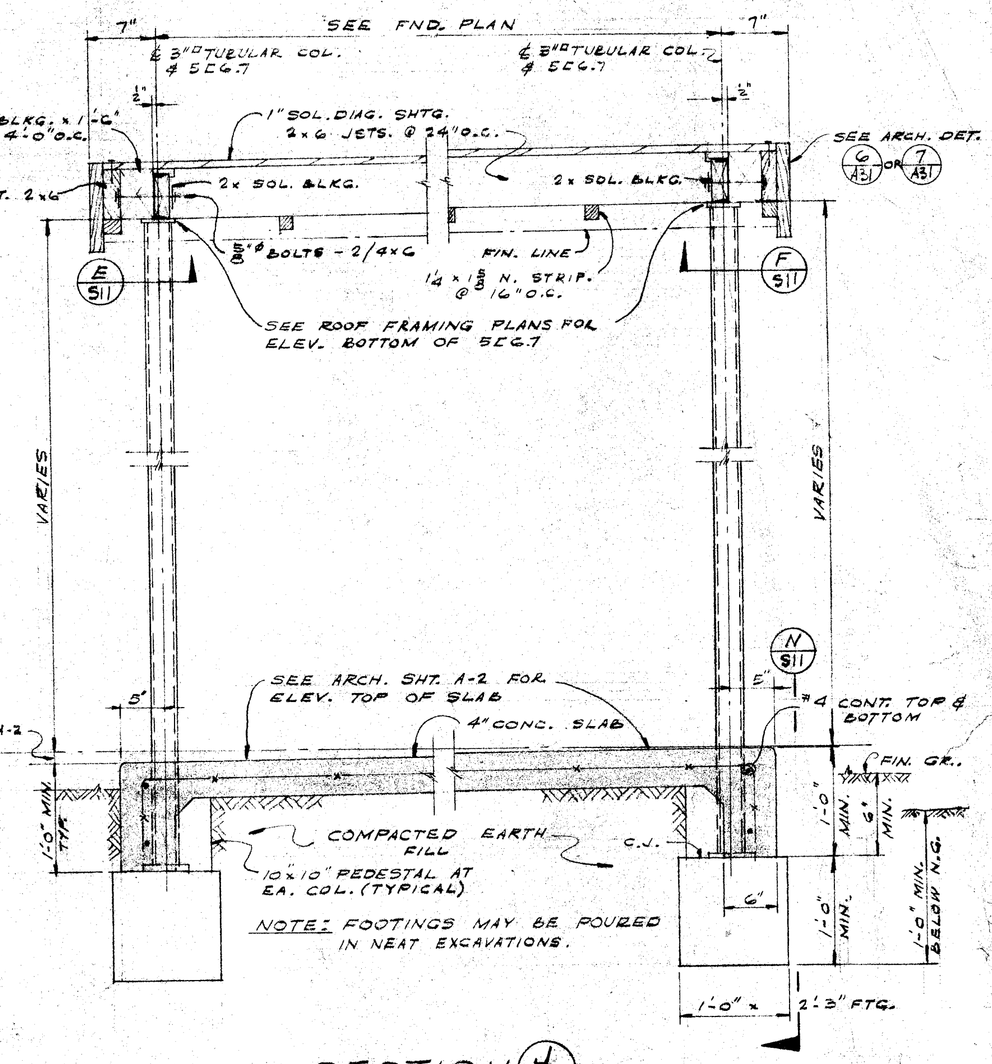

SECTION (J S11)

1" = 1'-0"

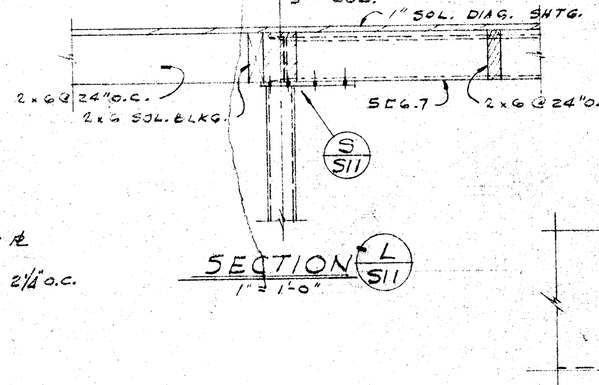

SECTION (L S11)

1" = 1'-0"

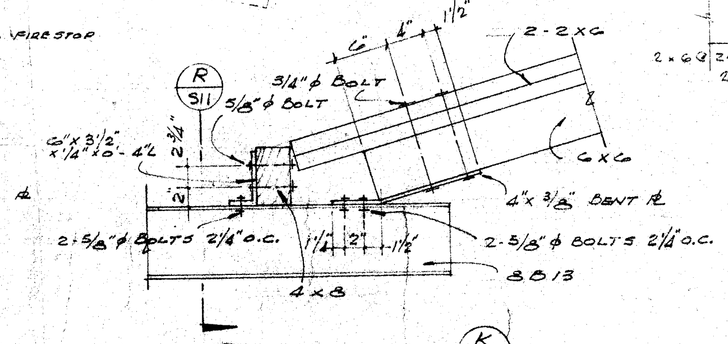

DETAIL (K S11)

1" = 1'-0"

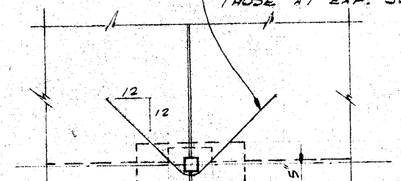

PLAN DETAIL (M S11)

1/2" = 1'-0"

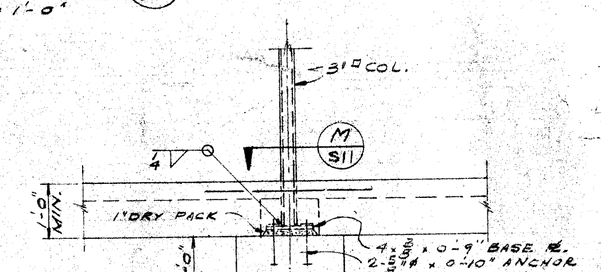

COLUMN FTG. ELEV. (N S11)

1/2" = 1'-0"

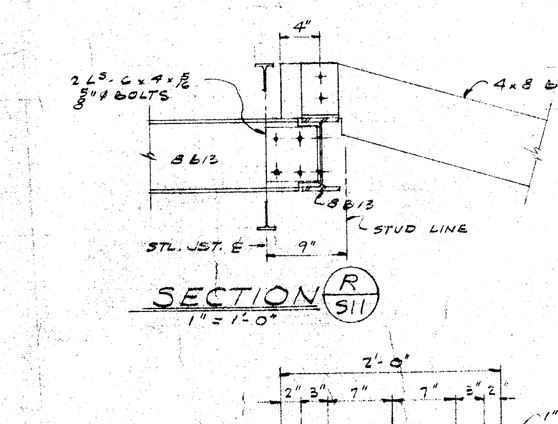

SECTION (R S11)

1" = 1'-0"

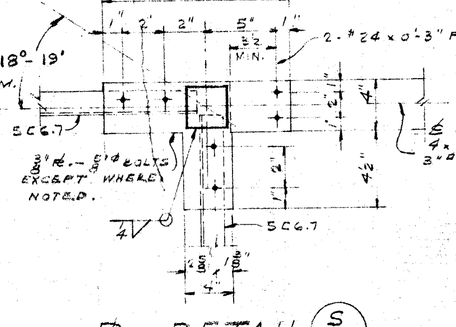

PL. DETAIL (S S11)

1" = 1'-0"

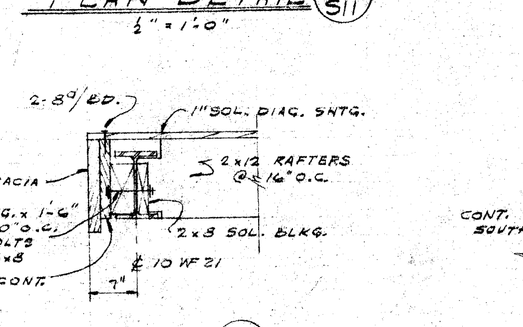

SECTION (T S11)

3/4" = 1'-0"

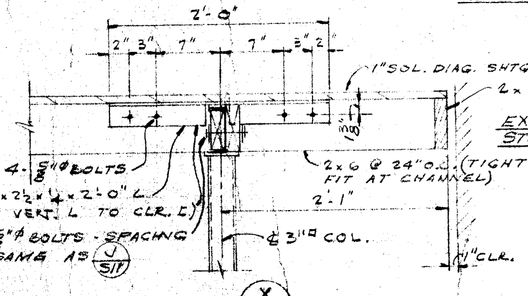

SECTION (X S11)

1" = 1'-0"

PLAN

DETAIL (EE S11)

1" = 1'-0"

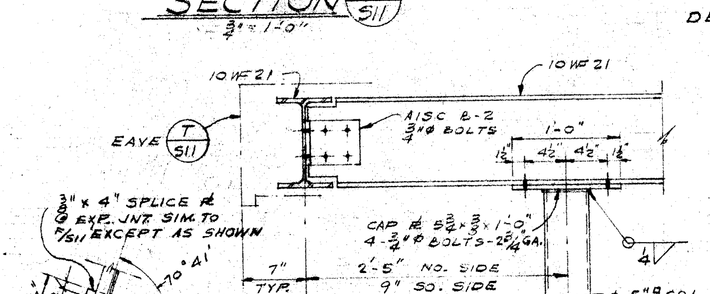

SECTION (Y S11)

1" = 1'-0"

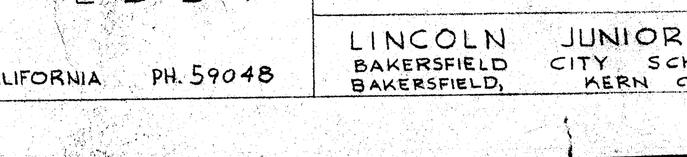

COLUMN FOOTING (Z S11)

3/4" = 1'-0"

DETAIL (CC S11)

WILLIAM T. WHEELER
STRUCTURAL ENGINEER
LOS ANGELES, CALIFORNIA

STATE OF CALIFORNIA DEPT. OF PUBLIC WORKS DIVISION OF ARCHITECTURE
11314 APPROVED 10-26-53
APPL'N. NO. PER Harry Wirth PRINCIPAL STRUCTURAL ENGINEER

KERN CO. SUPERINTENDENT OF SCHOOLS
APPROVED:
SUPT. 10-30-53 DATE

BAKERSFIELD CITY SCHOOL DISTRICT BOARD OF EDUCATION
APPROVED: [illegible] PRES.
SEC. 10-29-53 DATE

REVISIONS:

DATE 9-30-53 DRAWN LGM
JOB NO. CHECKED RJV
Architect C-6895

ROBERT N. EDDY
ARCHITECT A.I.A.
2901 H ST. BAKERSFIELD, CALIFORNIA PH. 59048

WALL ELEVATIONS AND ARCADE SECTIONS

LINCOLN JUNIOR HIGH SCHOOL
BAKERSFIELD CITY SCHOOL DISTRICT
BAKERSFIELD, KERN COUNTY, CALIFORNIA

S 11